




59+98
BRIDGE 43

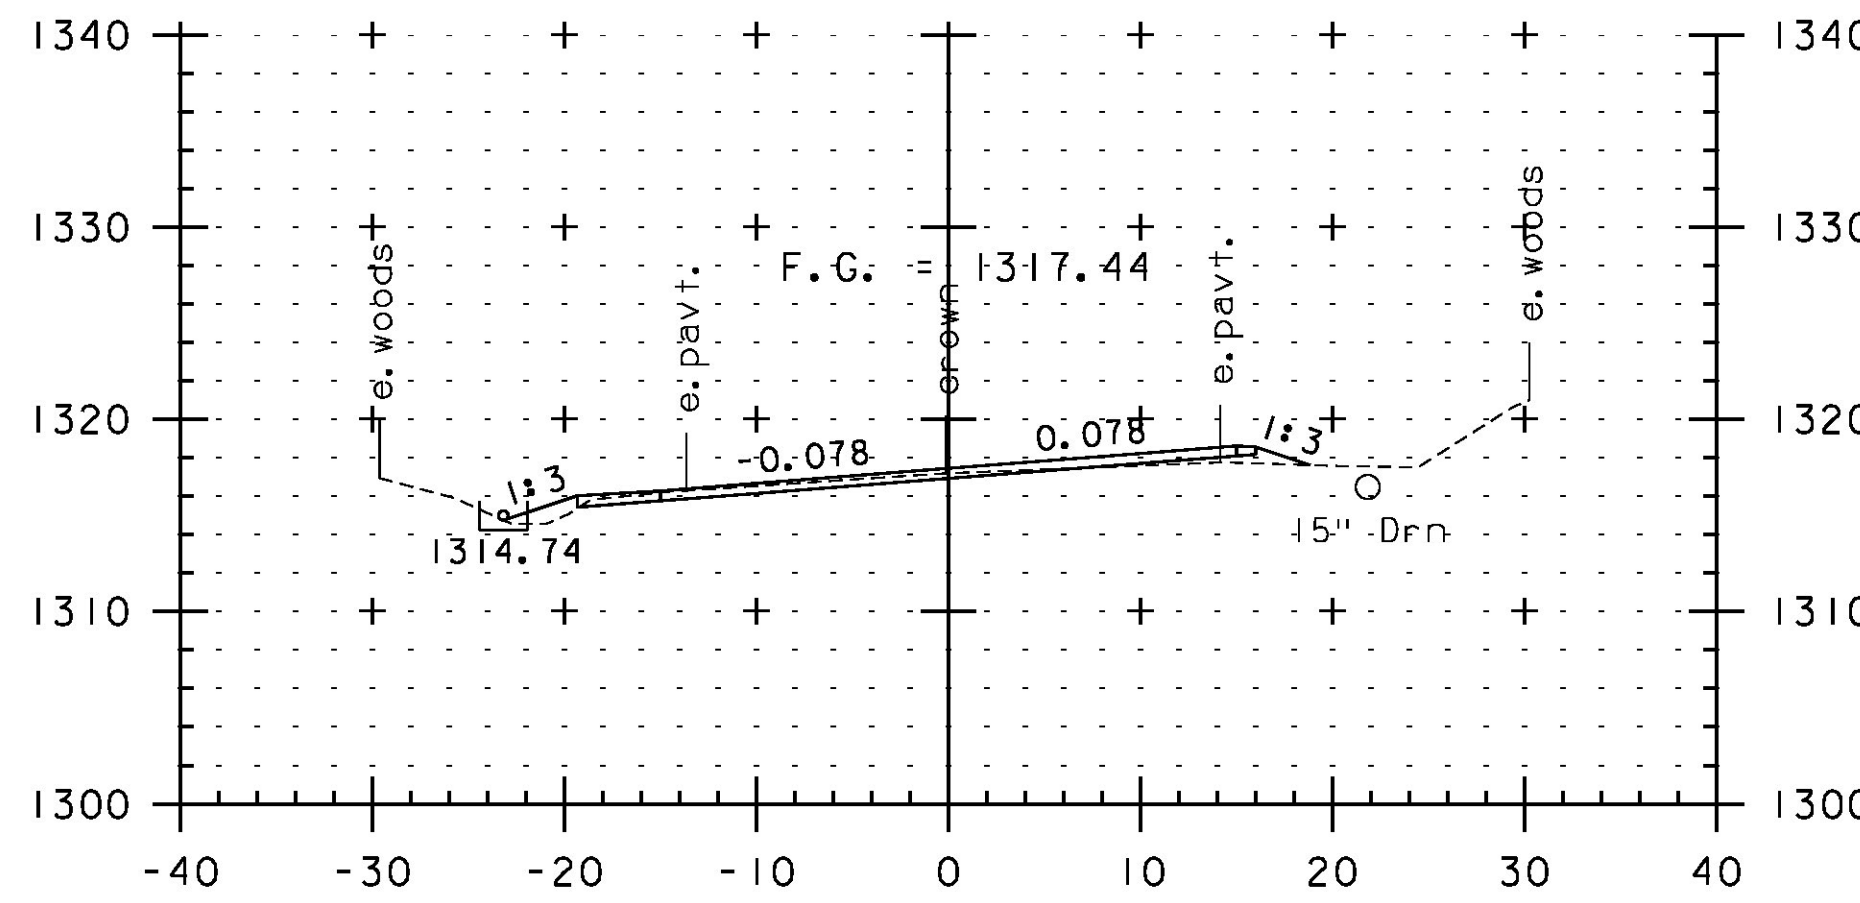


61+00

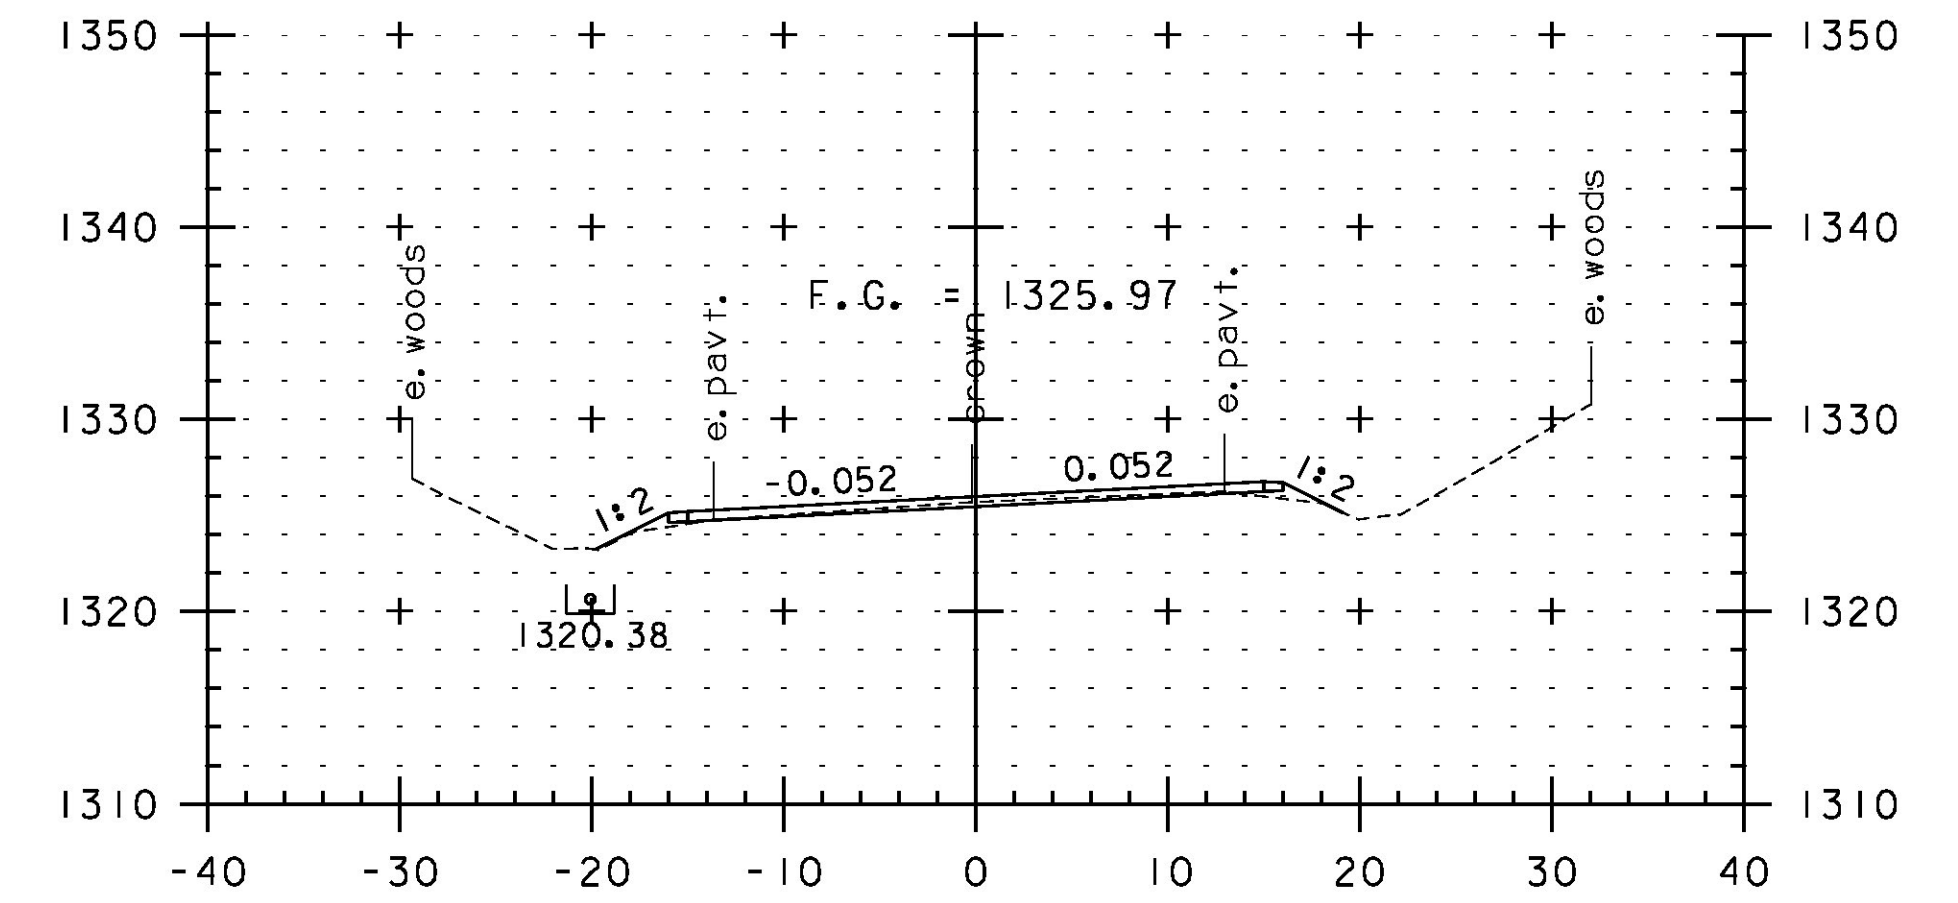


62+50

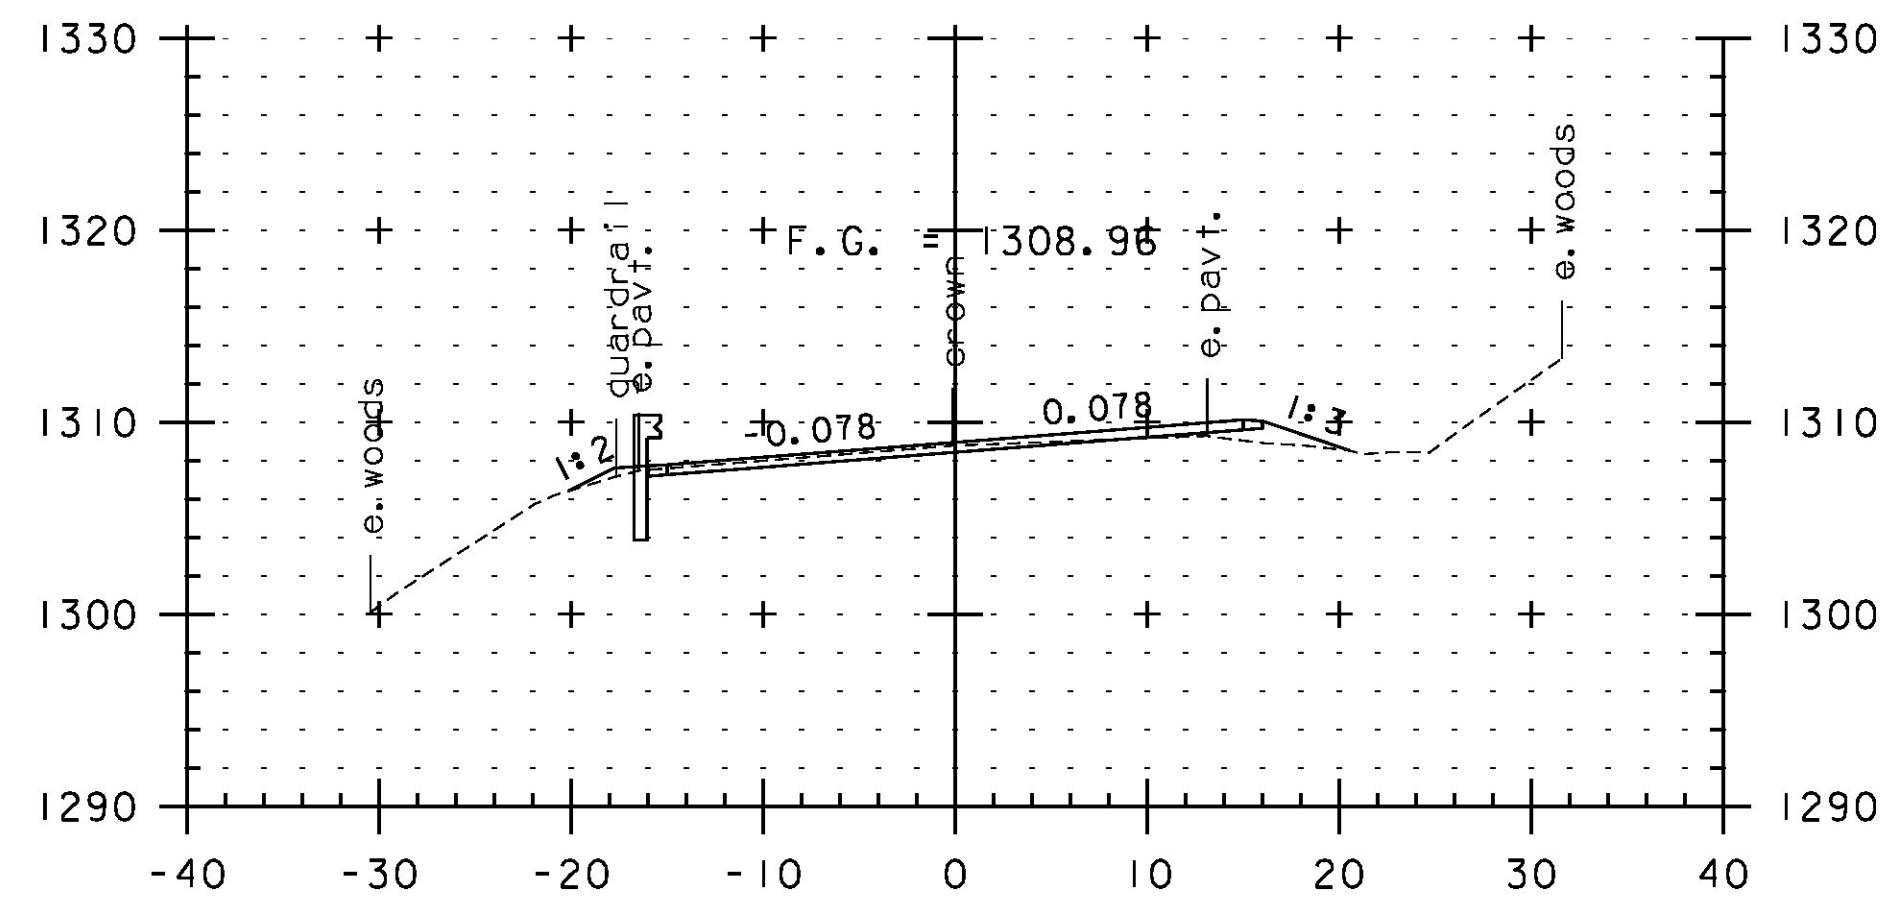


59+50

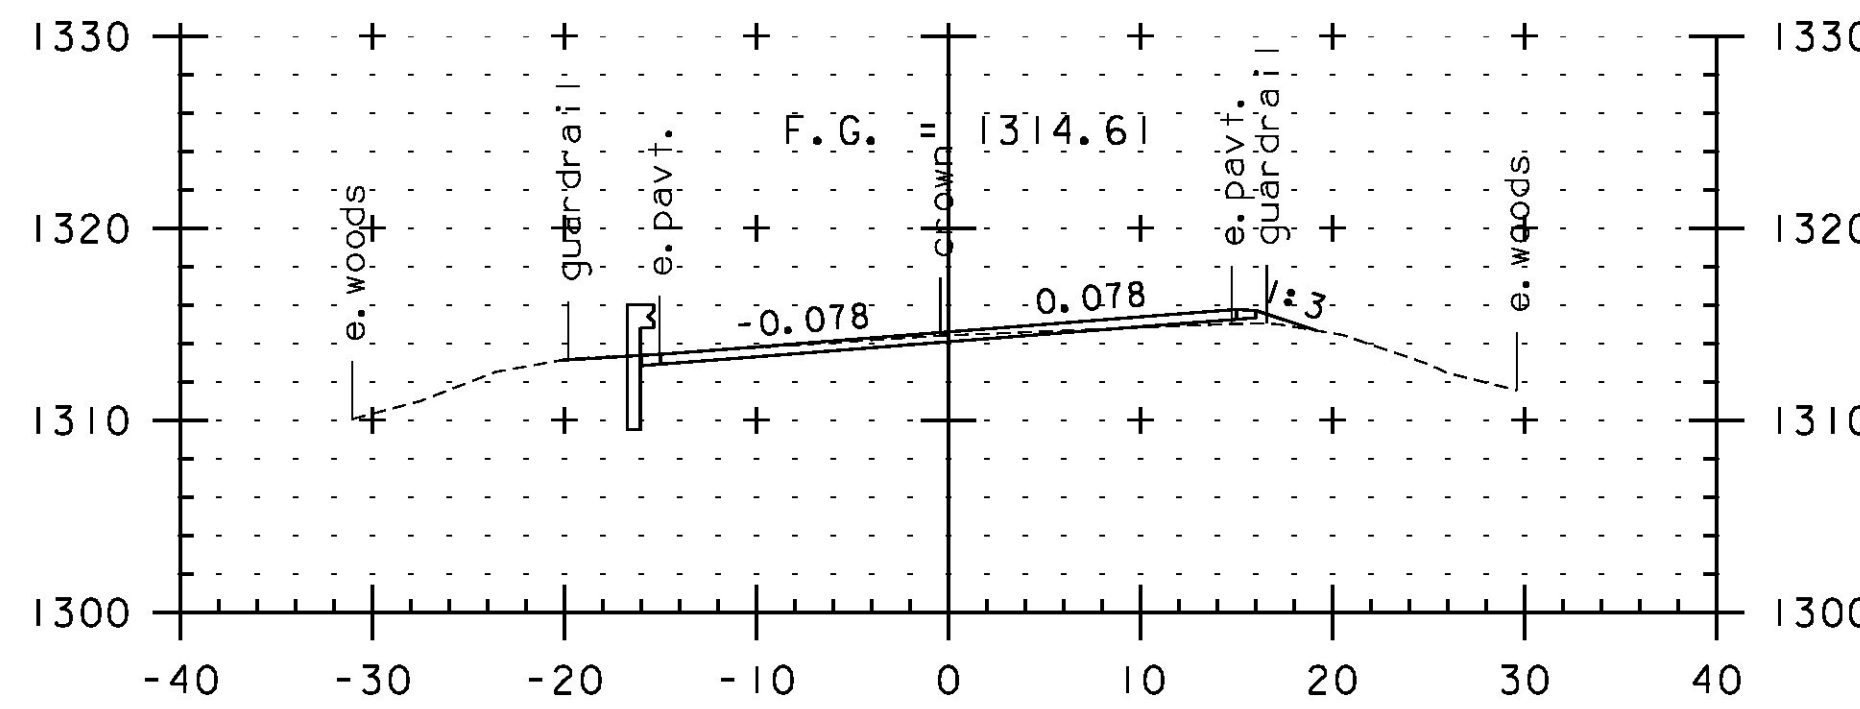


60+50

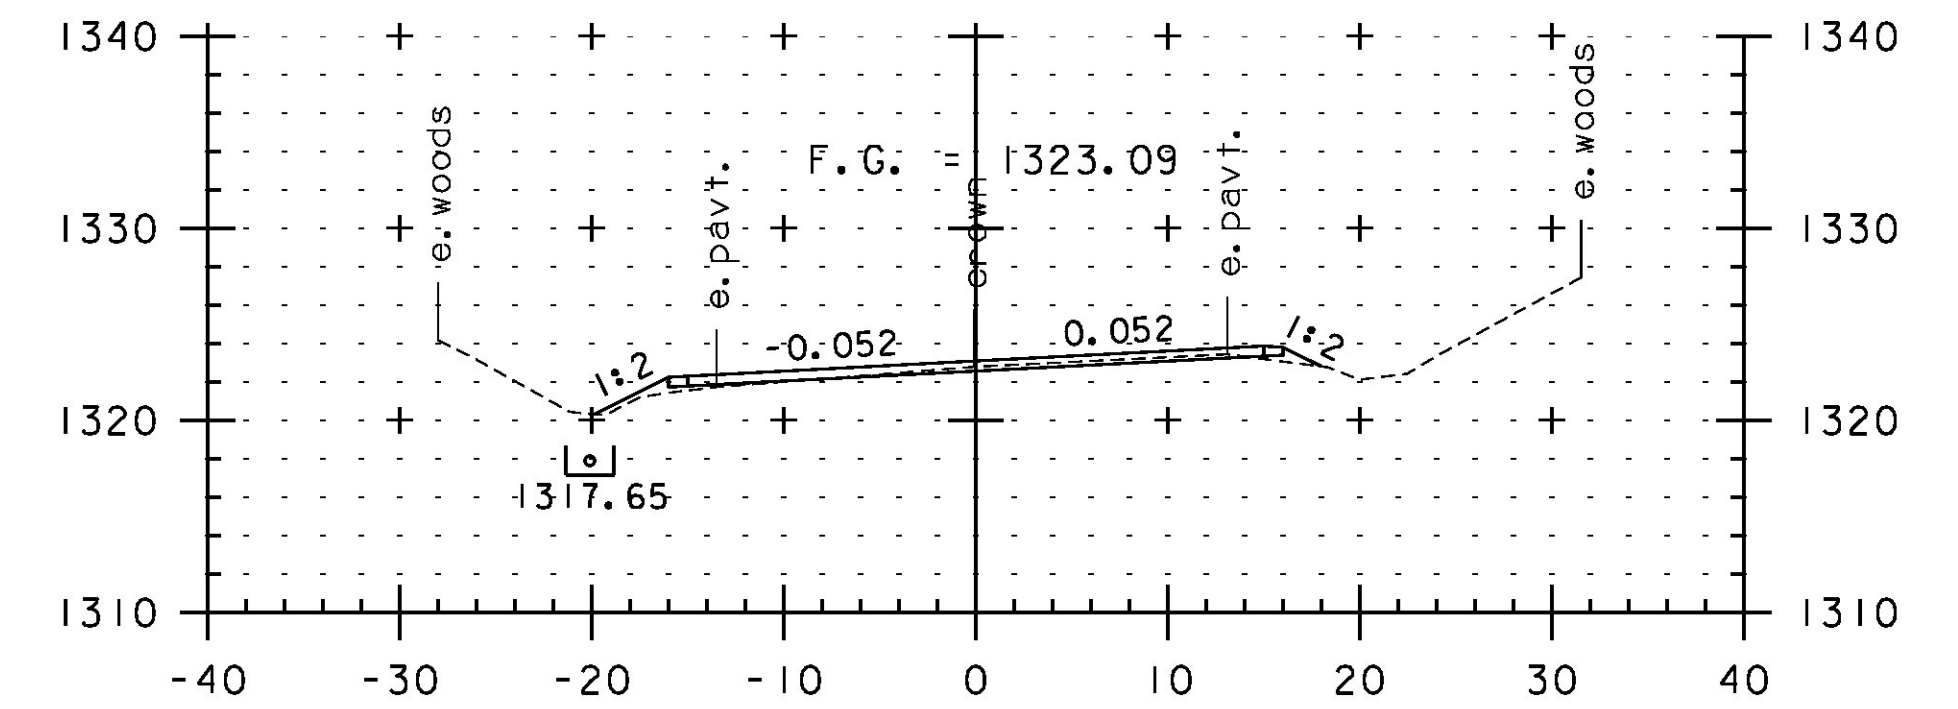

62+00

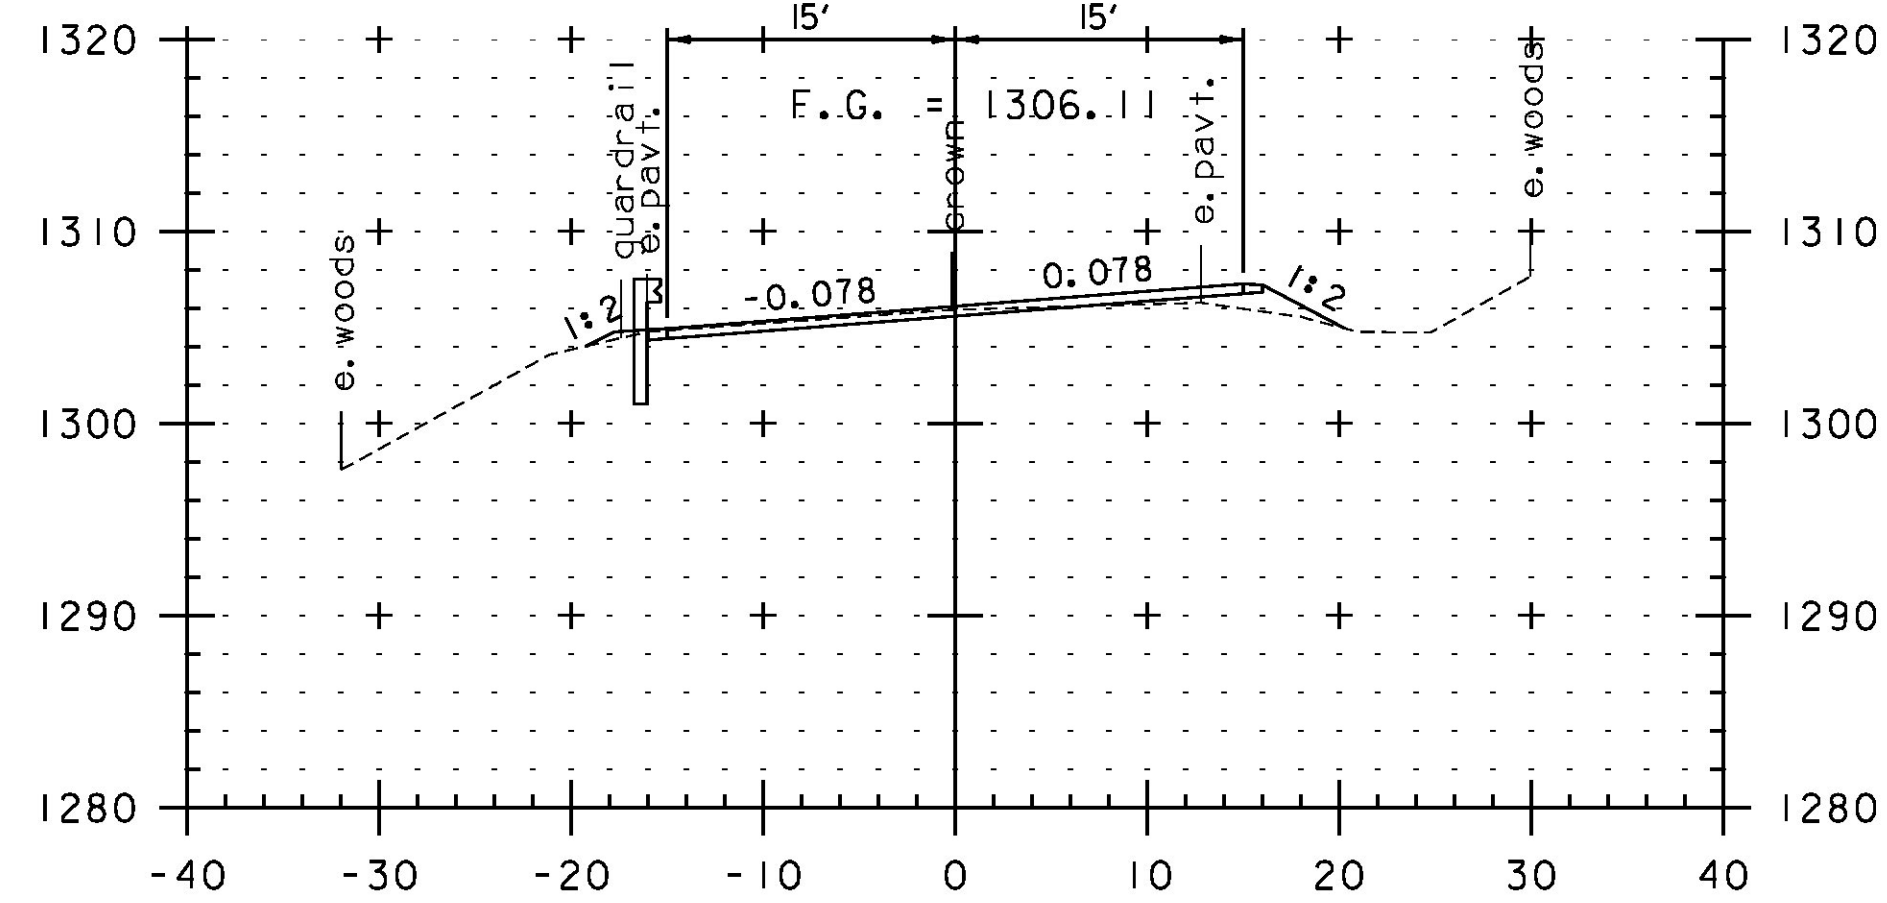


59+00

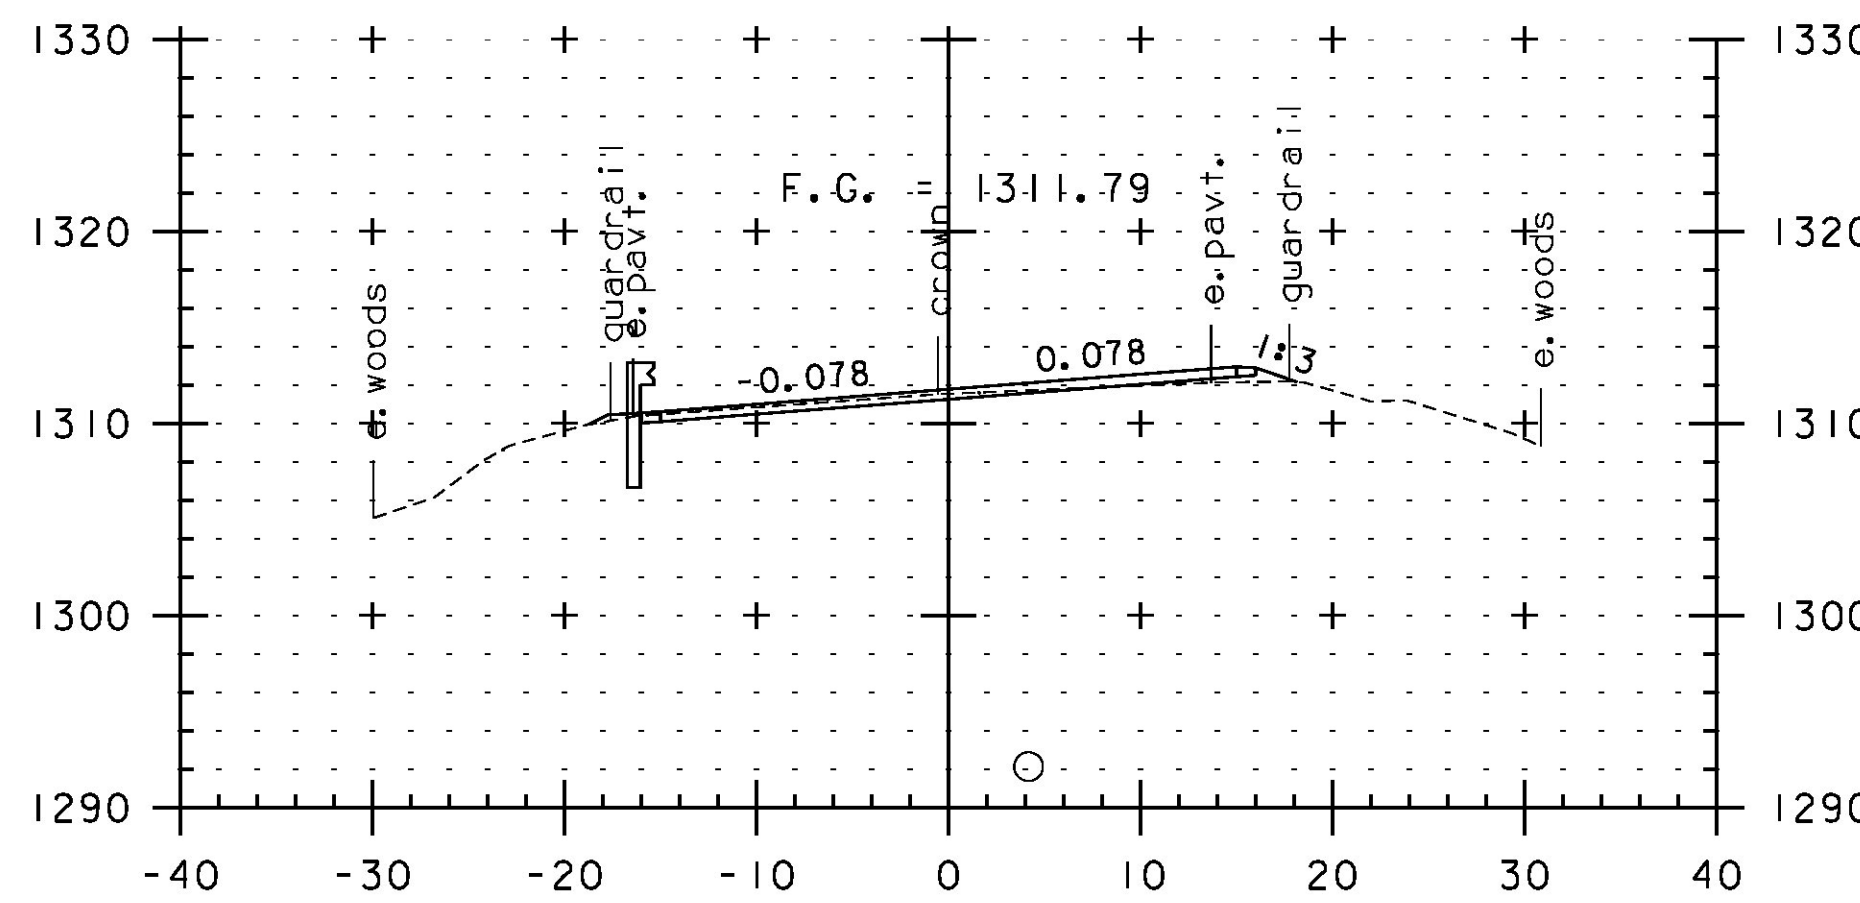

60+00



61+50

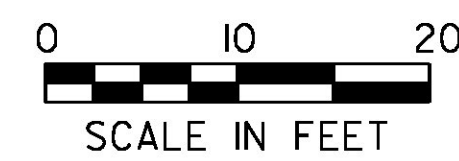

SCALE IN FEET

STA. 59+00 TO STA. 62+50

PROJECT NAME:	JAY-TROY	PLOT DATE:	5/16/2014
PROJECT NUMBER:	STP 2315(I)	DRAWN BY:	W. GORDON
FILE NAME:	z10b232xs.dgn	DESIGNED BY:	N. LEMAY
PROJECT LEADER:	P. SHEDD	CHECKED BY:	P. SHEDD
CROSS SECTION SHEET	6	SHEET	142 OF 244