




64+00

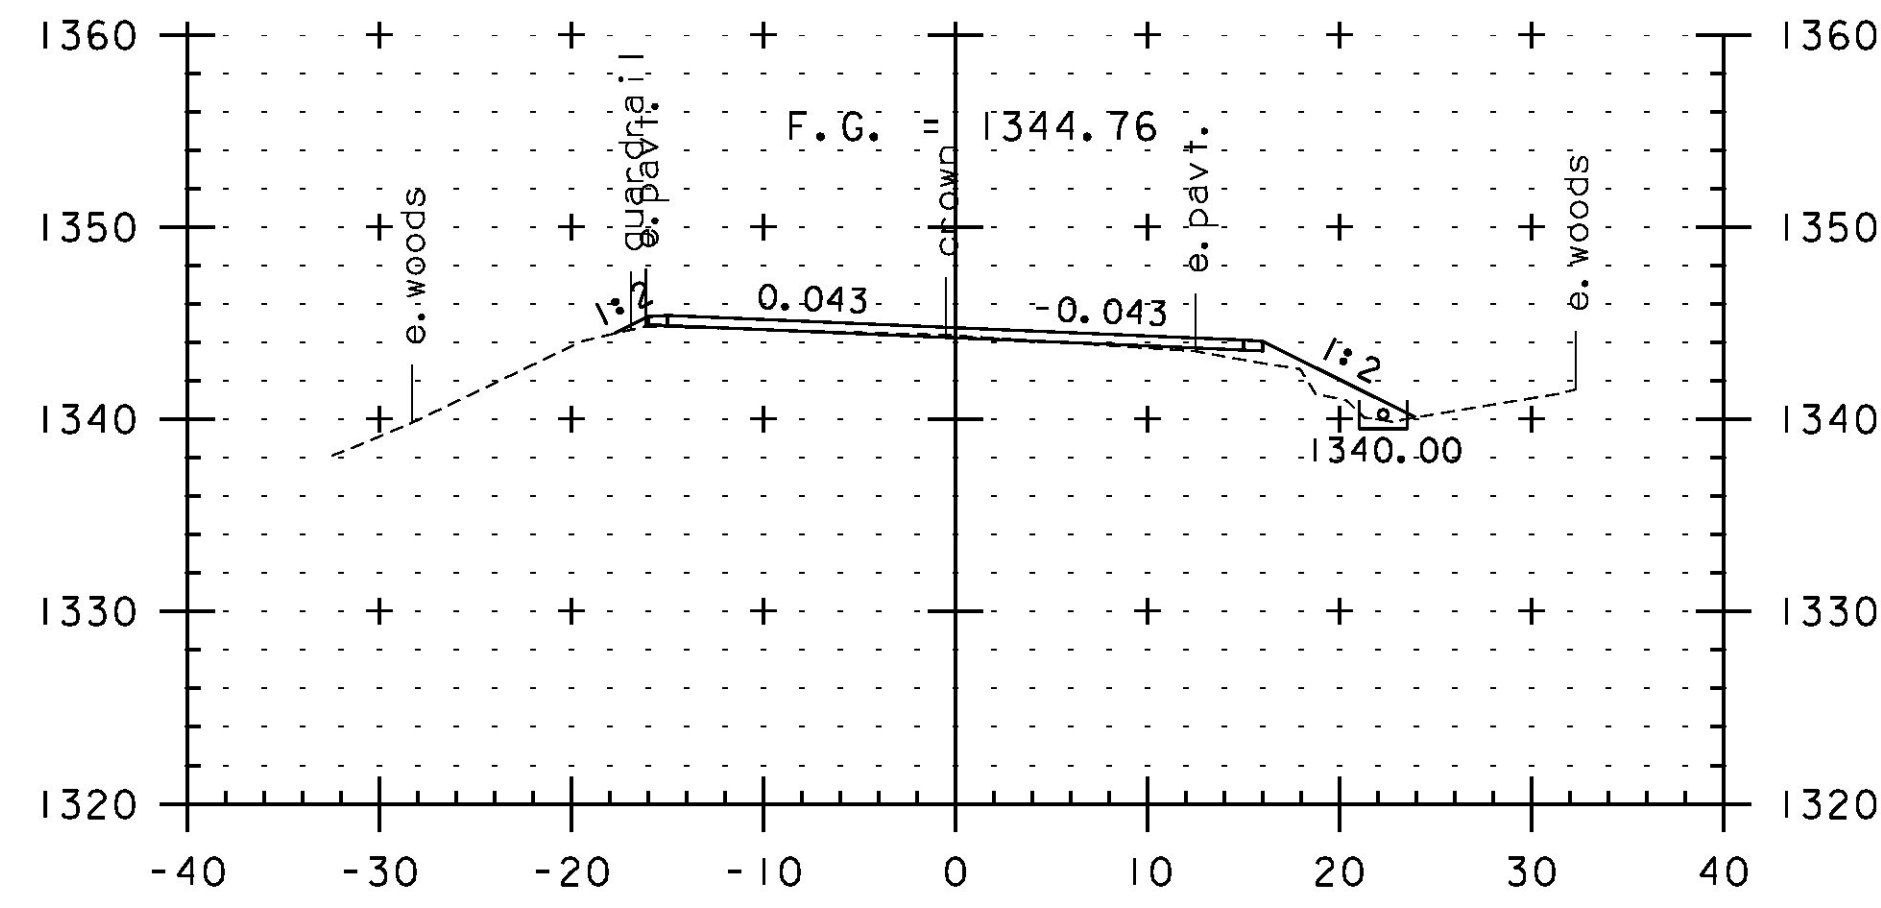


65+50

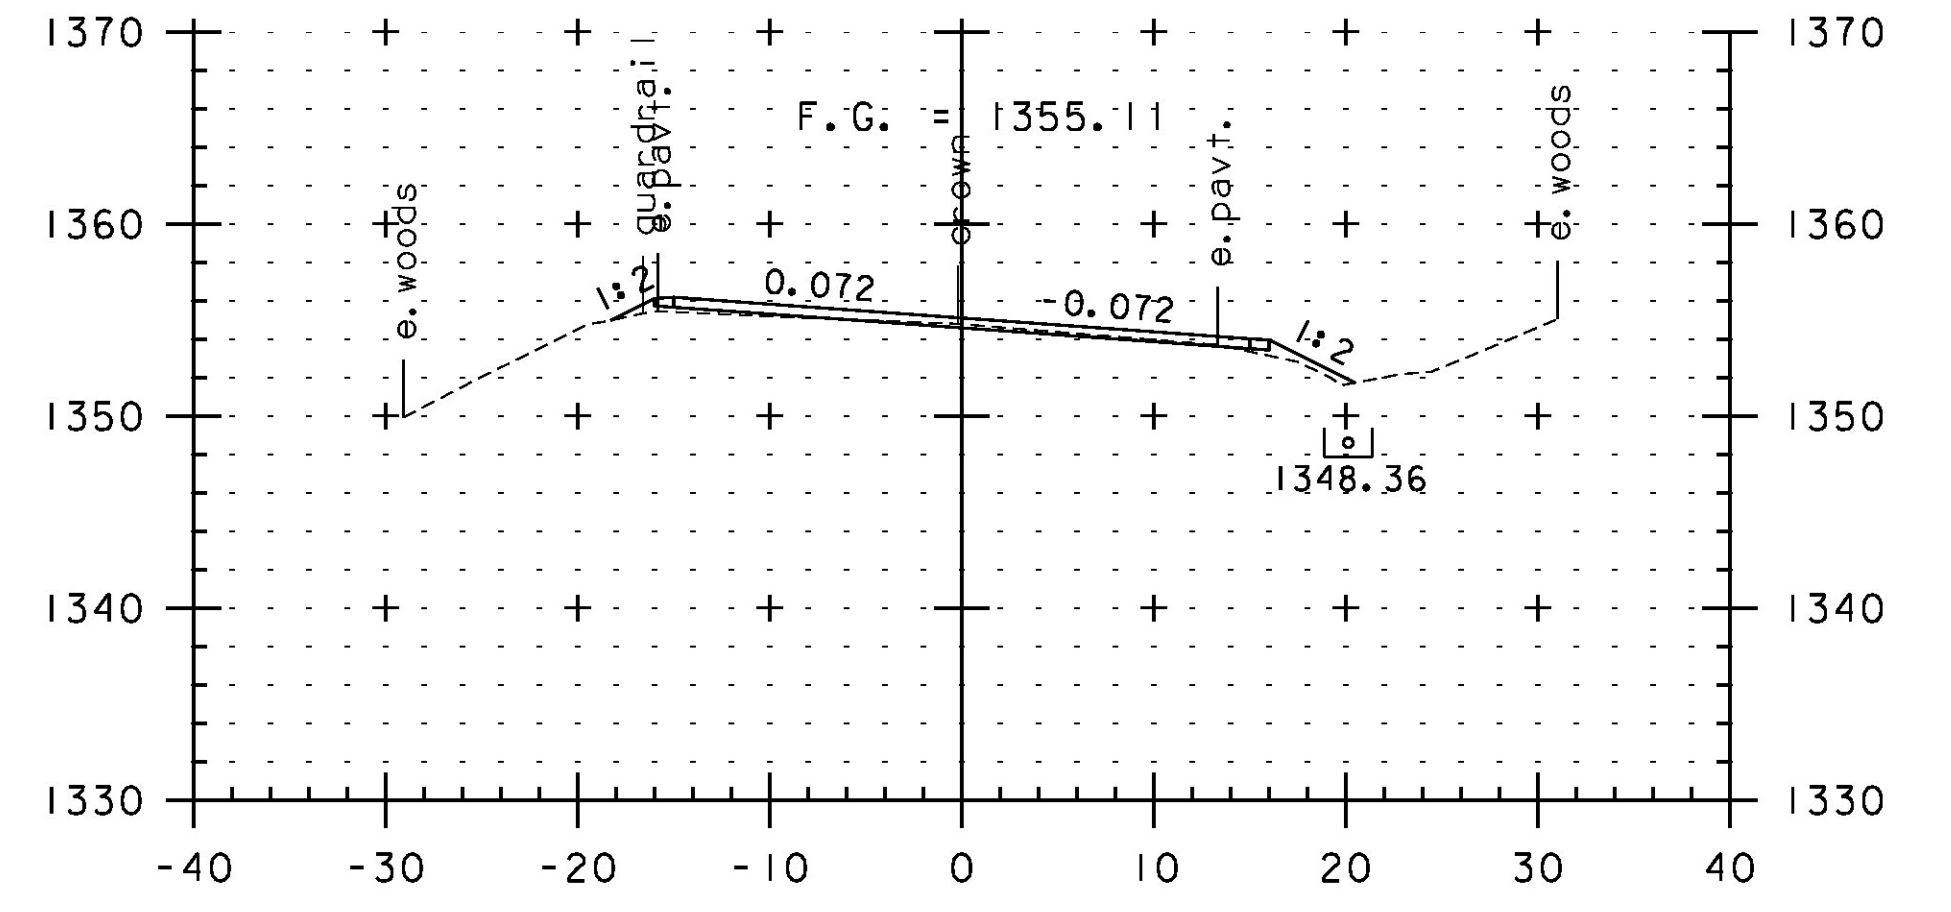


67+00

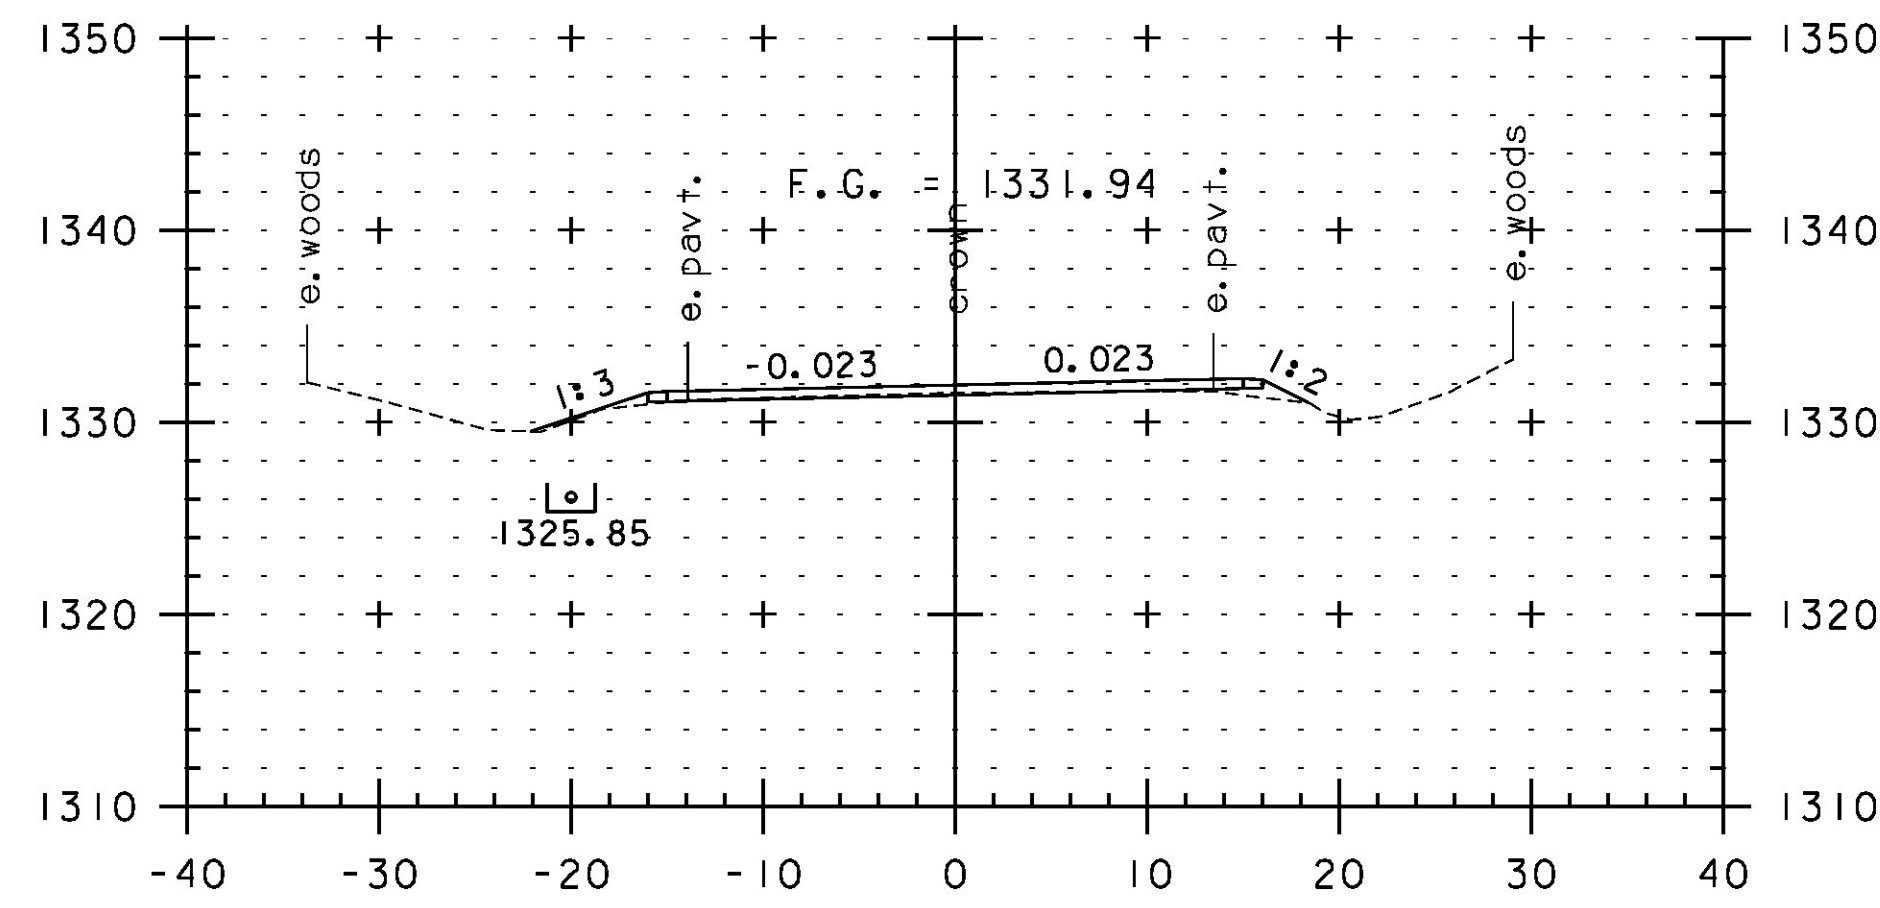


63+50

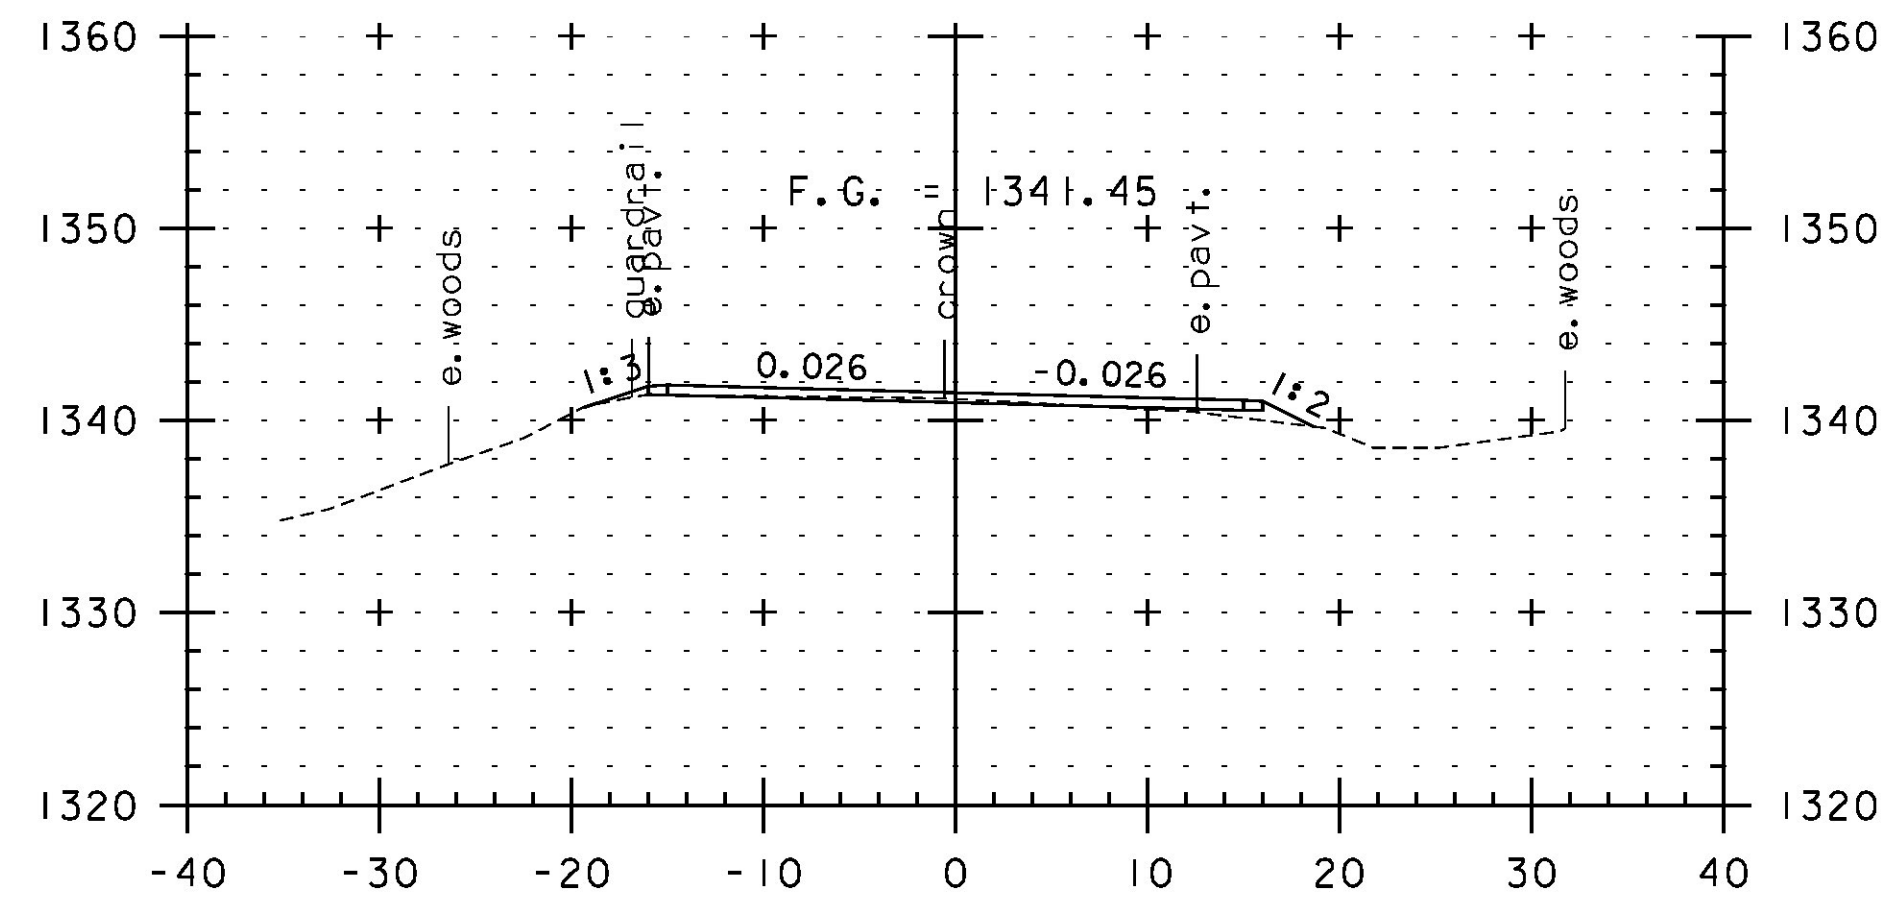


65+00

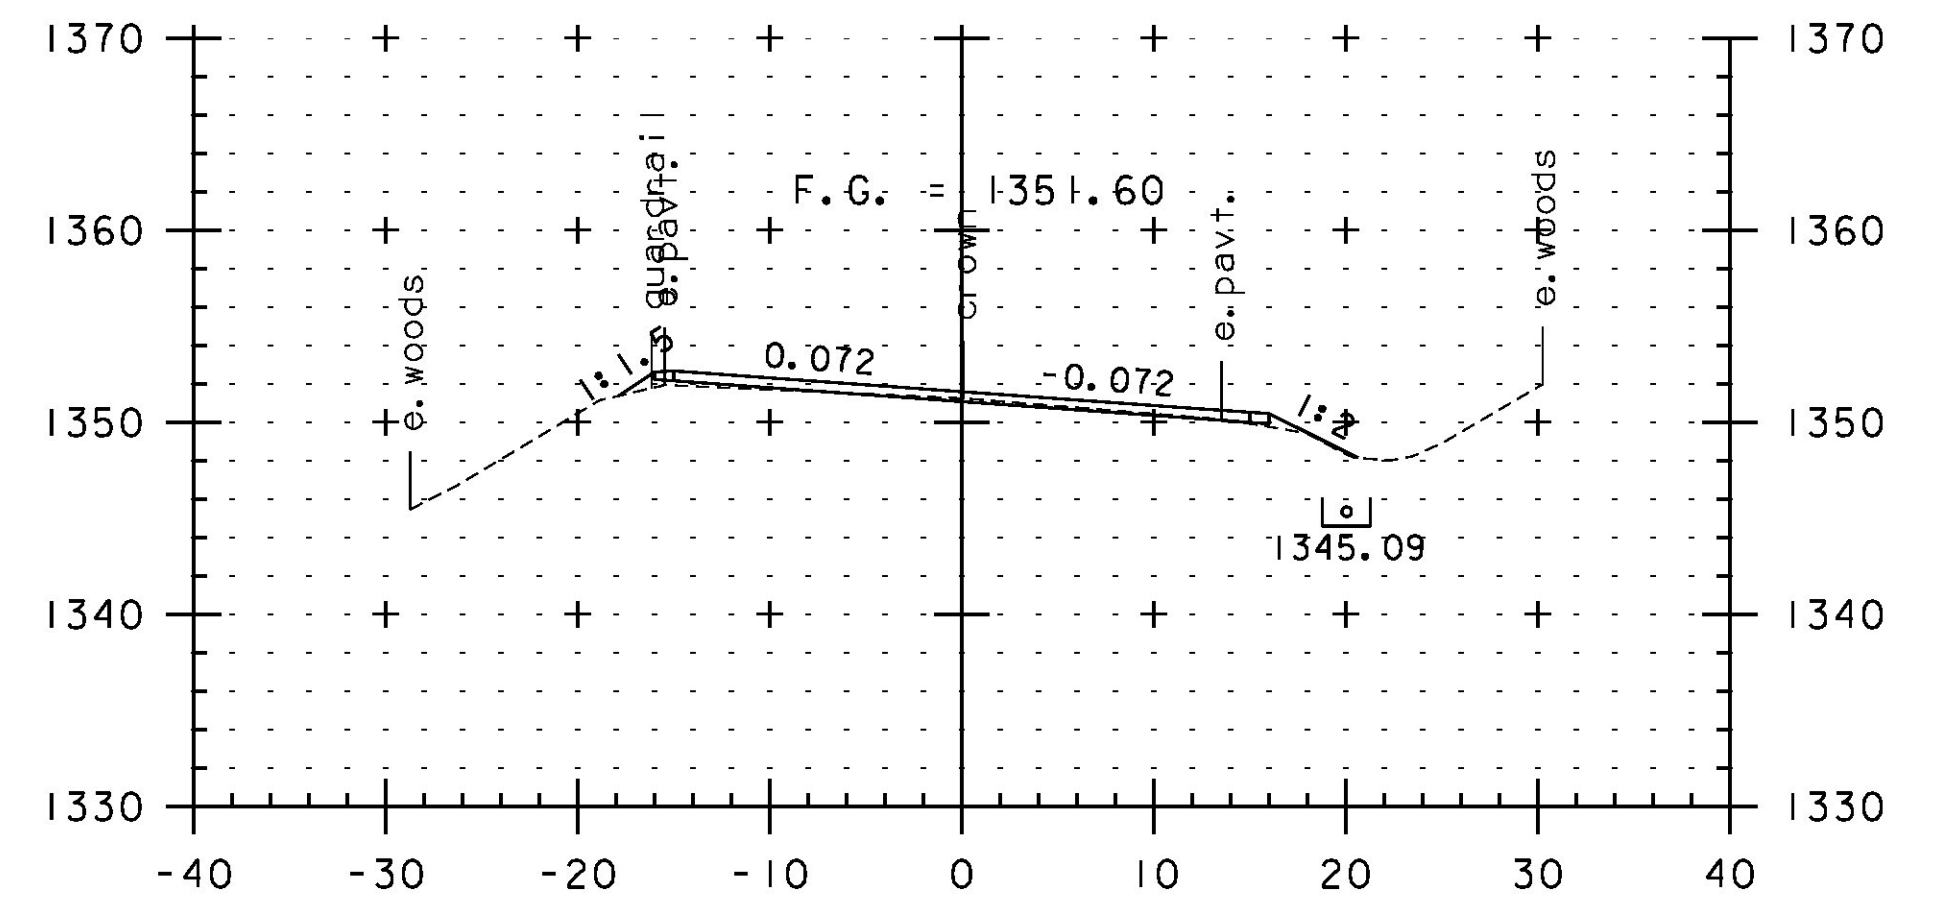


66+50

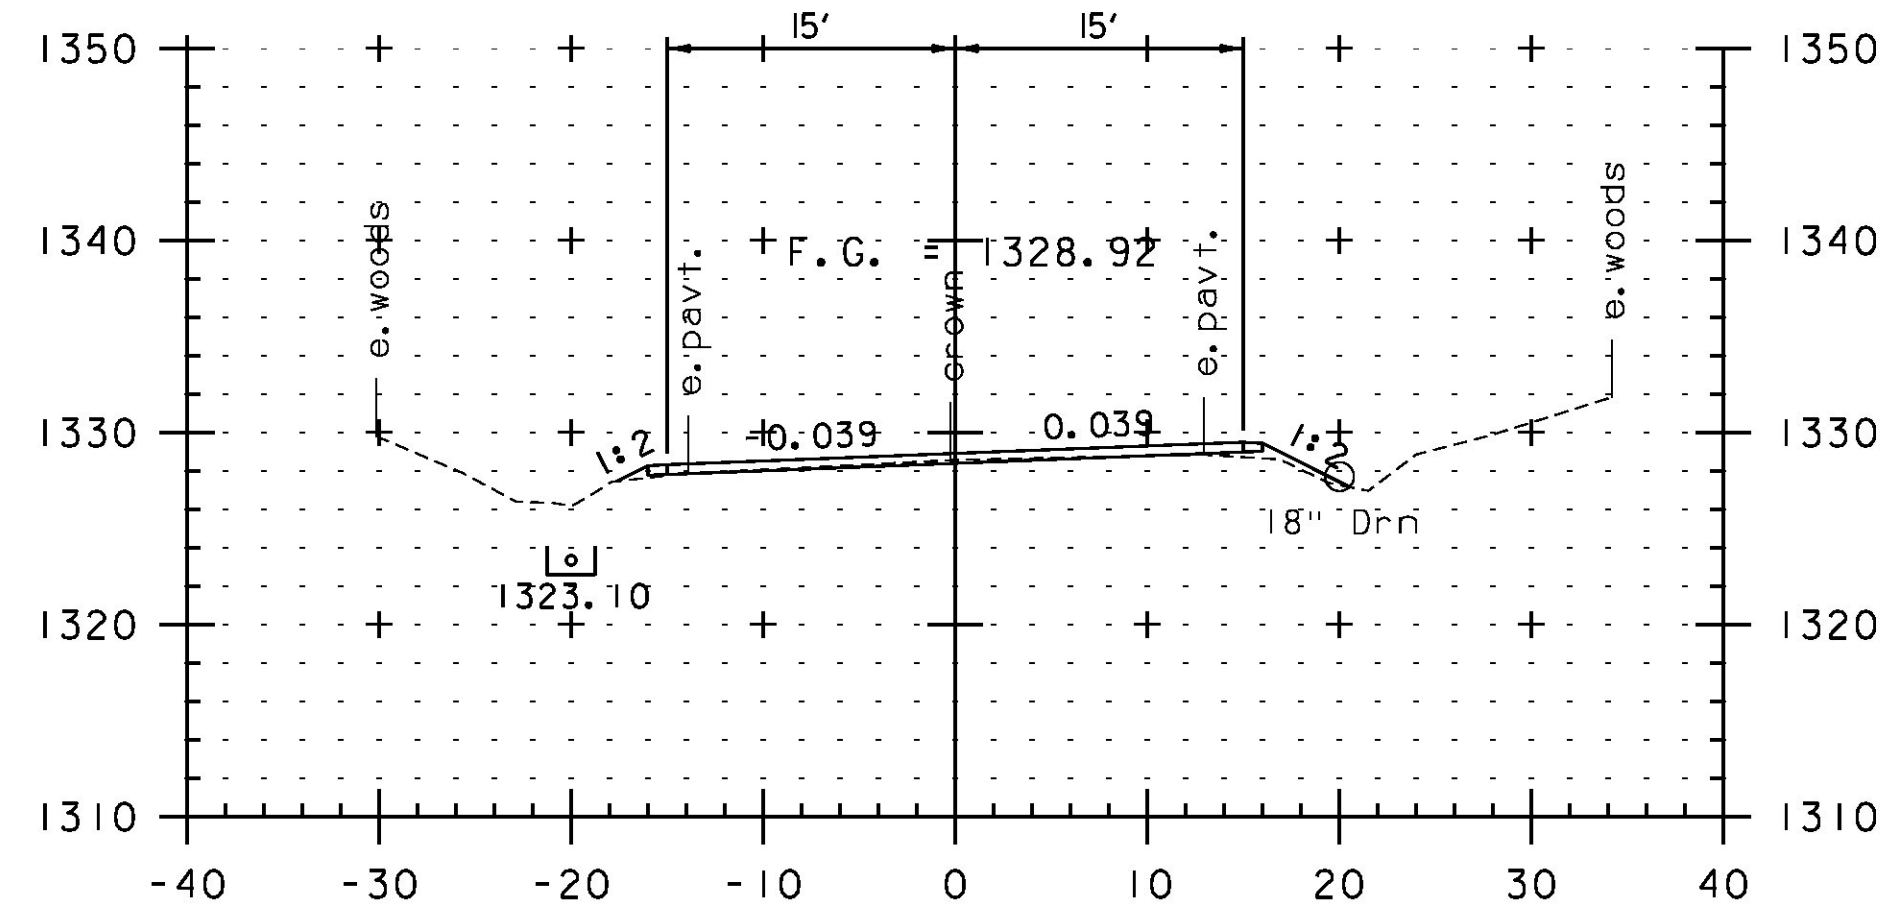

63+00

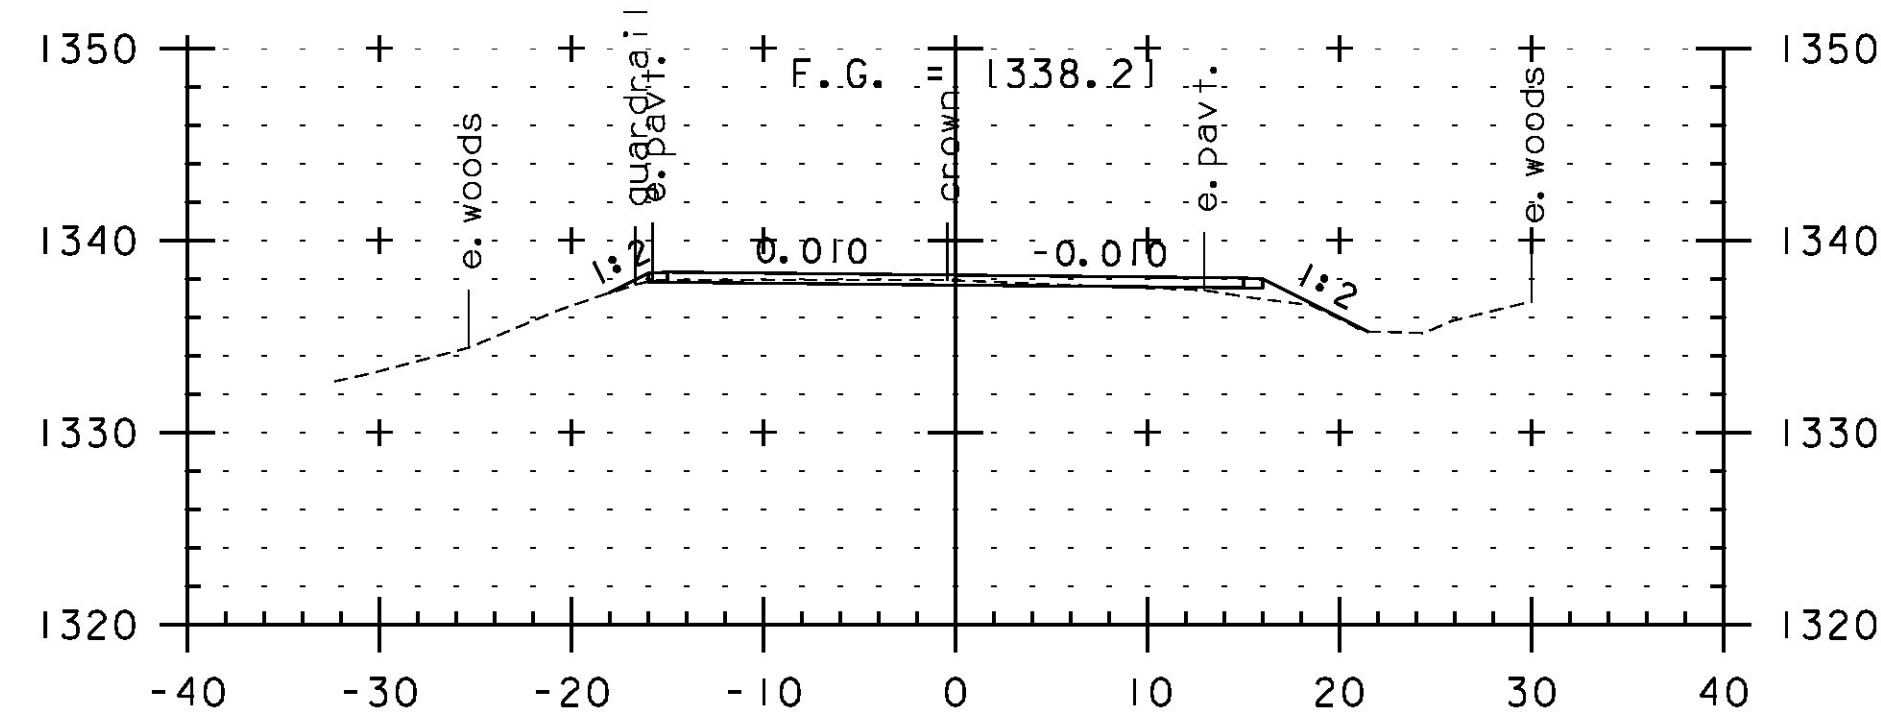

64+50

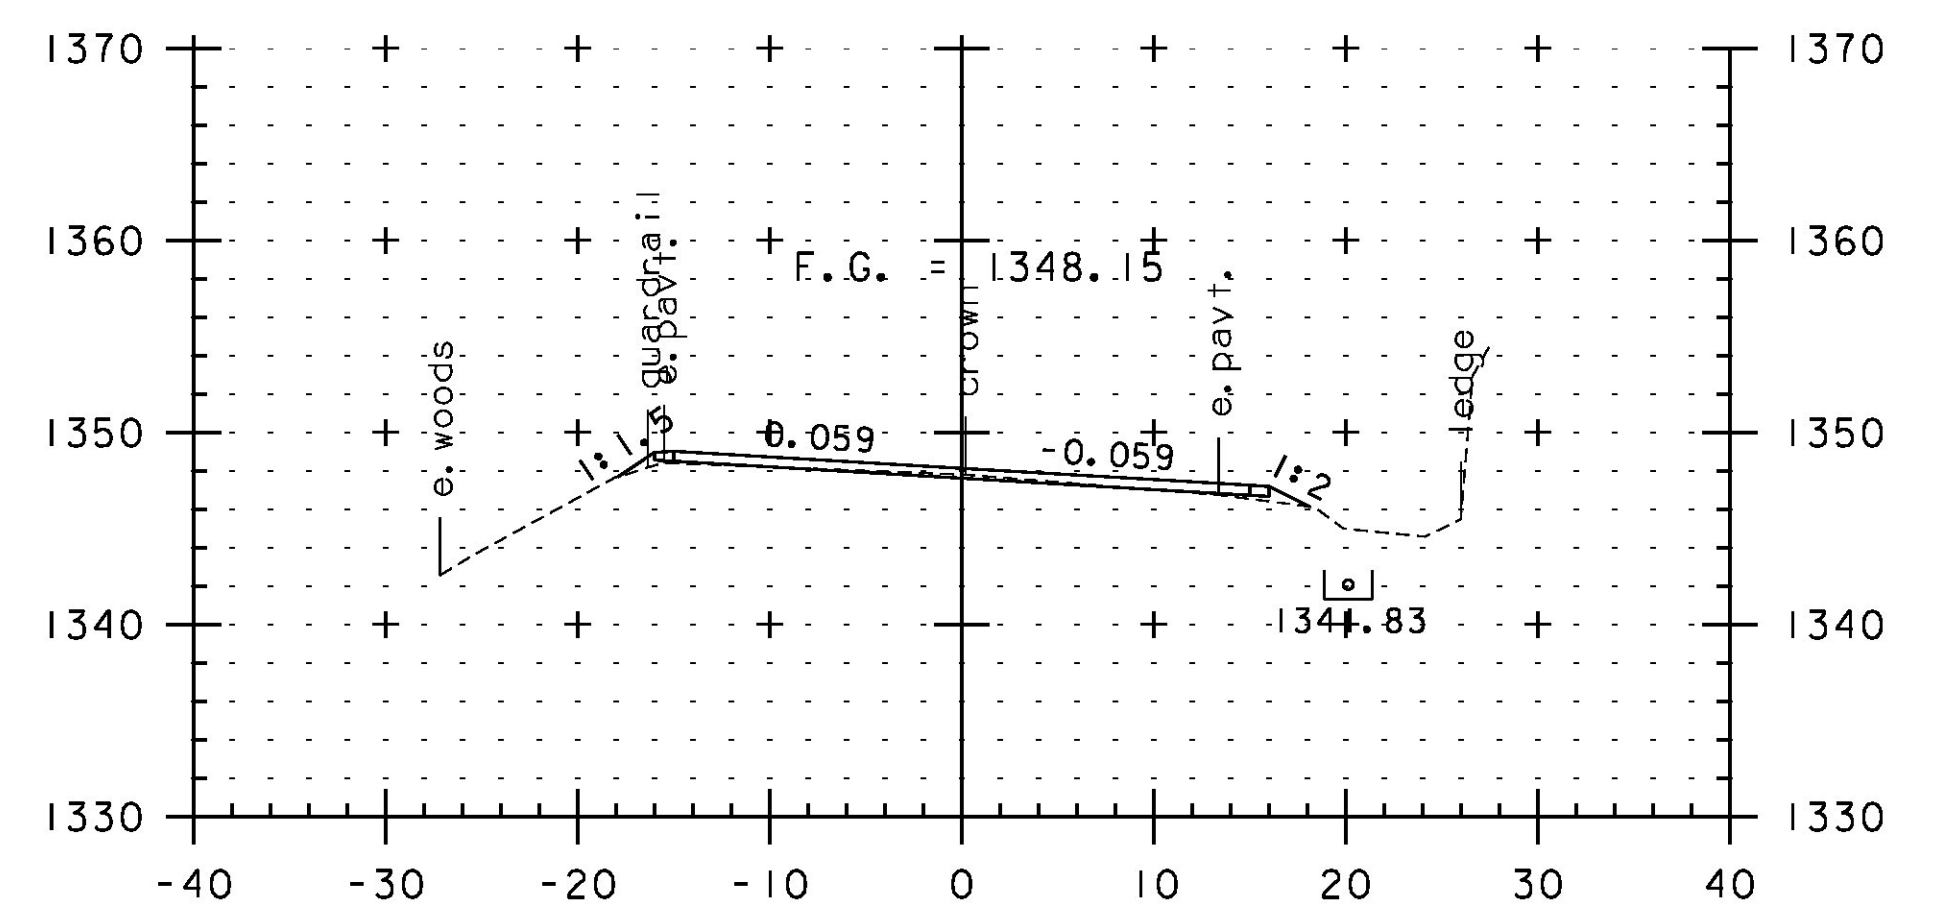

66+00



STA. 63+00 TO STA. 67+00

PROJECT NAME:	JAY-TROY	PLOT DATE:	5/16/2014
PROJECT NUMBER:	STP 2315(I)	DRAWN BY:	W. GORDON
FILE NAME:	z10b232xs.dgn	CHECKED BY:	P. SHEDD
DESIGNED BY:	N. LEMAY	CROSS SECTION SHEET	7
		SHEET	143 OF 244