




68+50

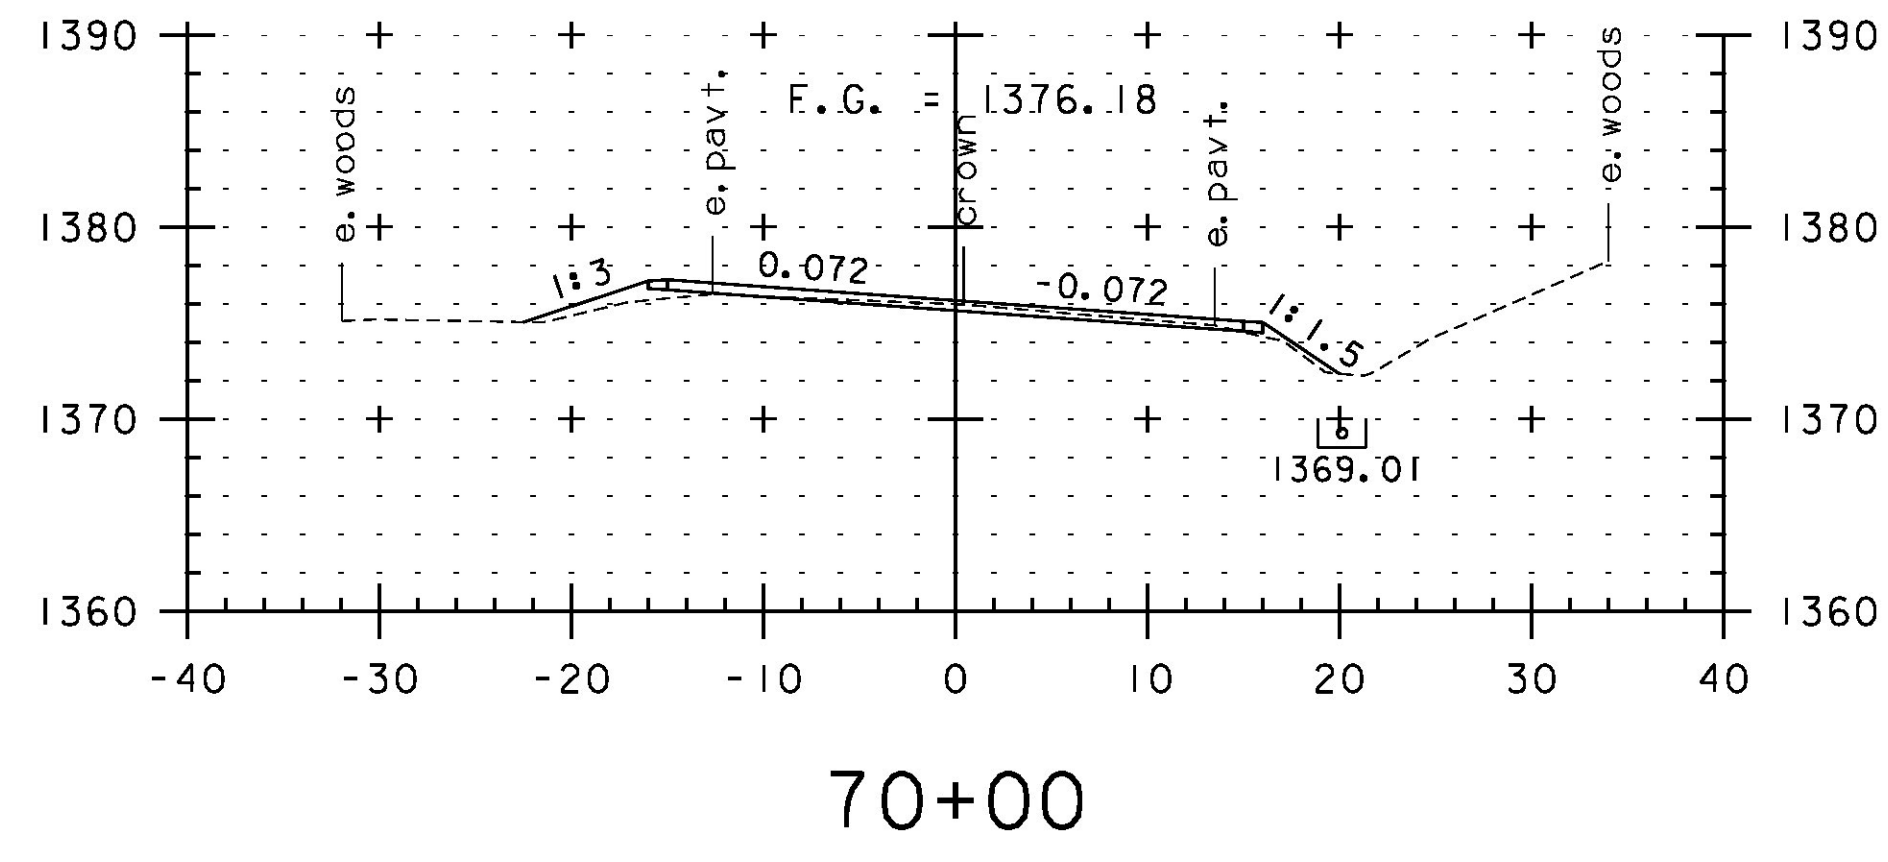


70+00

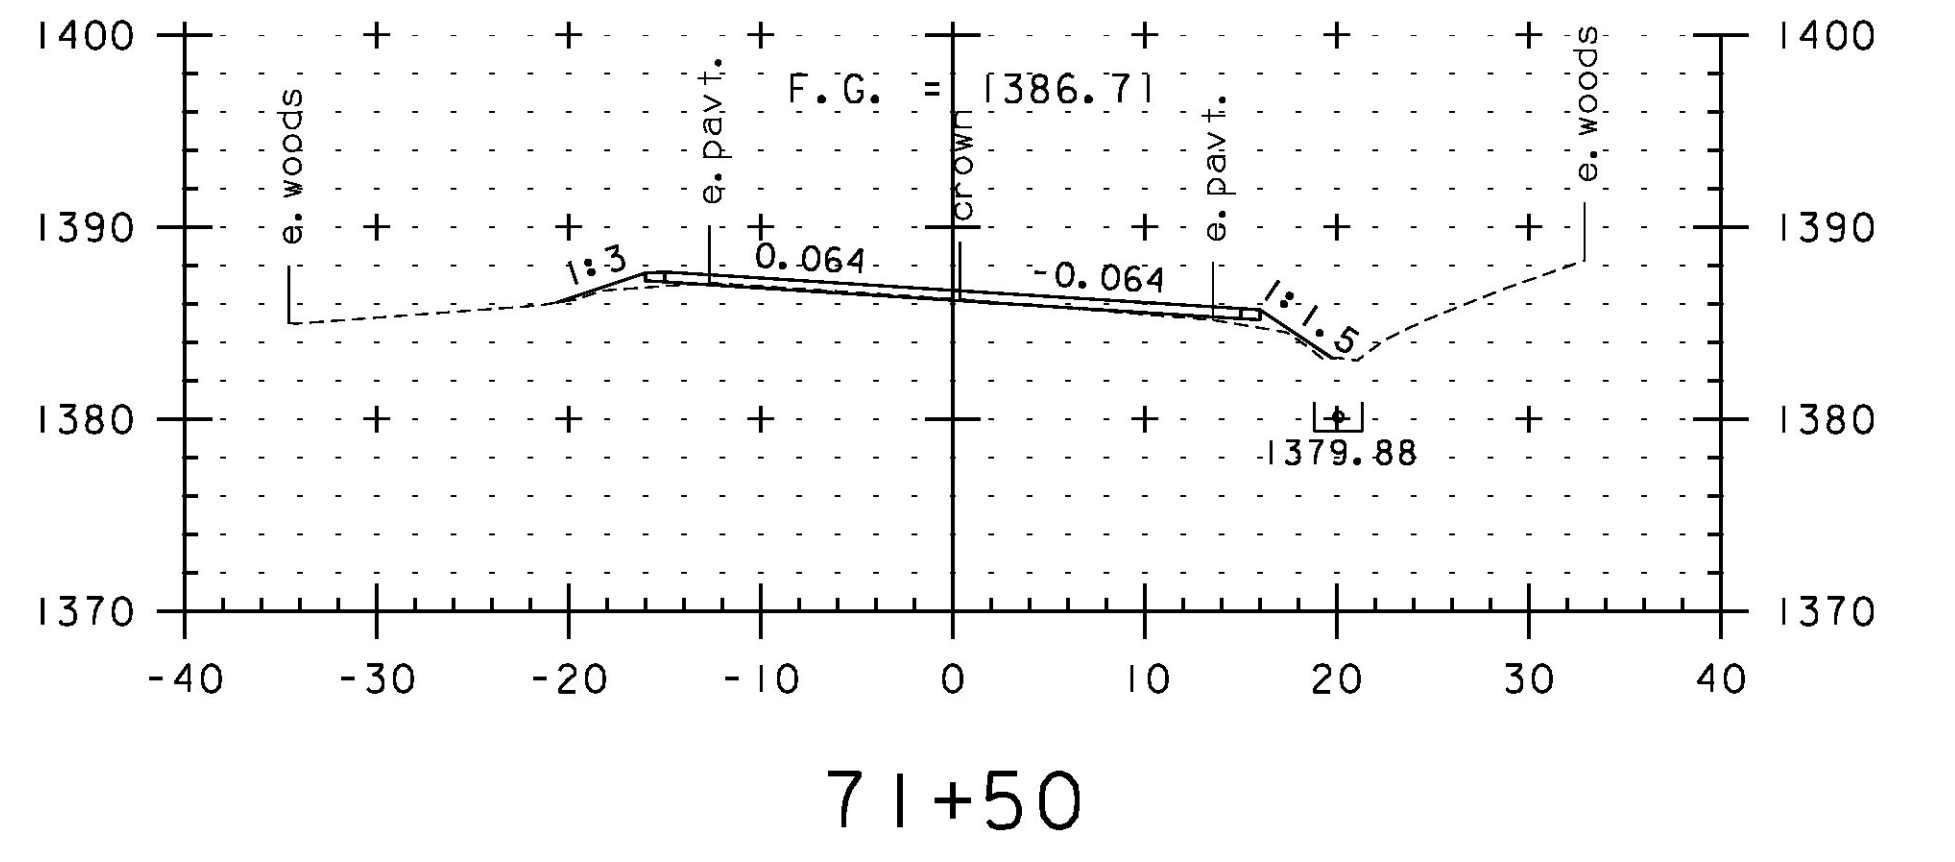


71+50

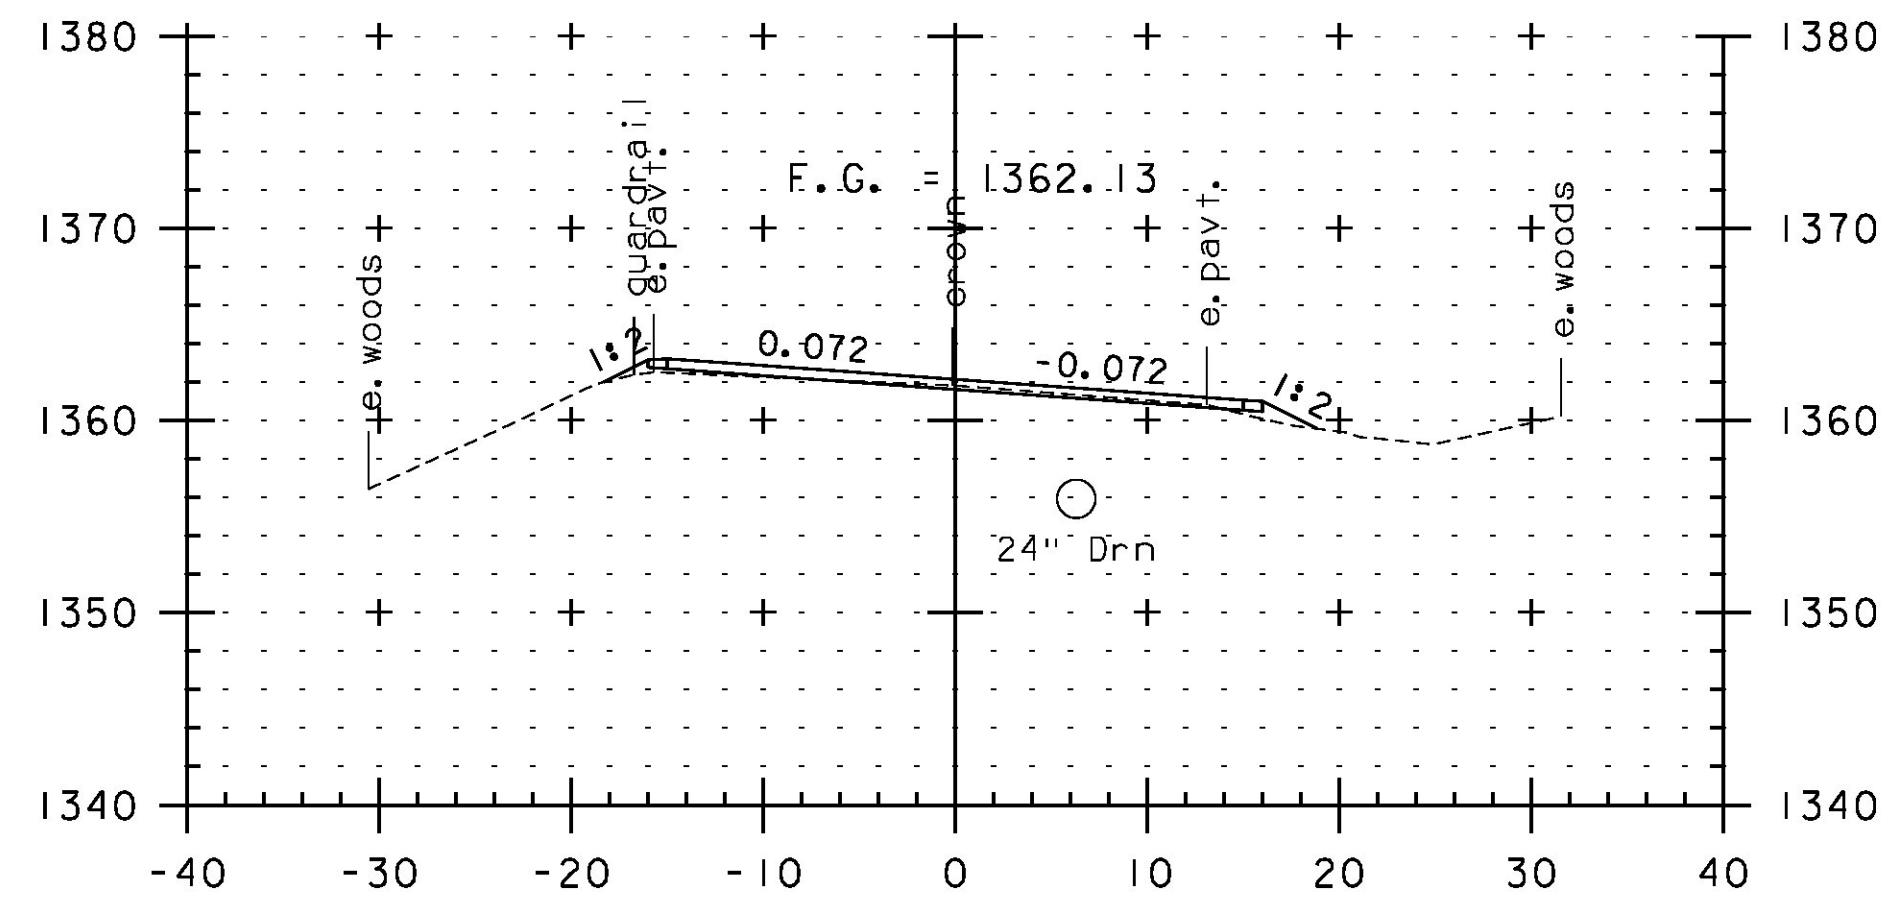


68+00

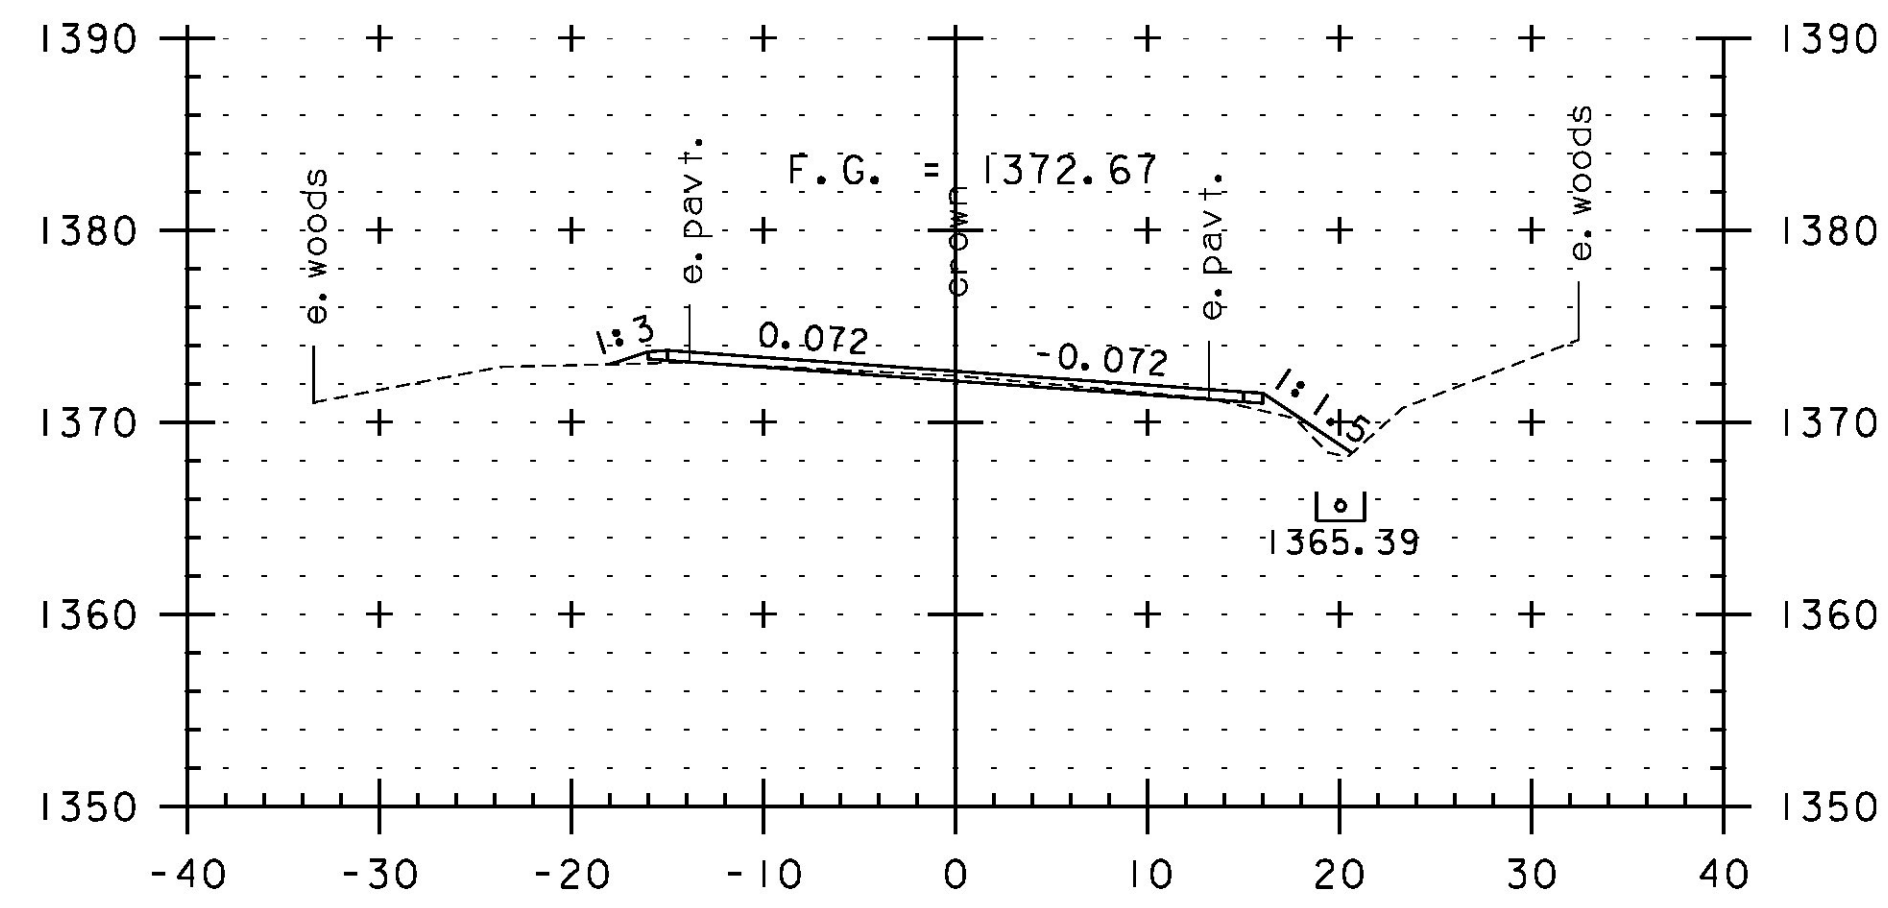


69+50

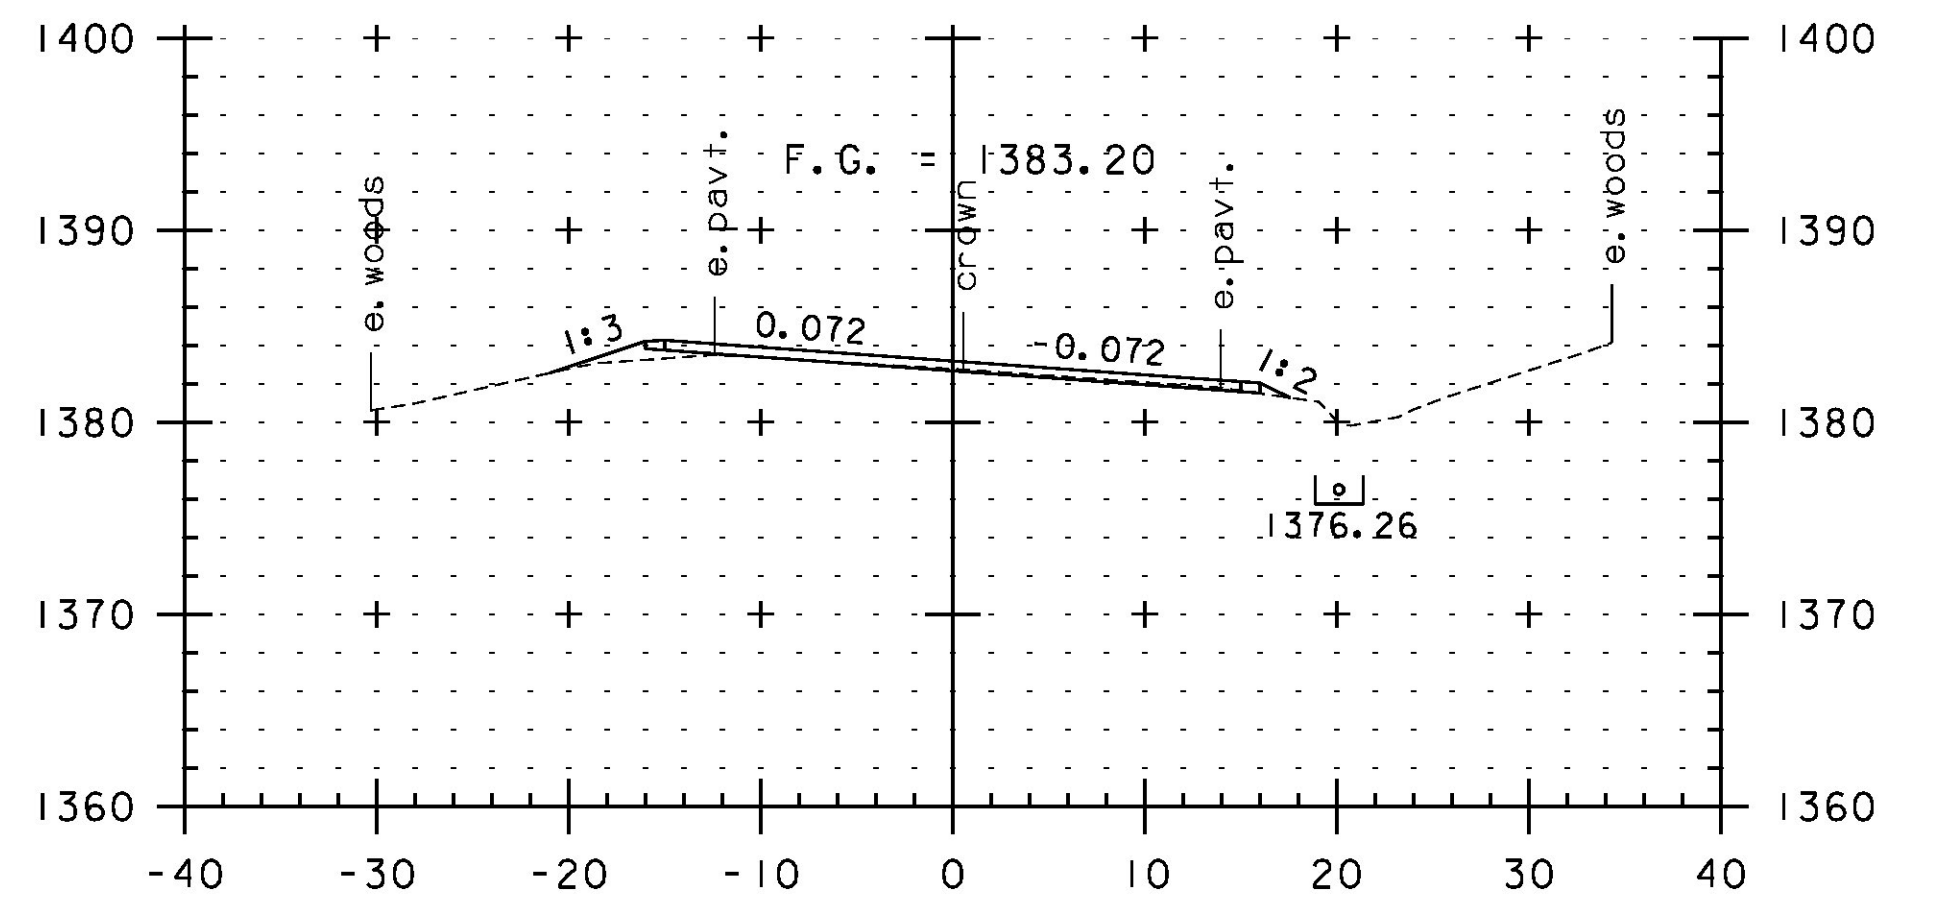


71+00

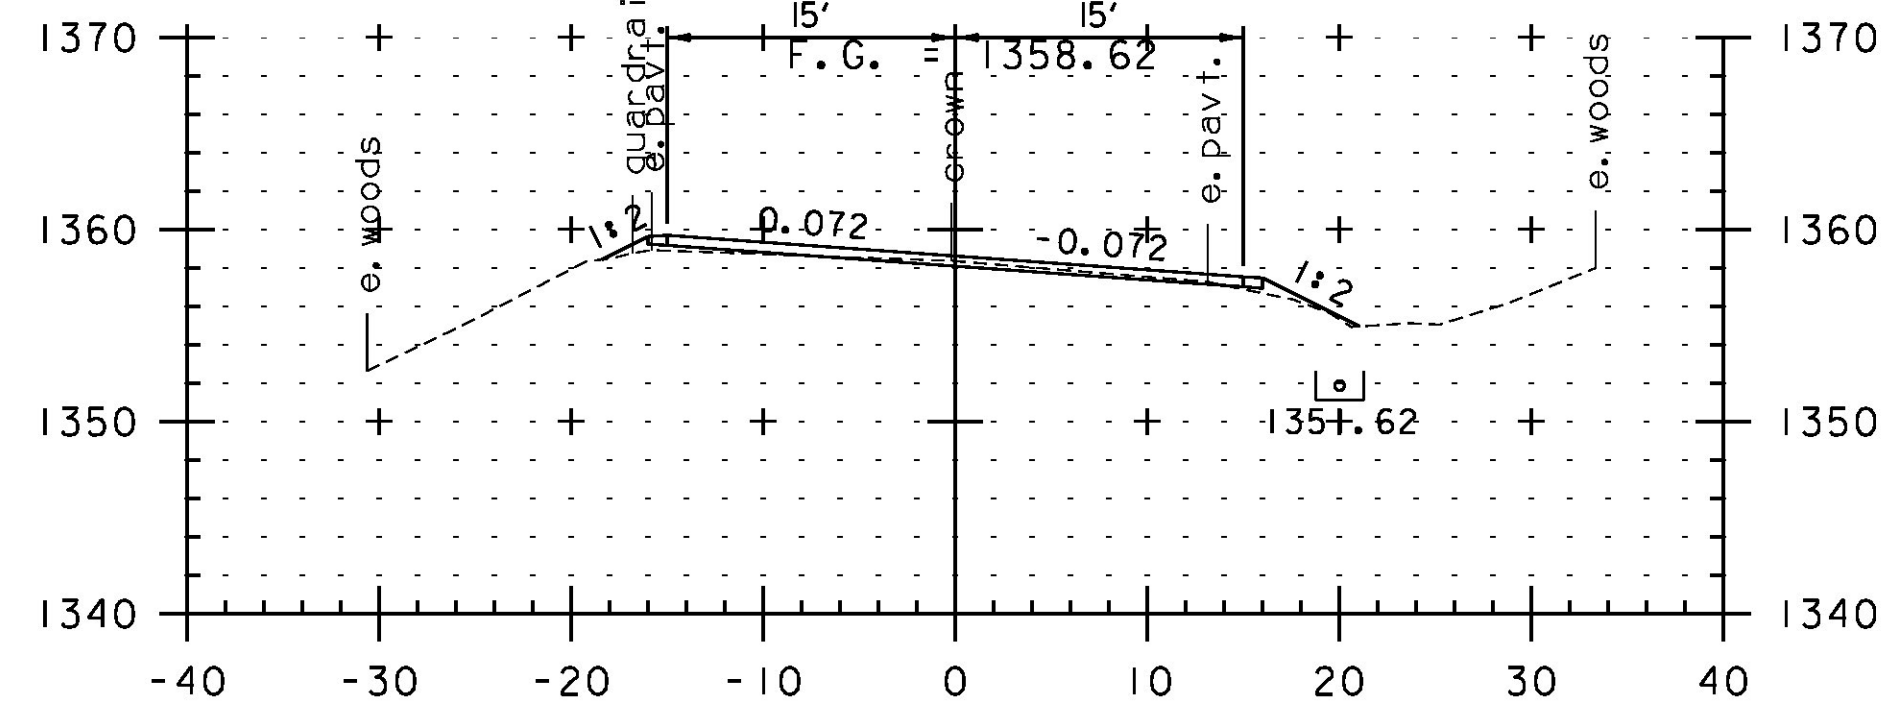

67+50

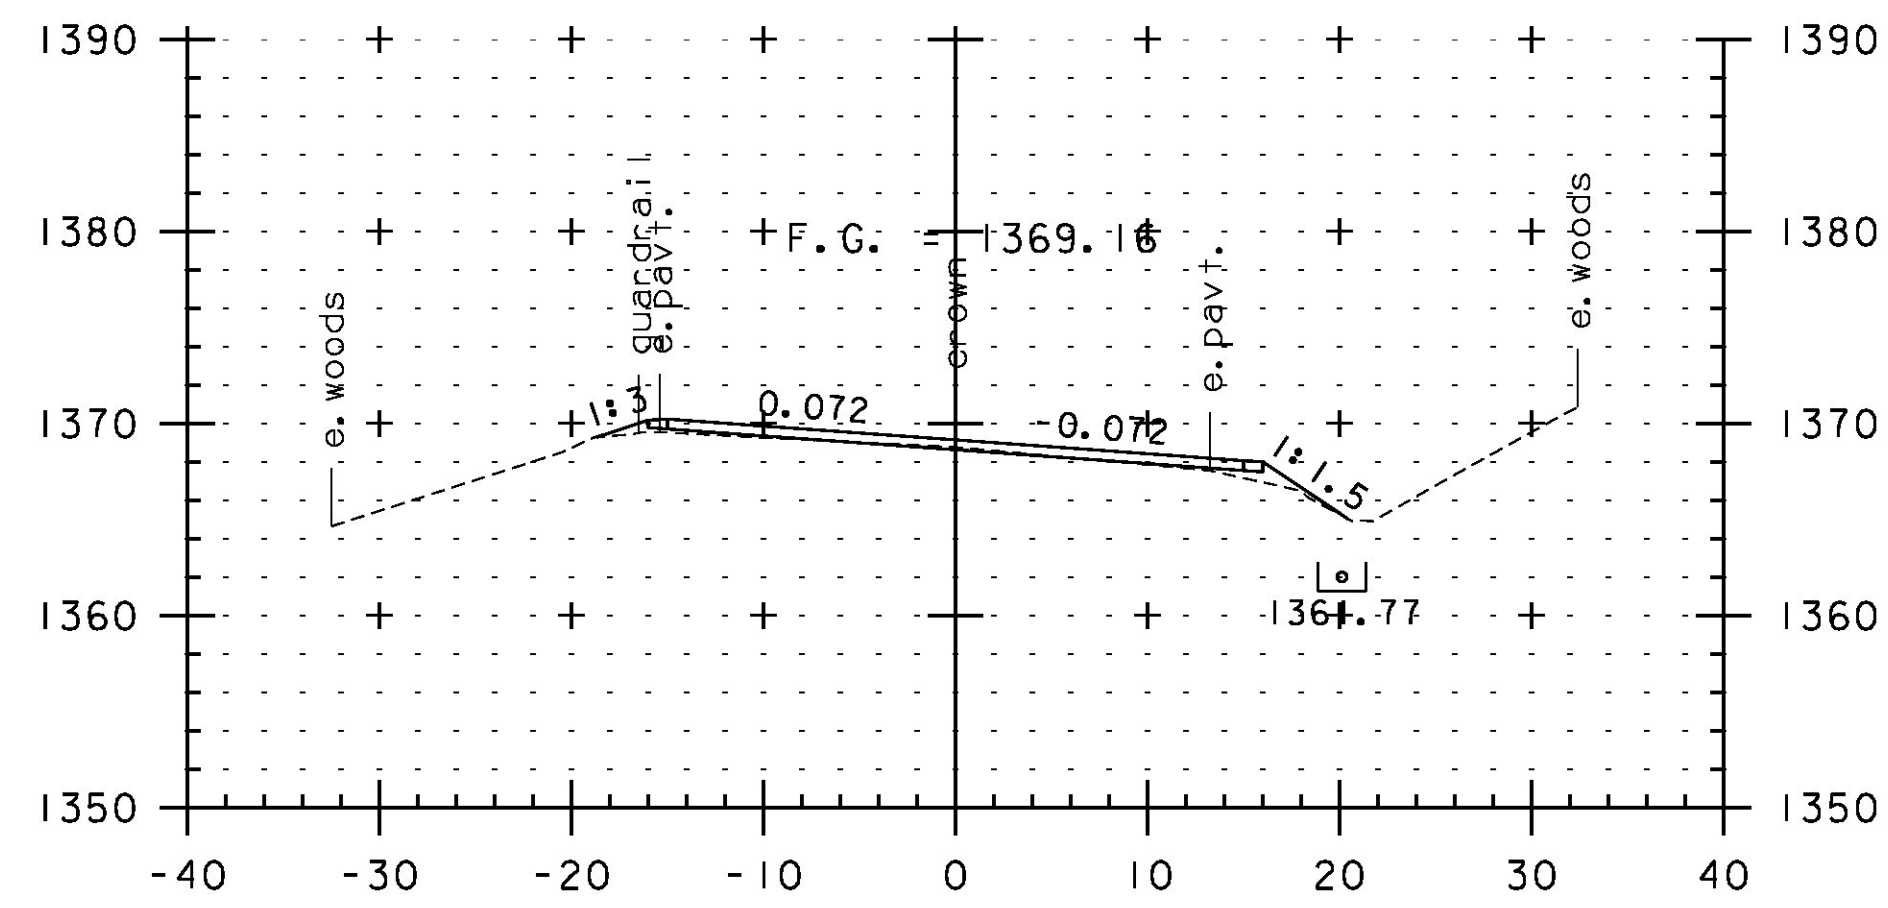

69+00

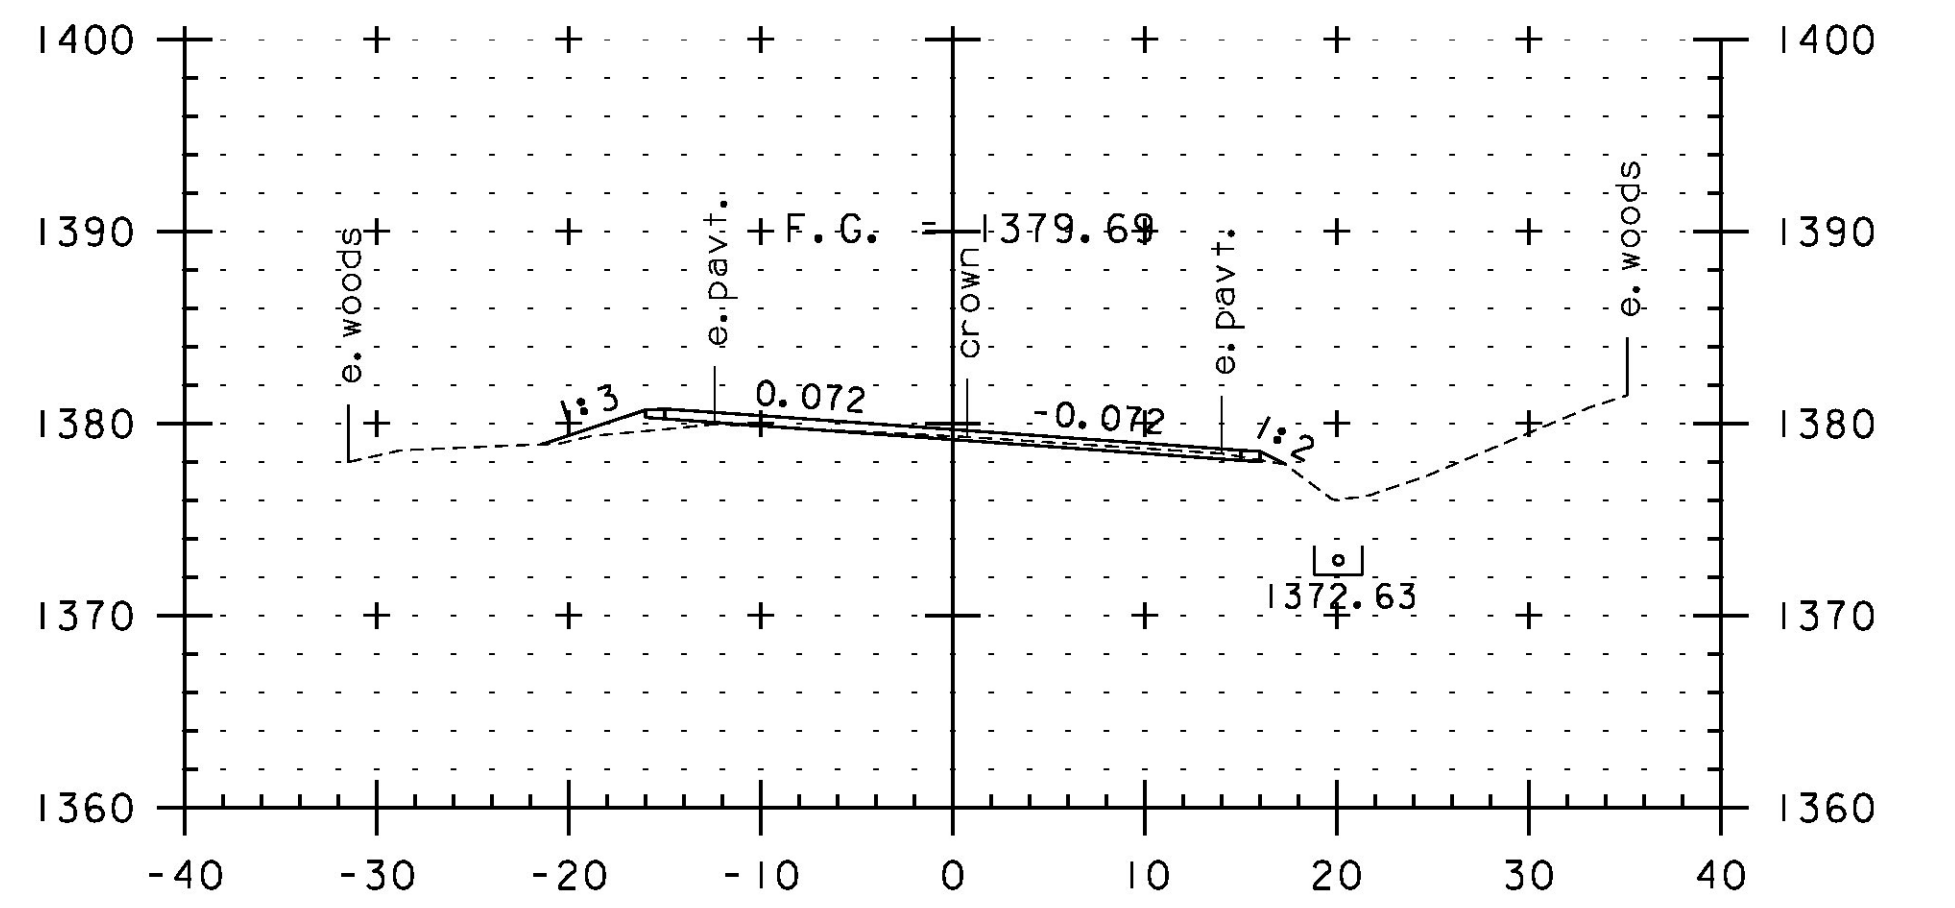

70+50



SCALE IN FEET

STA. 67+50 TO STA. 71+50

PROJECT NAME:	JAY-TROY	FILE NAME:	z10b232xs.dgn	PLOT DATE:	5/16/2014
PROJECT NUMBER:	STP 2315(I)	PROJECT LEADER:	P. SHEDD	DRAWN BY:	W. GORDON
		DESIGNED BY:	N. LEMAY	CHECKED BY:	P. SHEDD
		CROSS SECTION SHEET 8		SHEET	144 OF 244