




73+00

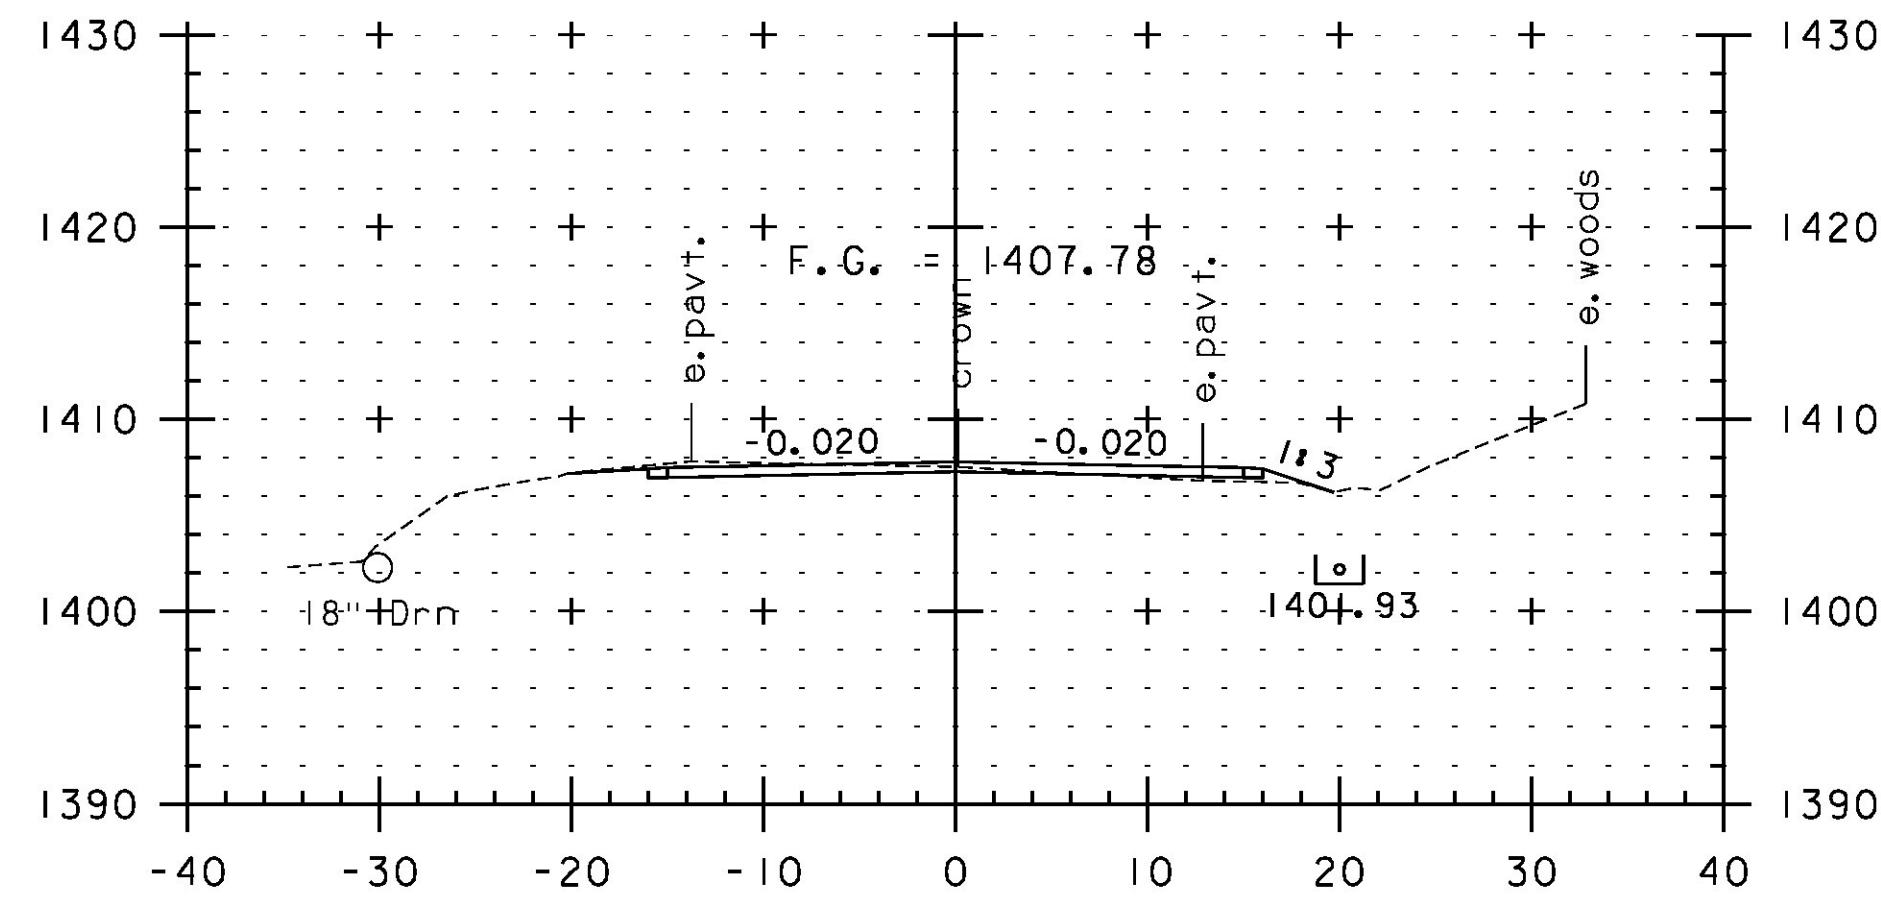


74+50

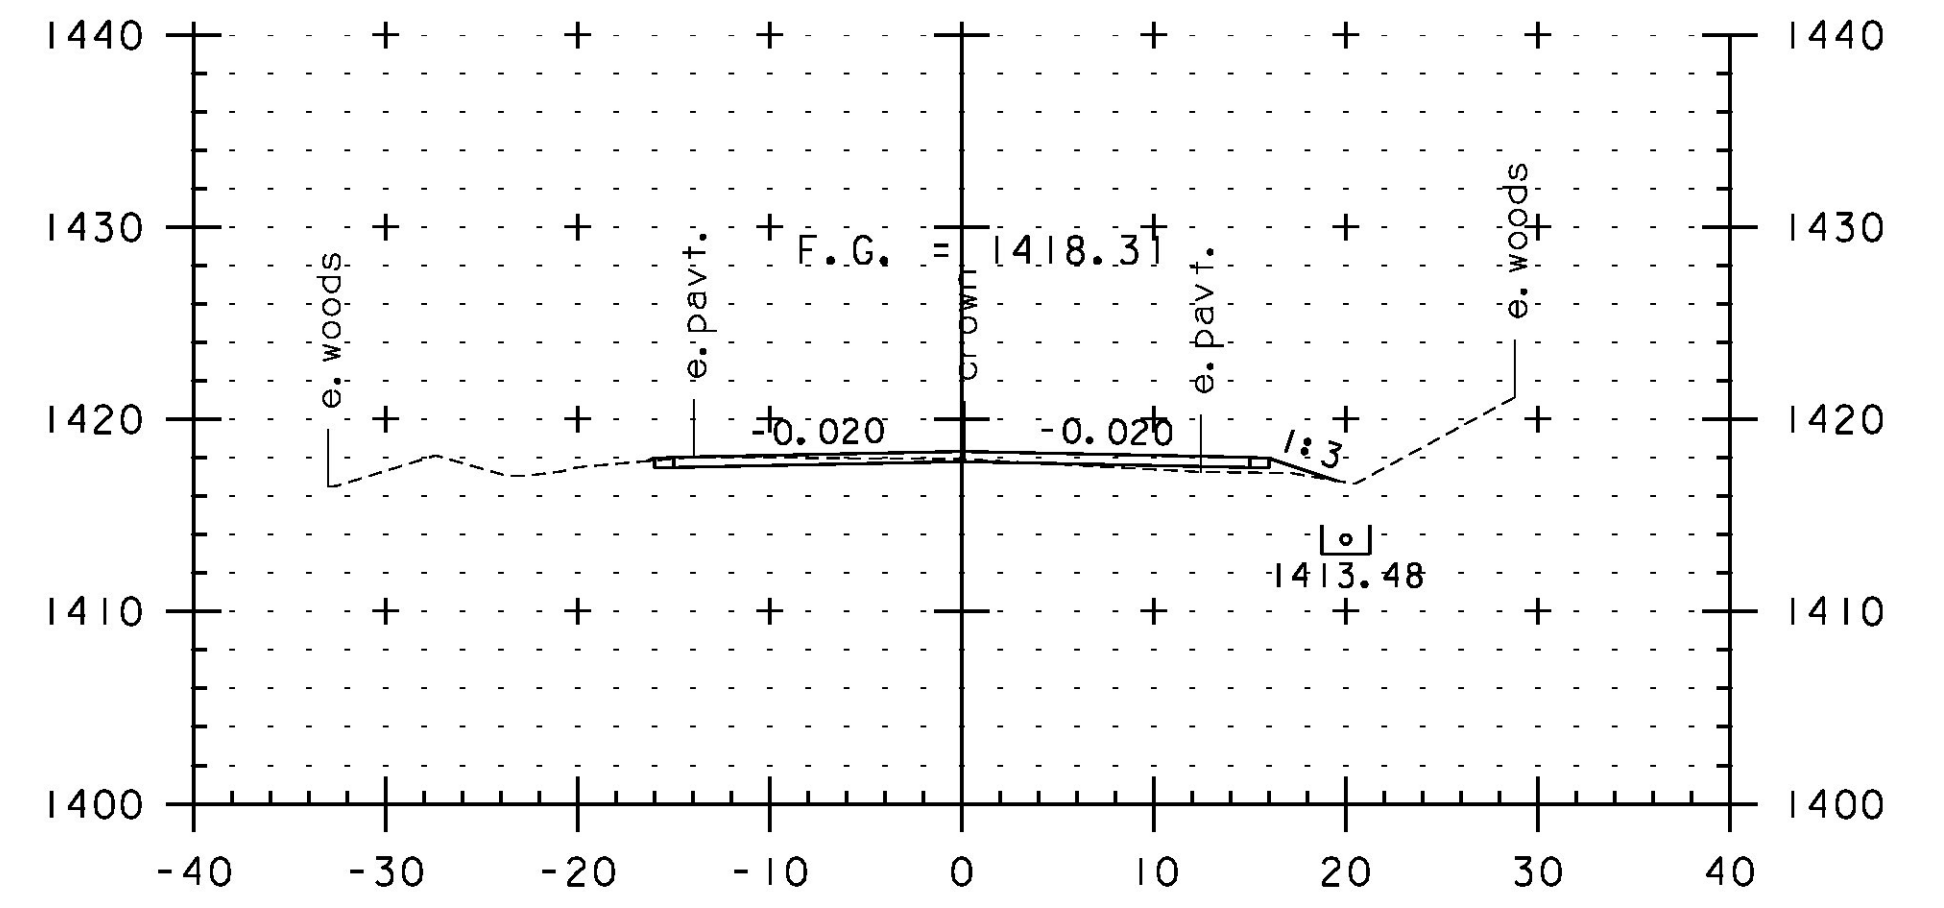


76+00

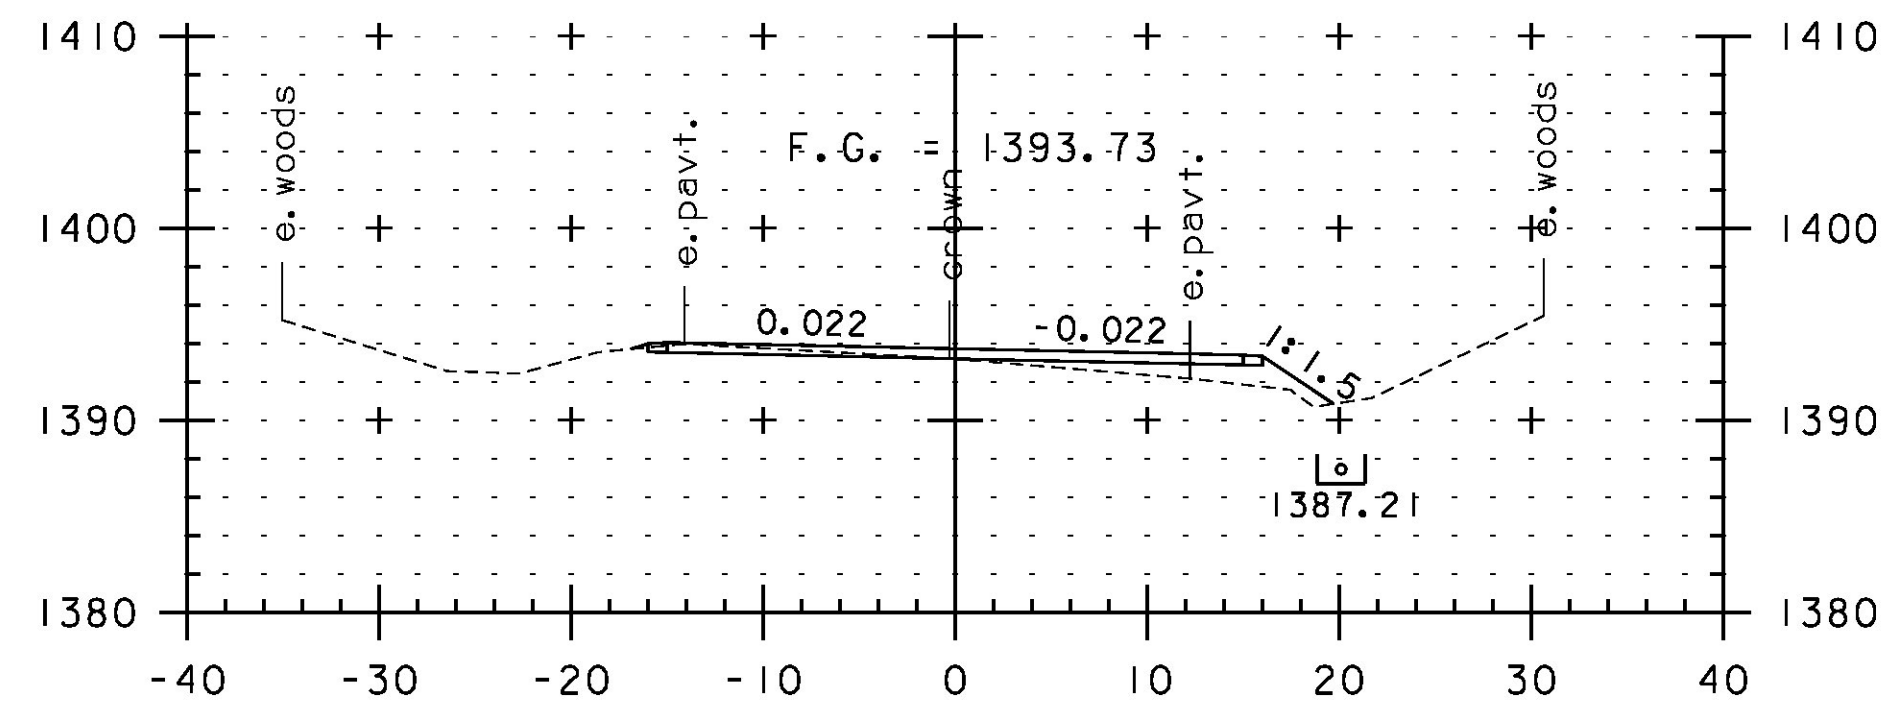


72+50

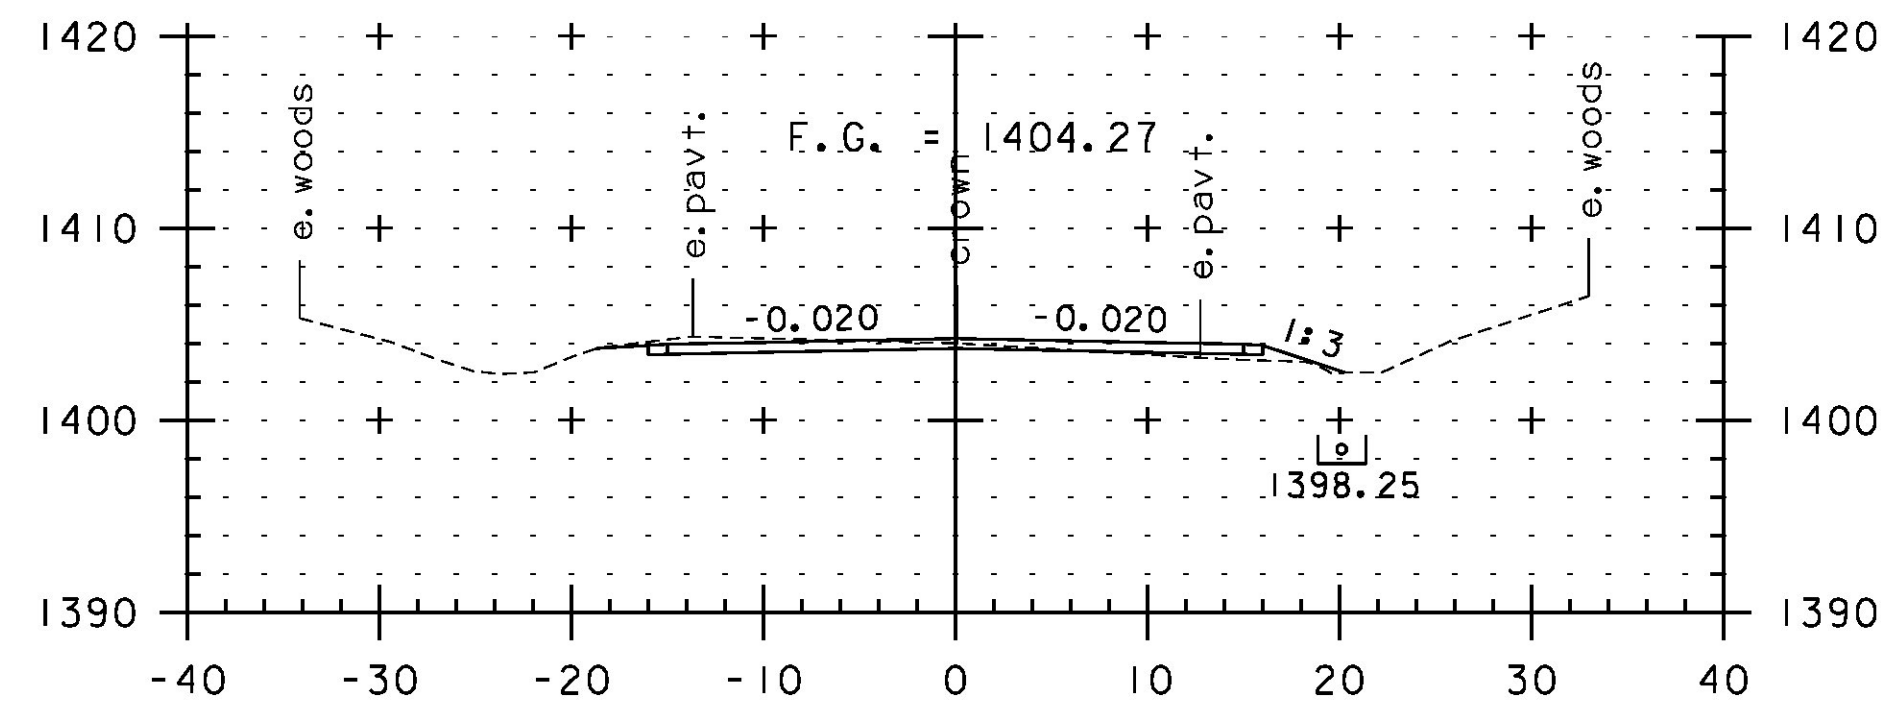


74+00

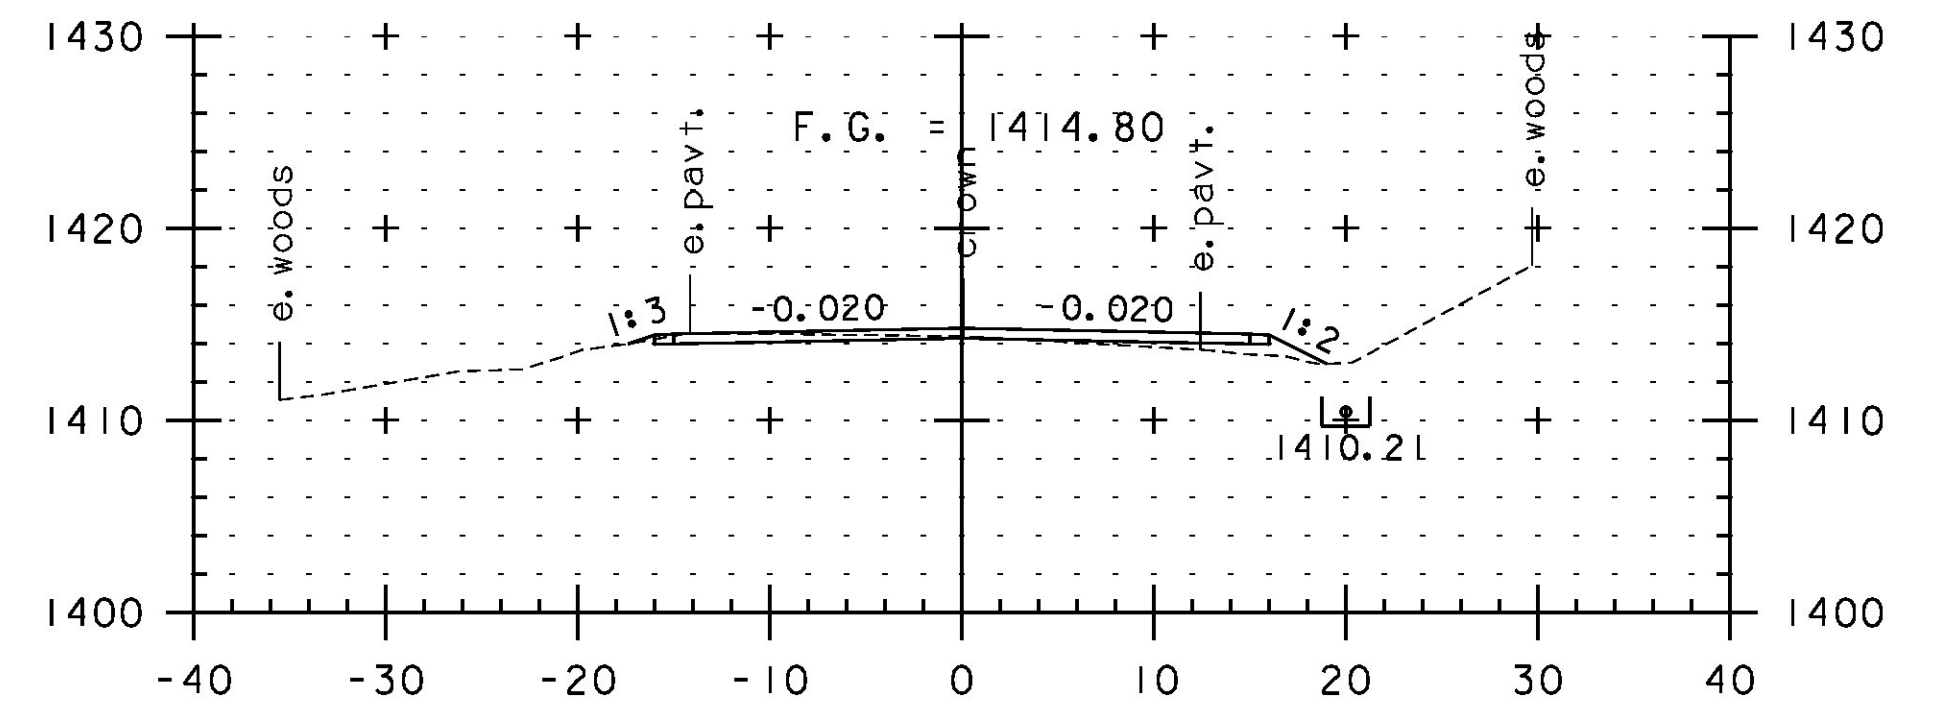


75+50

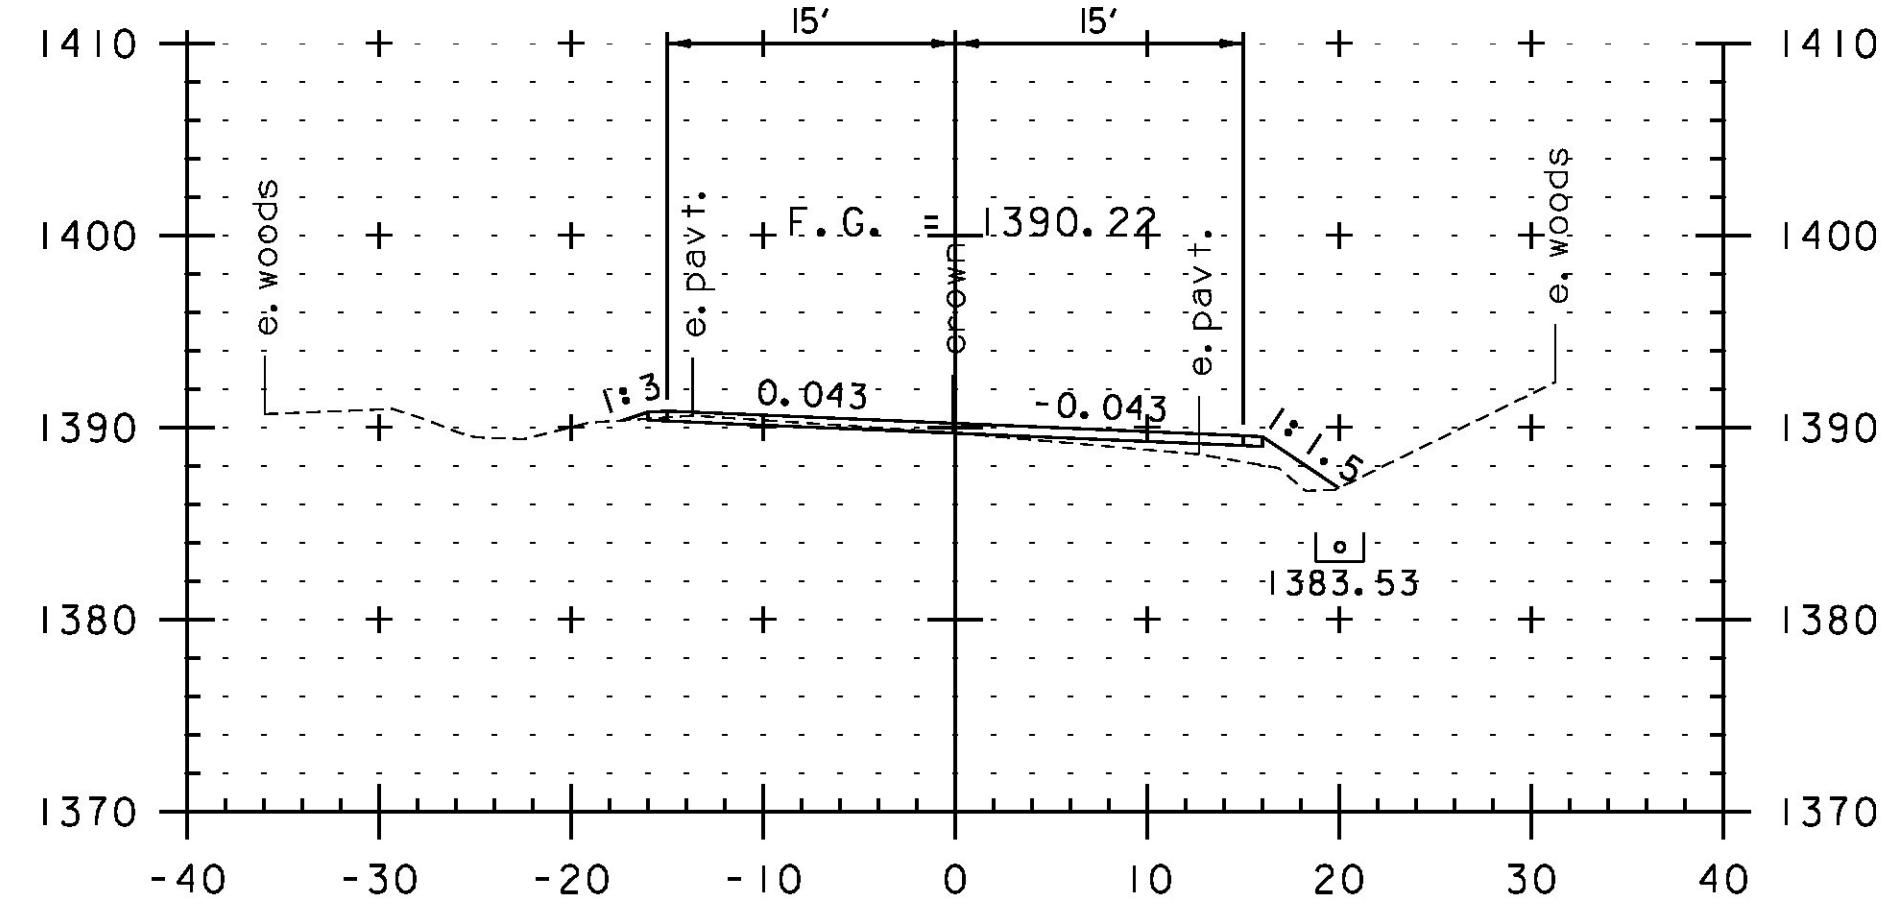

72+00

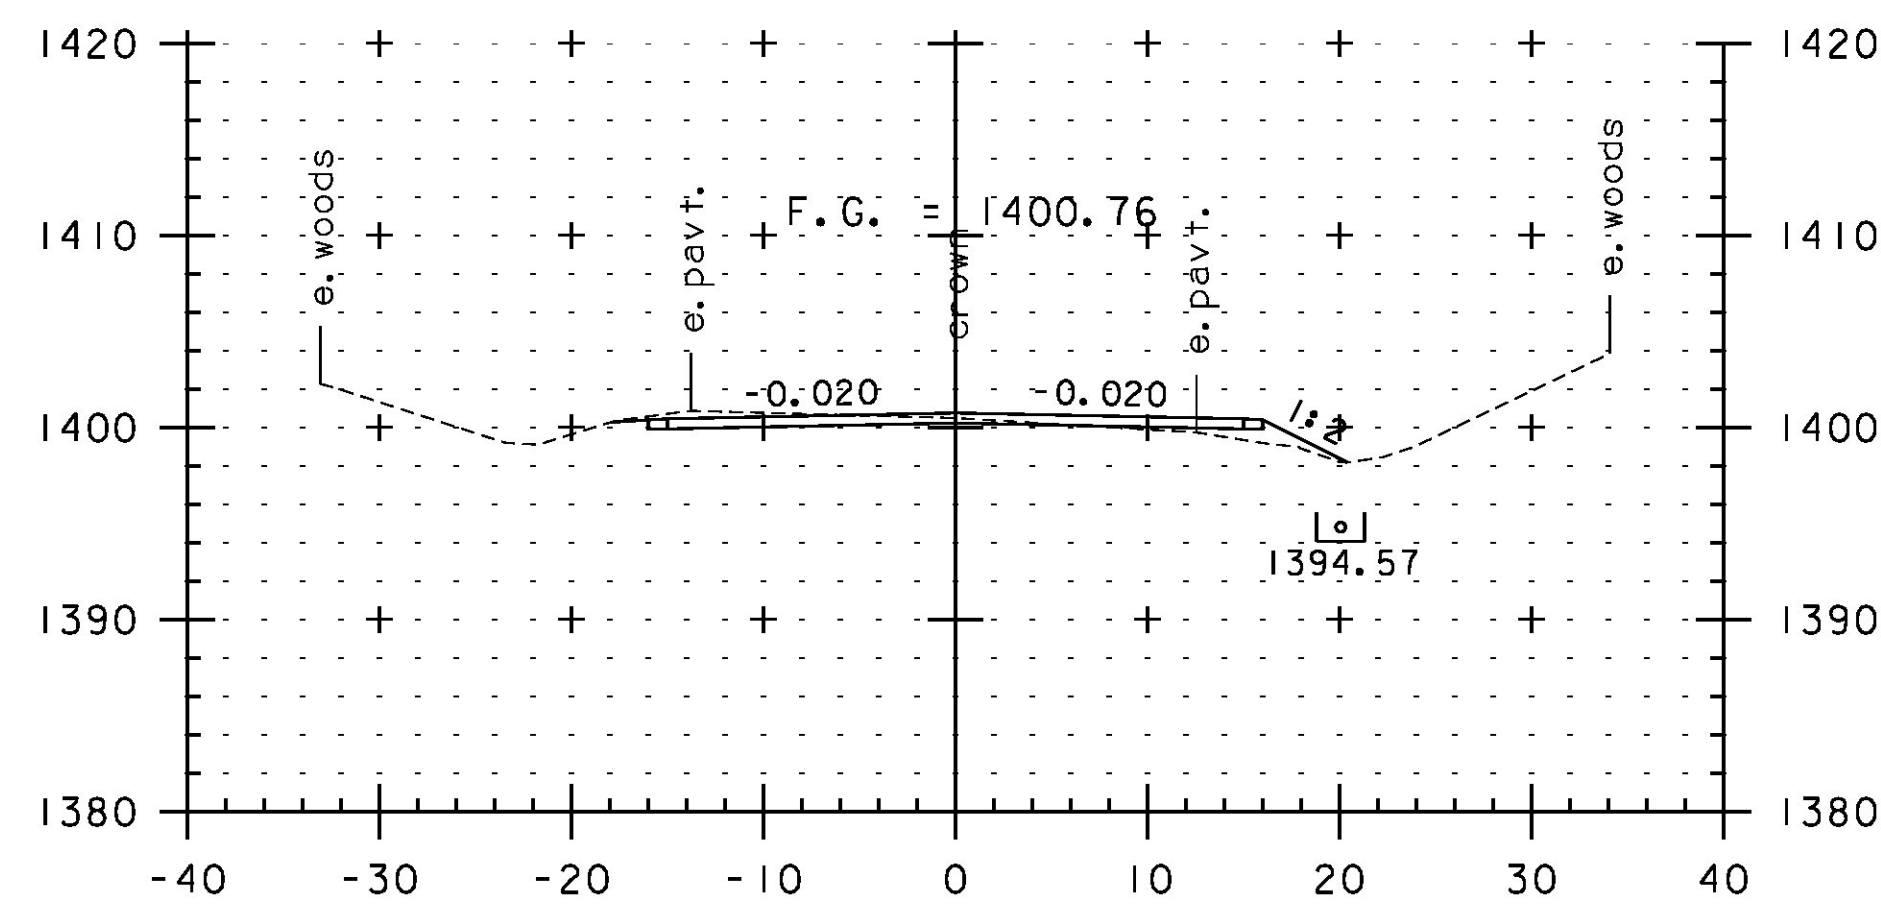

73+50

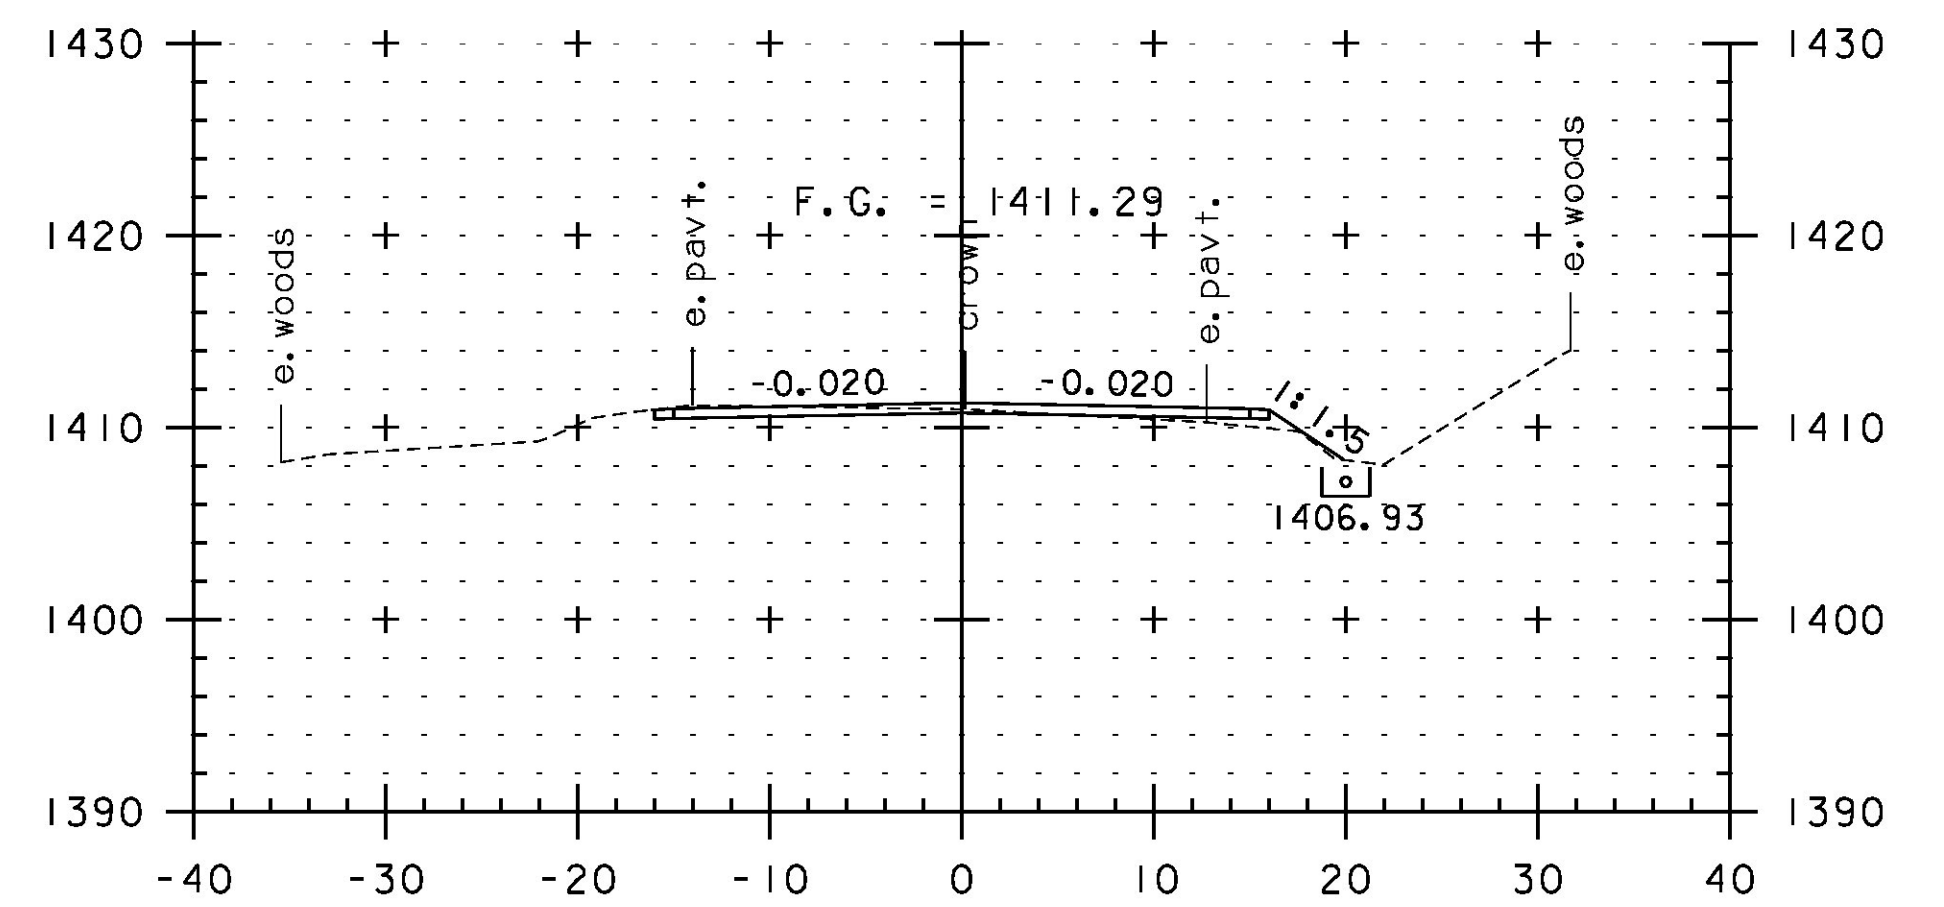

75+00



STA. 72+00 TO STA. 76+00

PROJECT NAME: JAY-TROY  
PROJECT NUMBER: STP 2315(1)

FILE NAME: z10b232xs.dgn  
PROJECT LEADER: P. SHEDD  
DESIGNED BY: N. LEMAY  
CROSS SECTION SHEET 9

PLOT DATE: 5/16/2014  
DRAWN BY: W. GORDON  
CHECKED BY: P. SHEDD  
SHEET 145 OF 244