




77+50

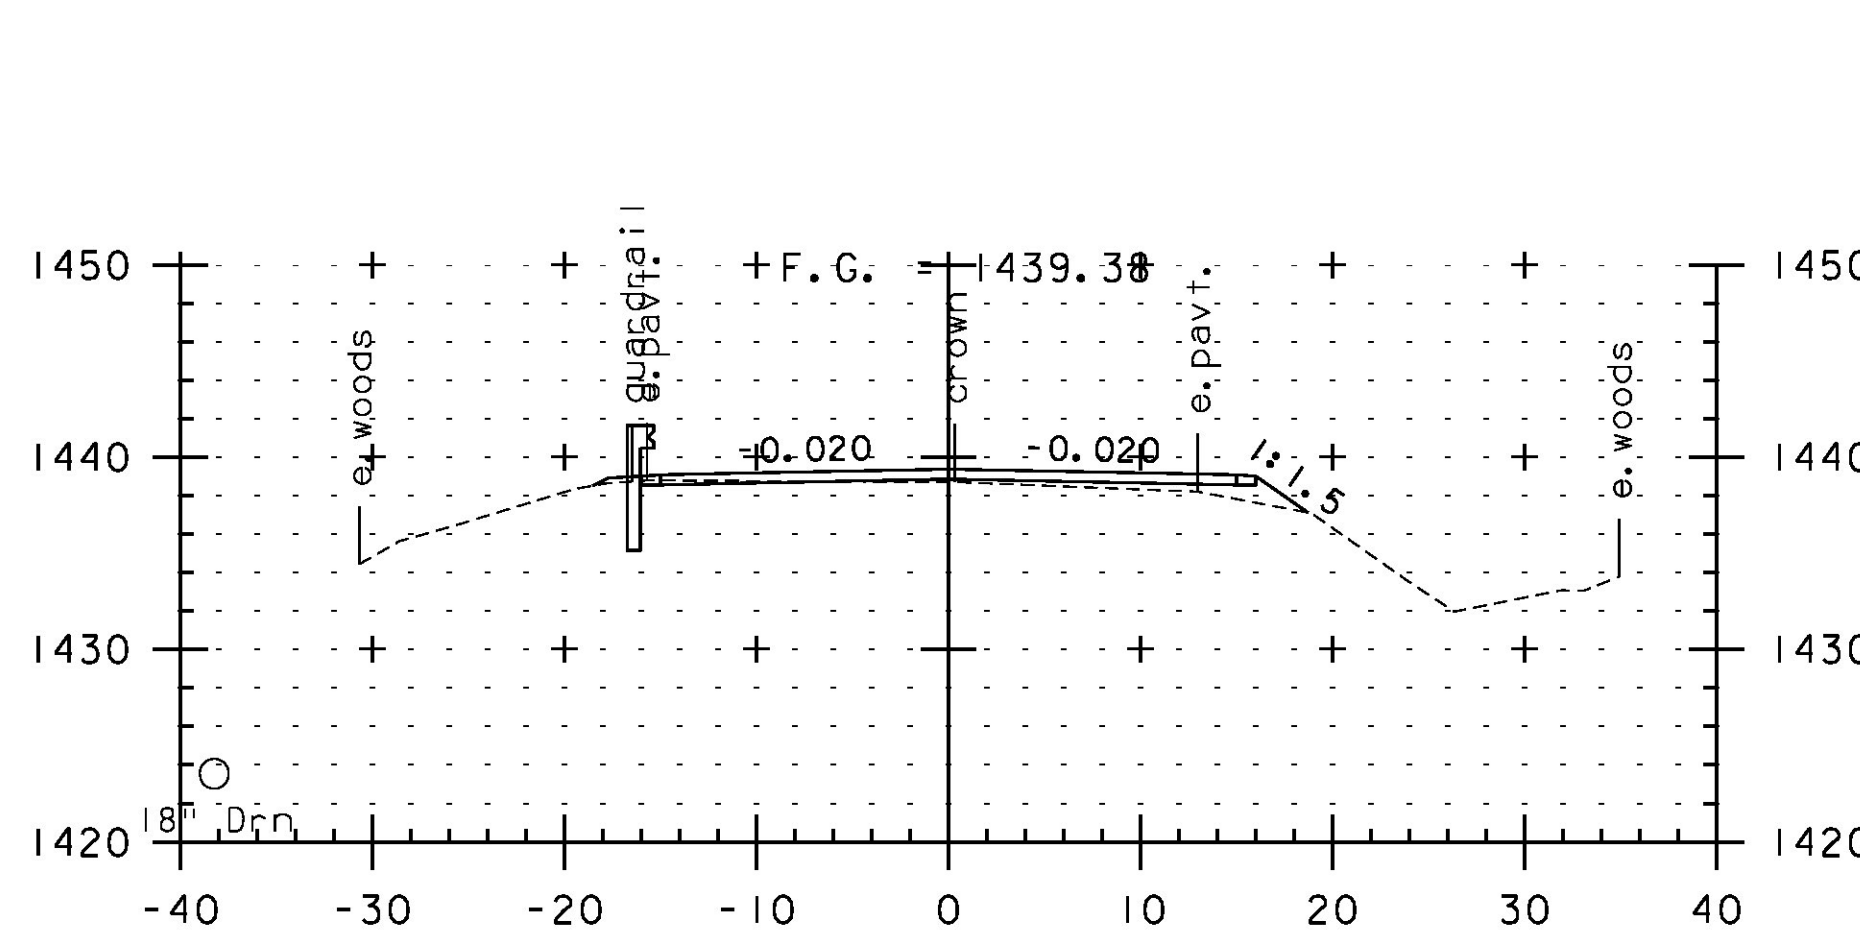


79+00

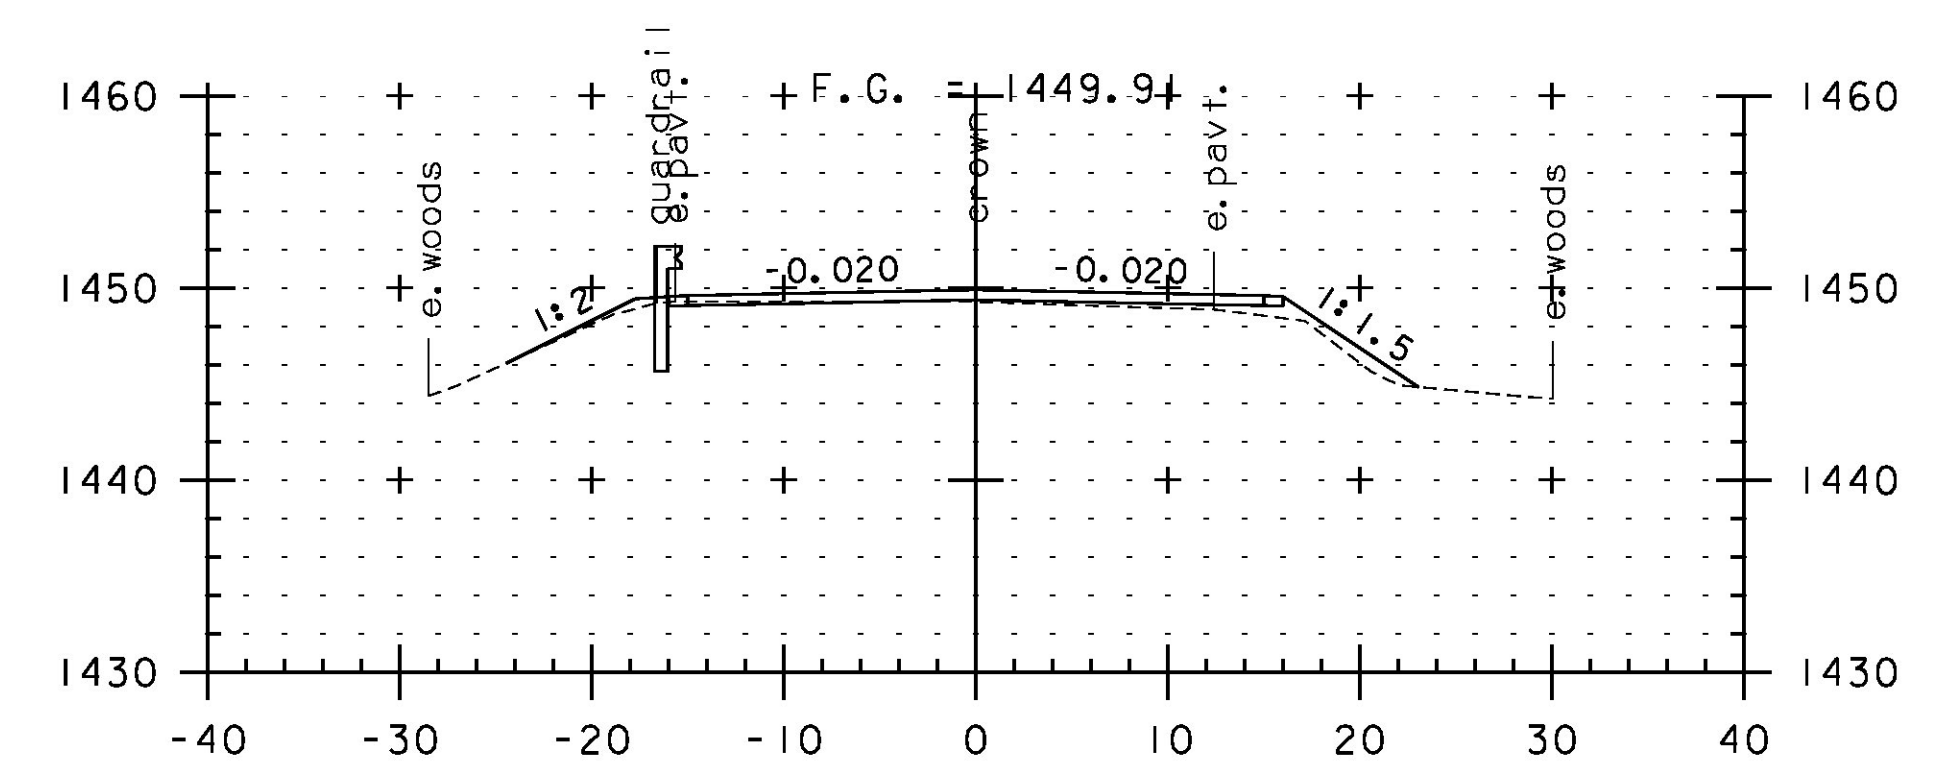


80+50

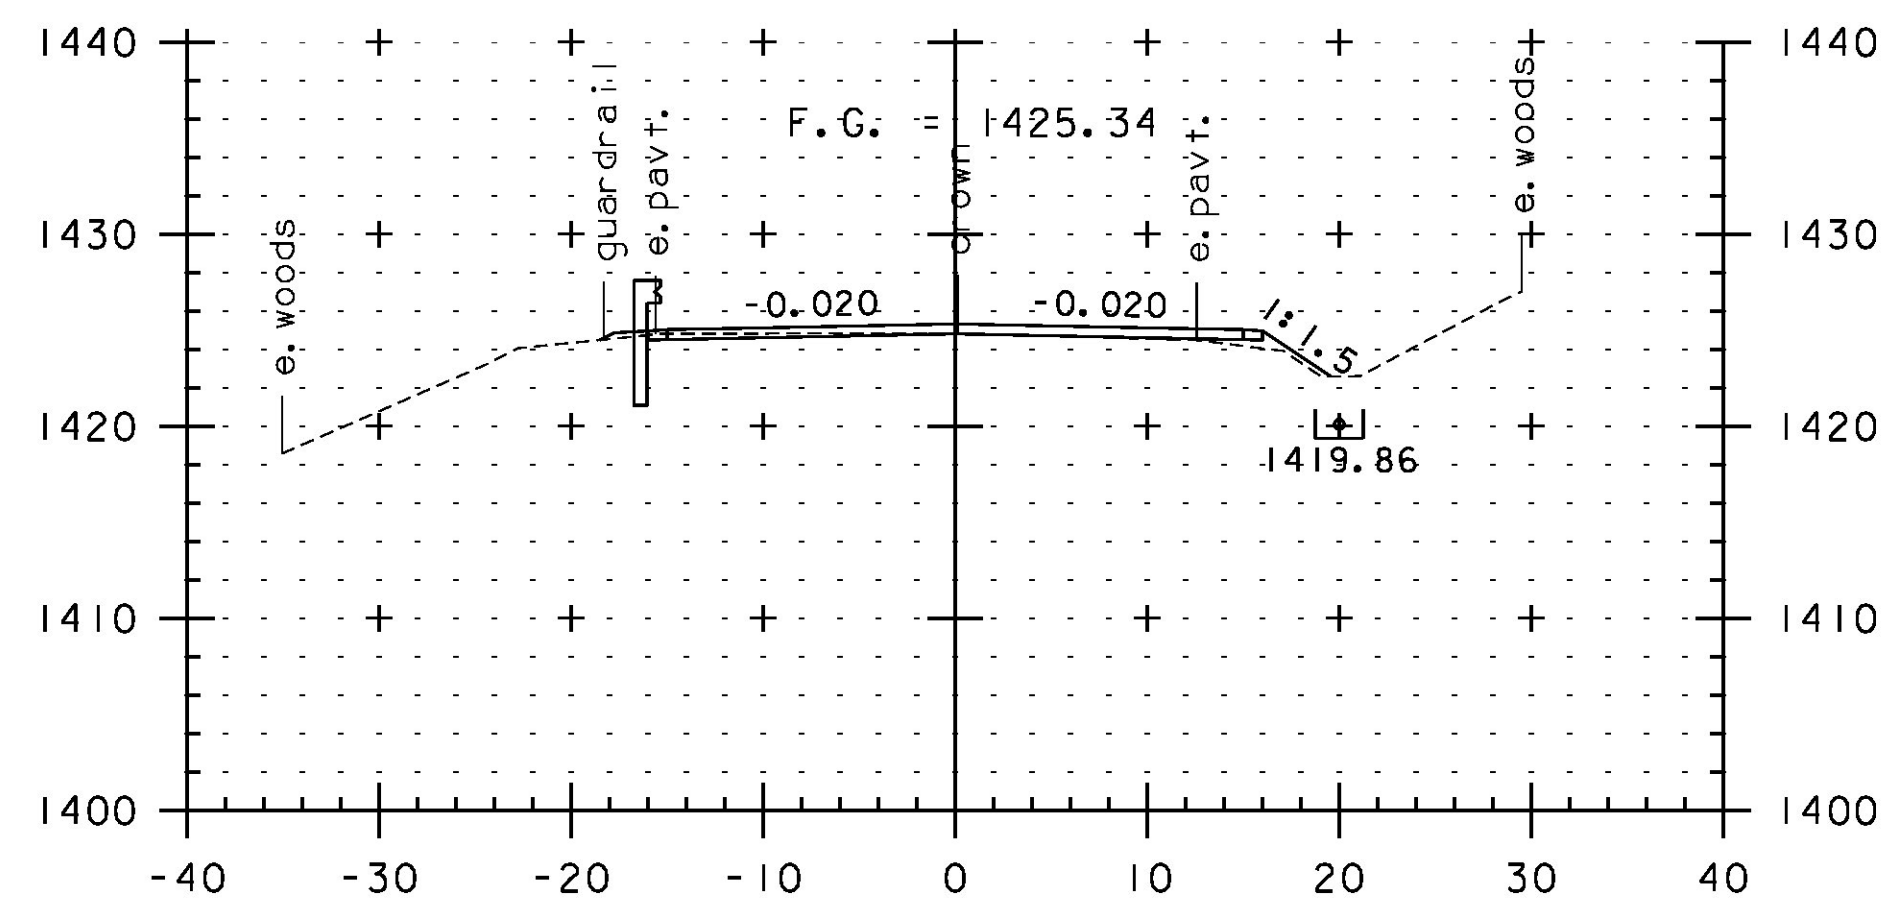


77+00

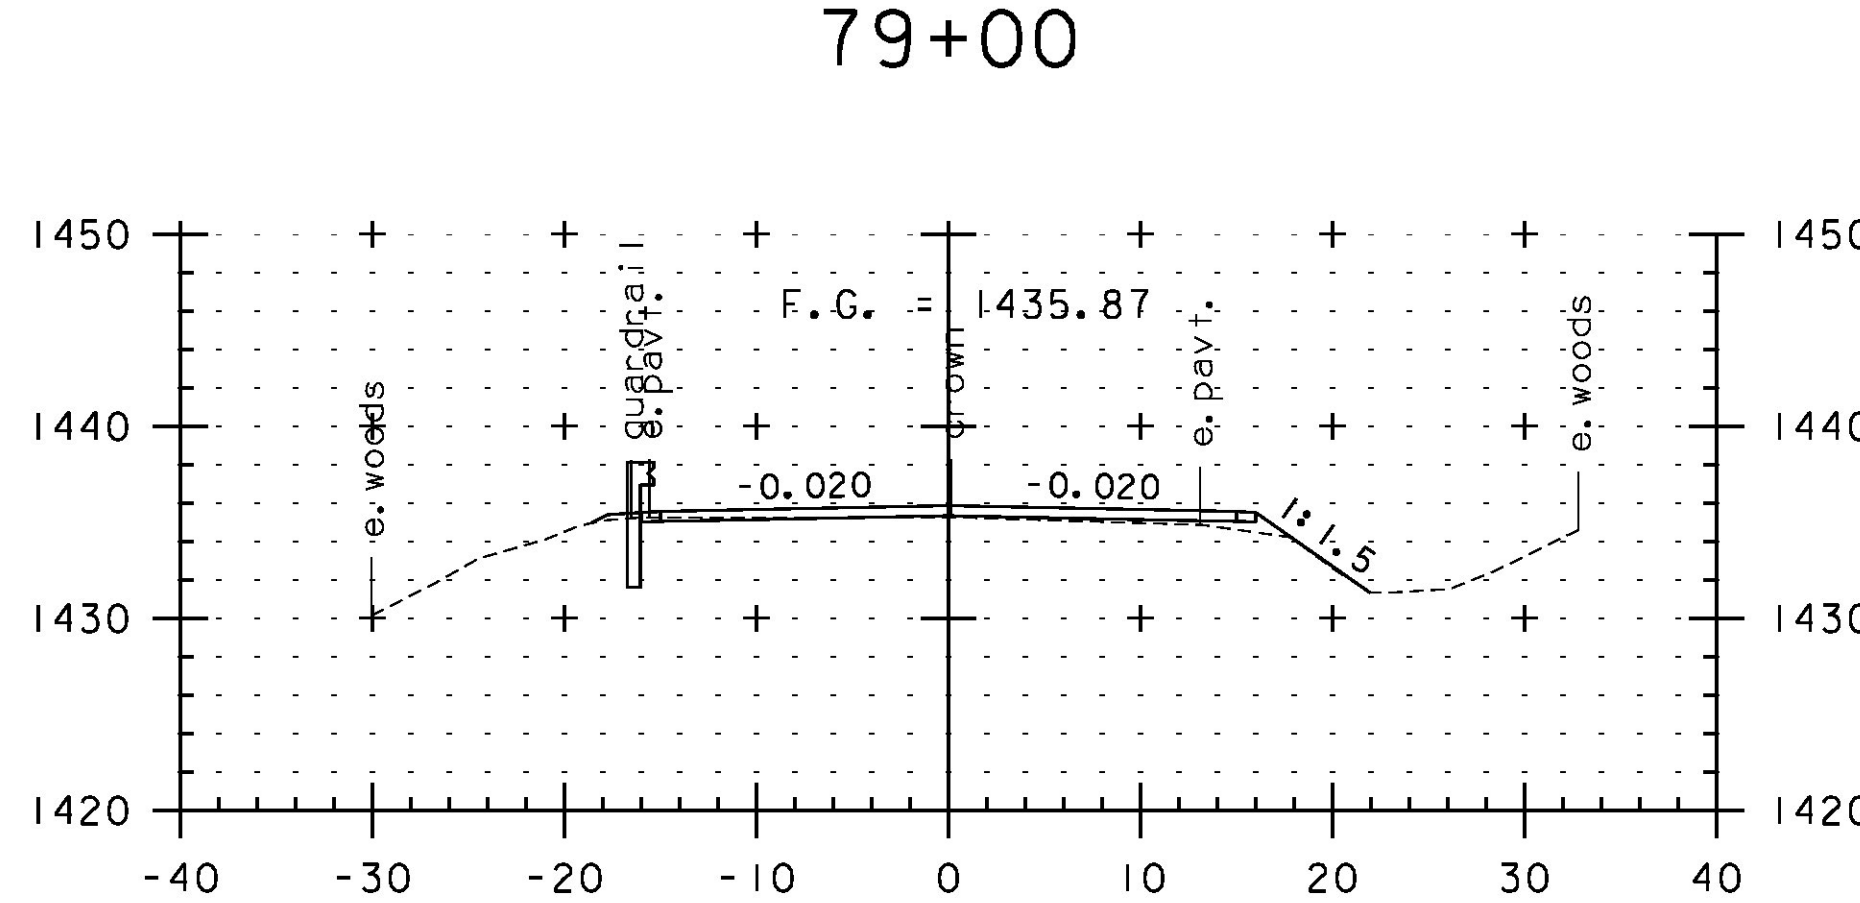


78+50

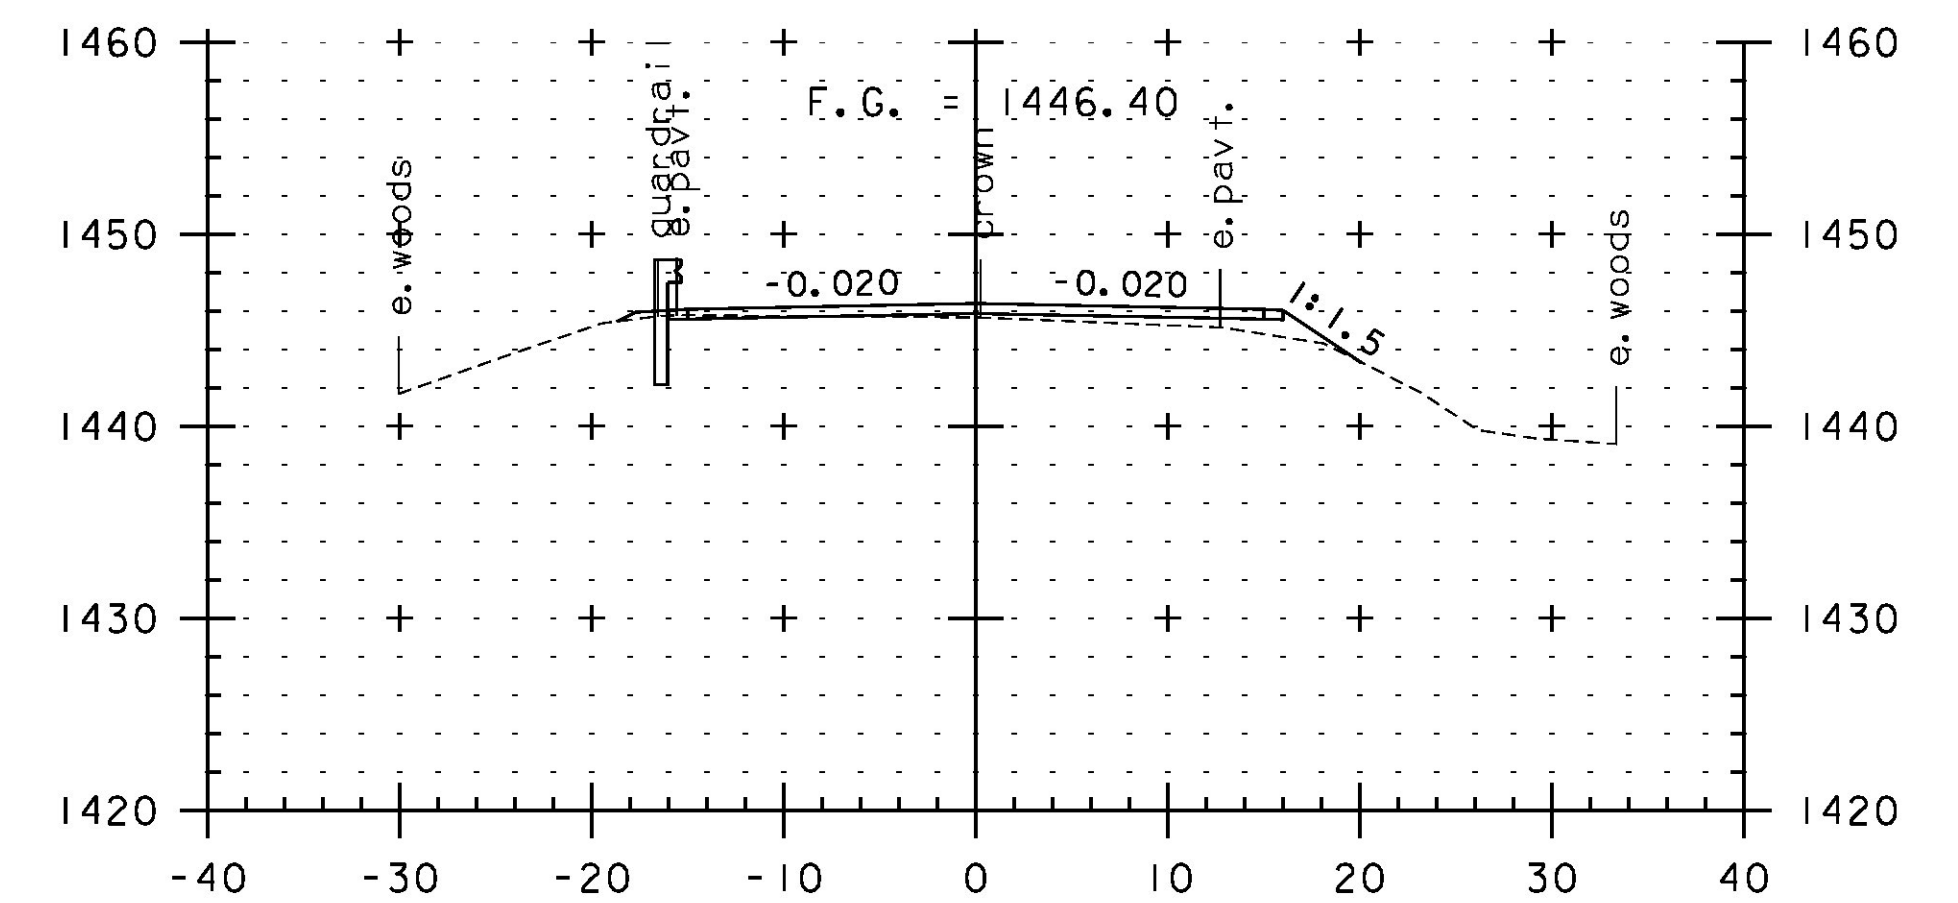


80+00

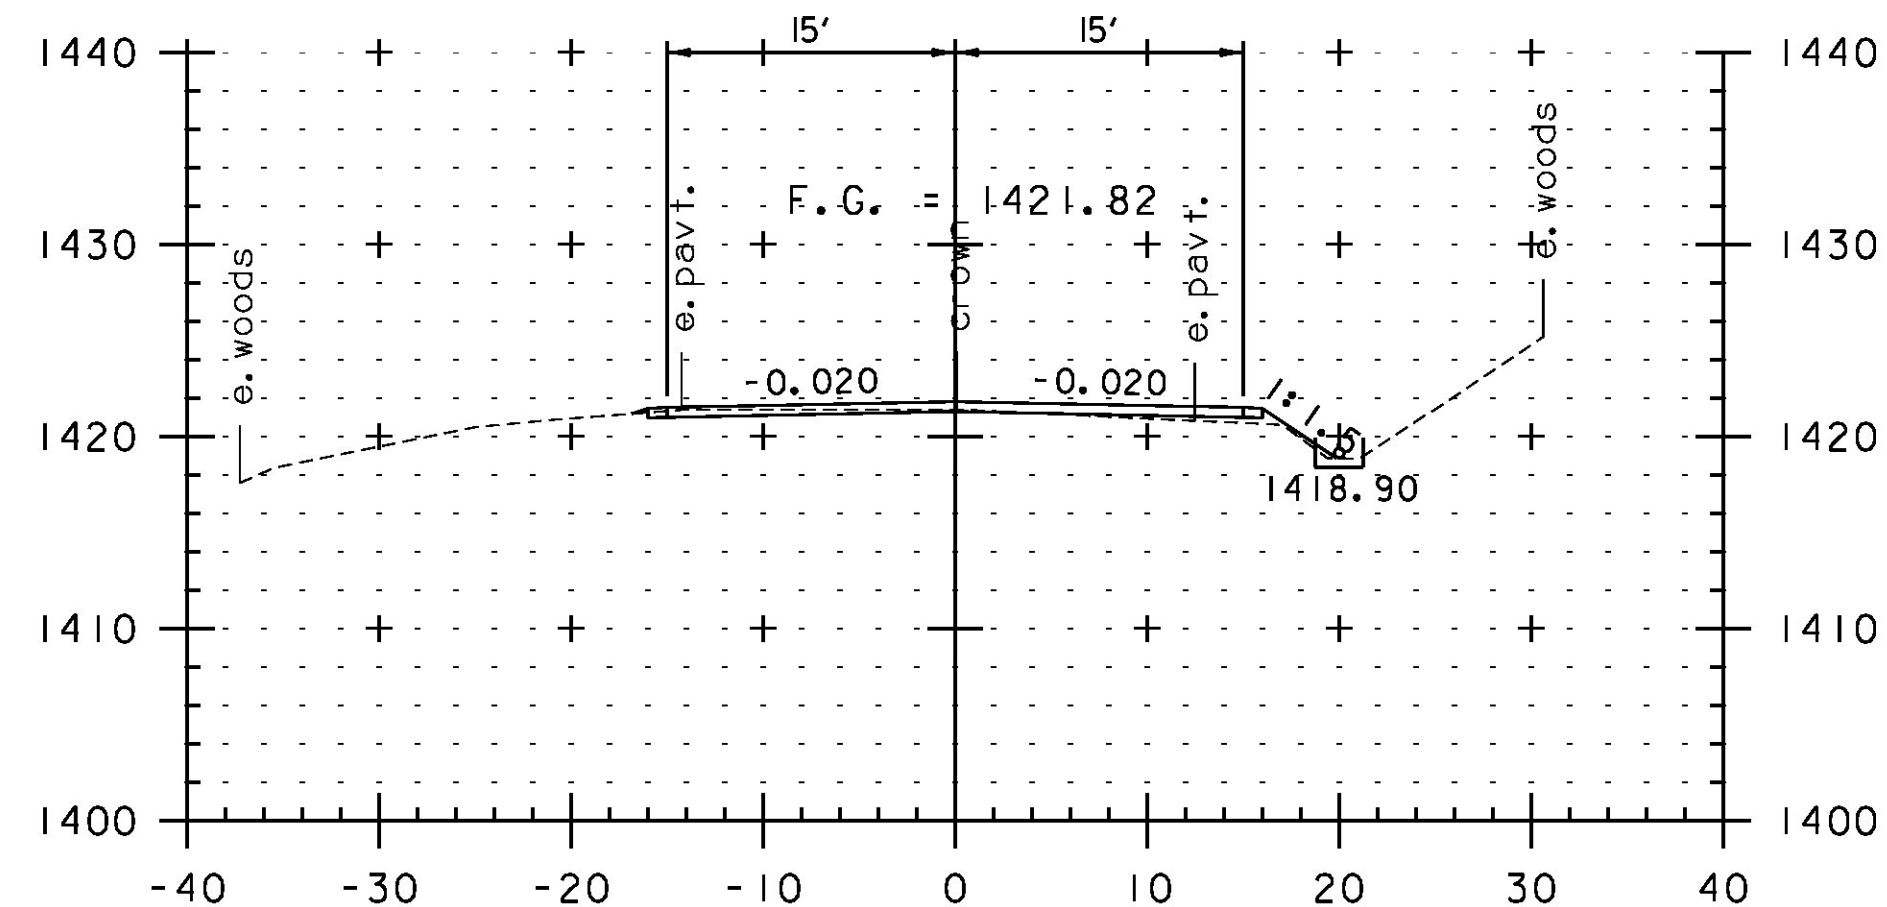


76+50

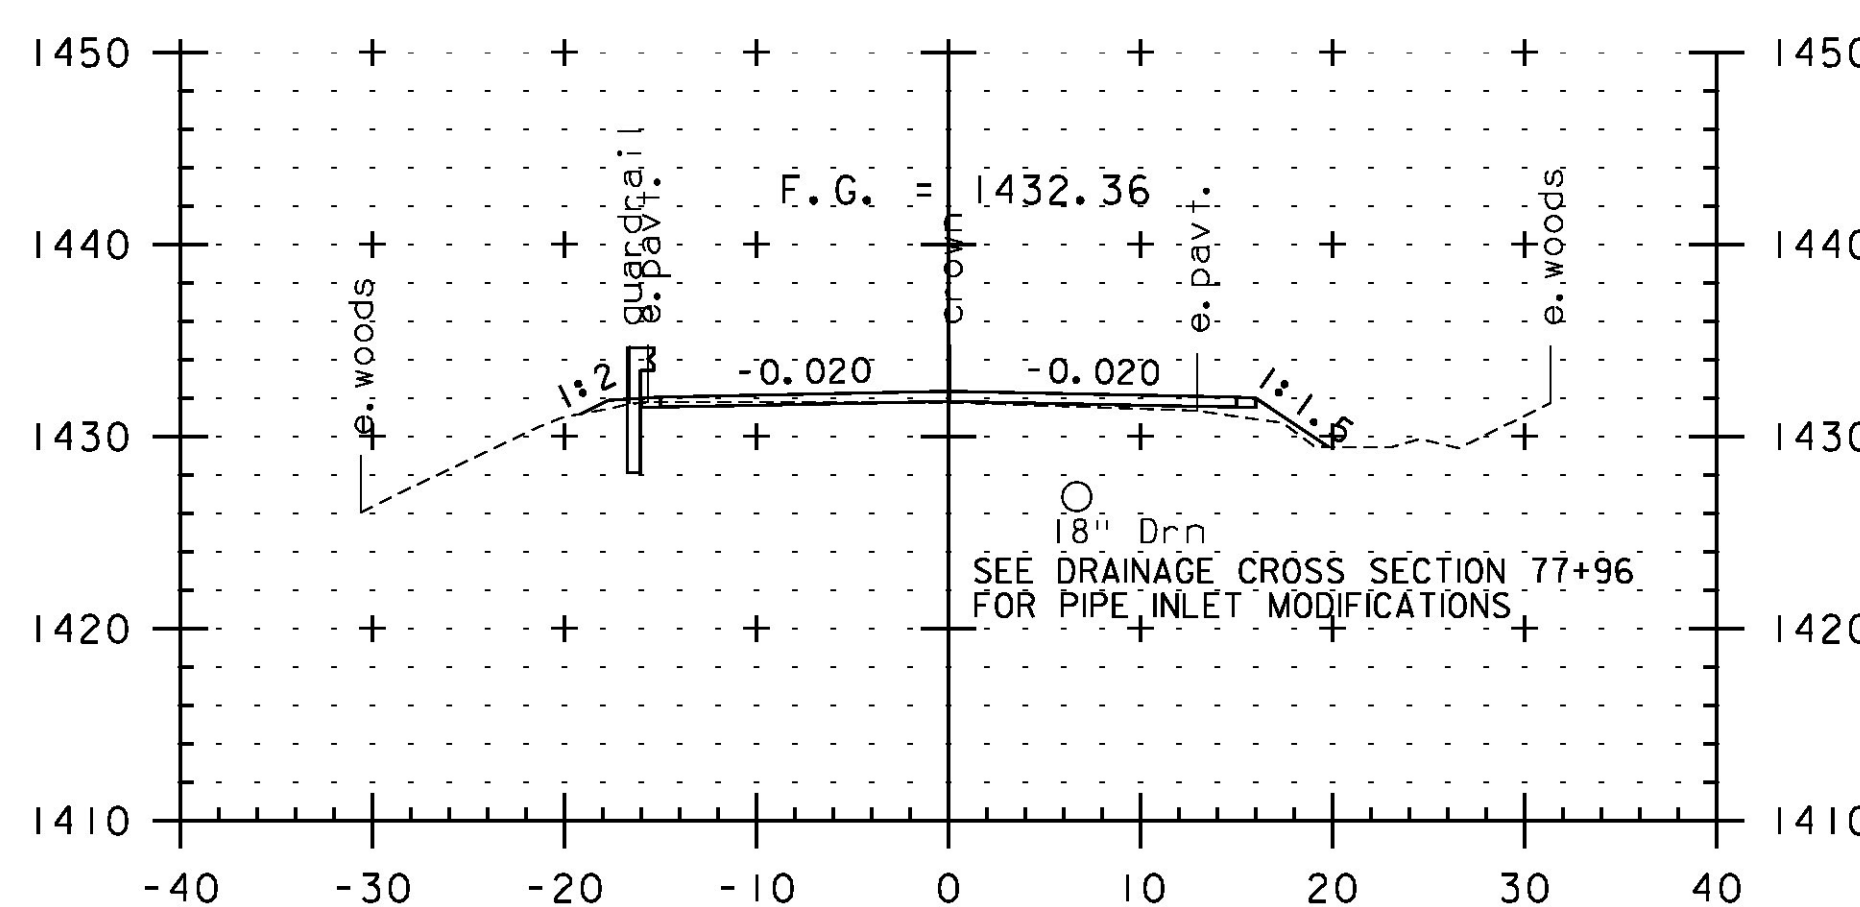

78+00

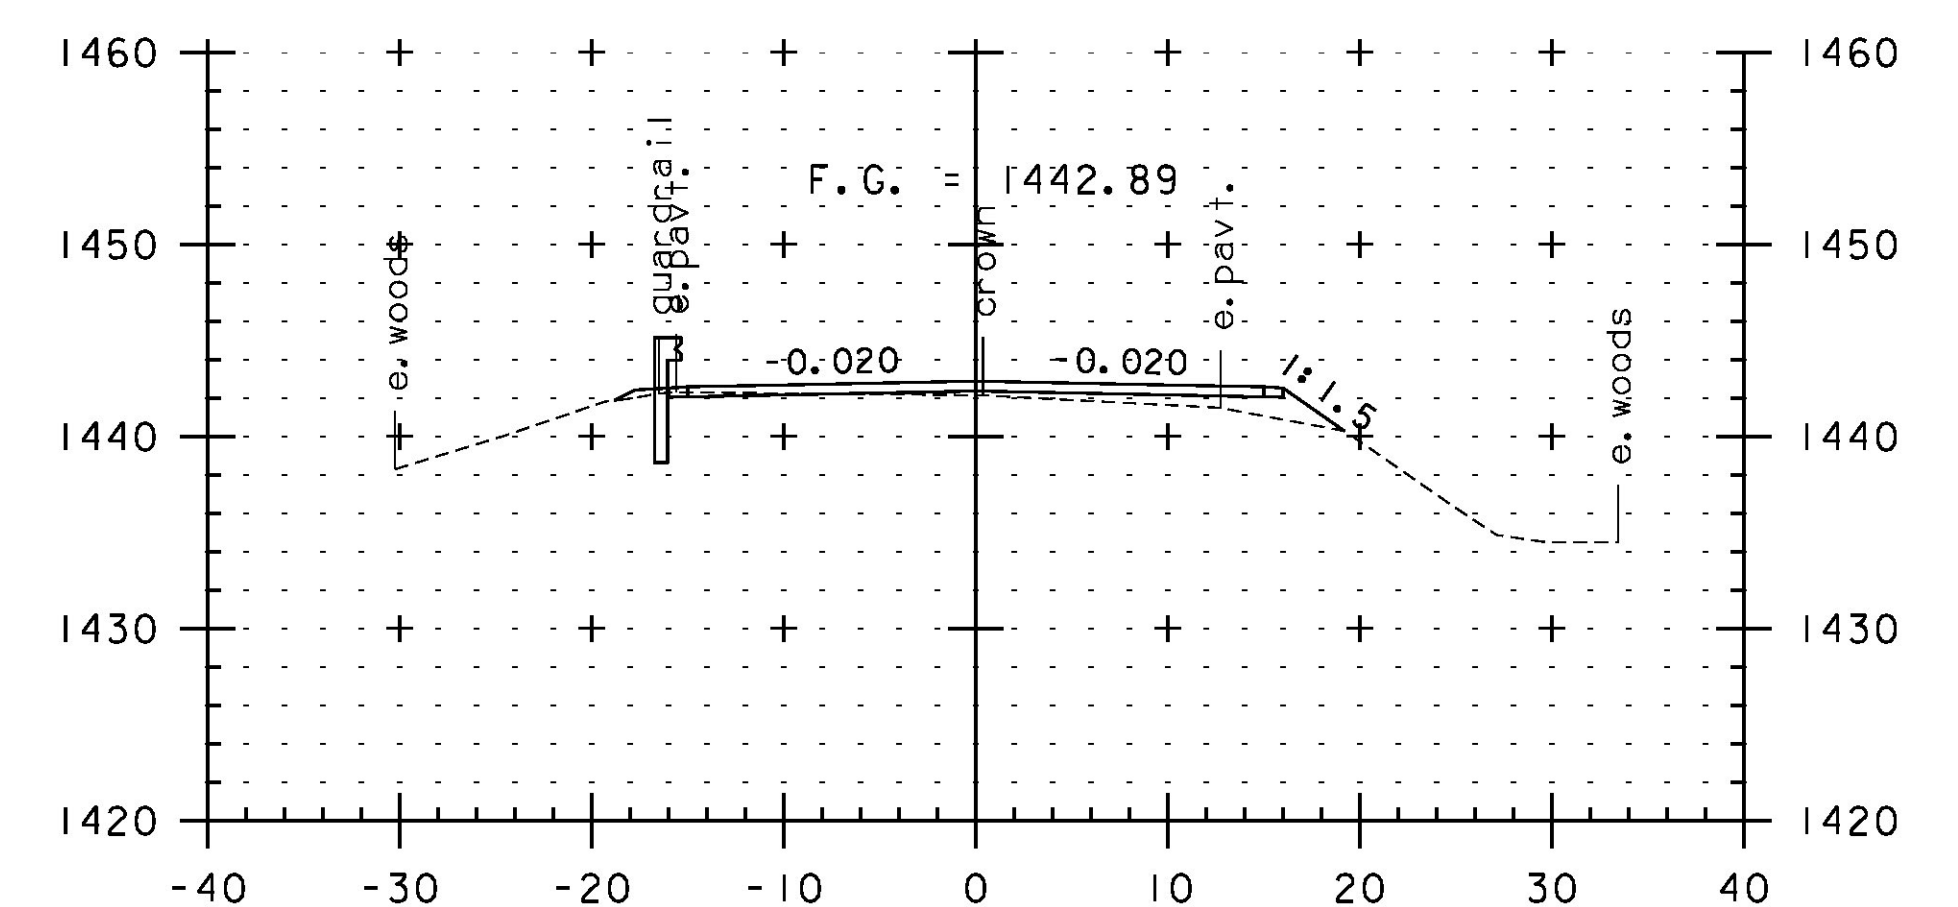

79+50

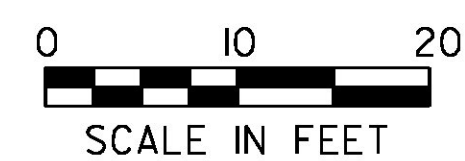

STA. 76+50 TO STA. 80+50

PROJECT NAME: JAY-TROY
PROJECT NUMBER: STP 2315(I)

FILE NAME: z10b232xs.dgn
PROJECT LEADER: P. SHEDD
DESIGNED BY: N. LEMAY
CROSS SECTION SHEET 10

PLOT DATE: 5/16/2014
DRAWN BY: W. GORDON
CHECKED BY: P. SHEDD
SHEET 146 OF 244