




82+00

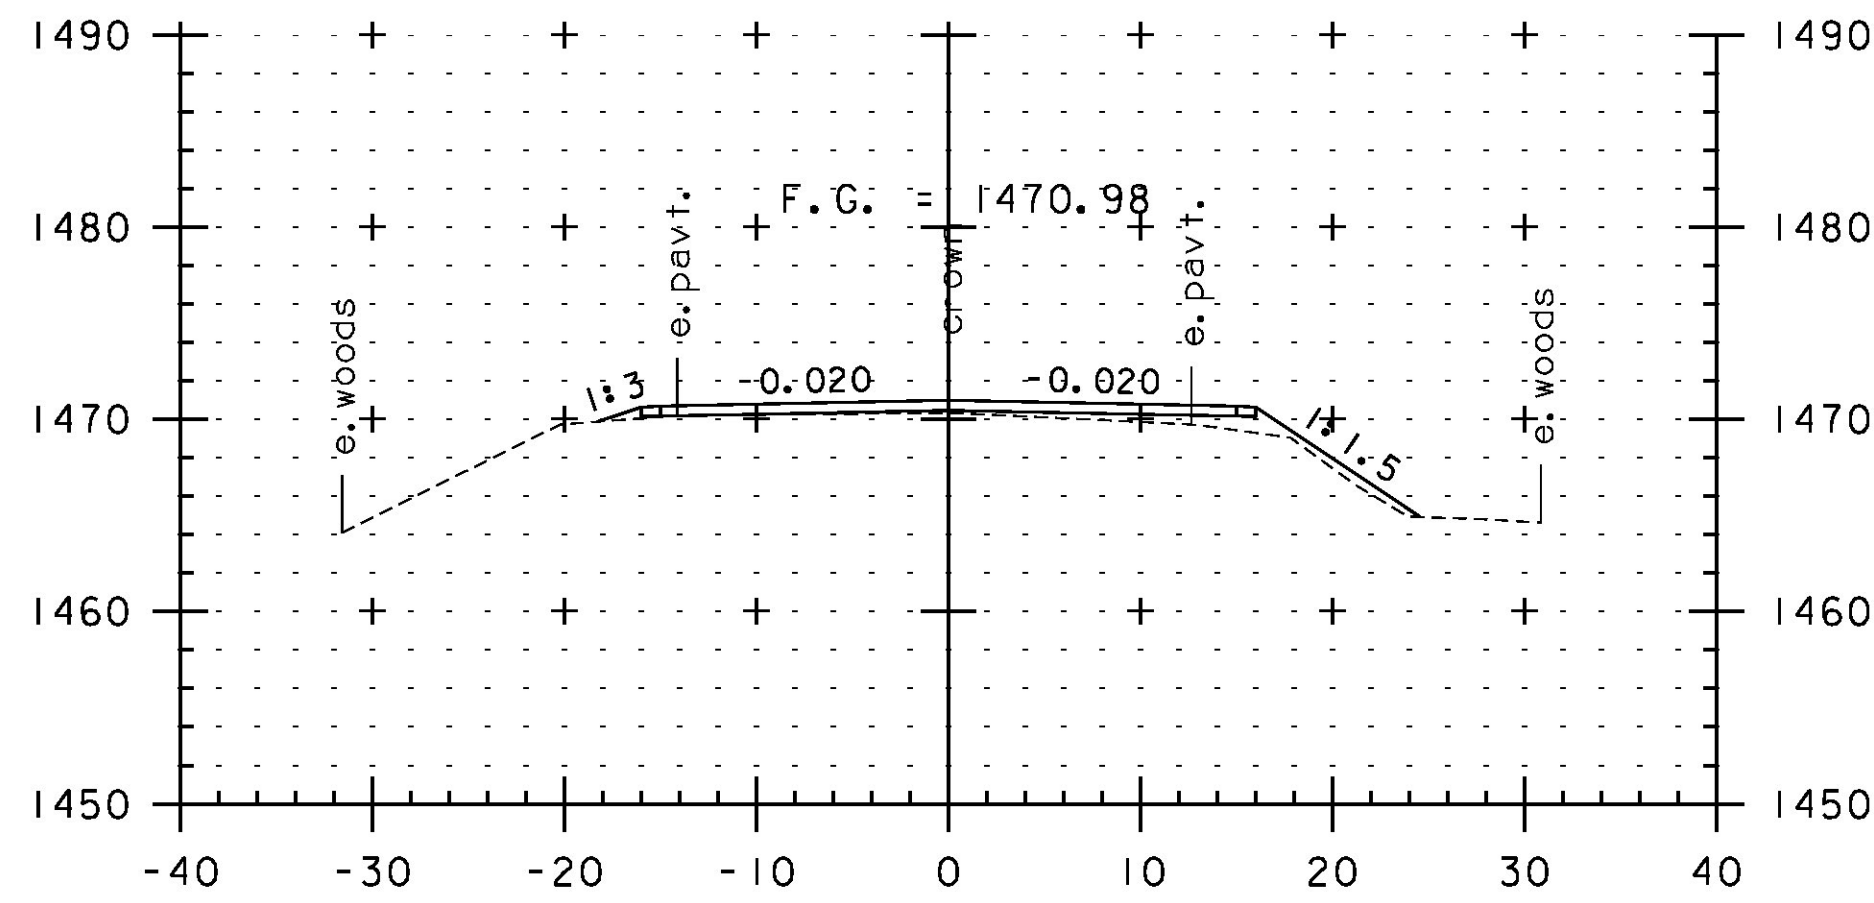


83+50

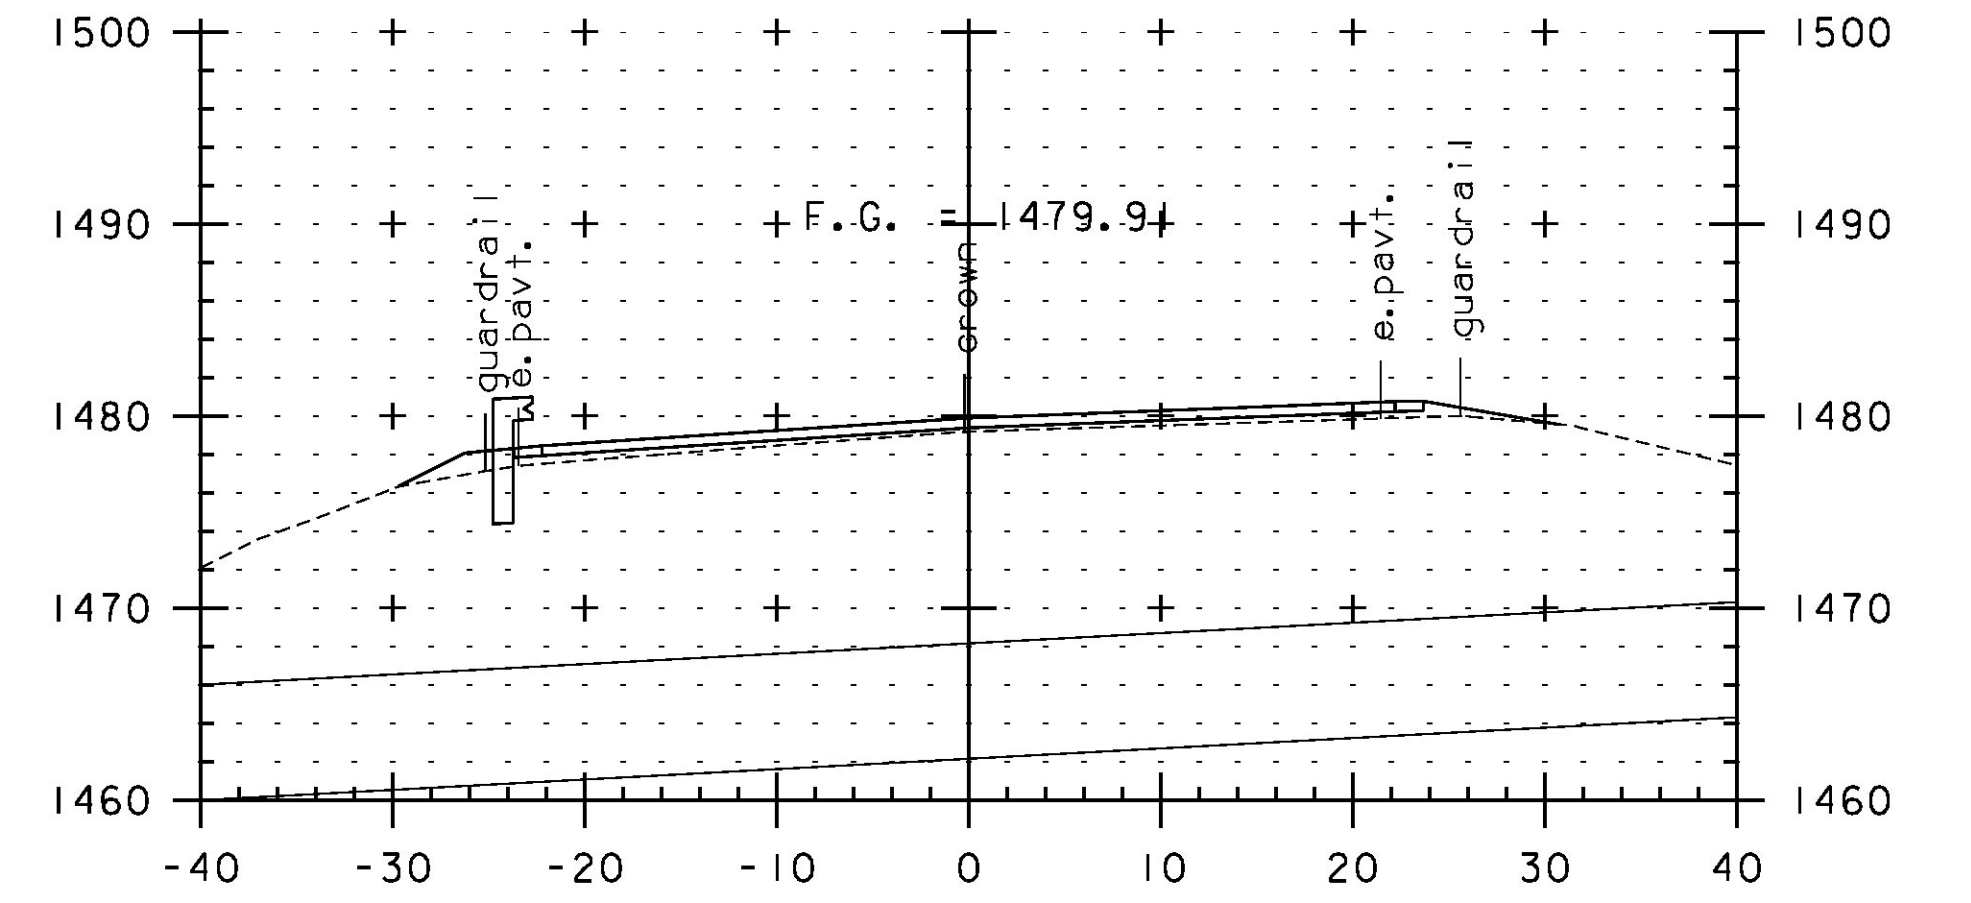


84+77
BRIDGE 44

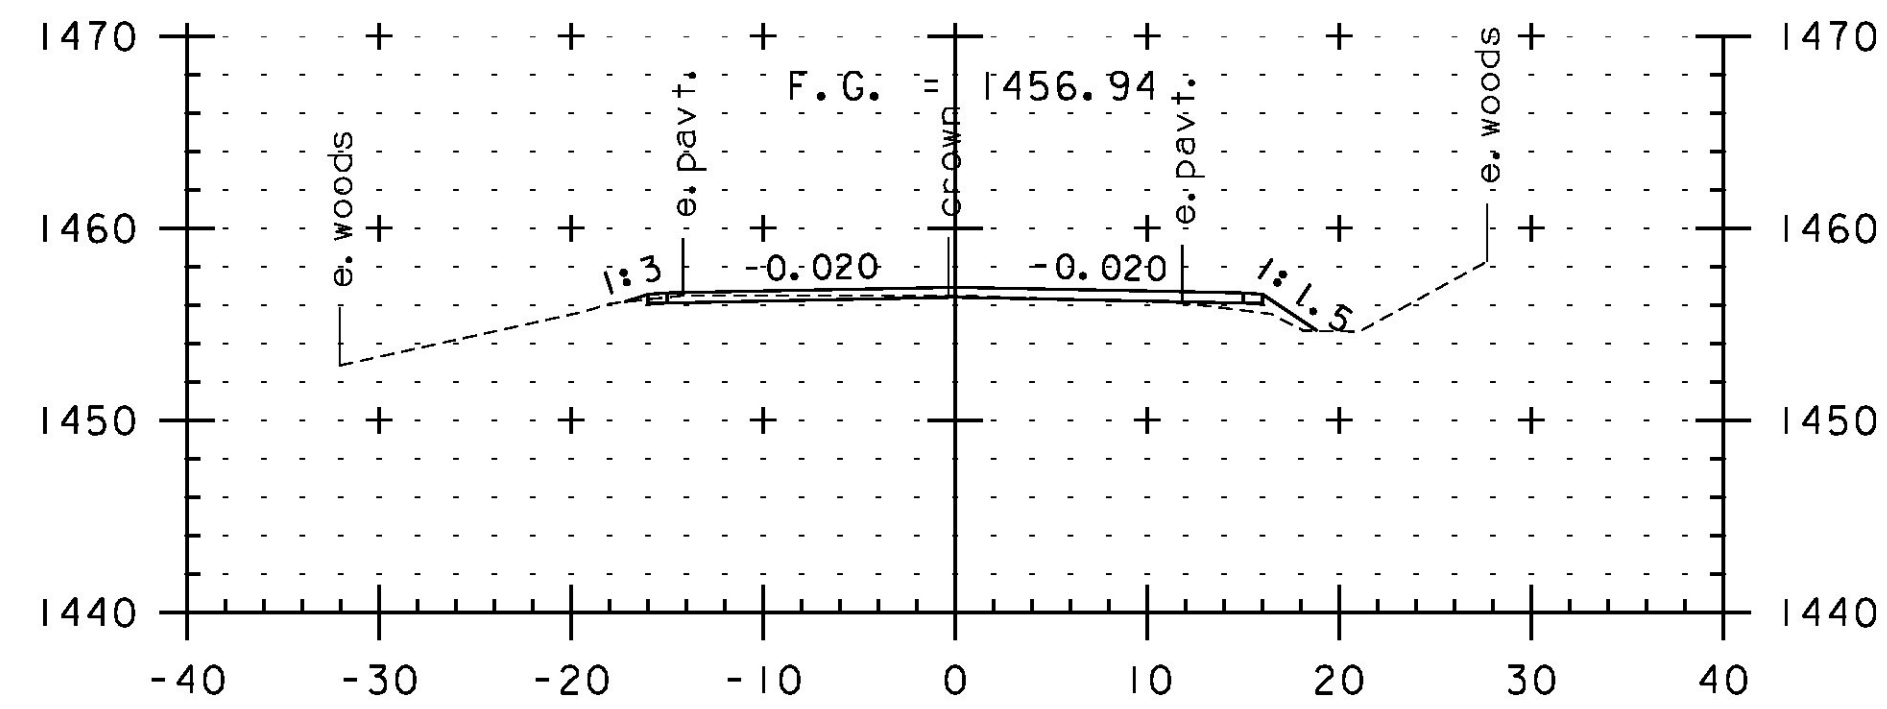


81+50

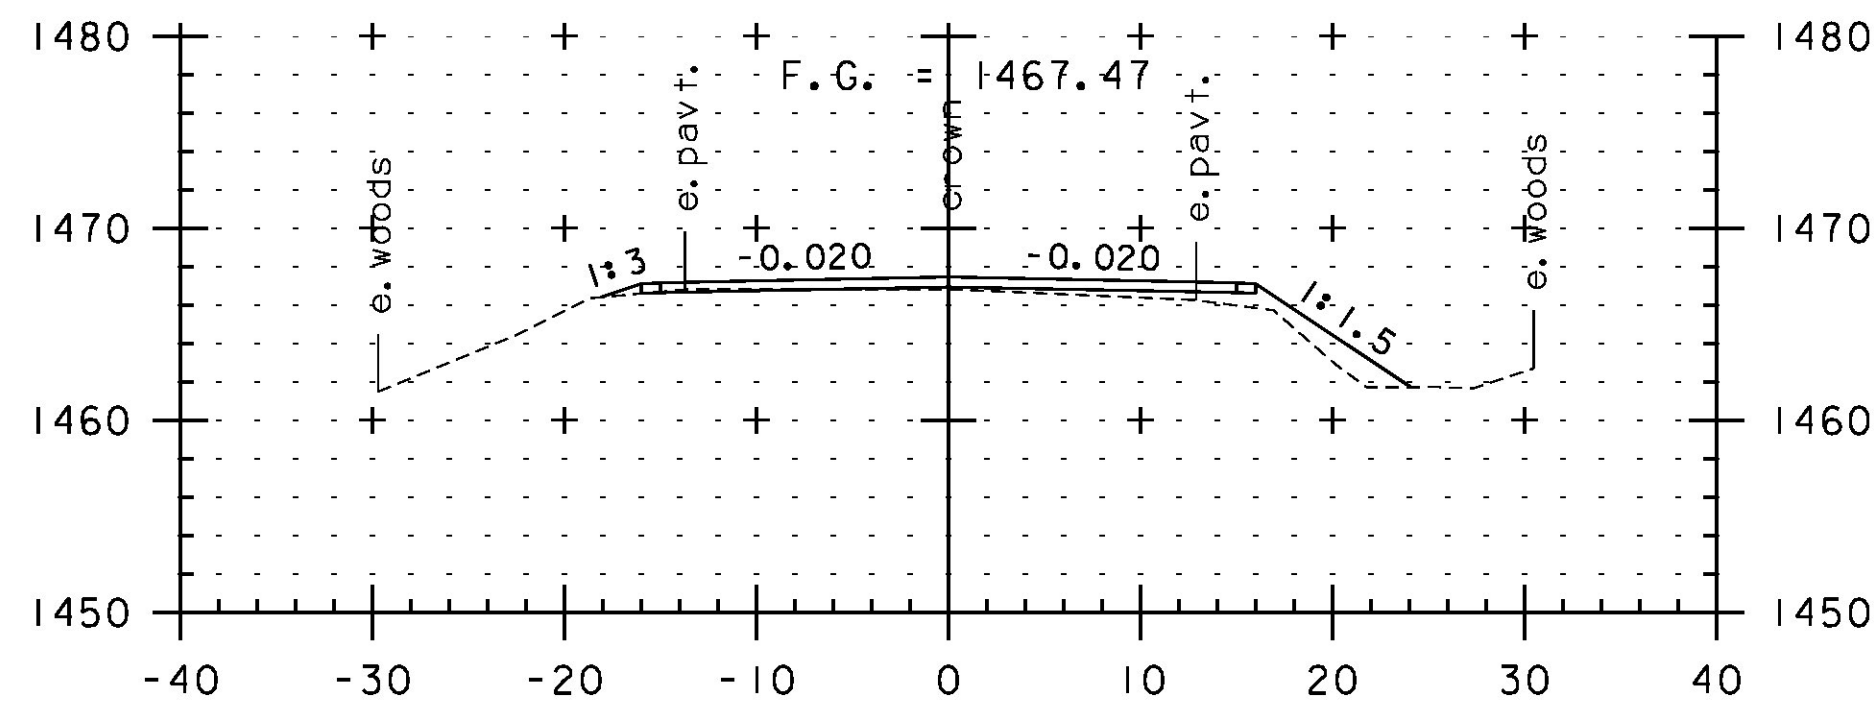


83+00

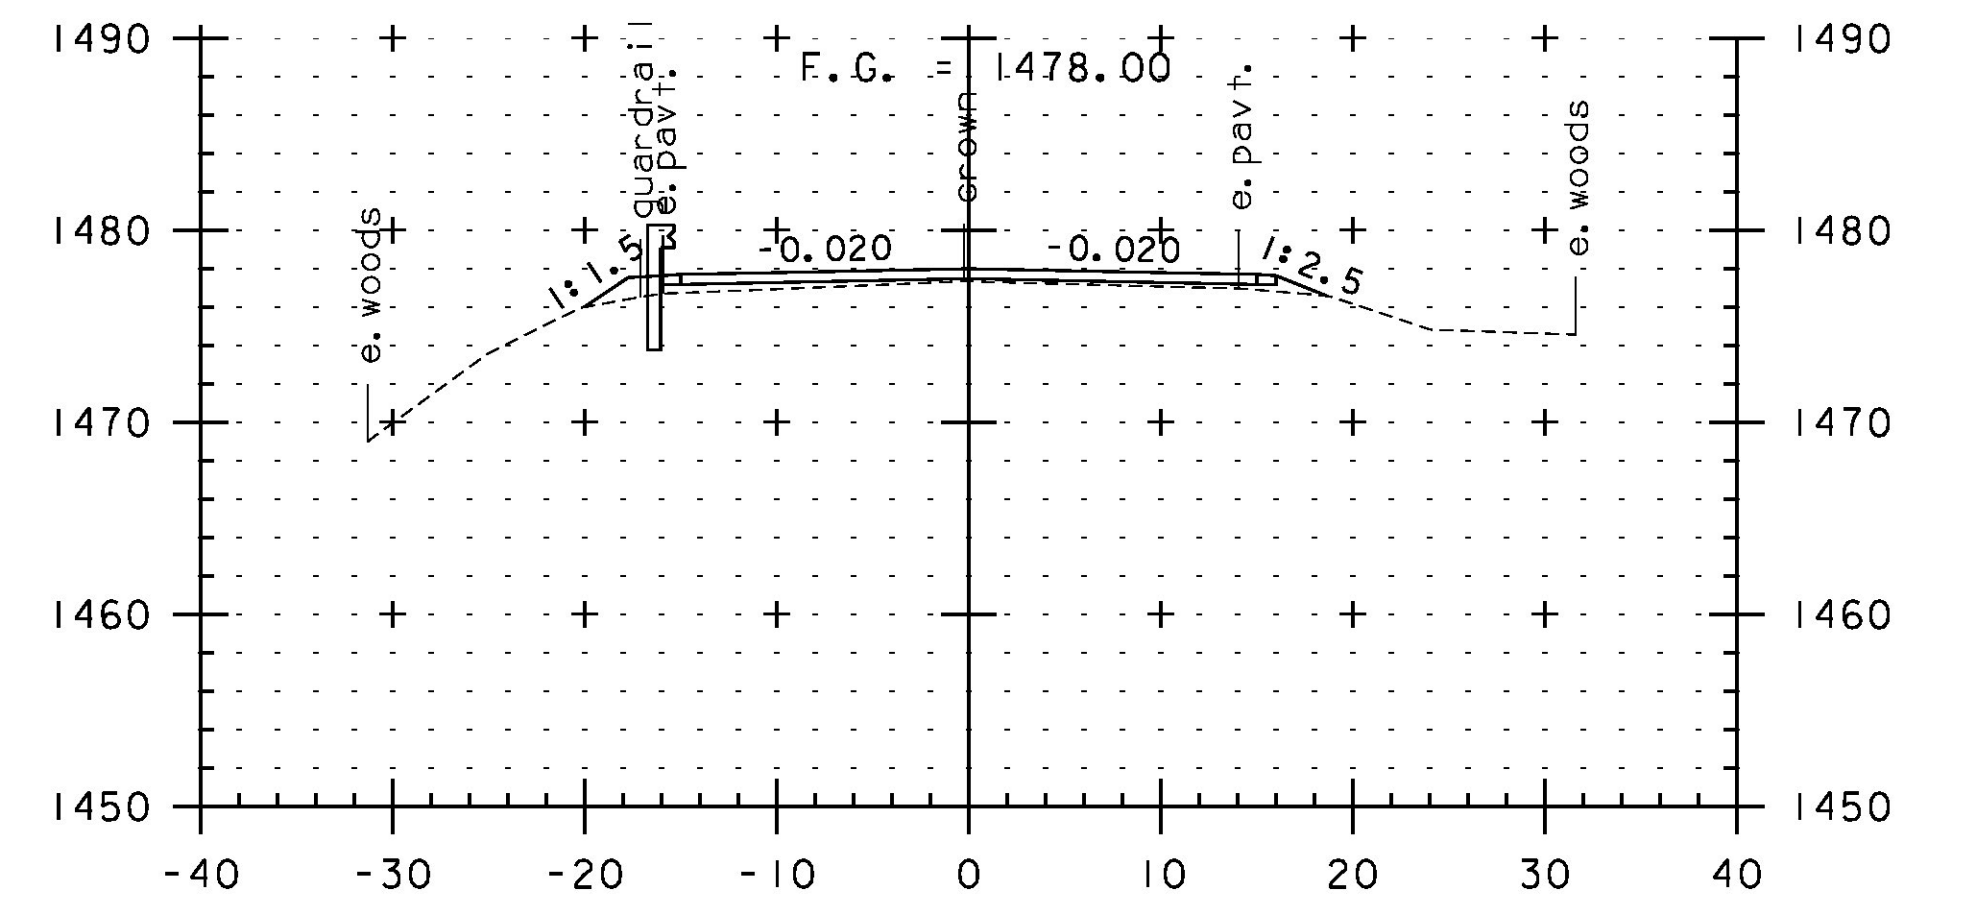


84+50

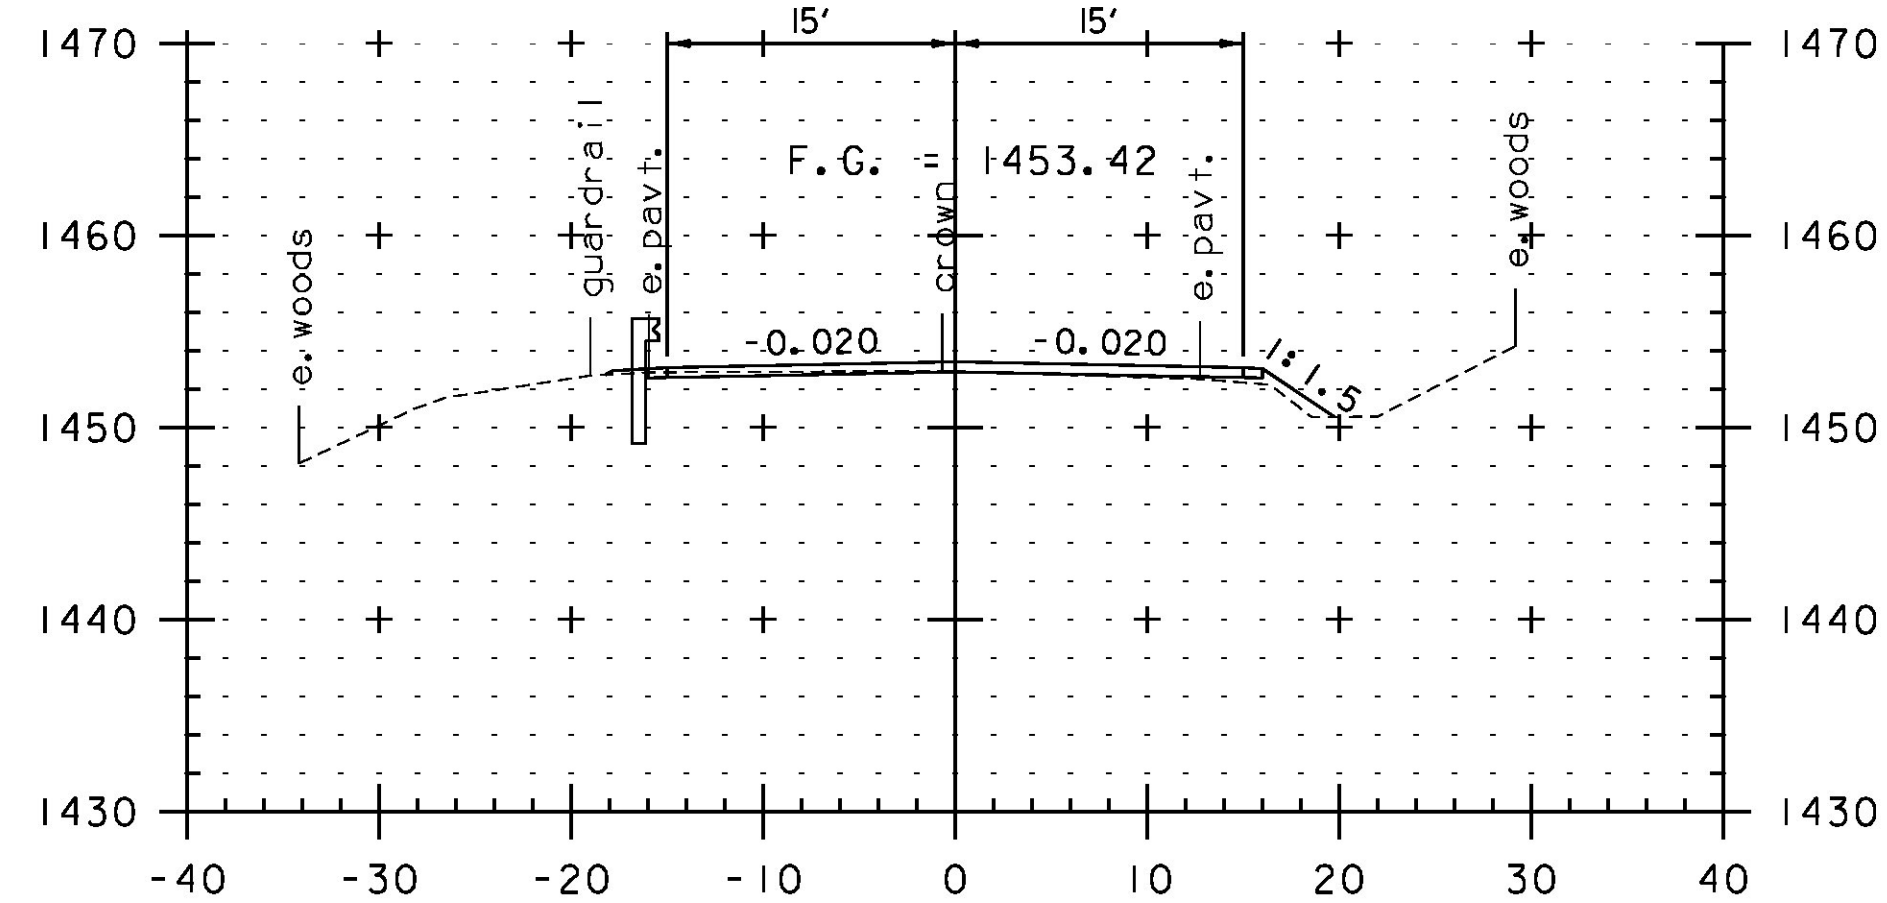

81+00

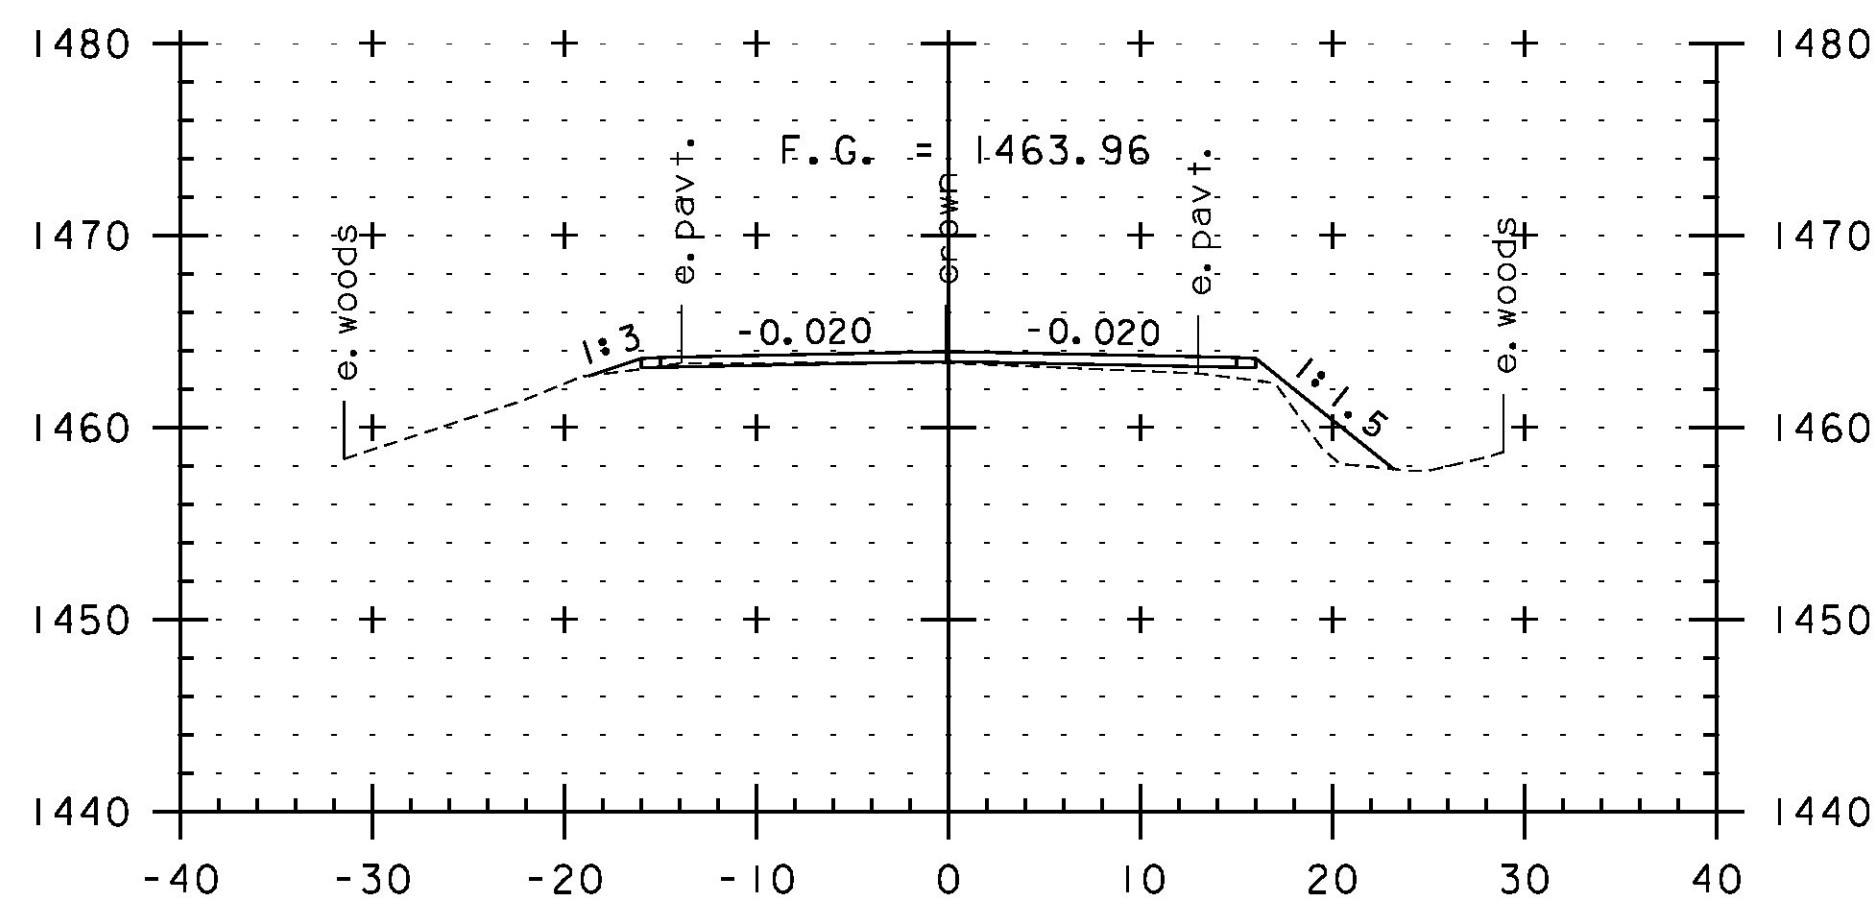

82+50

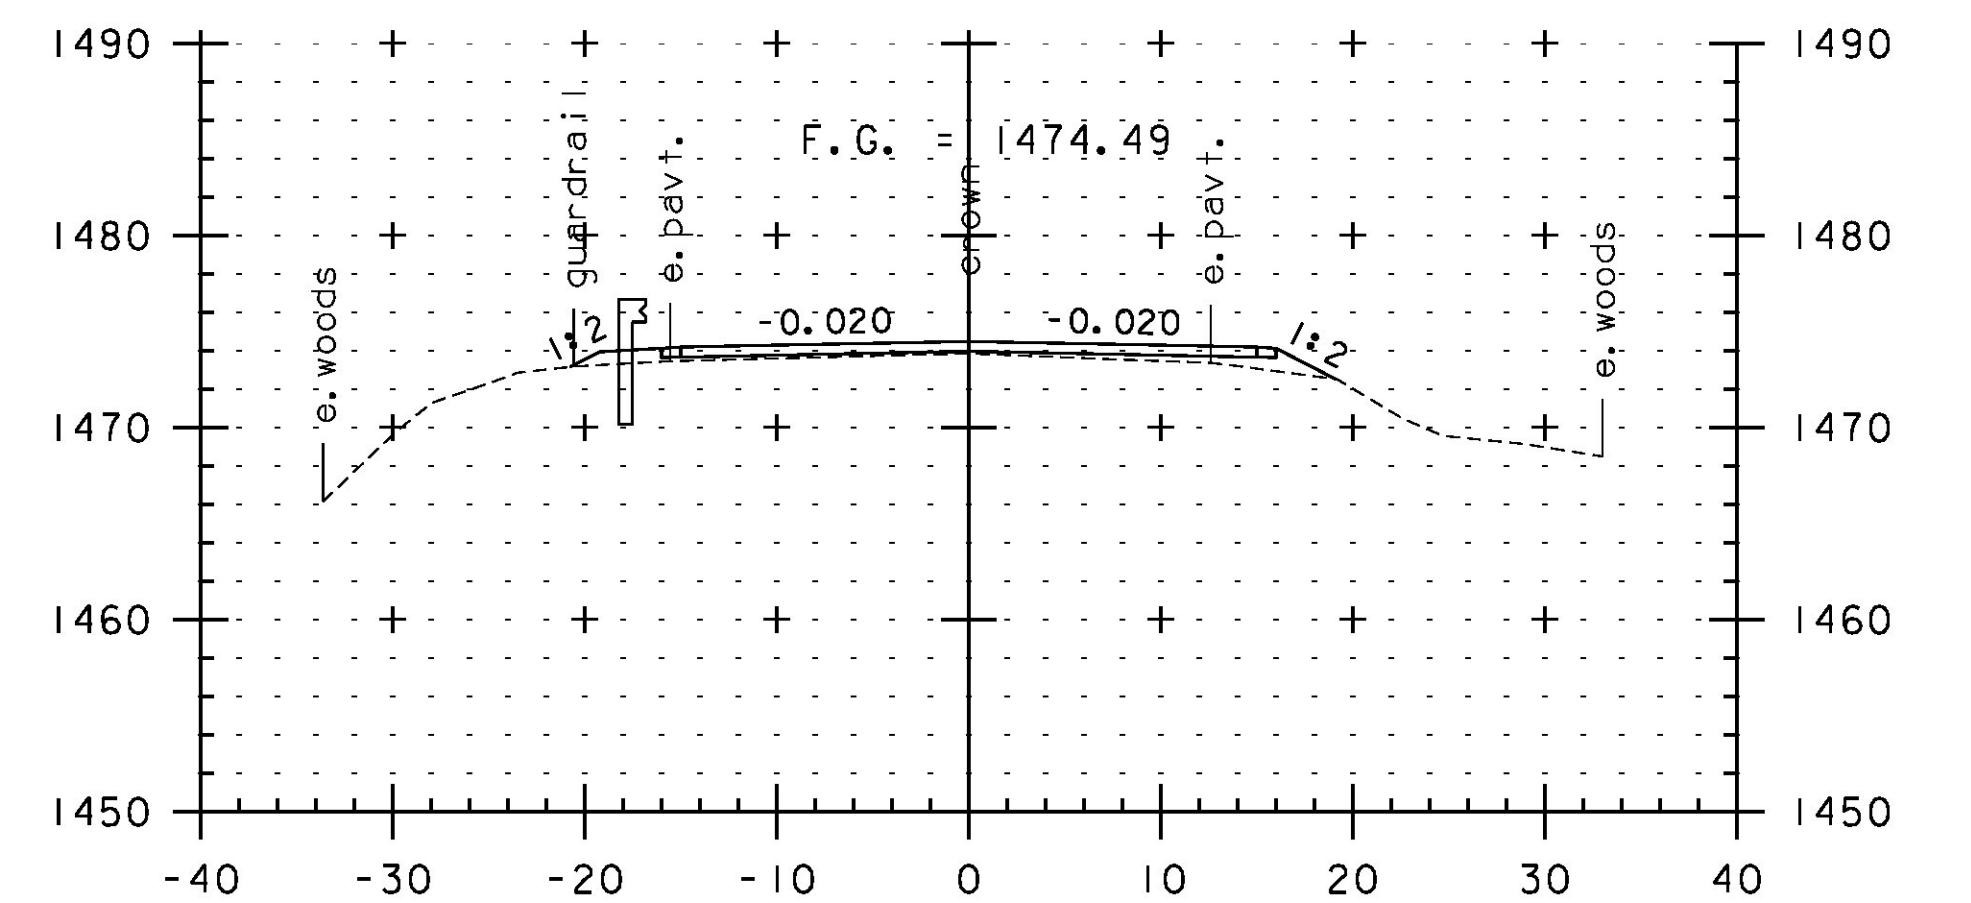

84+00



STA. 81+00 TO STA. 84+77

PROJECT NAME:	JAY-TROY	PLOT DATE:	5/16/2014
PROJECT NUMBER:	STP 2315(I)	DRAWN BY:	W. GORDON
FILE NAME:	z10b232xs.dgn	DESIGNED BY:	N. LEMAY
PROJECT LEADER:	P. SHEDD	CHECKED BY:	P. SHEDD
CROSS SECTION SHEET 11		SHEET	147 OF 244