




94+50

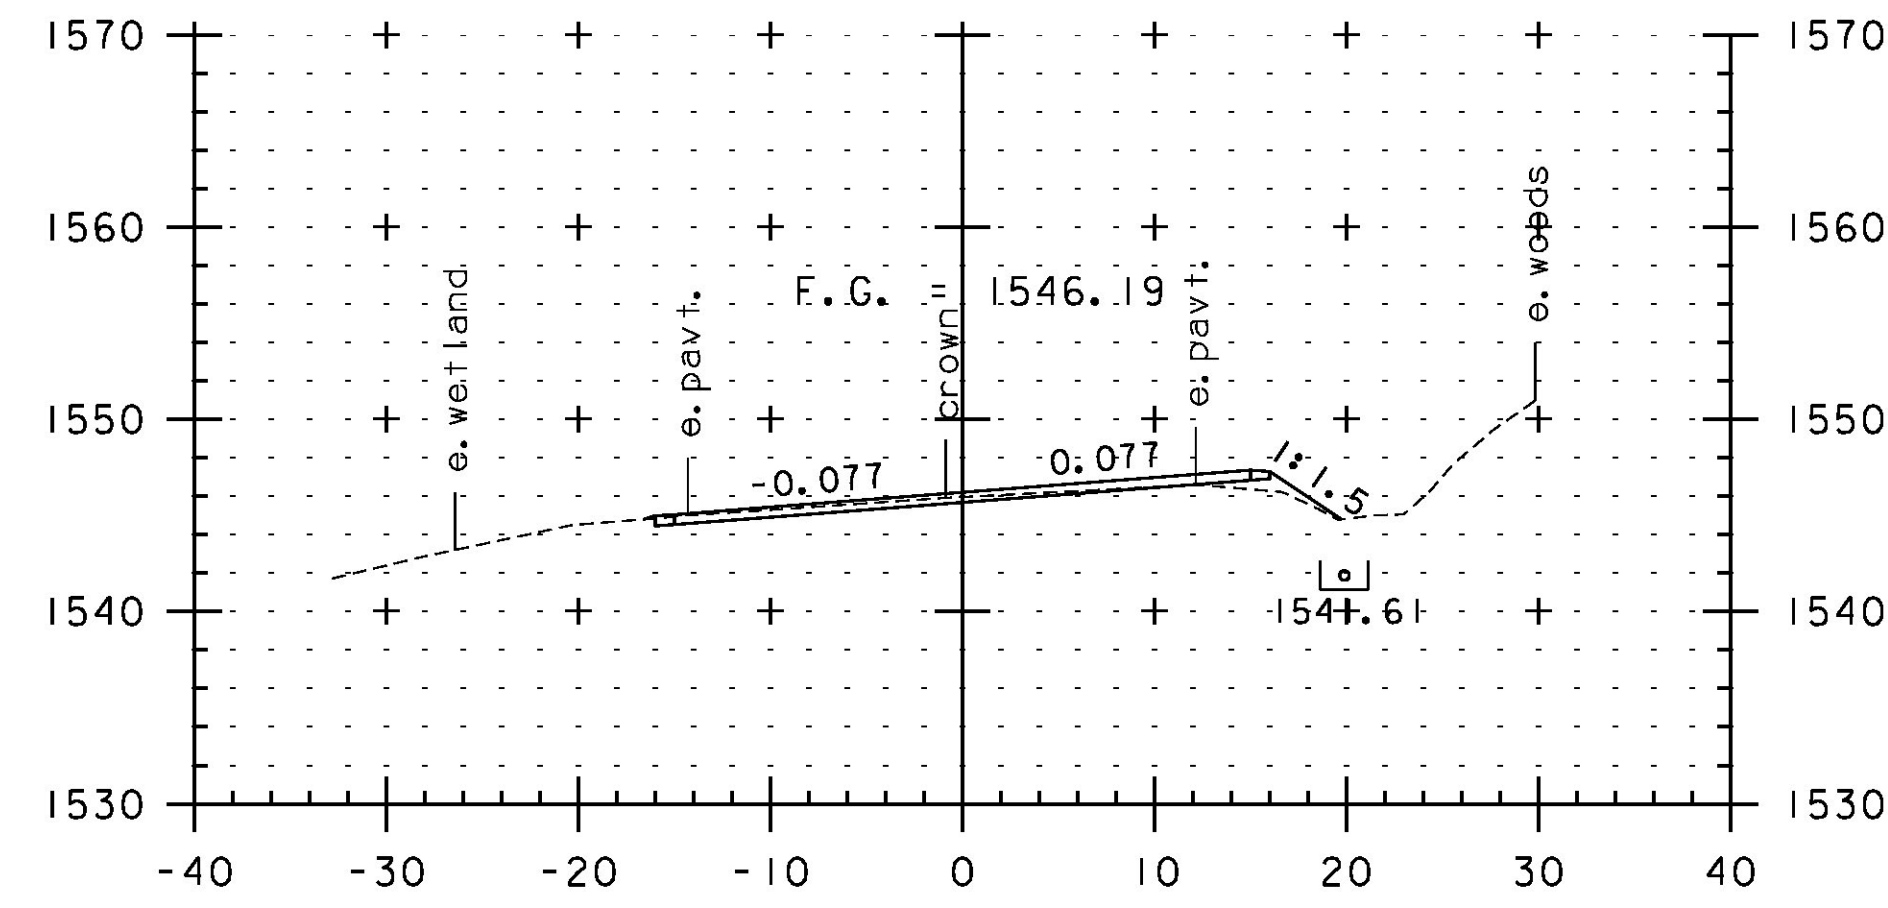


96+00

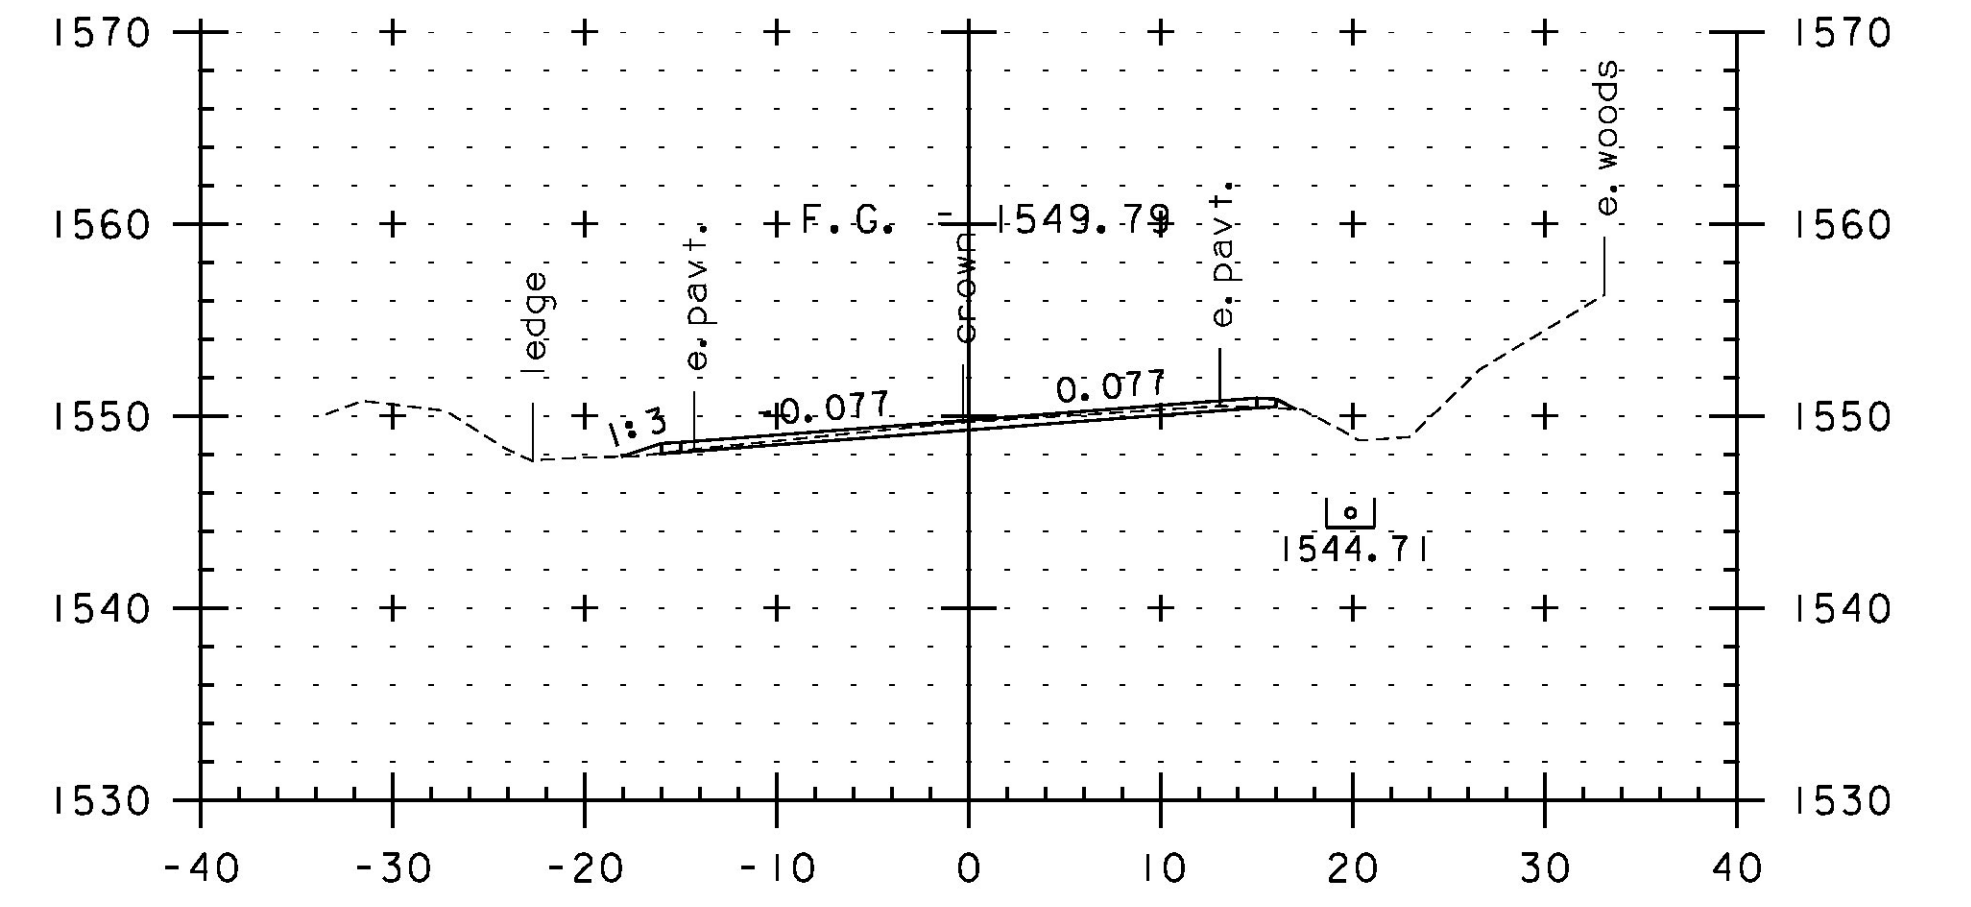


97+50

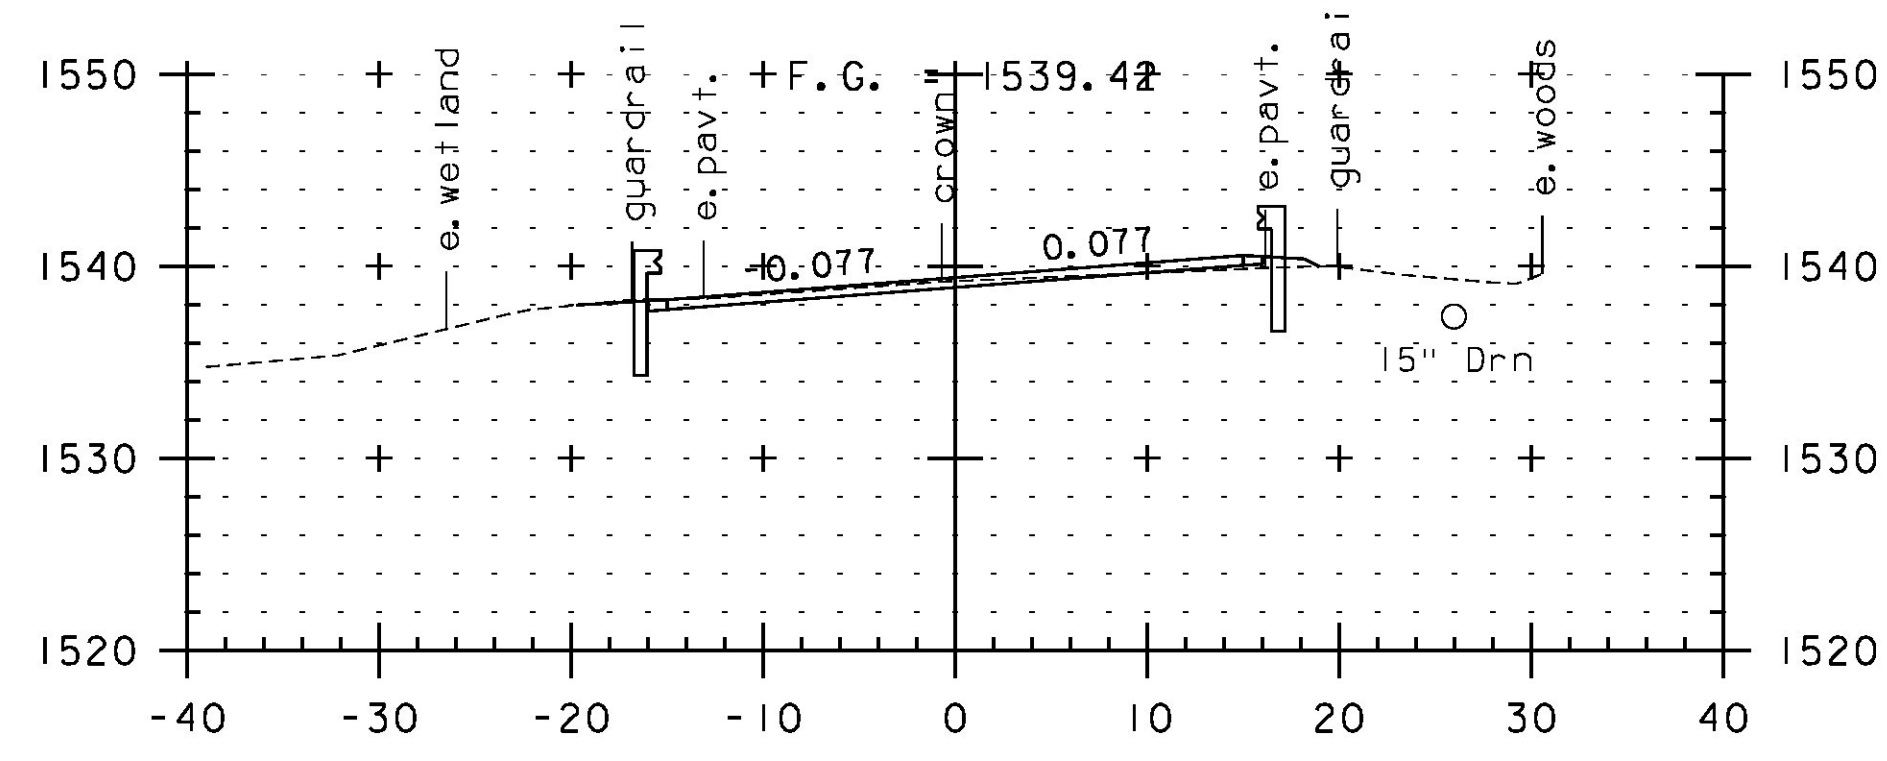


94+00

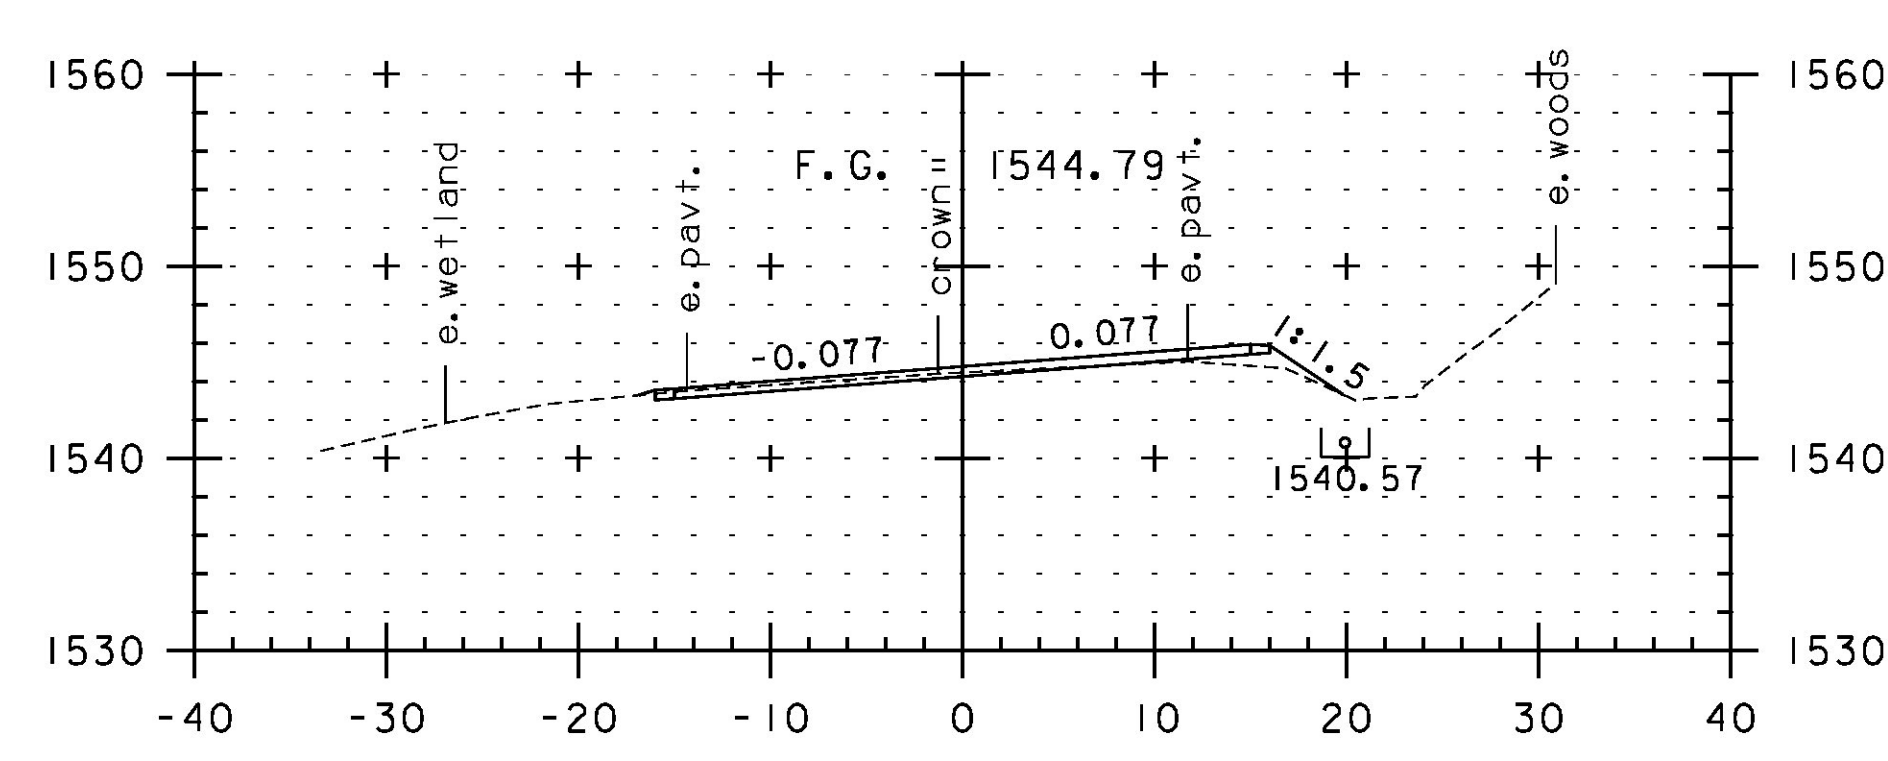


95+50

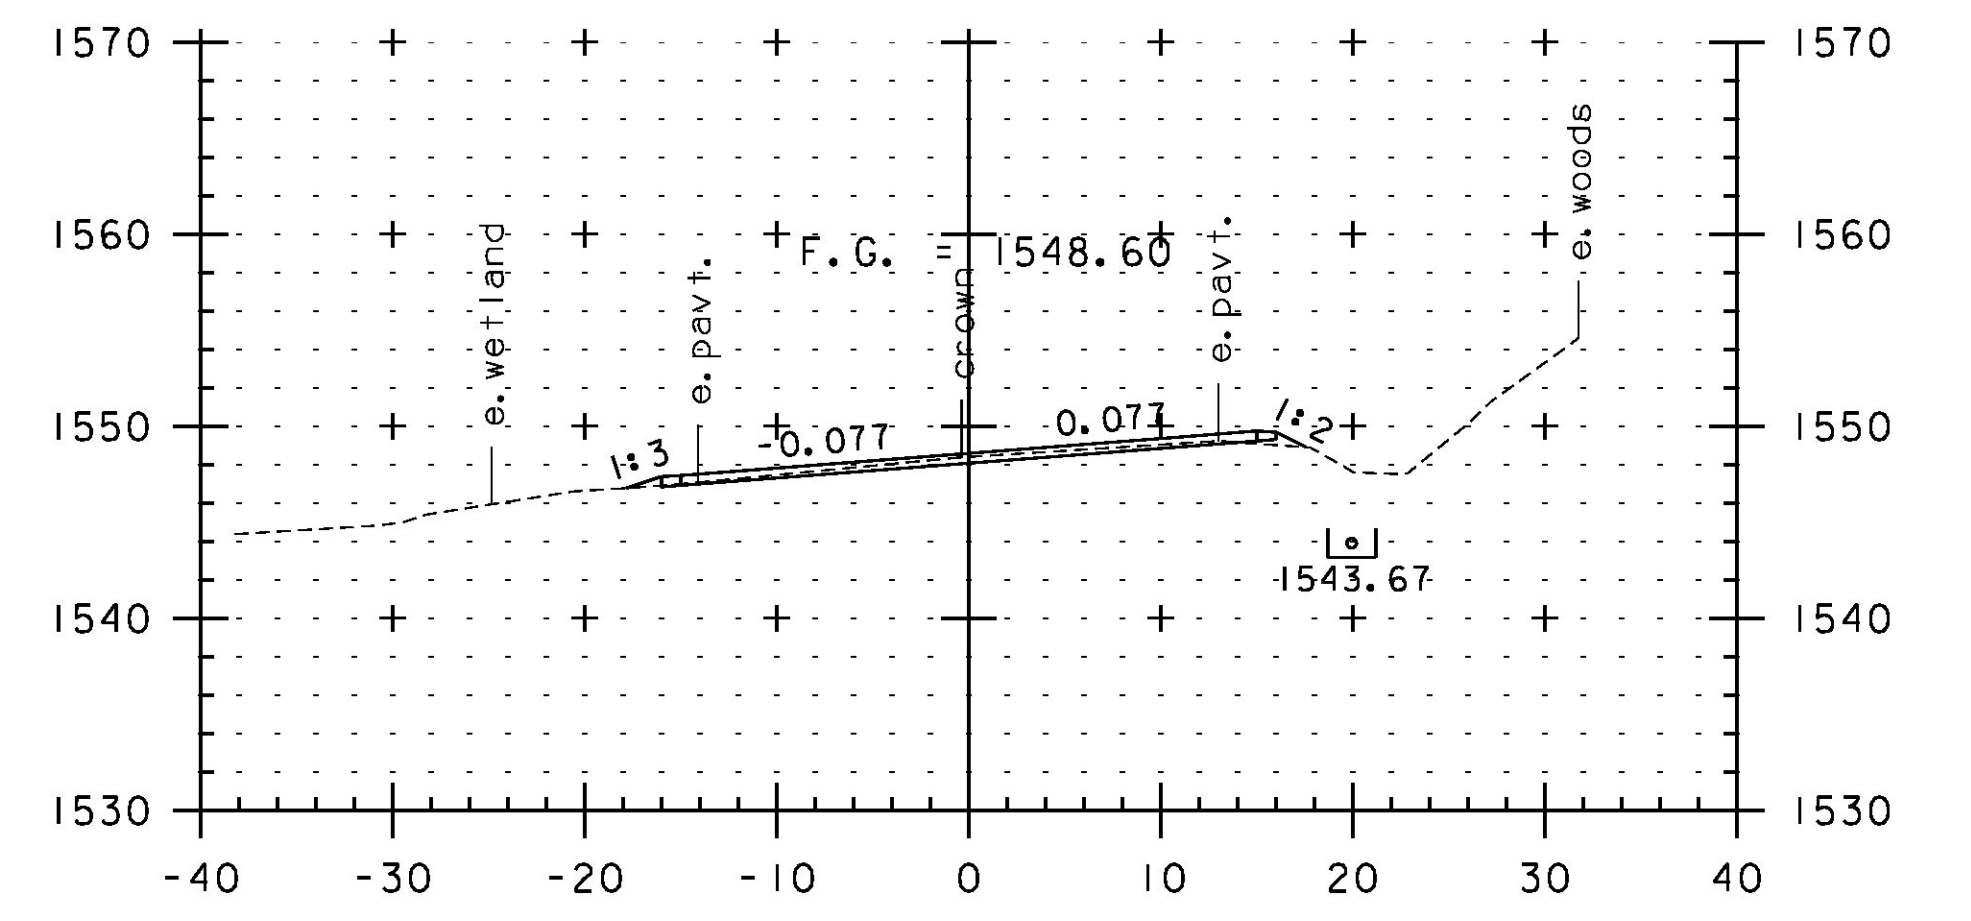


97+00

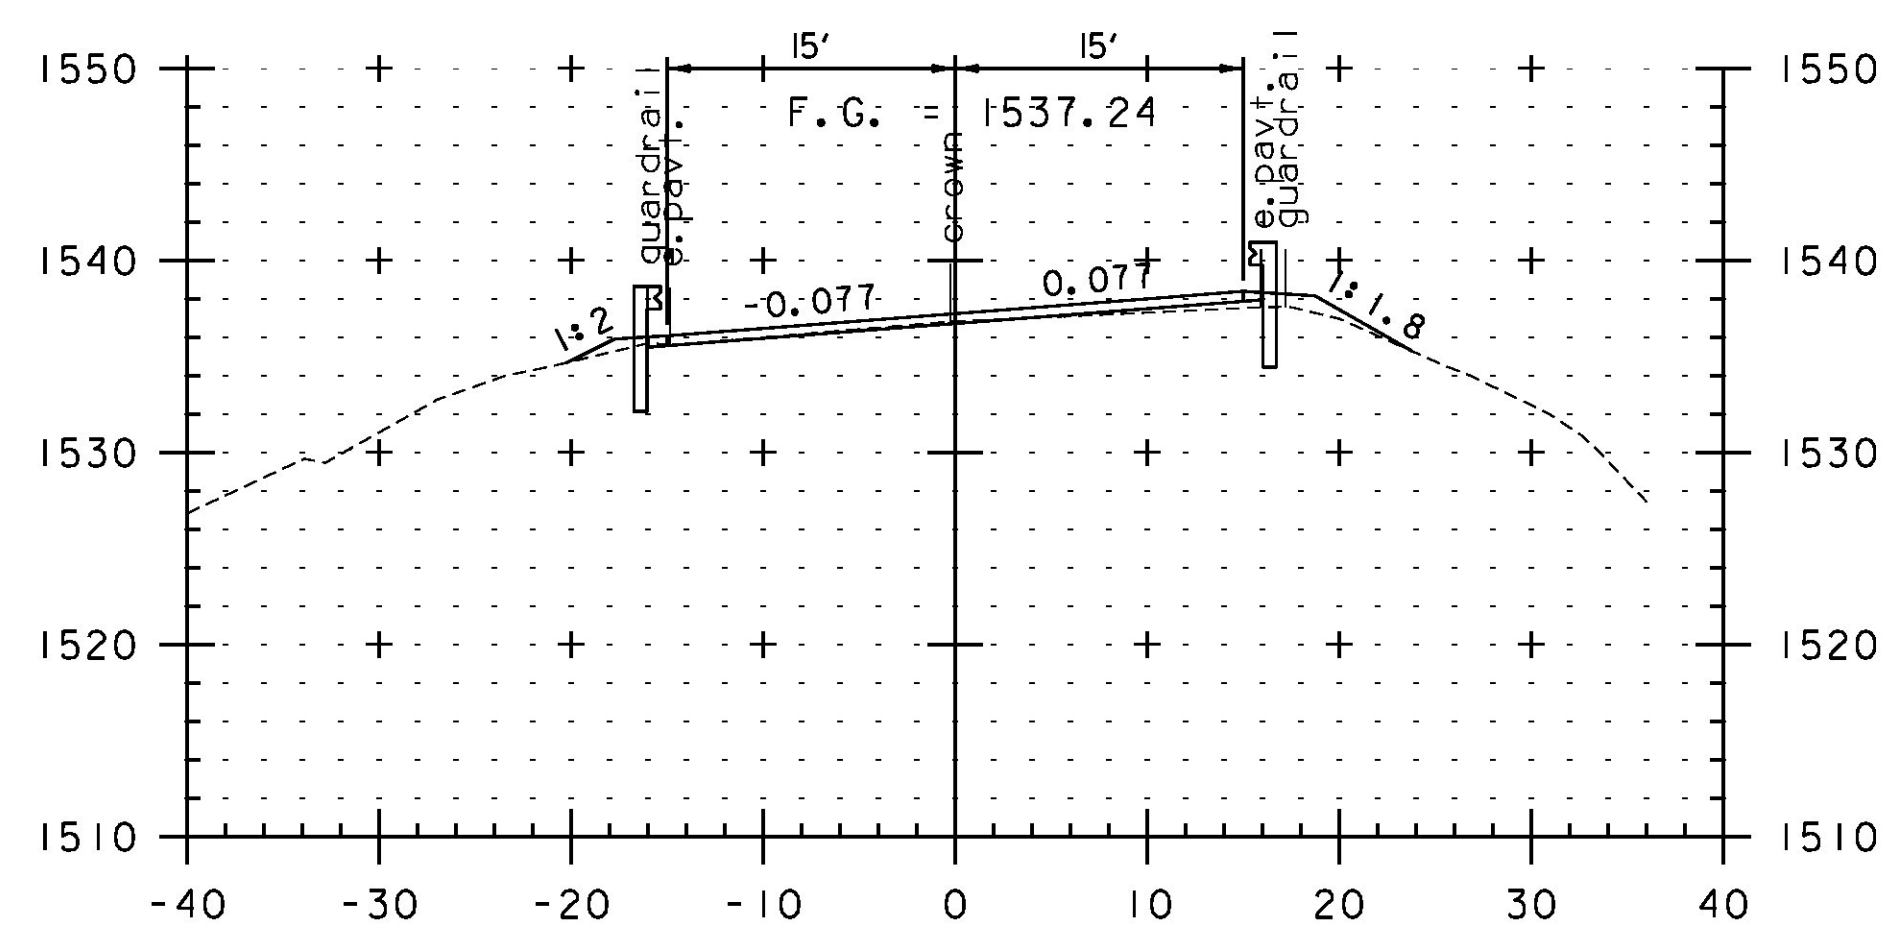


93+50

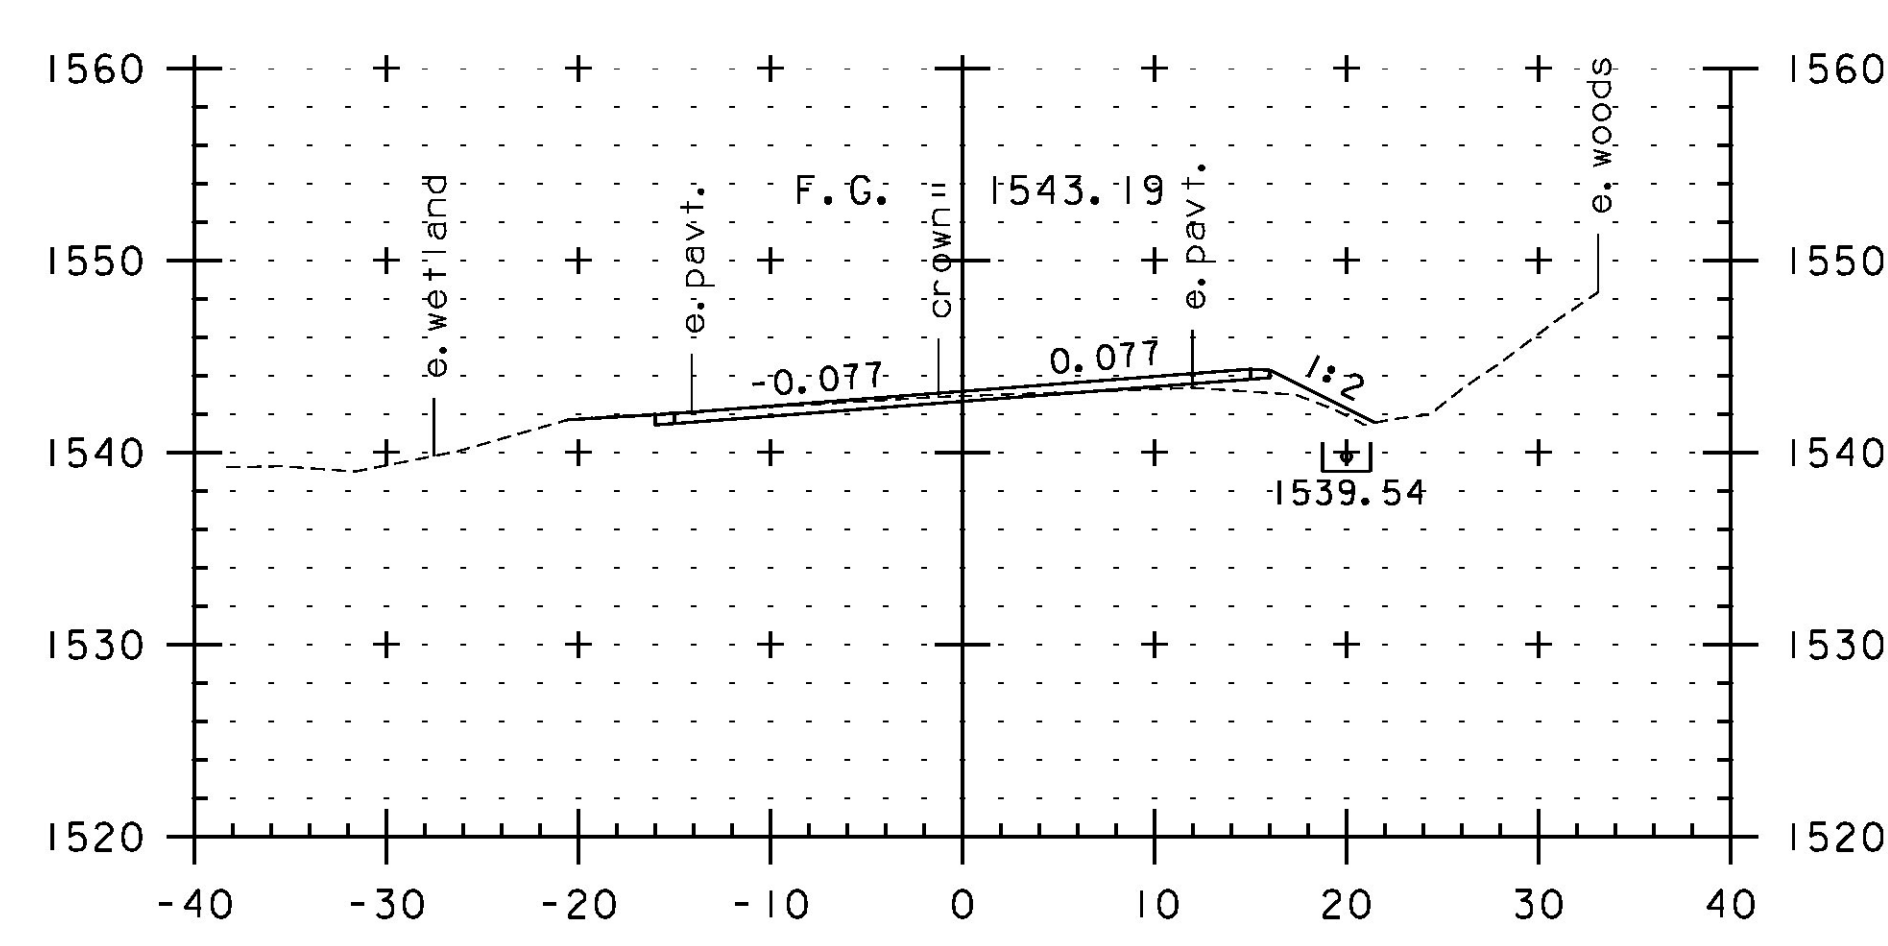

95+00

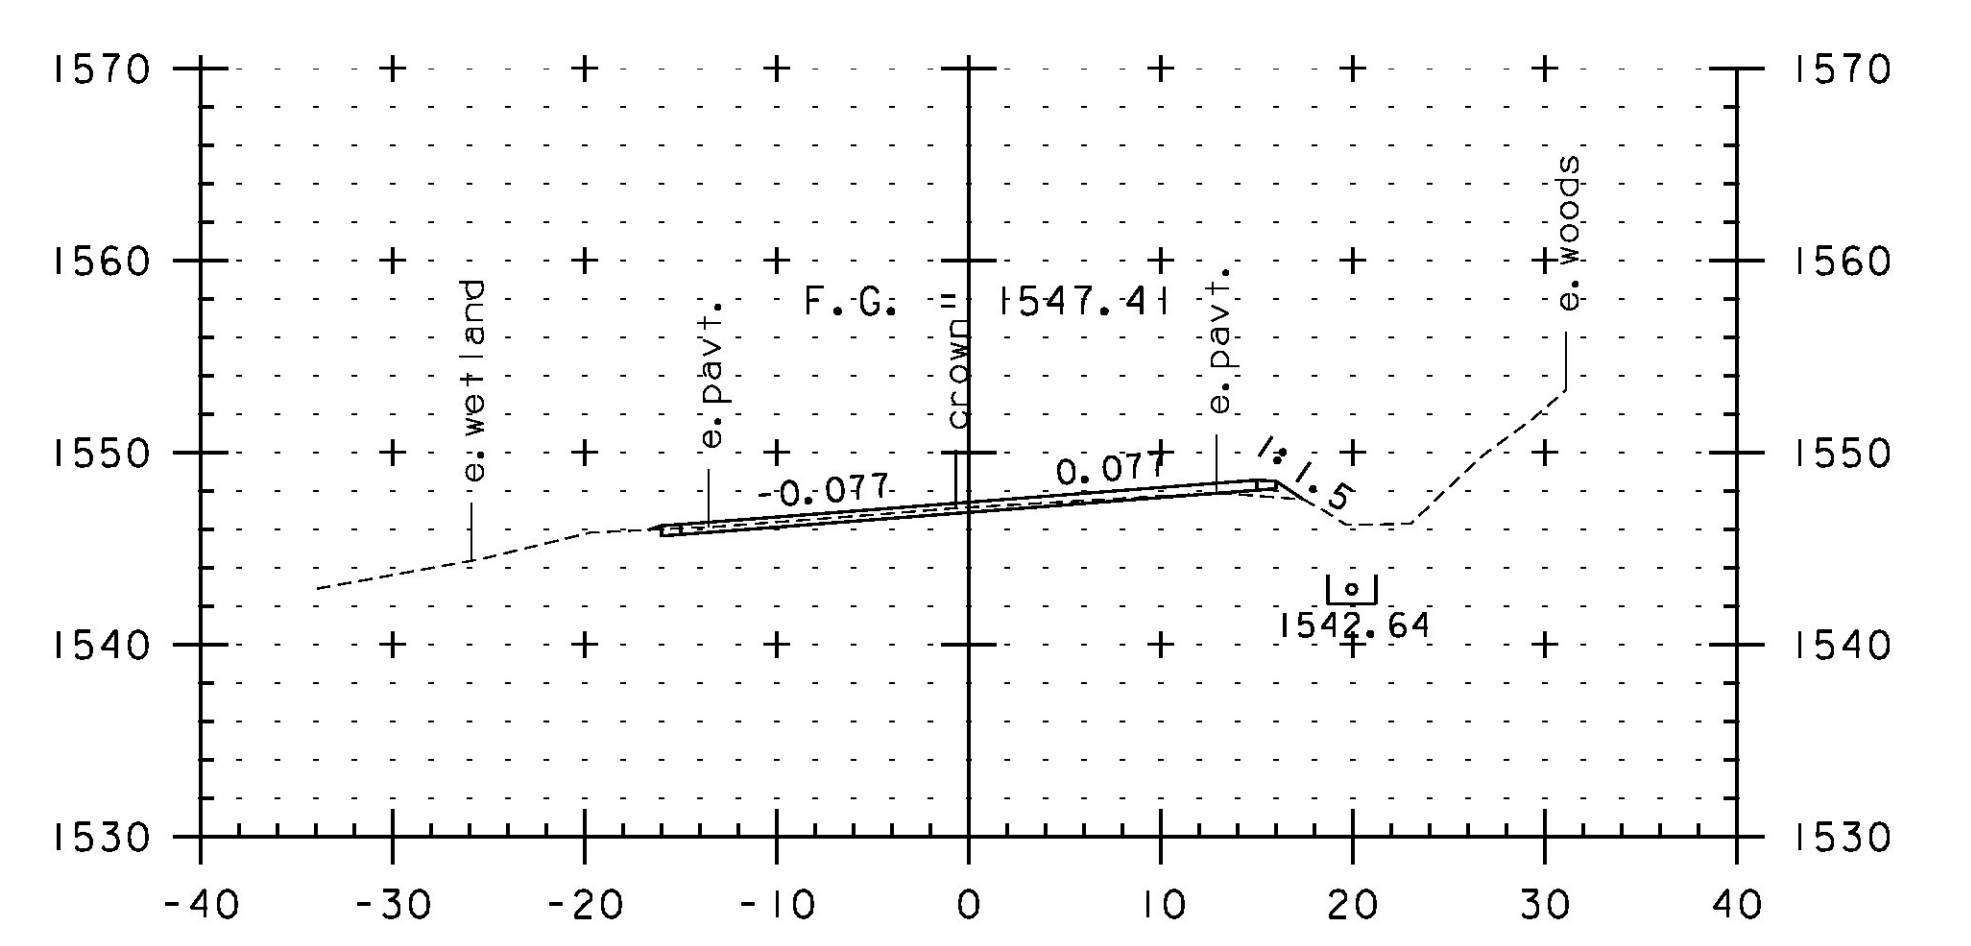

96+50

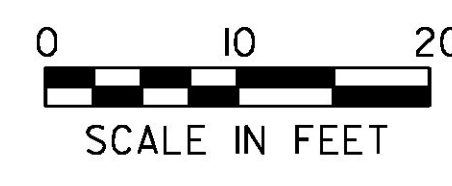

STA. 93+50 TO STA. 97+50

PROJECT NAME:	JAY-TROY	PLOT DATE:	5/16/2014
PROJECT NUMBER:	STP 2315(I)	DRAWN BY:	W. GORDON
FILE NAME:	z10b232xs.dgn	DESIGNED BY:	N. LEMAY
PROJECT LEADER:	P. SHEDD	CHECKED BY:	P. SHEDD
CROSS SECTION SHEET 14			SHEET 150 OF 244