




99+00

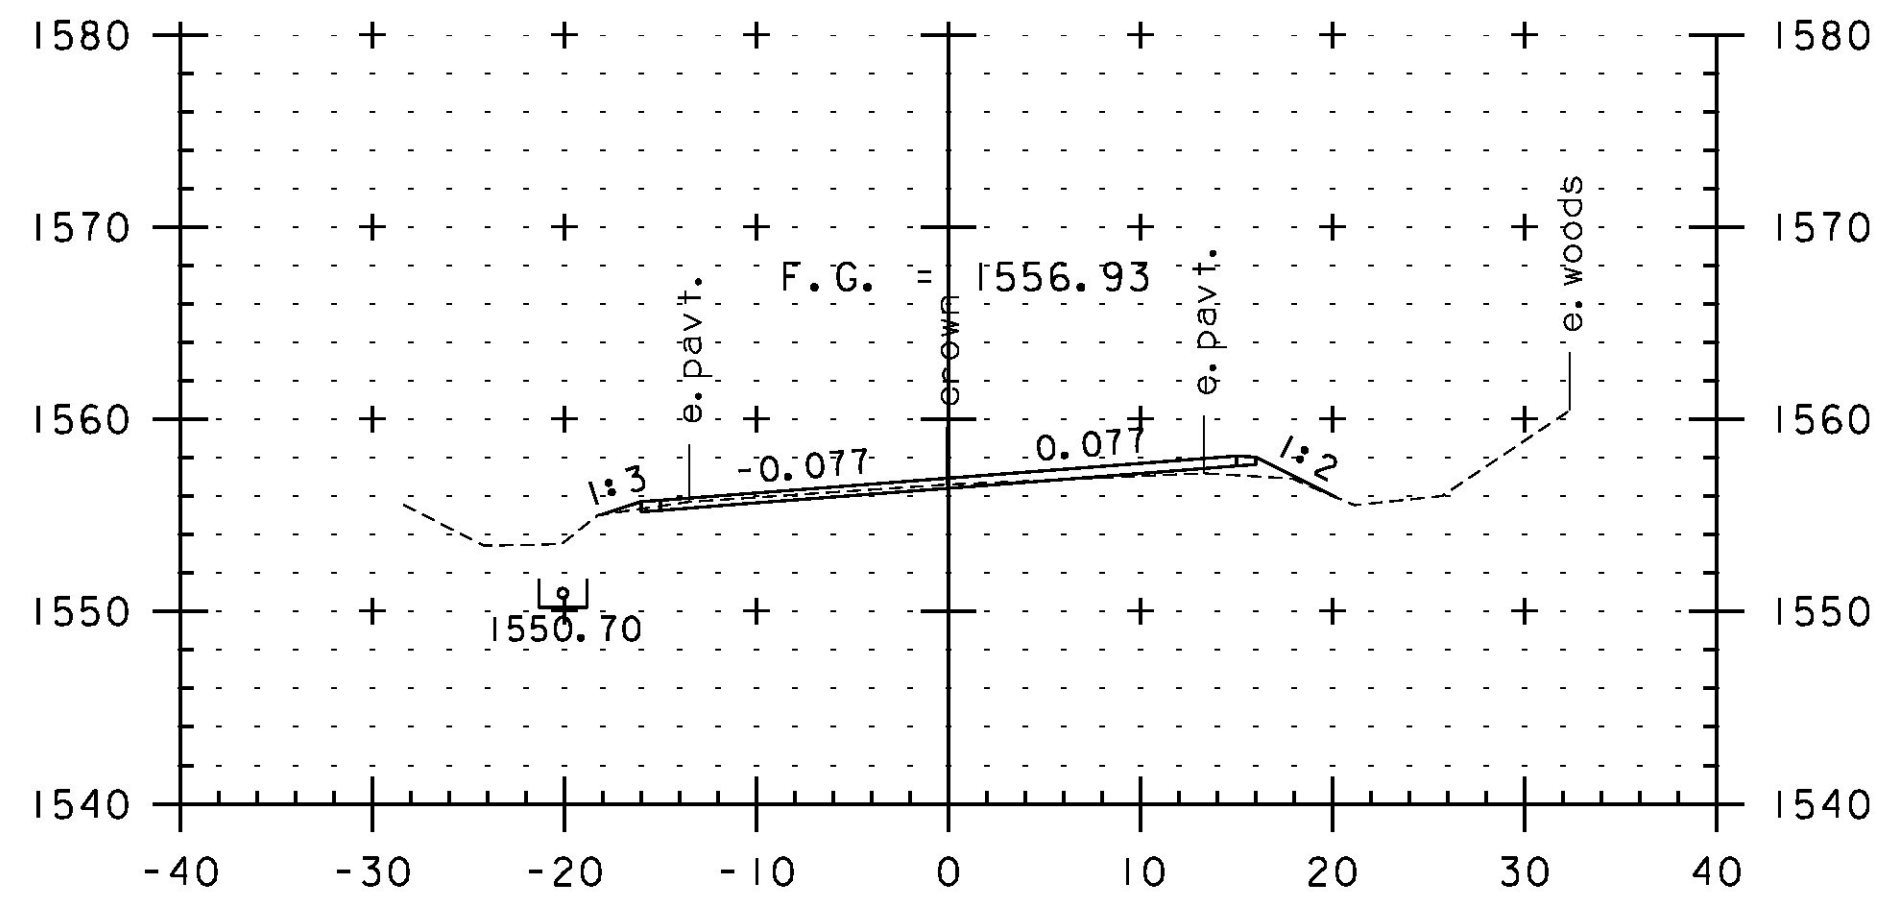


100+50

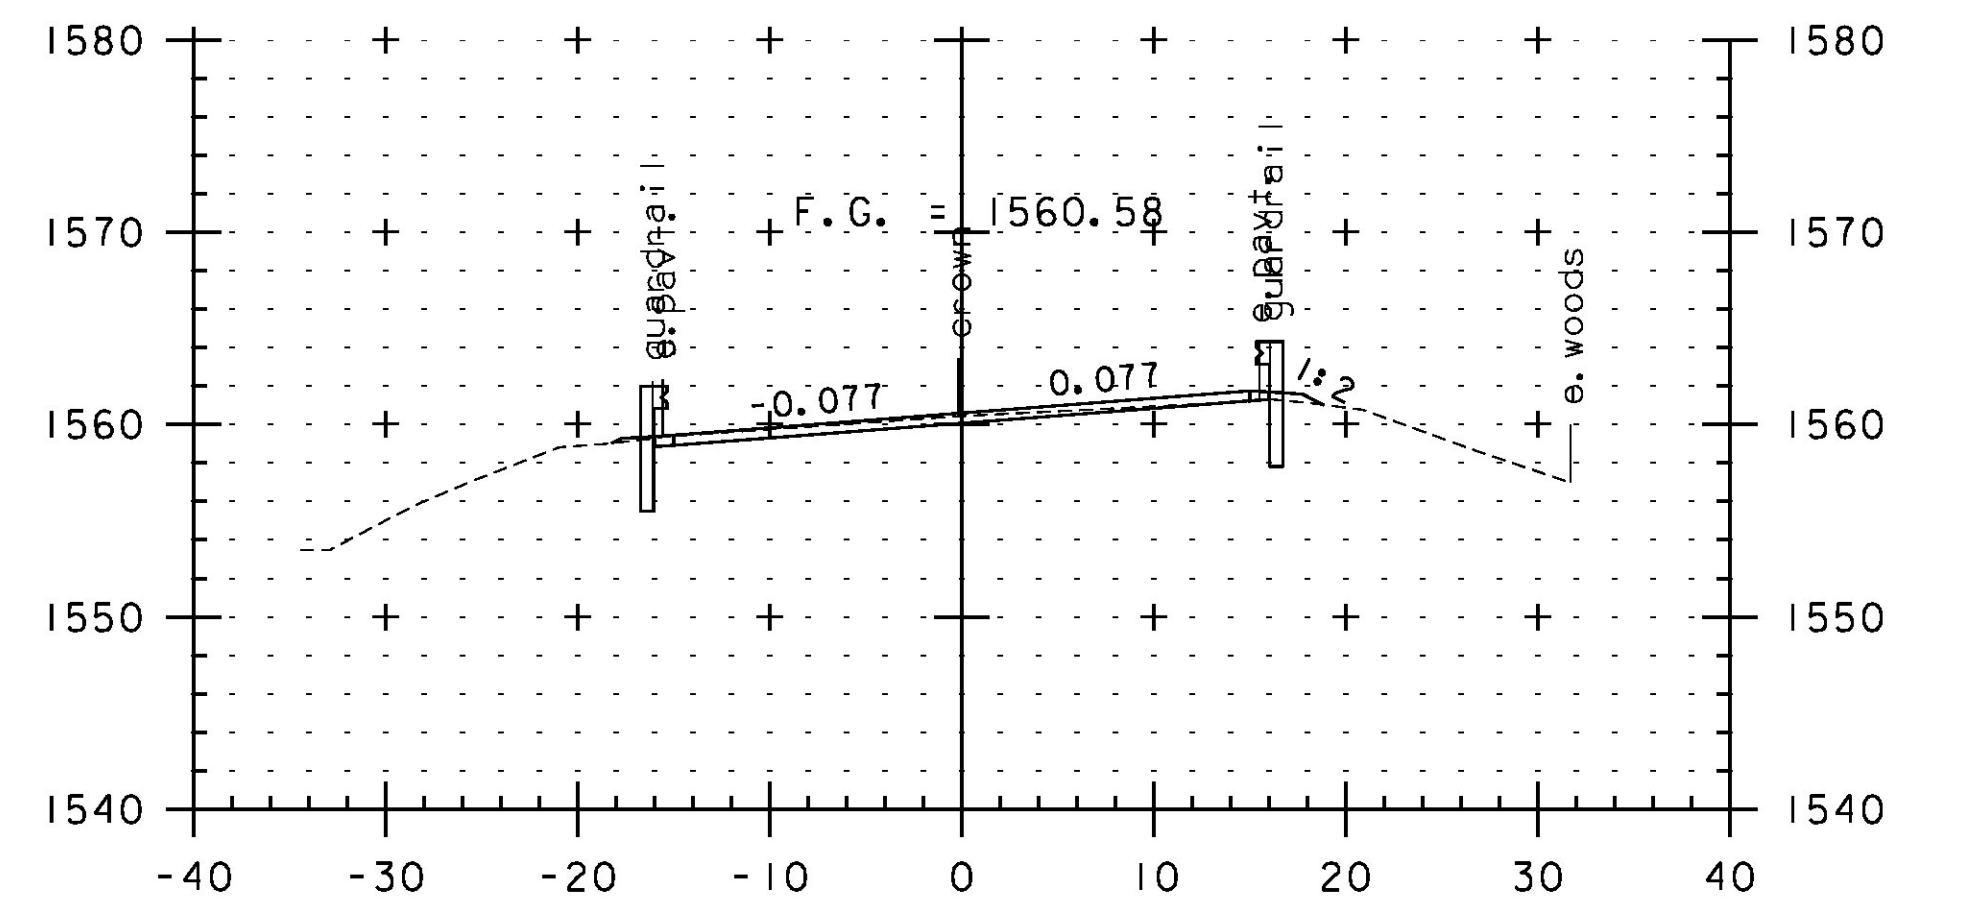


102+00

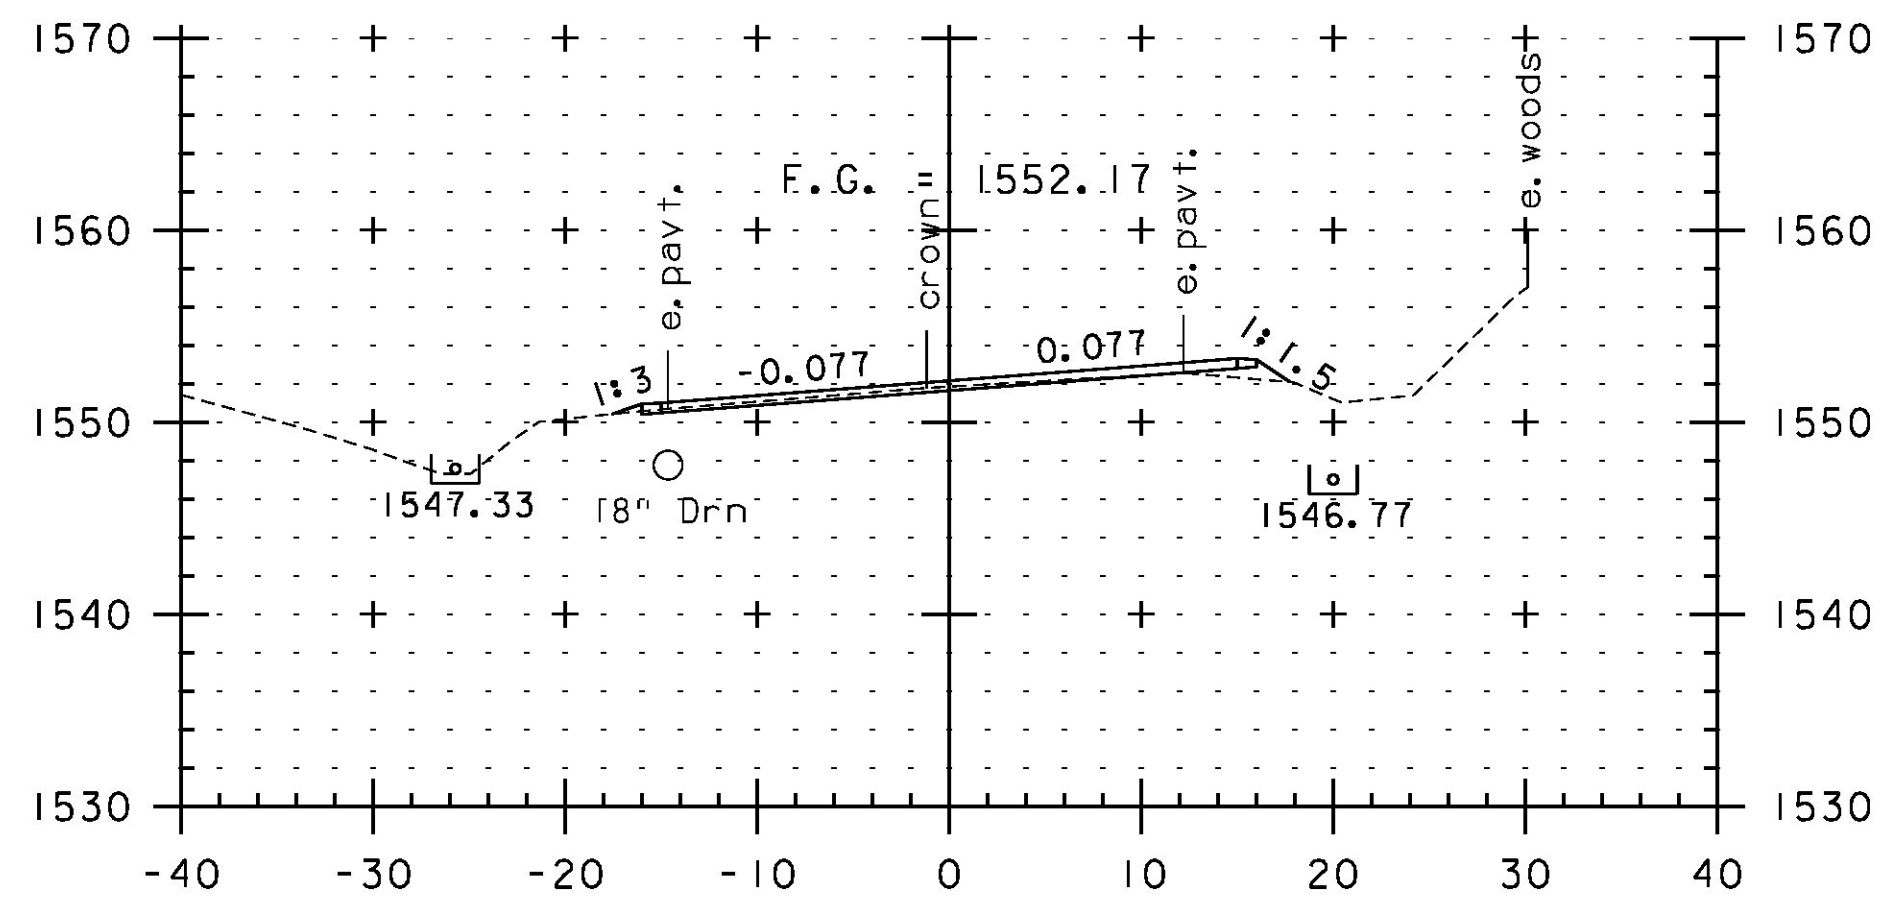


98+50

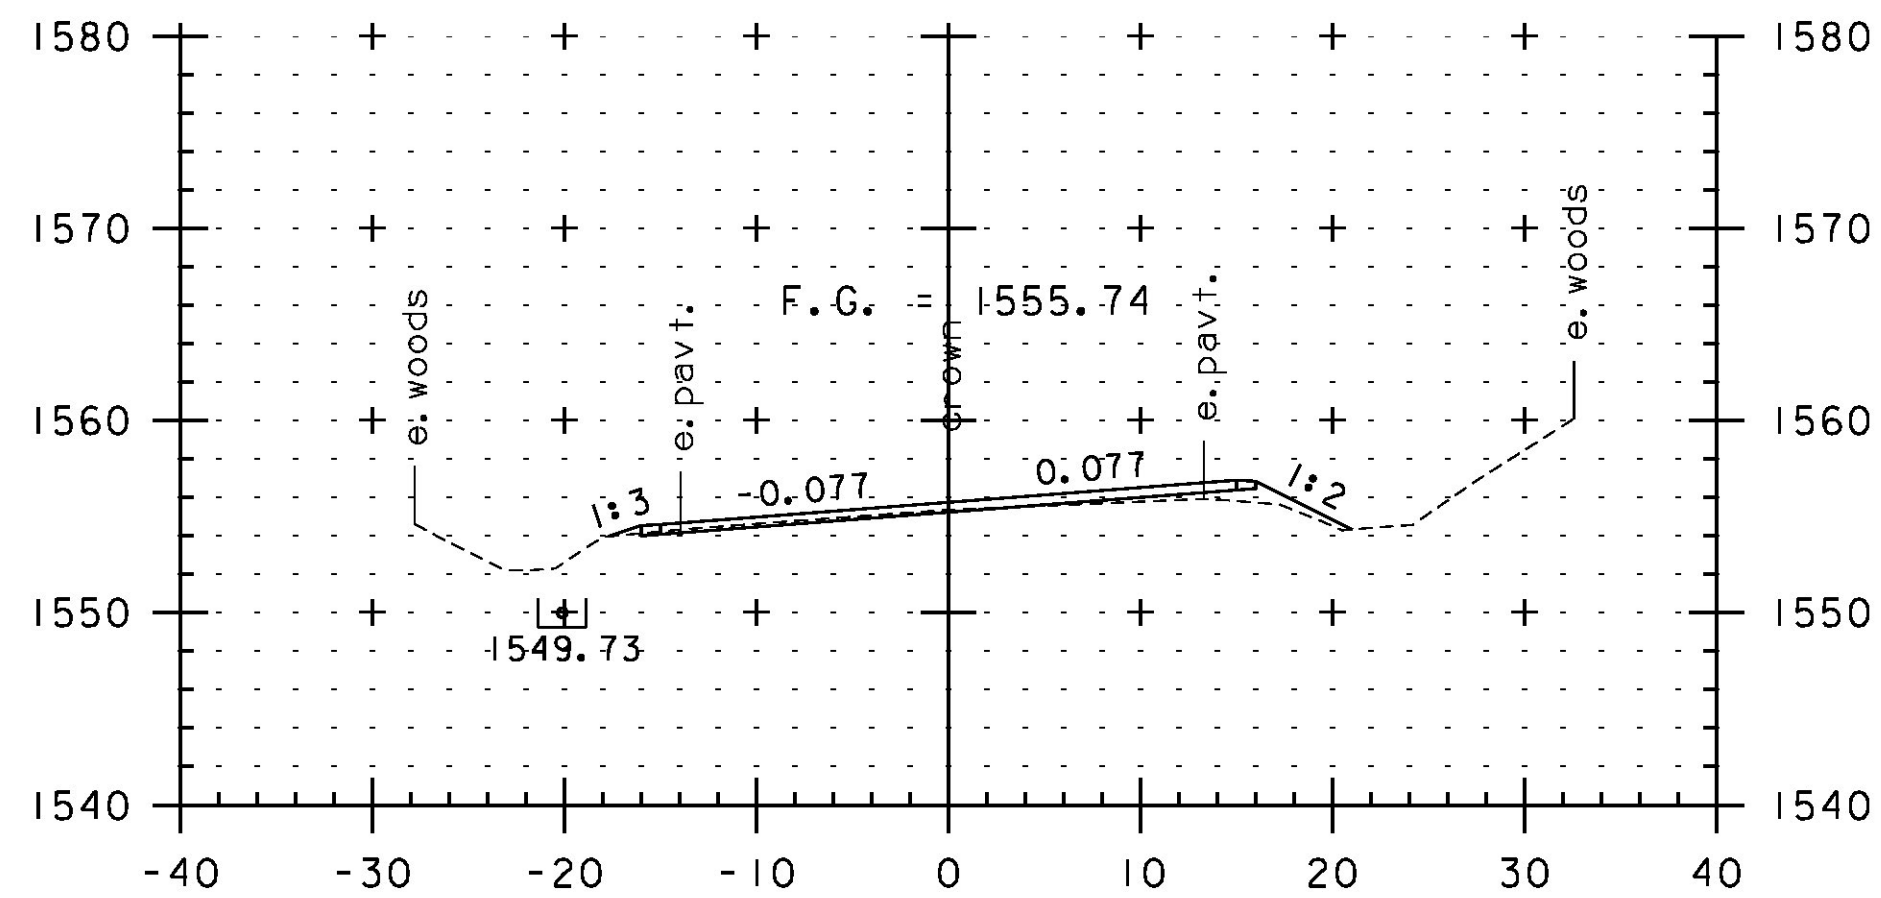


100+00

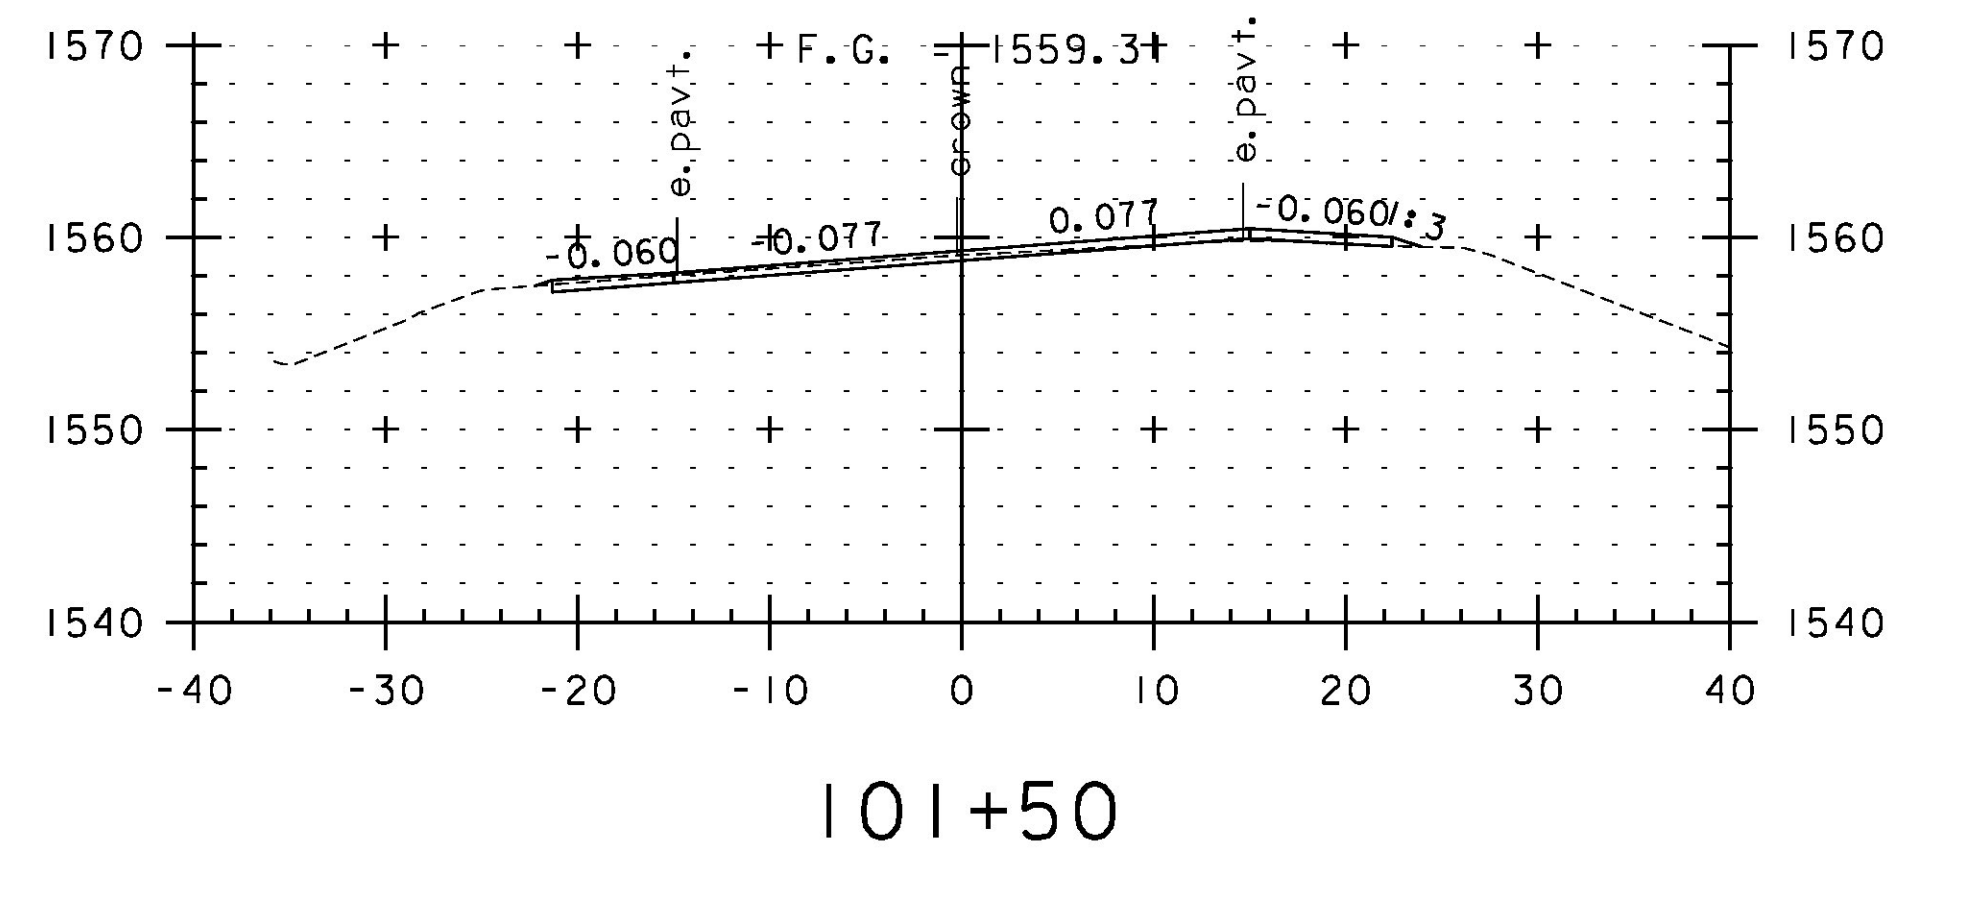


101+50

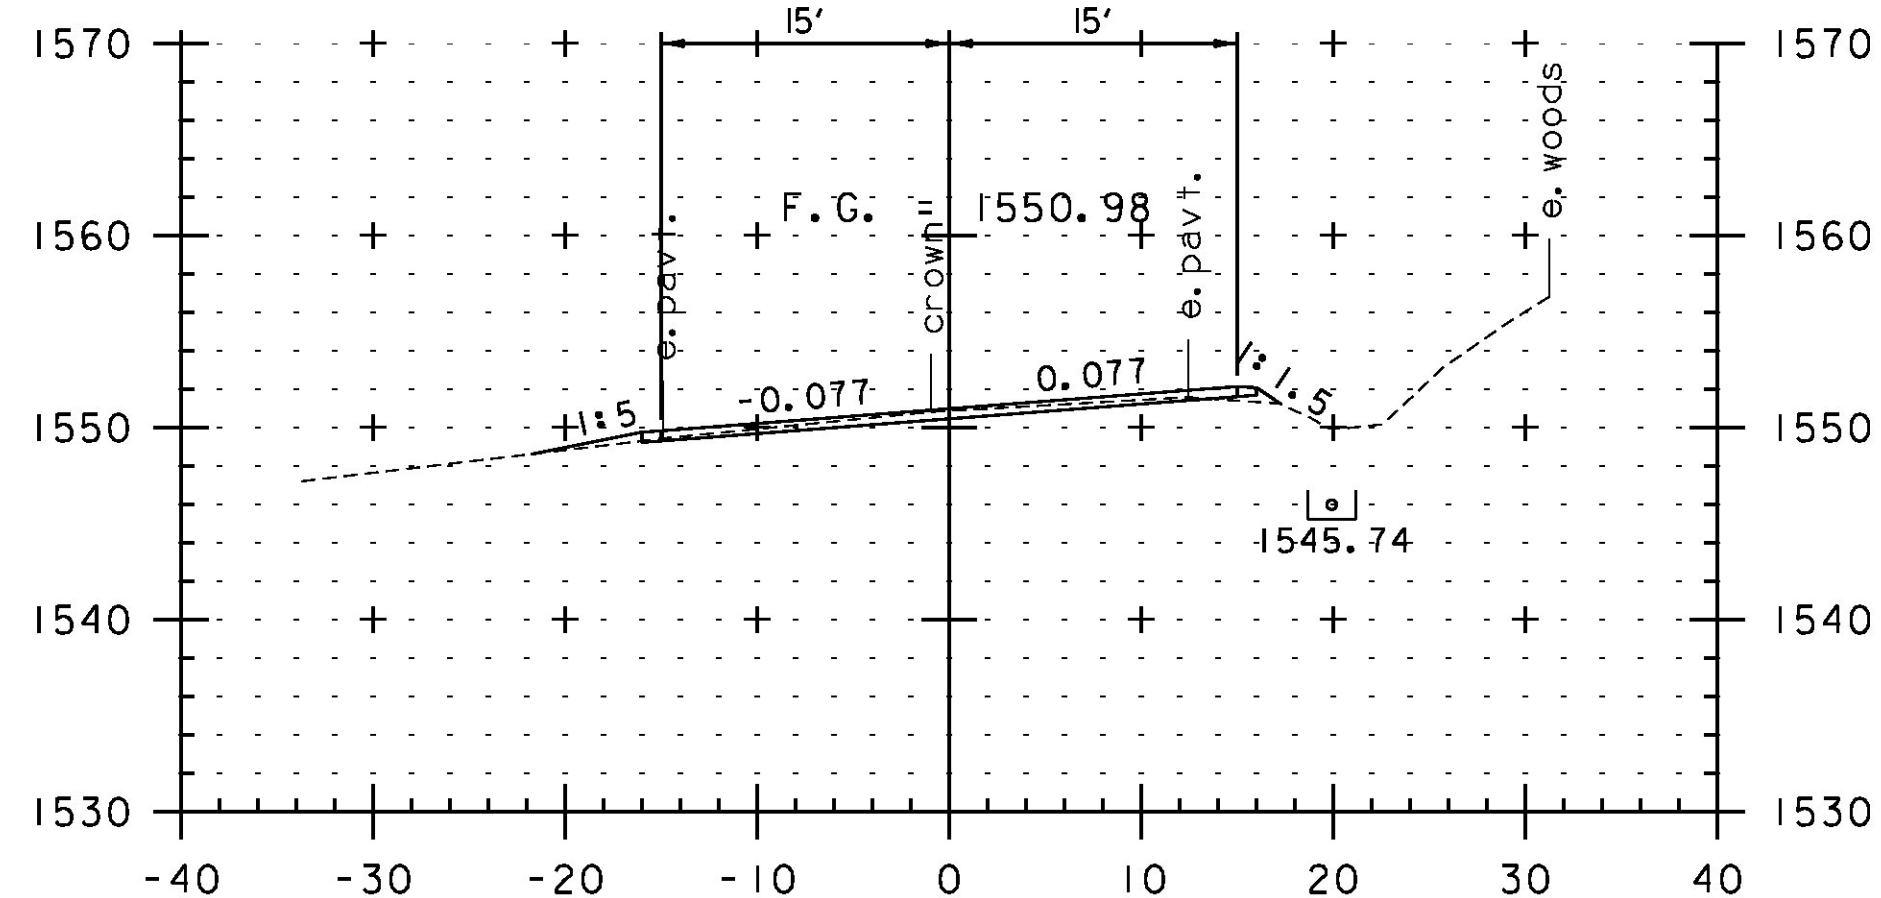

98+00

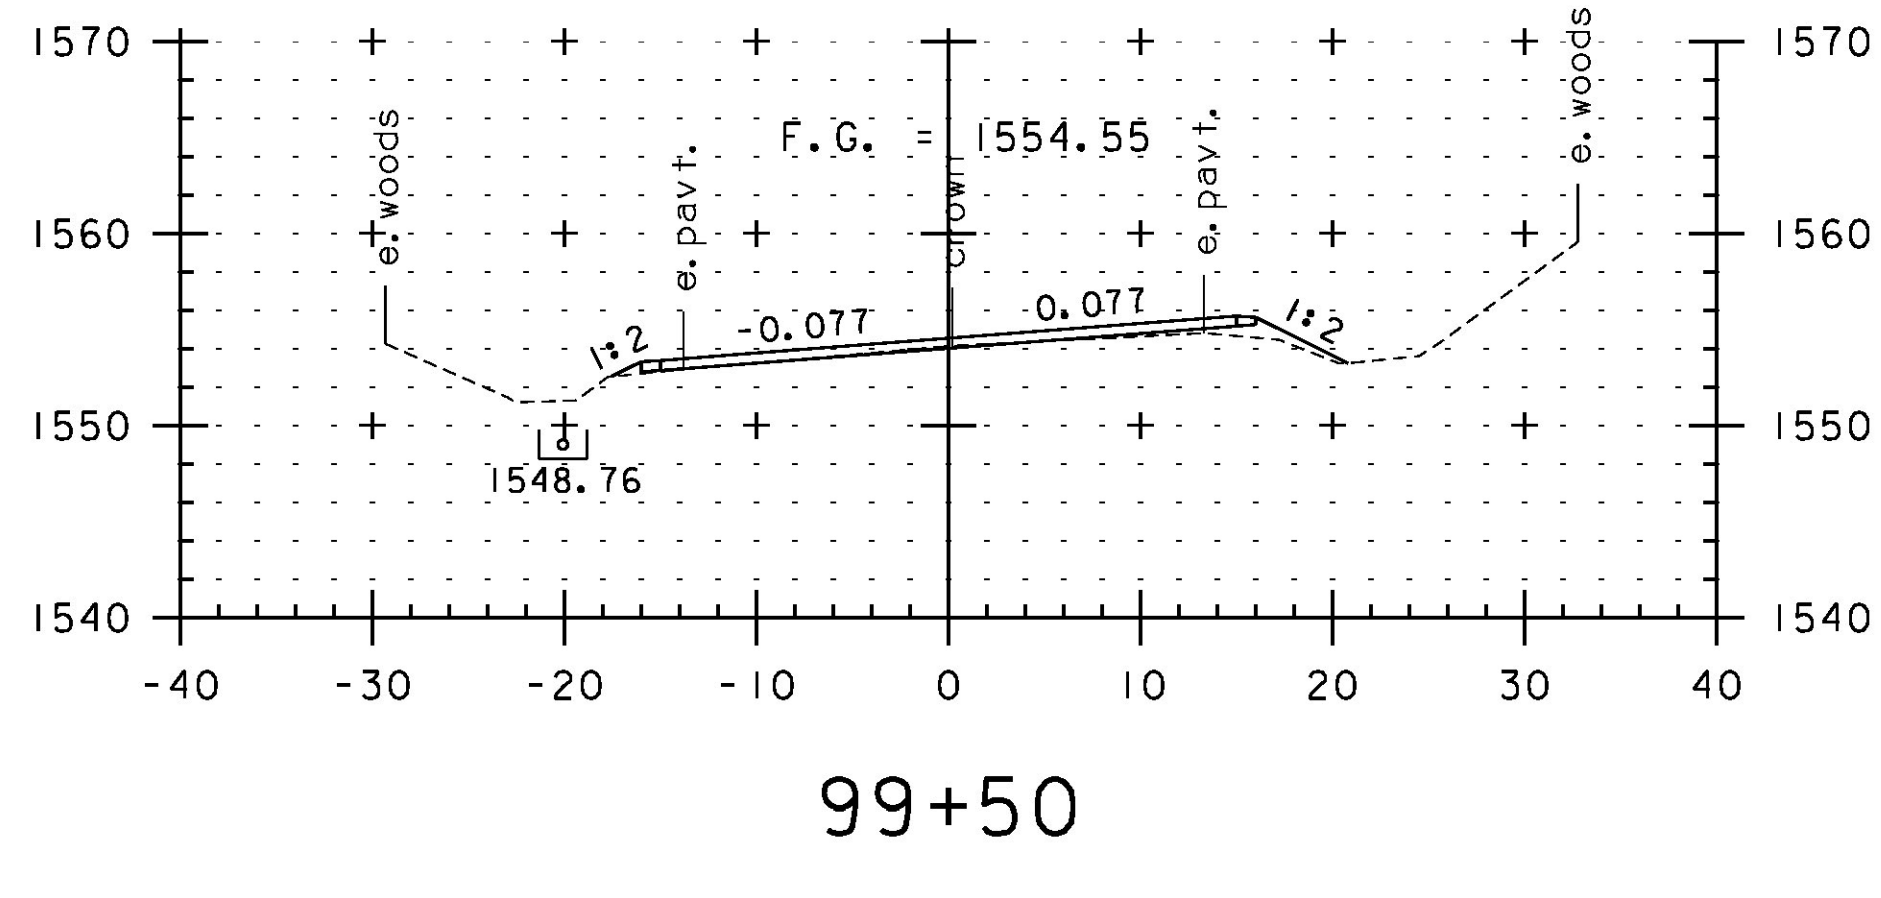

99+50

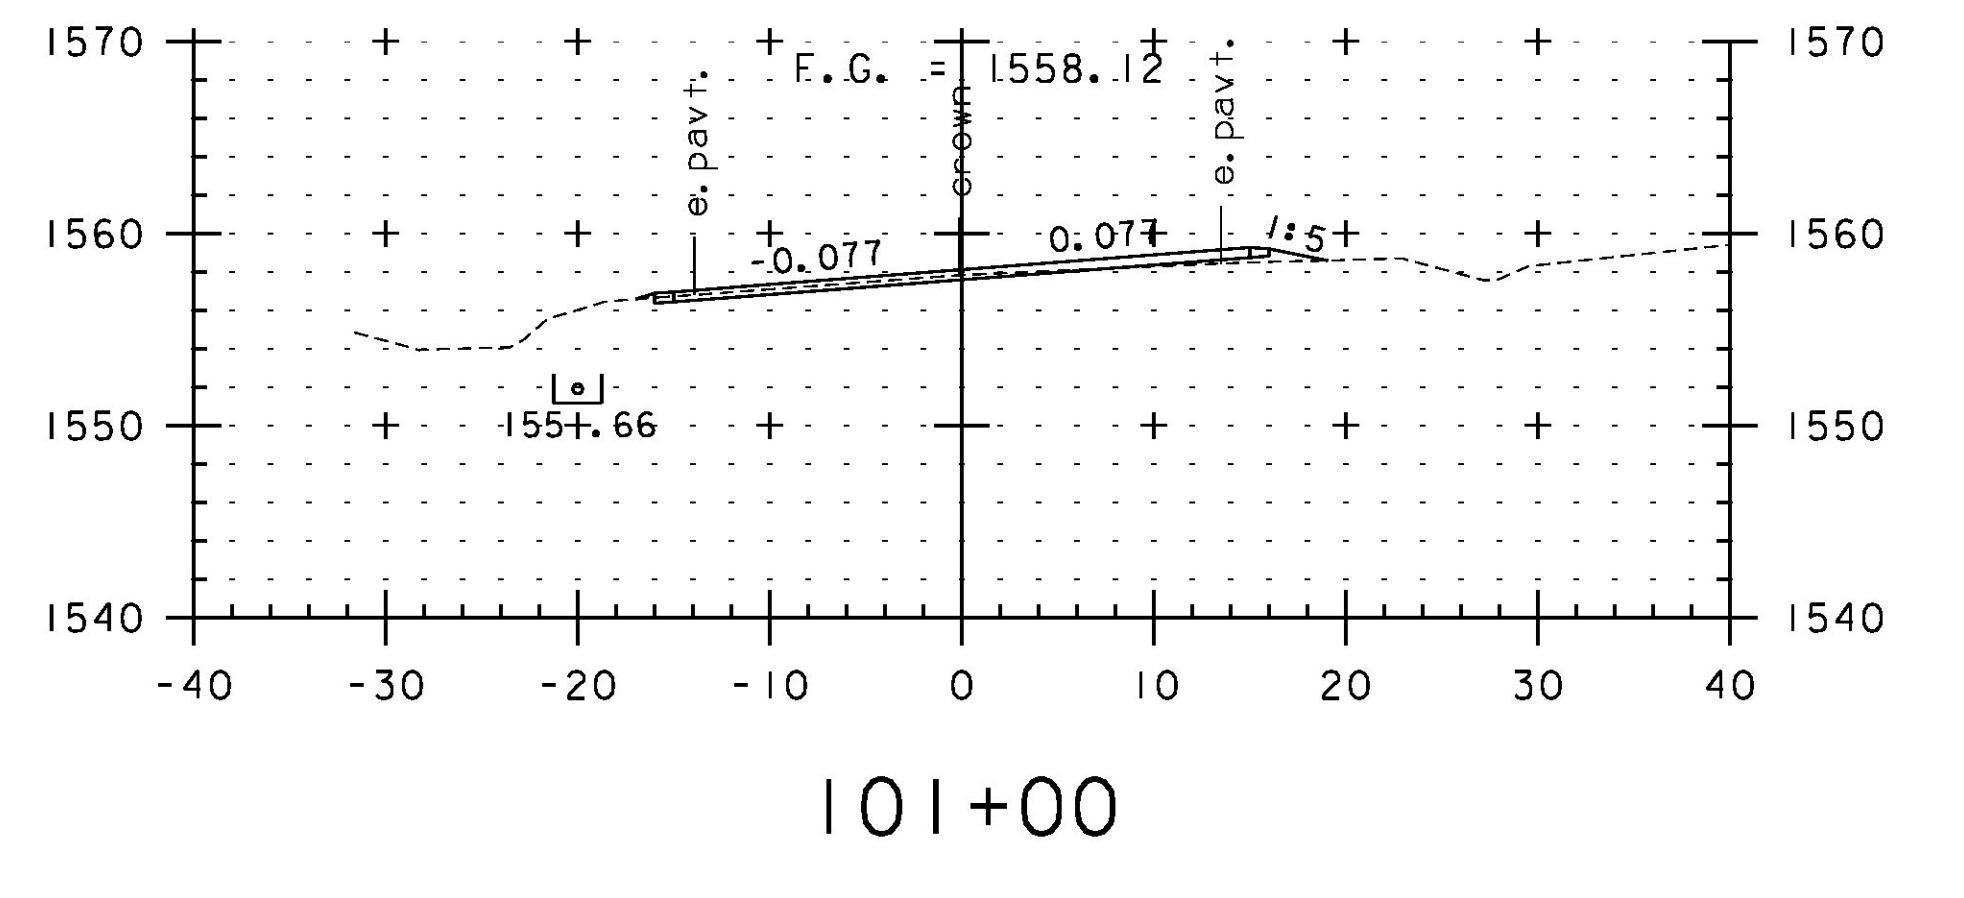

101+00



SCALE IN FEET

STA. 98+00 TO STA. 102+00

PROJECT NAME: JAY-TROY
PROJECT NUMBER: STP 2315(I)

FILE NAME: z10b232xs.dgn
PROJECT LEADER: P. SHEDD
DESIGNED BY: N. LEMAY
CROSS SECTION SHEET 15

PLOT DATE: 5/16/2014
DRAWN BY: W. GORDON
CHECKED BY: P. SHEDD
SHEET 151 OF 244