




103+50

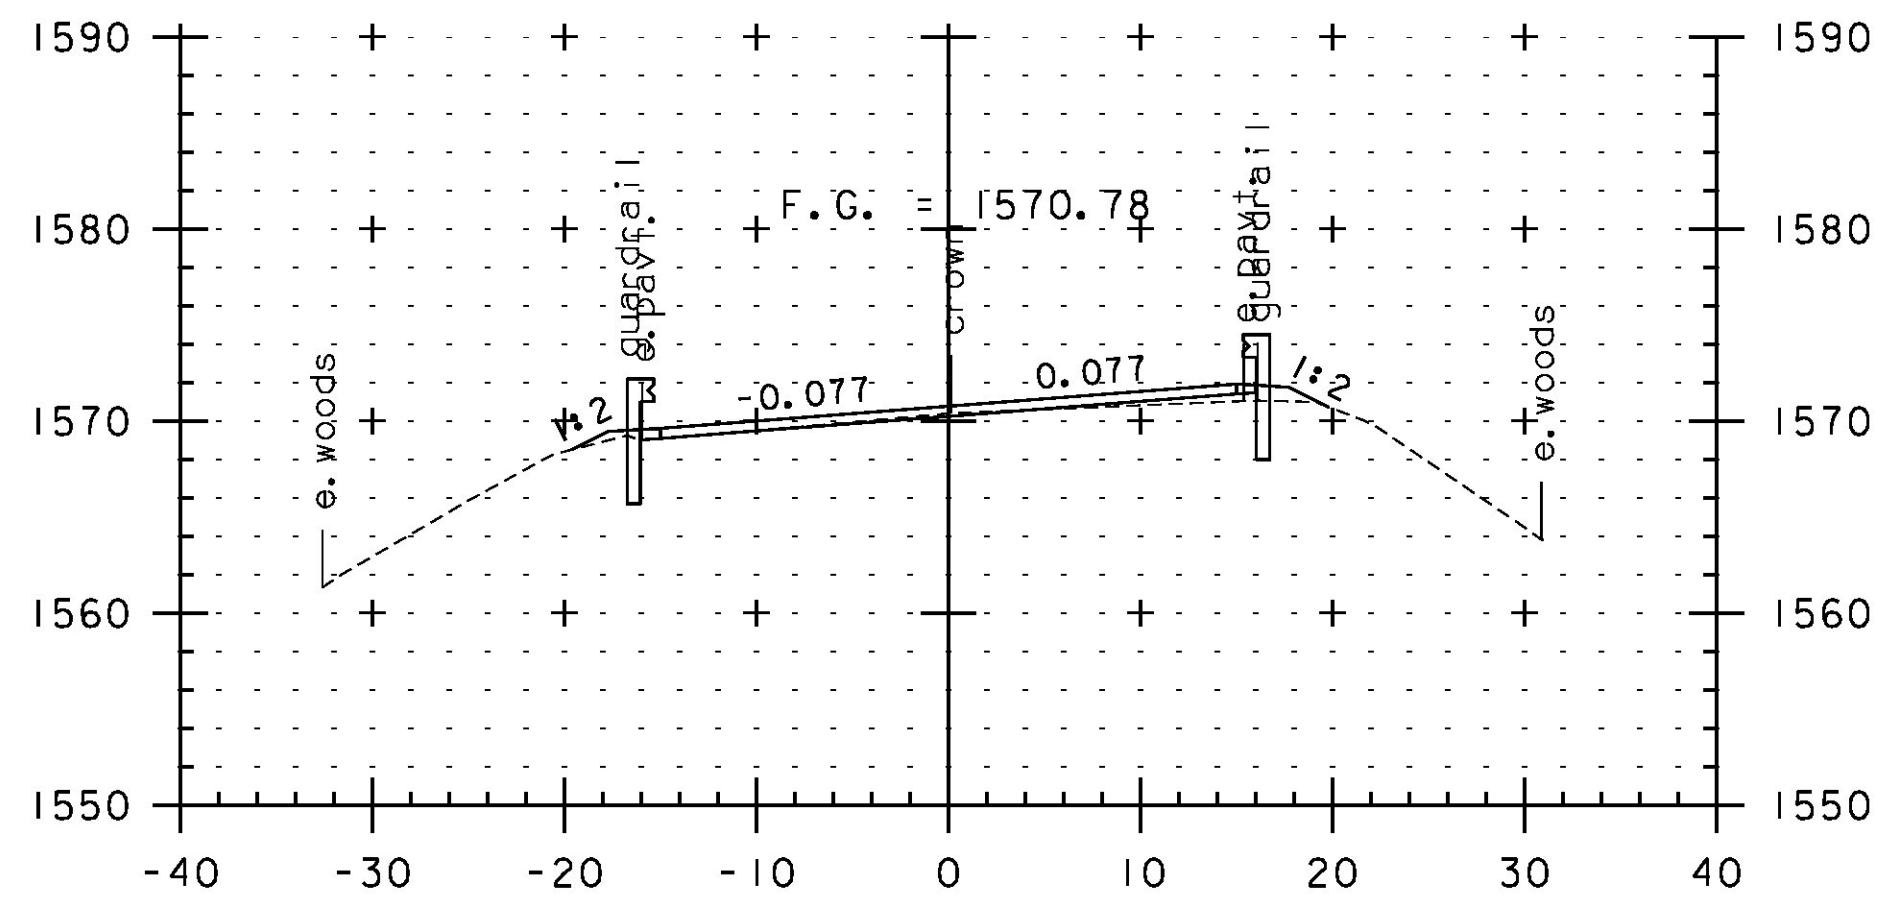


104+50

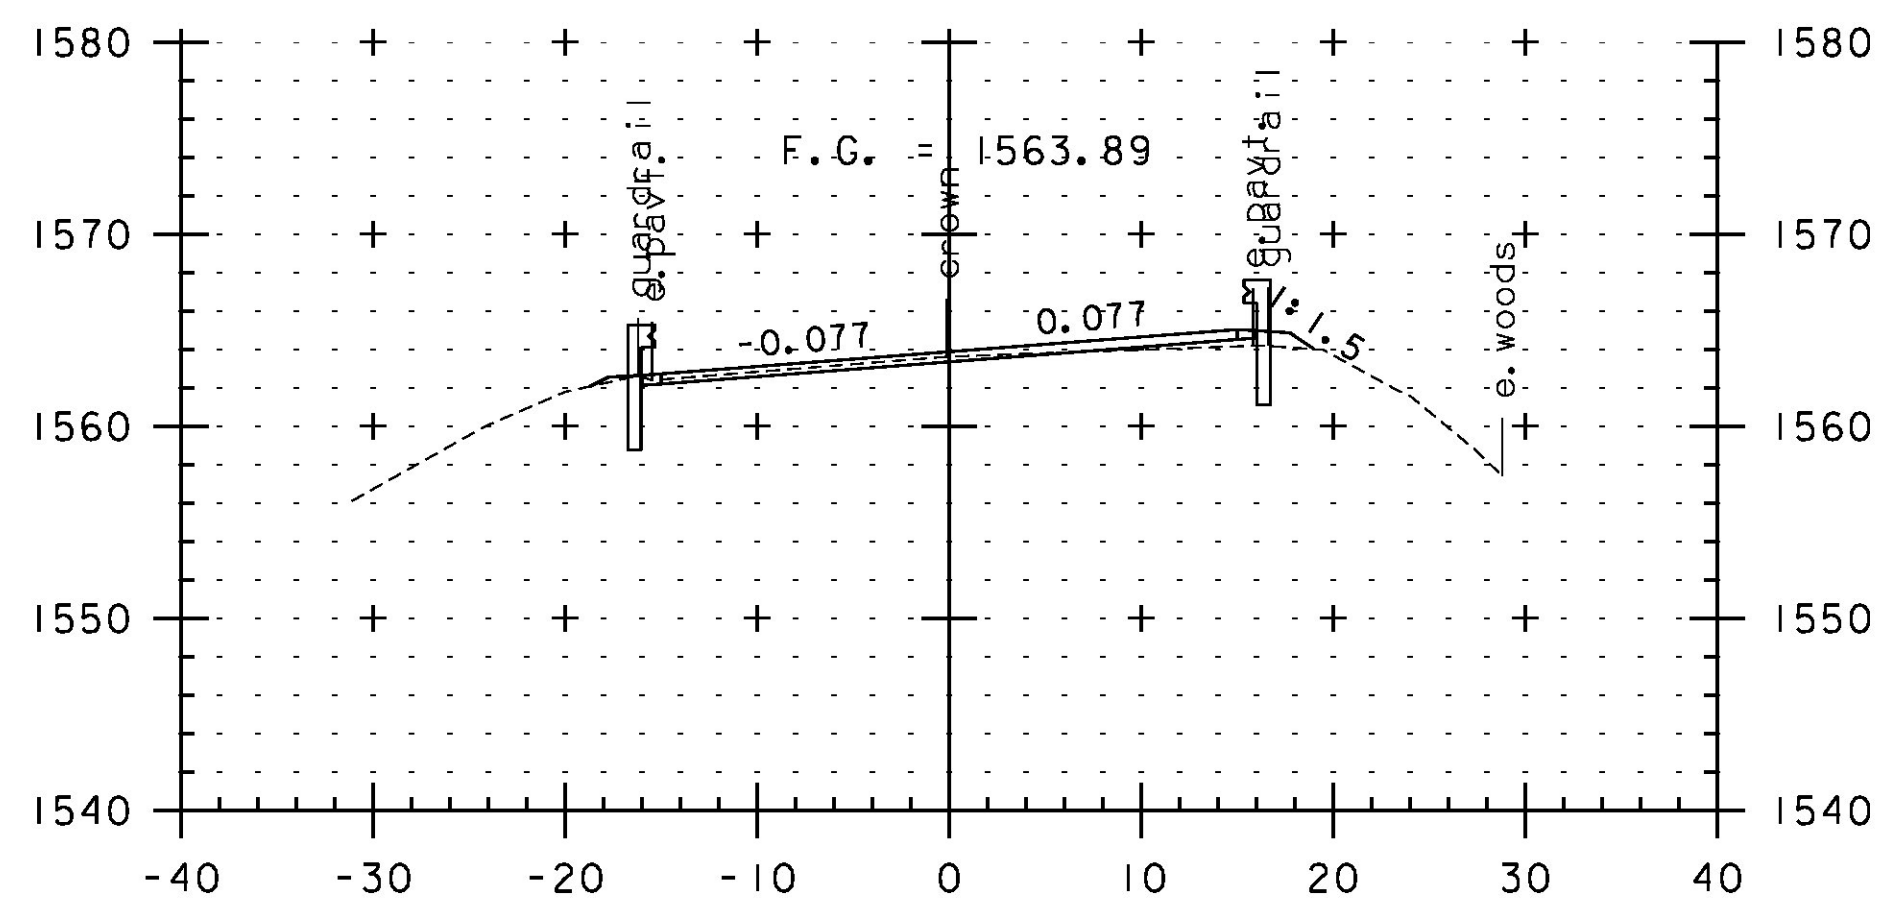


103+00

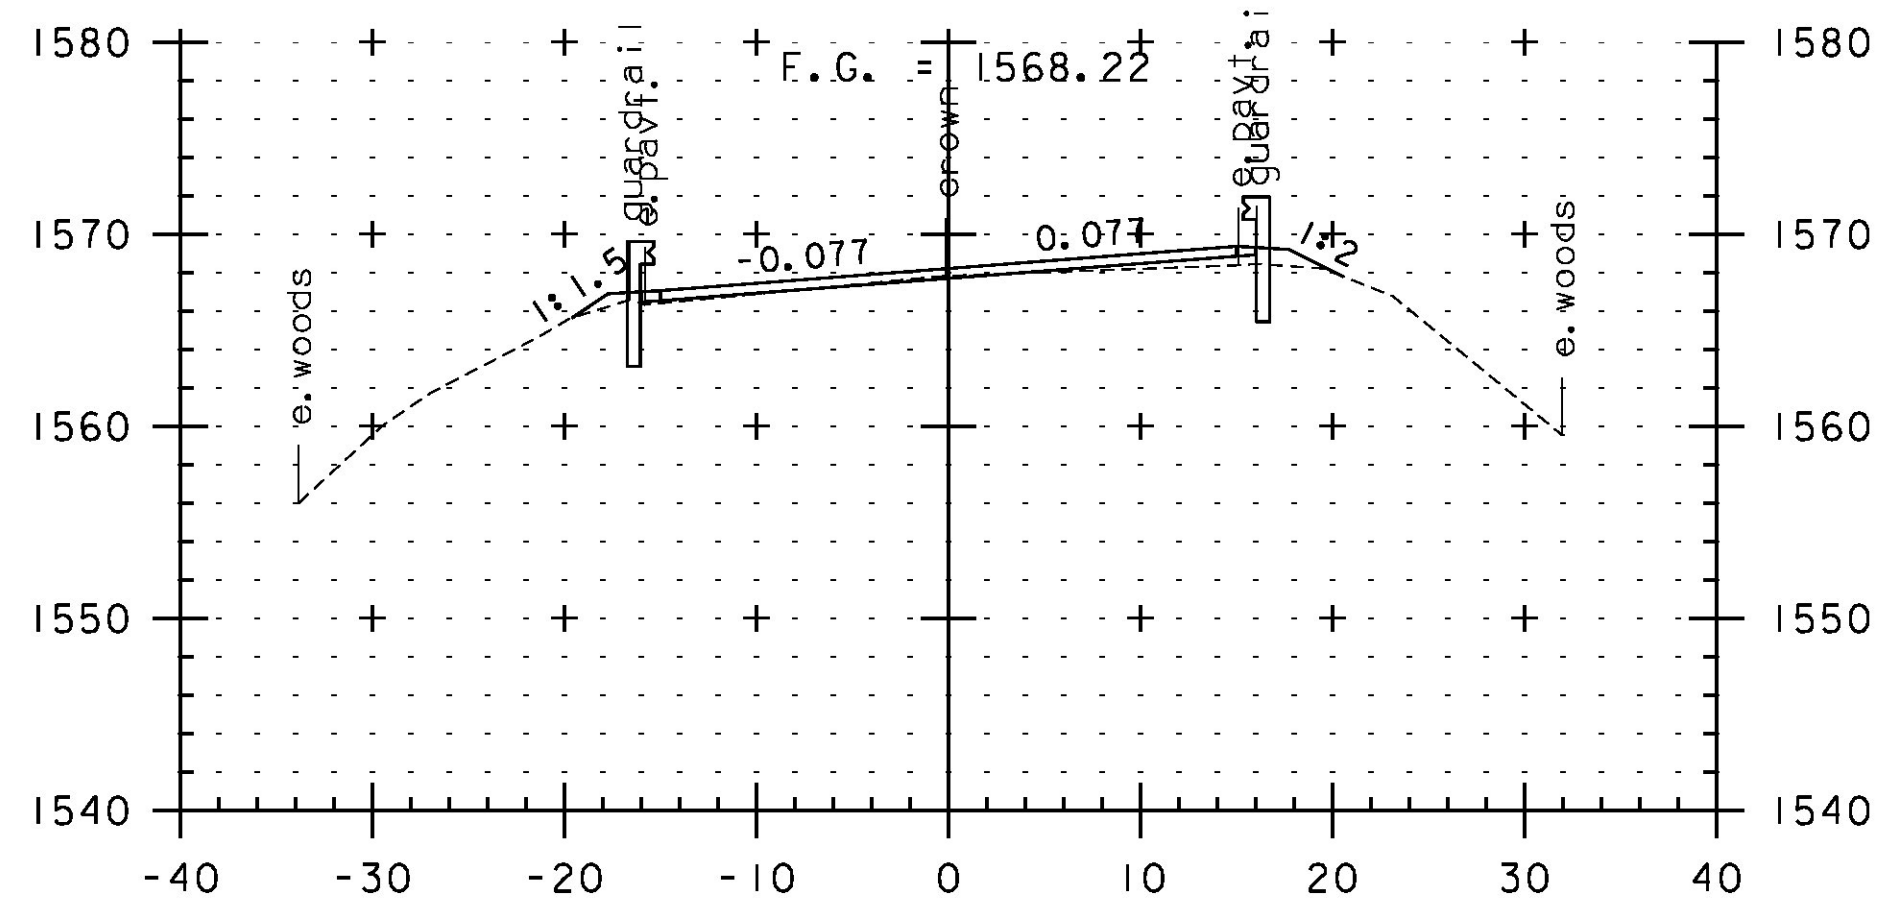


104+00

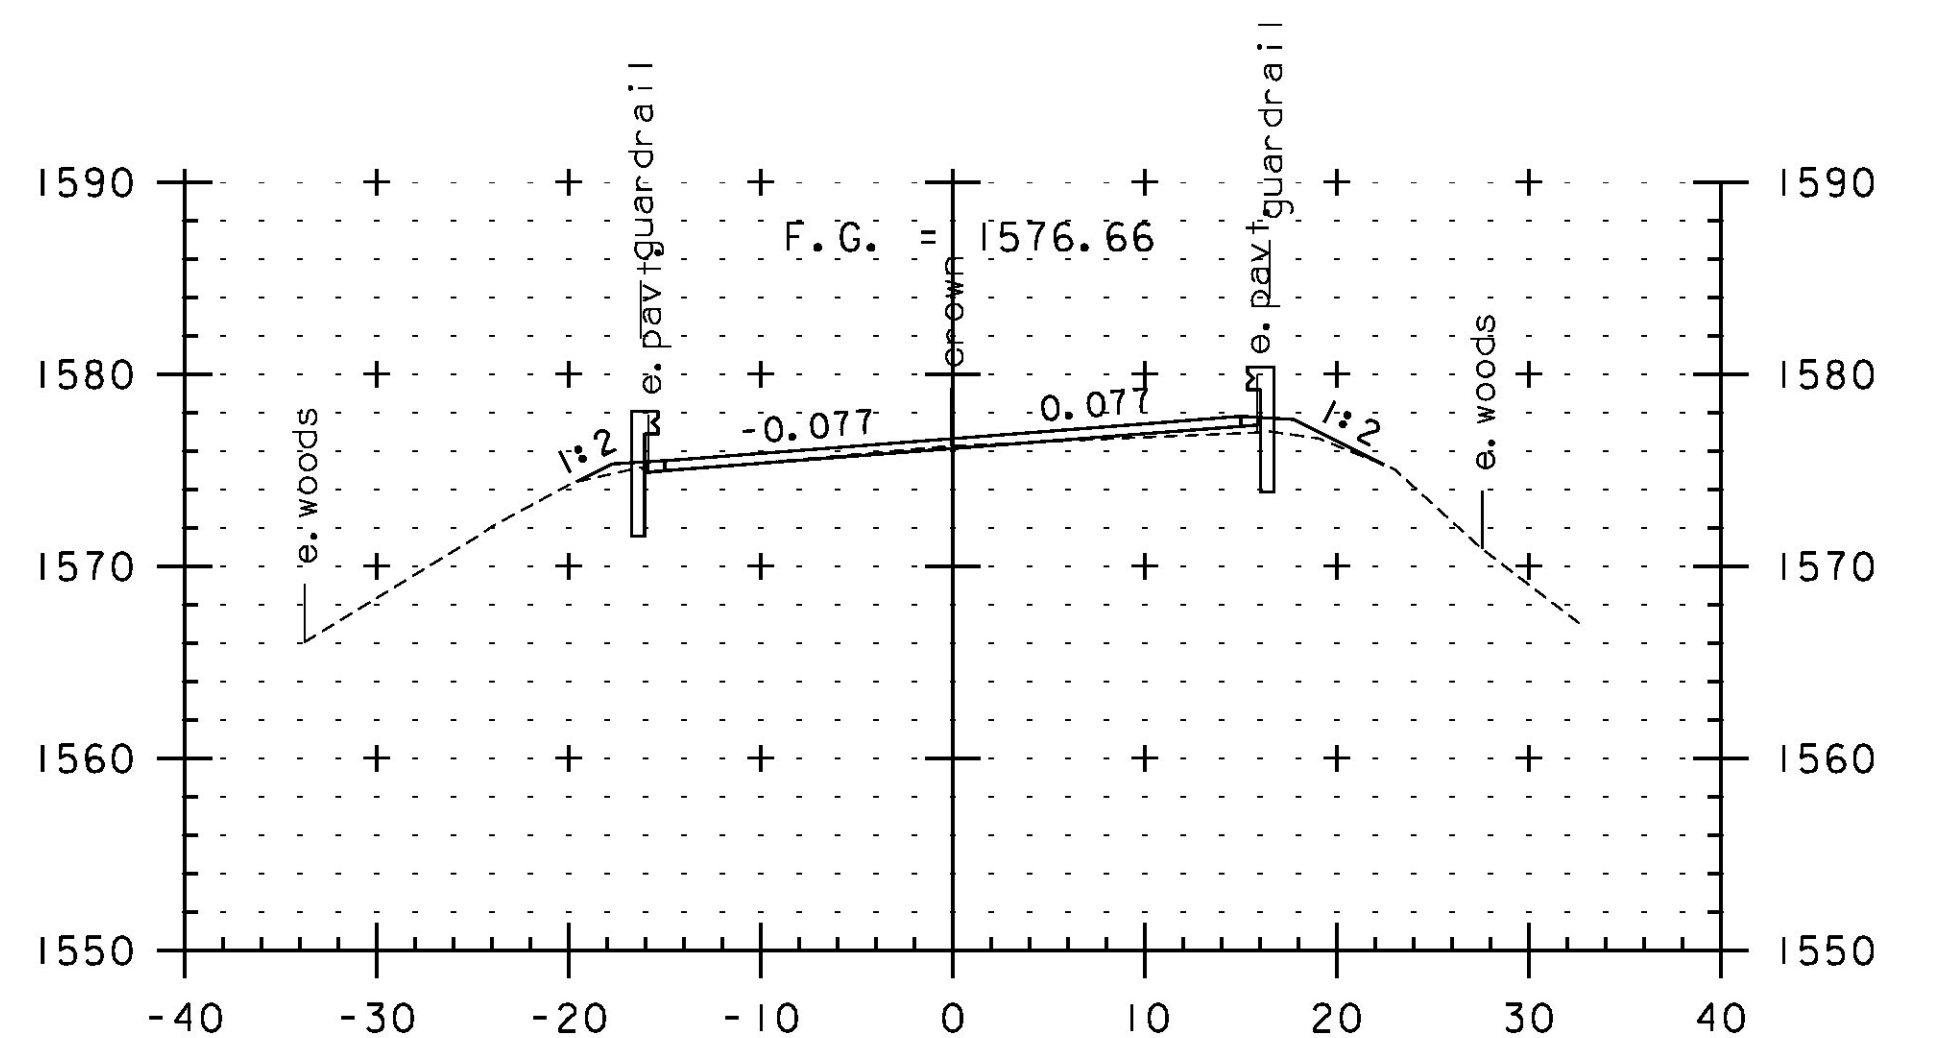


105+50

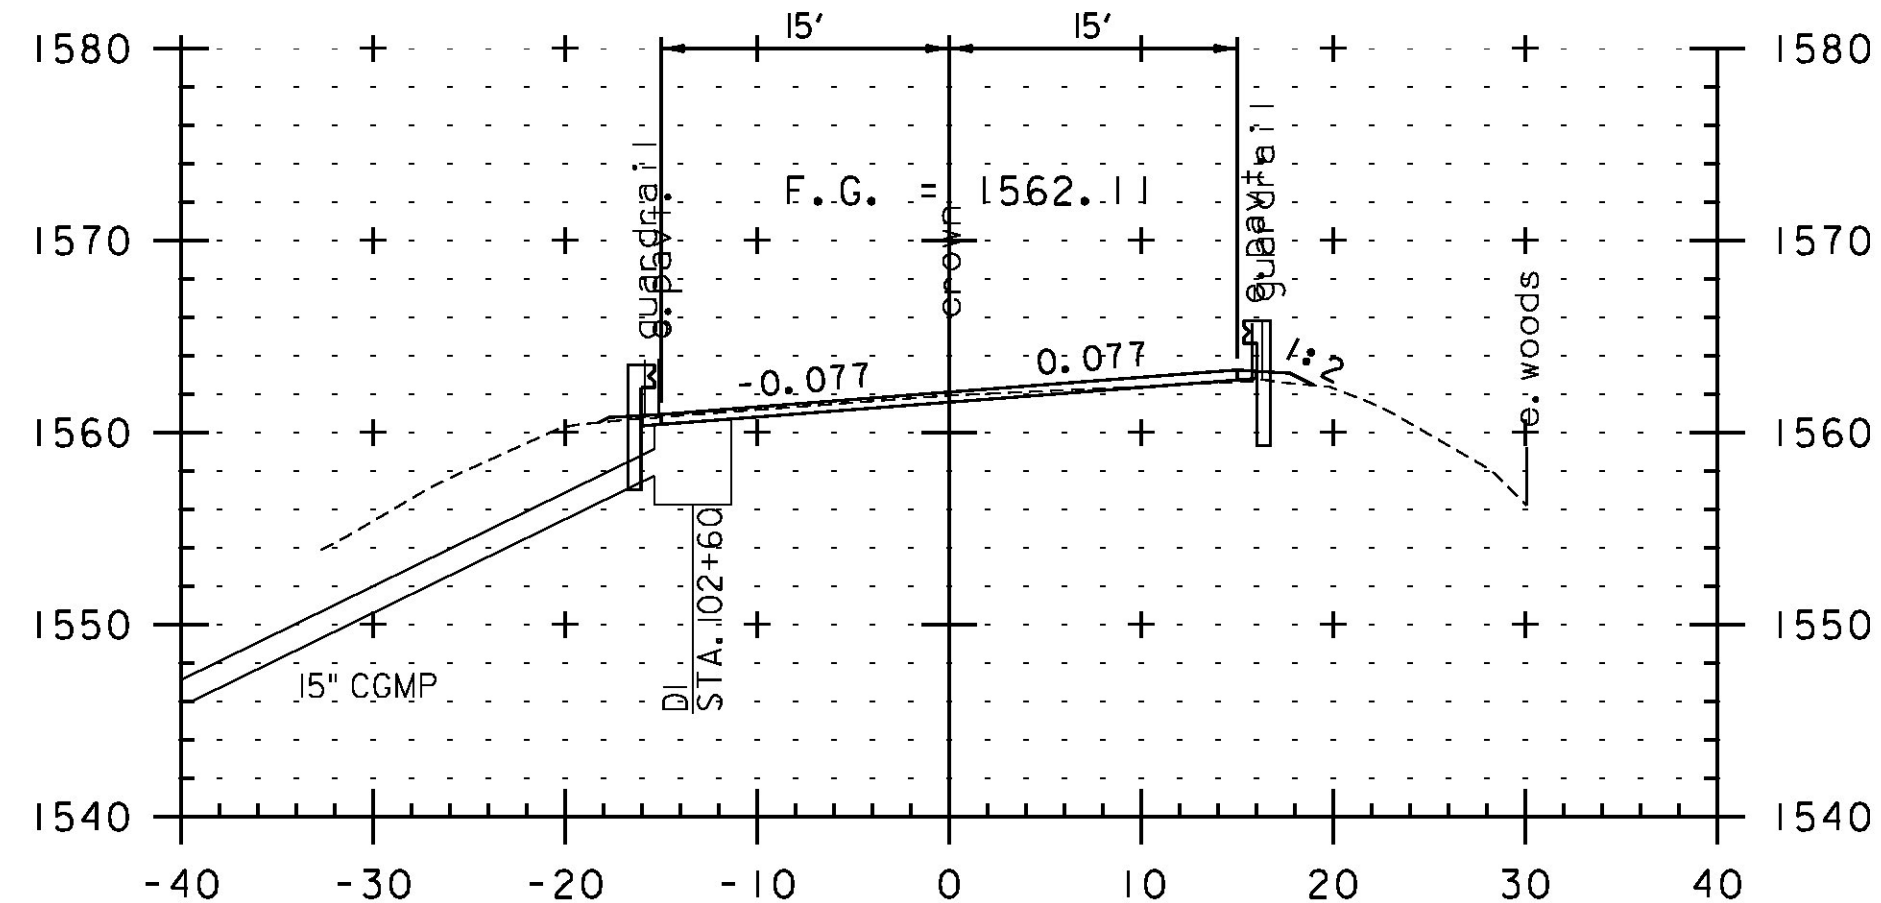


102+50

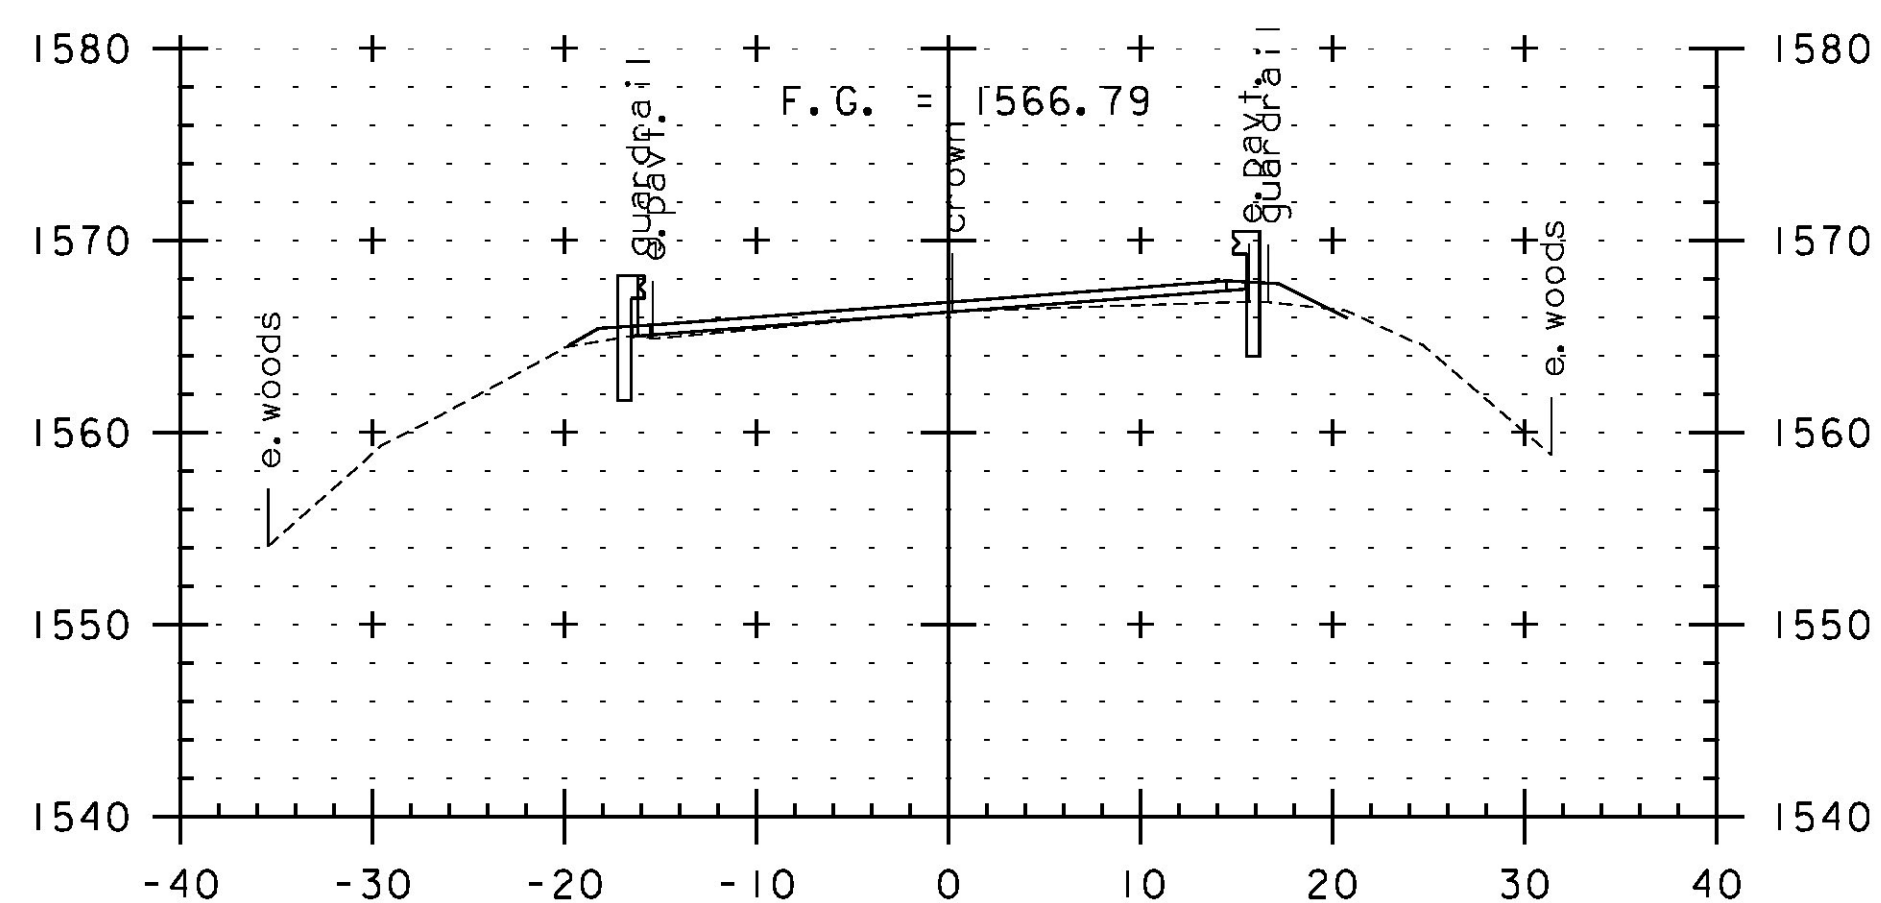

103+68
BRIDGE 46

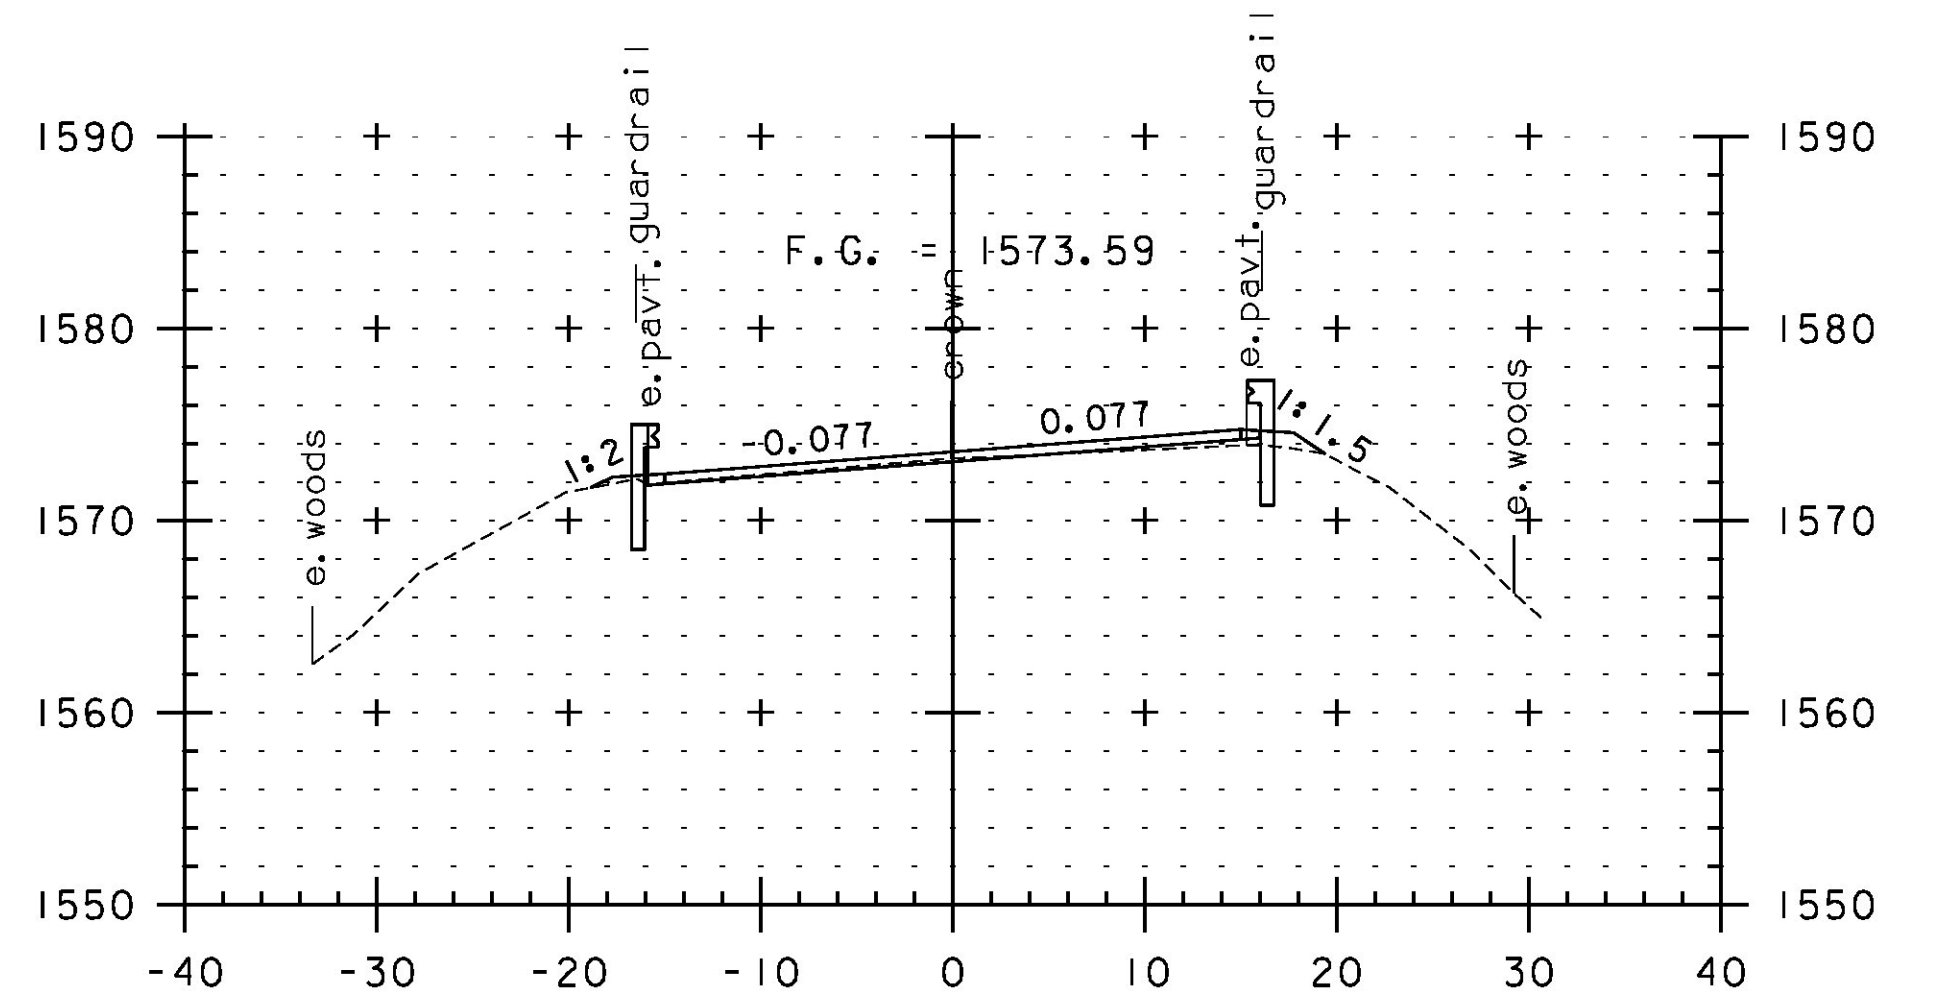

105+00

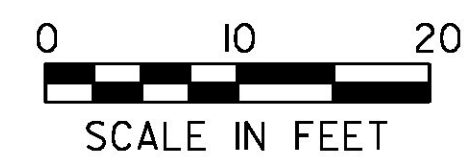

STA. 102+50 TO STA. 105+50

PROJECT NAME:	JAY-TROY	PLOT DATE:	5/16/2014
PROJECT NUMBER:	STP 2315(I)	DRAWN BY:	W. GORDON
FILE NAME:	z10b232xs.dgn	DESIGNED BY:	N. LEMAY
PROJECT LEADER:	P. SHEDD	CHECKED BY:	P. SHEDD
CROSS SECTION SHEET 16		SHEET	152 OF 244