






106+50

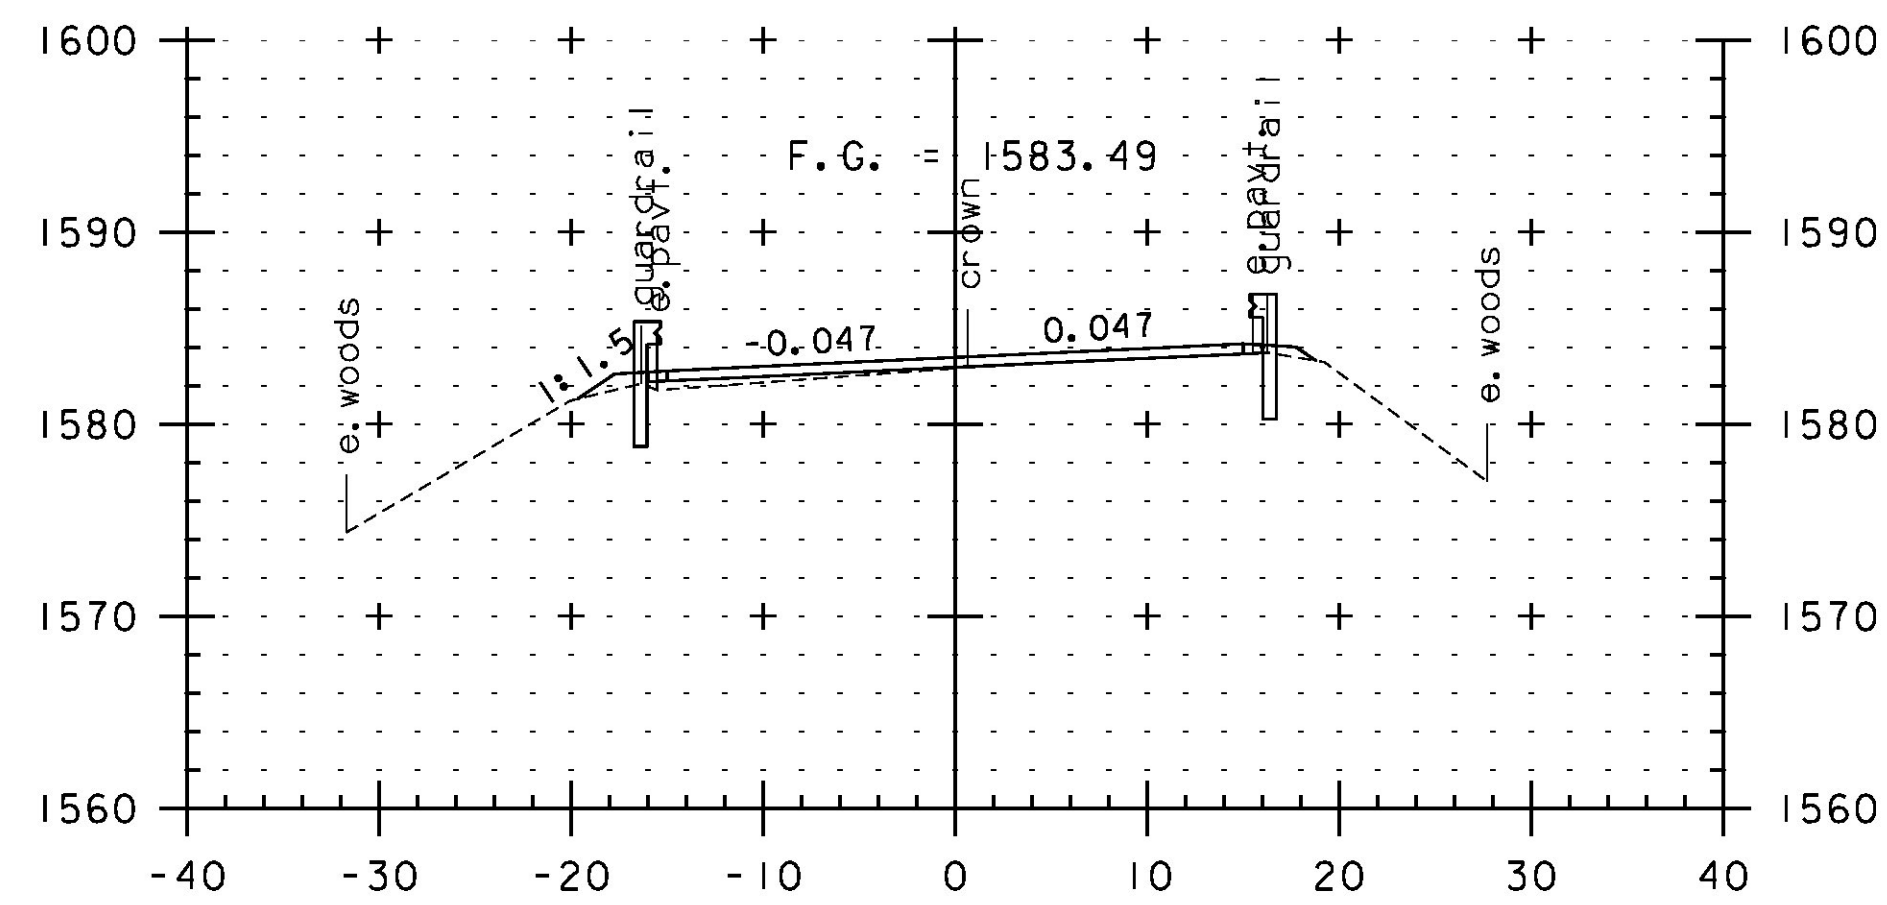


106+00

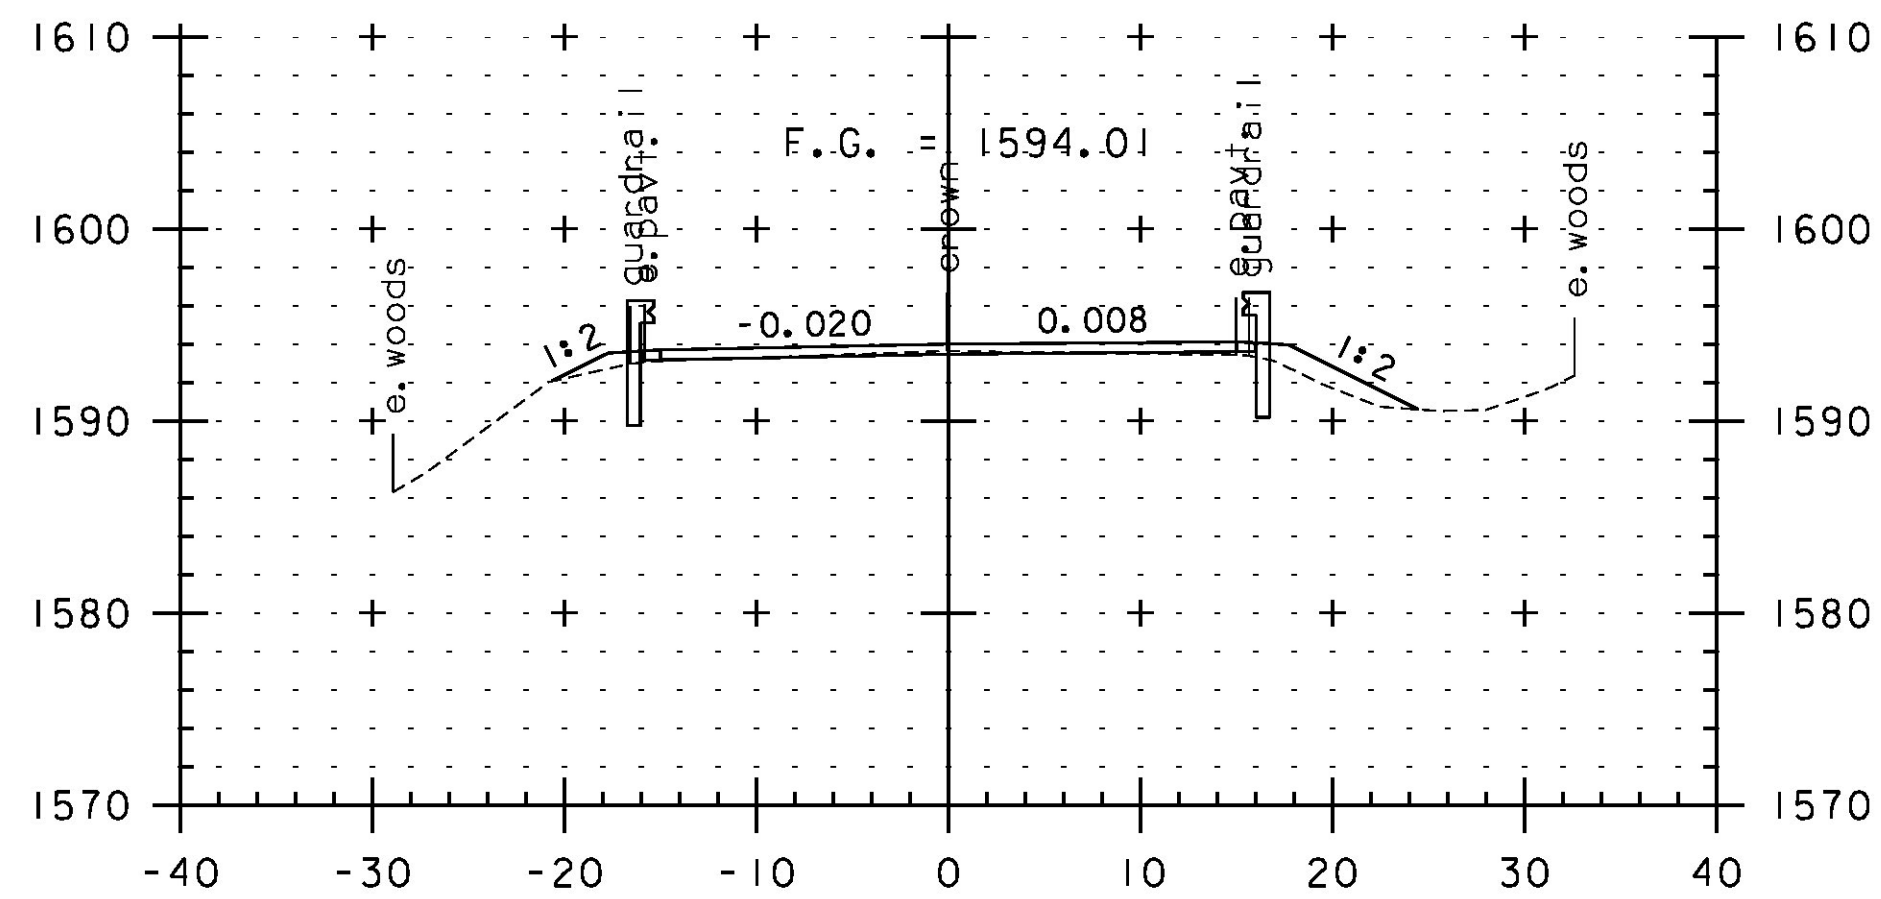


108+00

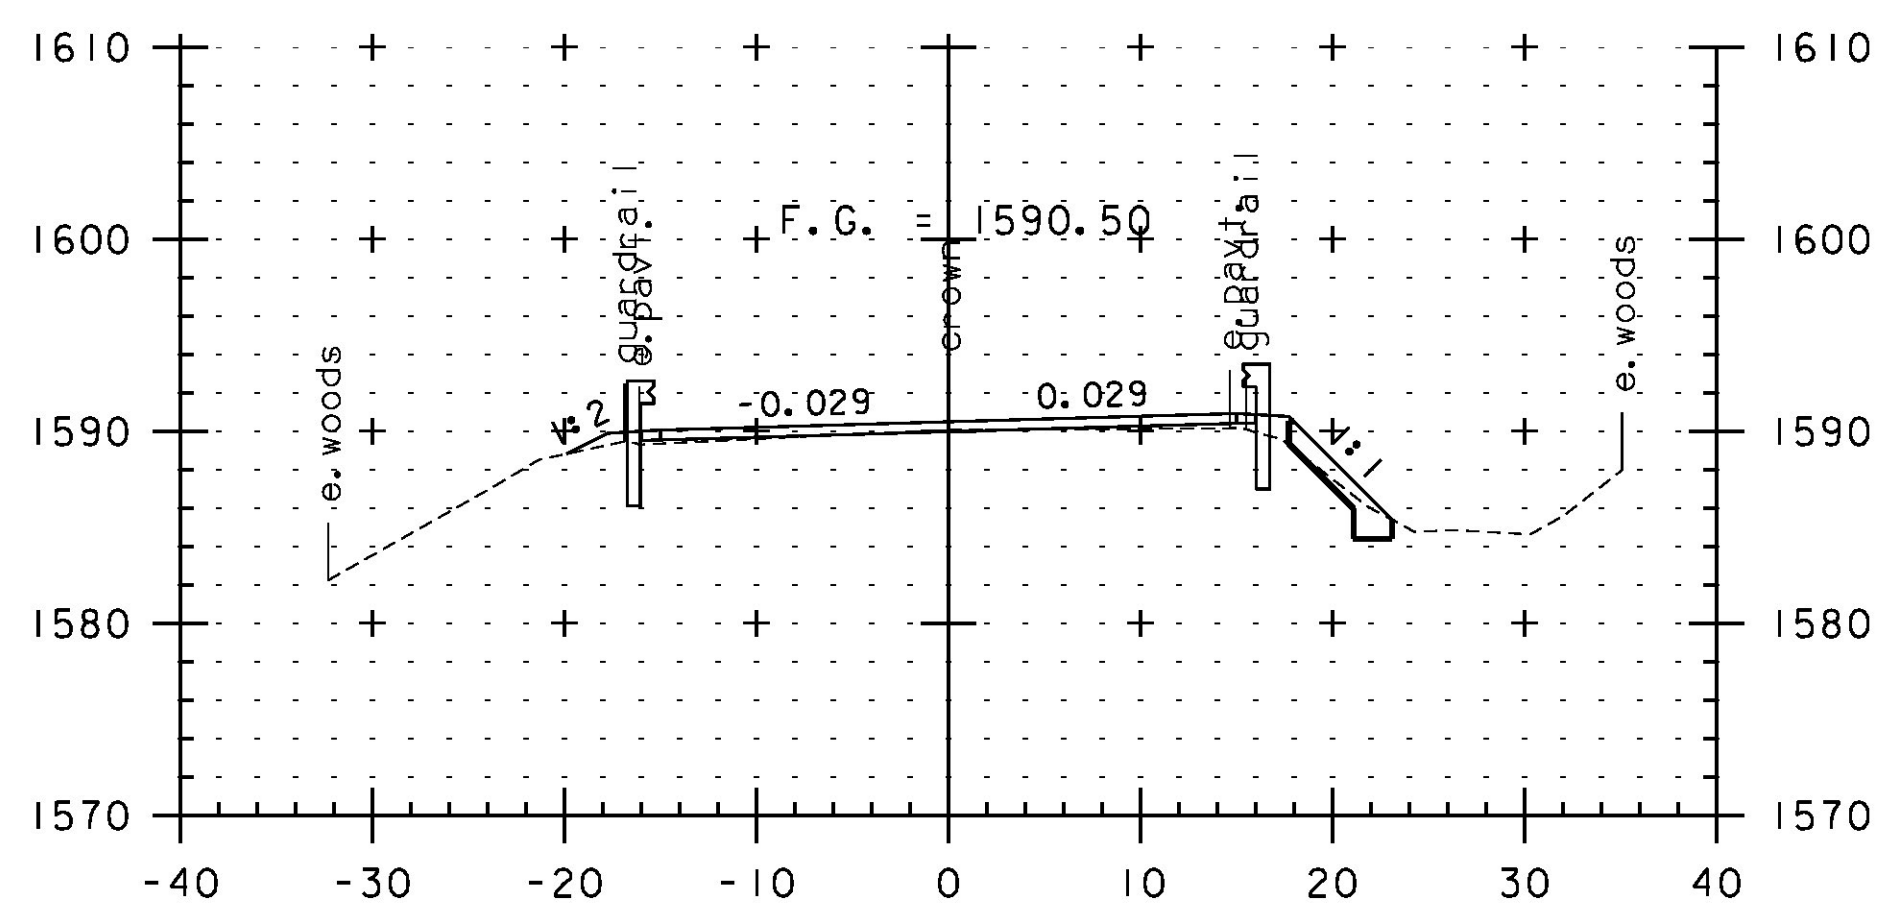


109+00

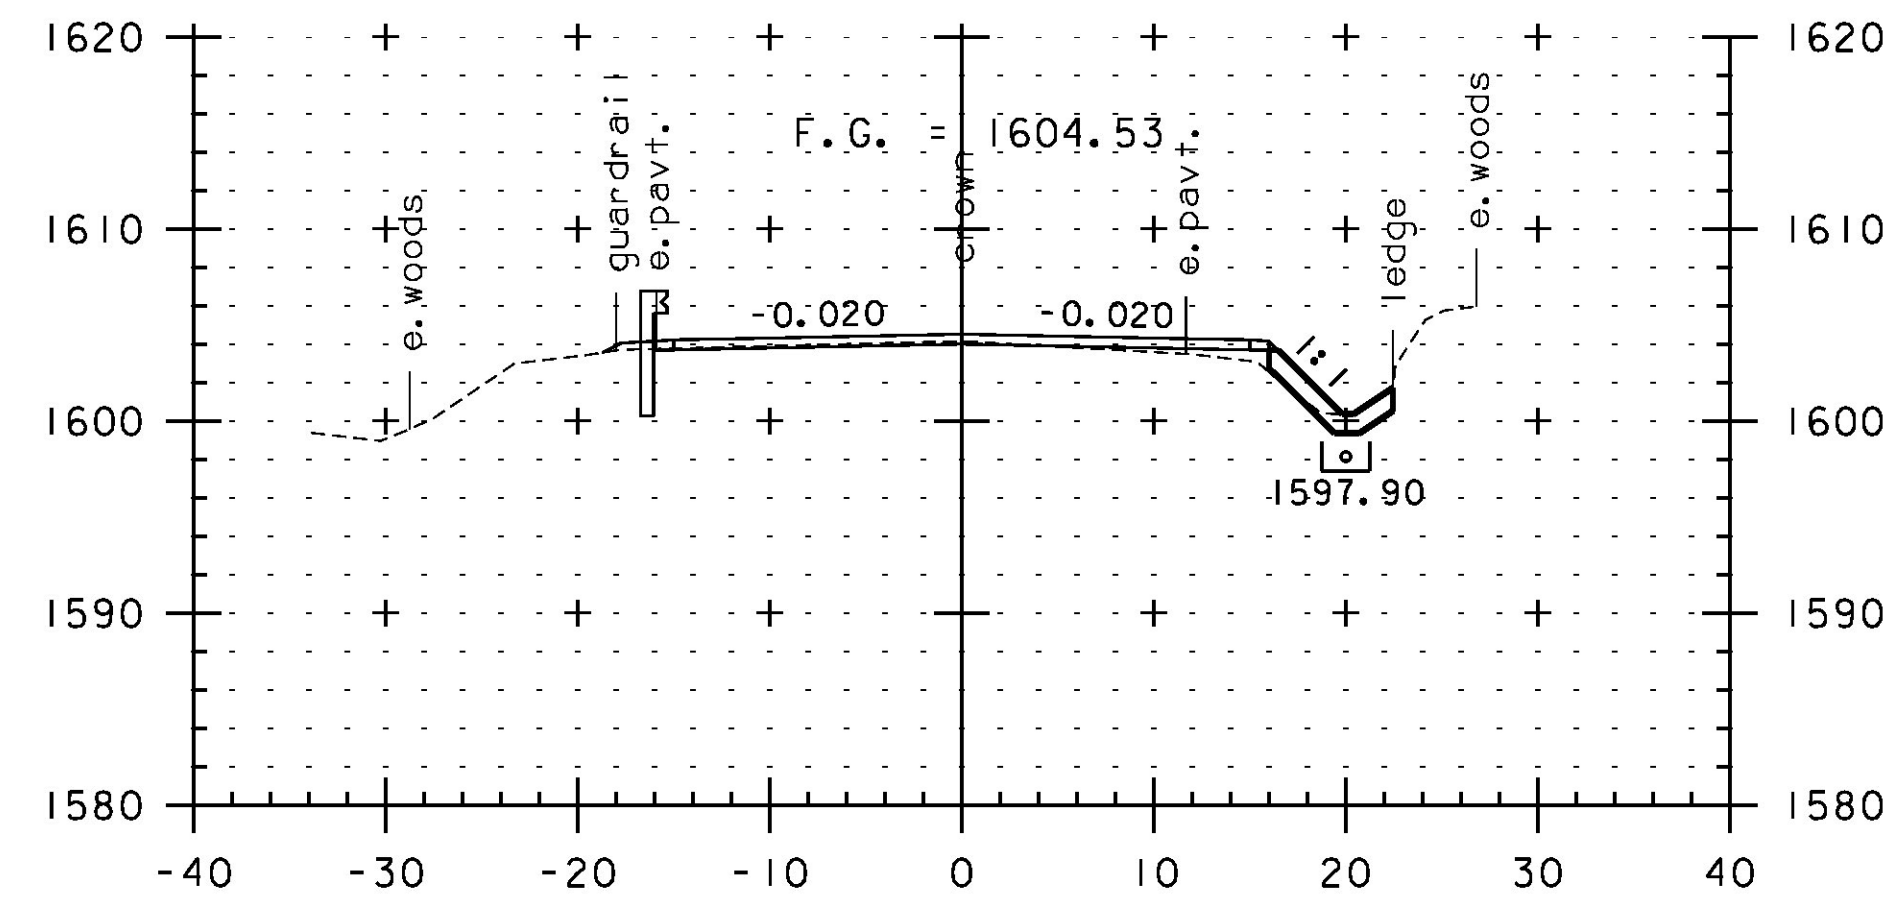


109+50

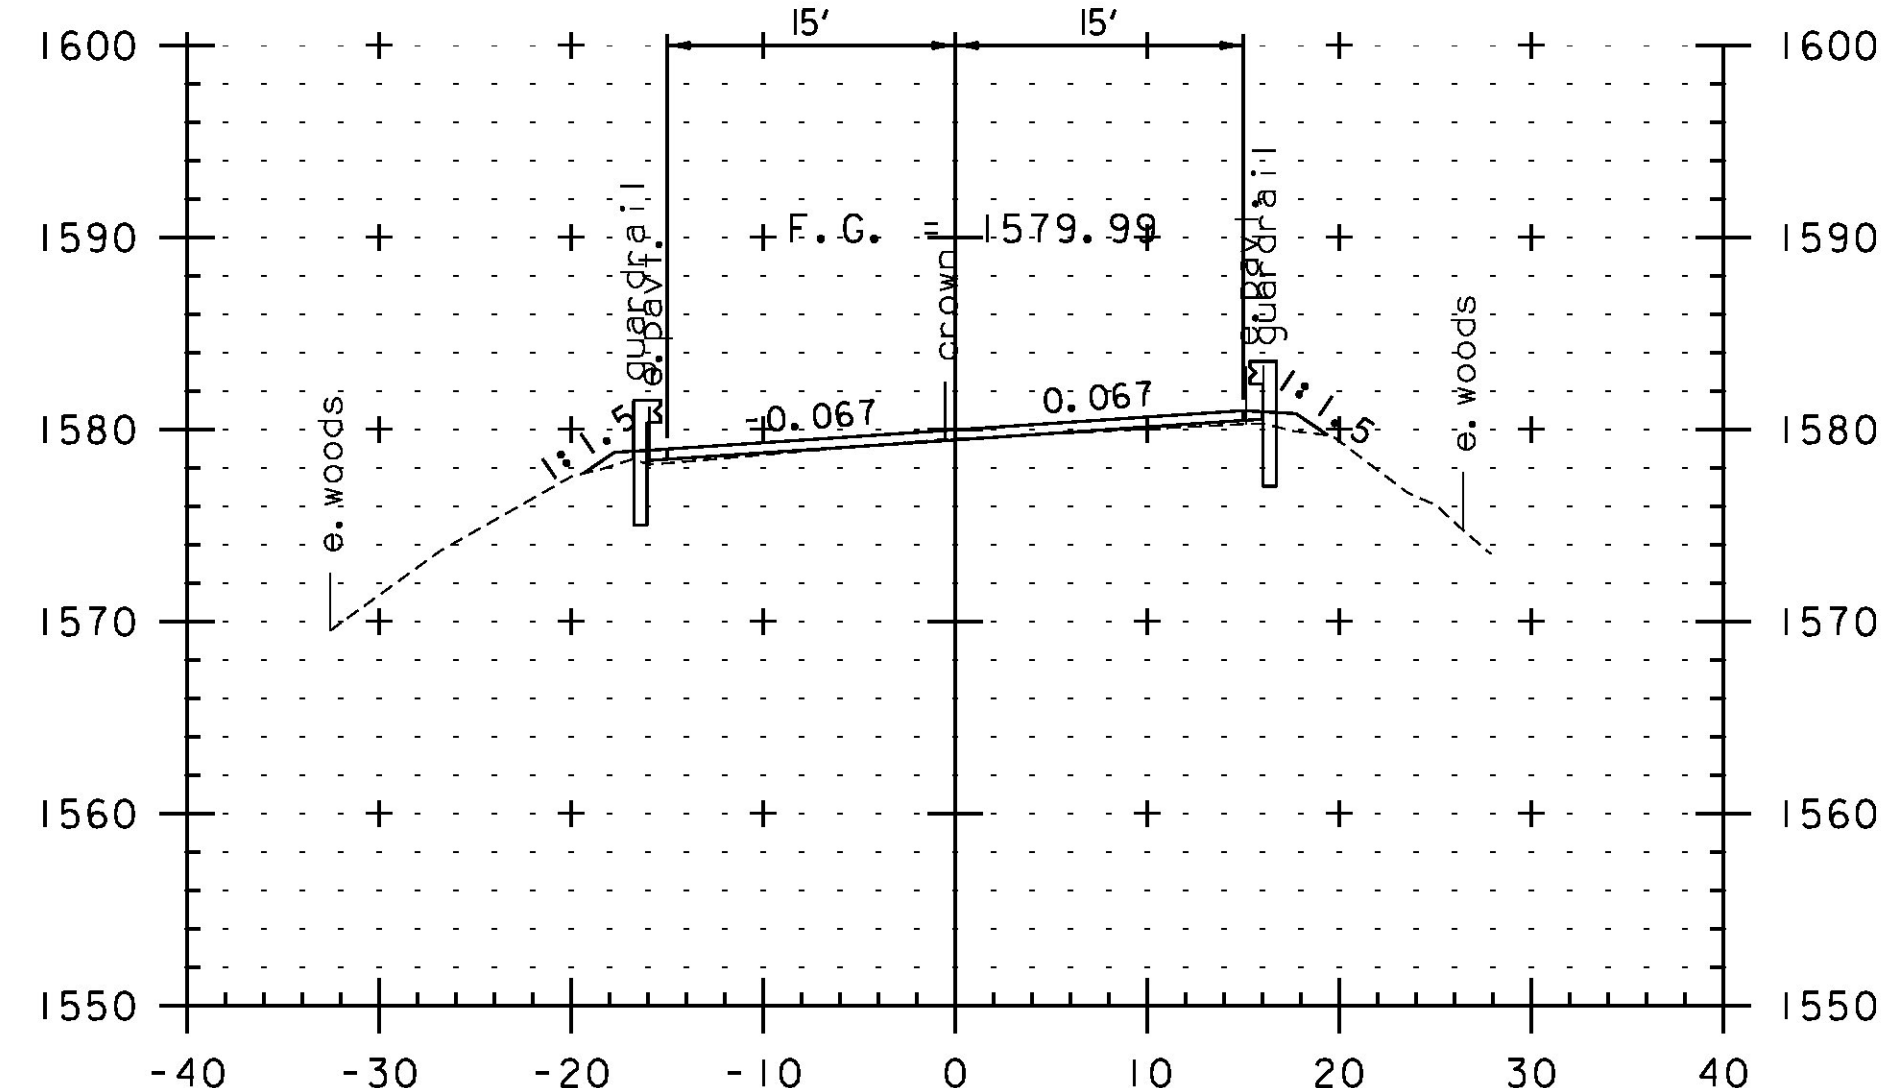


107+50

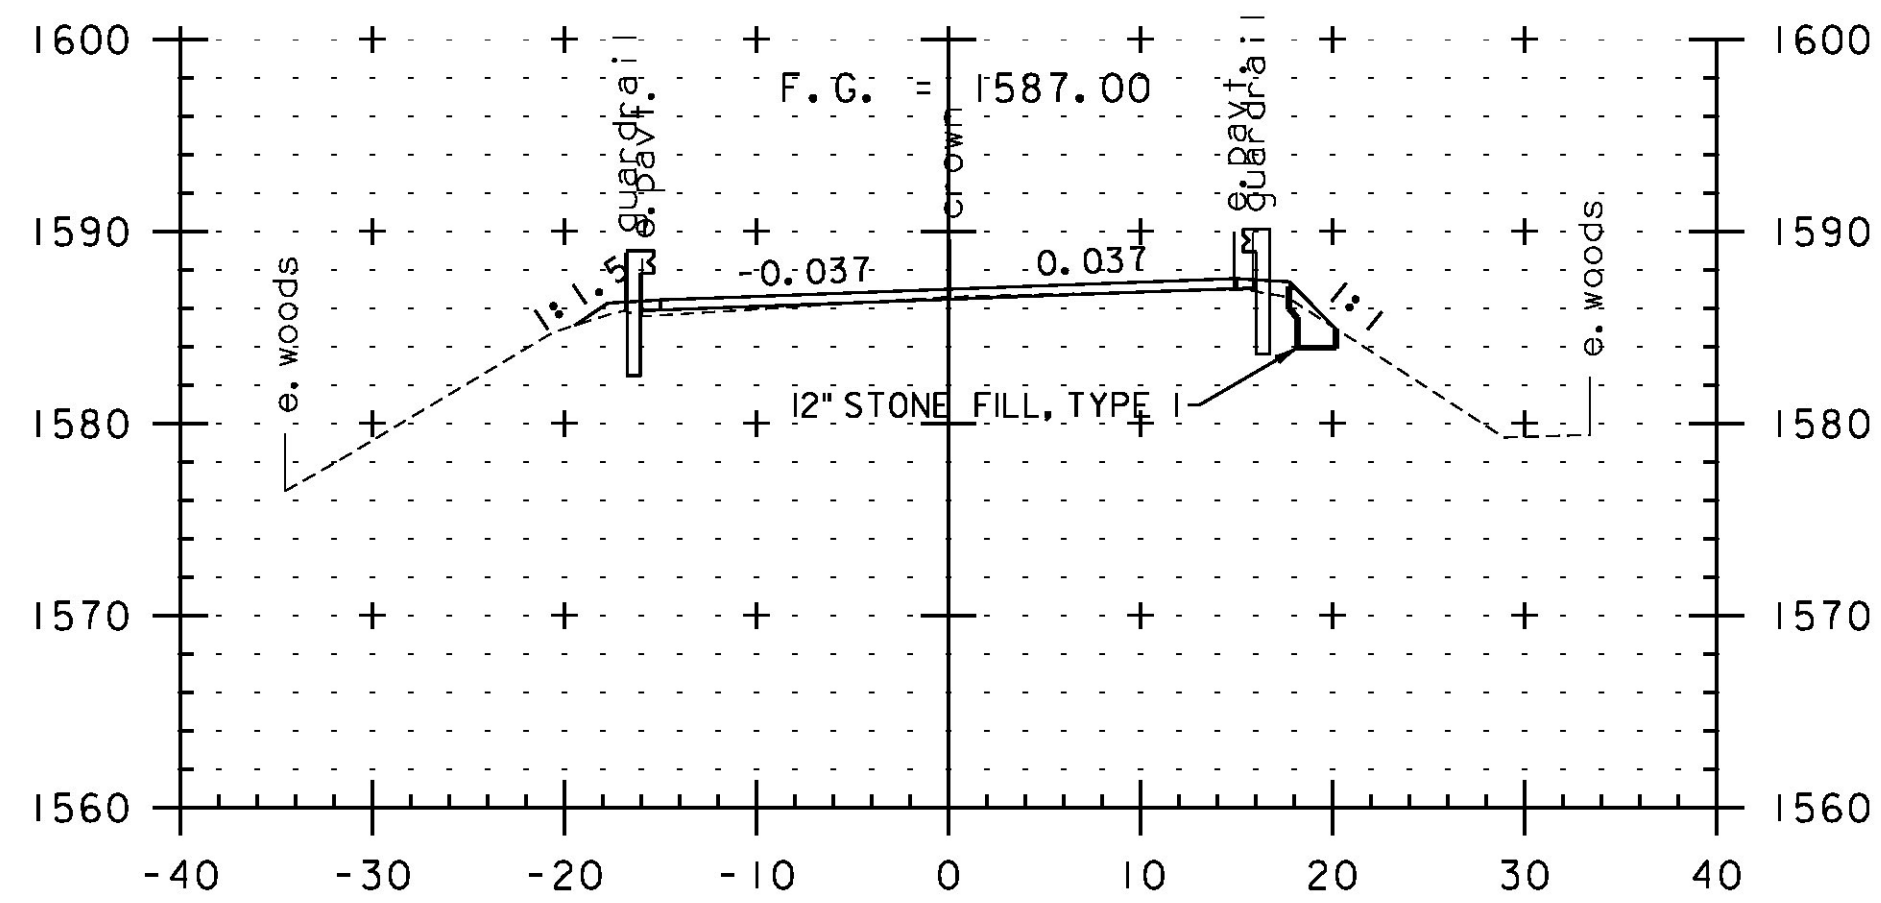

107+00

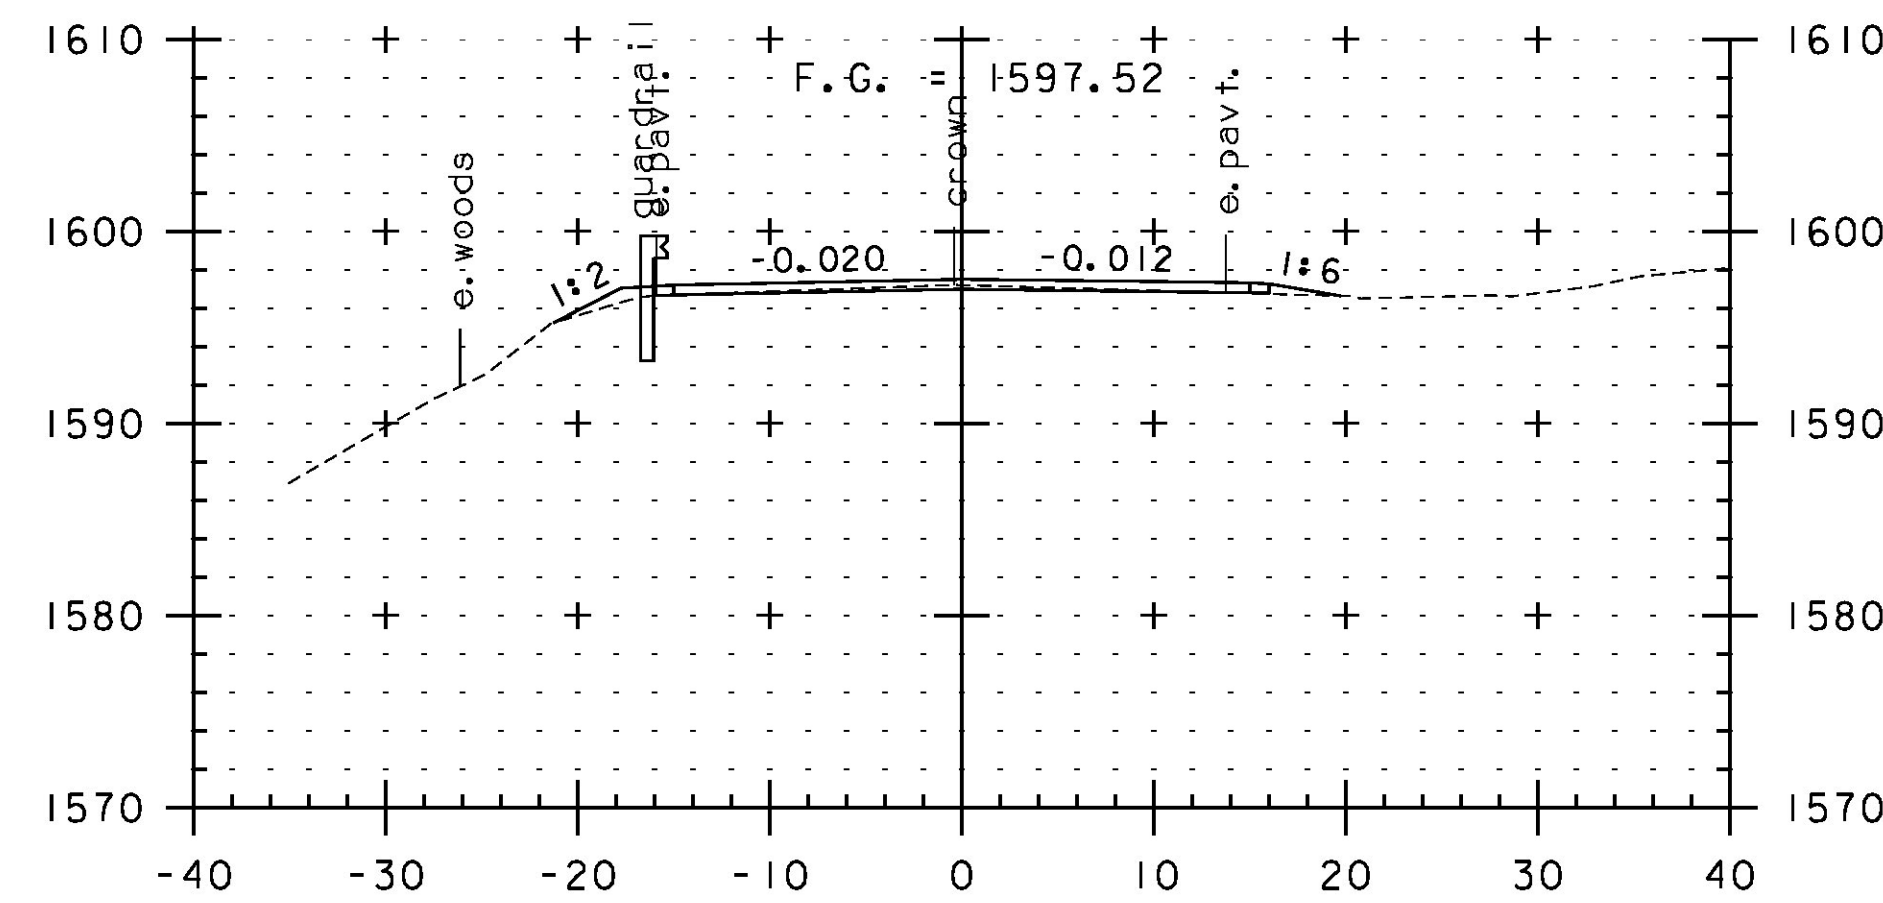

108+50

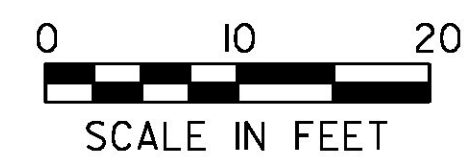

SCALE IN FEET

STA. 106+00 TO STA. 109+50

PROJECT NAME:	JAY-TROY	PLOT DATE:	5/16/2014
PROJECT NUMBER:	STP 2315(I)	DRAWN BY:	W. GORDON
FILE NAME:	z10b232xs.dgn	DESIGNED BY:	N. LEMAY
PROJECT LEADER:	P. SHEDD	CHECKED BY:	P. SHEDD
CROSS SECTION SHEET 17		SHEET	153 OF 244