




111+00

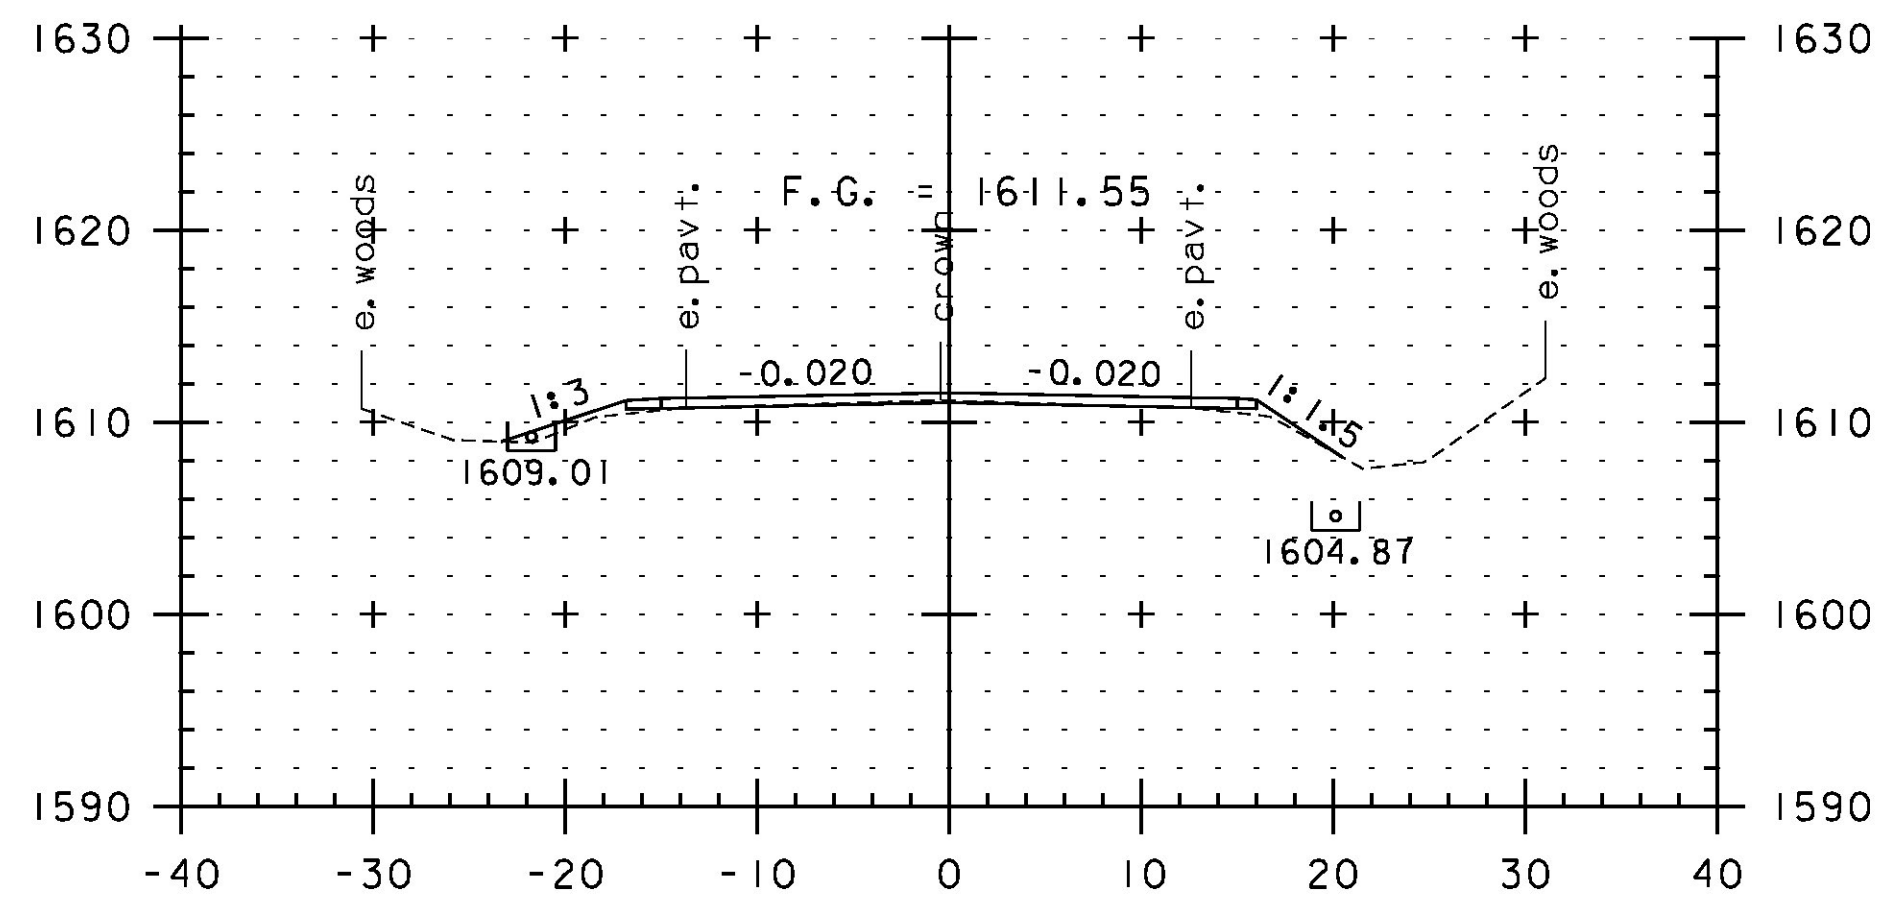


110+50

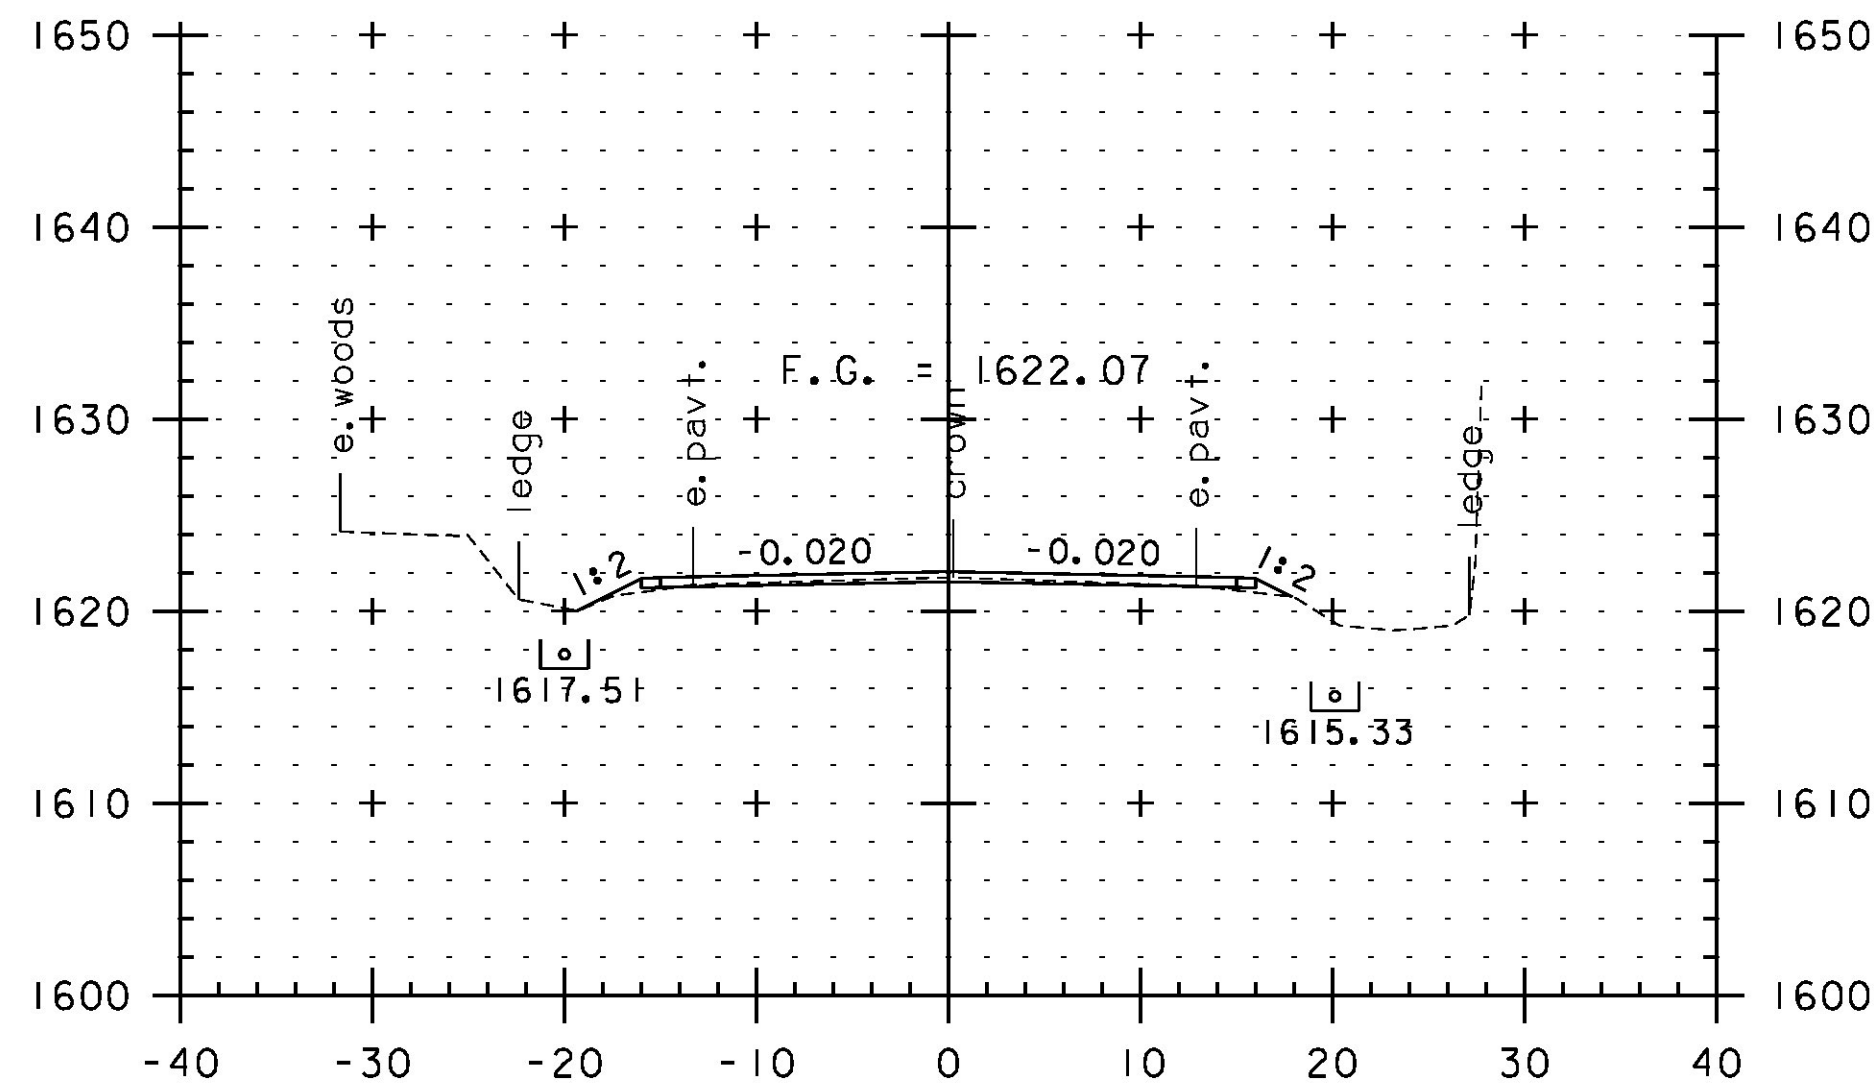


112+00

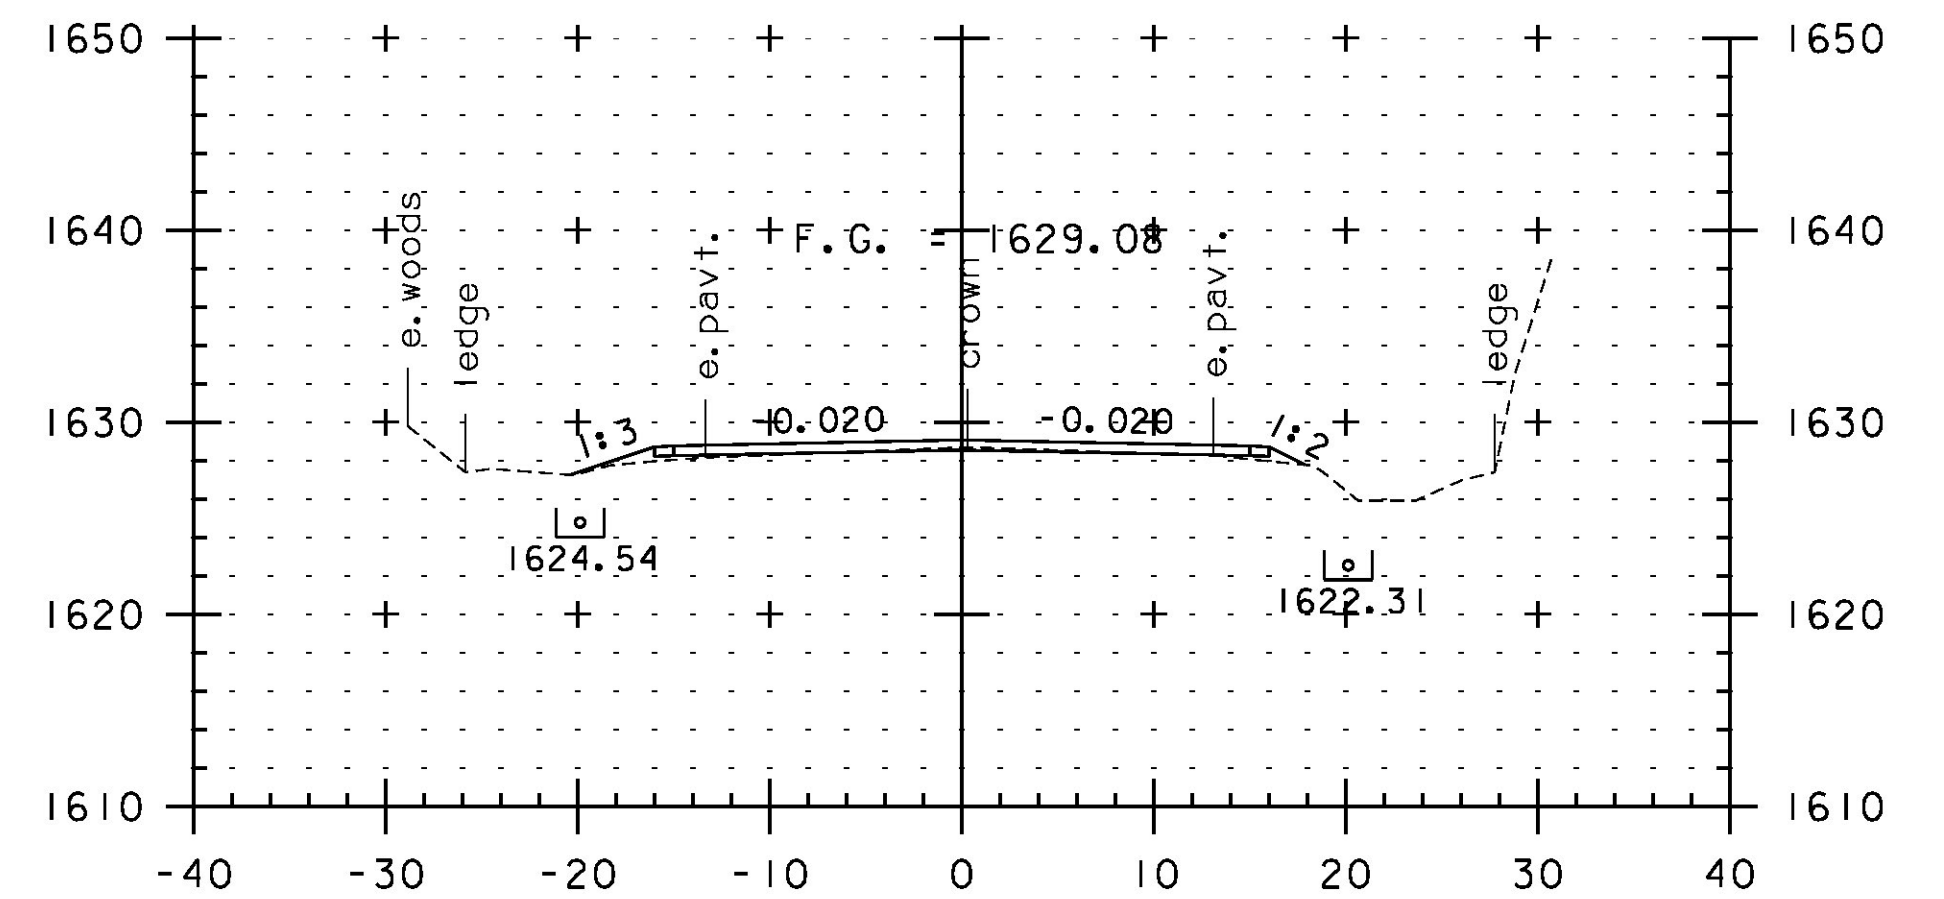


113+00

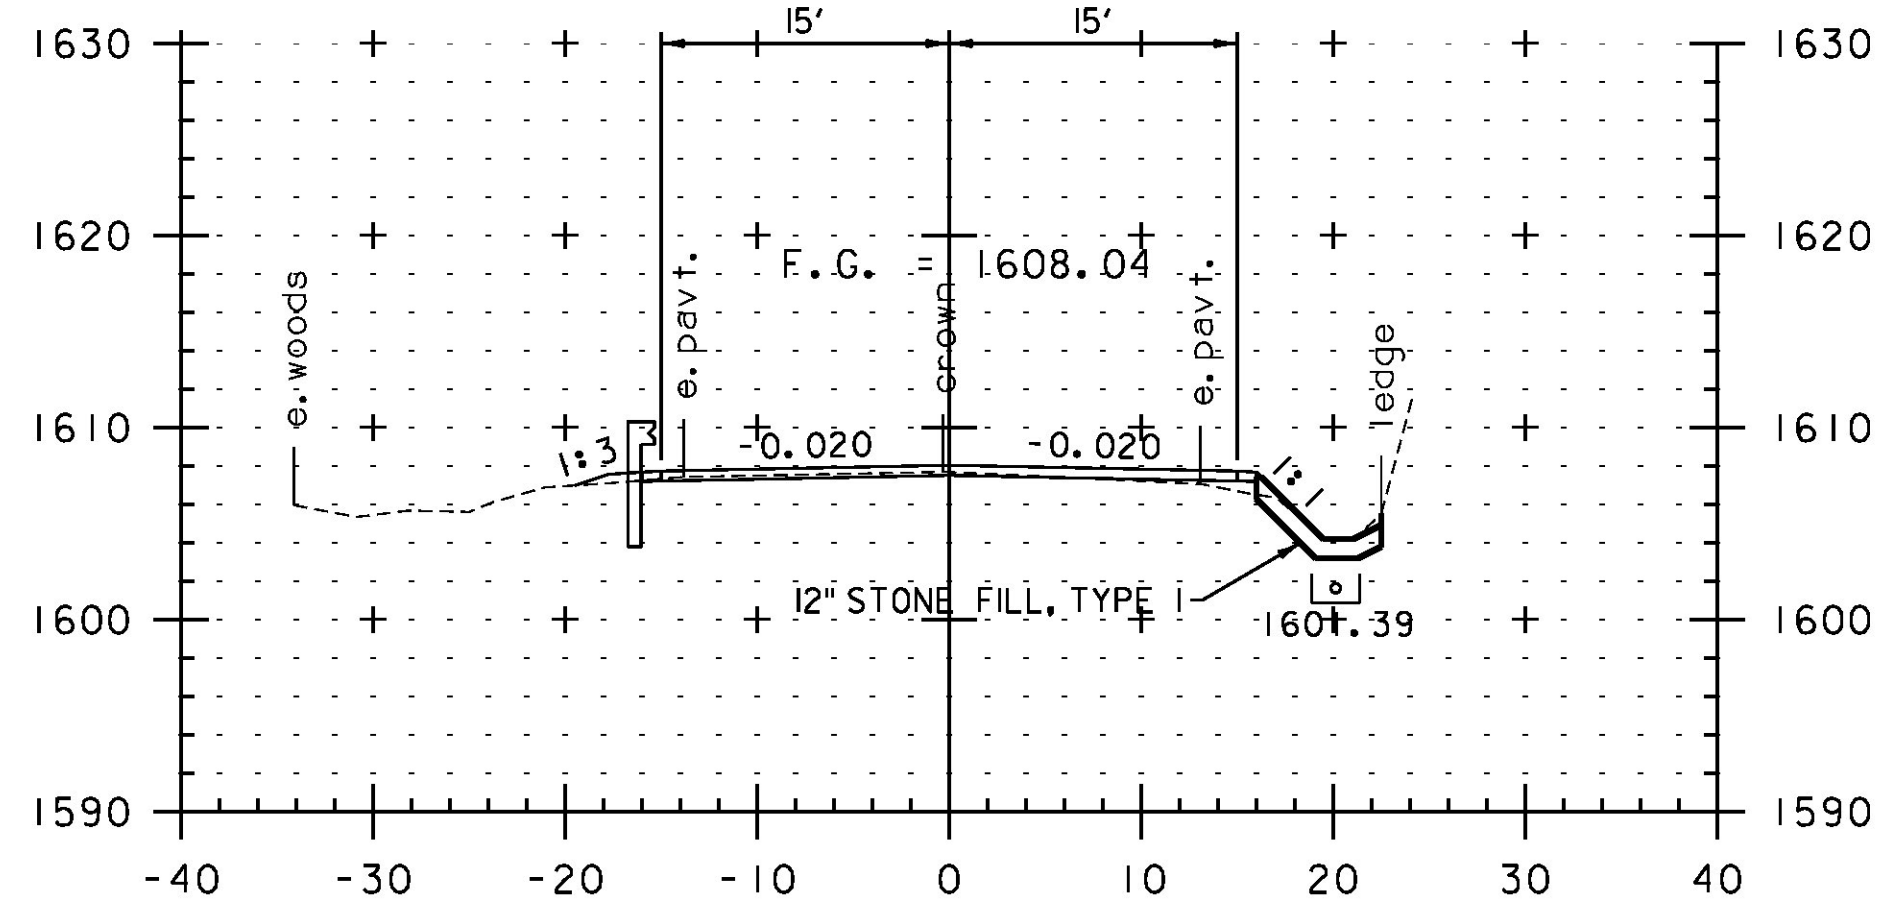


110+00

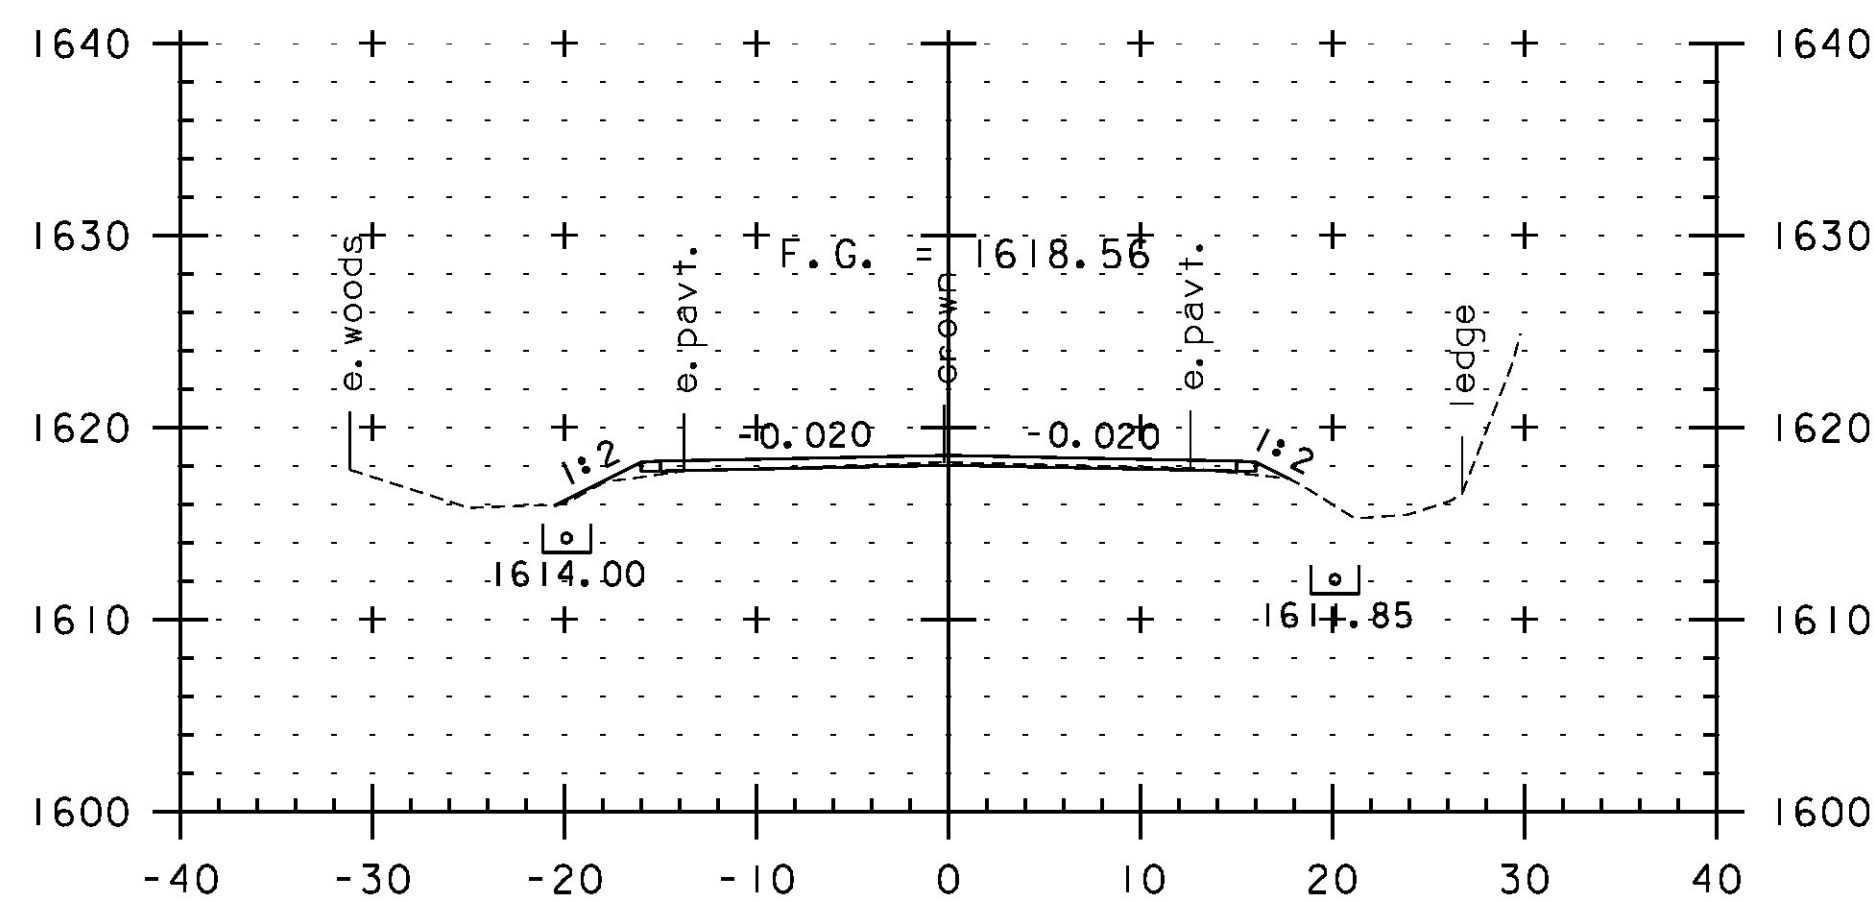

111+50

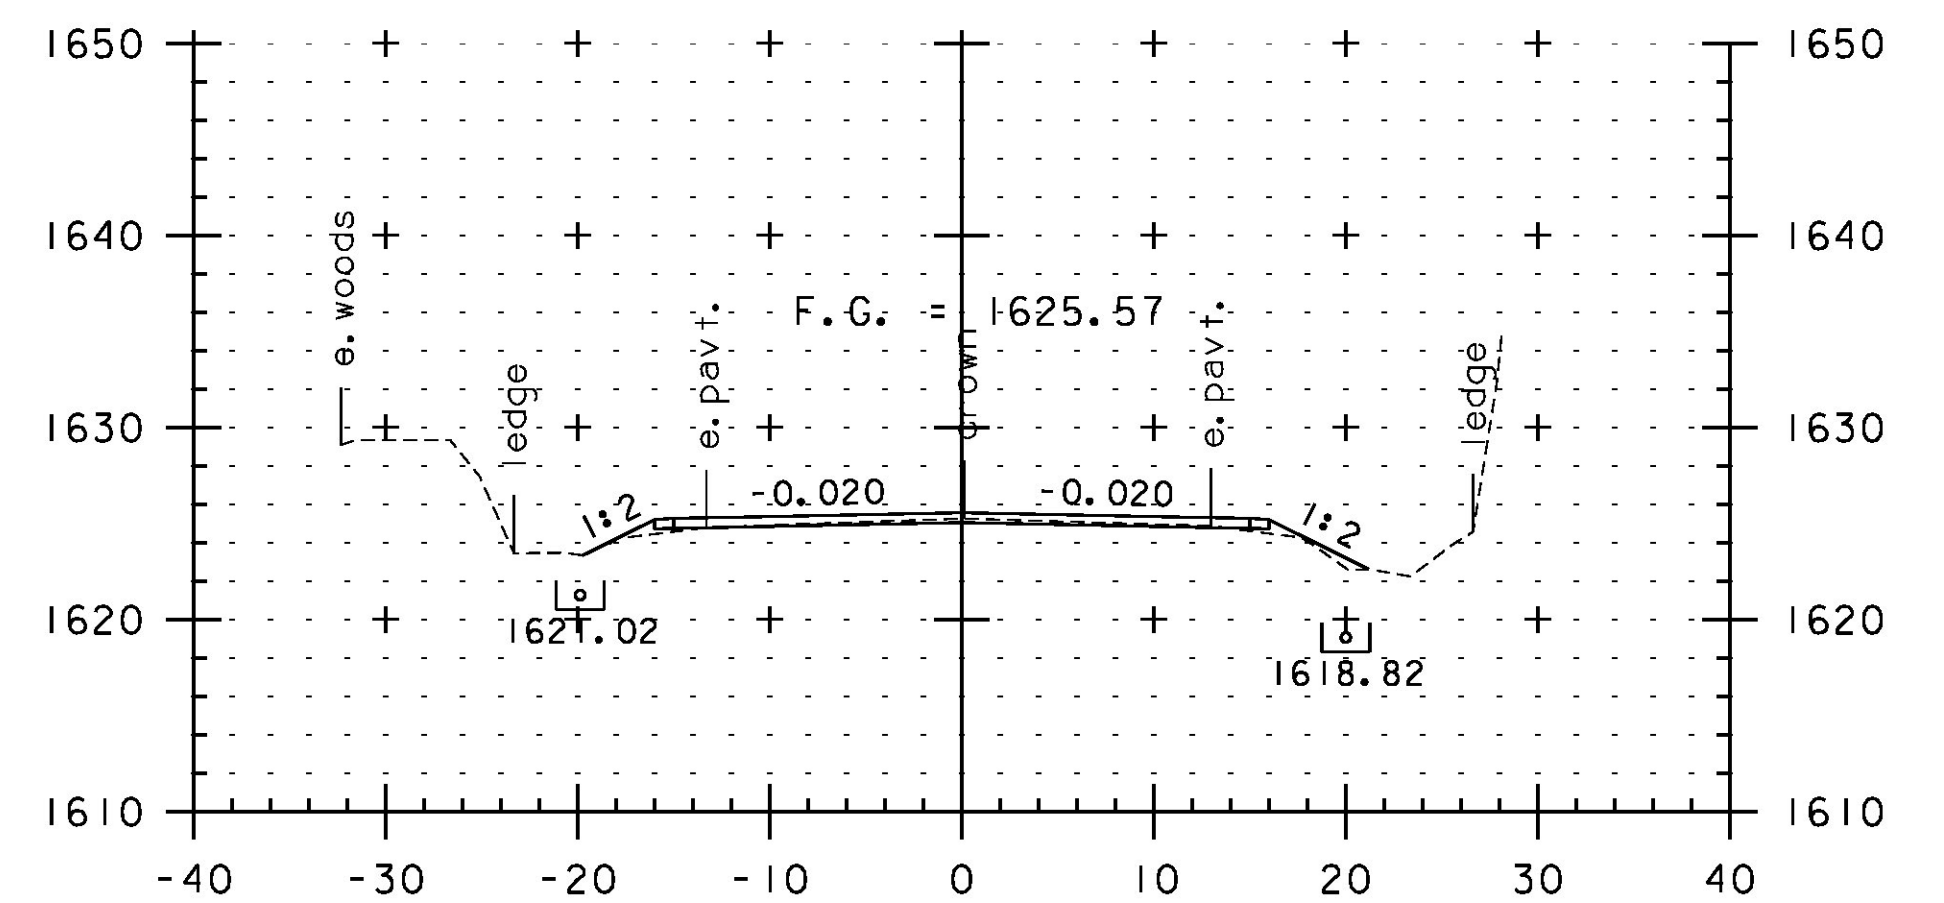

112+50

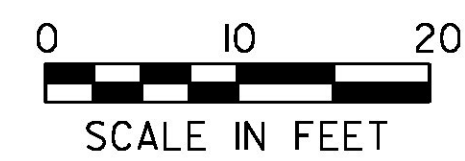

SCALE IN FEET

STA. 110+00 TO STA. 113+00

PROJECT NAME: JAY-TROY
PROJECT NUMBER: STP 2315(I)

FILE NAME: z10b232xs.dgn
PROJECT LEADER: P. SHEDD
DESIGNED BY: N. LEMAY
CROSS SECTION SHEET 18

PLOT DATE: 5/16/2014
DRAWN BY: W. GORDON
CHECKED BY: P. SHEDD
SHEET 154 OF 244