




117+50

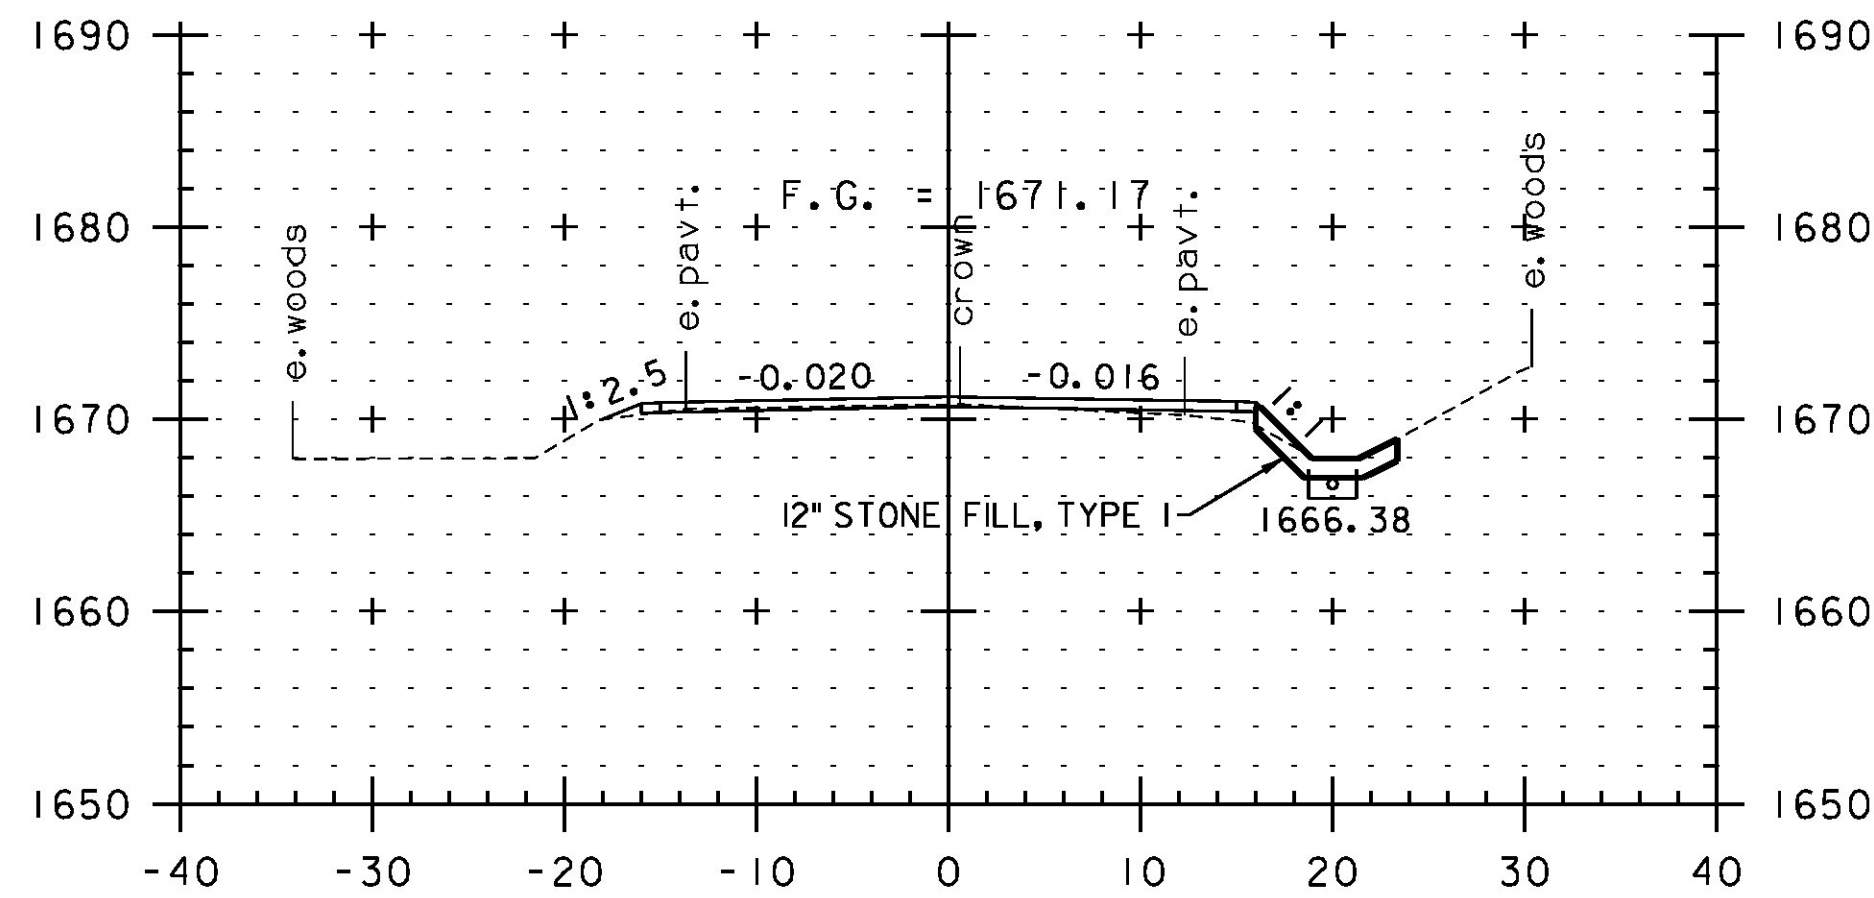


119+00

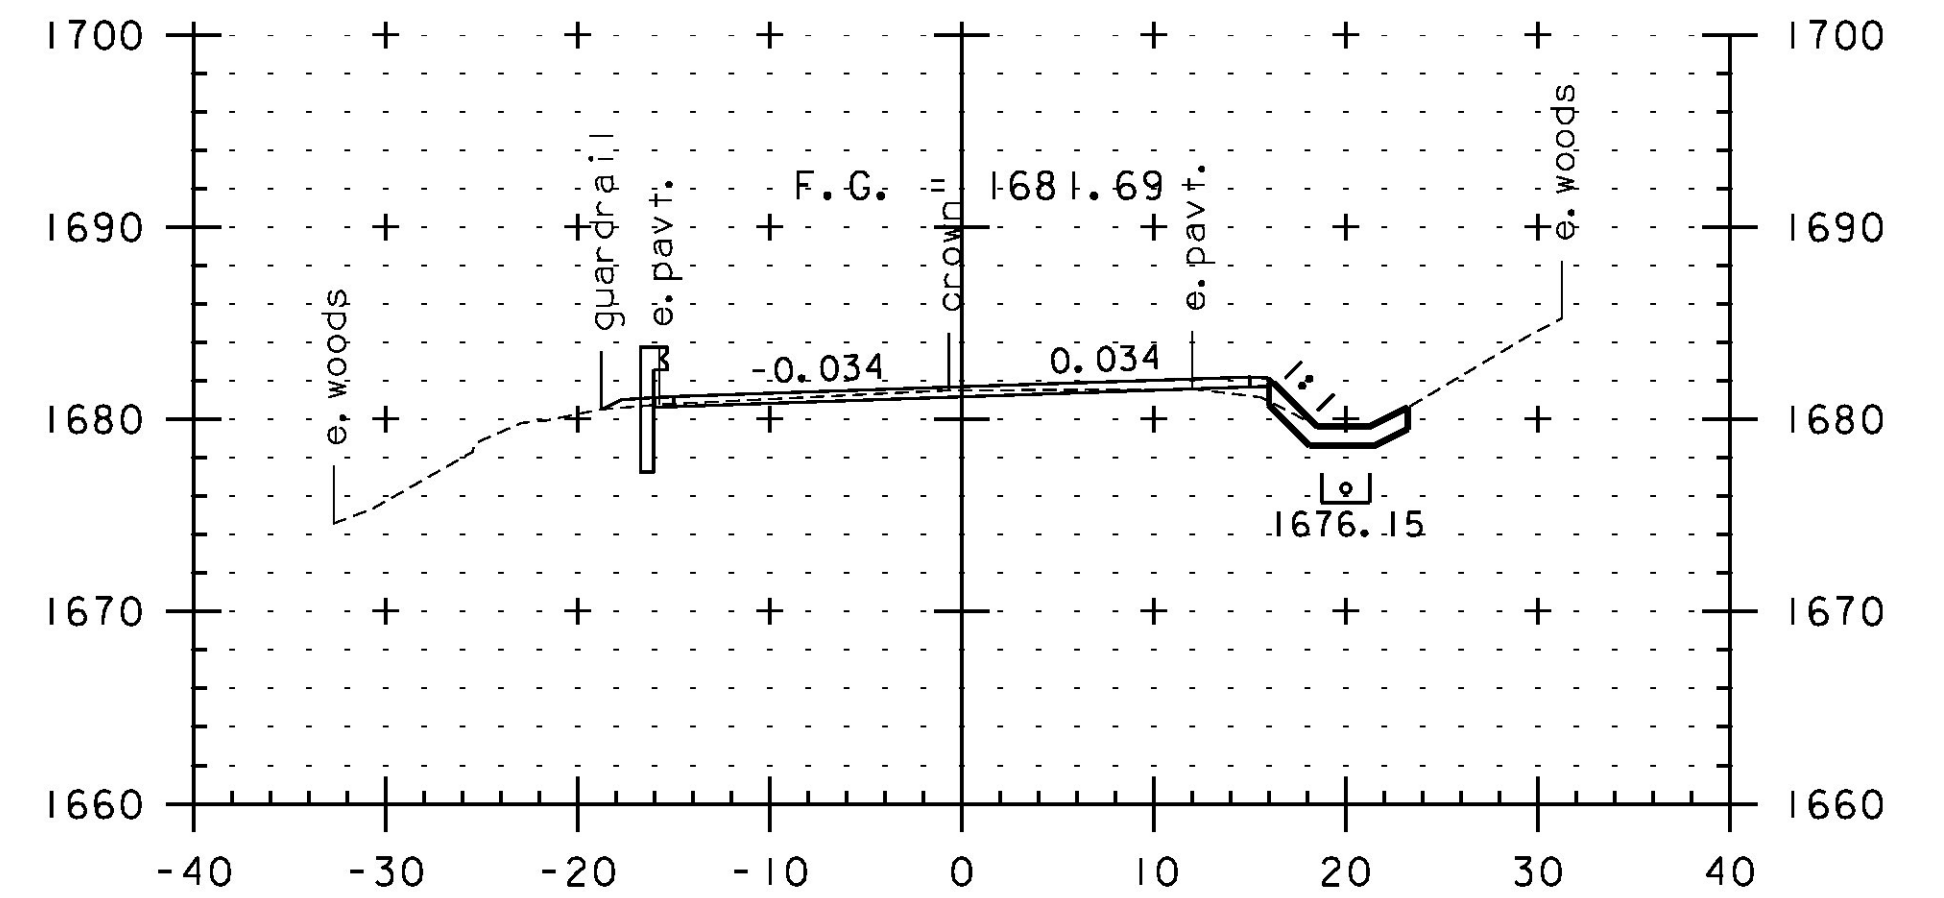


120+50

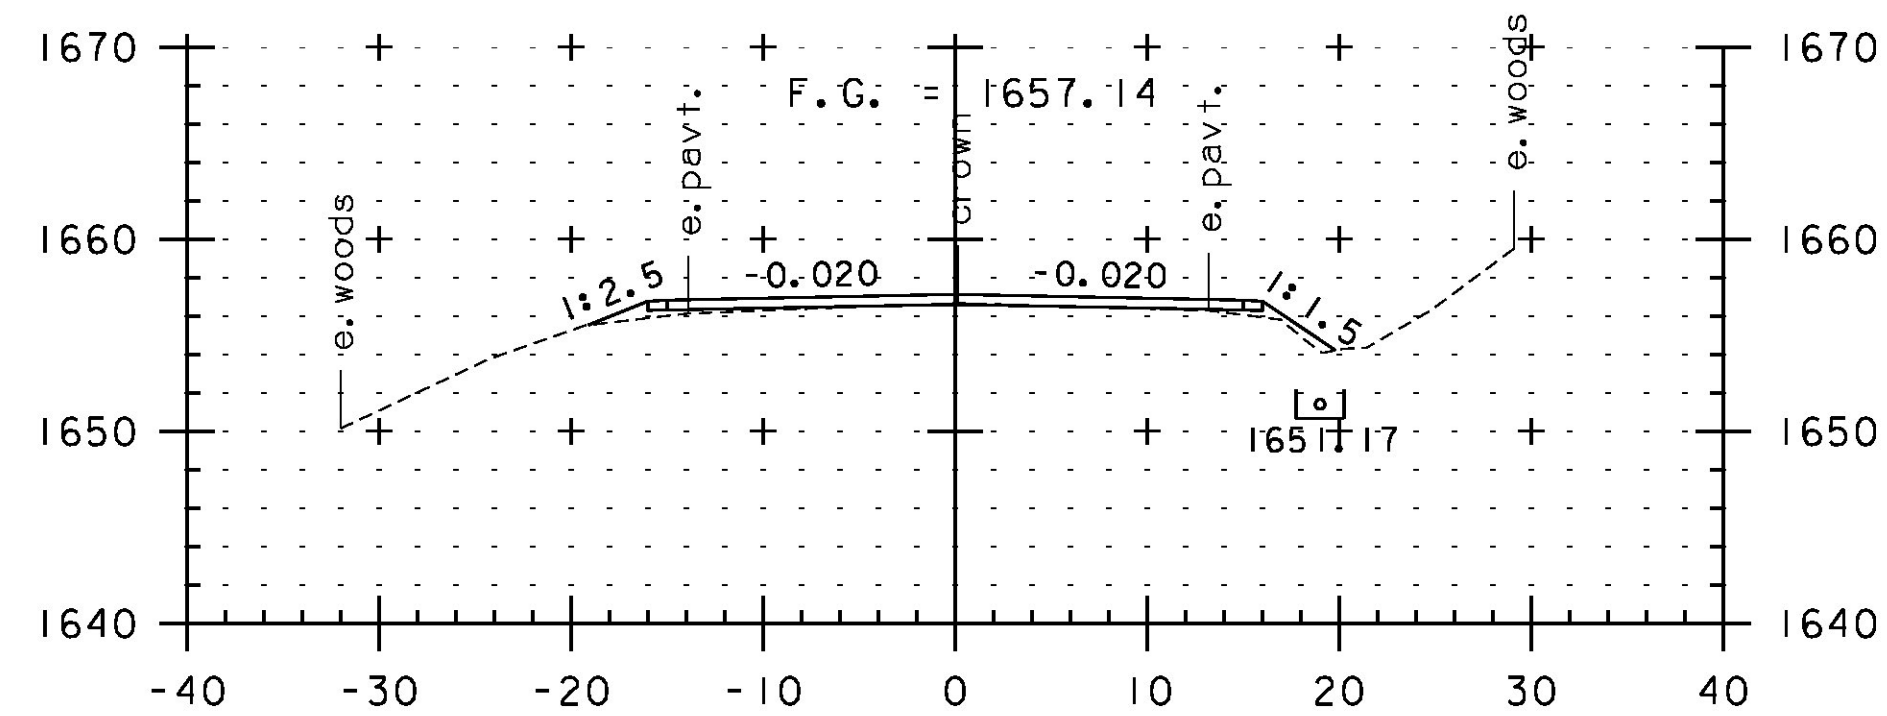


117+00

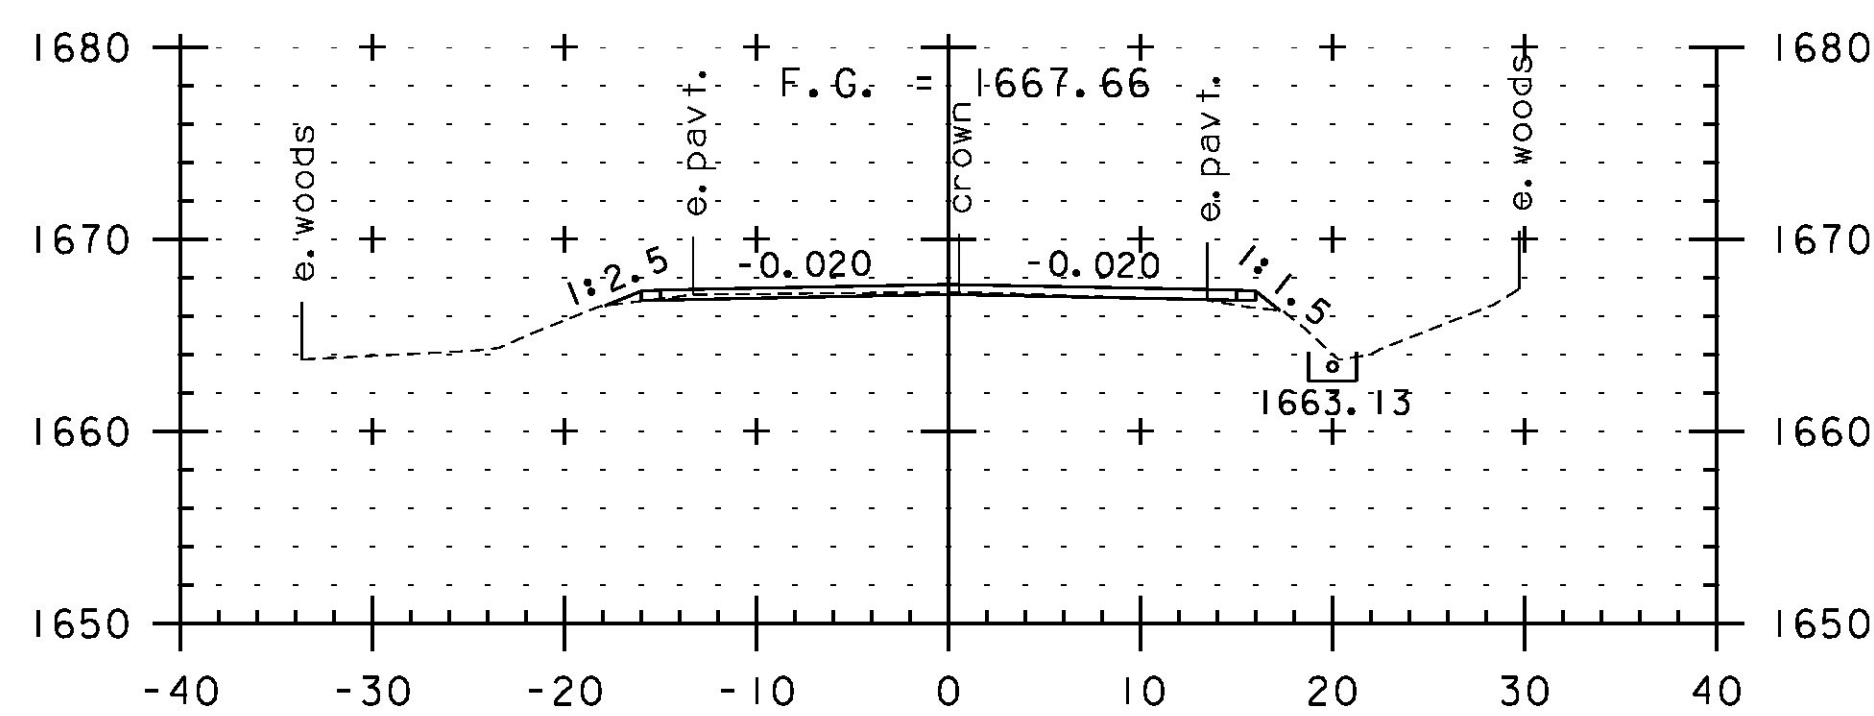


118+50

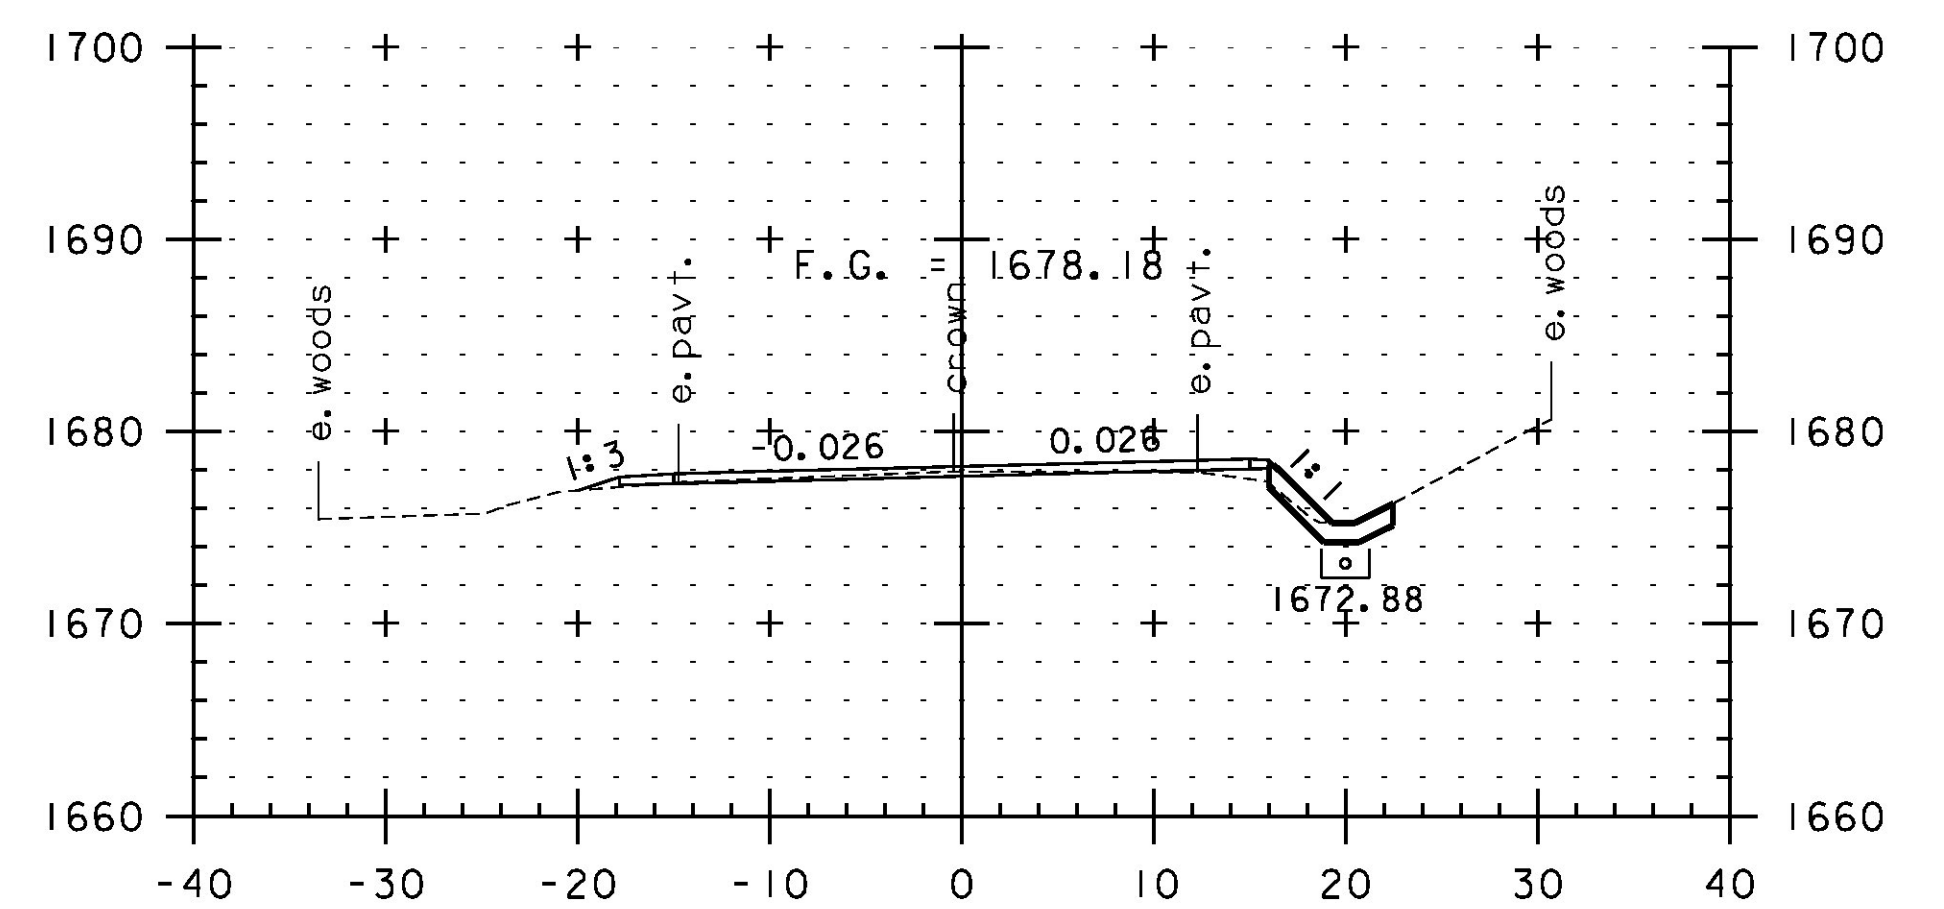


120+00

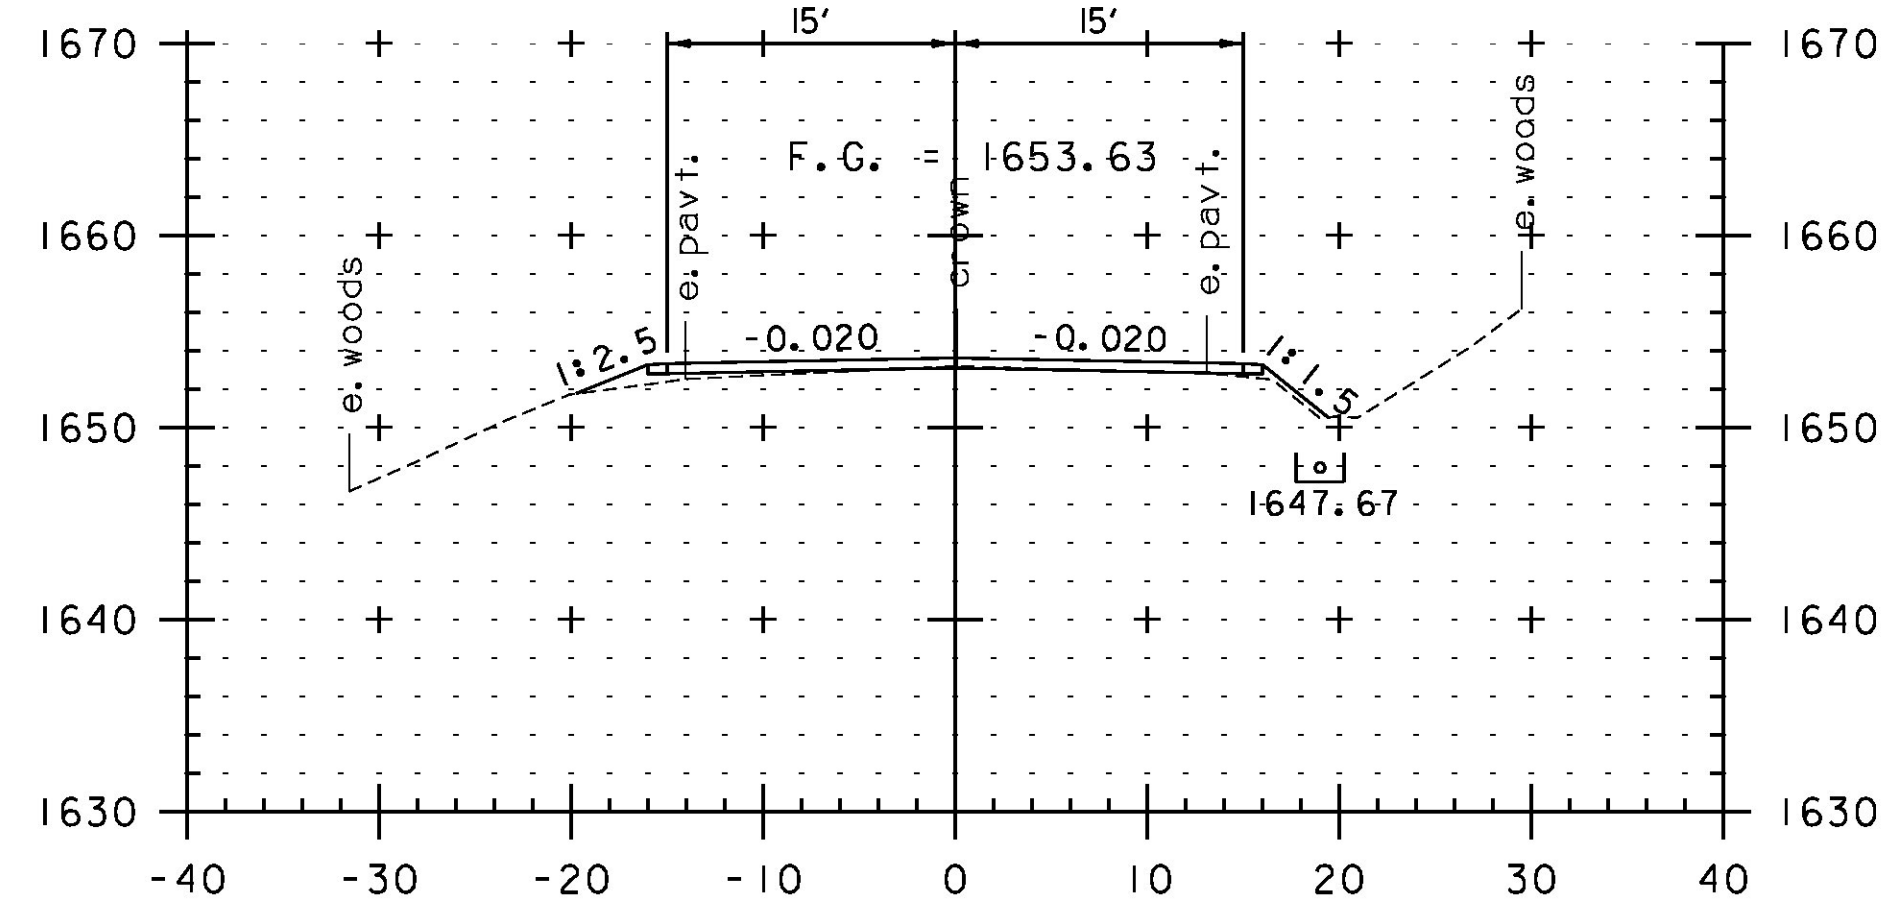

116+50

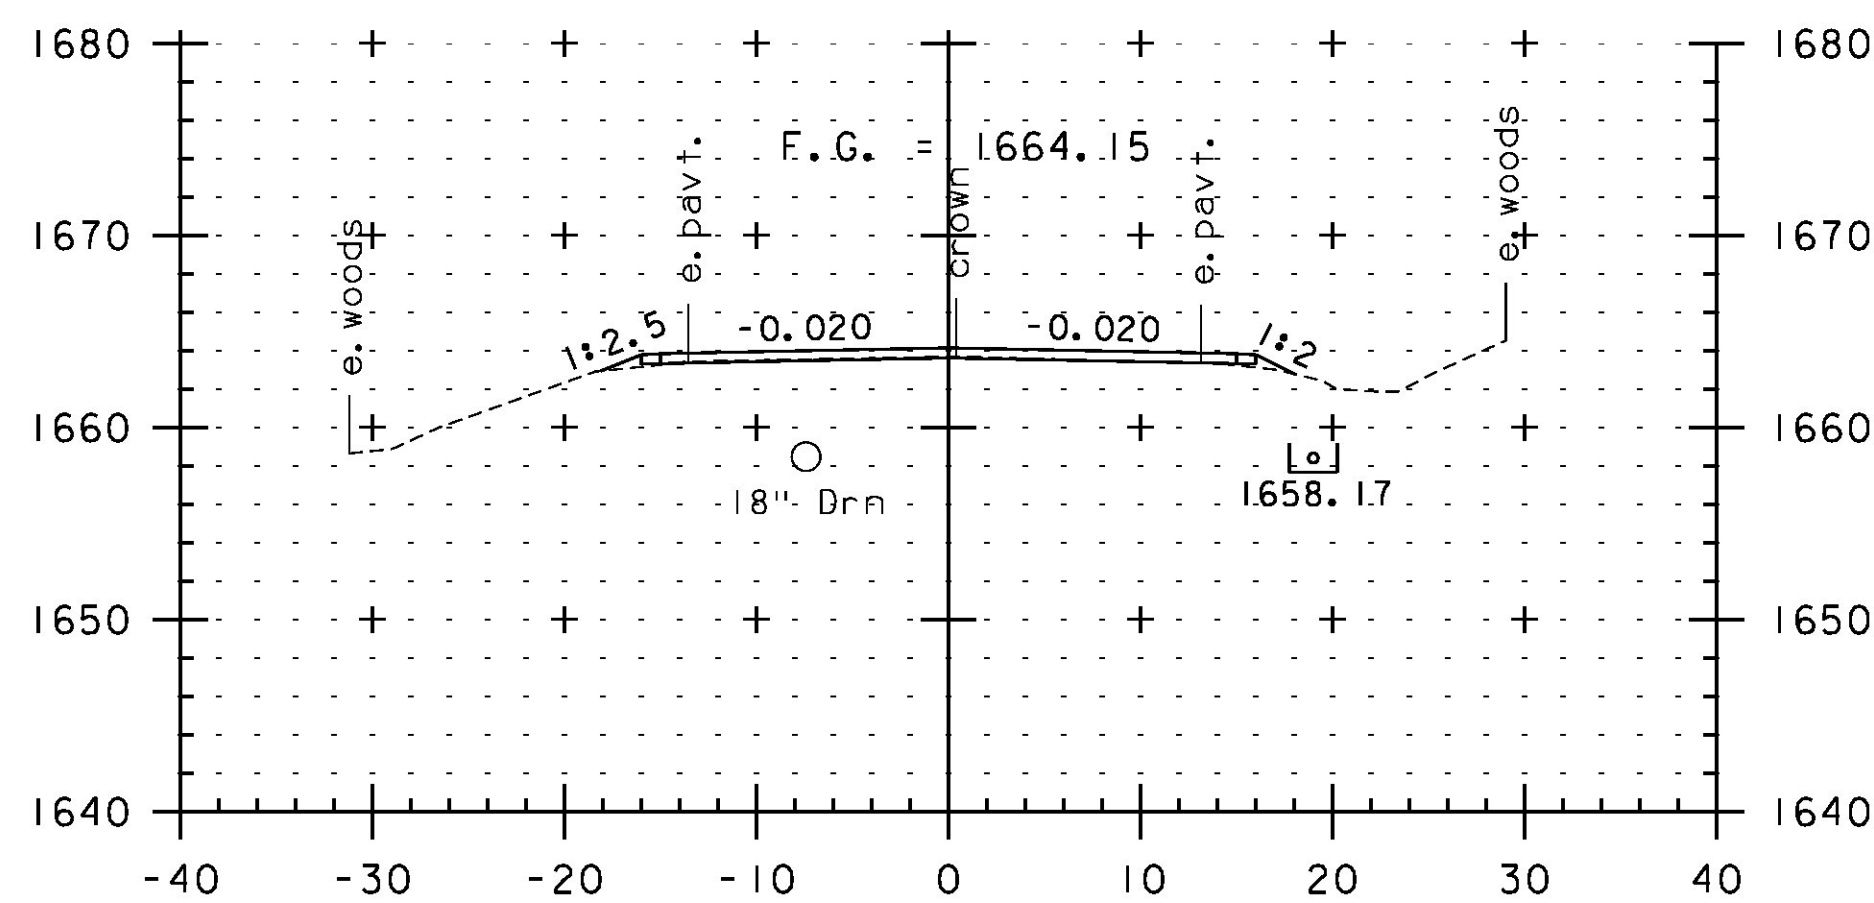

118+00

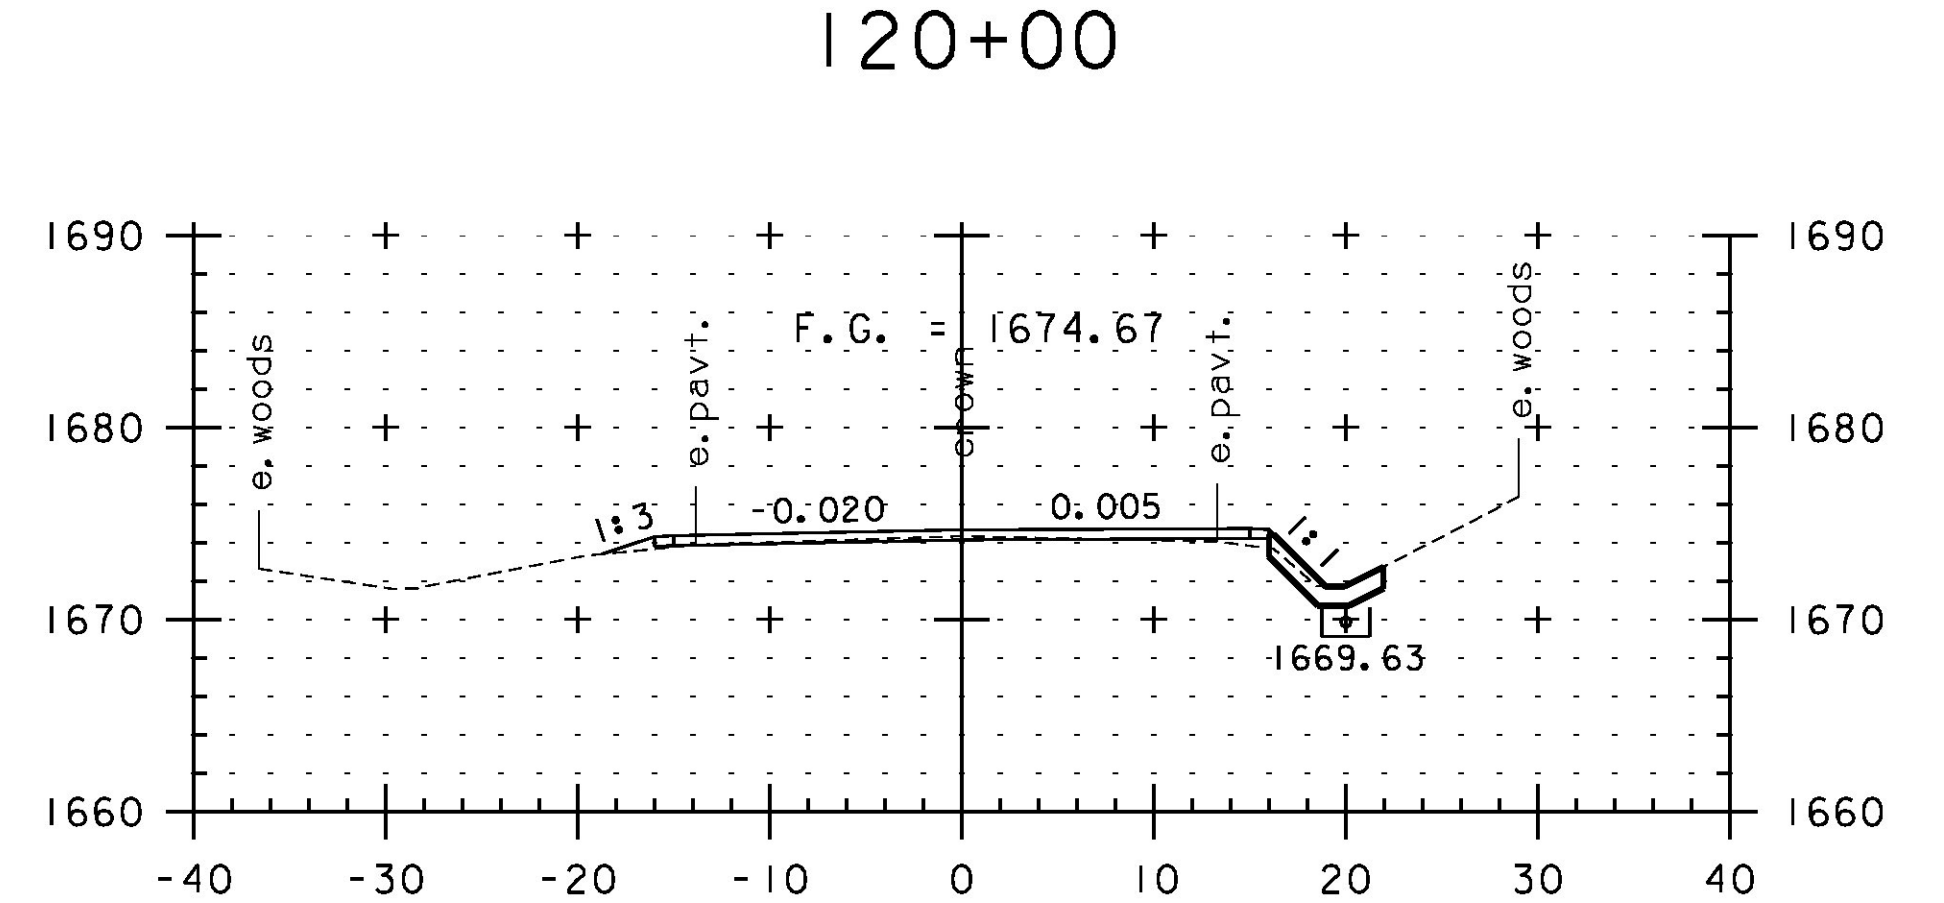

119+50



STA. 116+50 TO STA. 120+50

PROJECT NAME:	JAY-TROY	PLOT DATE:	5/16/2014
PROJECT NUMBER:	STP 2315(I)	DRAWN BY:	W. GORDON
FILE NAME:	z10b232xs.dgn	CHECKED BY:	P. SHEDD
PROJECT LEADER:	P. SHEDD	CROSS SECTION SHEET	20
DESIGNED BY:	N. LEMAY	SHEET	156 OF 244