




123+00

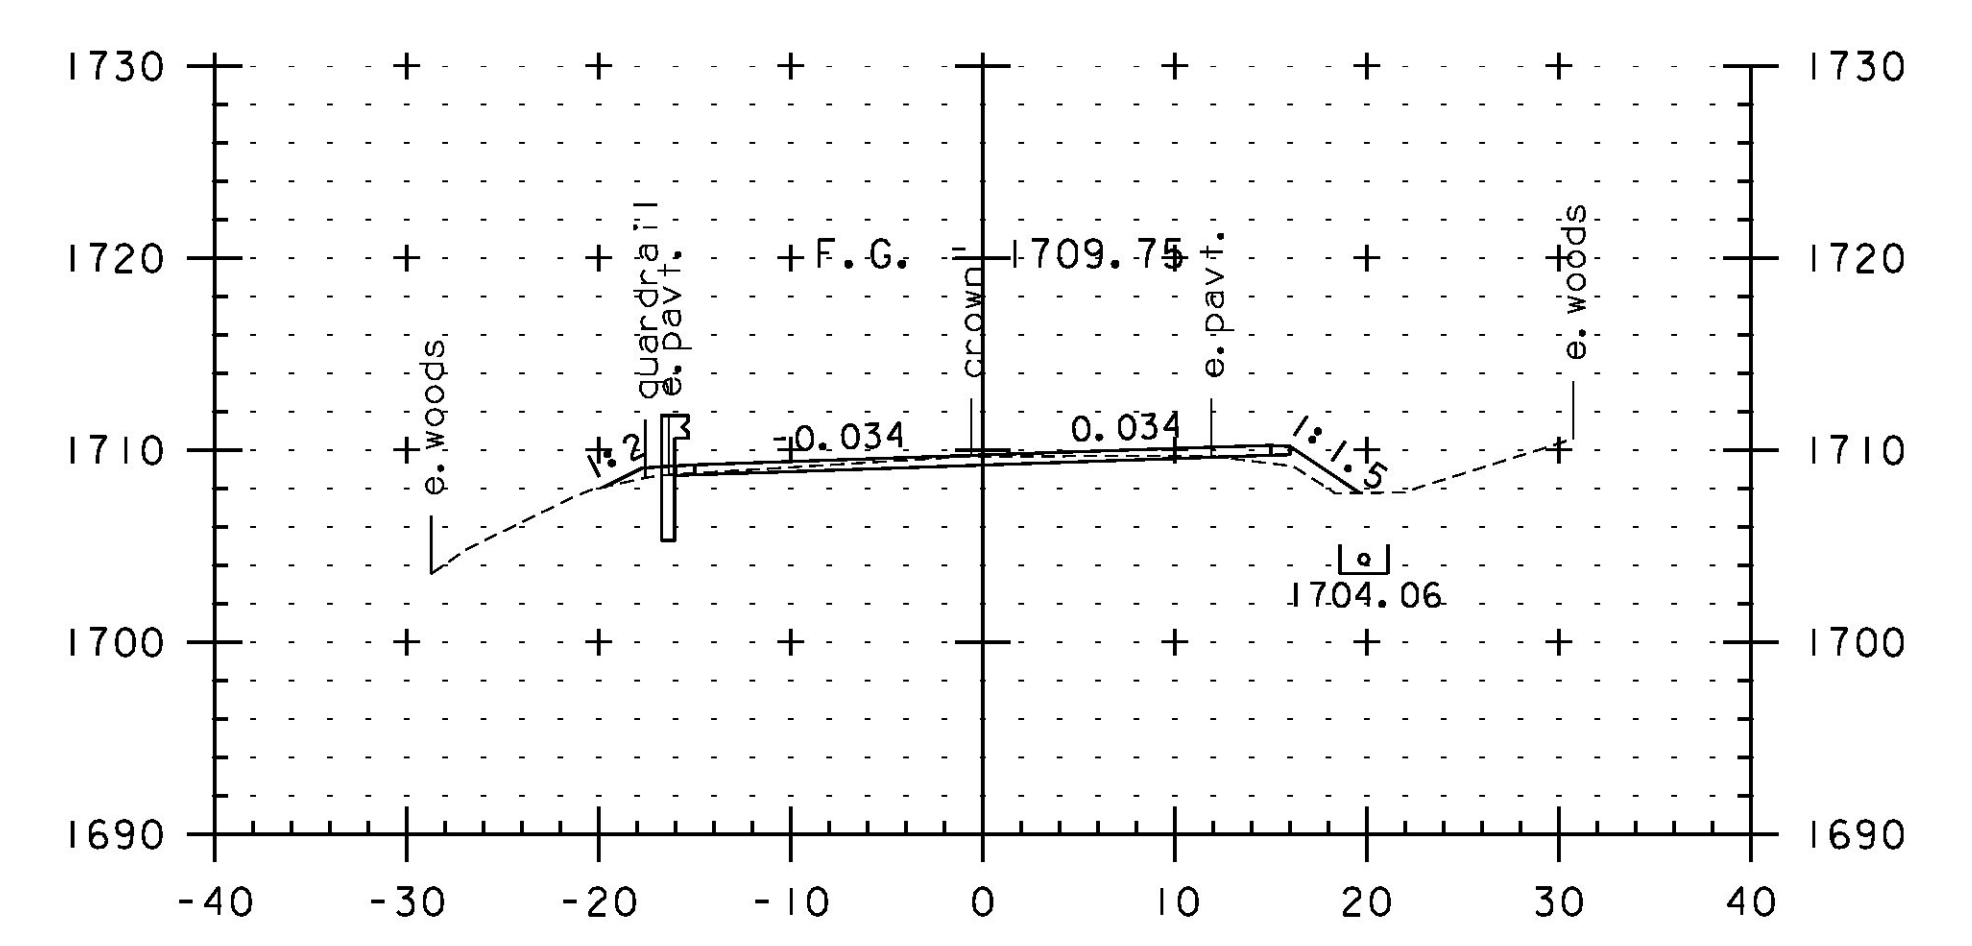


124+50

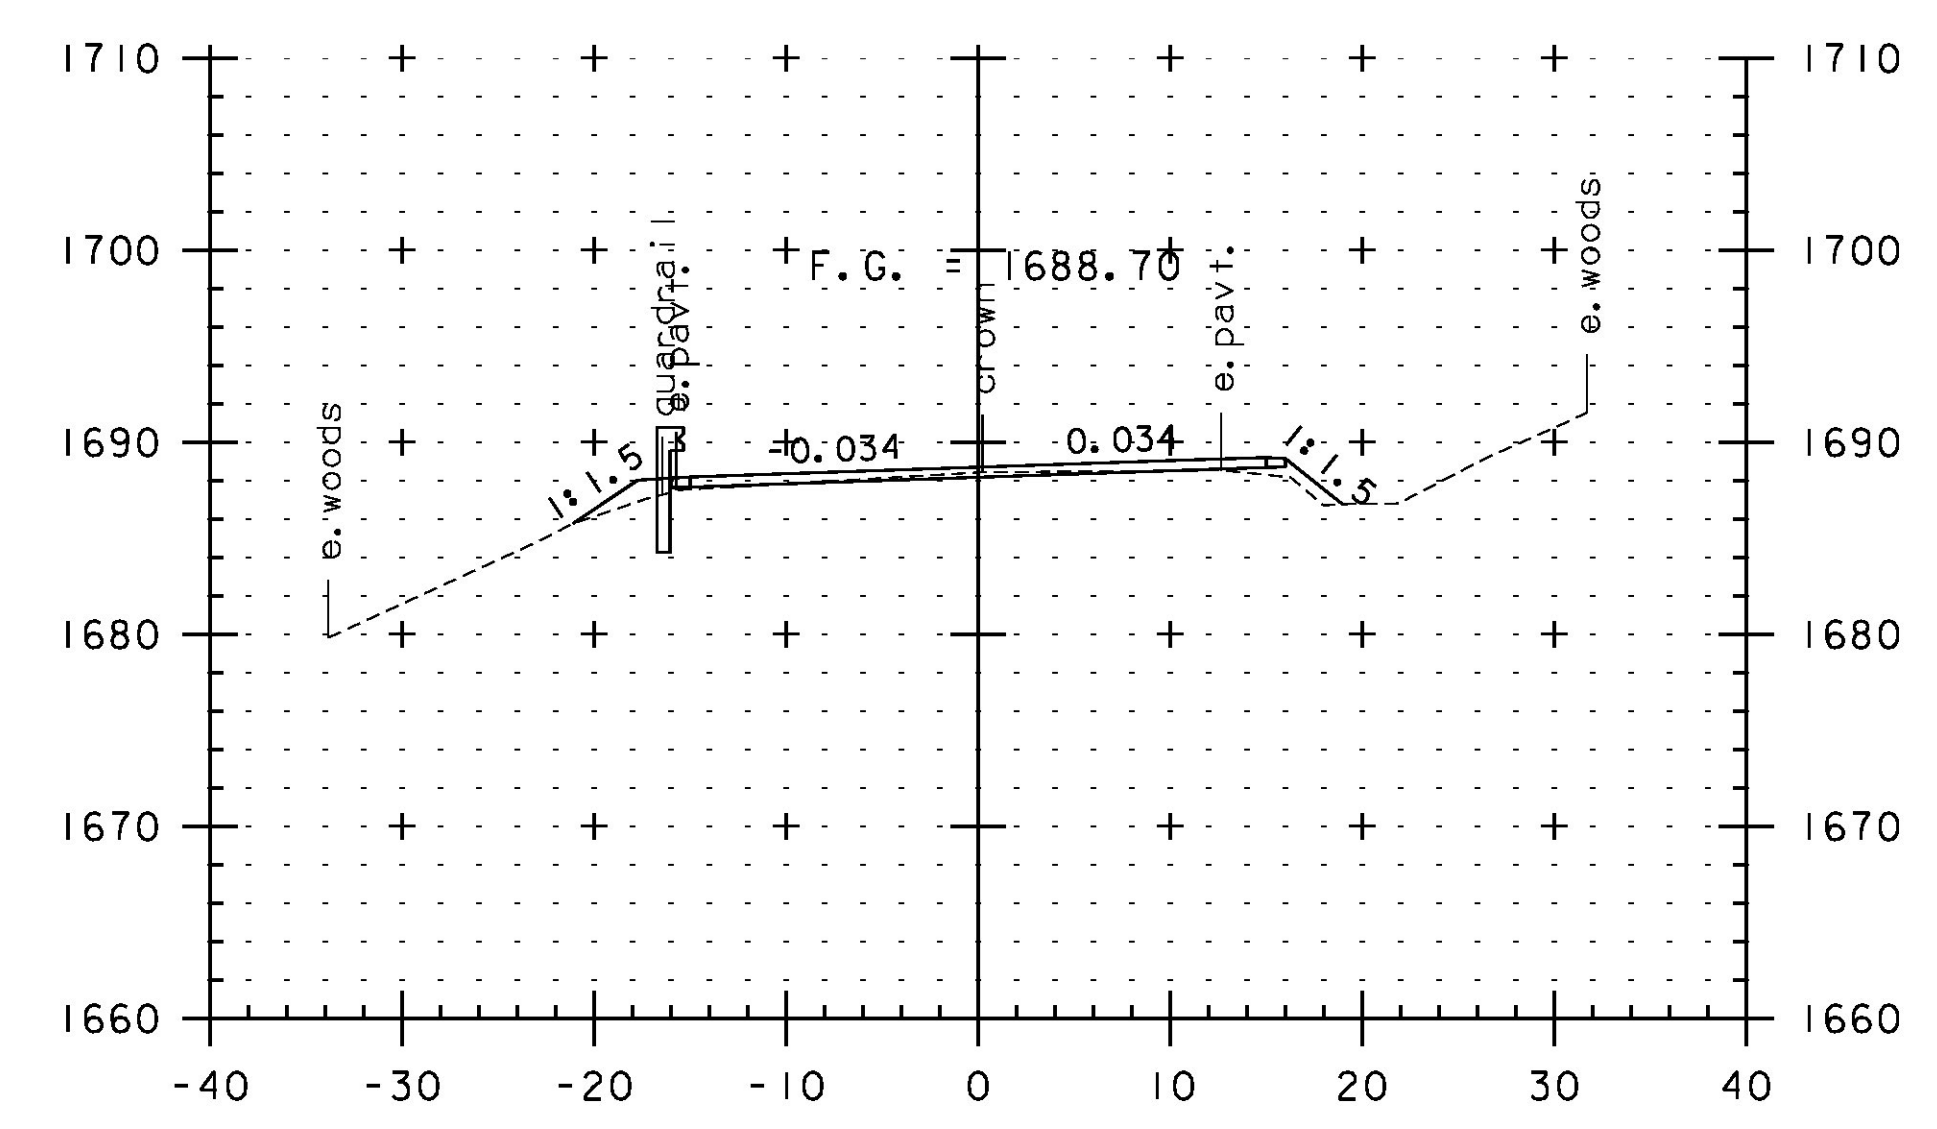


121+50

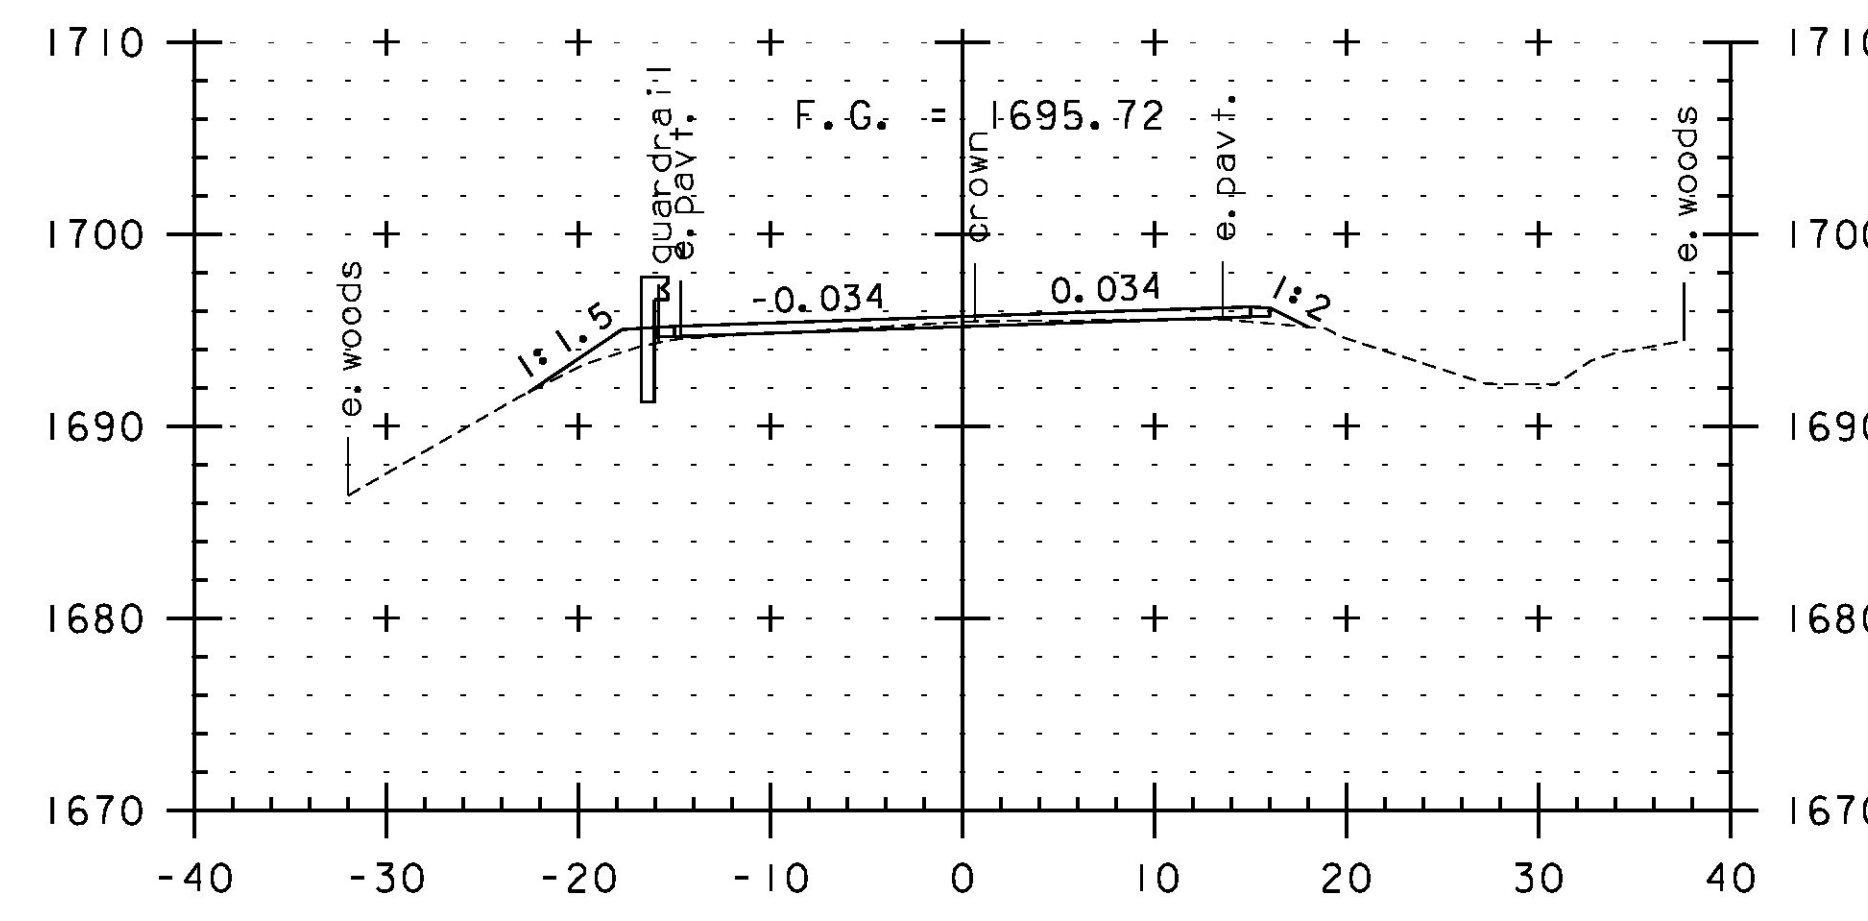


122+50

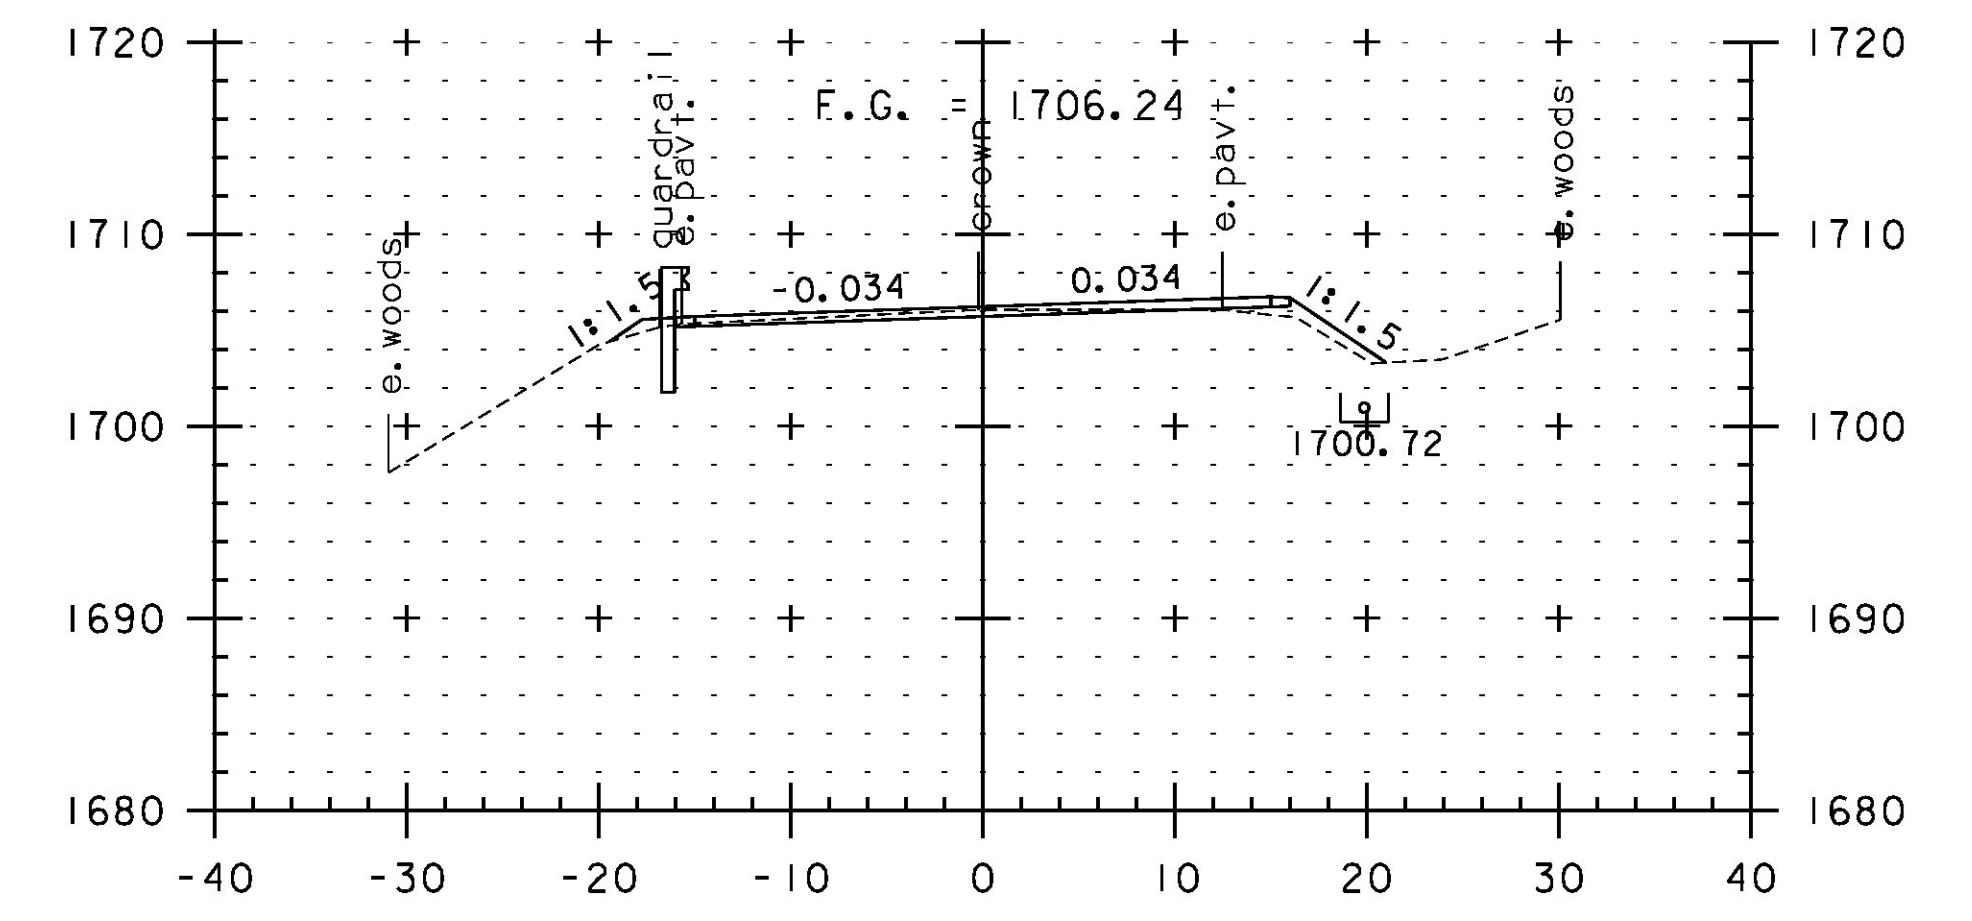


124+00

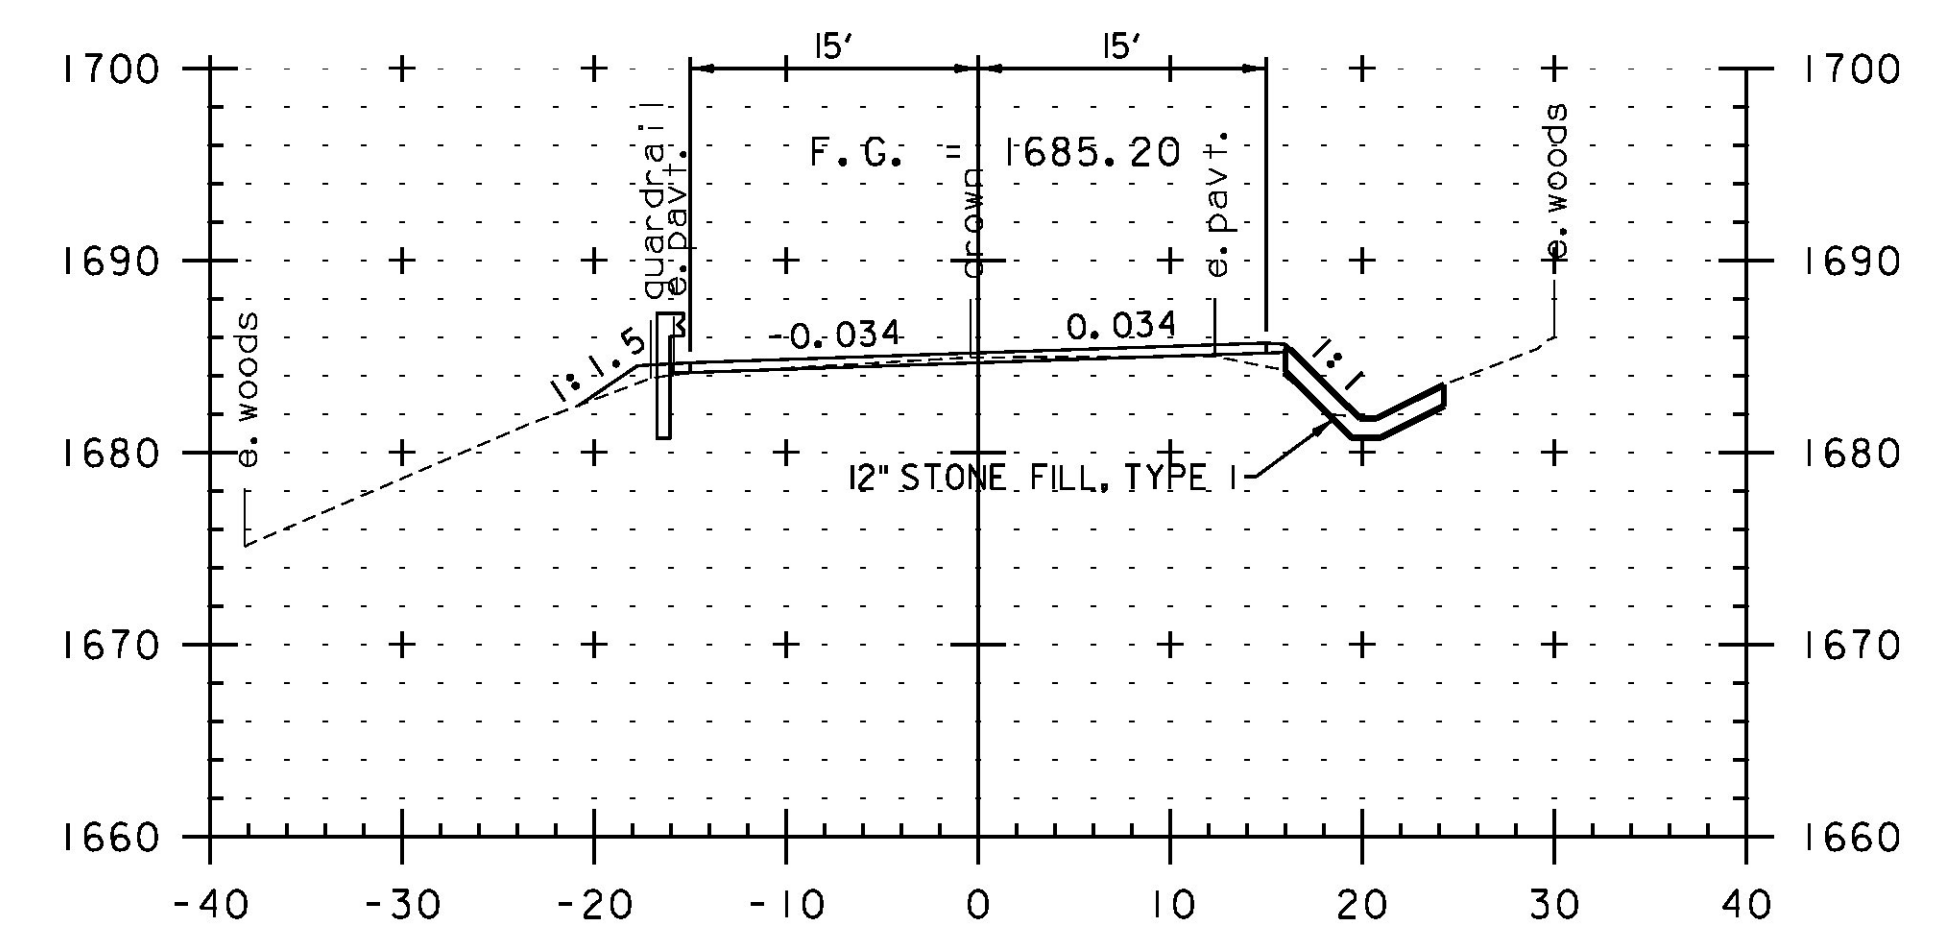


121+00

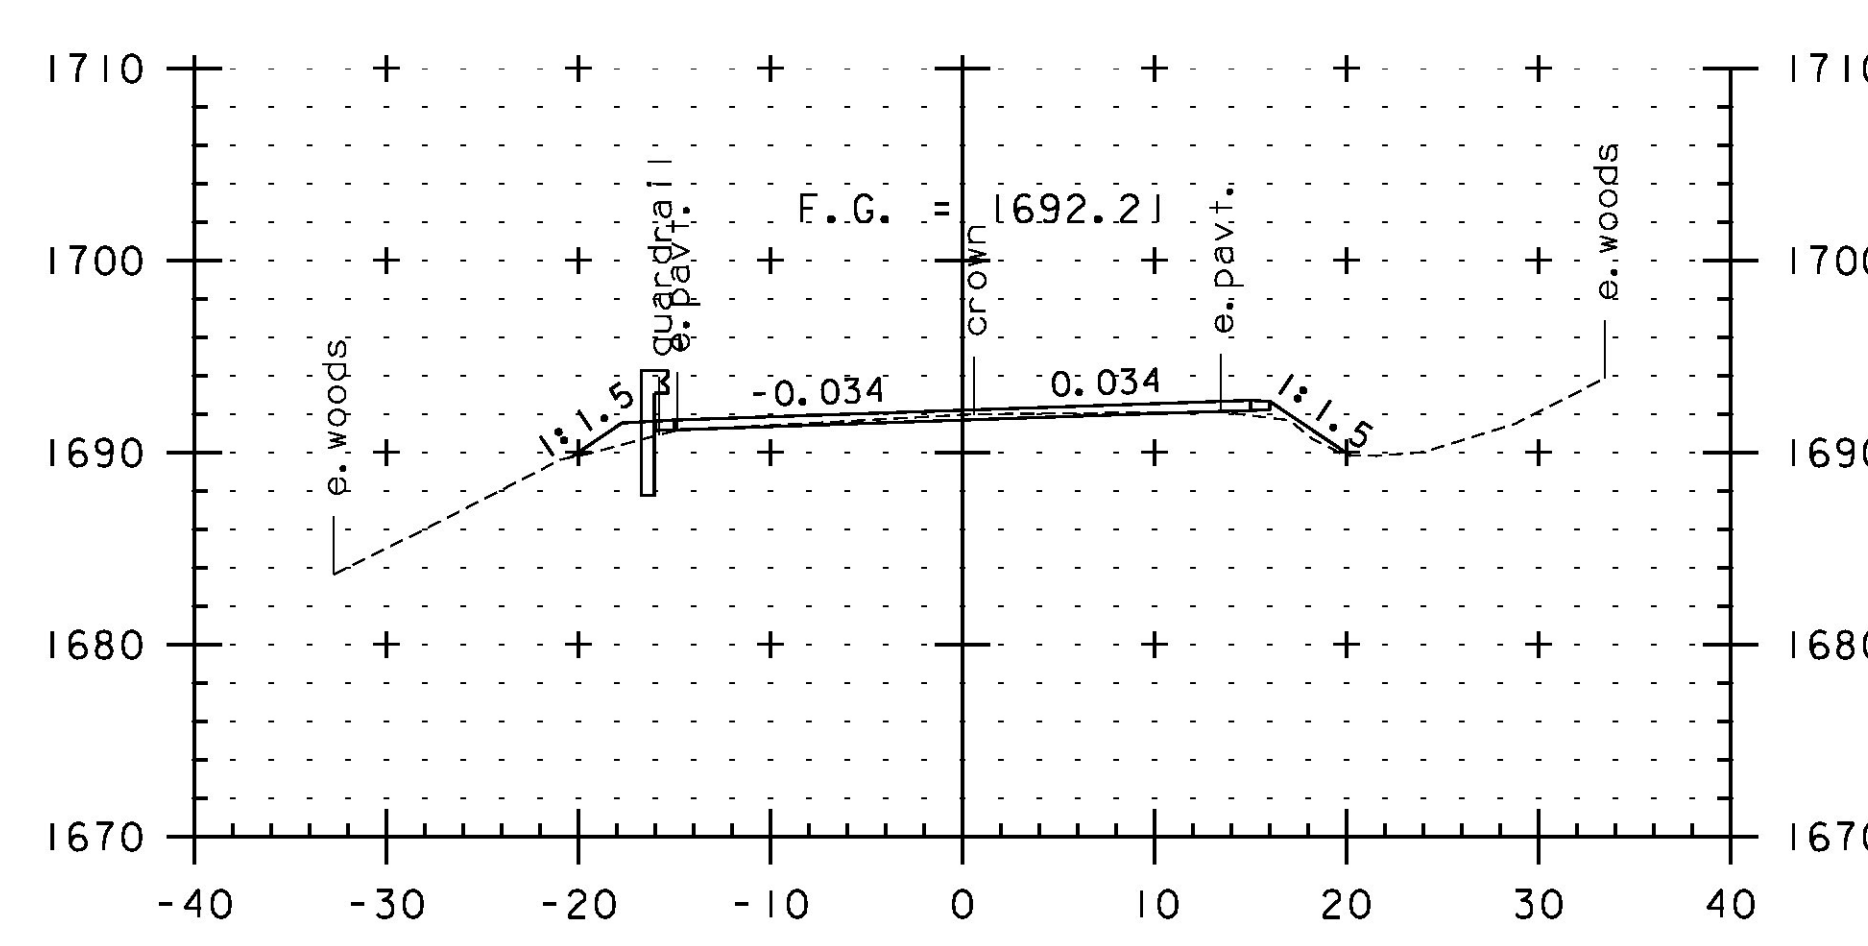

122+00

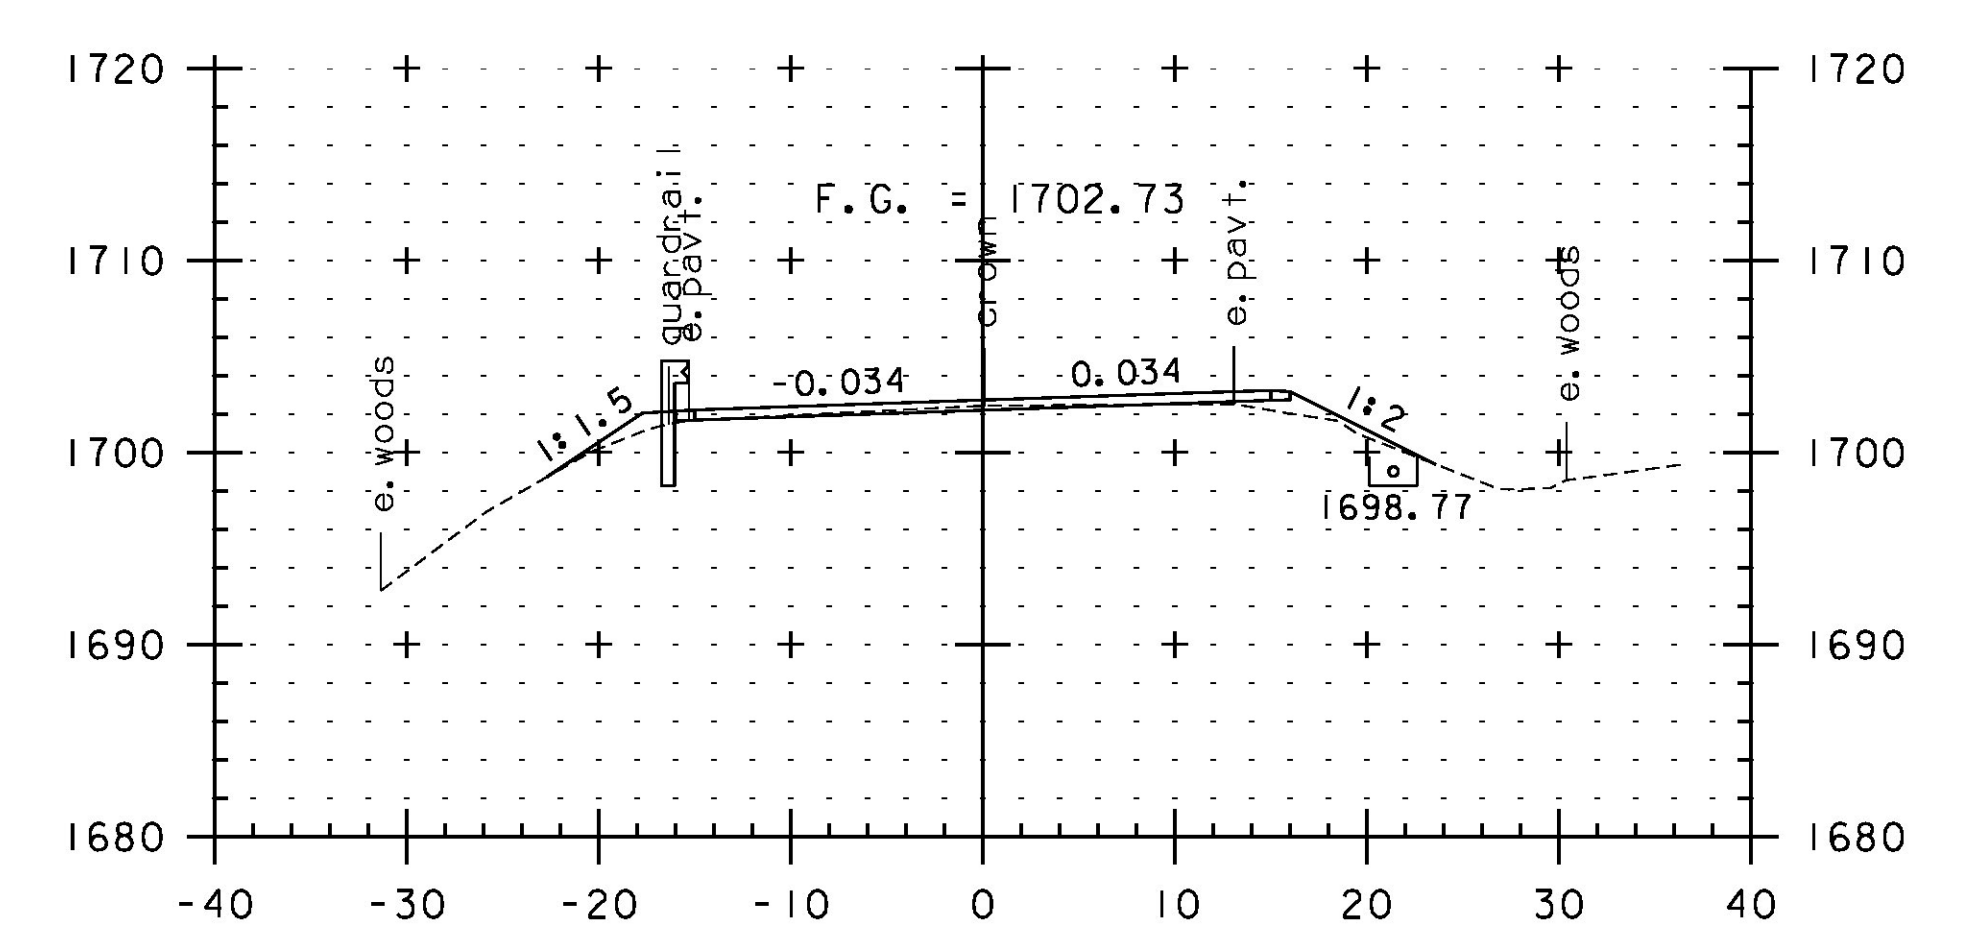

123+50

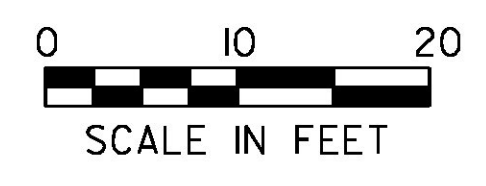

STA. 121+00 TO STA. 124+50

PROJECT NAME:	JAY-TROY	PLOT DATE:	5/16/2014
PROJECT NUMBER:	STP 2315(I)	DRAWN BY:	W. GORDON
FILE NAME:	z10b232xs.dgn	DESIGNED BY:	N. LEMAY
PROJECT LEADER:	P. SHEDD	CROSS SECTION SHEET 21	SHEET 157 OF 244