




130+50

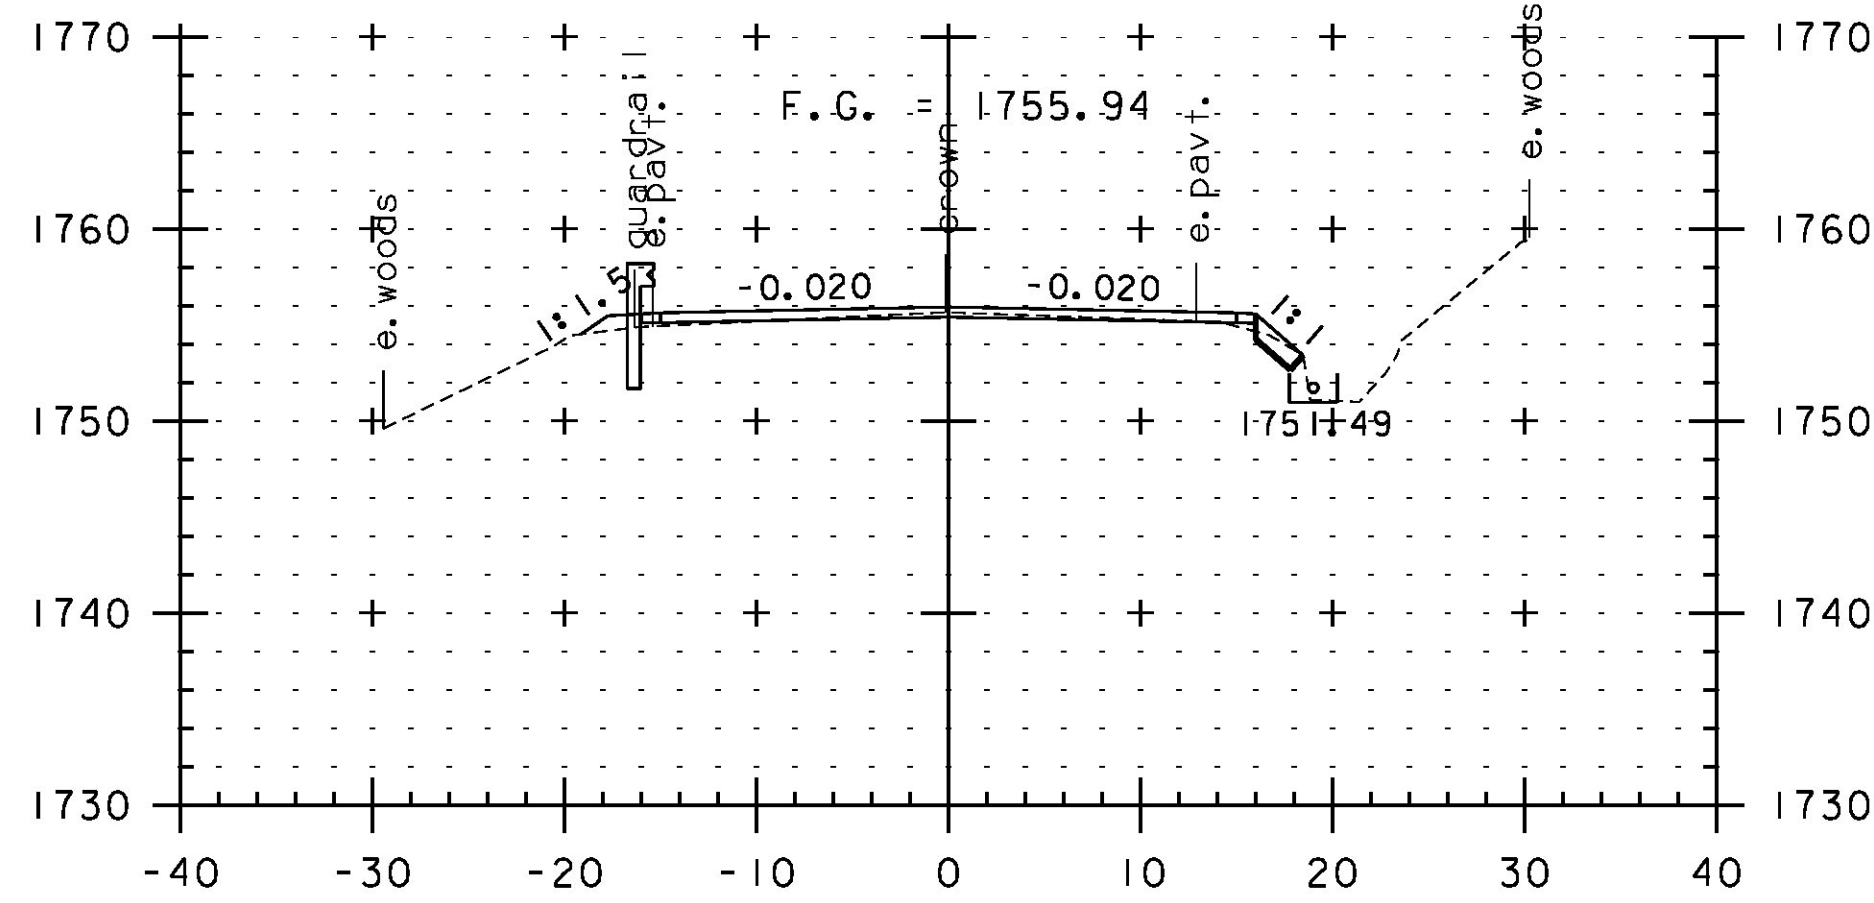


132+00

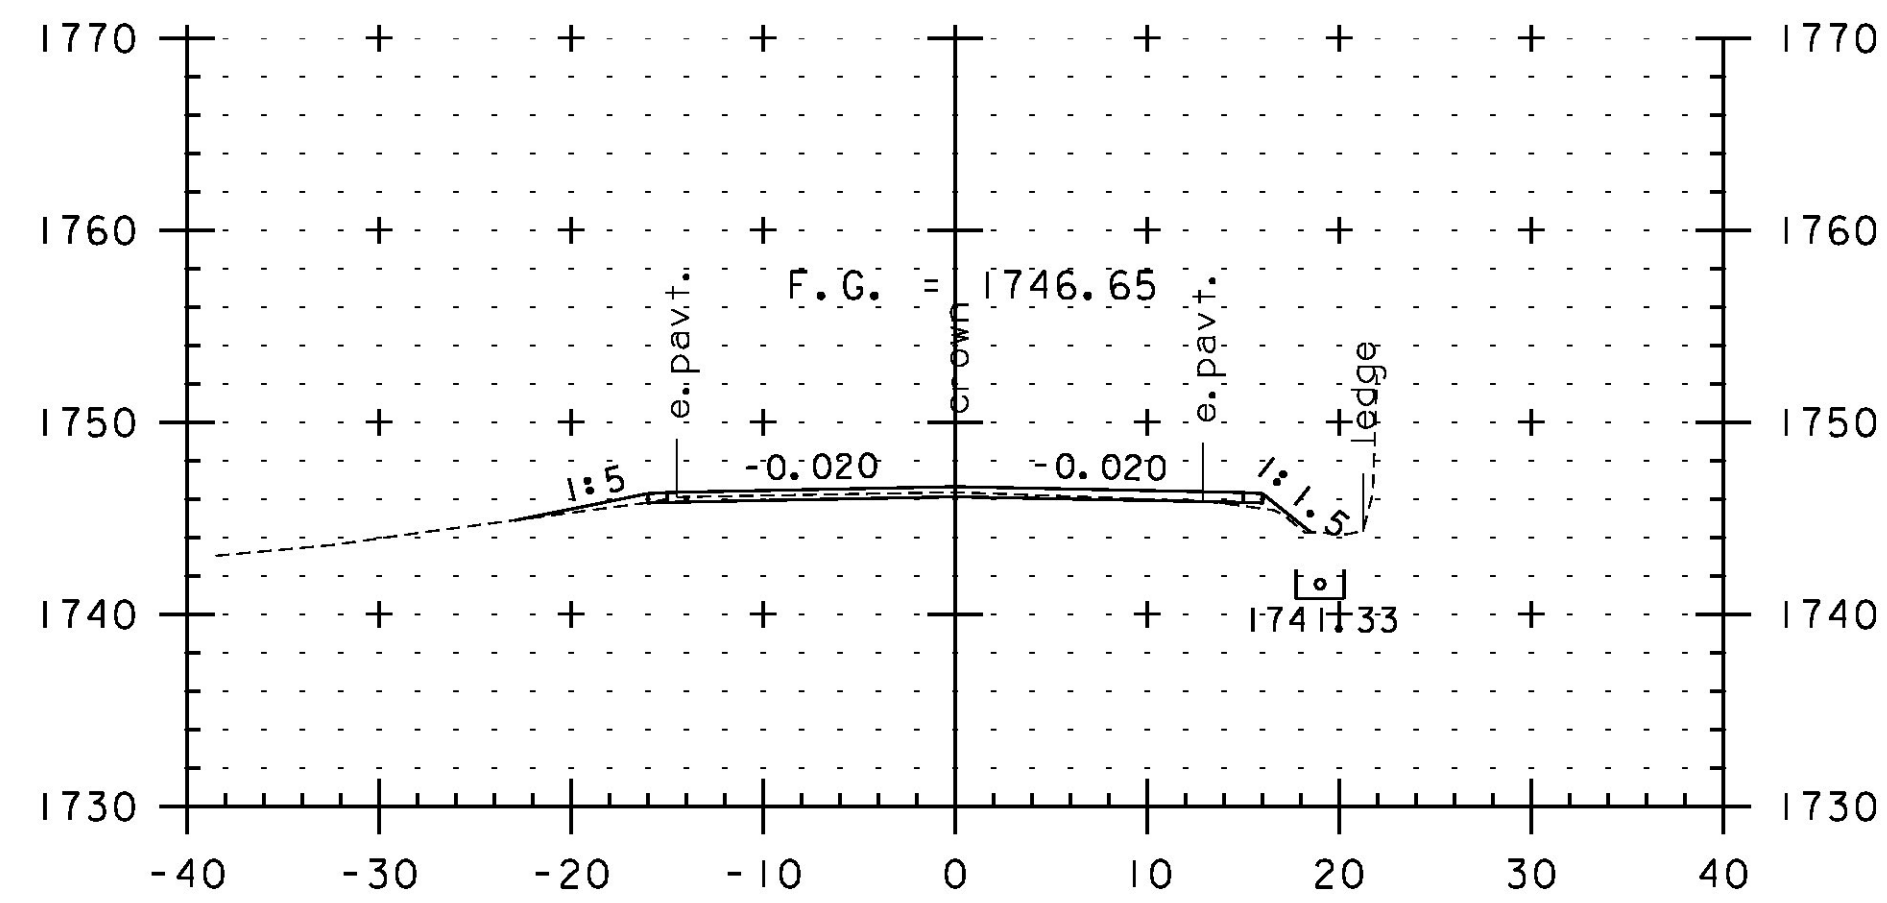


130+00

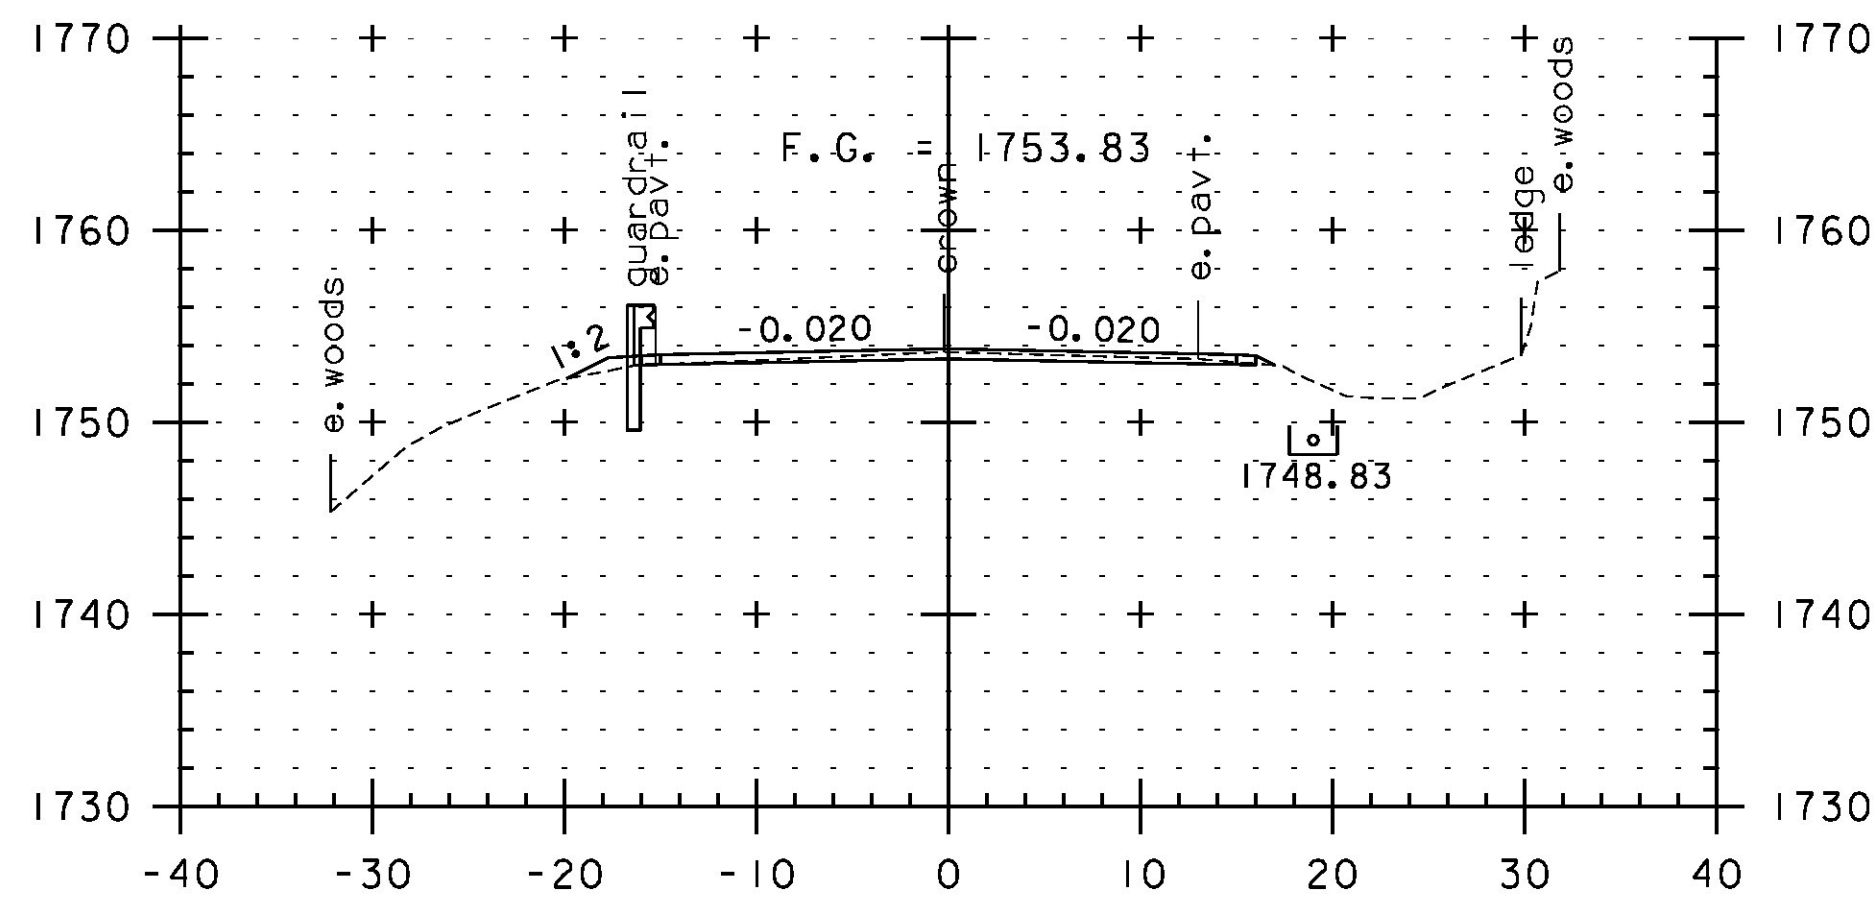


131+50

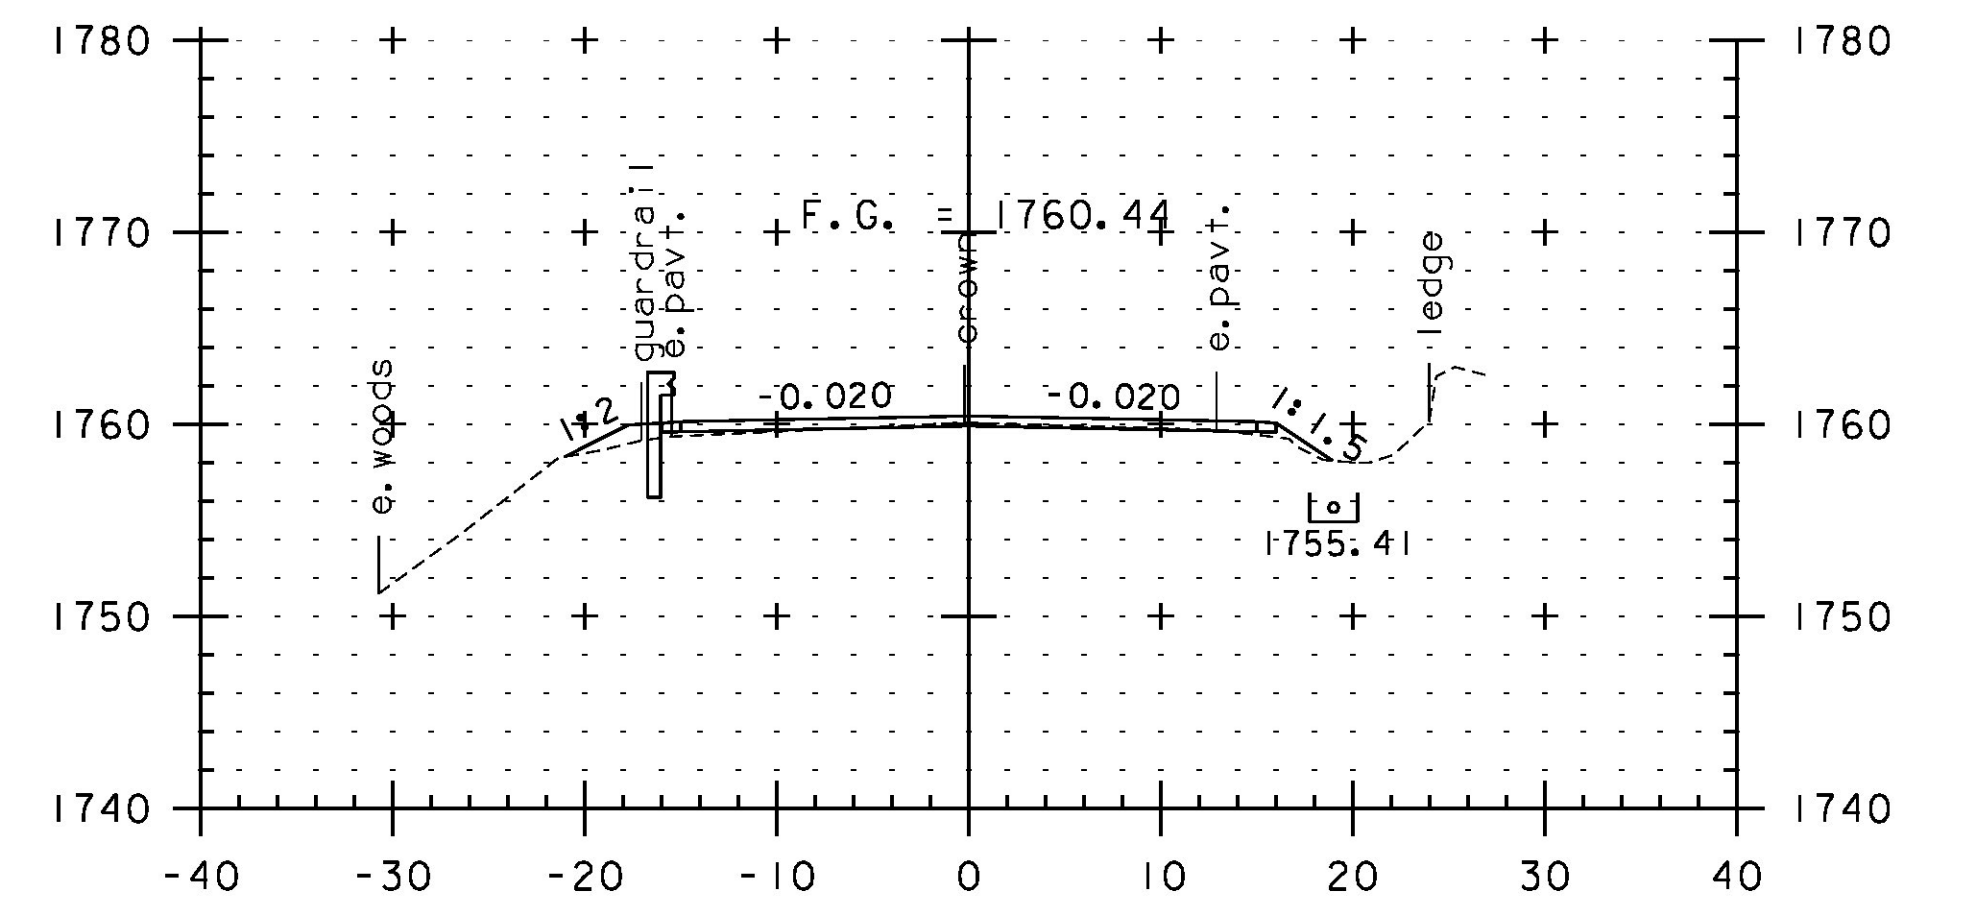


133+00

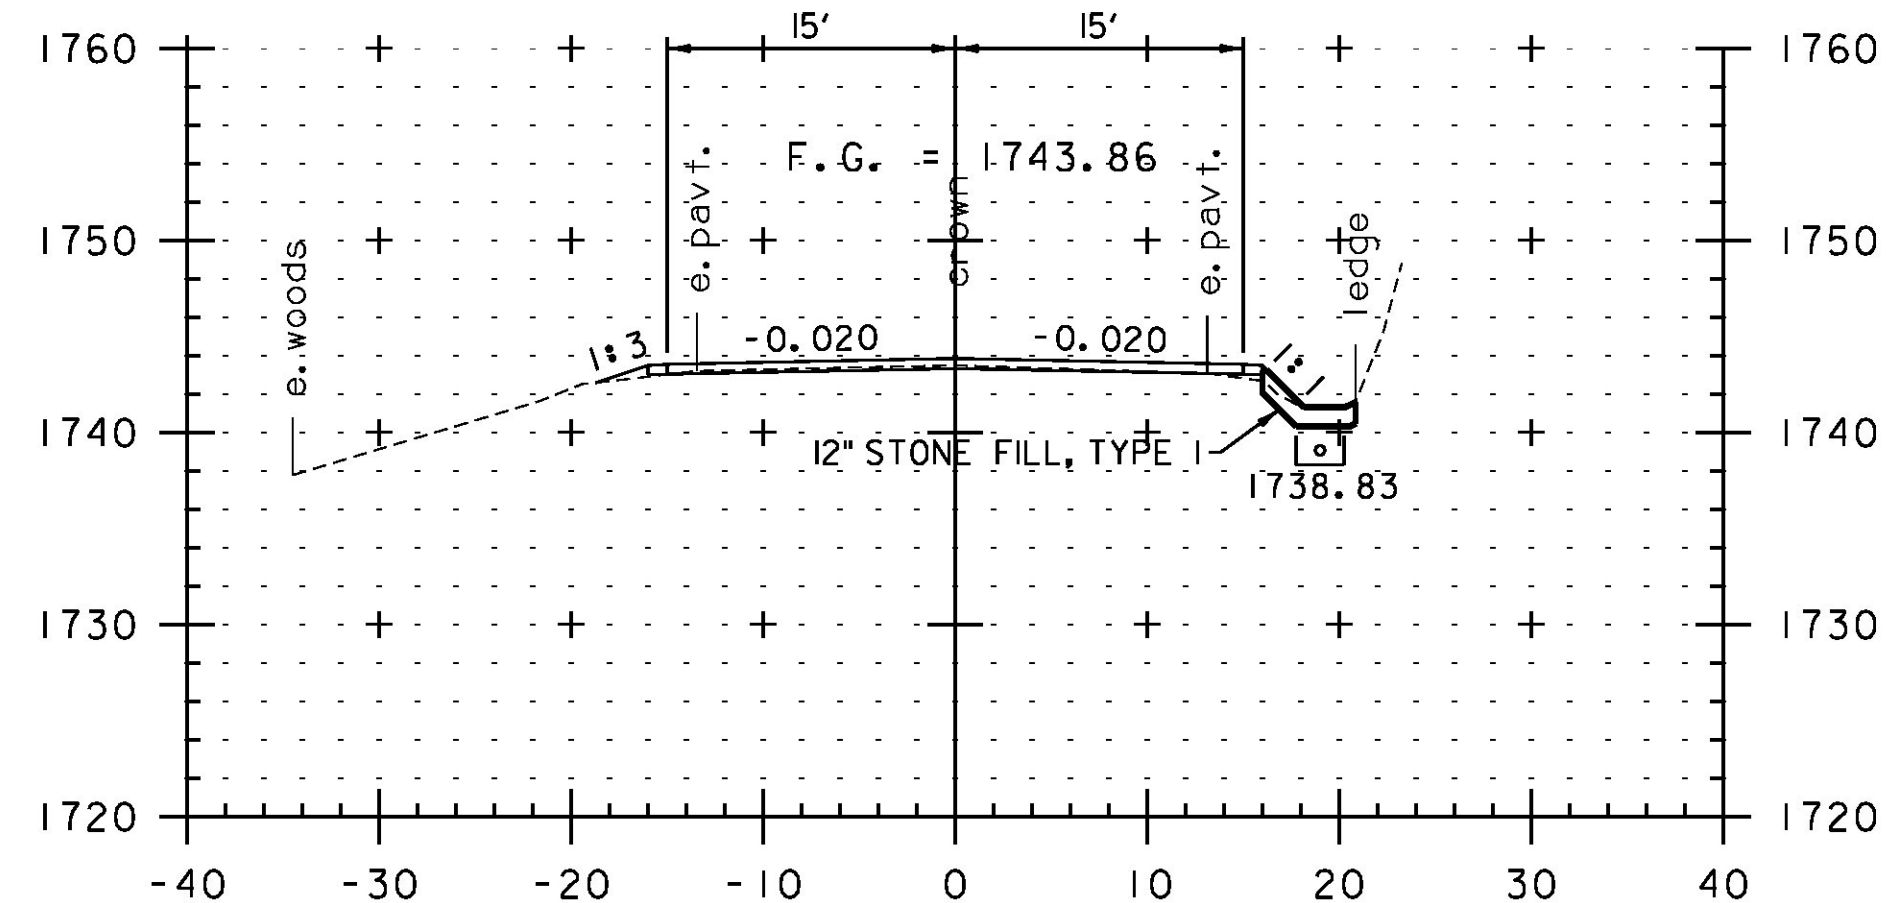


129+50

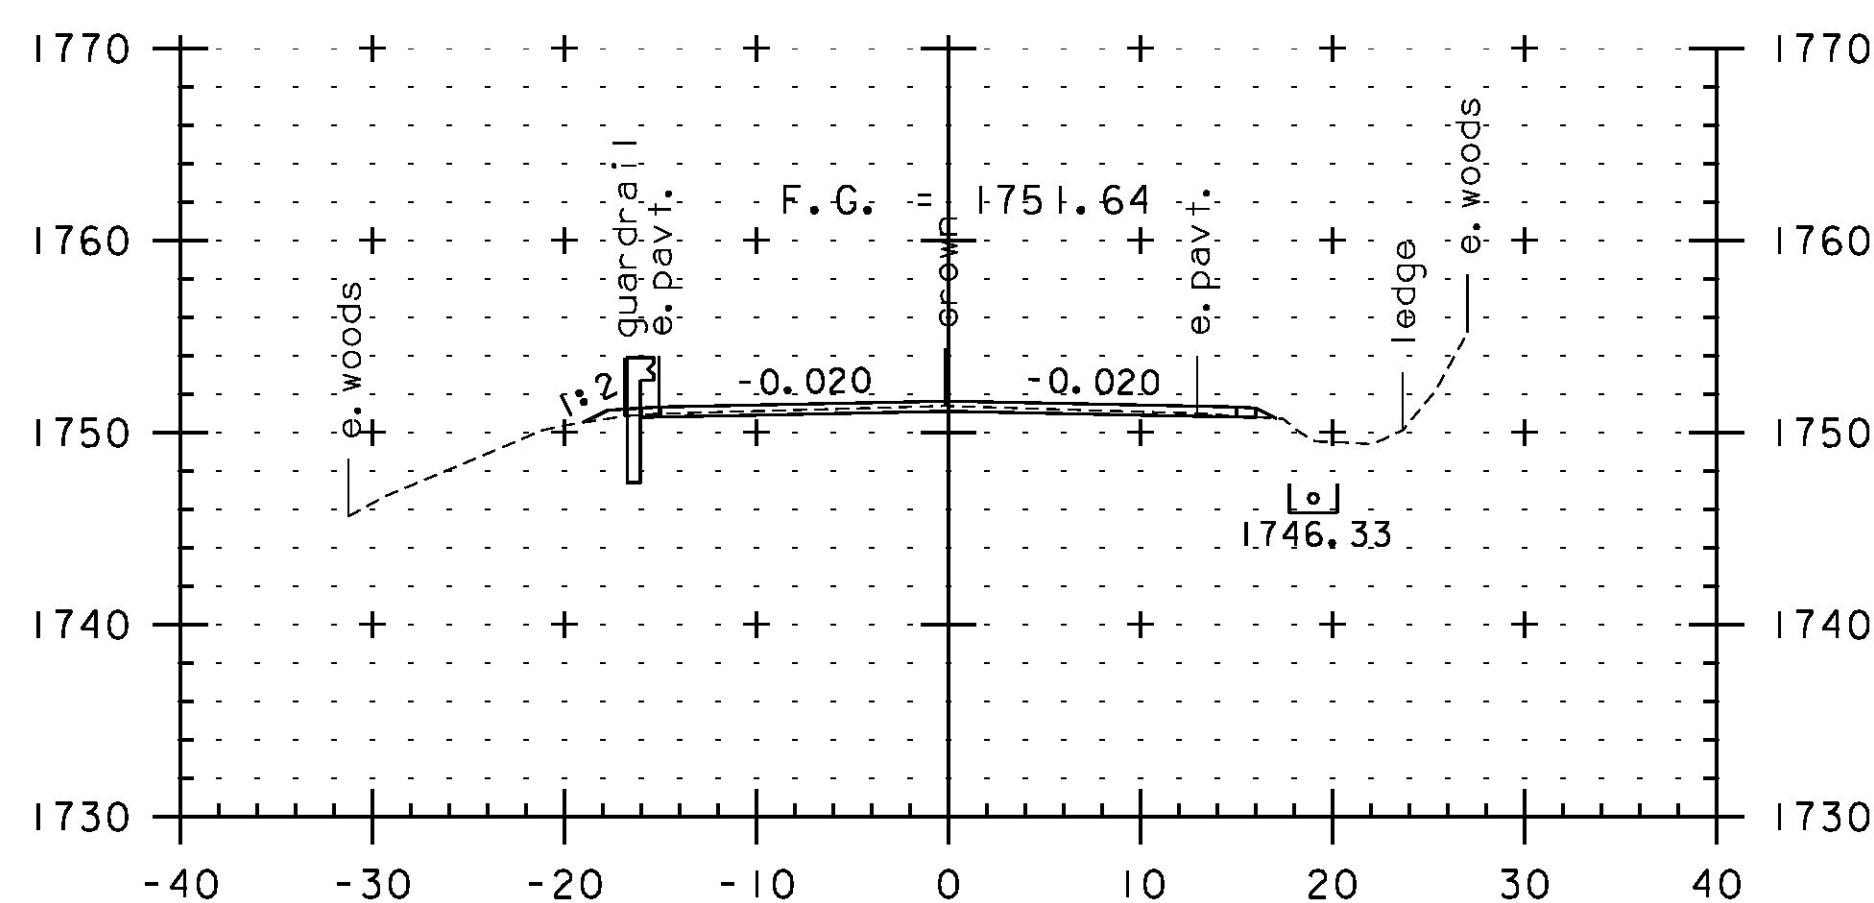

131+00

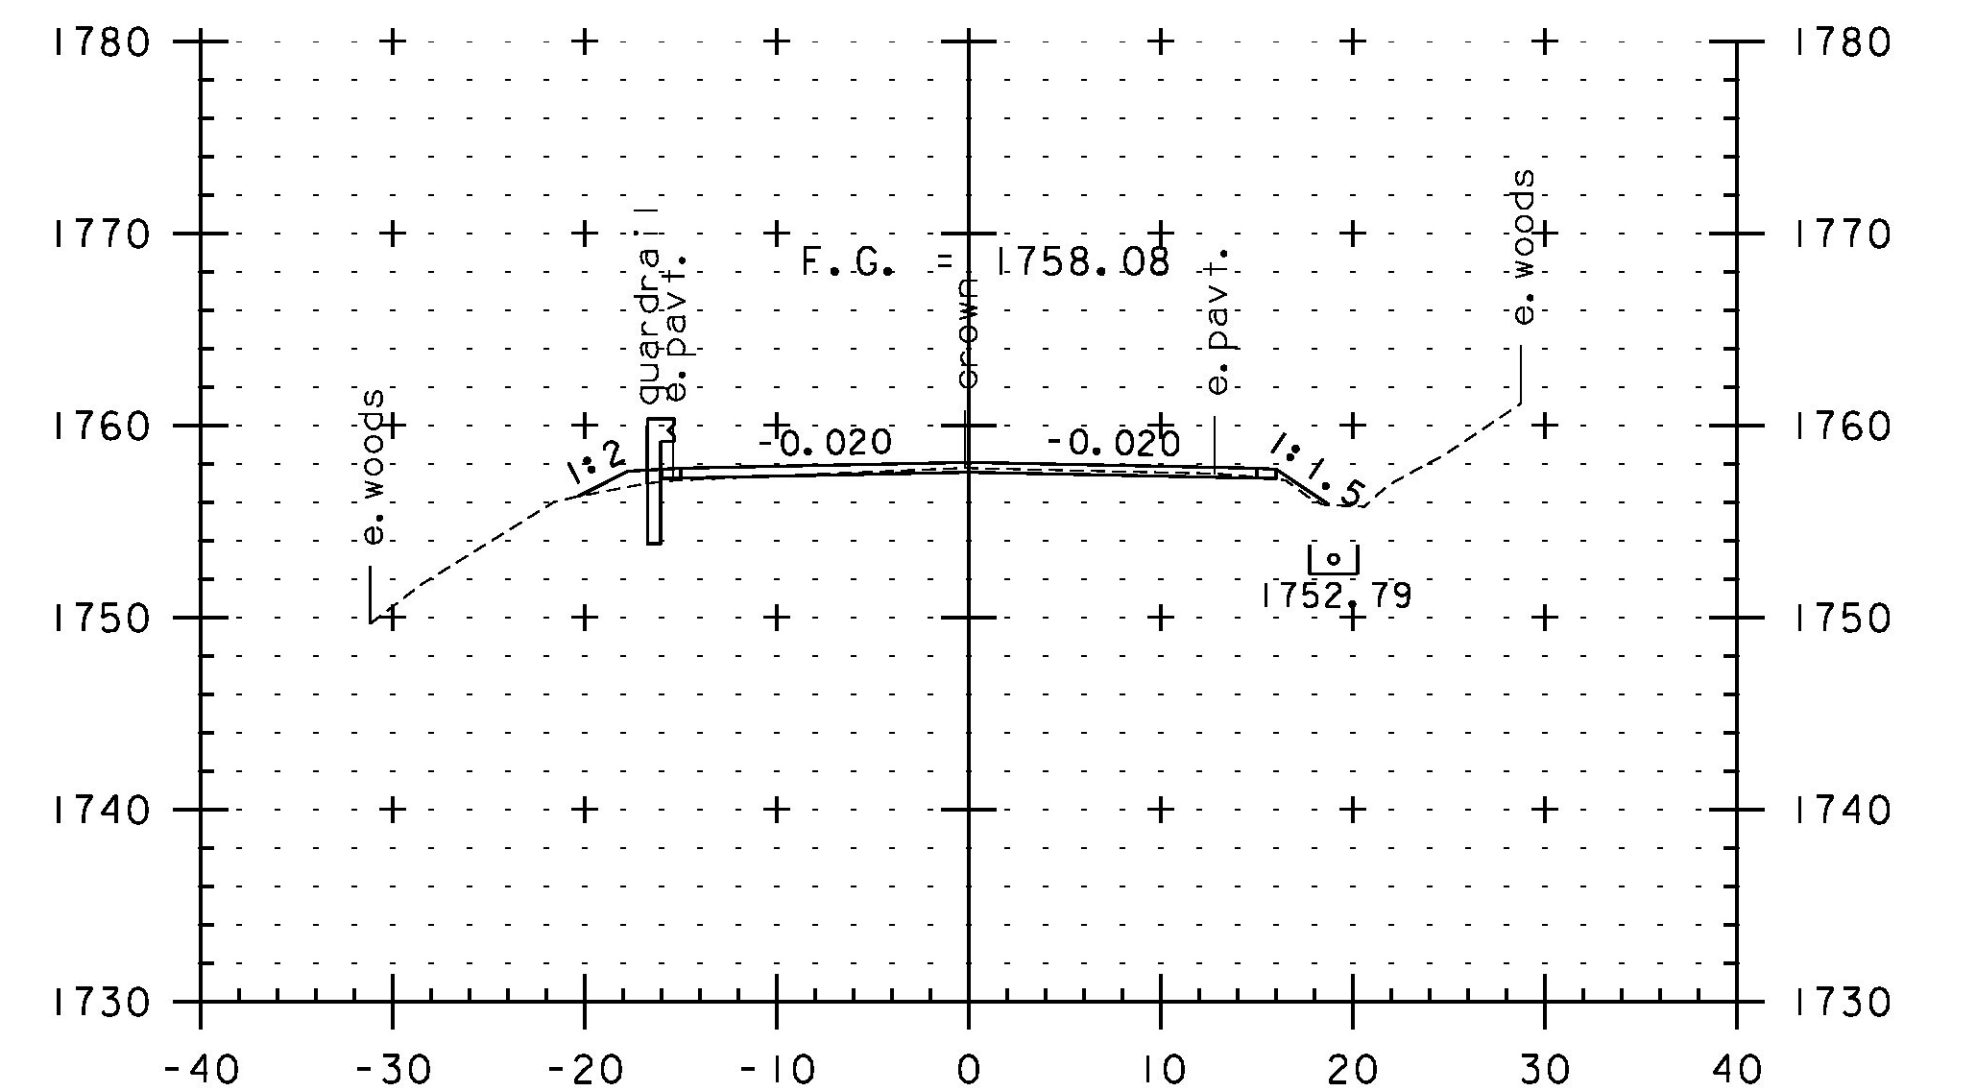

132+50

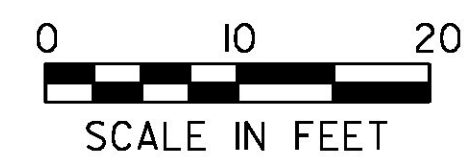

SCALE IN FEET

STA. 129+50 TO STA. 133+00

PROJECT NAME:	JAY-TROY	PLOT DATE:	5/16/2014
PROJECT NUMBER:	STP 2315(I)	DRAWN BY:	W. GORDON
FILE NAME:	z10b232xs.dgn	DESIGNED BY:	N. LEMAY
PROJECT LEADER:	P. SHEDD	CHECKED BY:	P. SHEDD
CROSS SECTION SHEET 23			SHEET 159 OF 244