




134+50

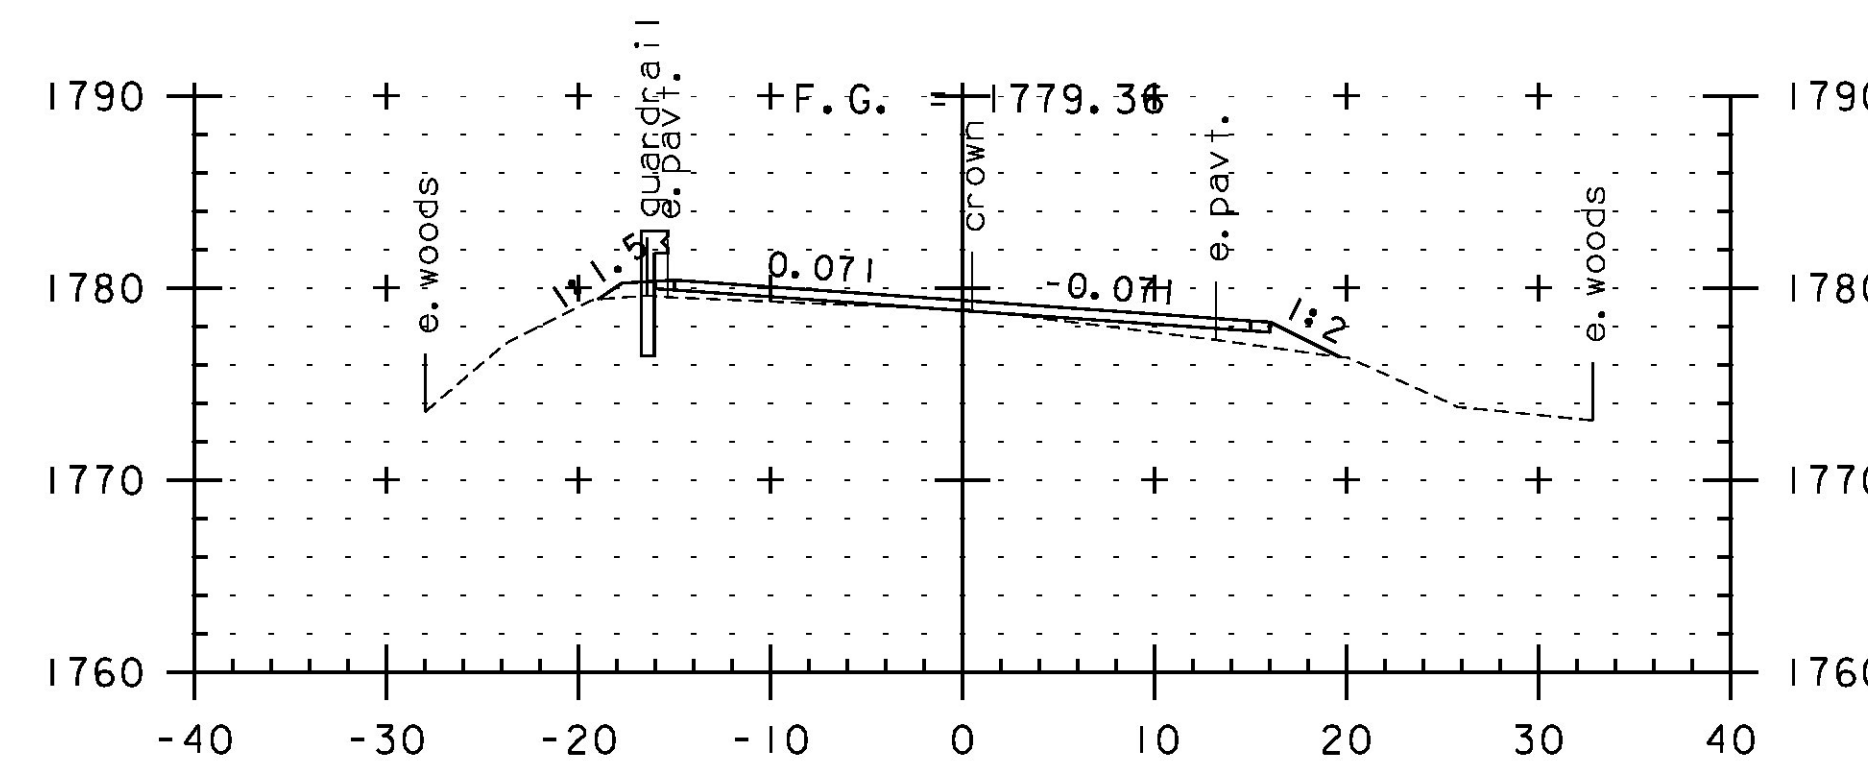


136+00

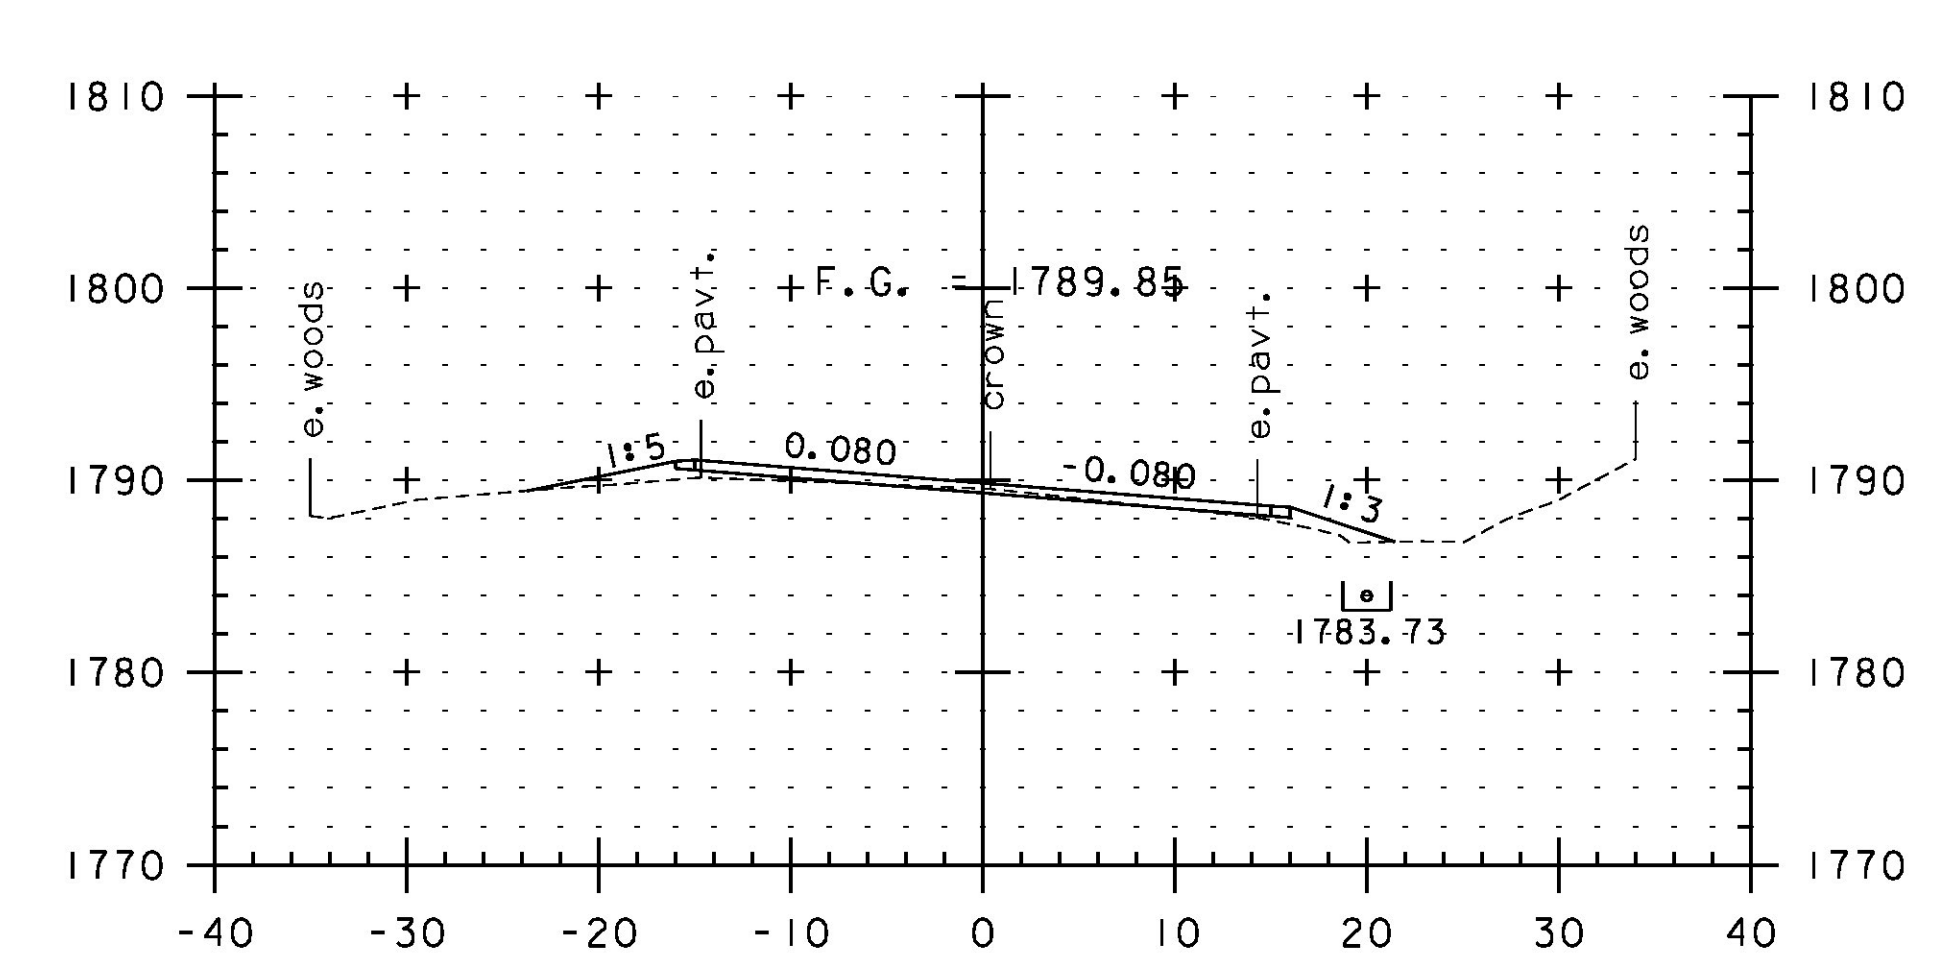


137+50

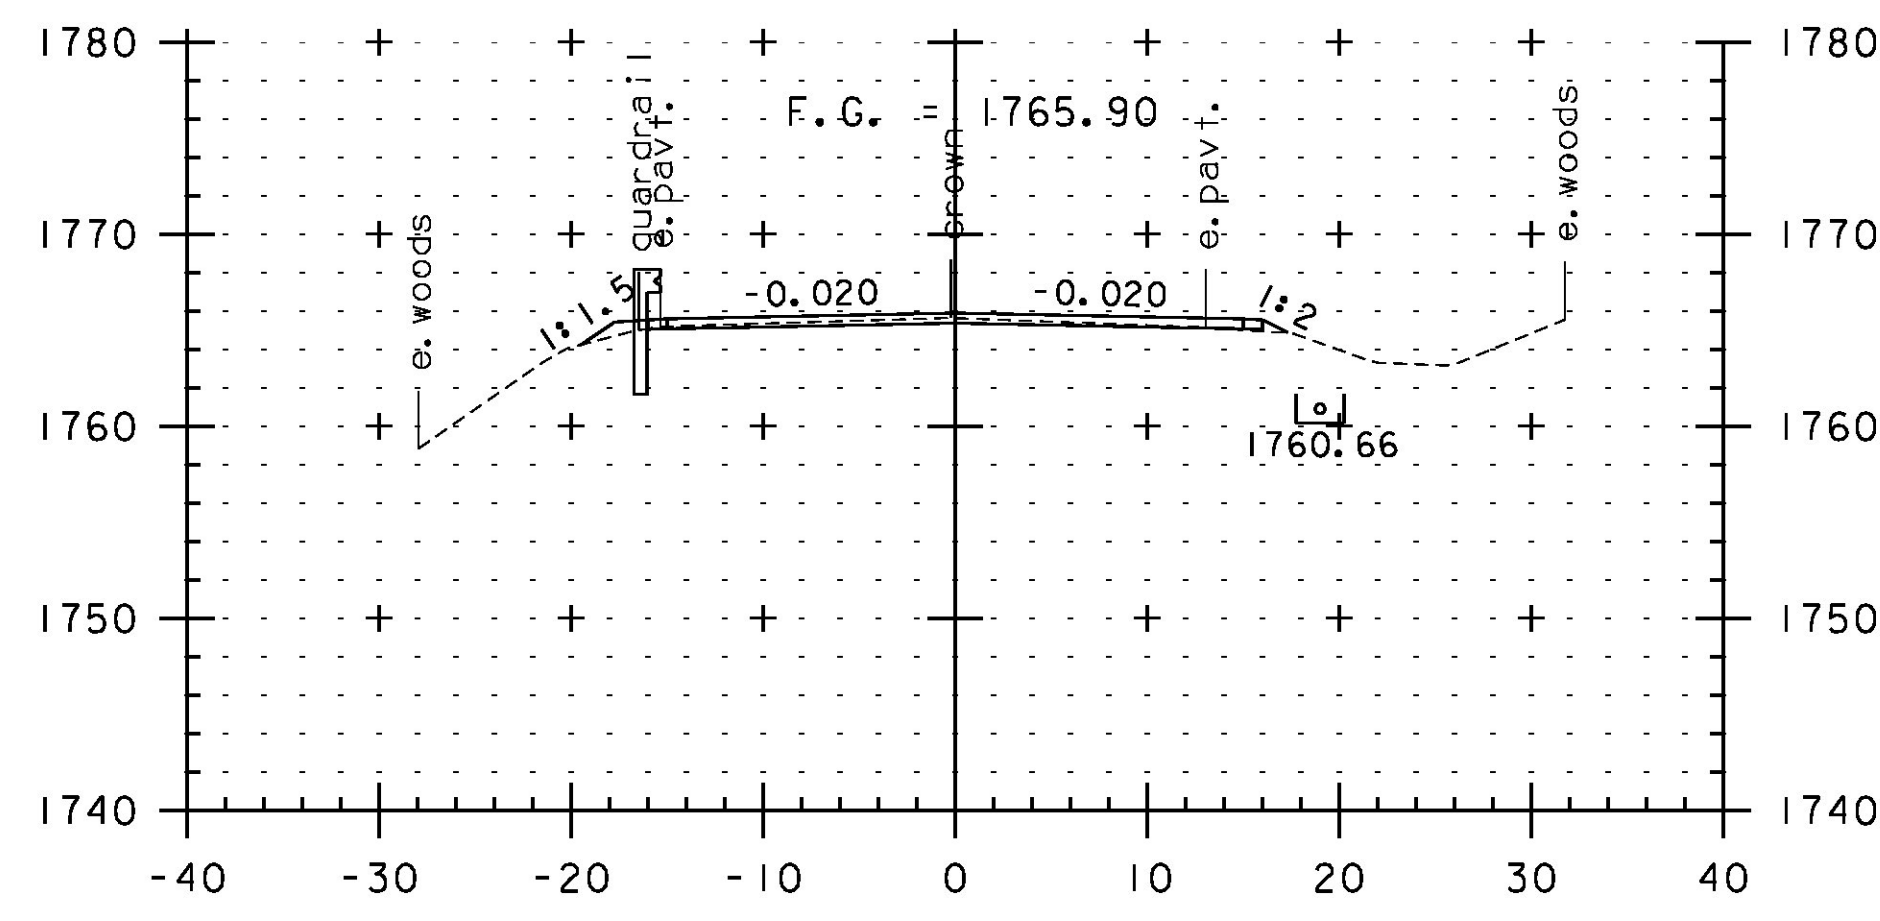


134+00

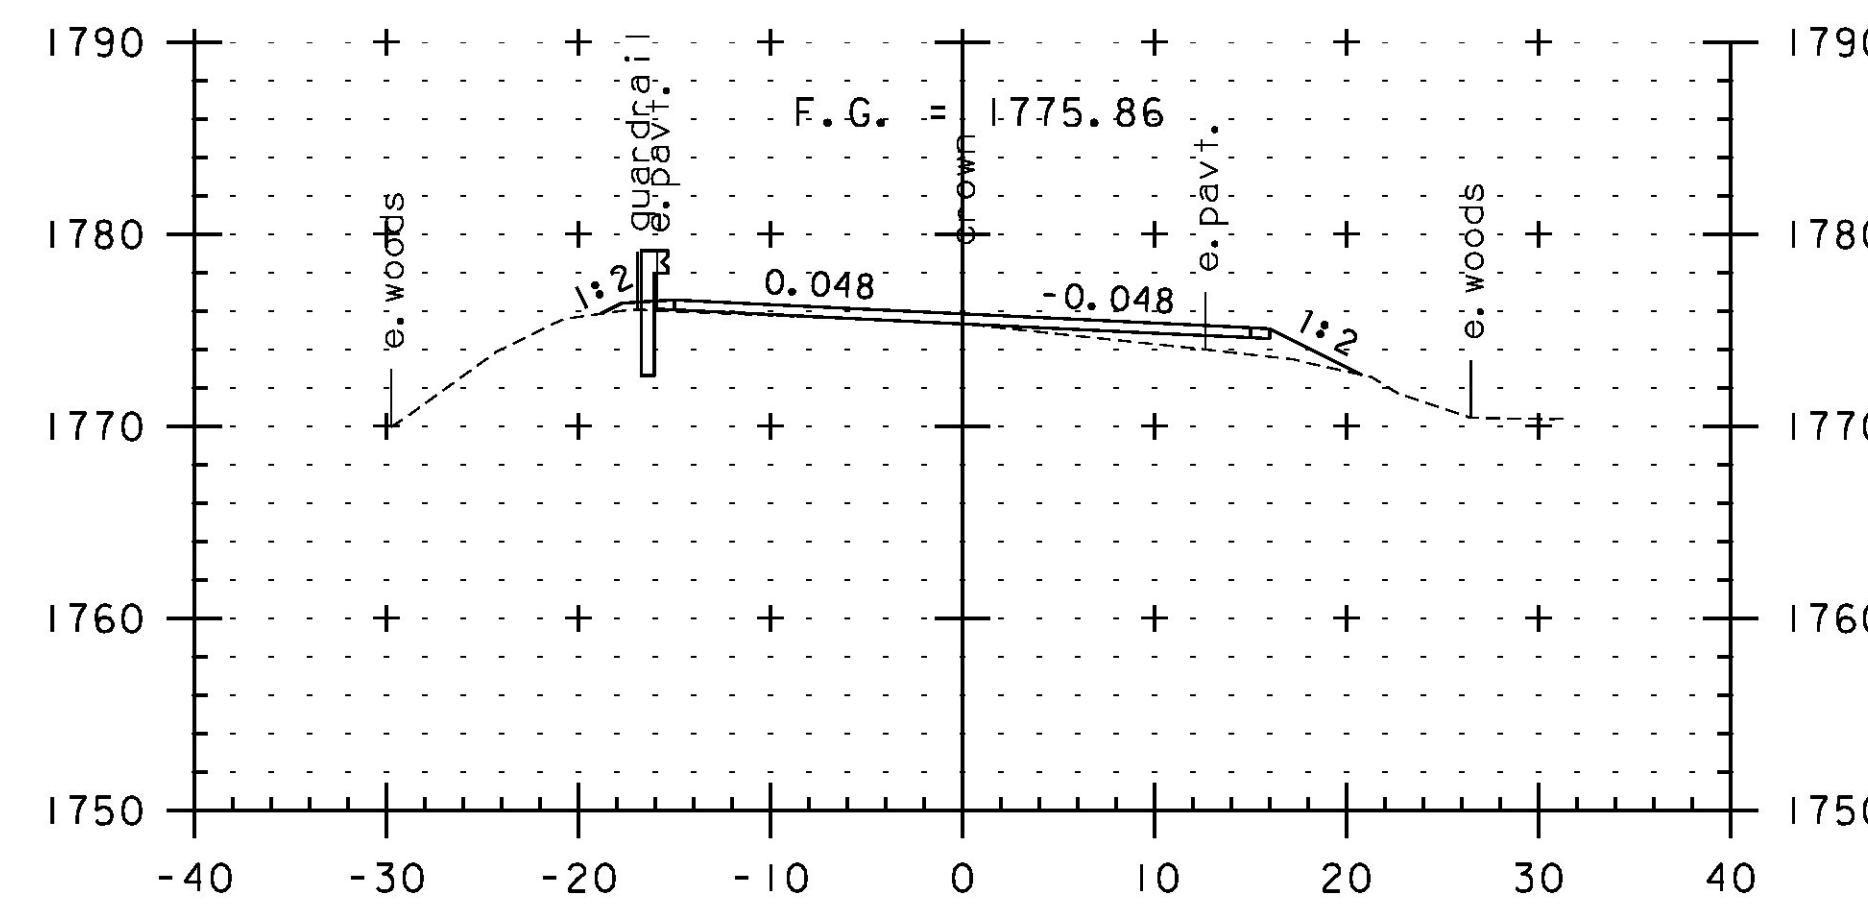


135+50

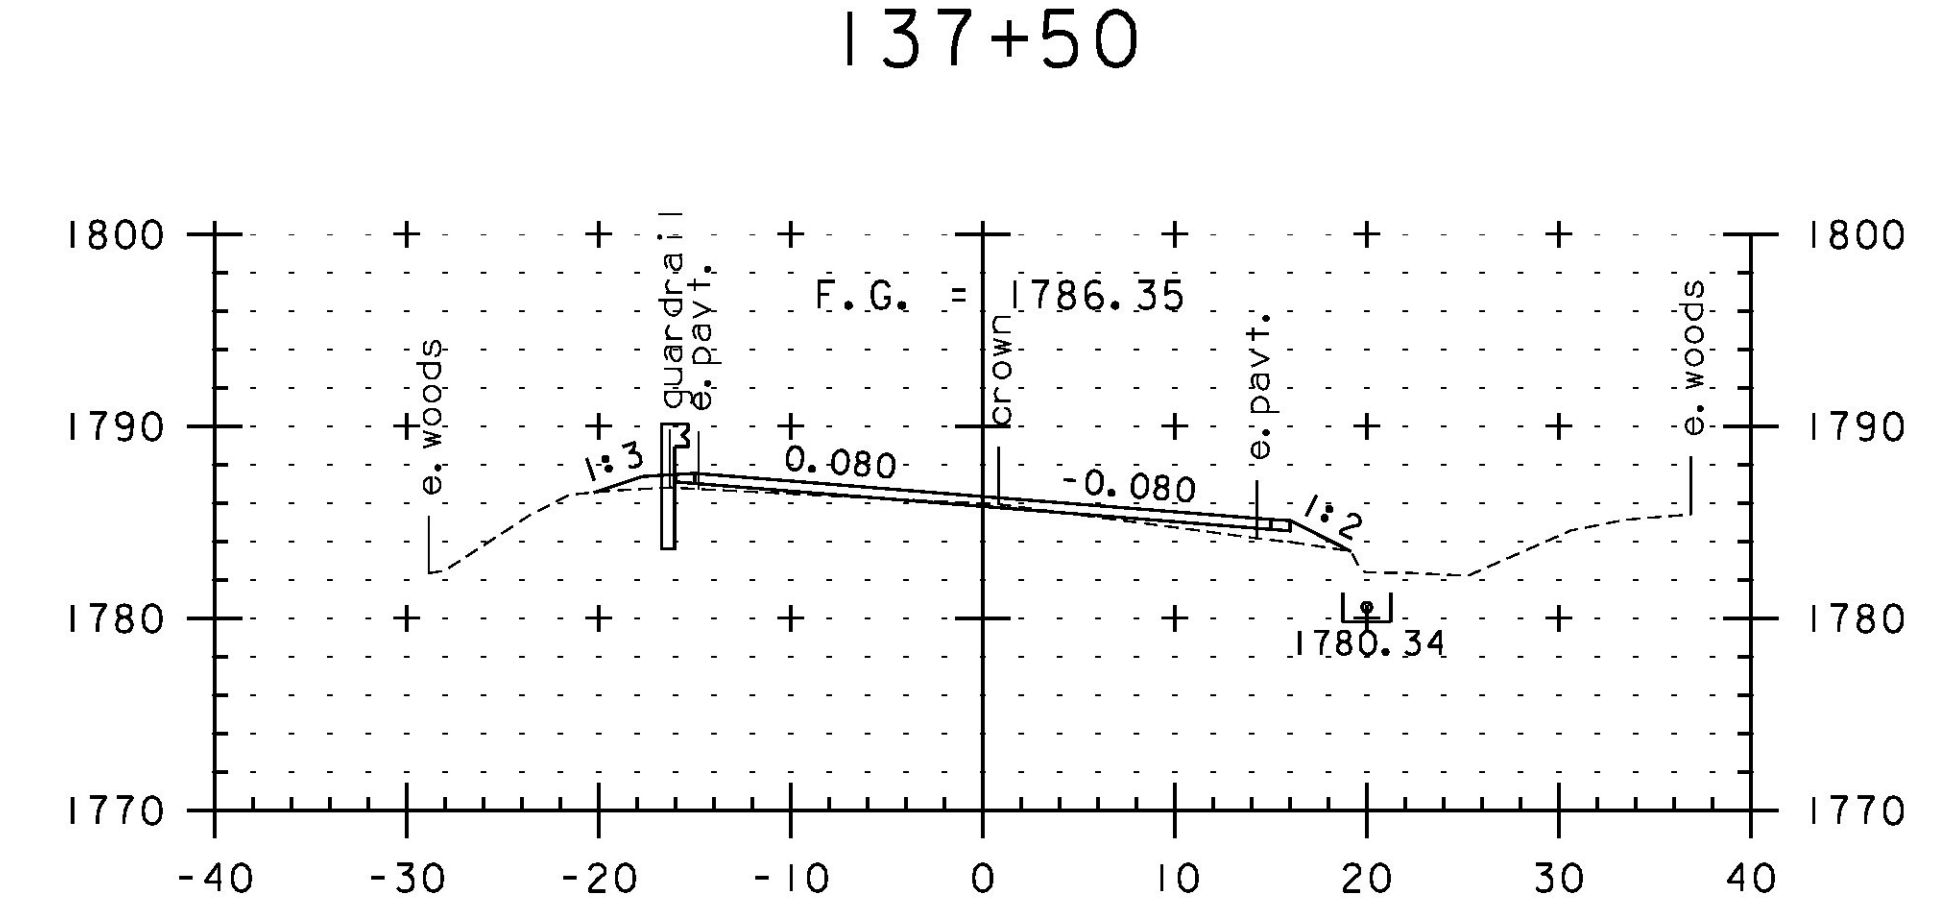


137+00

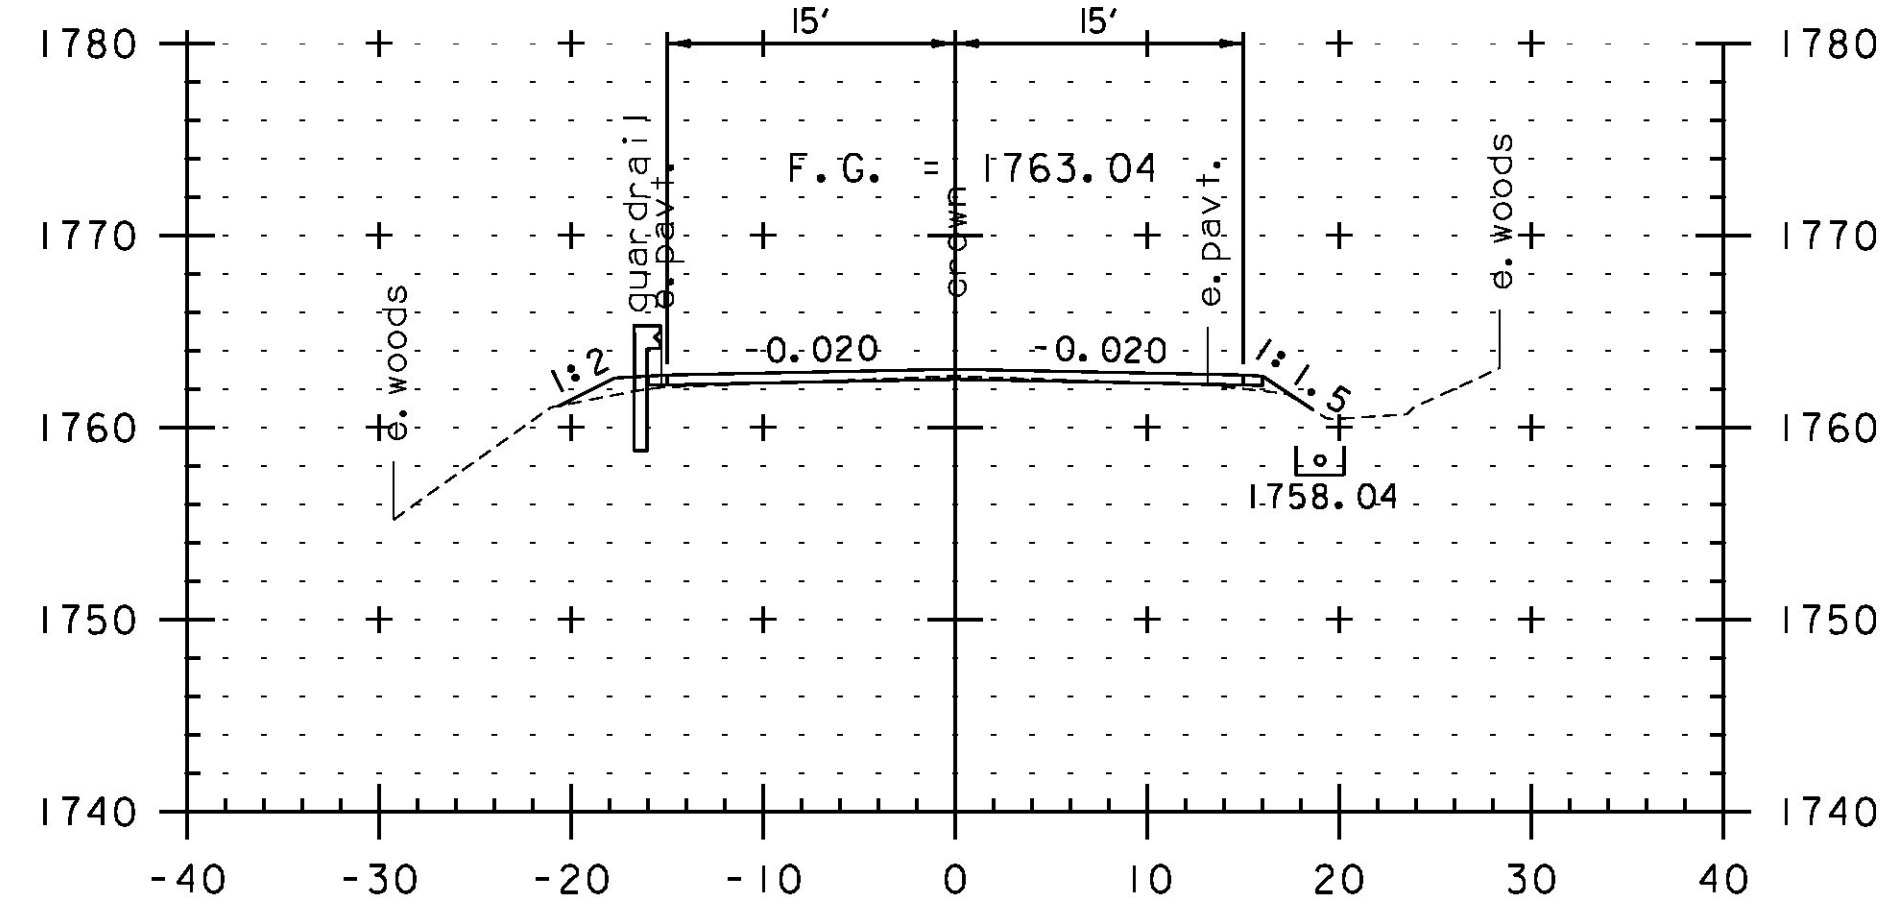


133+50

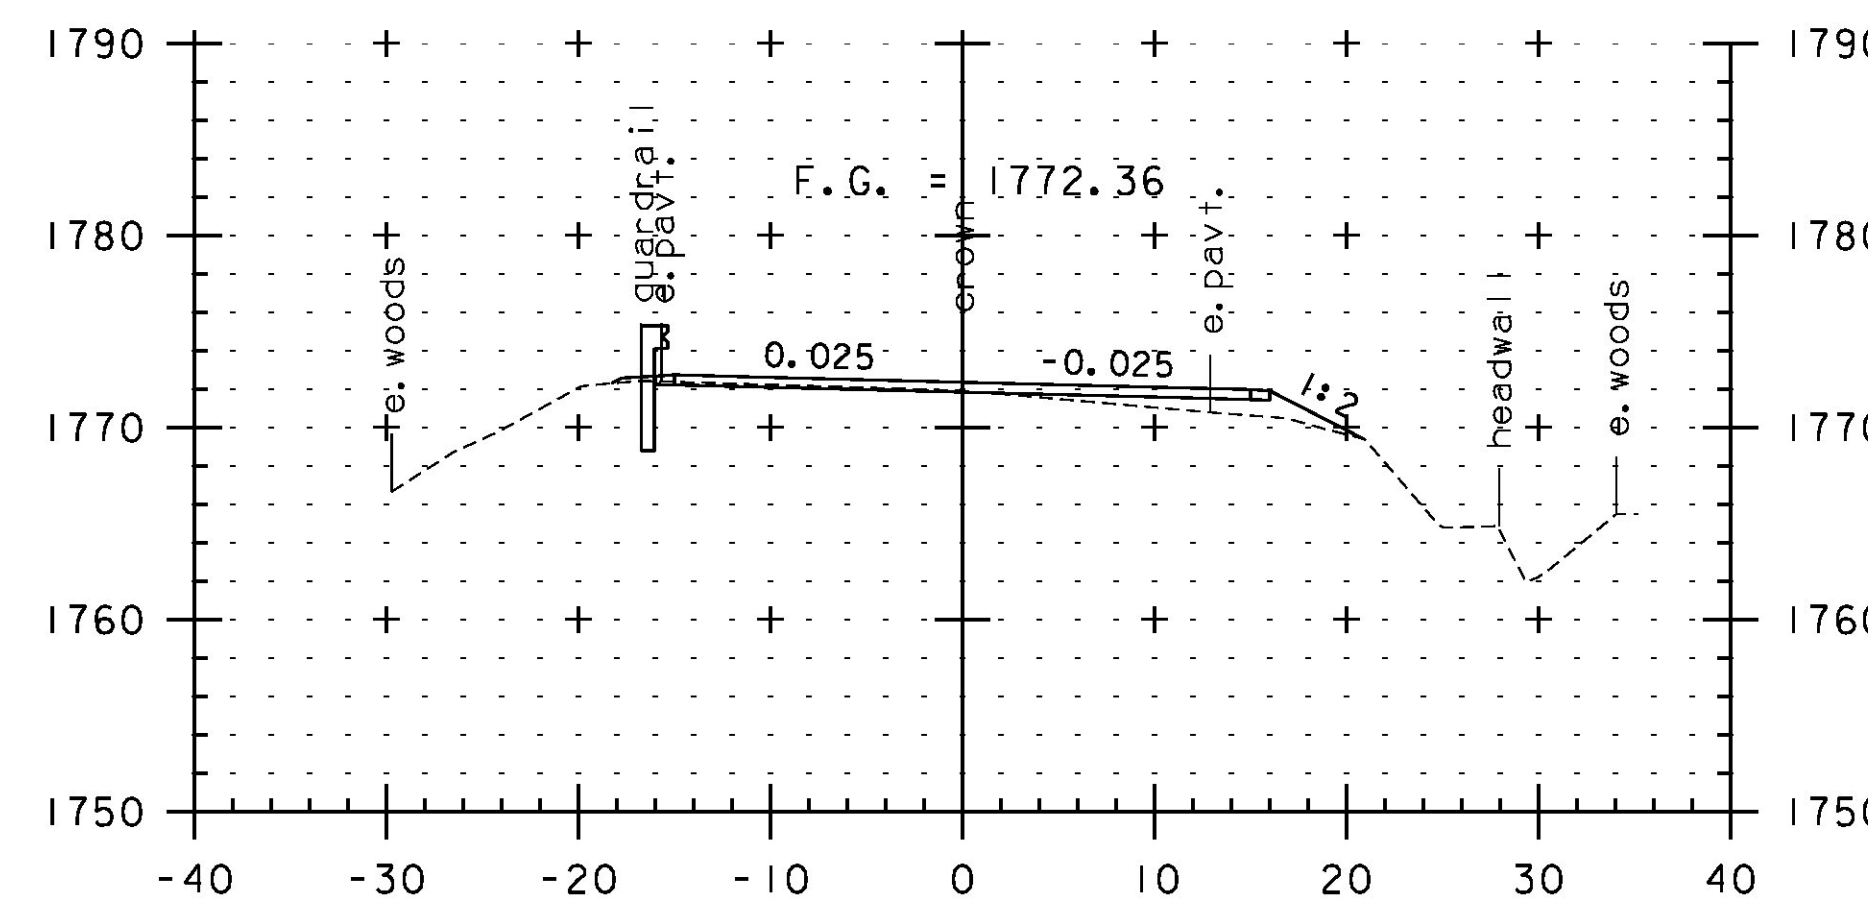

135+00

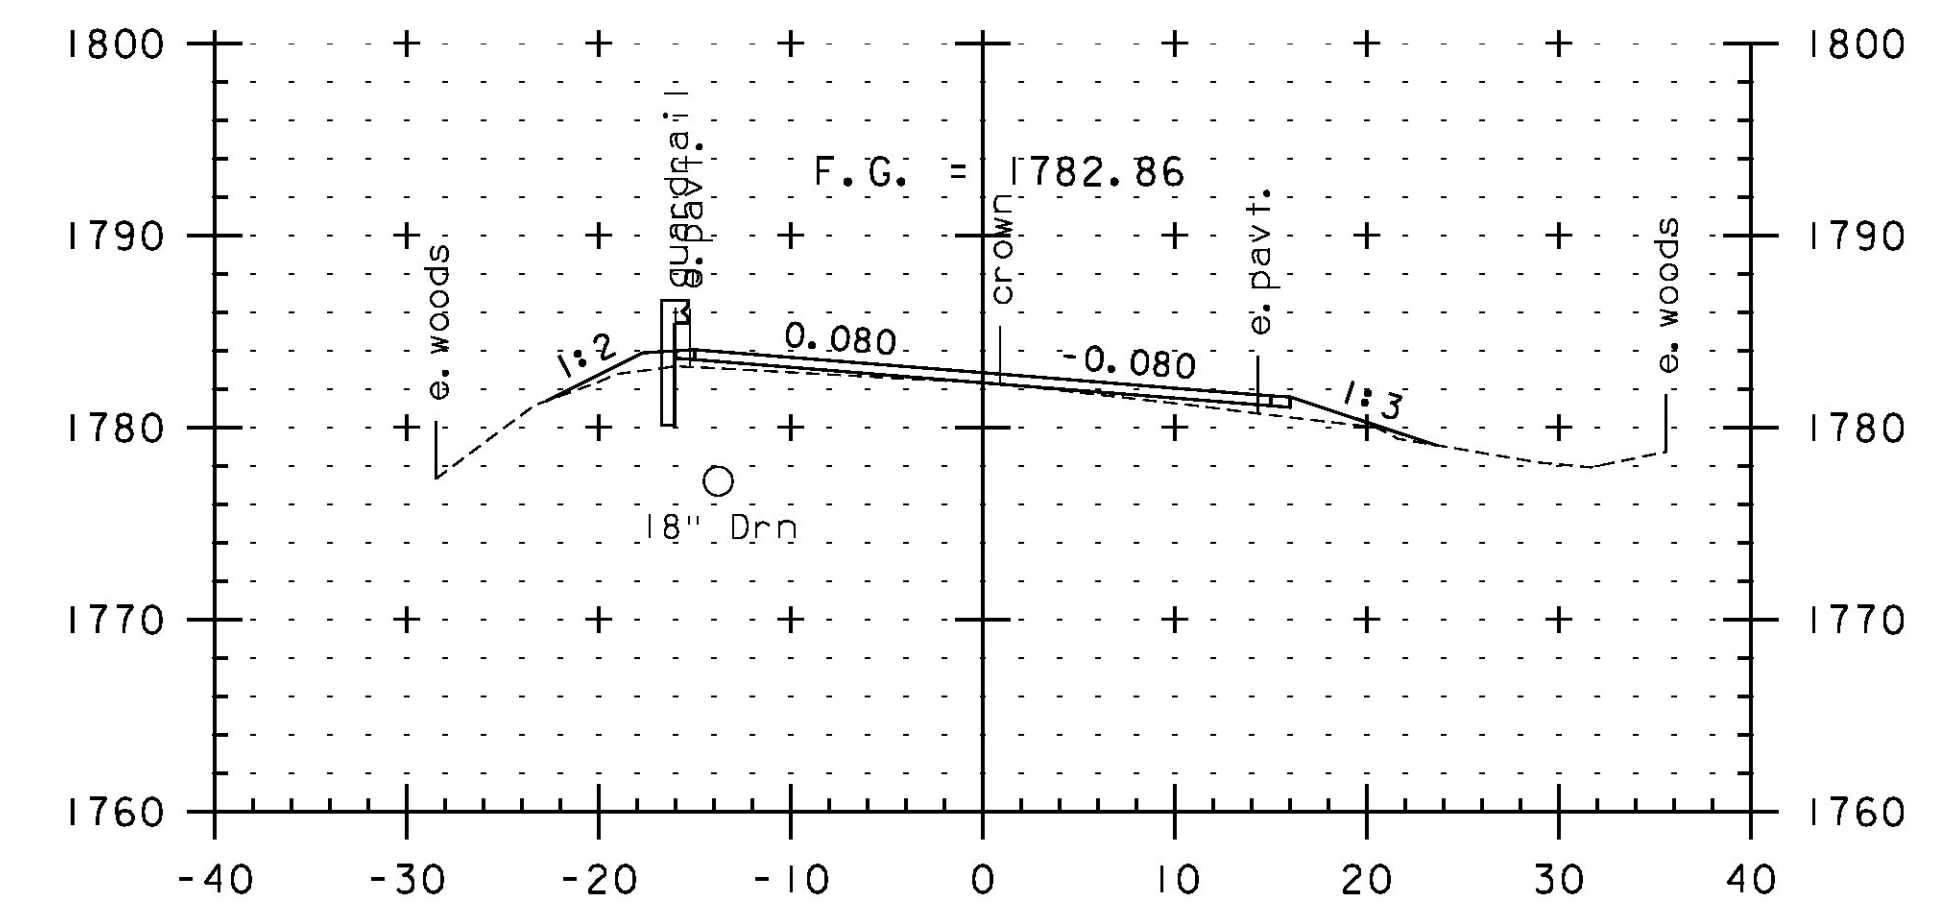

136+50

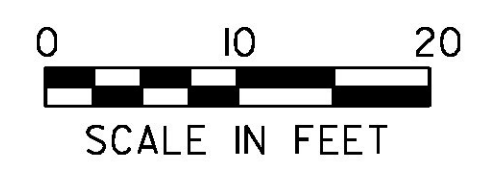

STA. 133+50 TO STA. 137+50

PROJECT NAME:	JAY-TROY	PLOT DATE:	5/16/2014
PROJECT NUMBER:	STP 2315(1)	DRAWN BY:	W. GORDON
FILE NAME:	z10b232xs.dgn	CHECKED BY:	P. SHEDD
PROJECT LEADER:	P. SHEDD	CROSS SECTION SHEET	24
DESIGNED BY:	N. LEMAY	SHEET	160 OF 244