




139+00

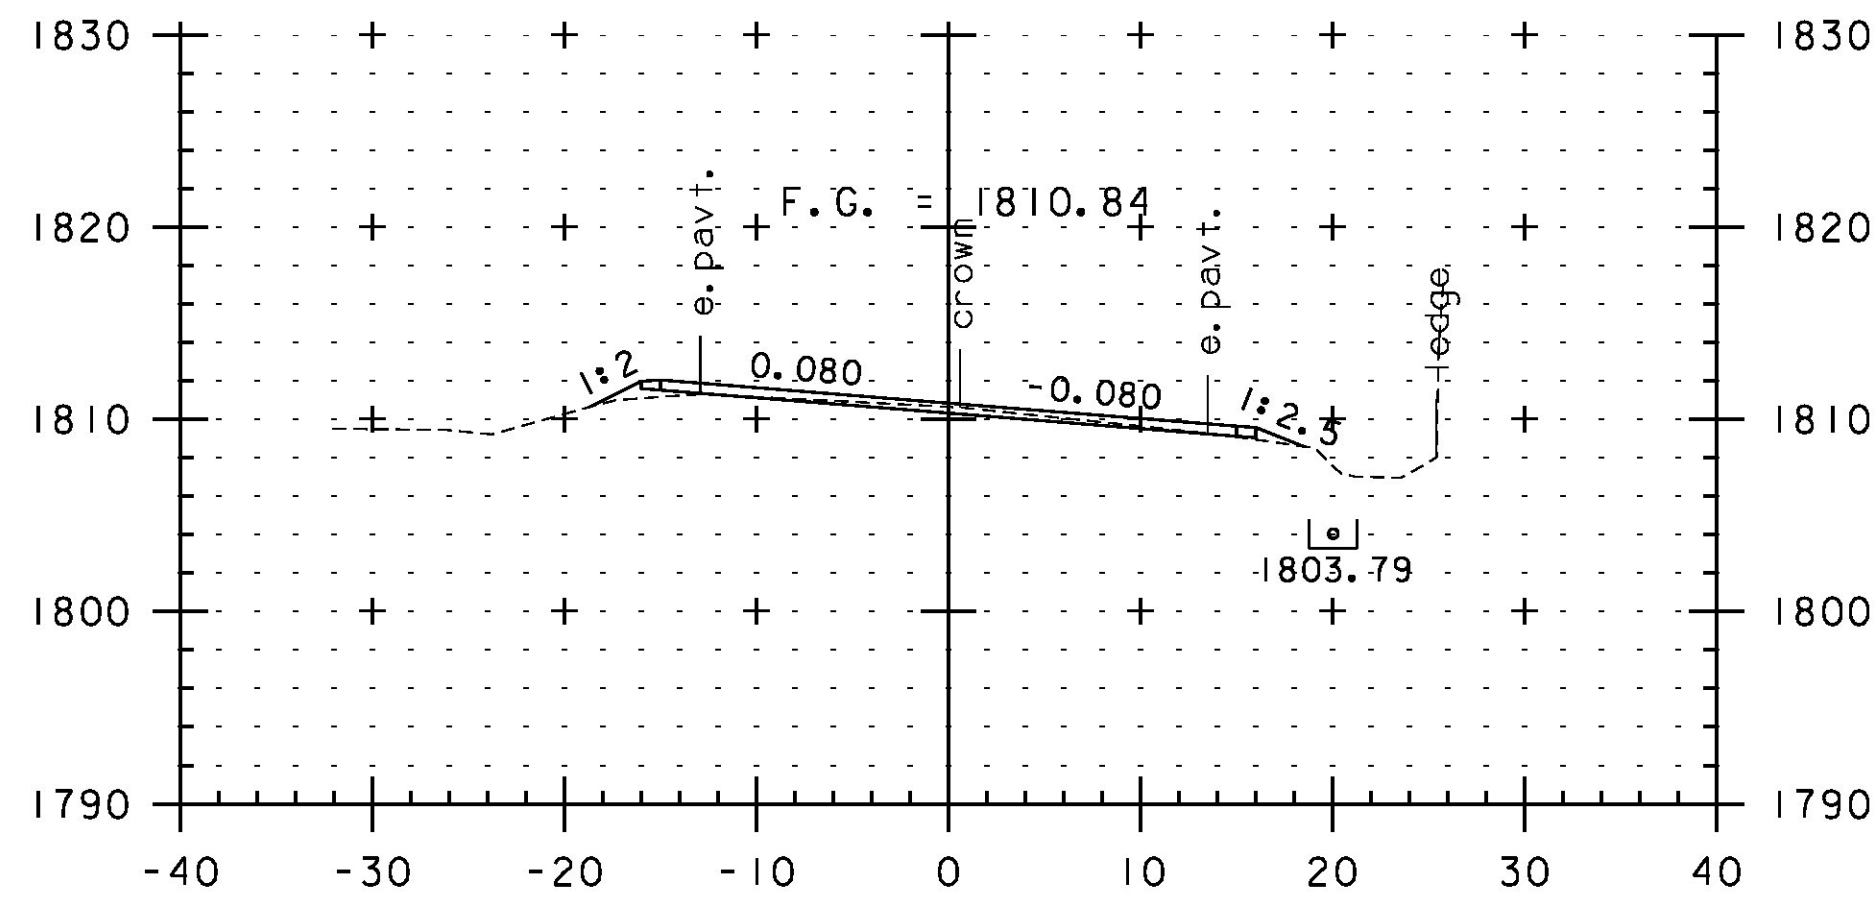


140+50

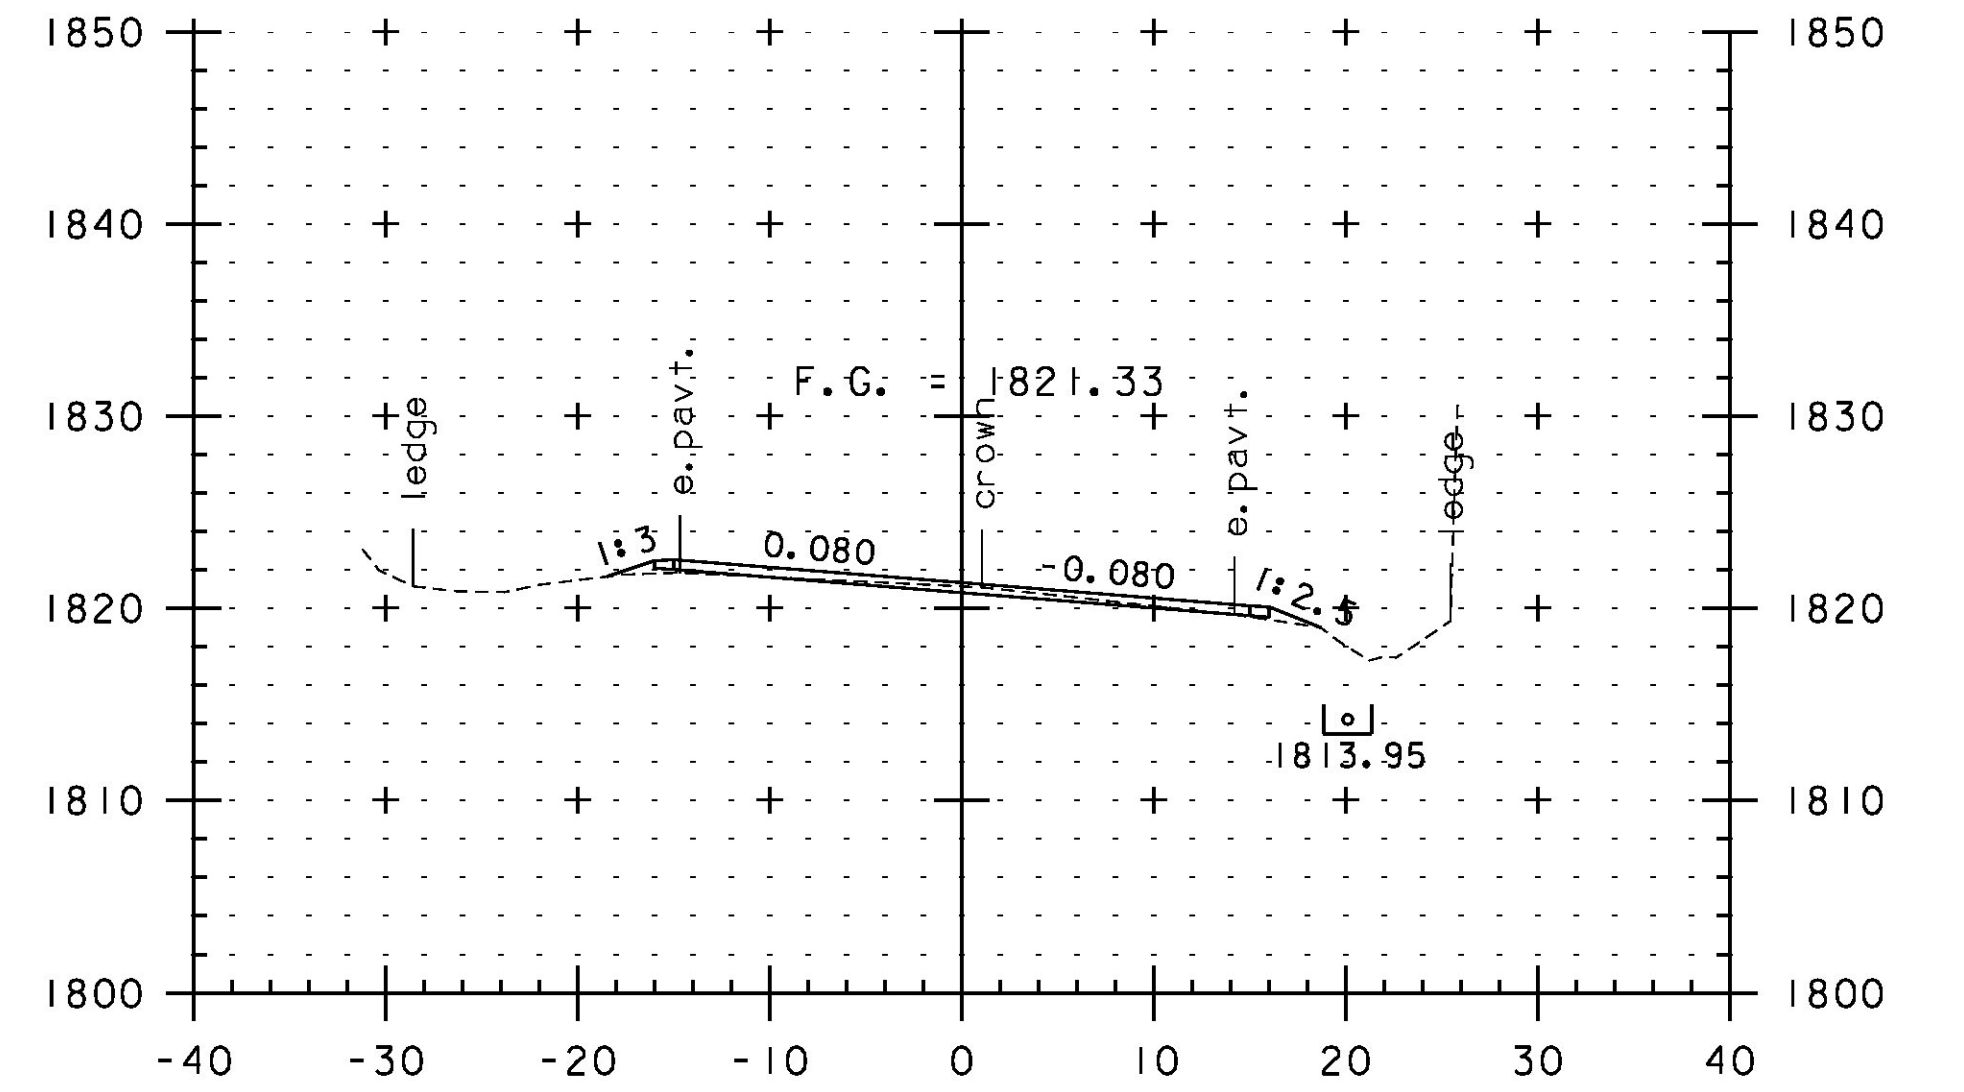


142+00

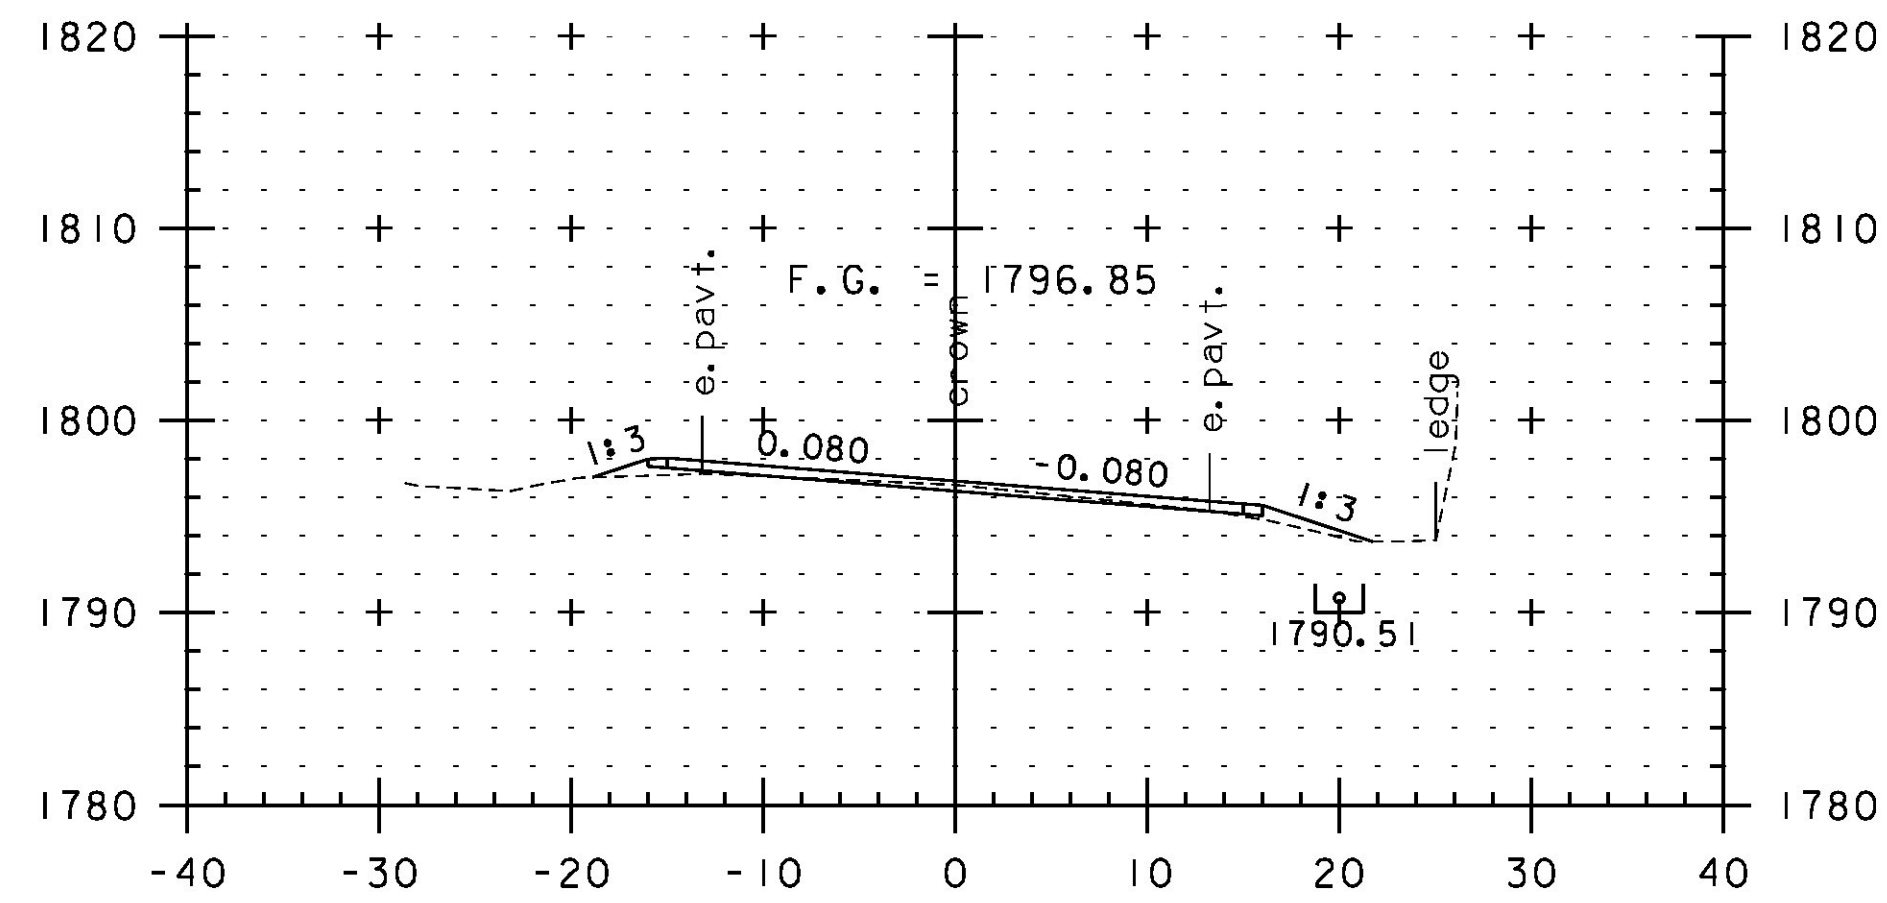


138+50

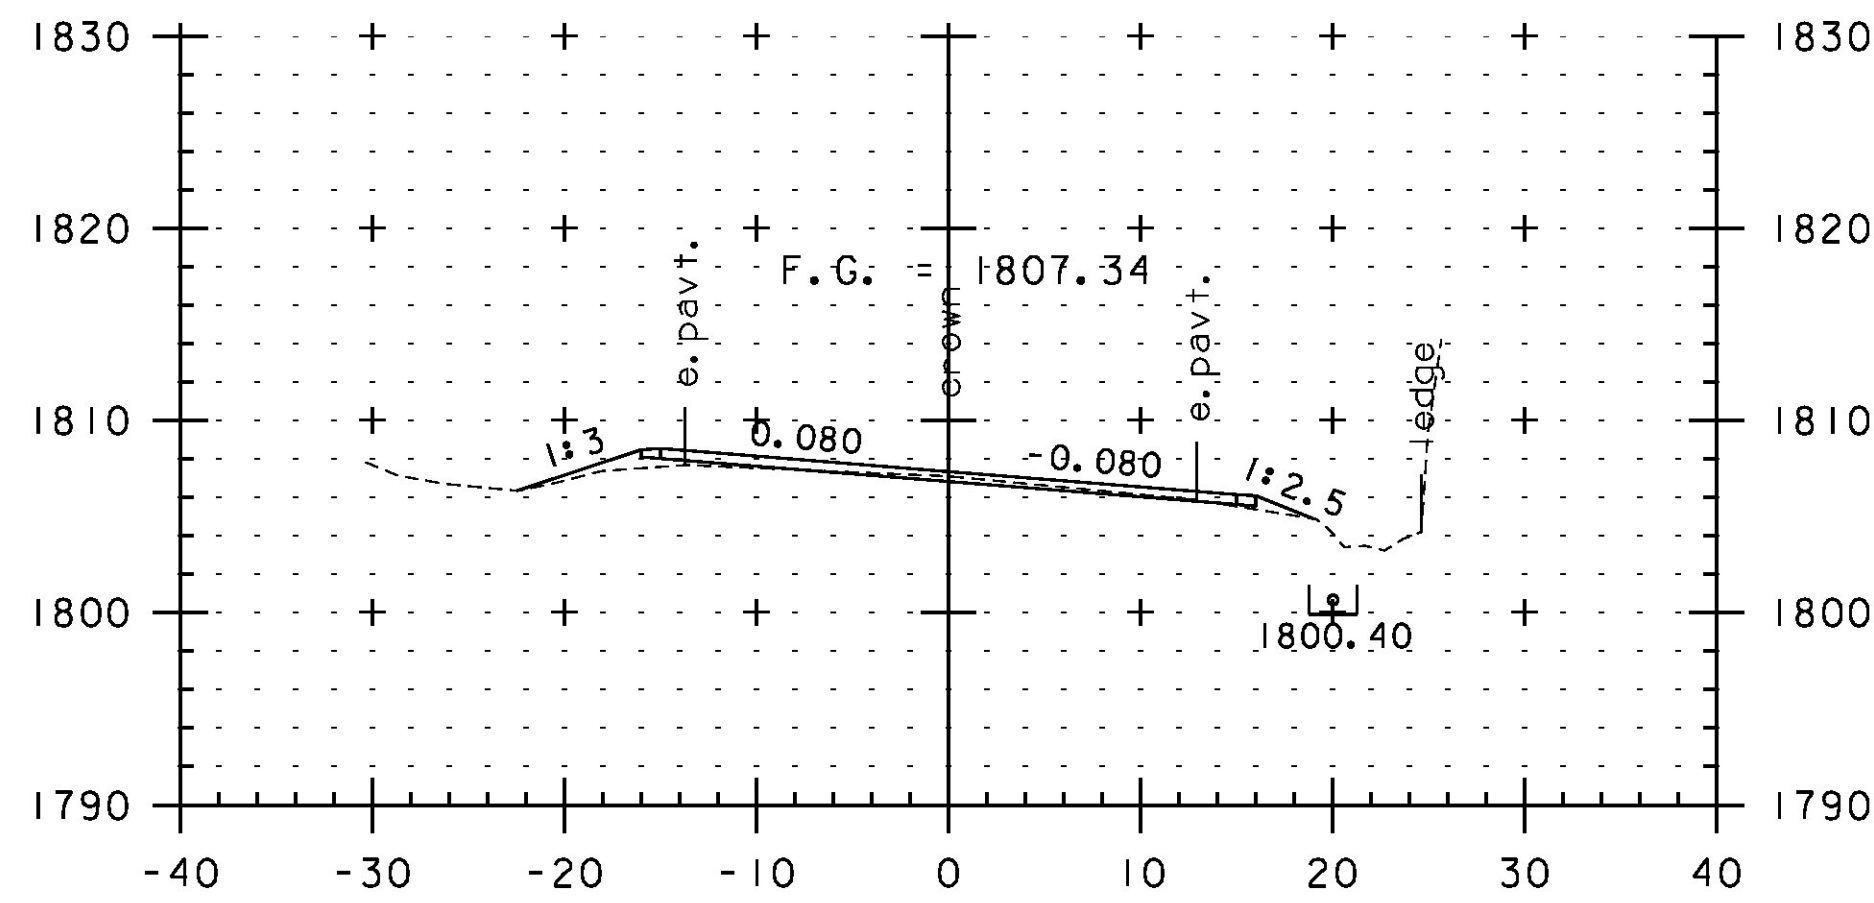


140+00

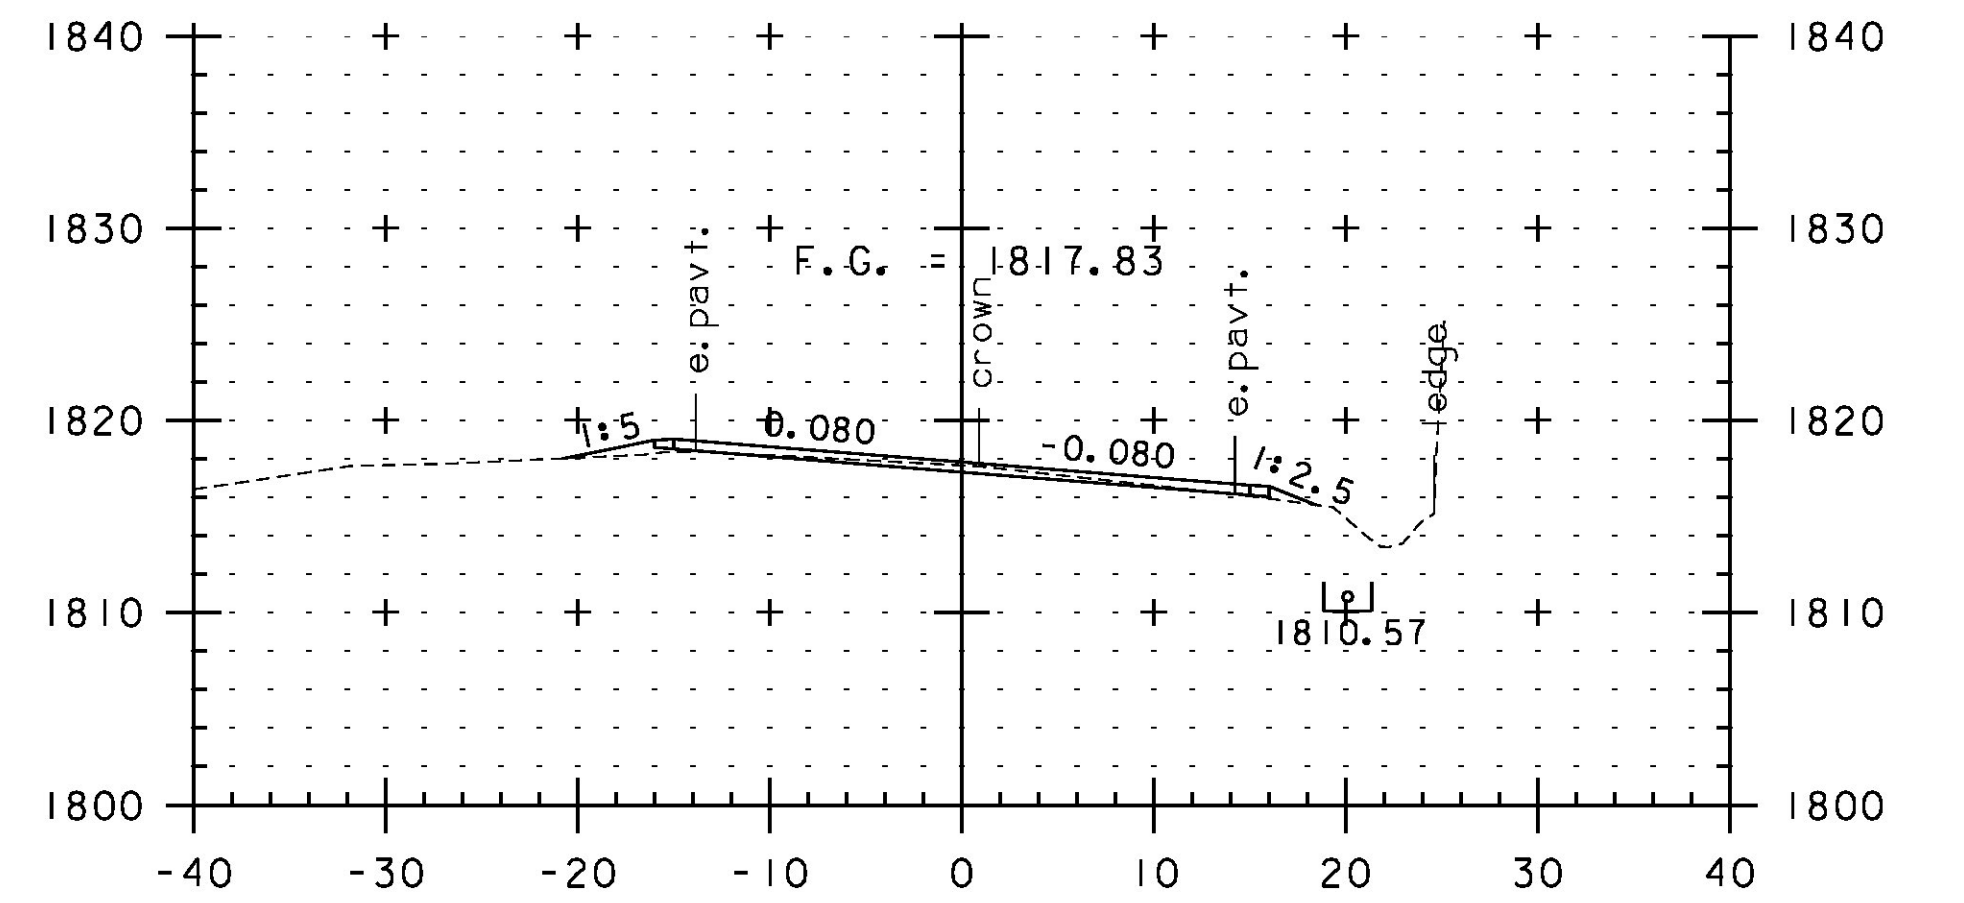


141+50

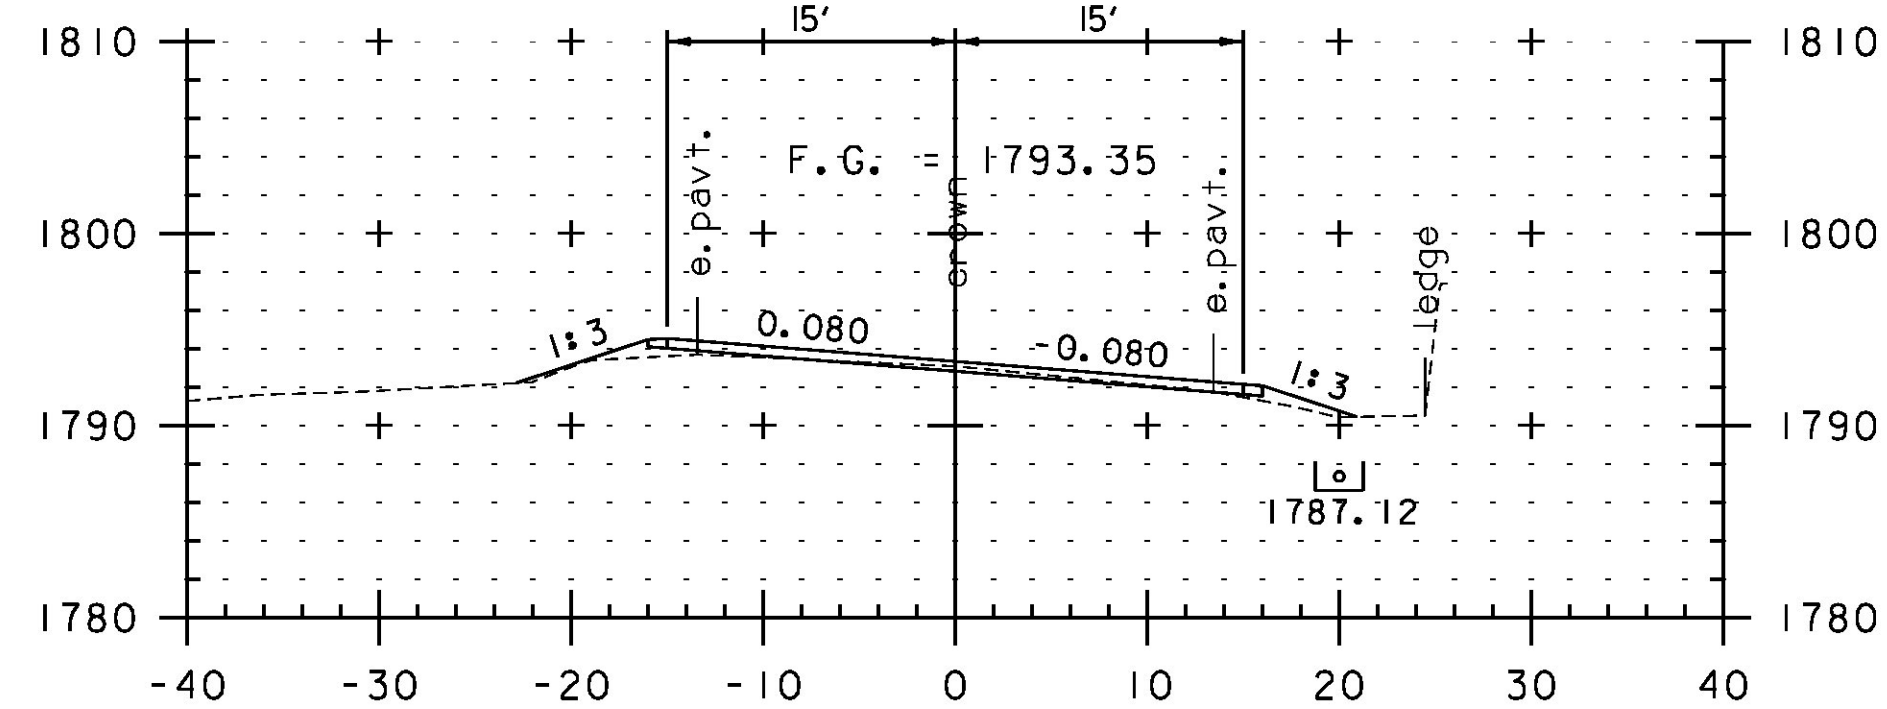

138+00

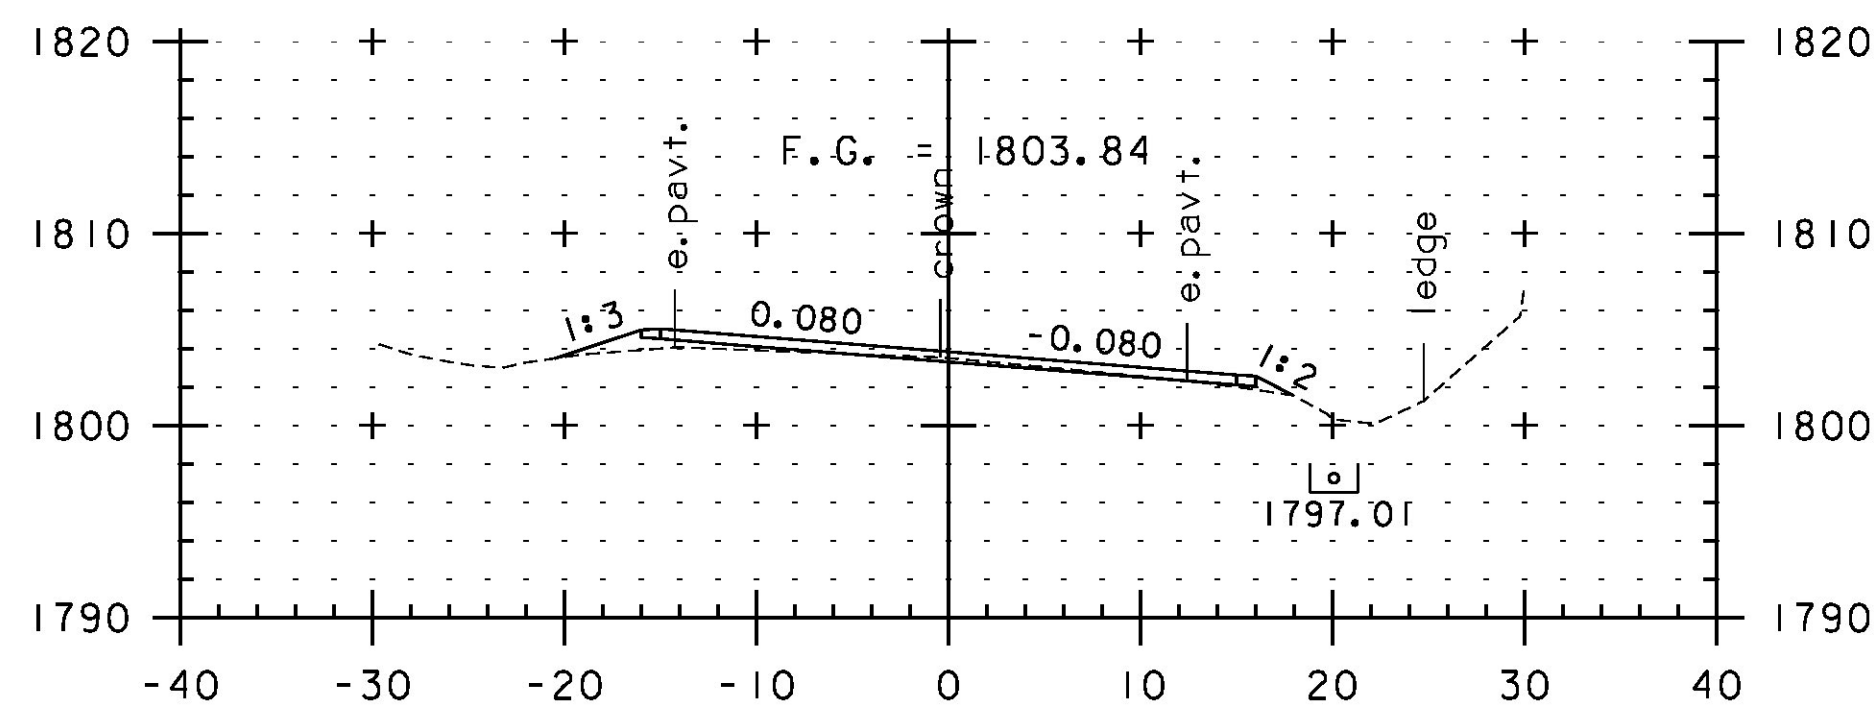

139+50

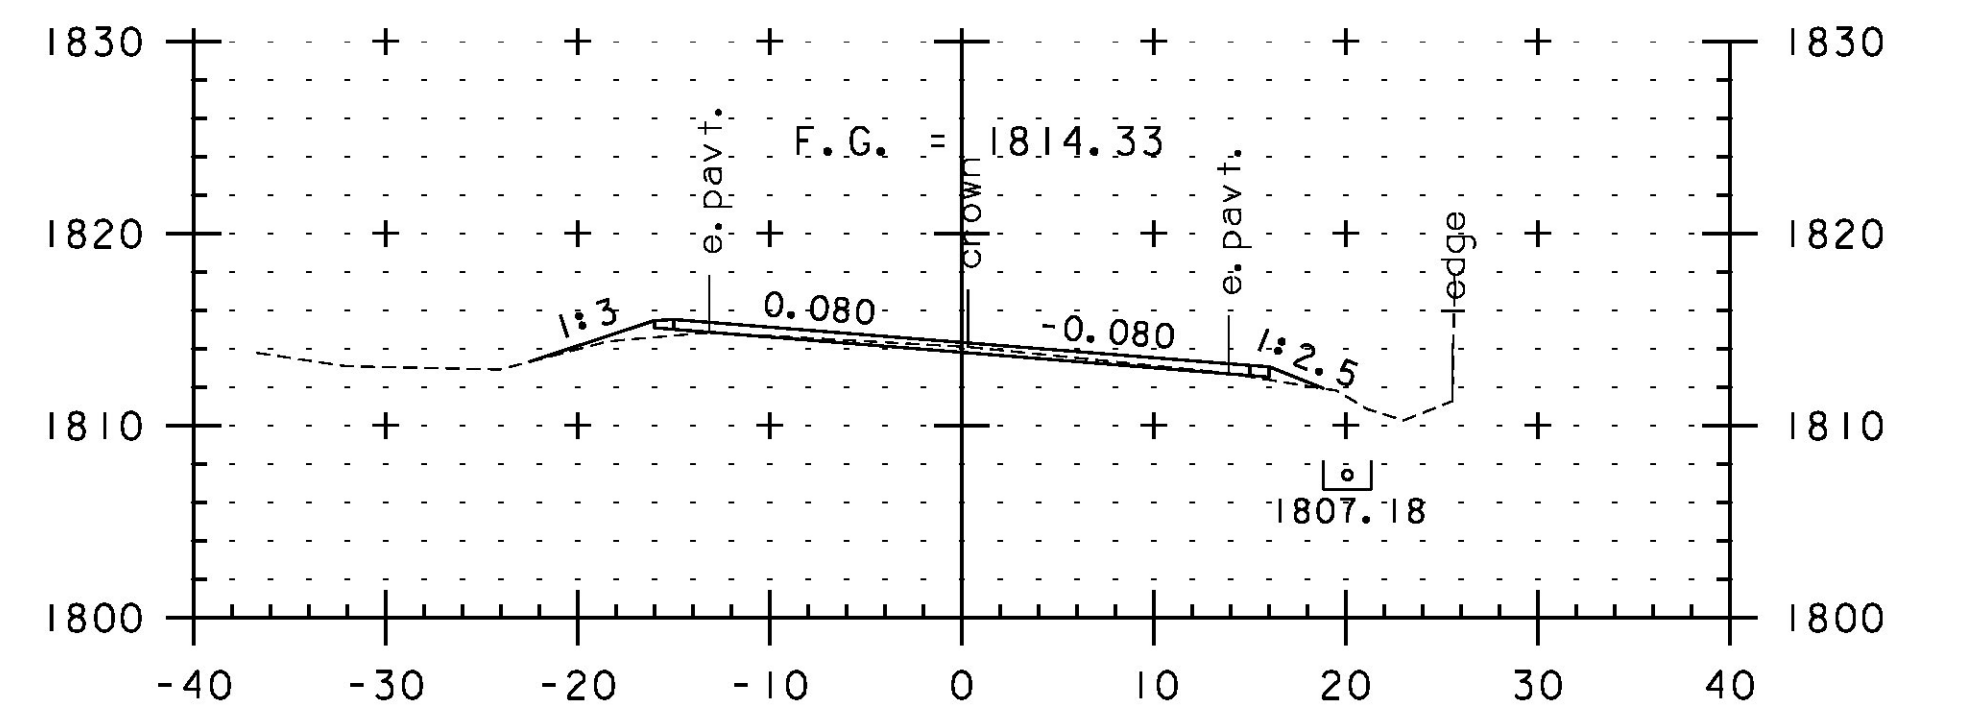

141+00



SCALE IN FEET

STA. 138+00 TO STA. 142+00

PROJECT NAME:	JAY-TROY	PLOT DATE:	5/16/2014
PROJECT NUMBER:	STP 2315(I)	DRAWN BY:	W. GORDON
FILE NAME:	z10b232xs.dgn	DESIGNED BY:	N. LEMAY
PROJECT LEADER:	P. SHEDD	CHECKED BY:	P. SHEDD
CROSS SECTION SHEET 25		SHEET	161 OF 244