




143+00

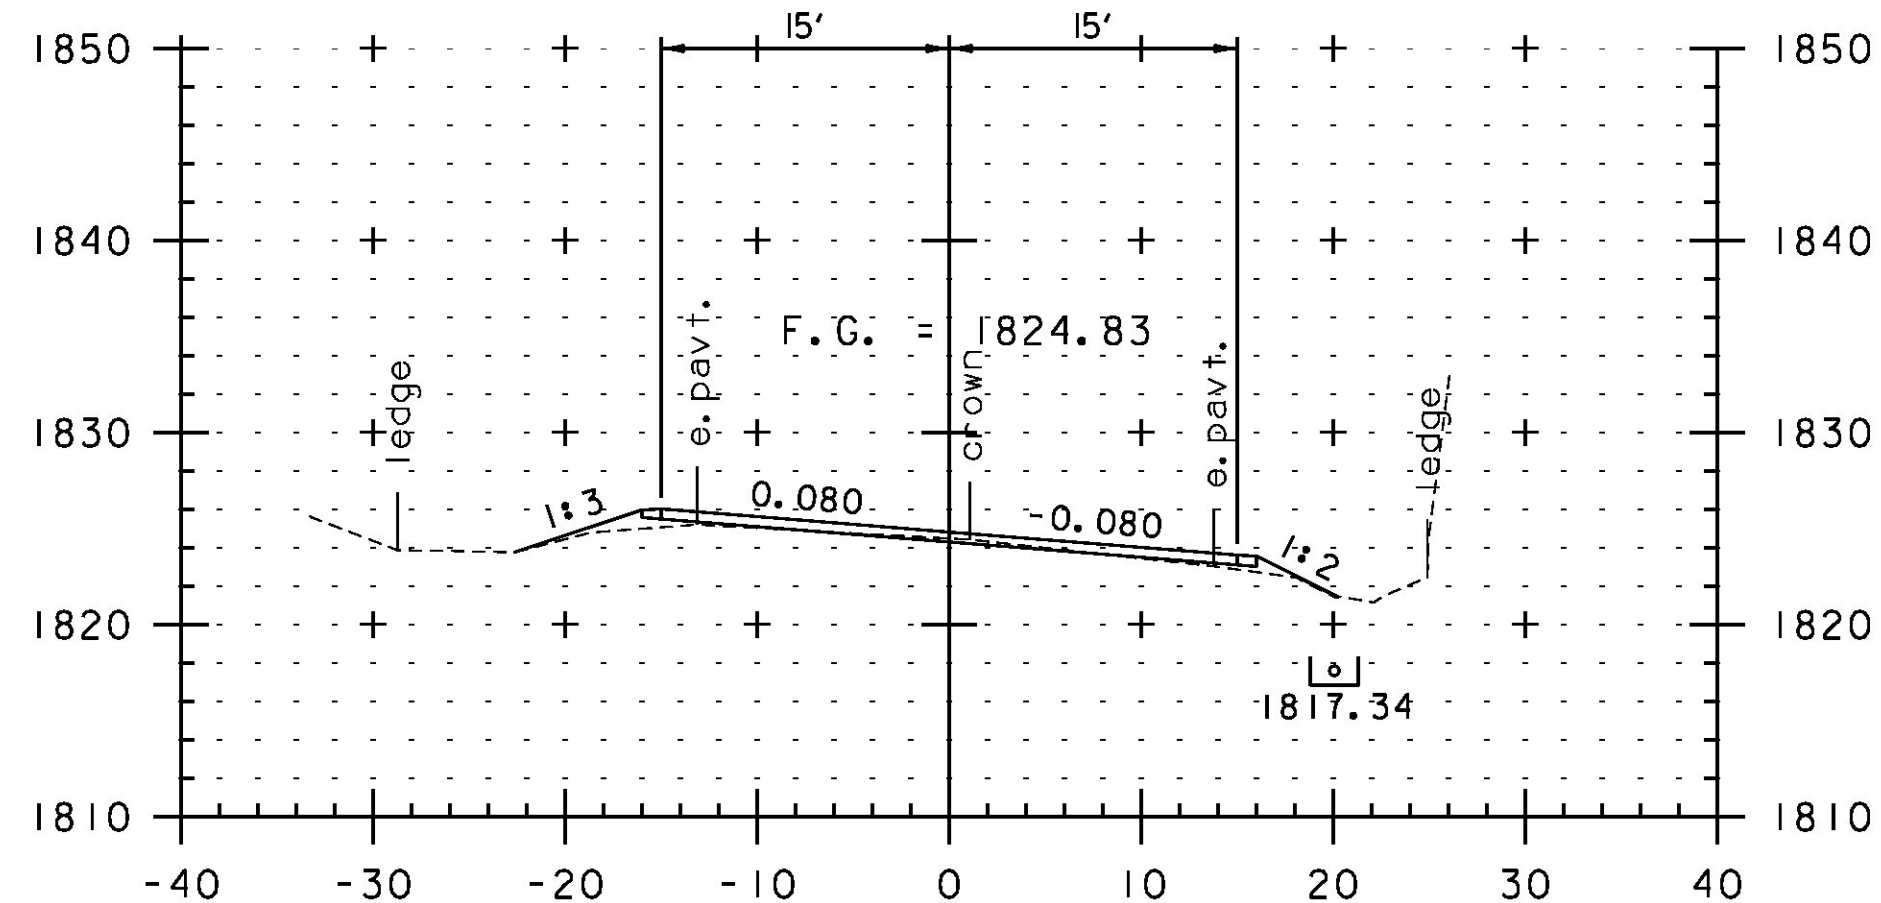


142+50

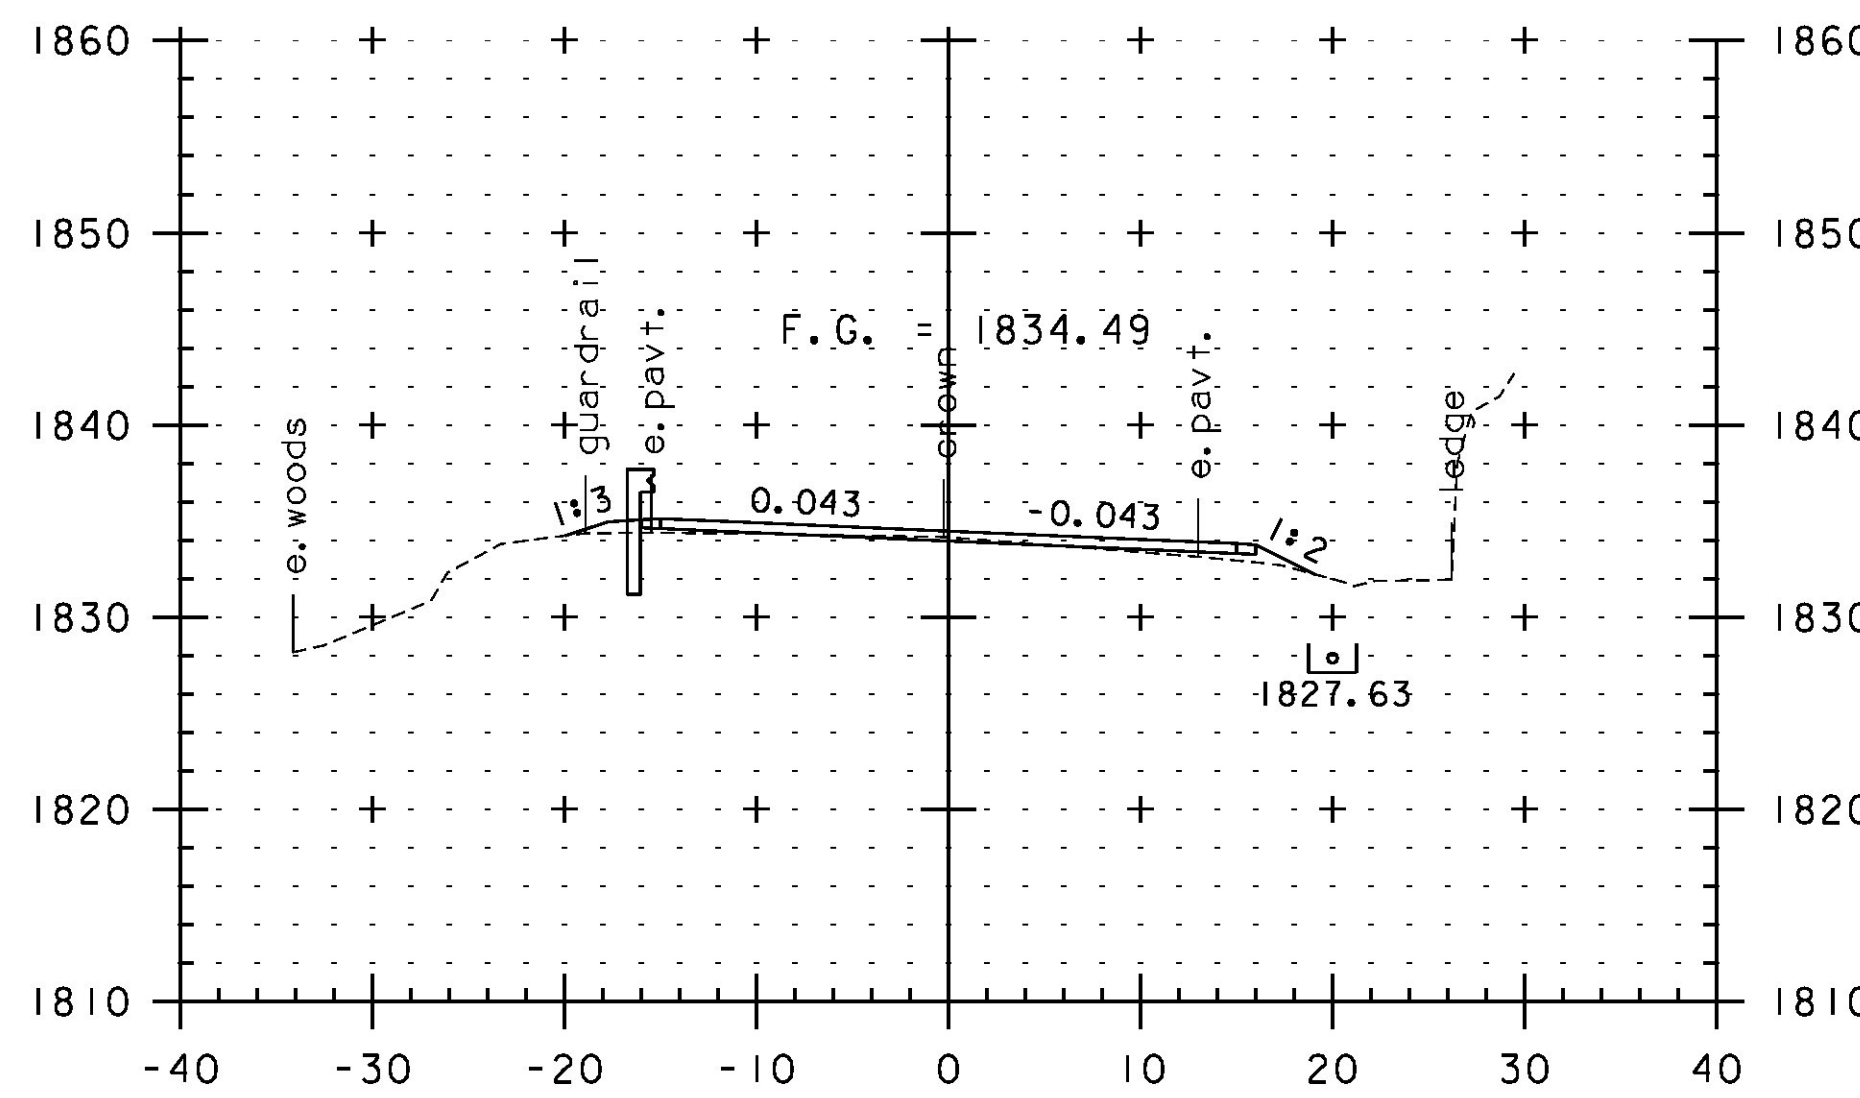


144+00

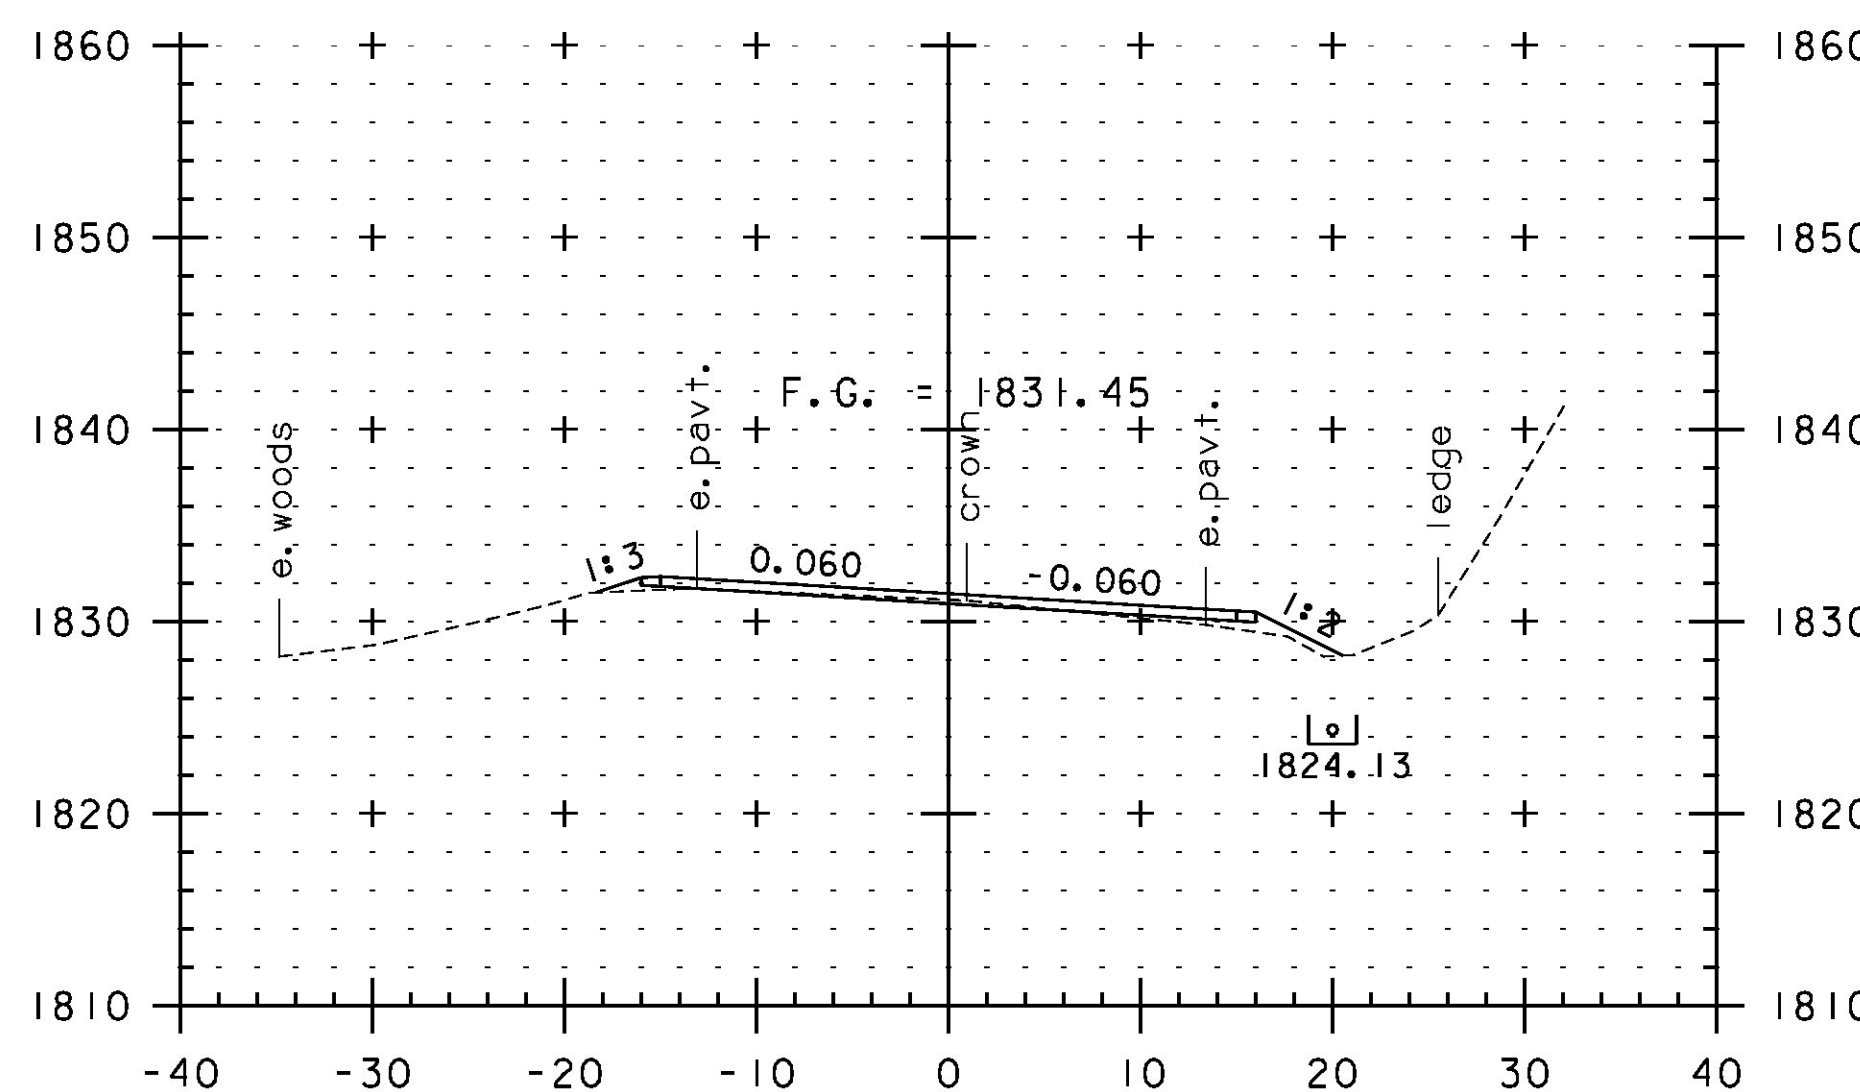


143+50

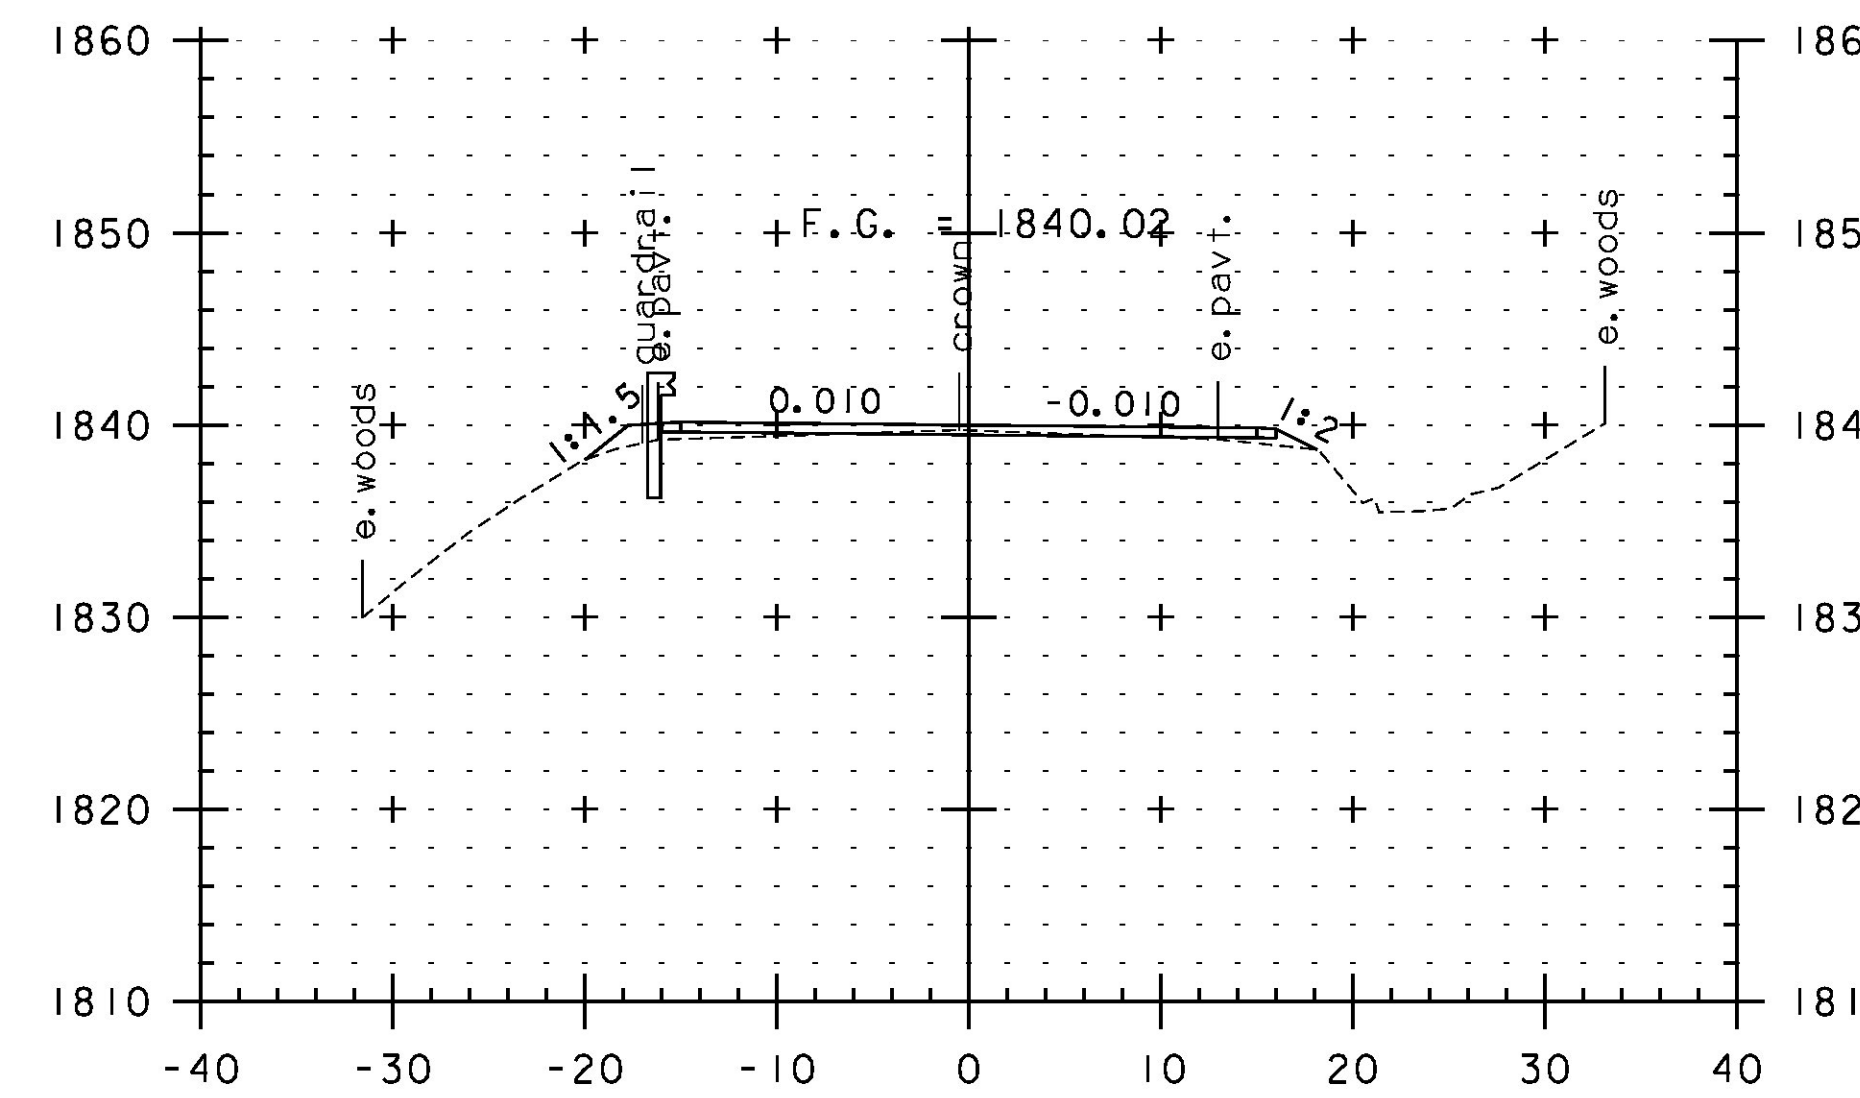

145+00

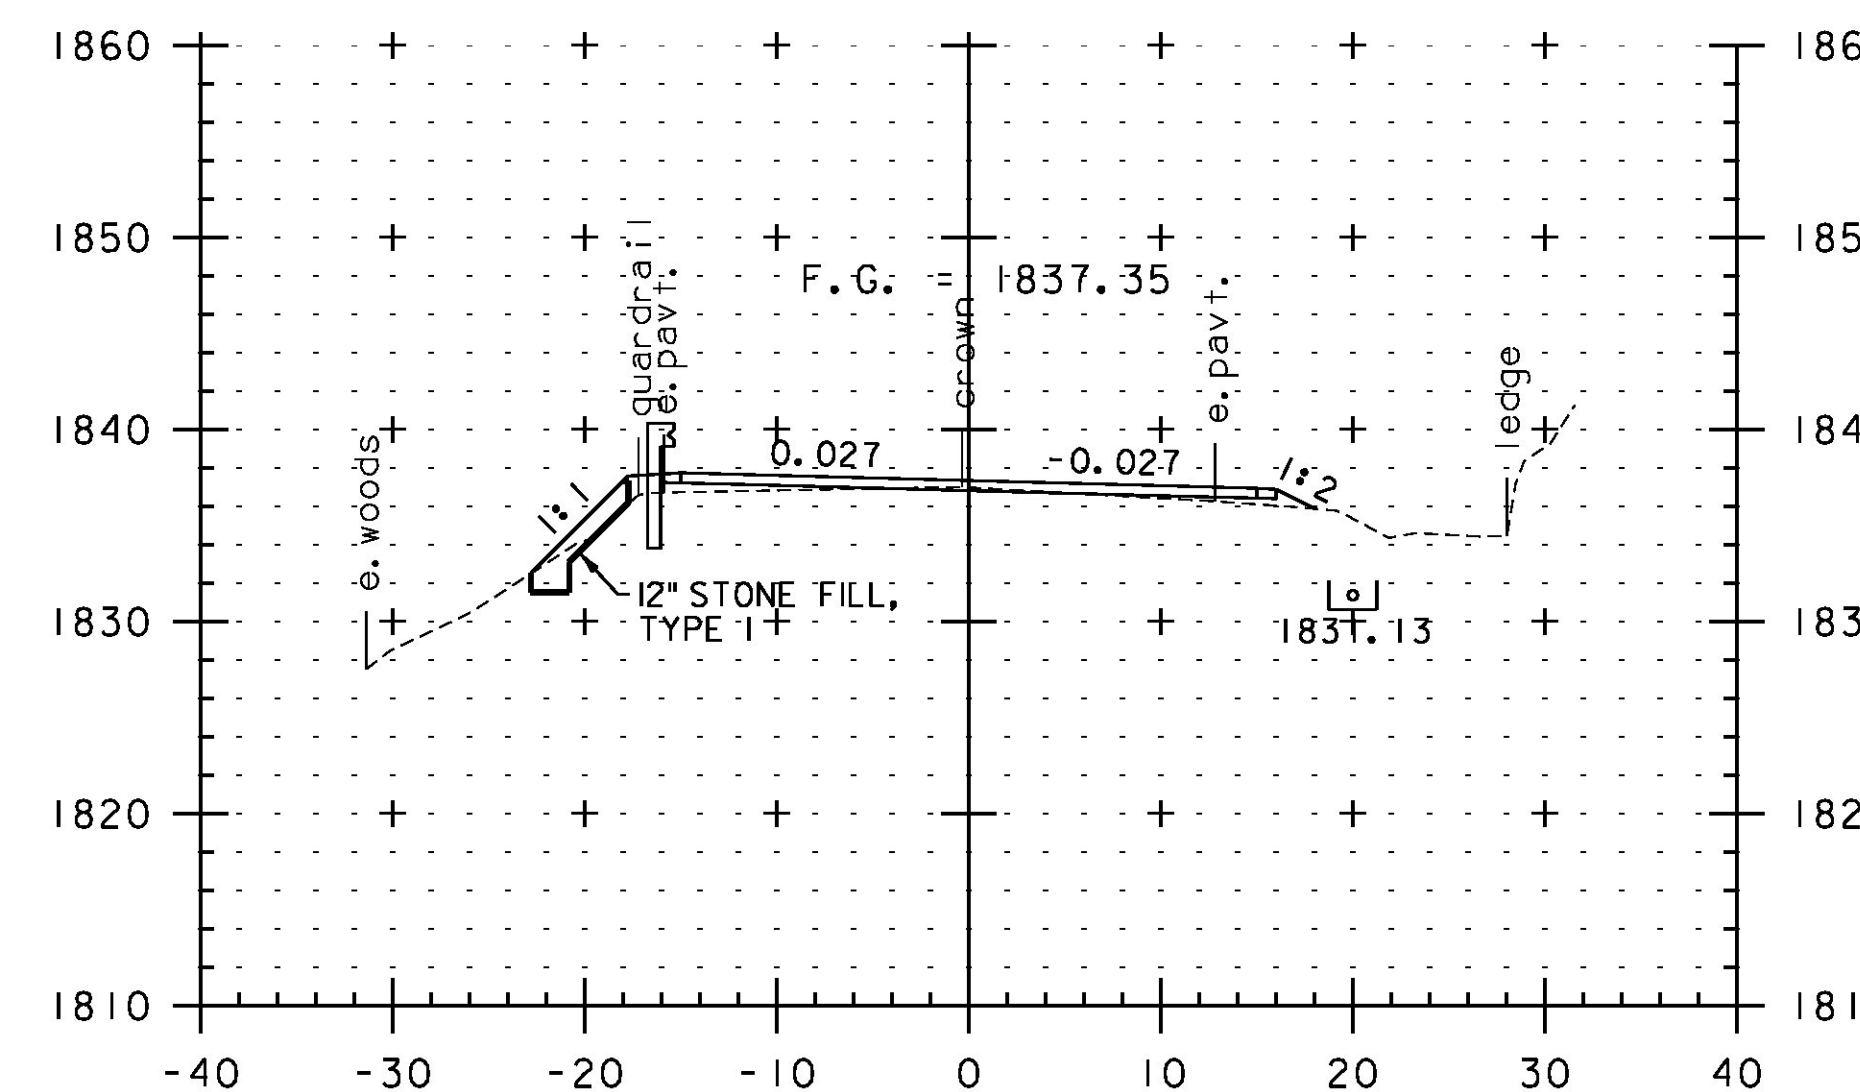

144+50

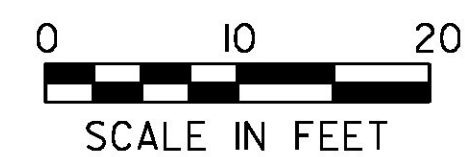

SCALE IN FEET

STA. 142+50 TO STA. 145+00

PROJECT NAME:	JAY-TROY	PLOT DATE:	5/16/2014
PROJECT NUMBER:	STP 2315(I)	DRAWN BY:	W. GORDON
FILE NAME:	z10b232xs.dgn	DESIGNED BY:	N. LEMAY
PROJECT LEADER:	P. SHEDD	CHECKED BY:	P. SHEDD
CROSS SECTION SHEET 26			SHEET 162 OF 244