




149+51  
BRIDGE 48

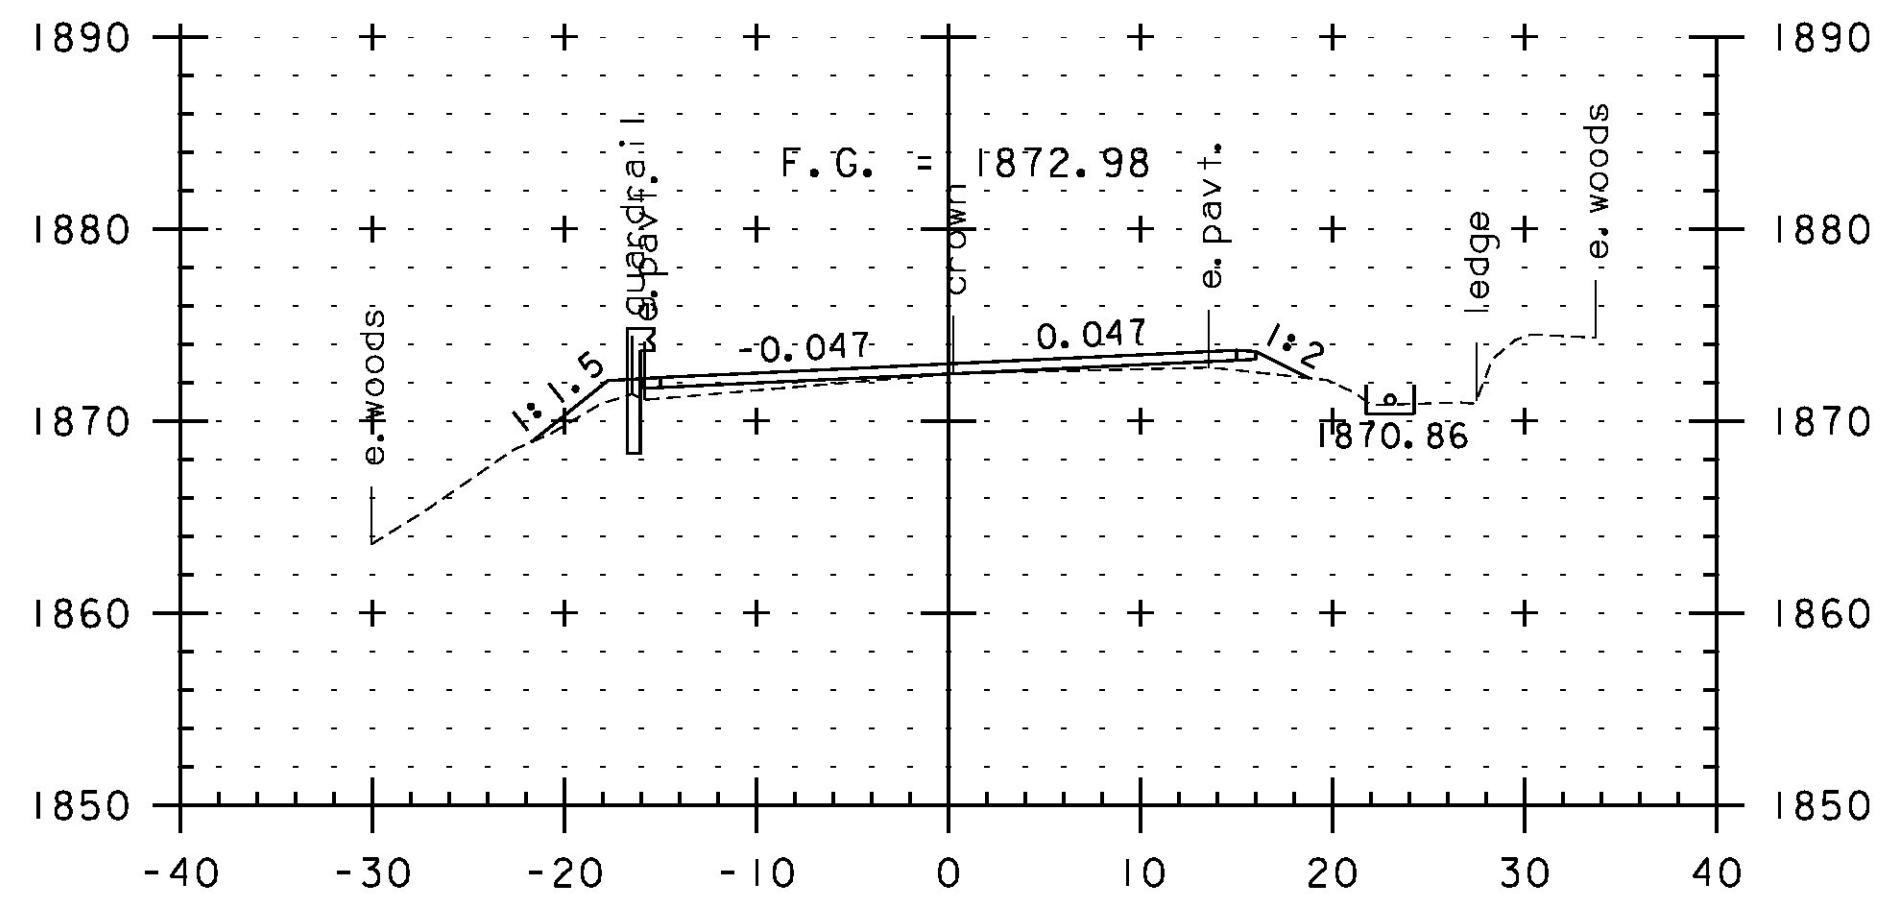


151+00

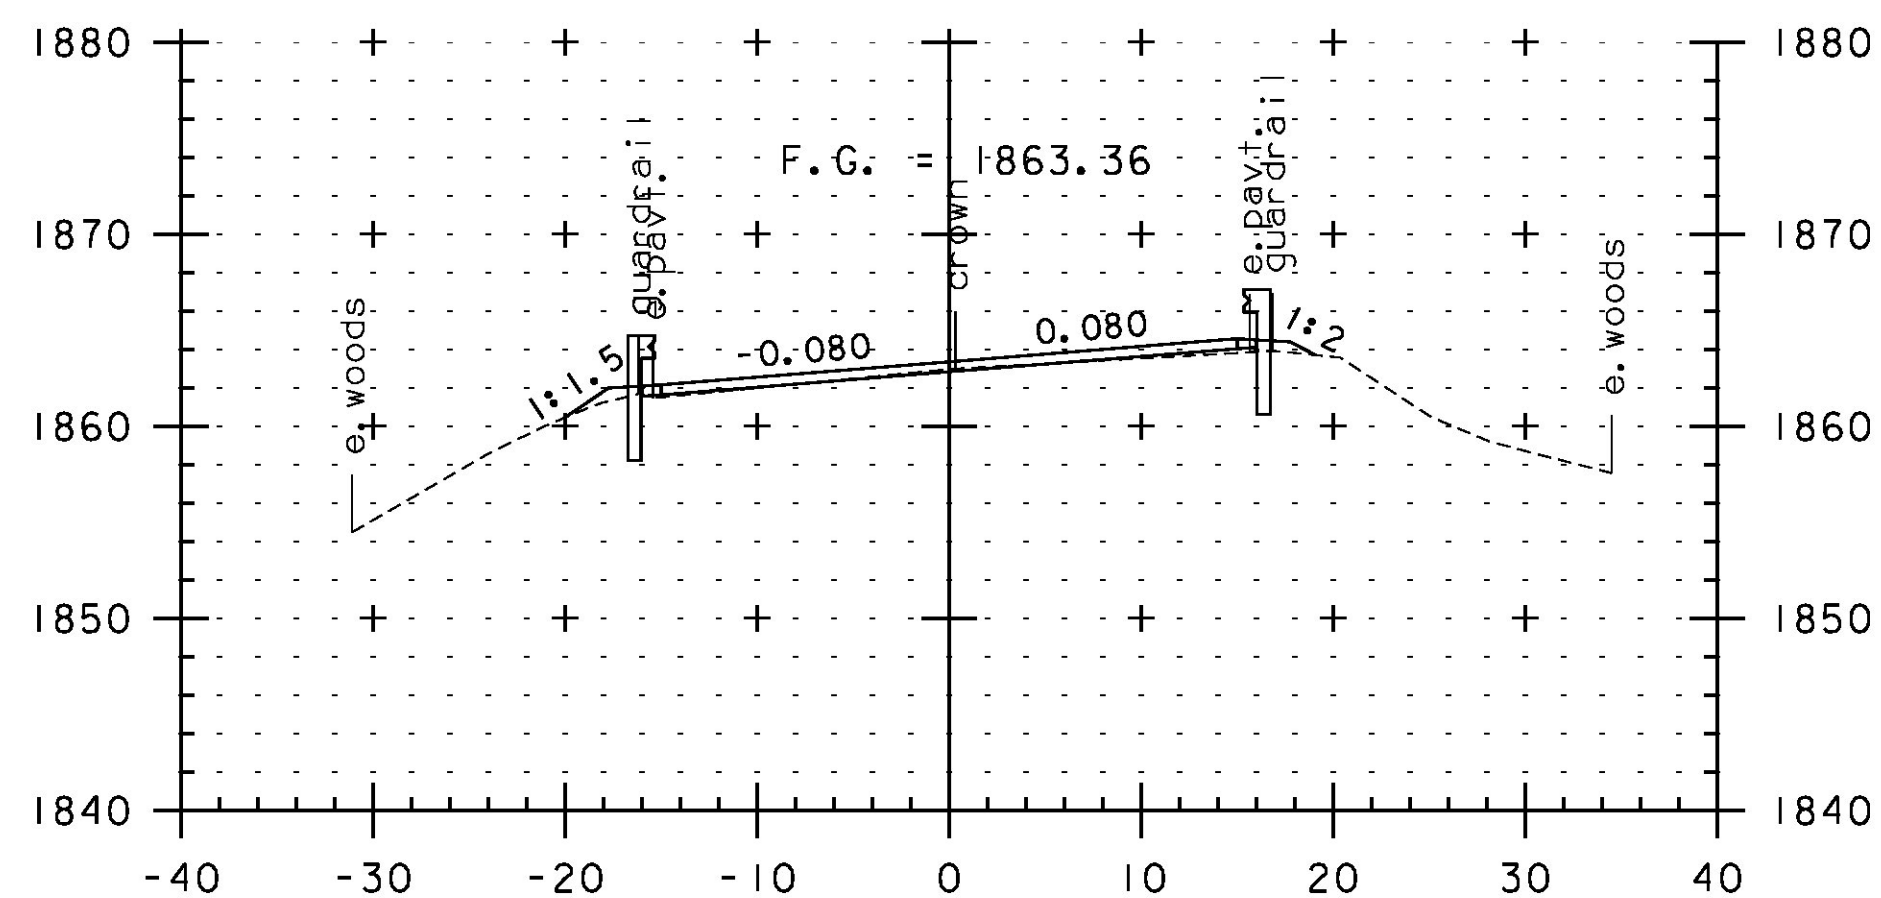


149+50

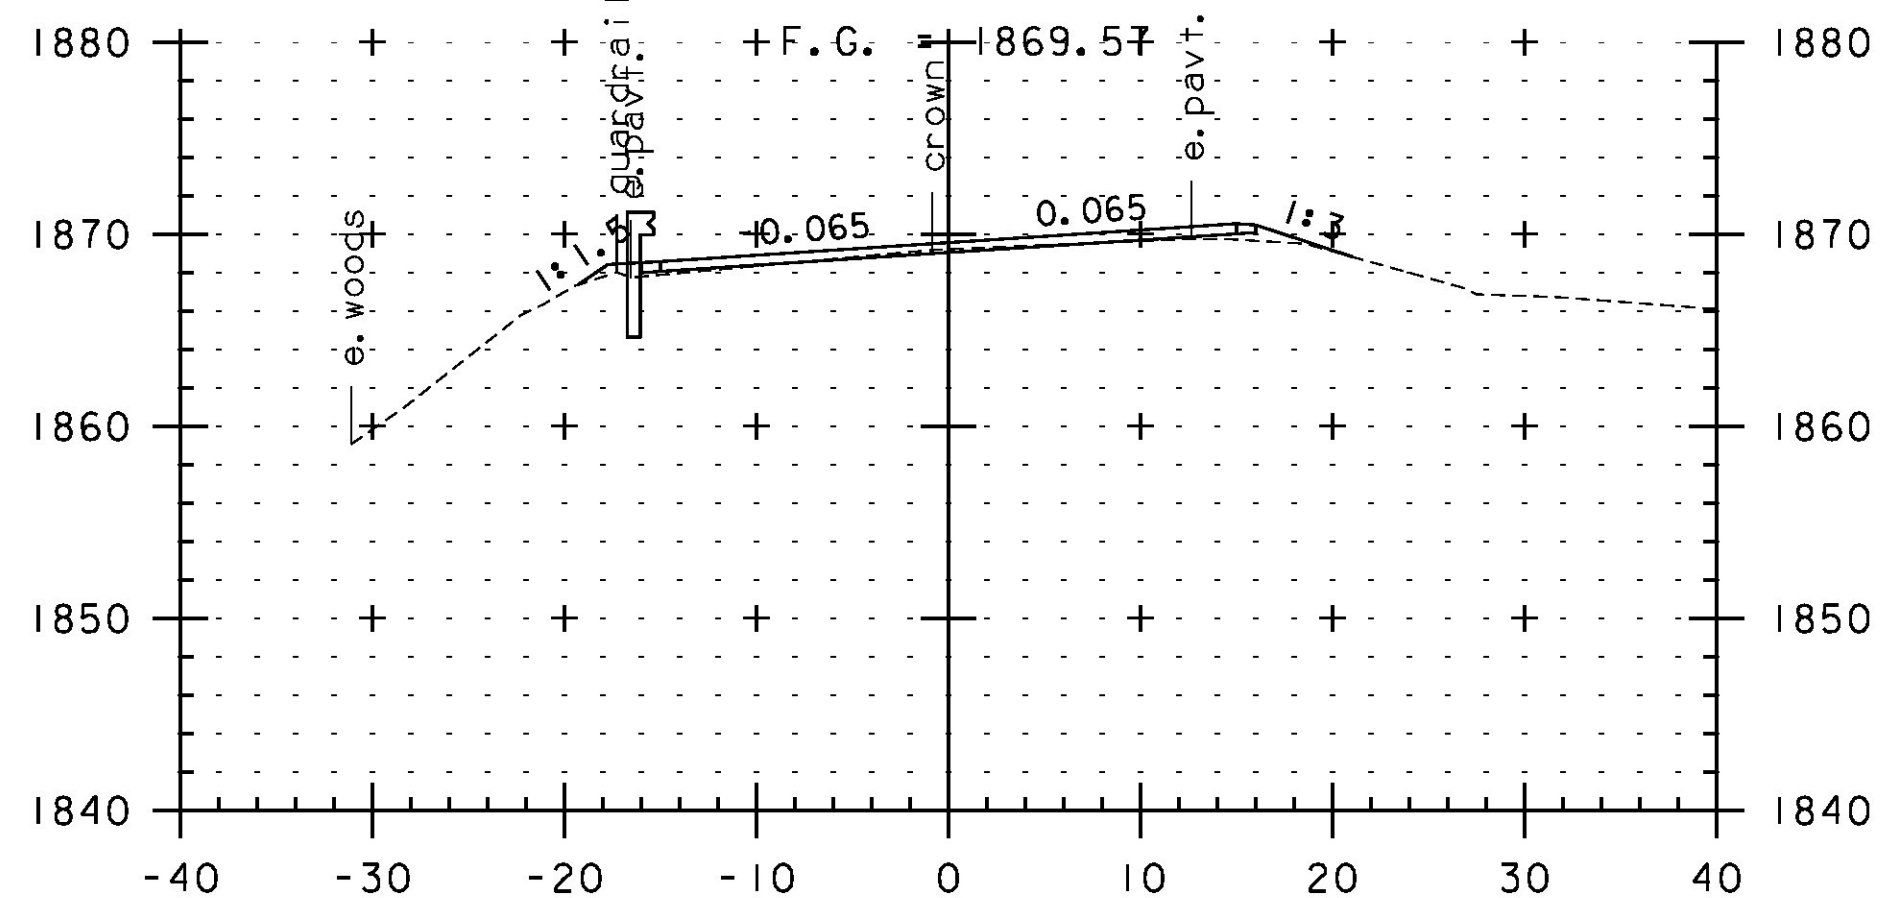


150+50

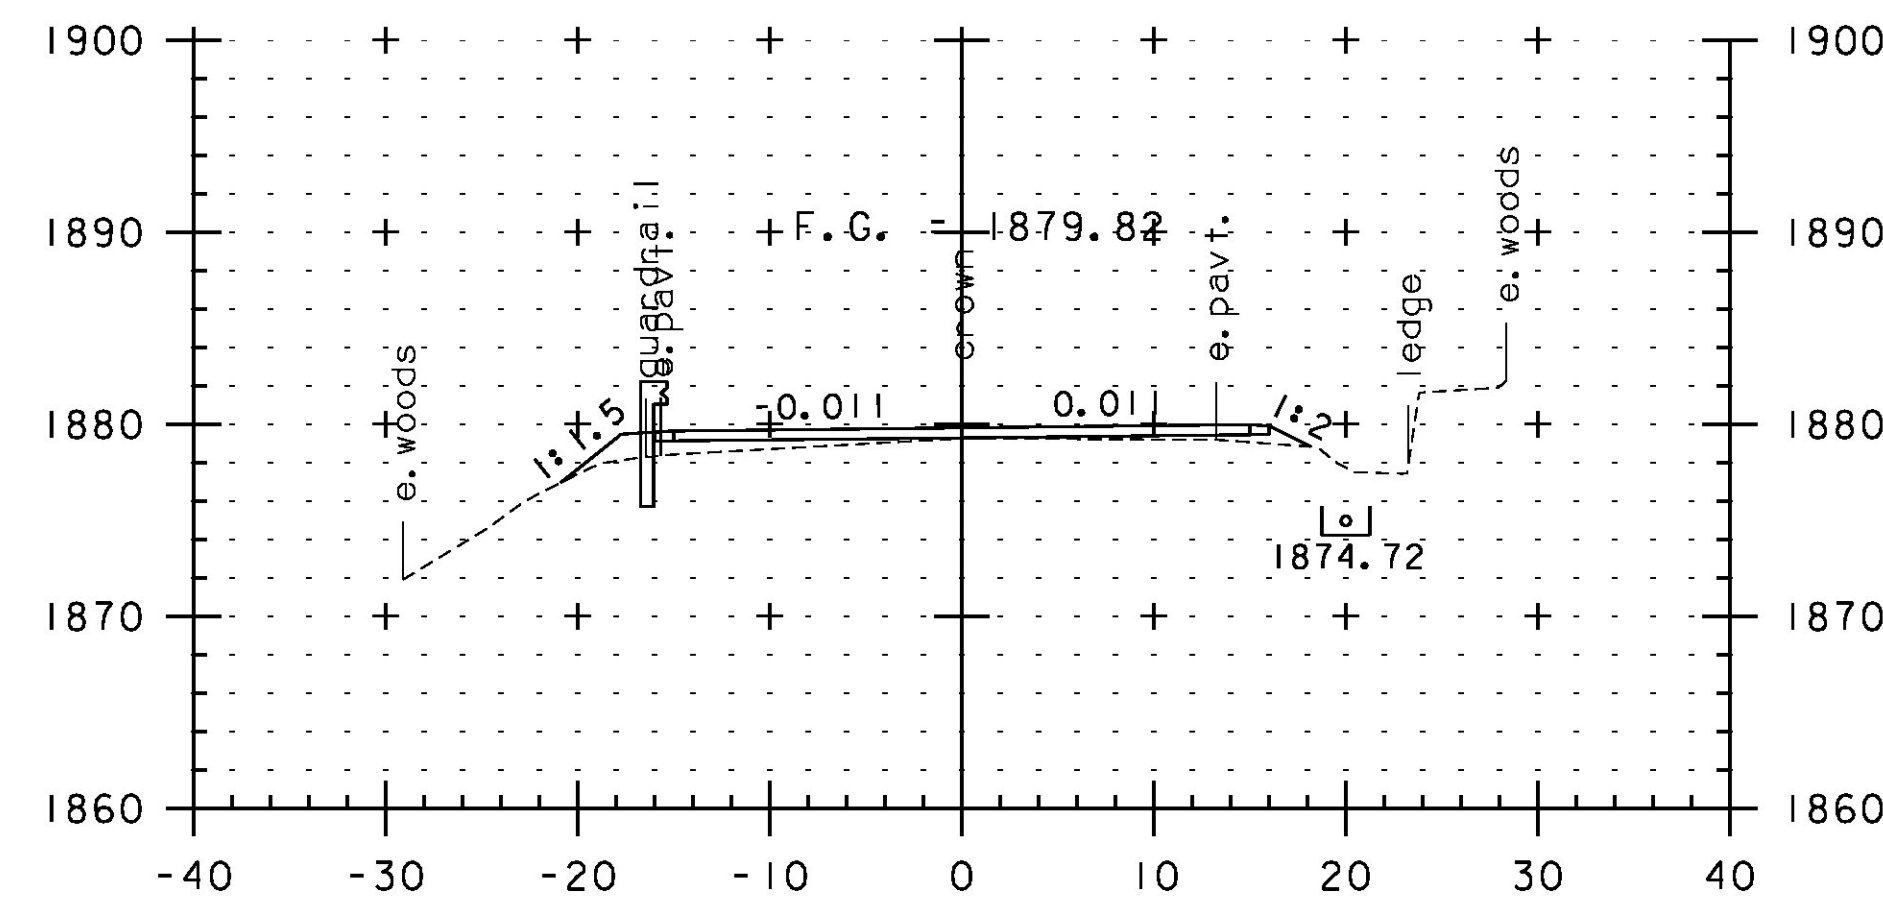


152+00

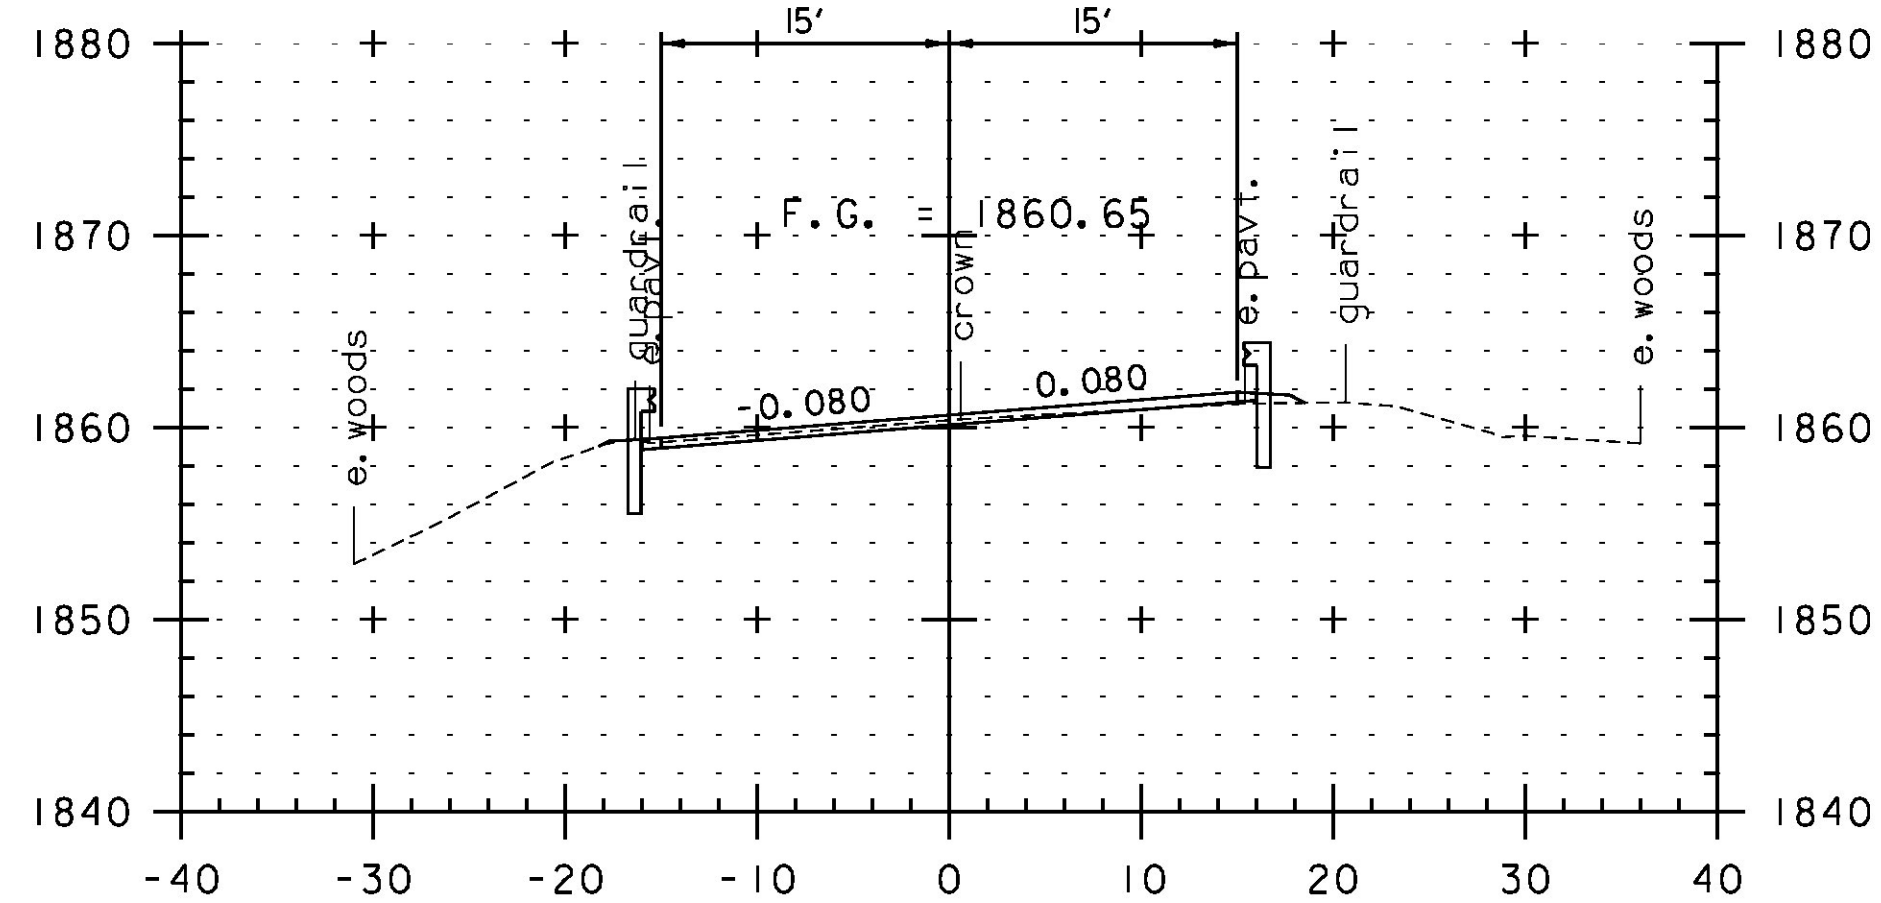


149+00

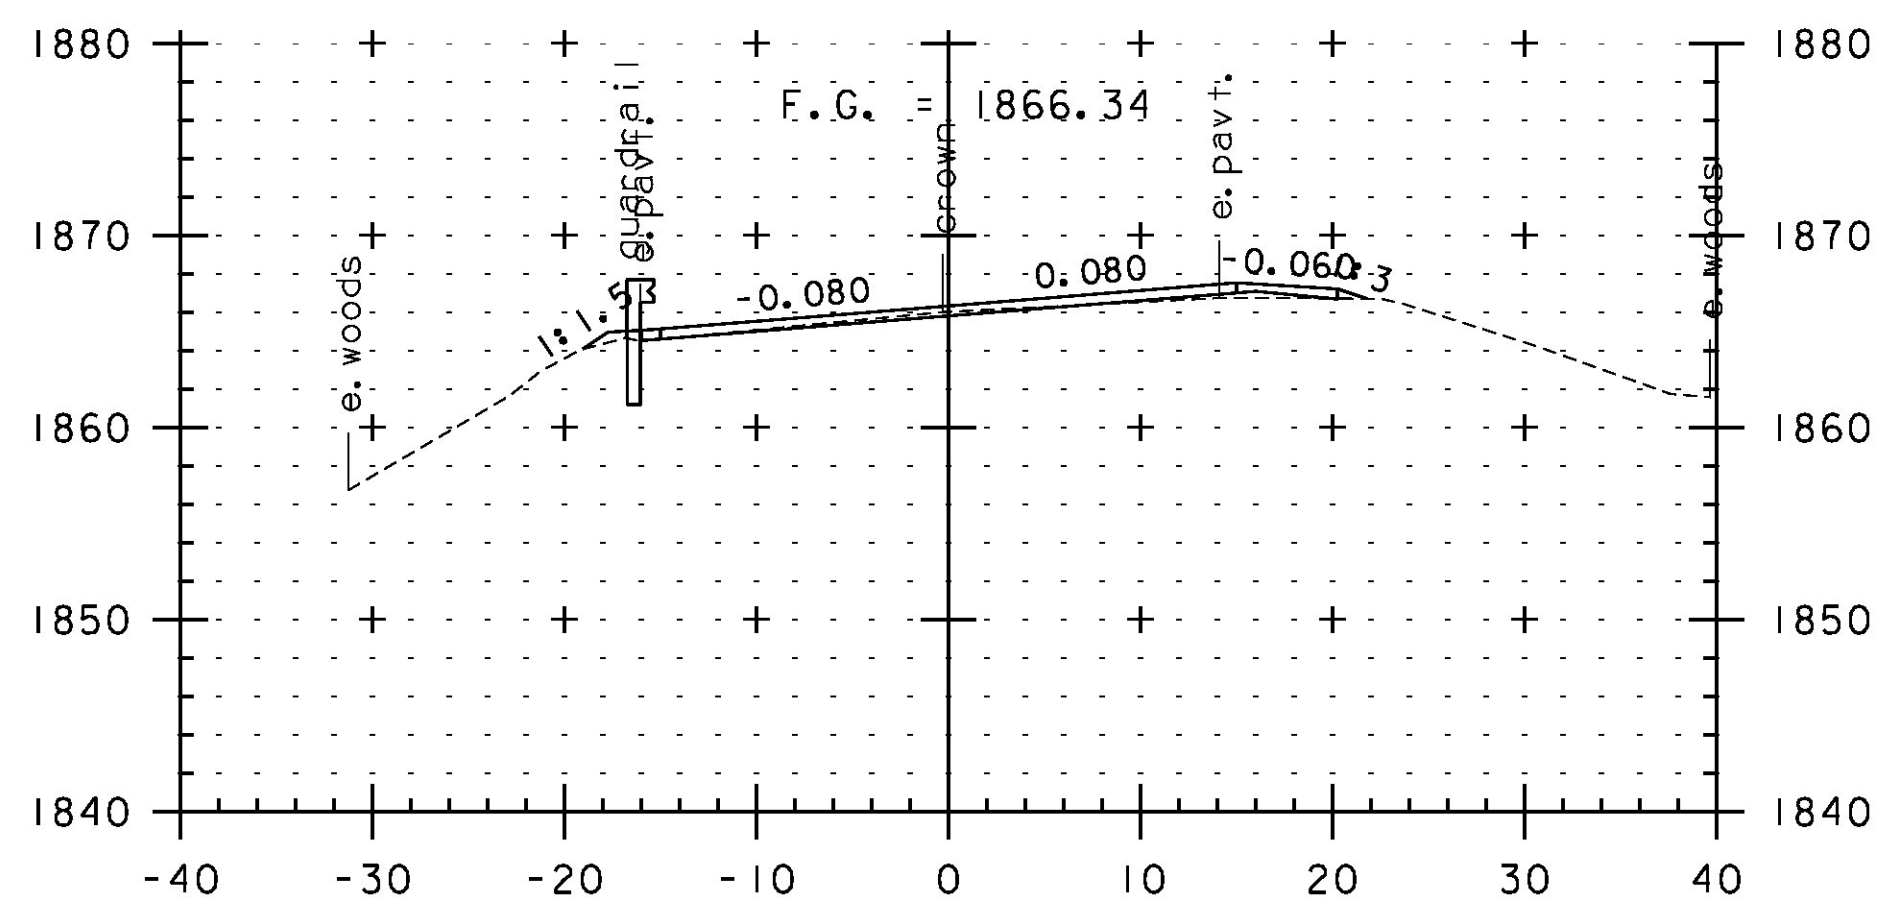

150+00

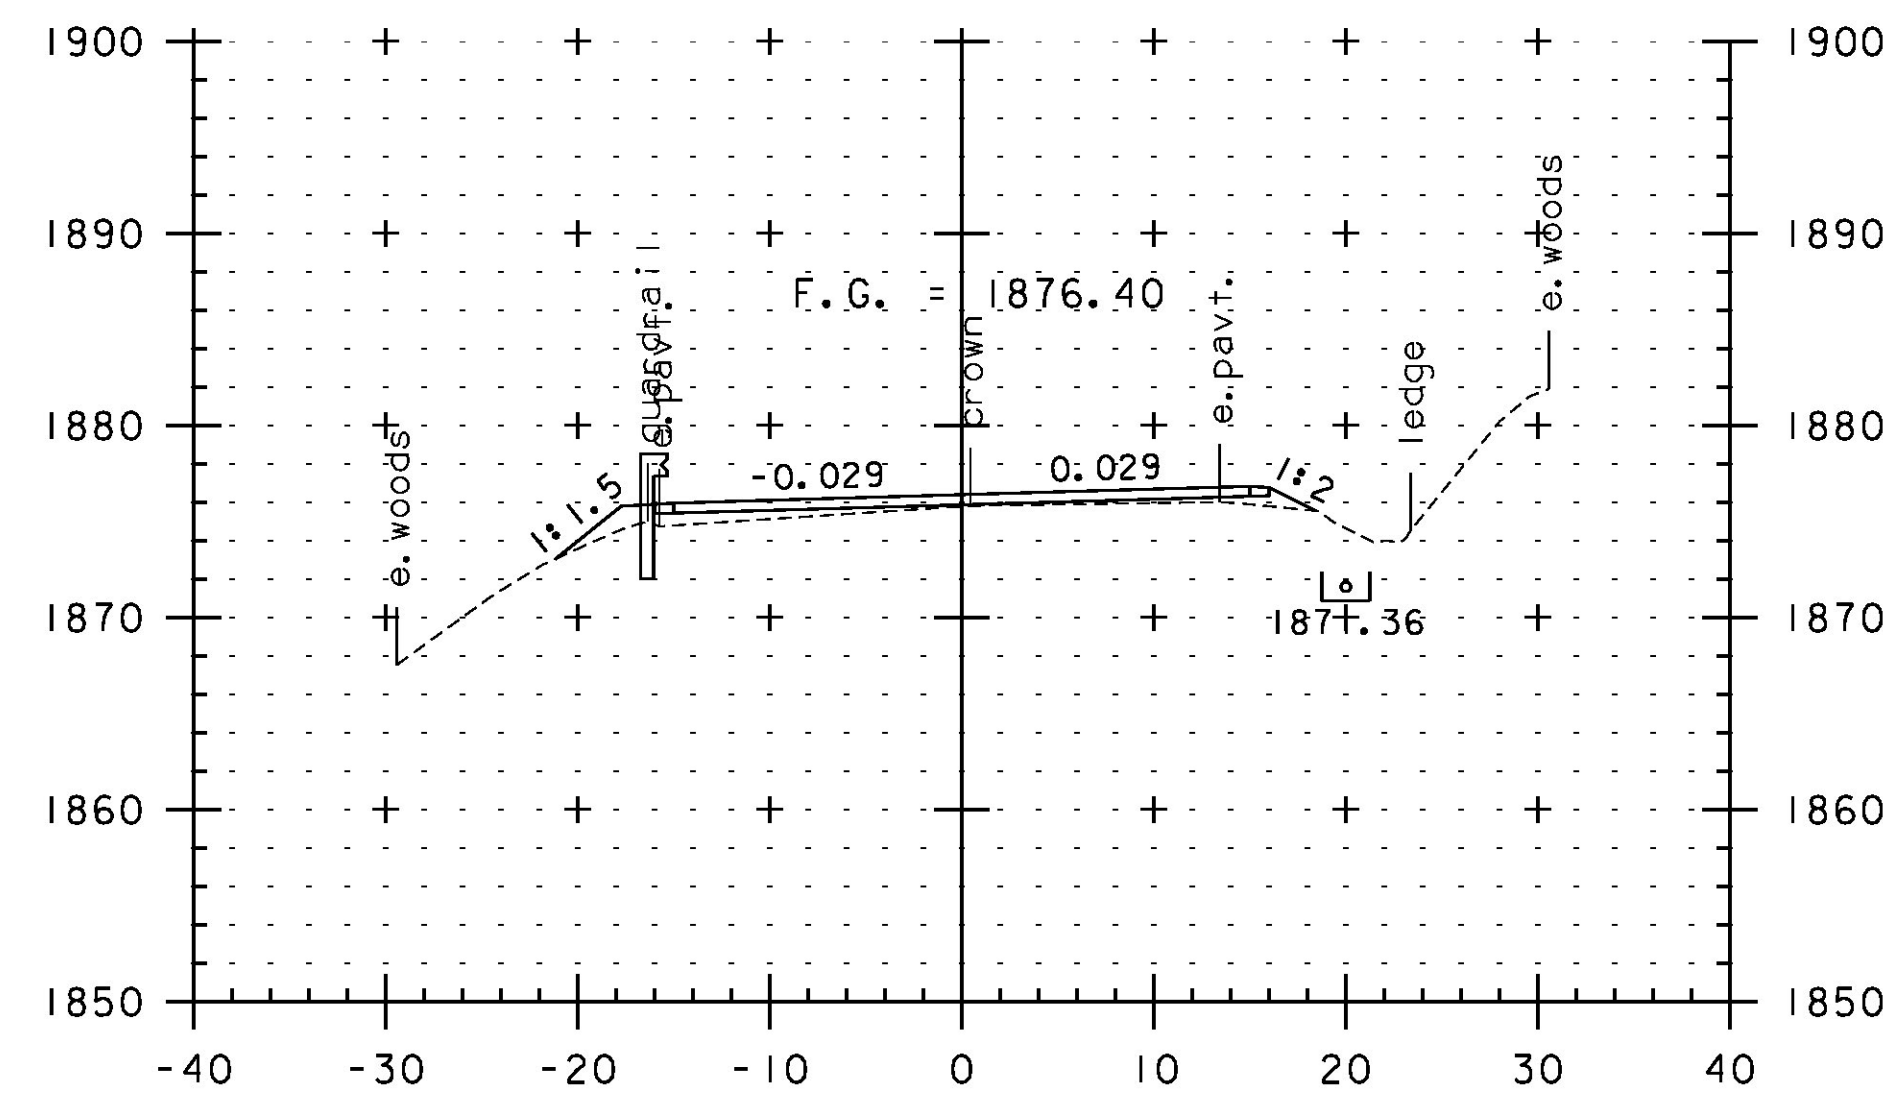

151+50

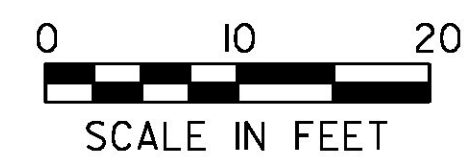

STA. 149+00 TO STA. 152+00

PROJECT NAME: JAY-TROY  
PROJECT NUMBER: STP 2315(1)

FILE NAME: z10b232xs.dgn  
PROJECT LEADER: P. SHEDD  
DESIGNED BY: N. LEMAY  
CROSS SECTION SHEET 28

PLOT DATE: 5/16/2014  
DRAWN BY: W. GORDON  
CHECKED BY: P. SHEDD  
SHEET 164 OF 244