




158+00

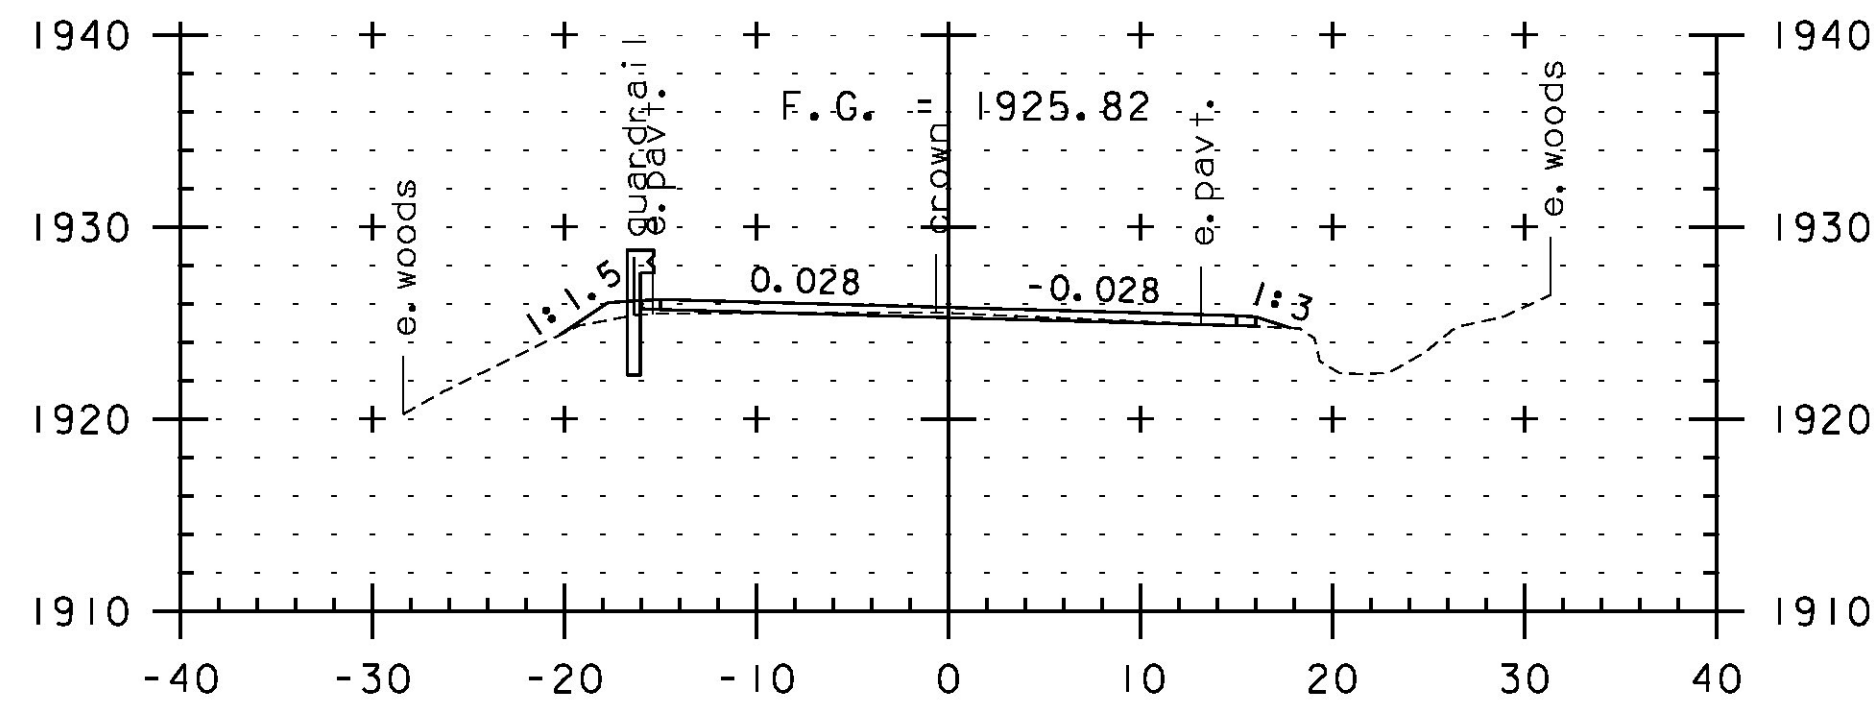


159+50

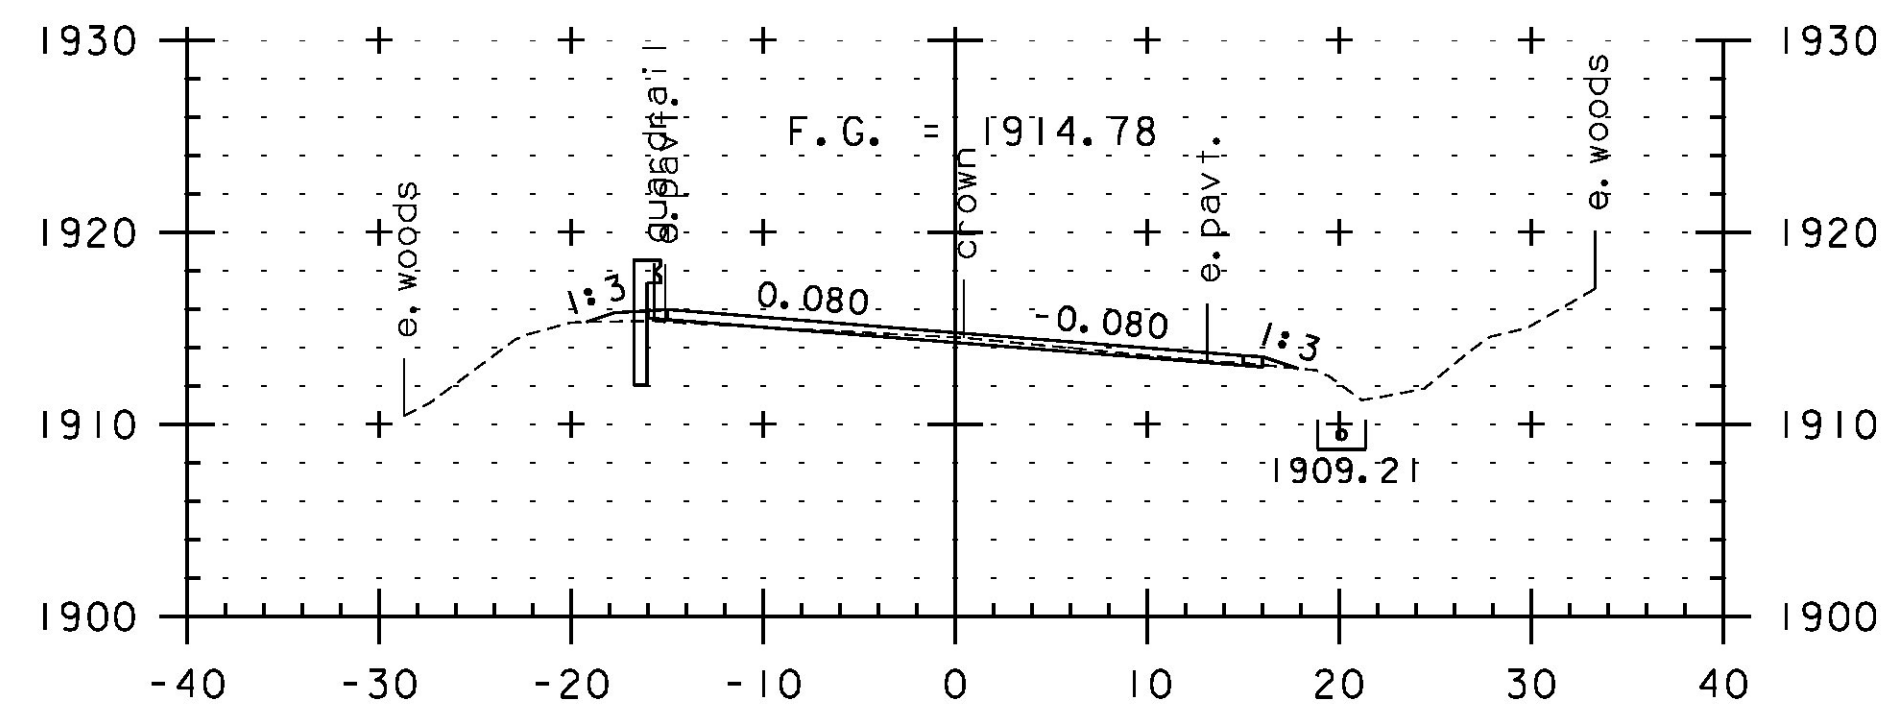


157+50

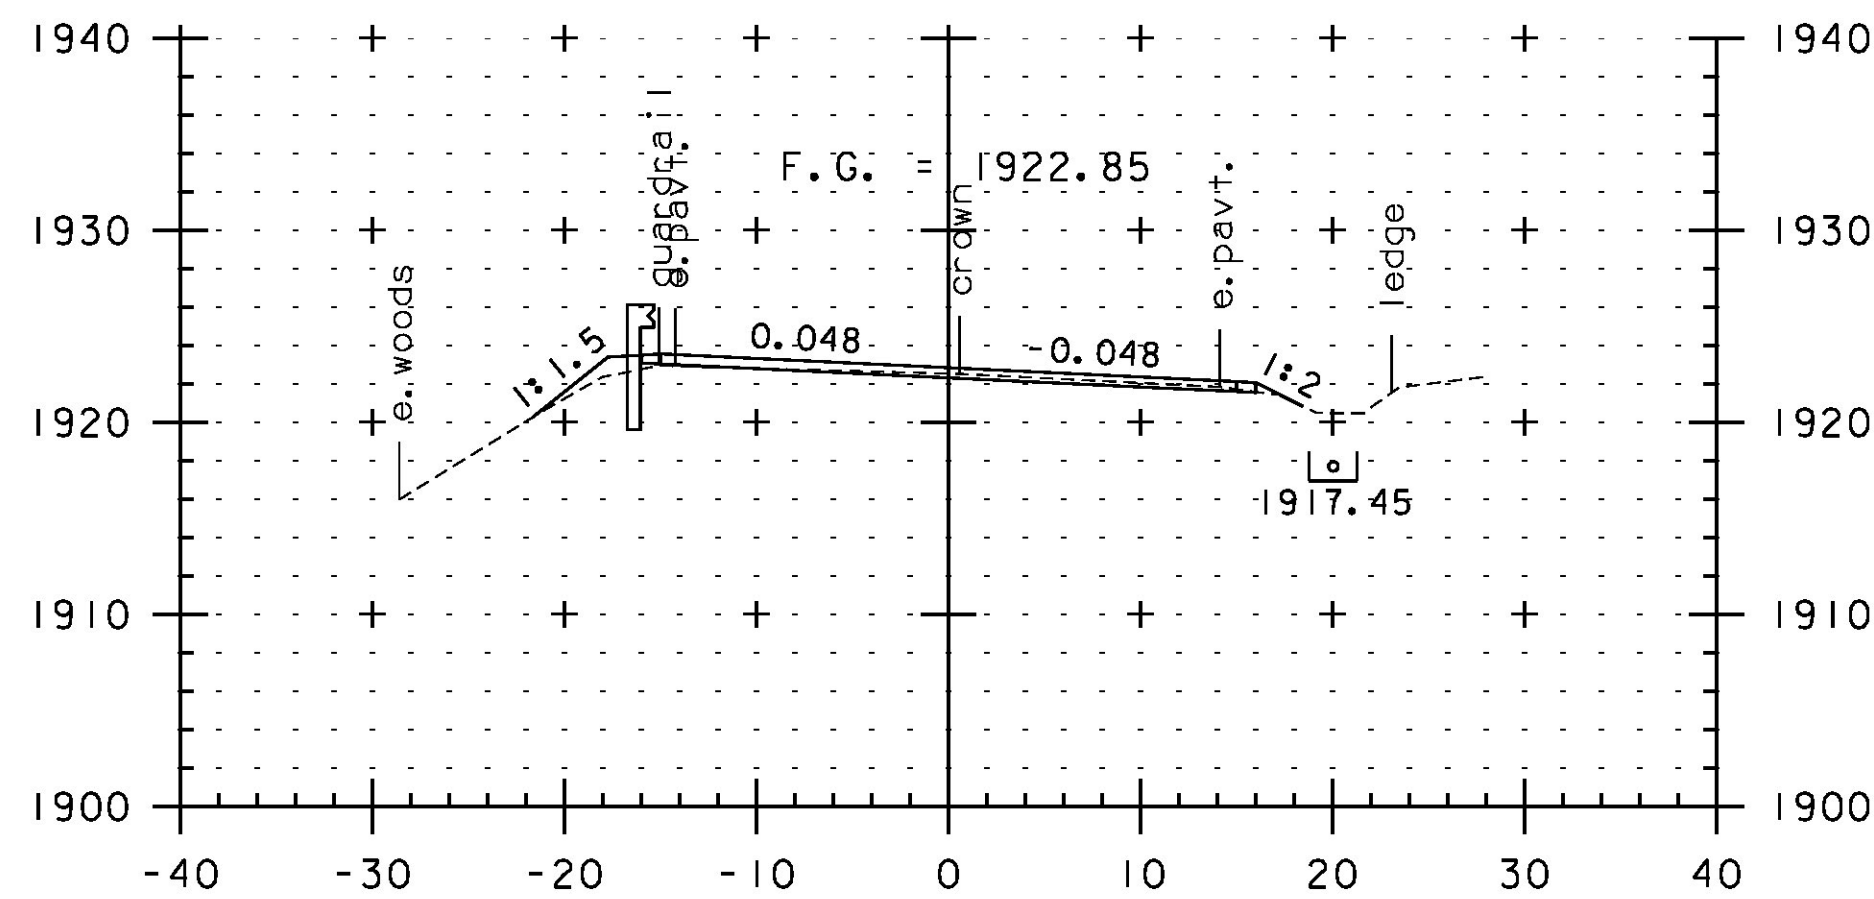


159+00

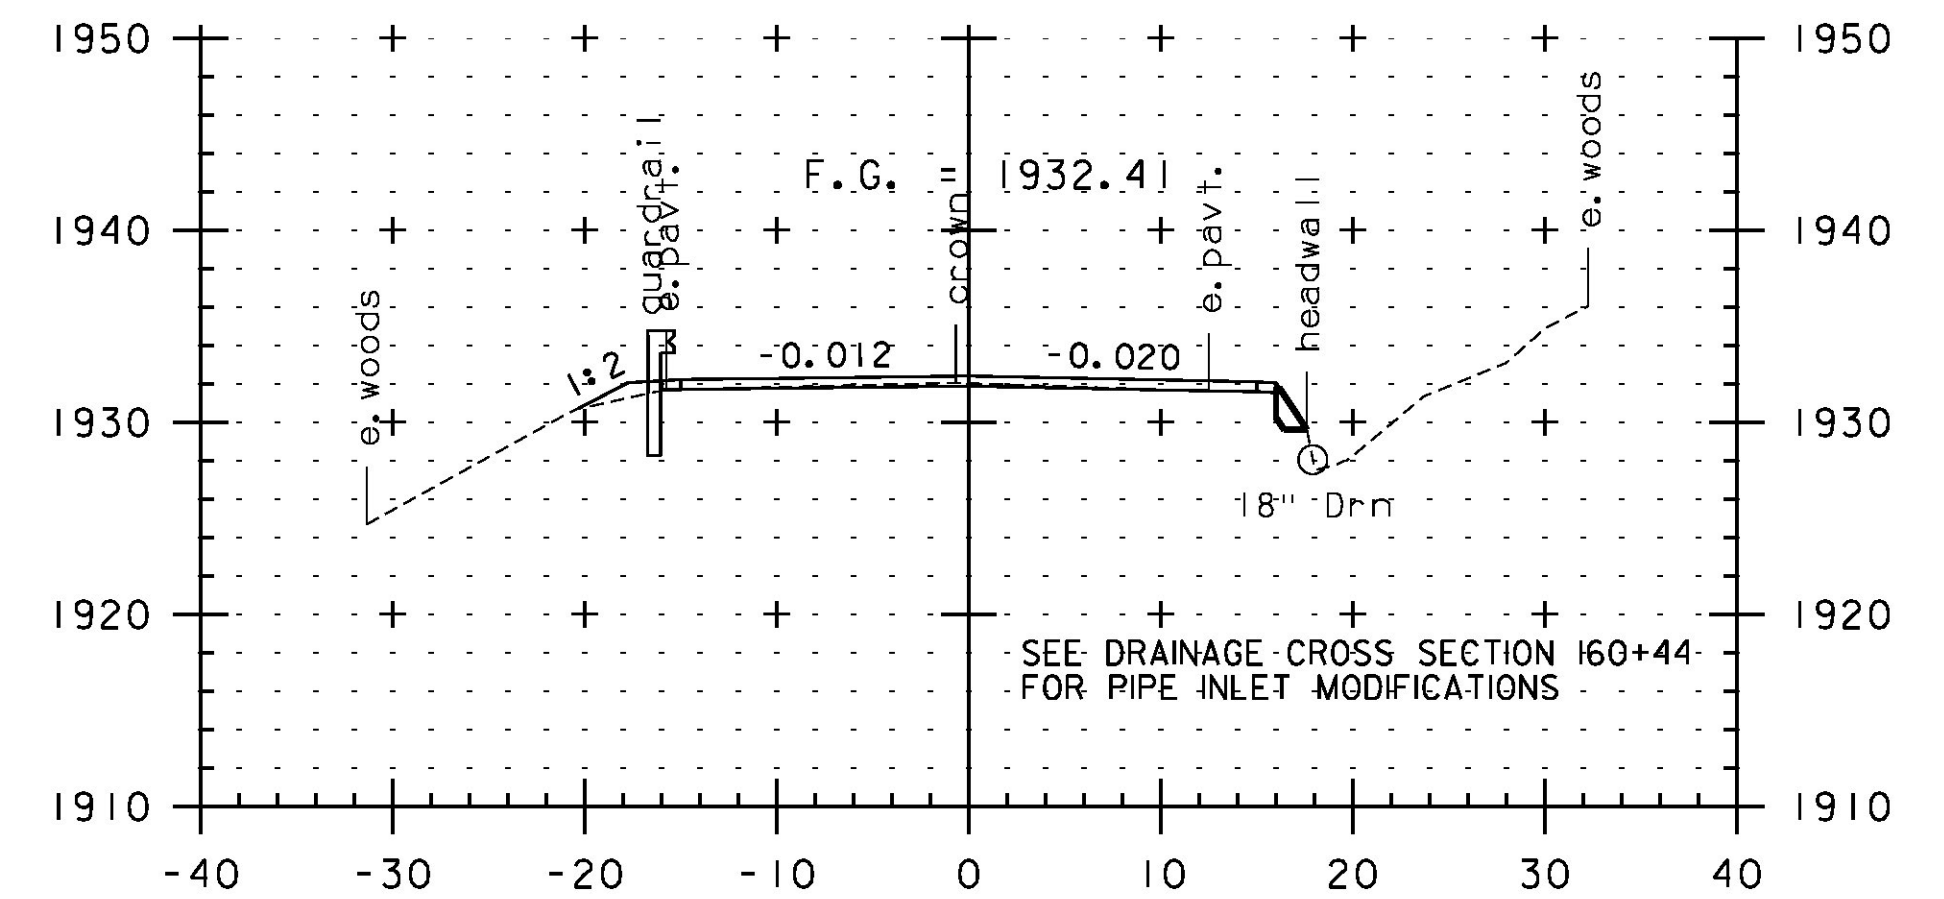


160+50

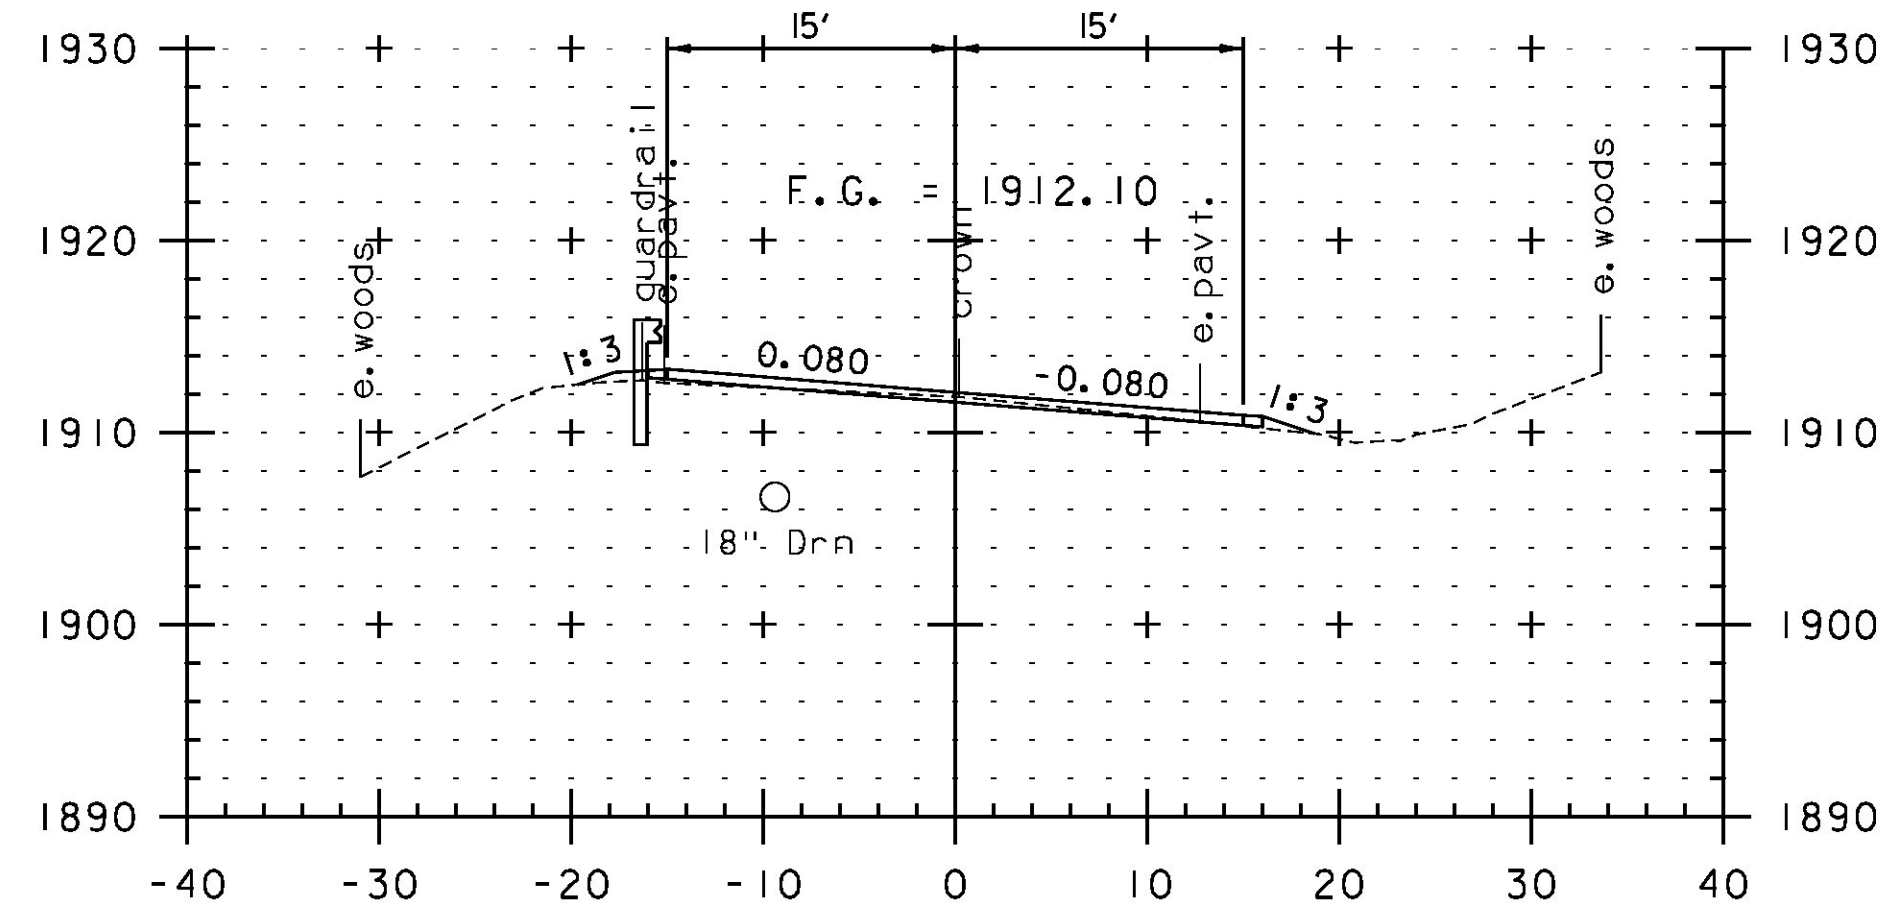


157+00

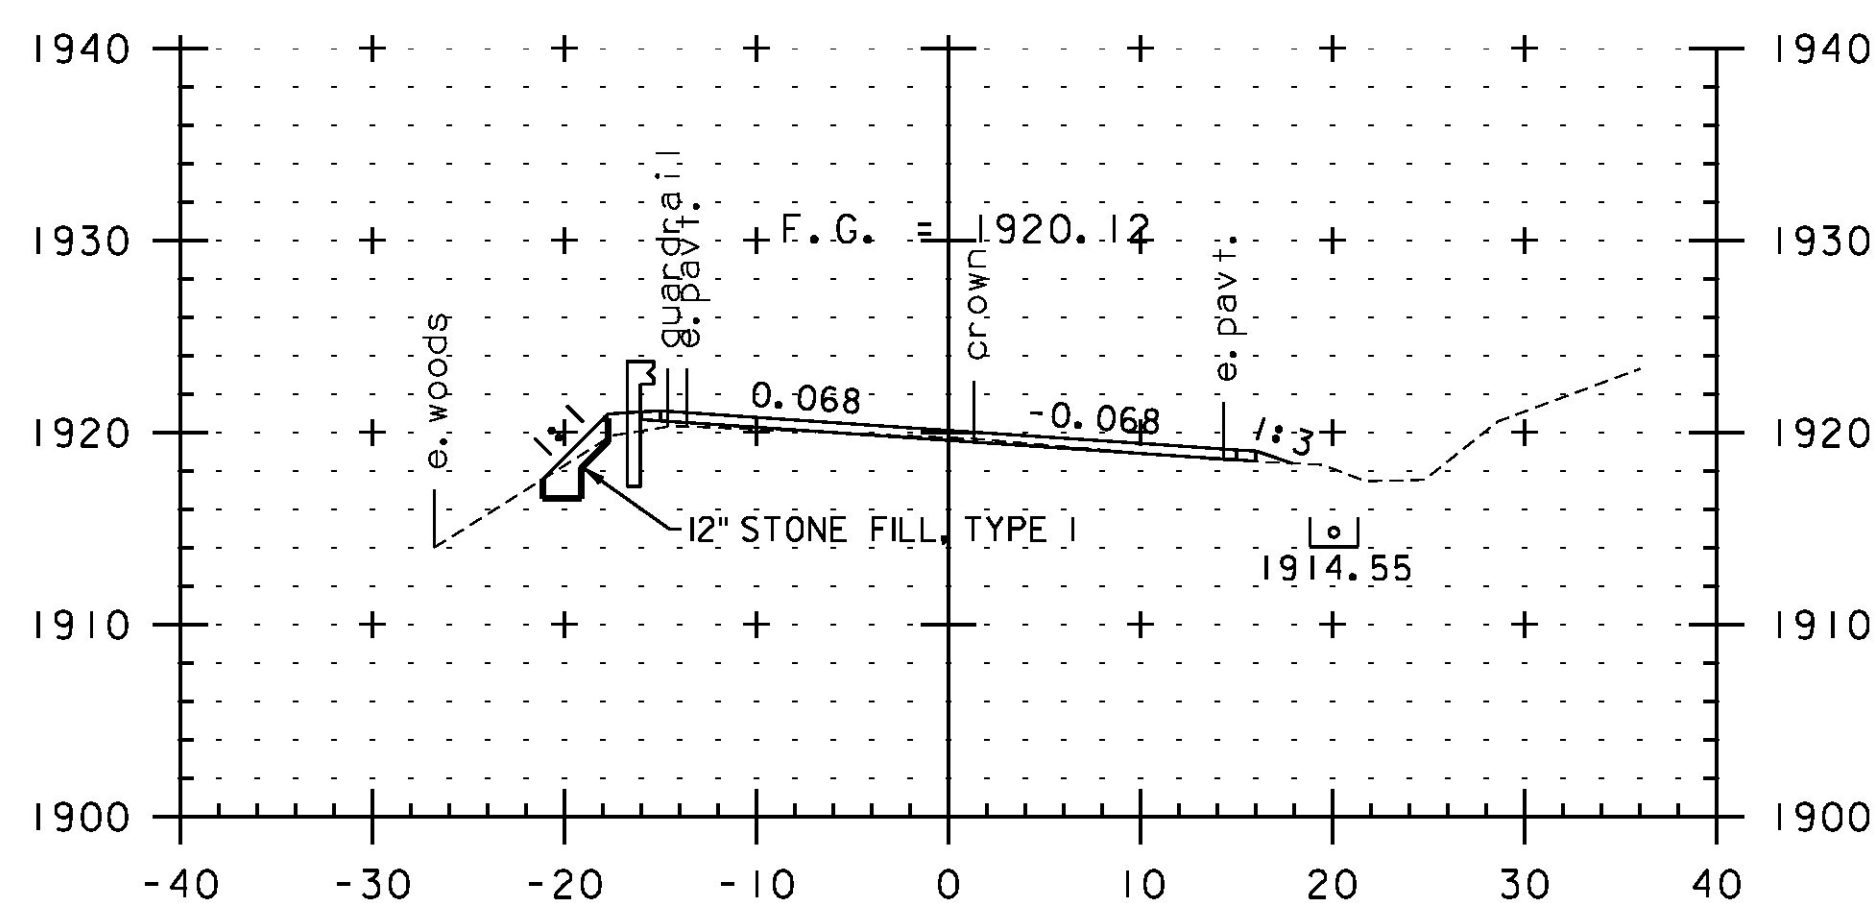

158+50

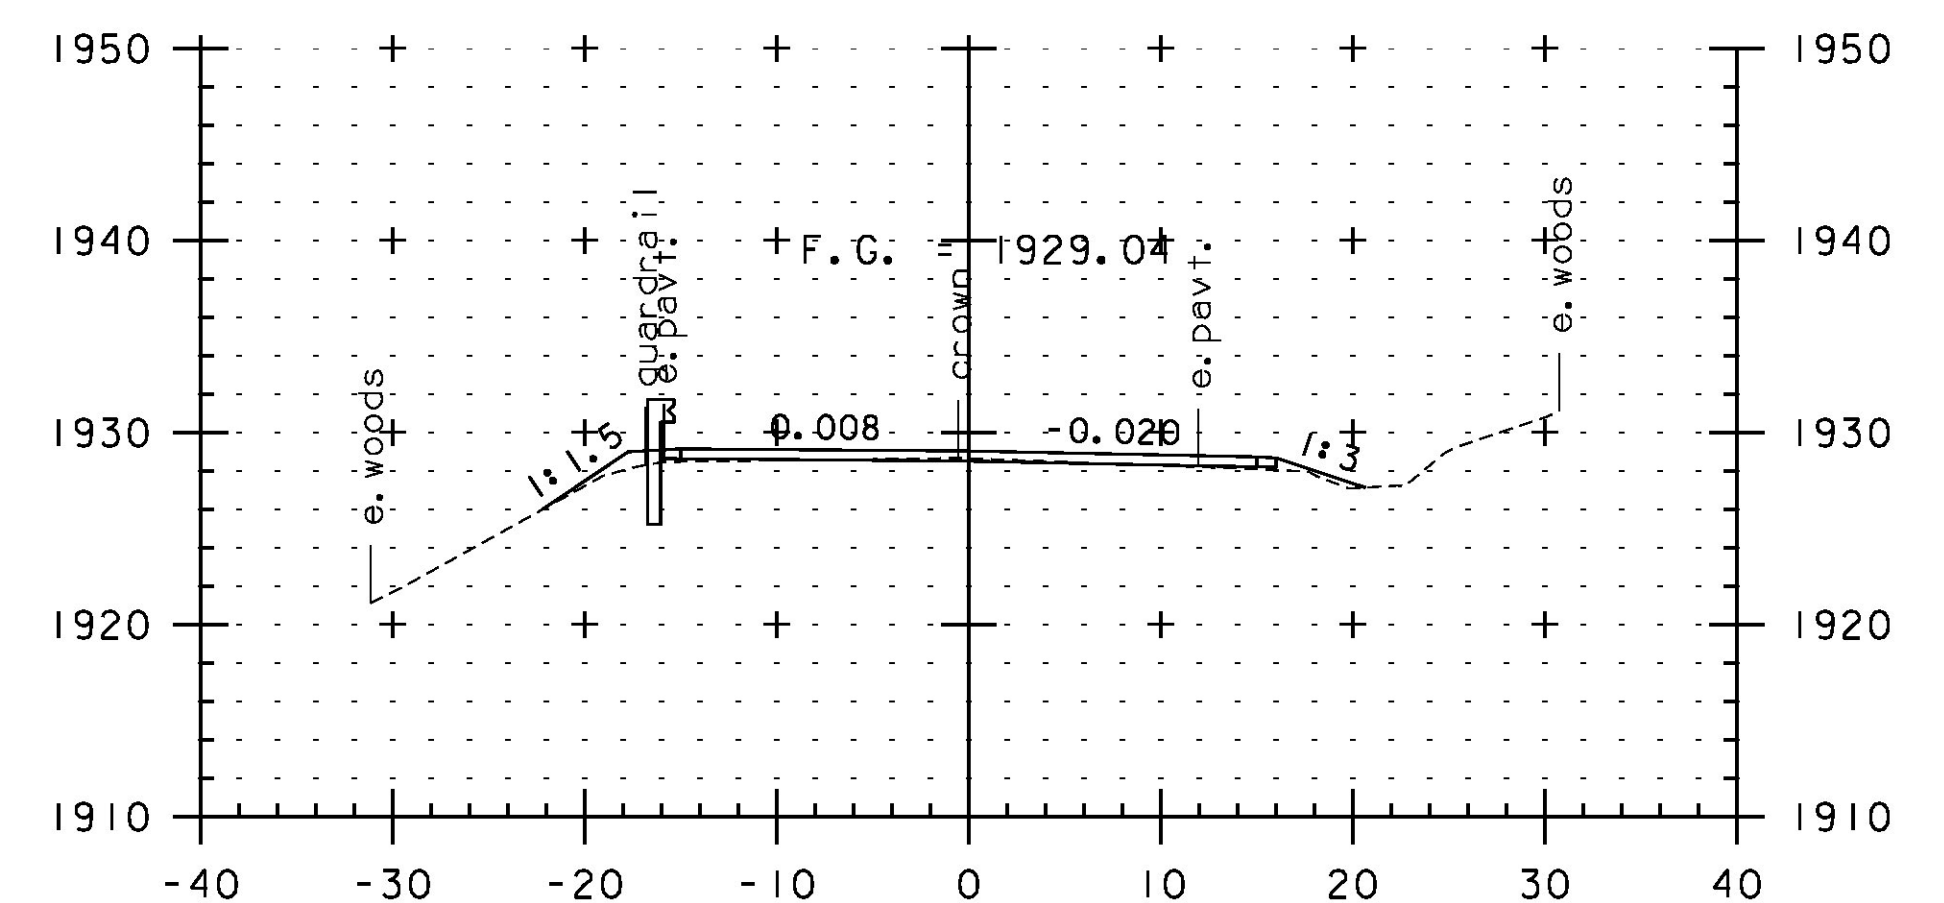

160+00

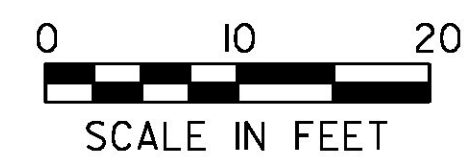

SCALE IN FEET

STA. 157+00 TO STA. 160+50

PROJECT NAME:	JAY-TROY	PLOT DATE:	5/16/2014
PROJECT NUMBER:	STP 2315(I)	DRAWN BY:	W. GORDON
FILE NAME:	z10b232xs.dgn	DESIGNED BY:	N. LEMAY
PROJECT LEADER:	P. SHEDD	CHECKED BY:	P. SHEDD
CROSS SECTION SHEET 30		SHEET	166 OF 244