




164+00

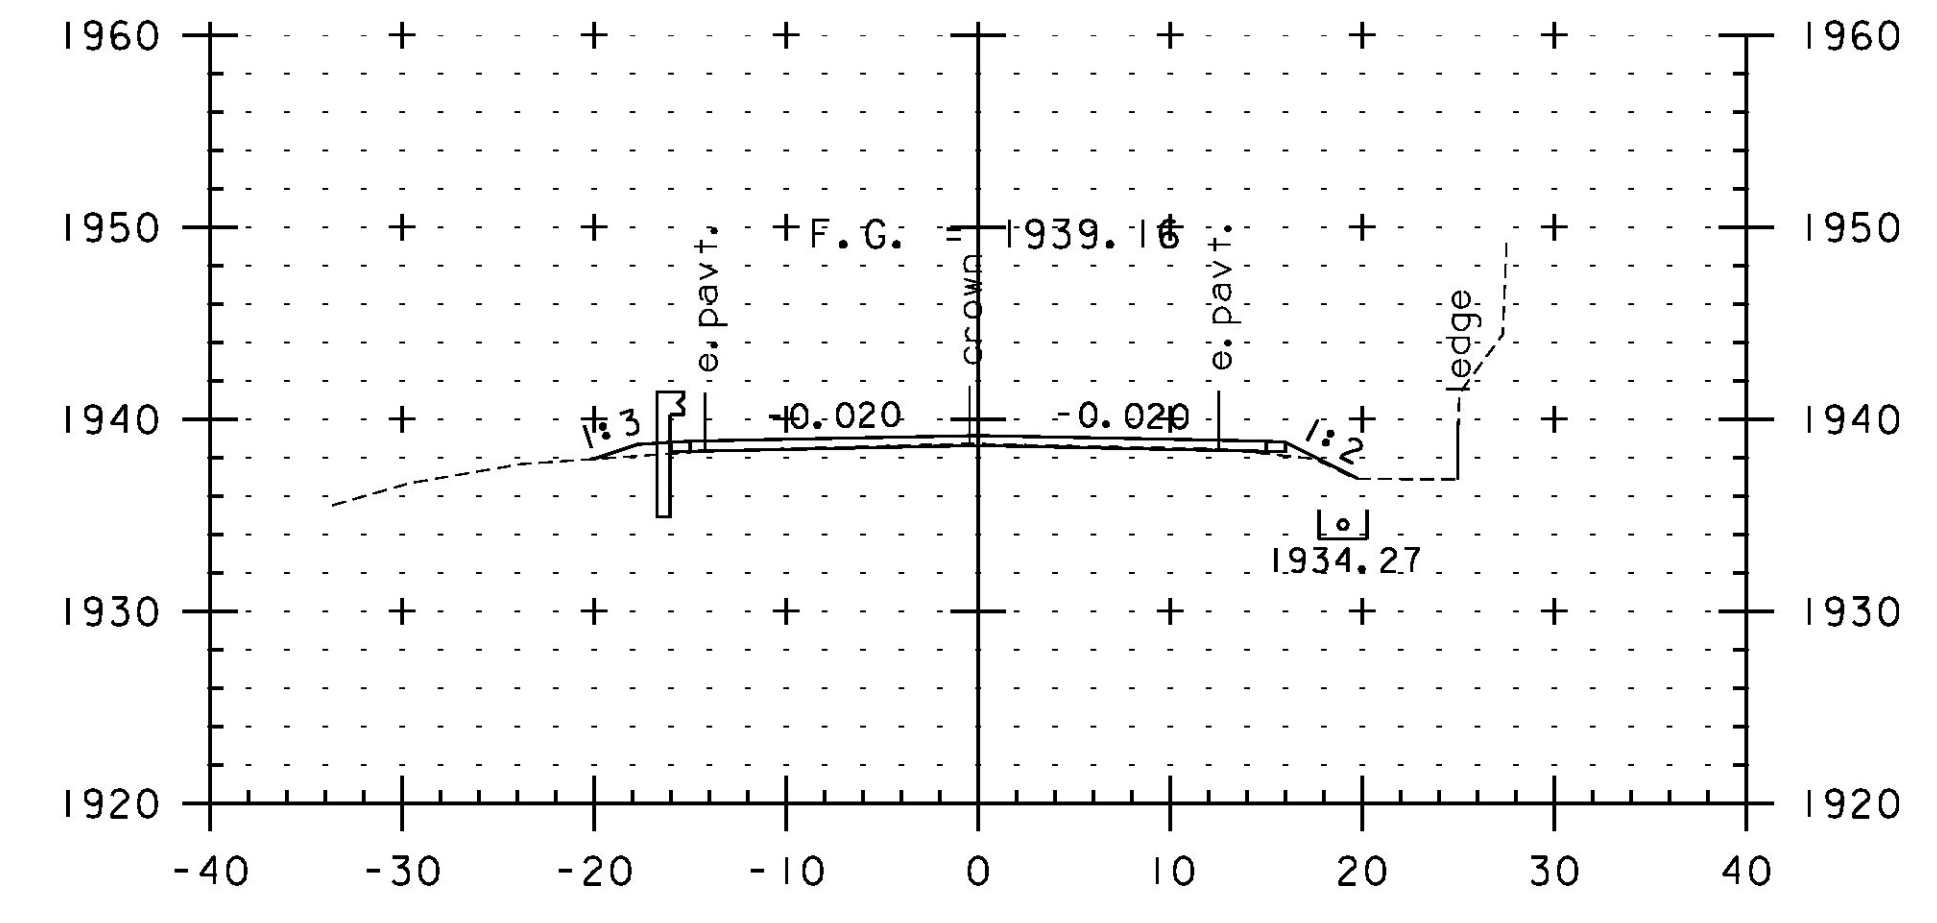


161+50

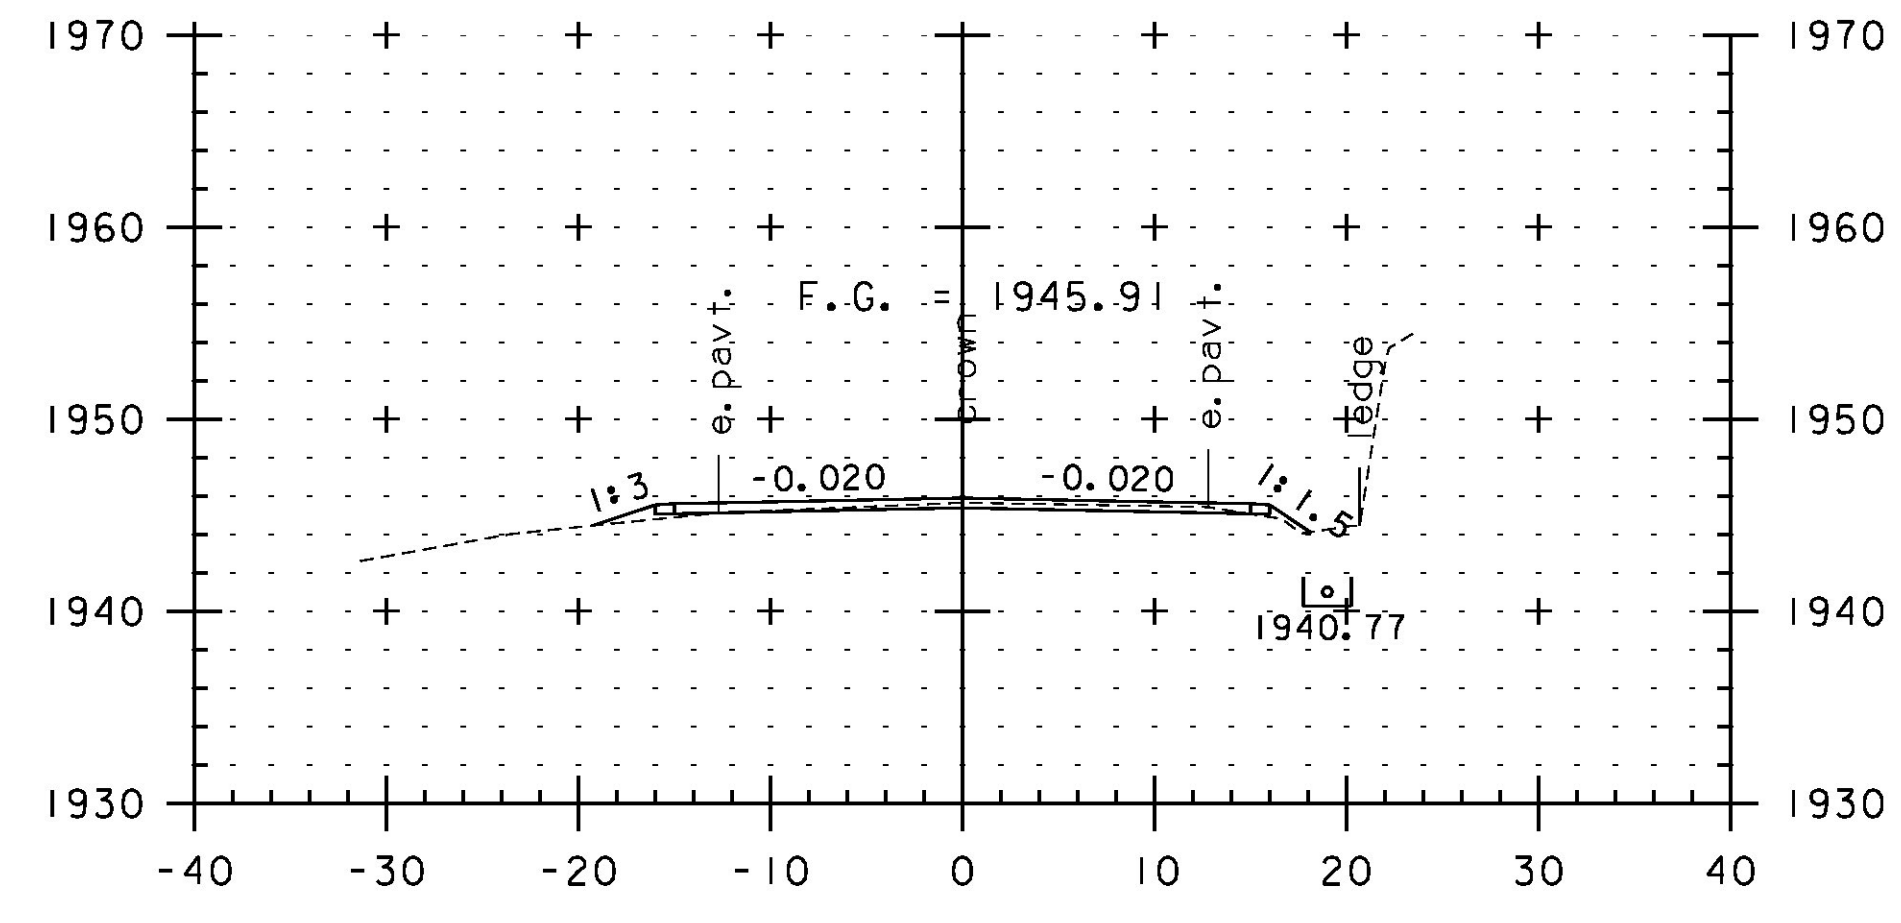


162+50

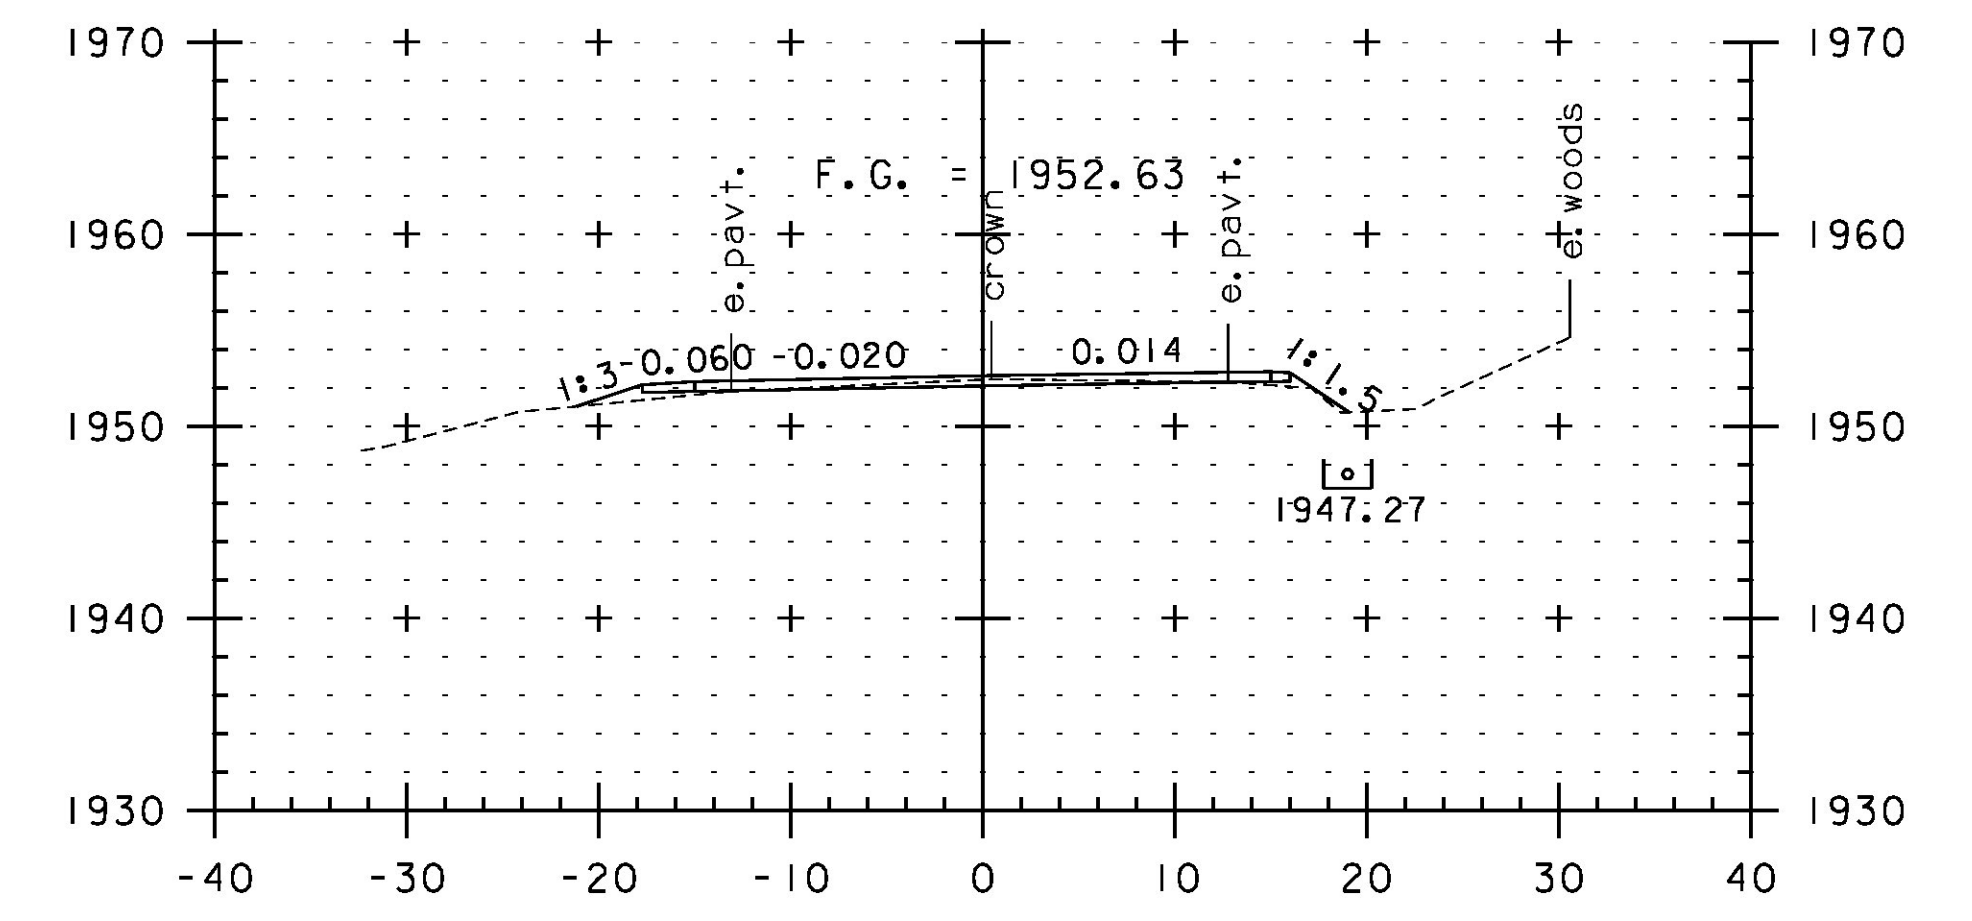


163+50

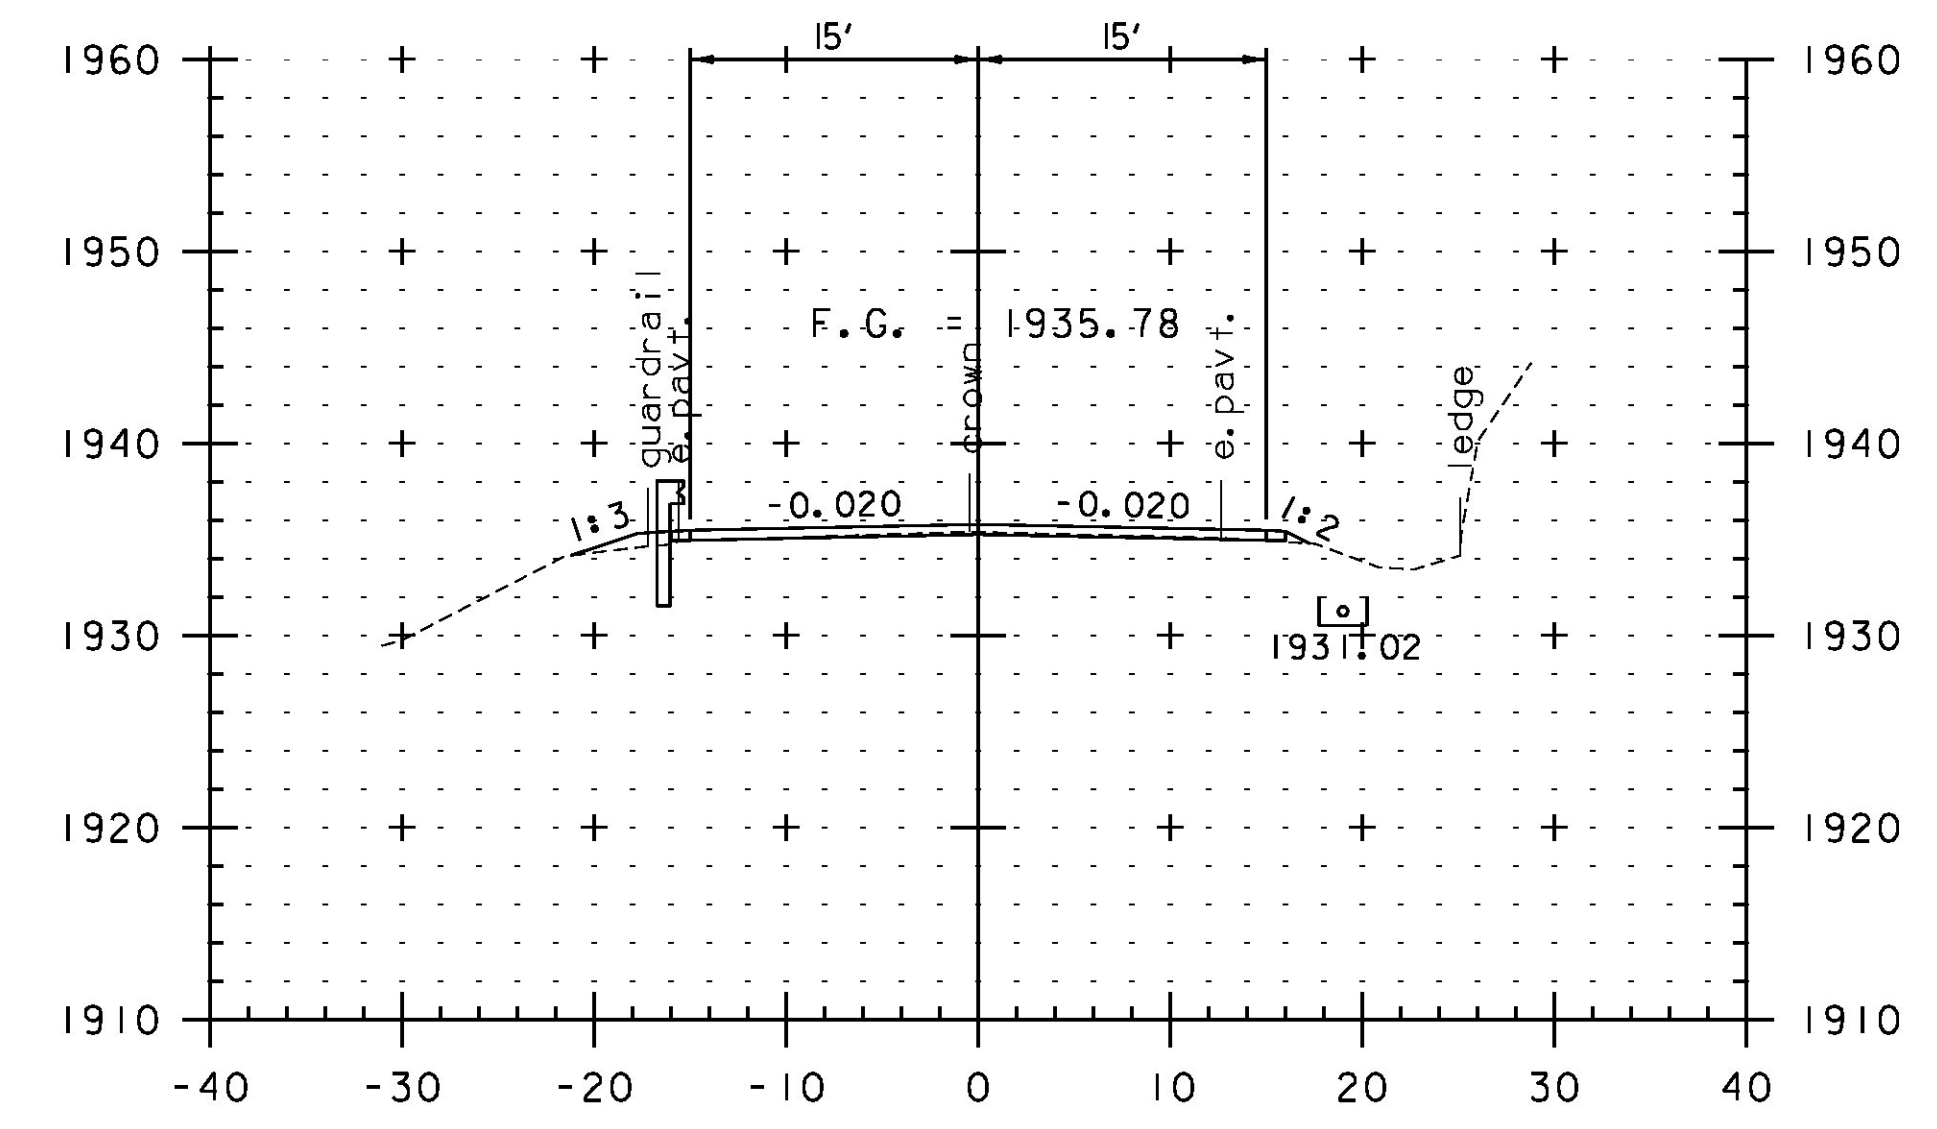


161+00

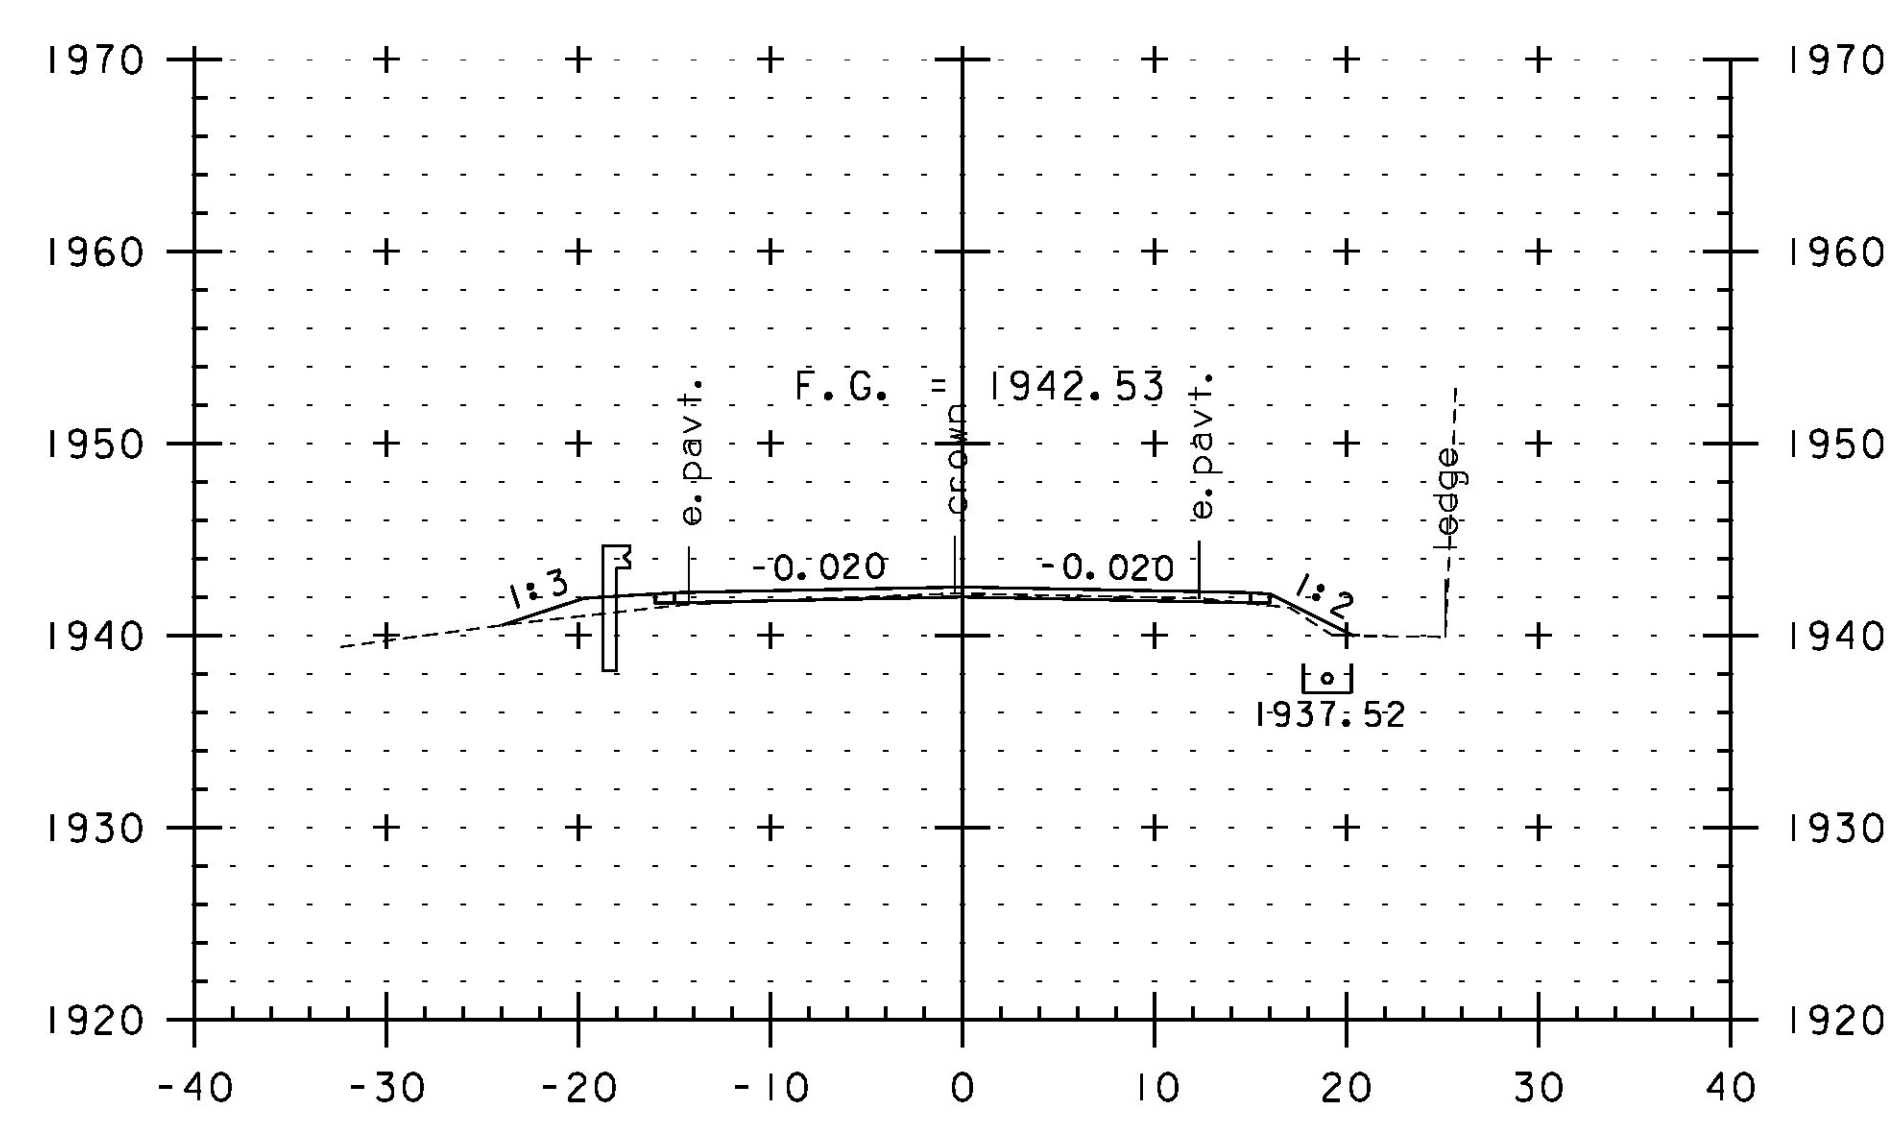

162+00

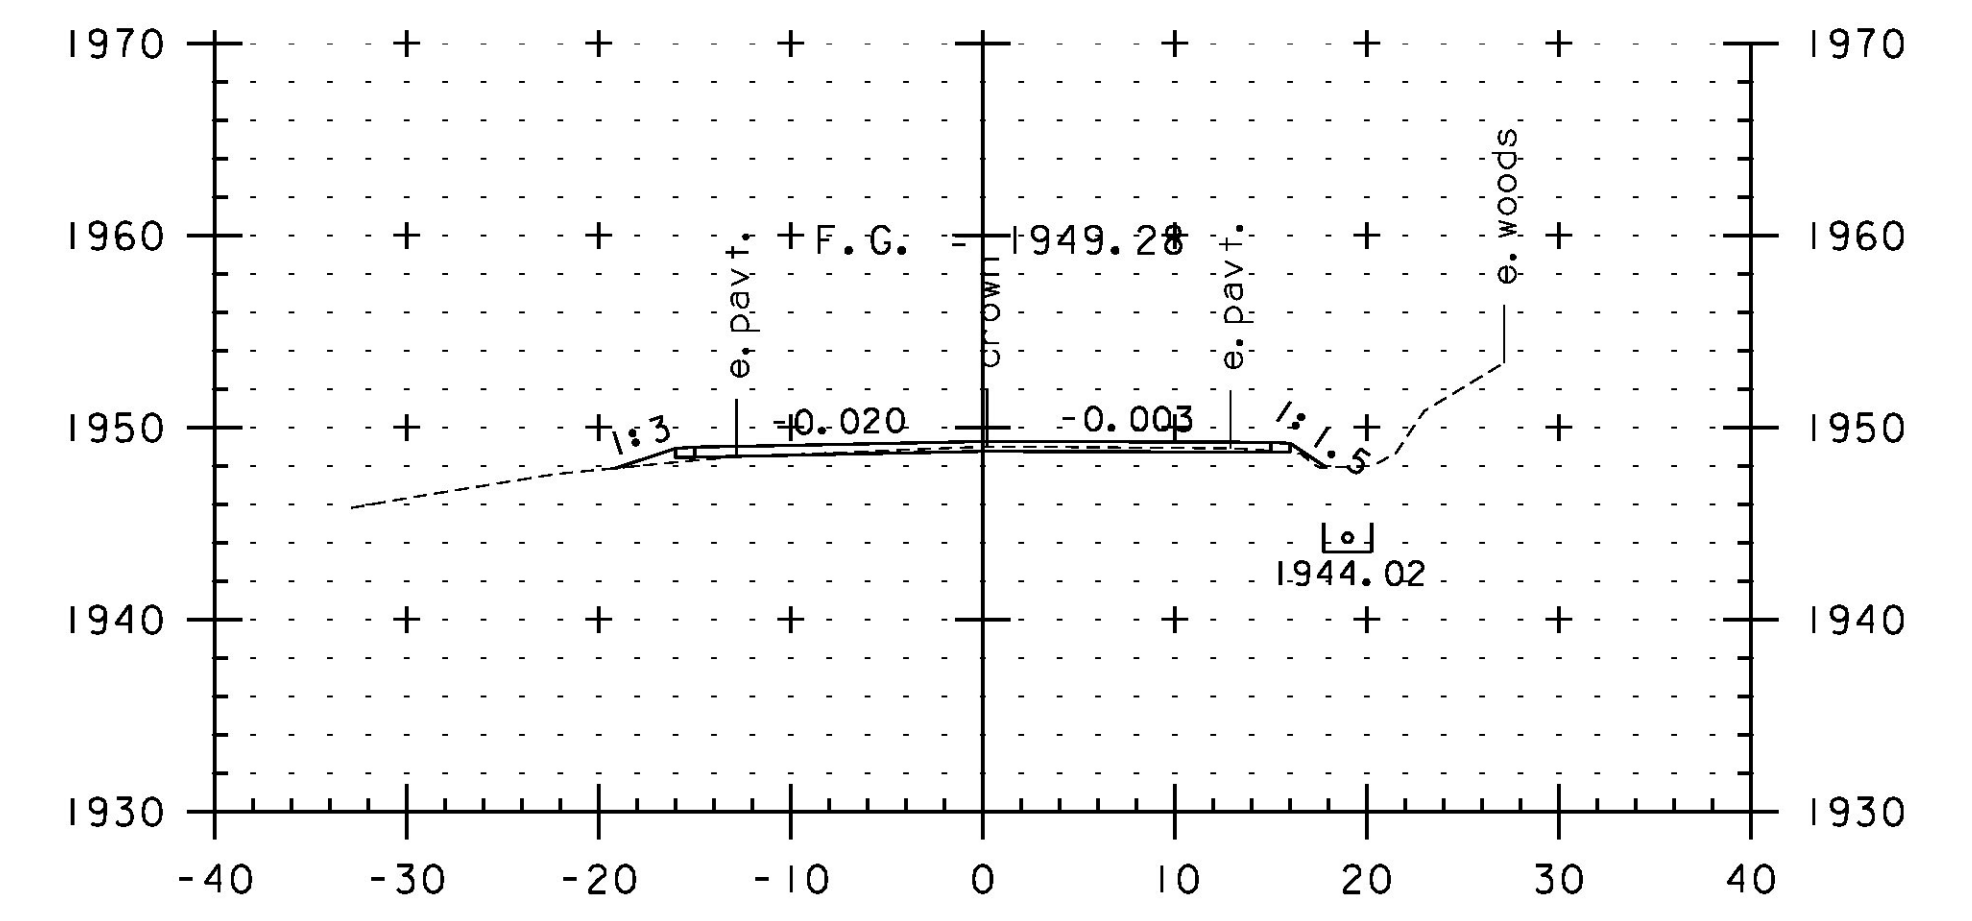

163+00

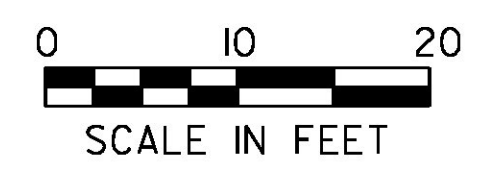

STA. 161+00 TO STA. 164+00

PROJECT NAME:	JAY-TROY	PLOT DATE:	5/16/2014
PROJECT NUMBER:	STP 2315(I)	DRAWN BY:	W. GORDON
FILE NAME:	z10b232xs.dgn	CHECKED BY:	P. SHEDD
PROJECT LEADER:	P. SHEDD	CROSS SECTION SHEET 31	SHEET 167 OF 244
DESIGNED BY:	N. LEMAY		