




169+00

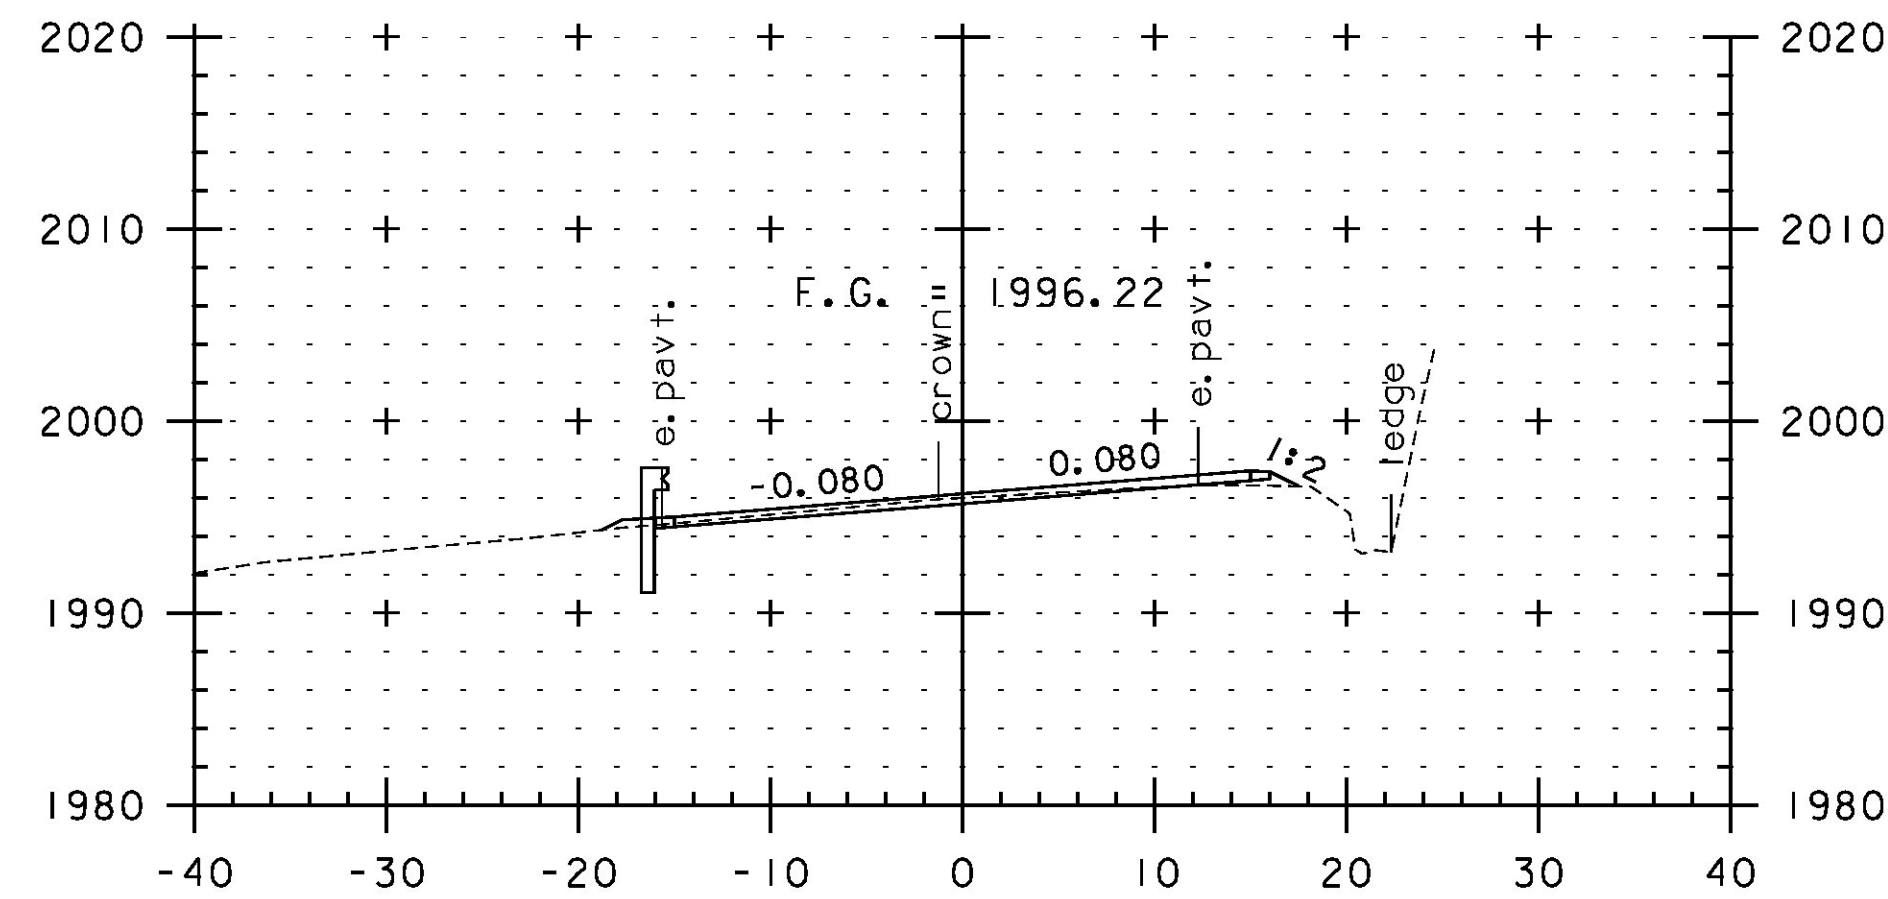

170+50

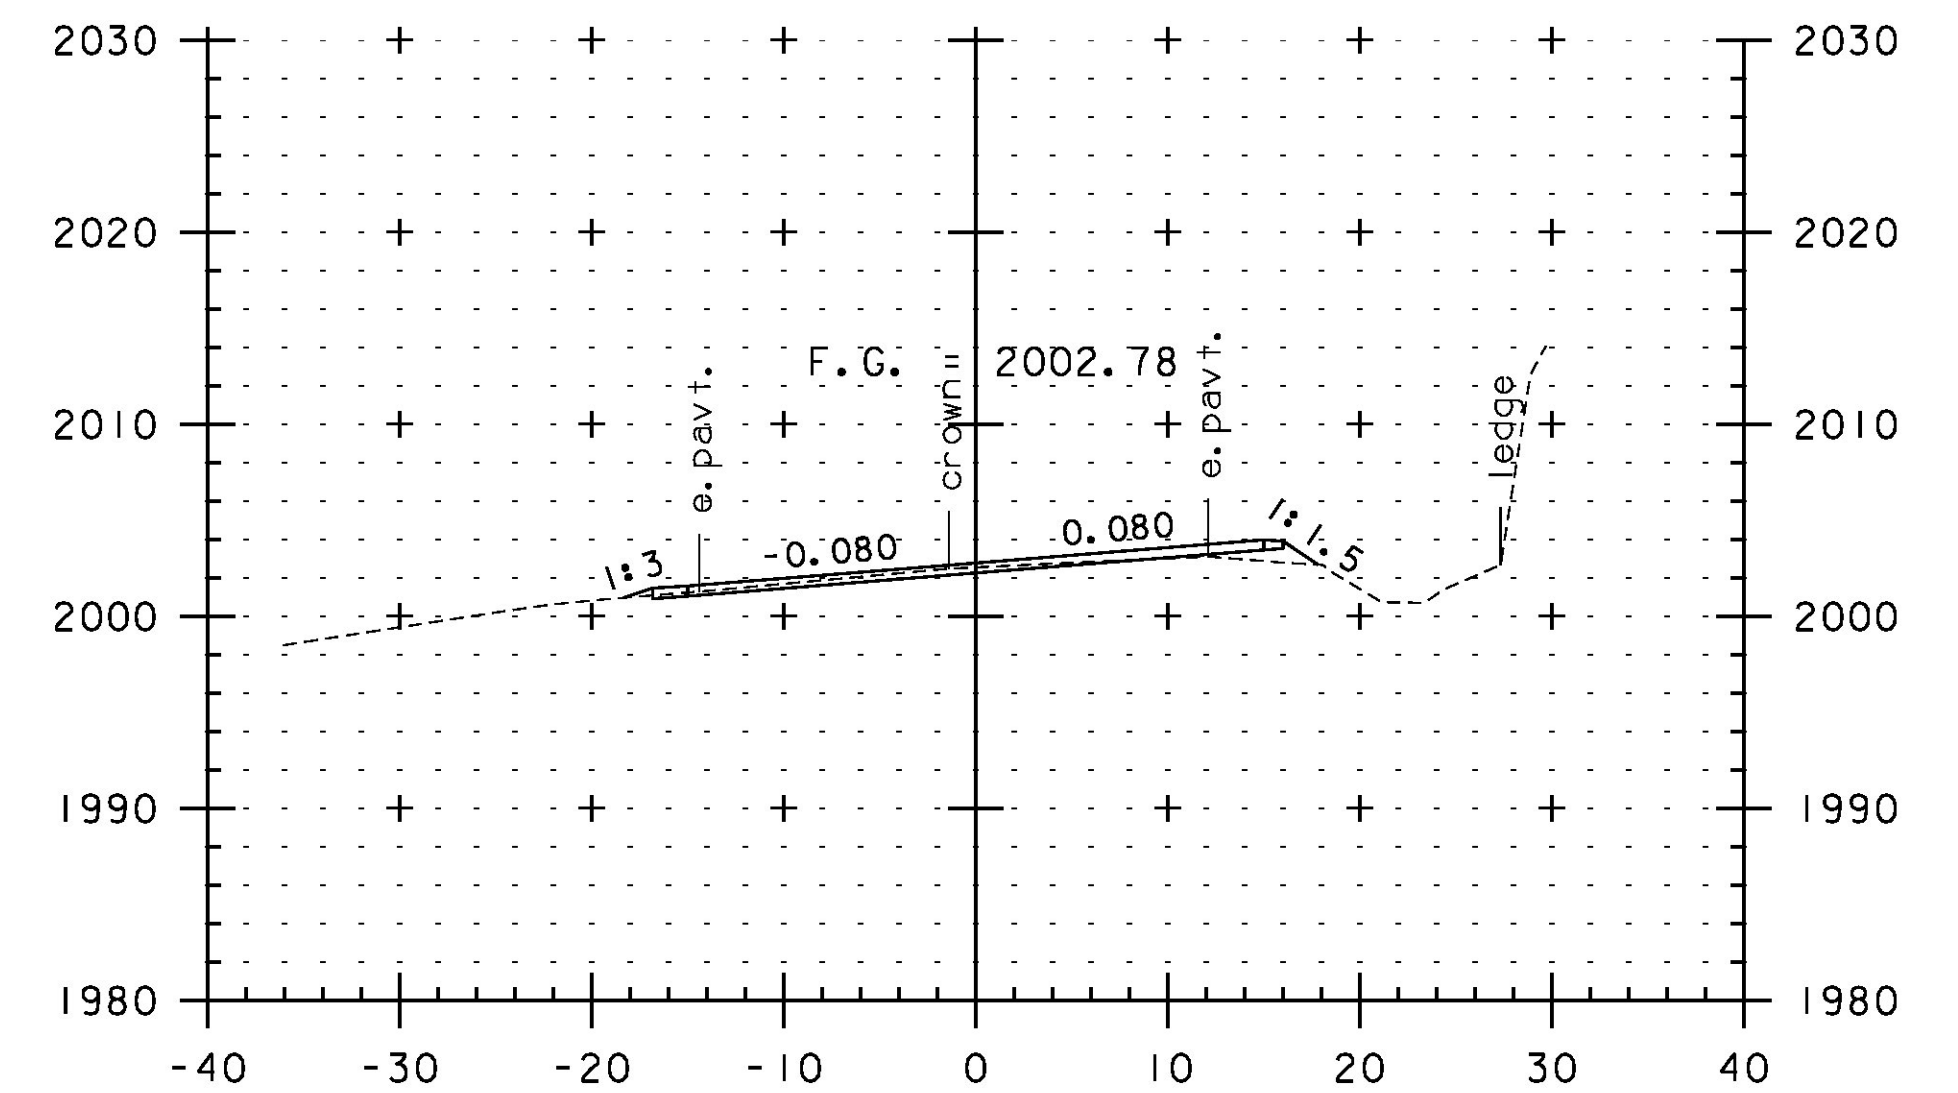


171+50

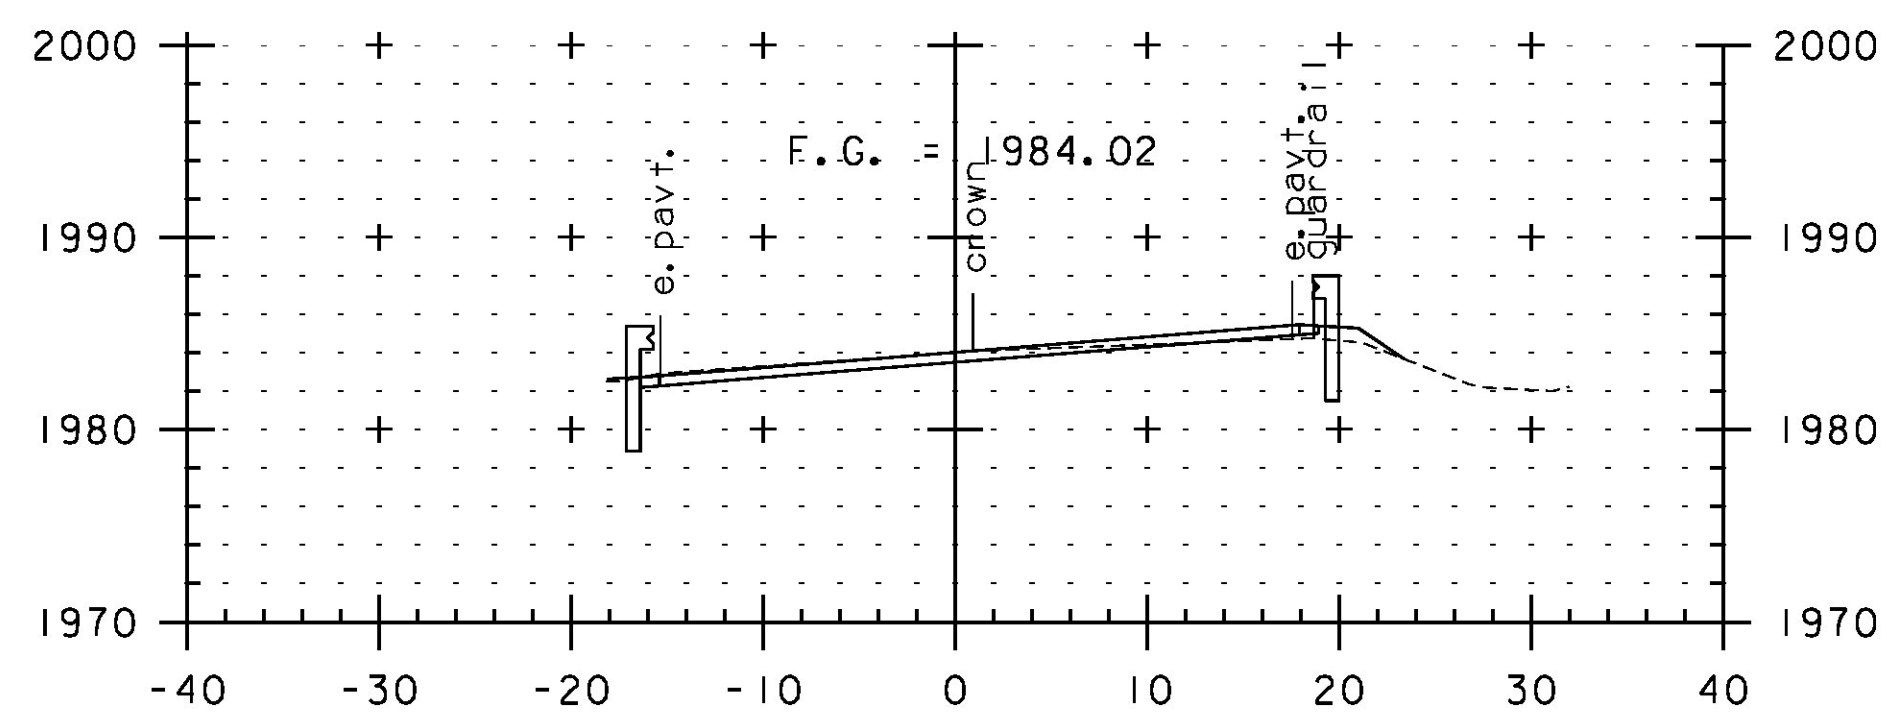


168+75


END BRIDGE 49 APPROACH

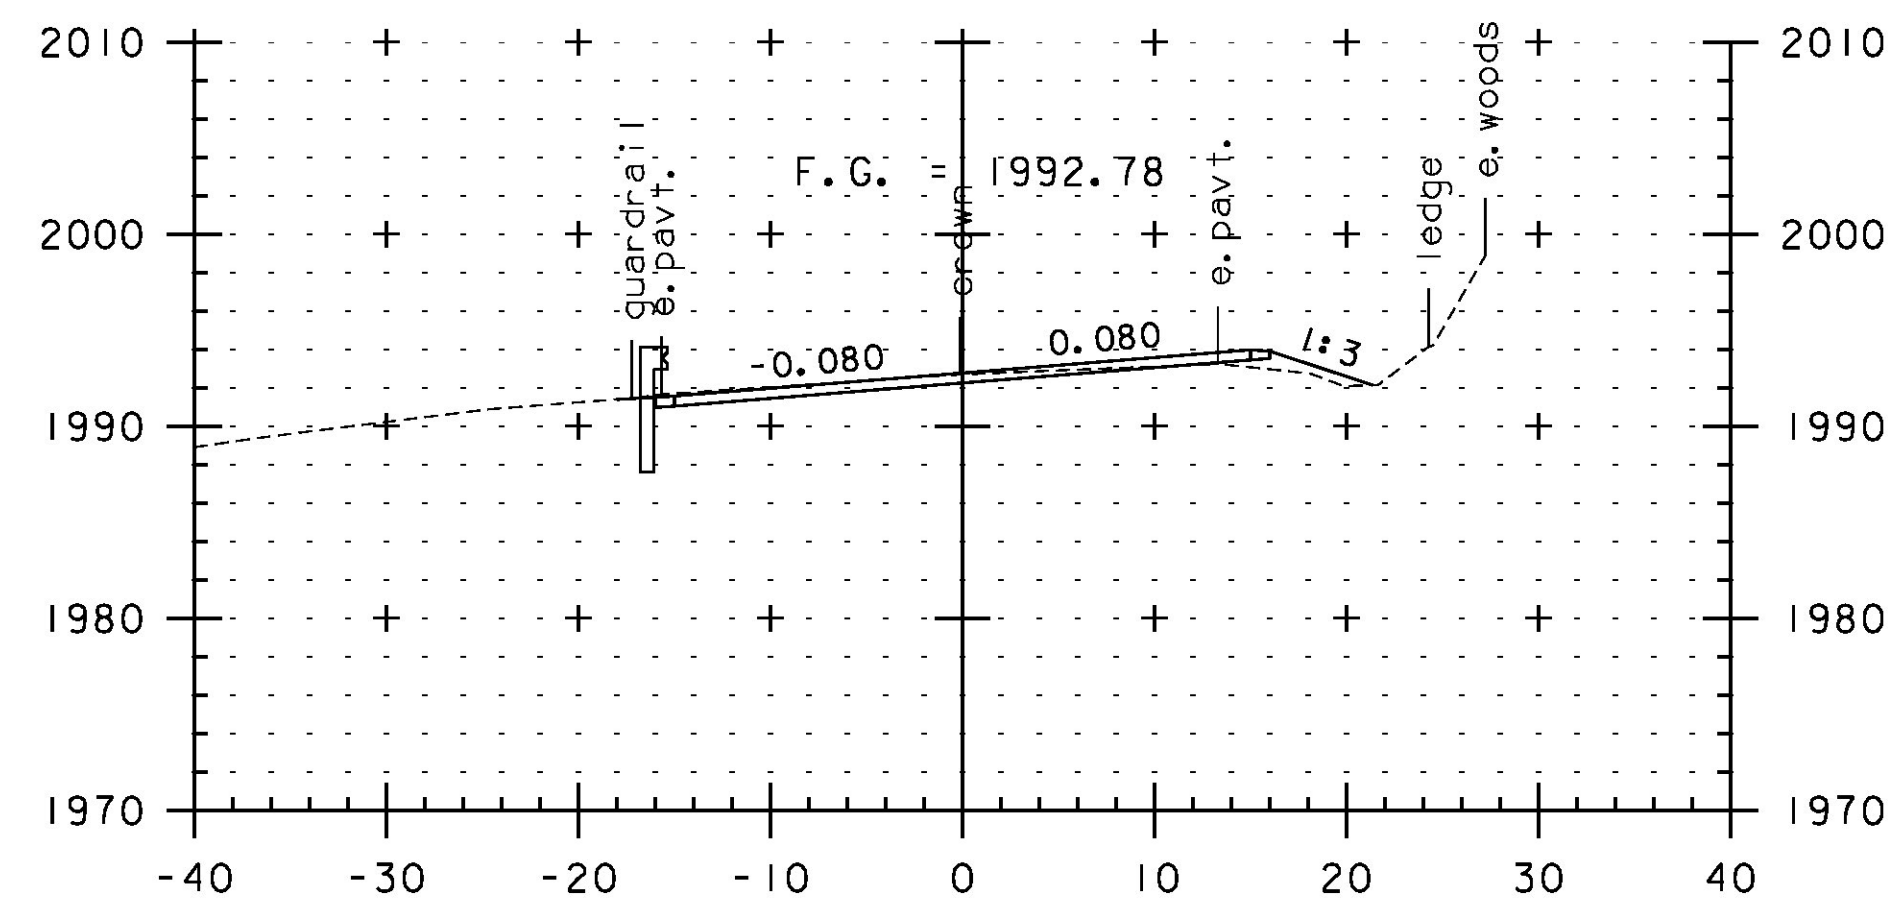


170+00

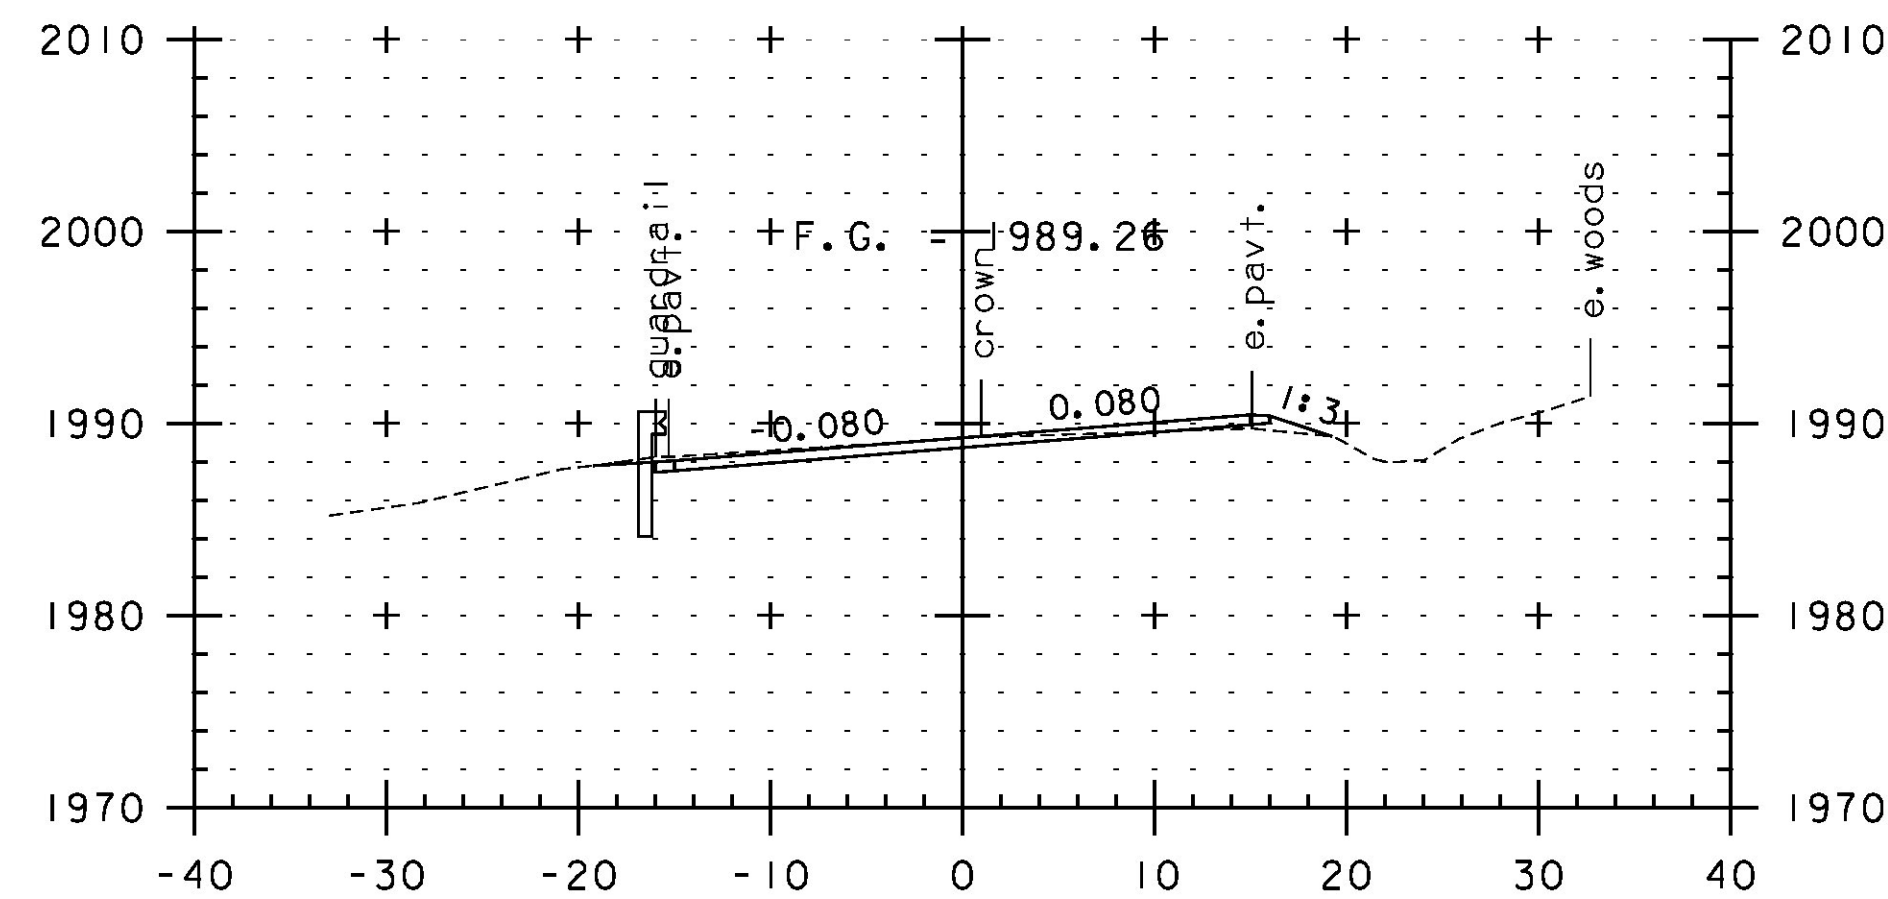

169+50

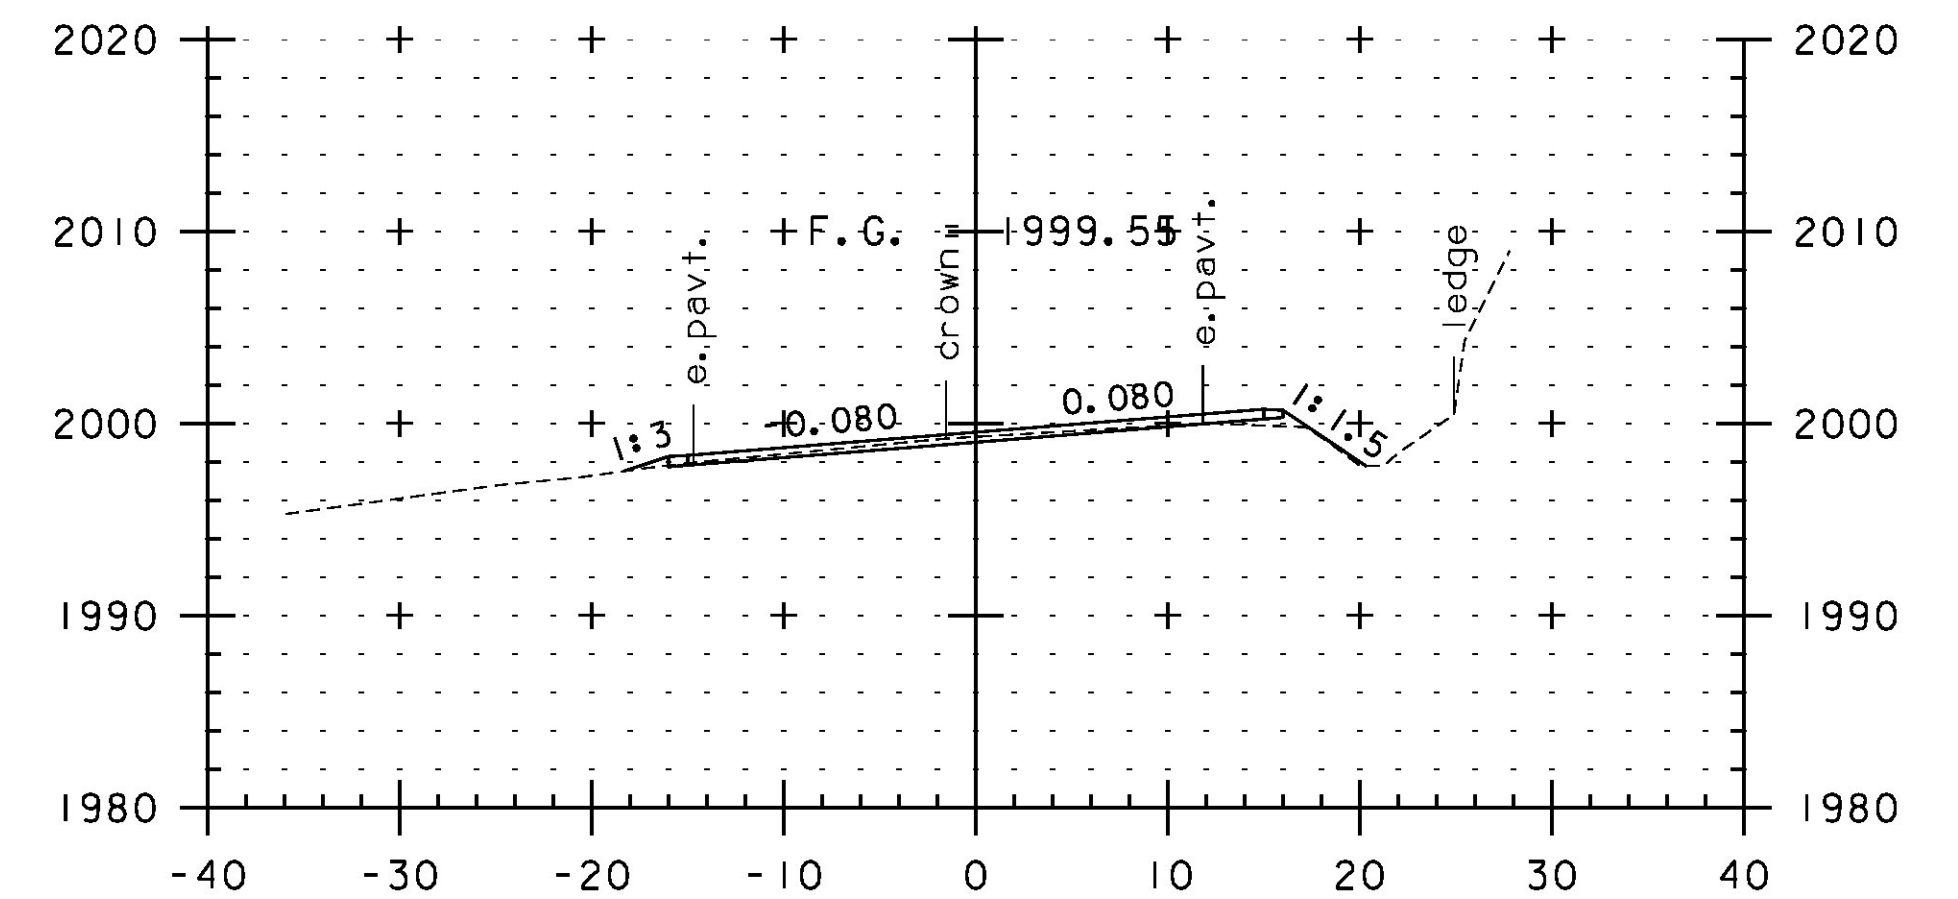

171+00

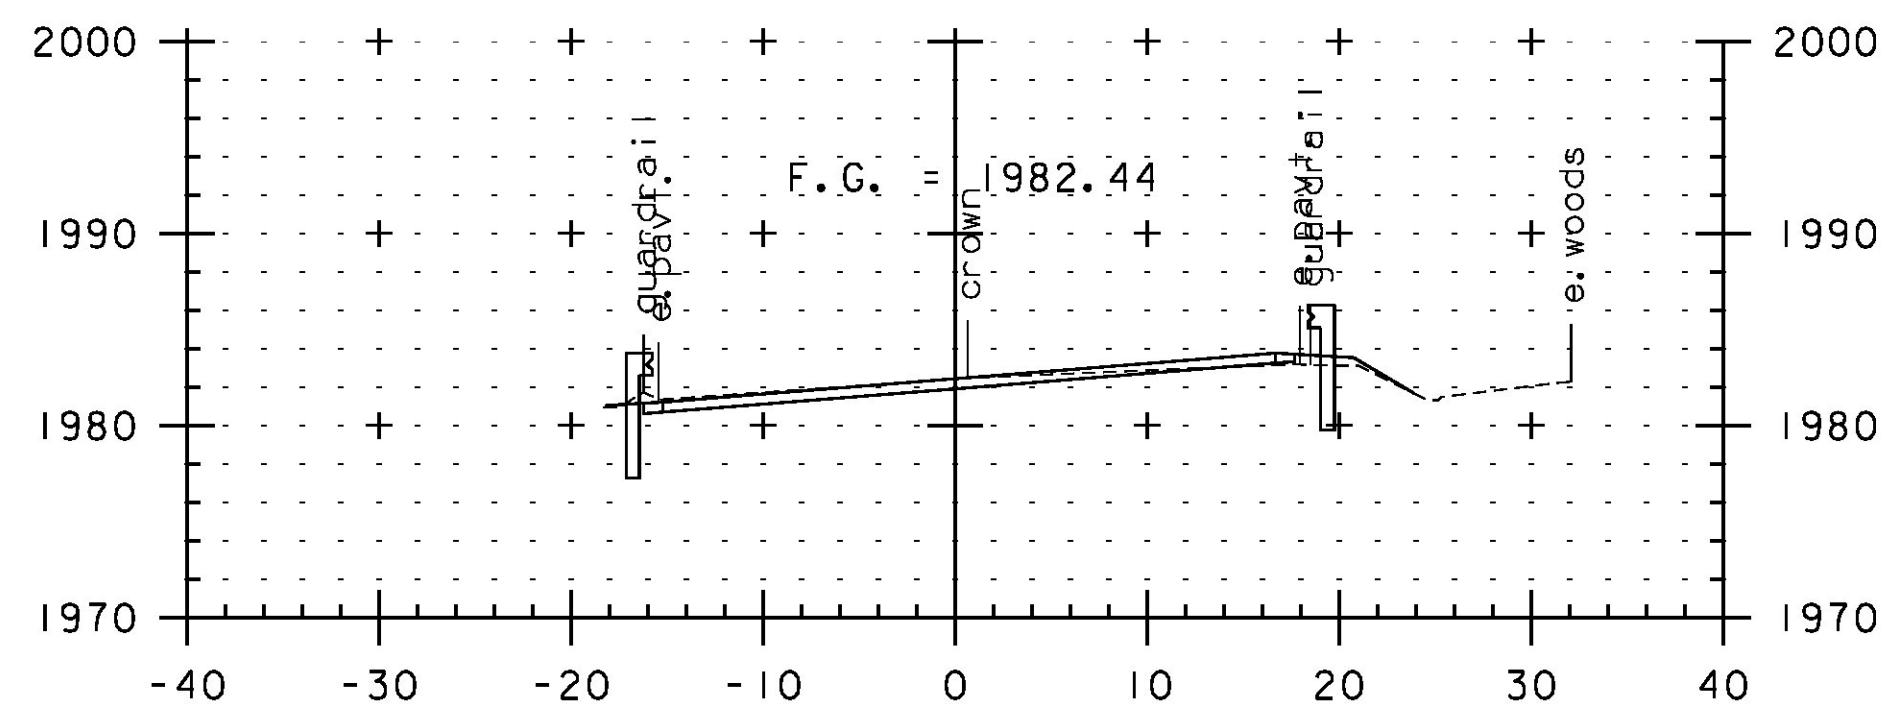

168+53

BEGIN BRIDGE 49 APPROACH



SCALE IN FEET

STA. 168+53 TO STA. 171+50

PROJECT NAME: JAY-TROY
PROJECT NUMBER: STP 2315(I)

FILE NAME: z10b232xs.dgn
PROJECT LEADER: P. SHEDD
DESIGNED BY: N. LEMAY
CROSS SECTION SHEET 33

PLOT DATE: 5/16/2014
DRAWN BY: W. GORDON
CHECKED BY: P. SHEDD
SHEET 169 OF 244