




173+00

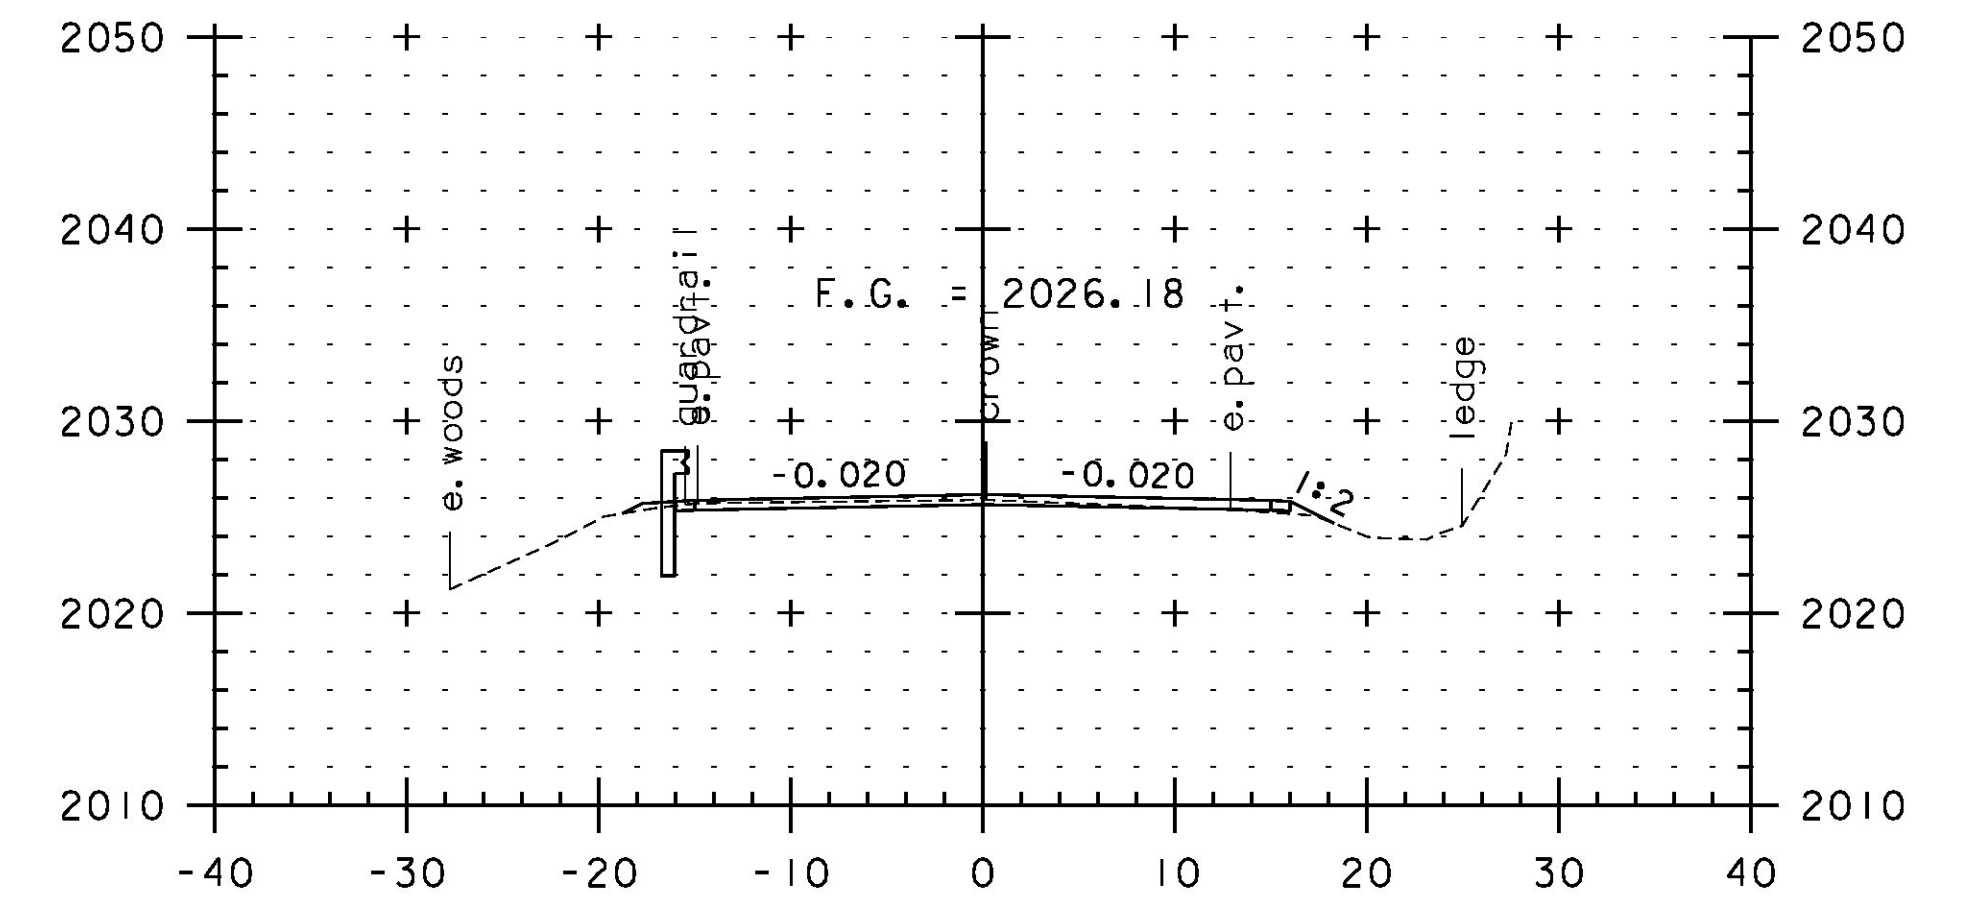


175+50

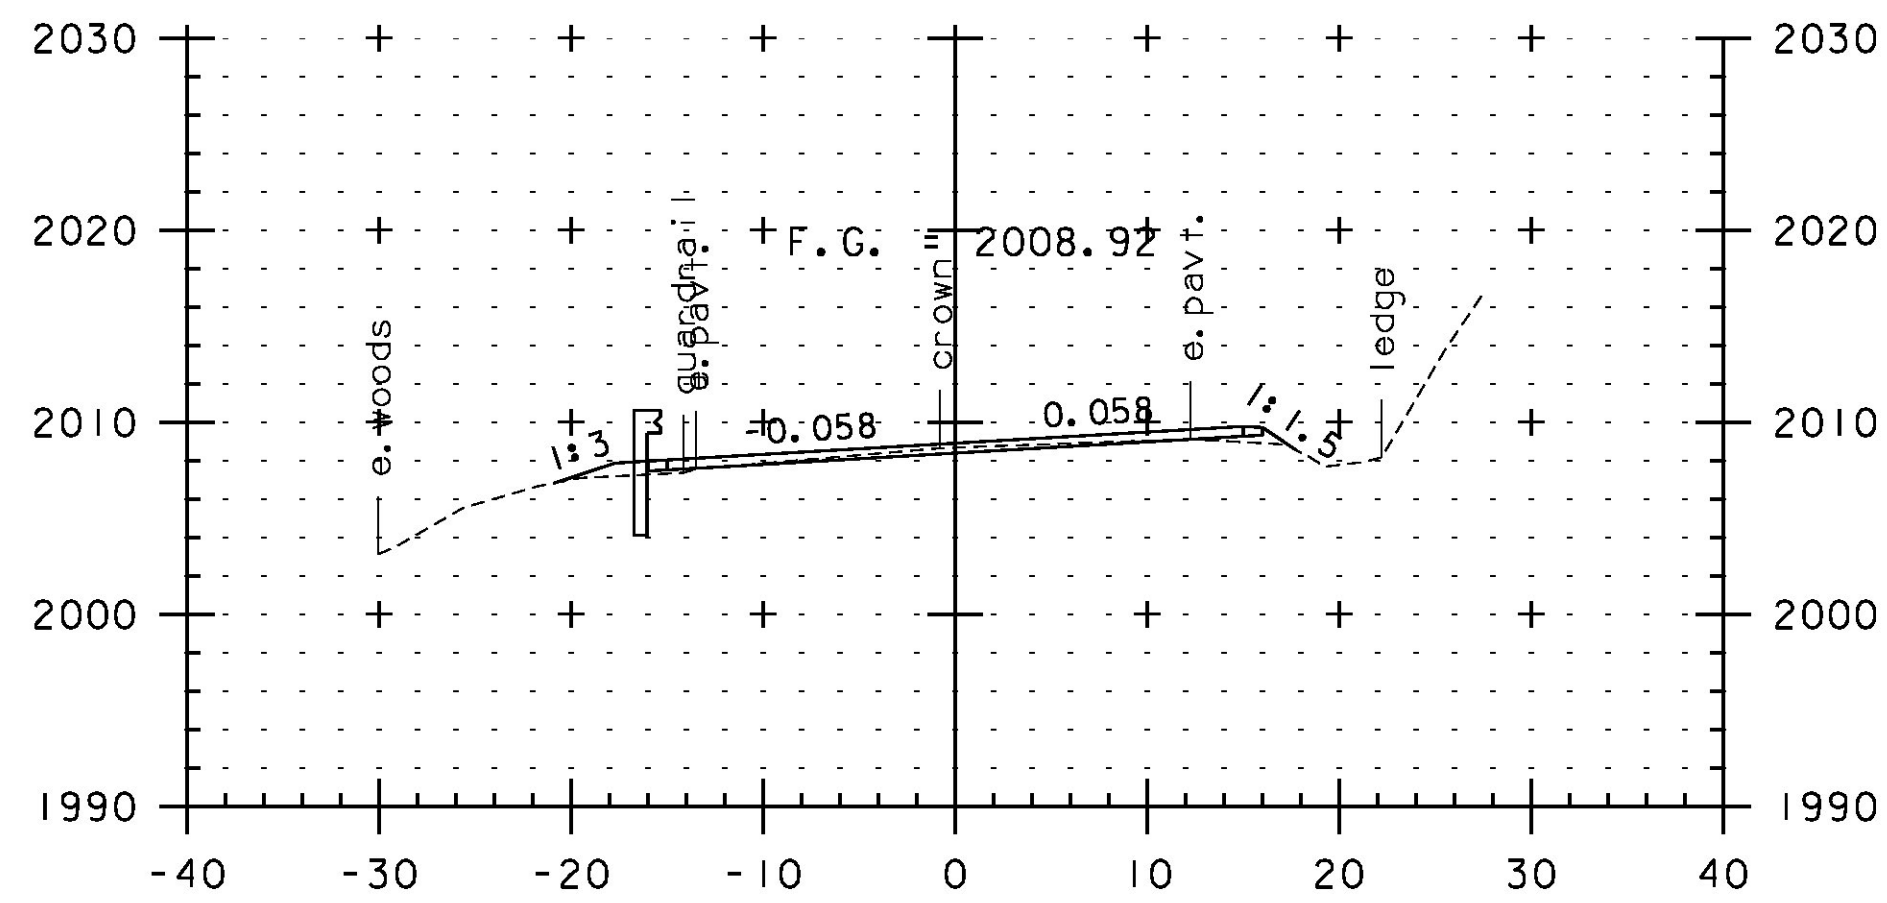


172+50

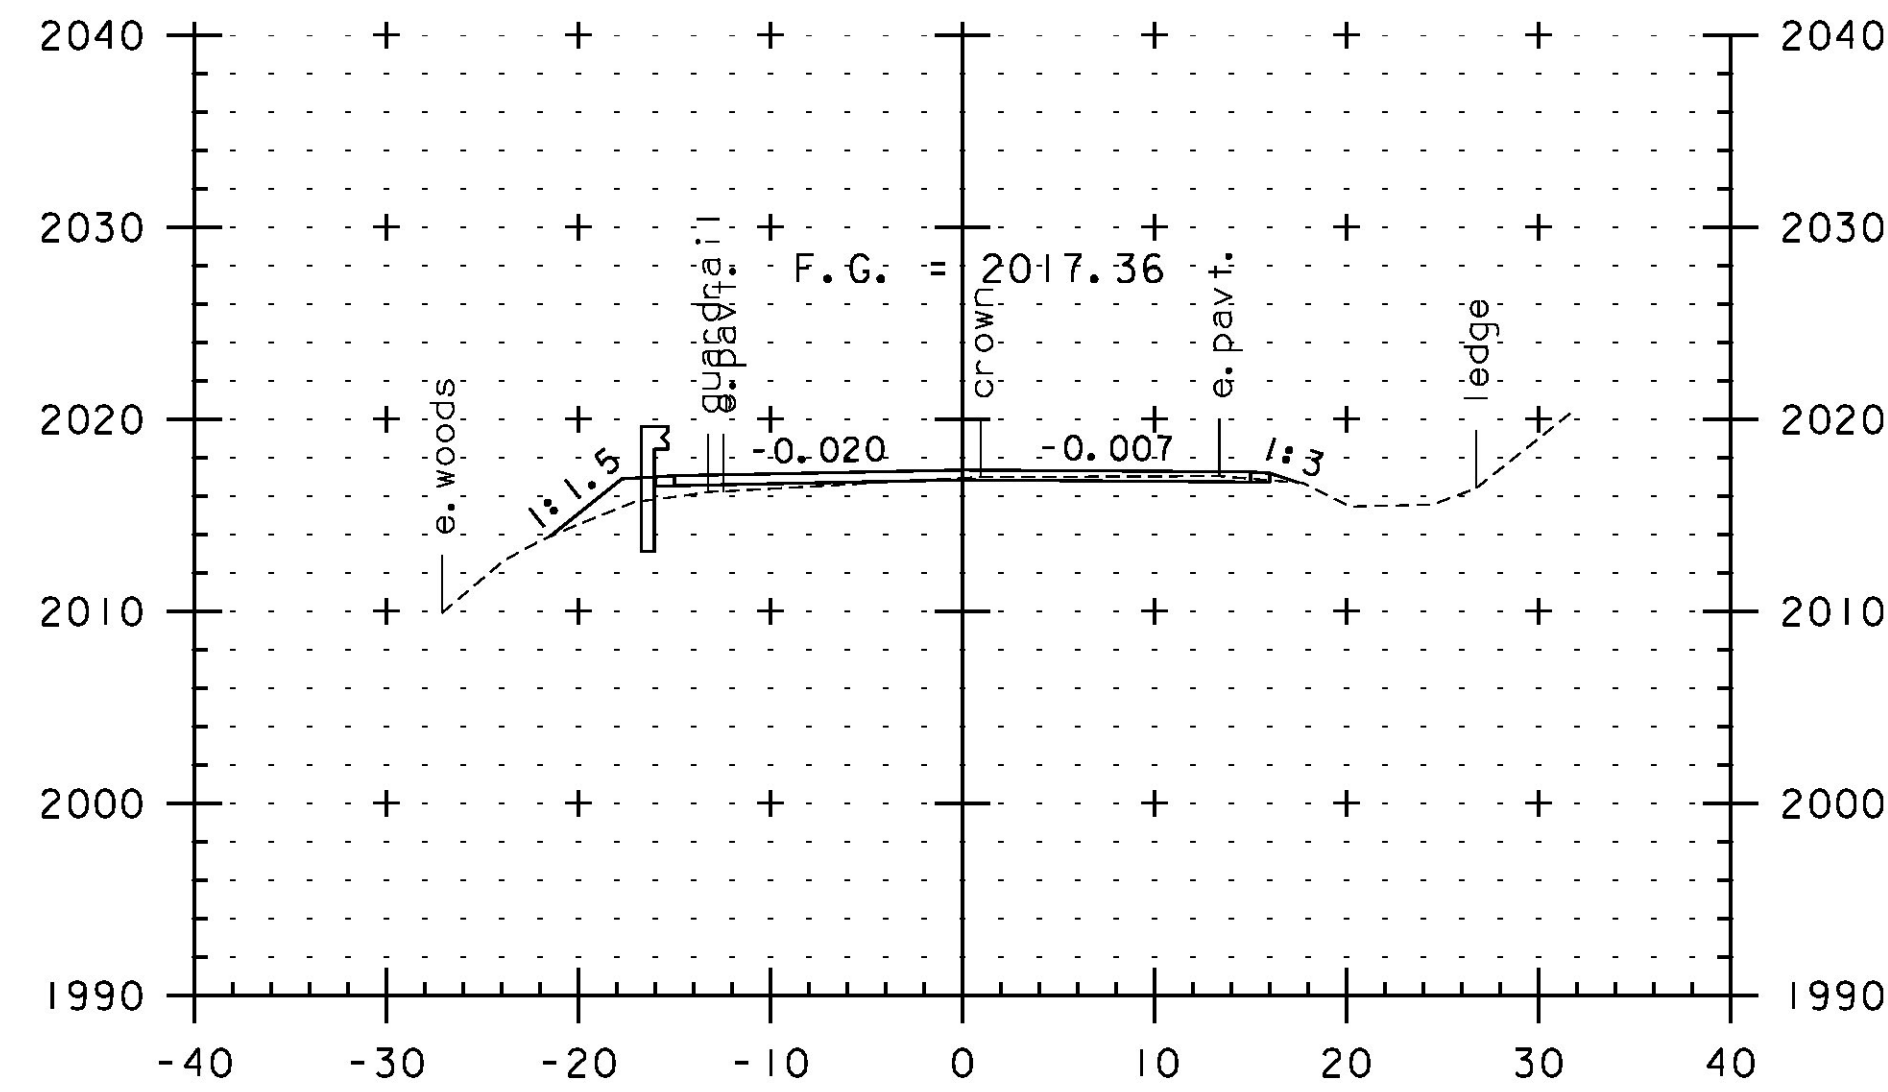


174+00

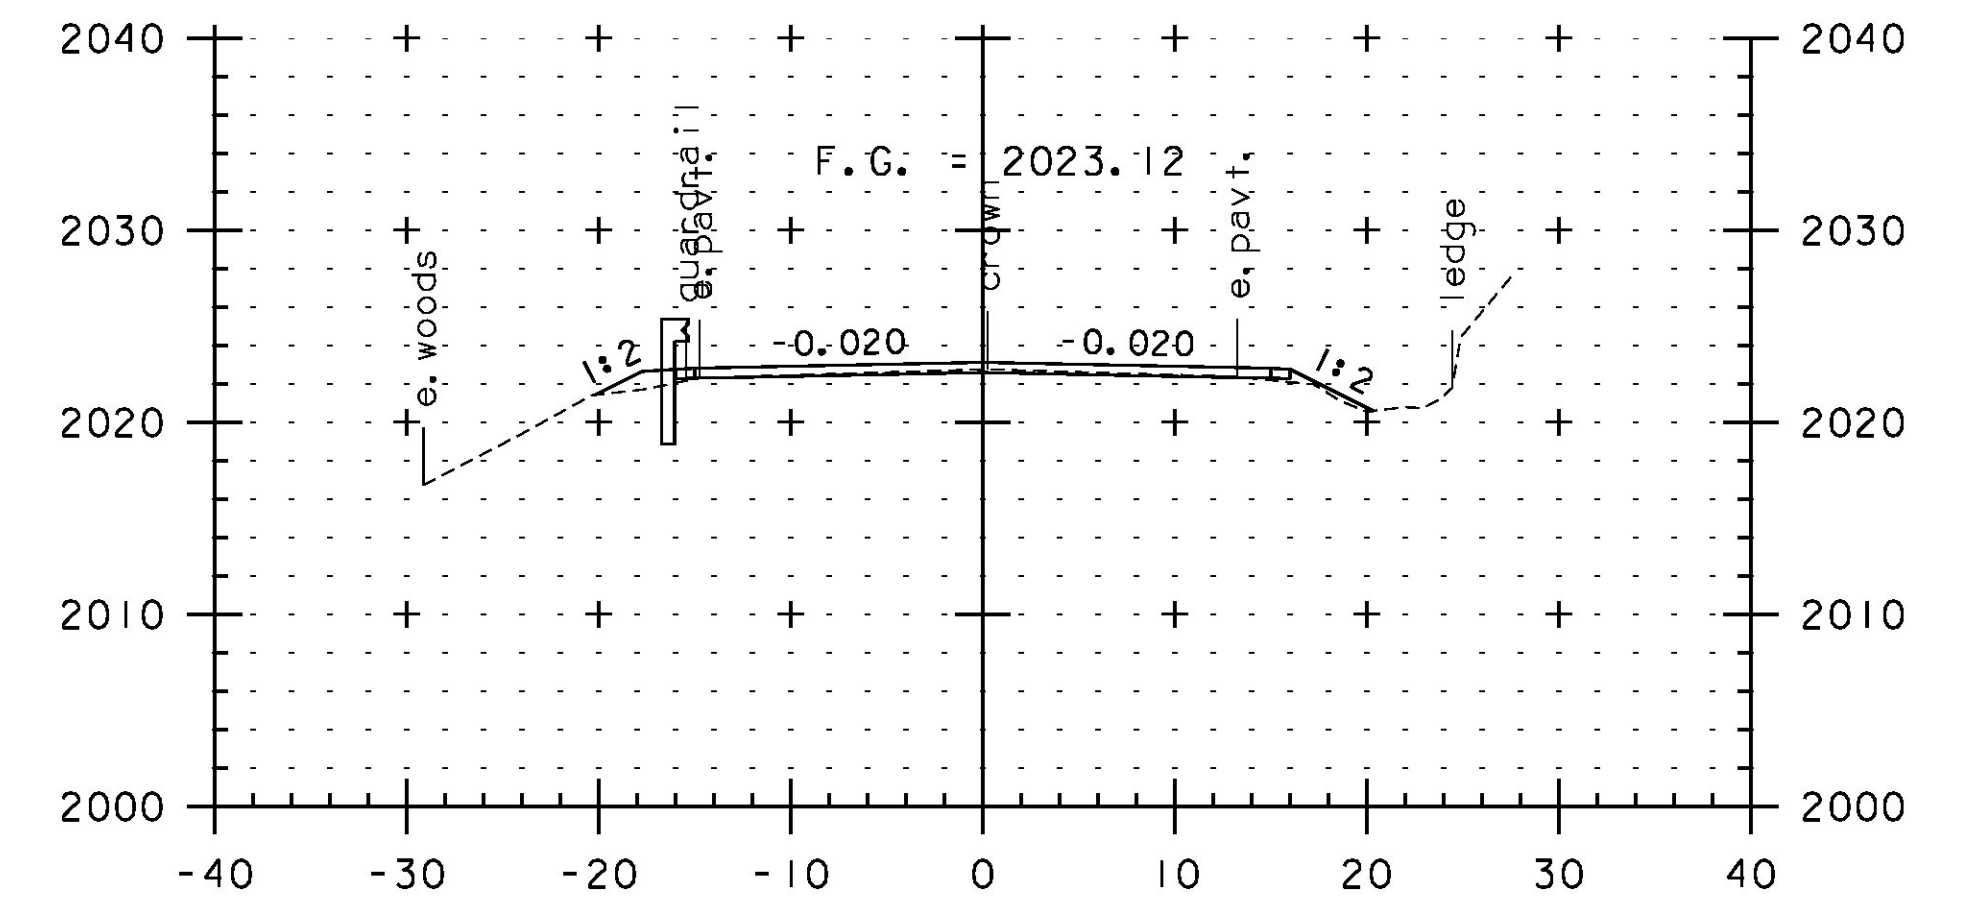


175+00

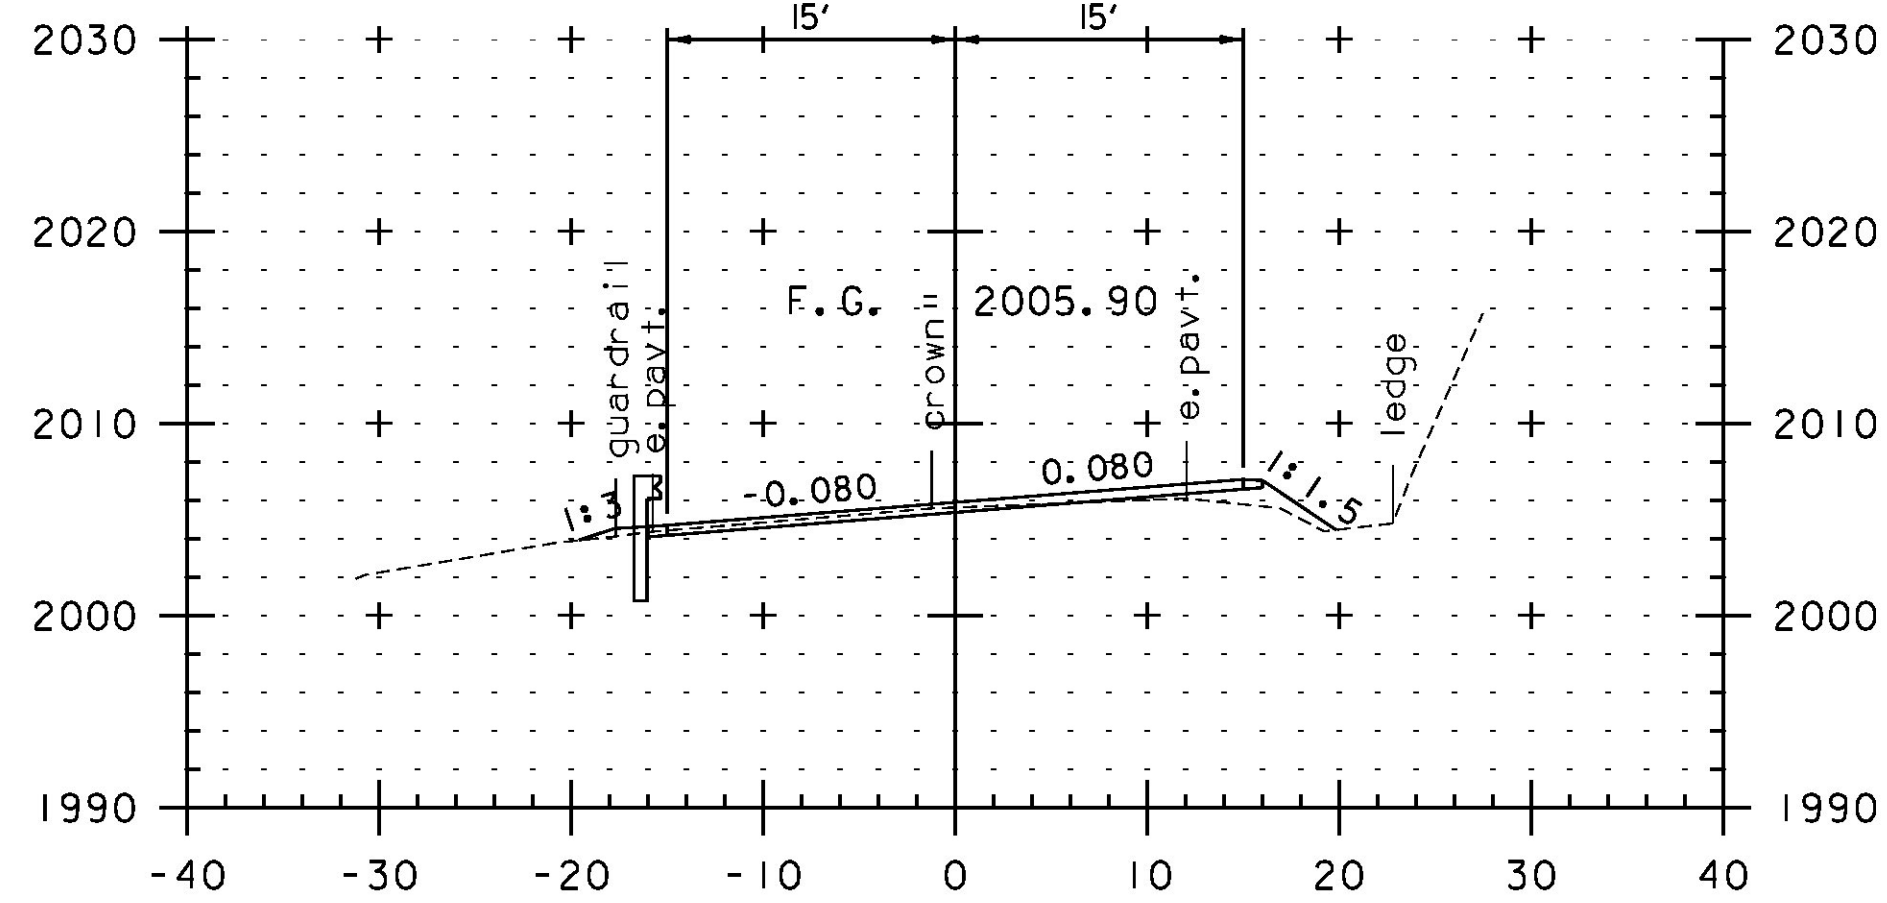


172+00

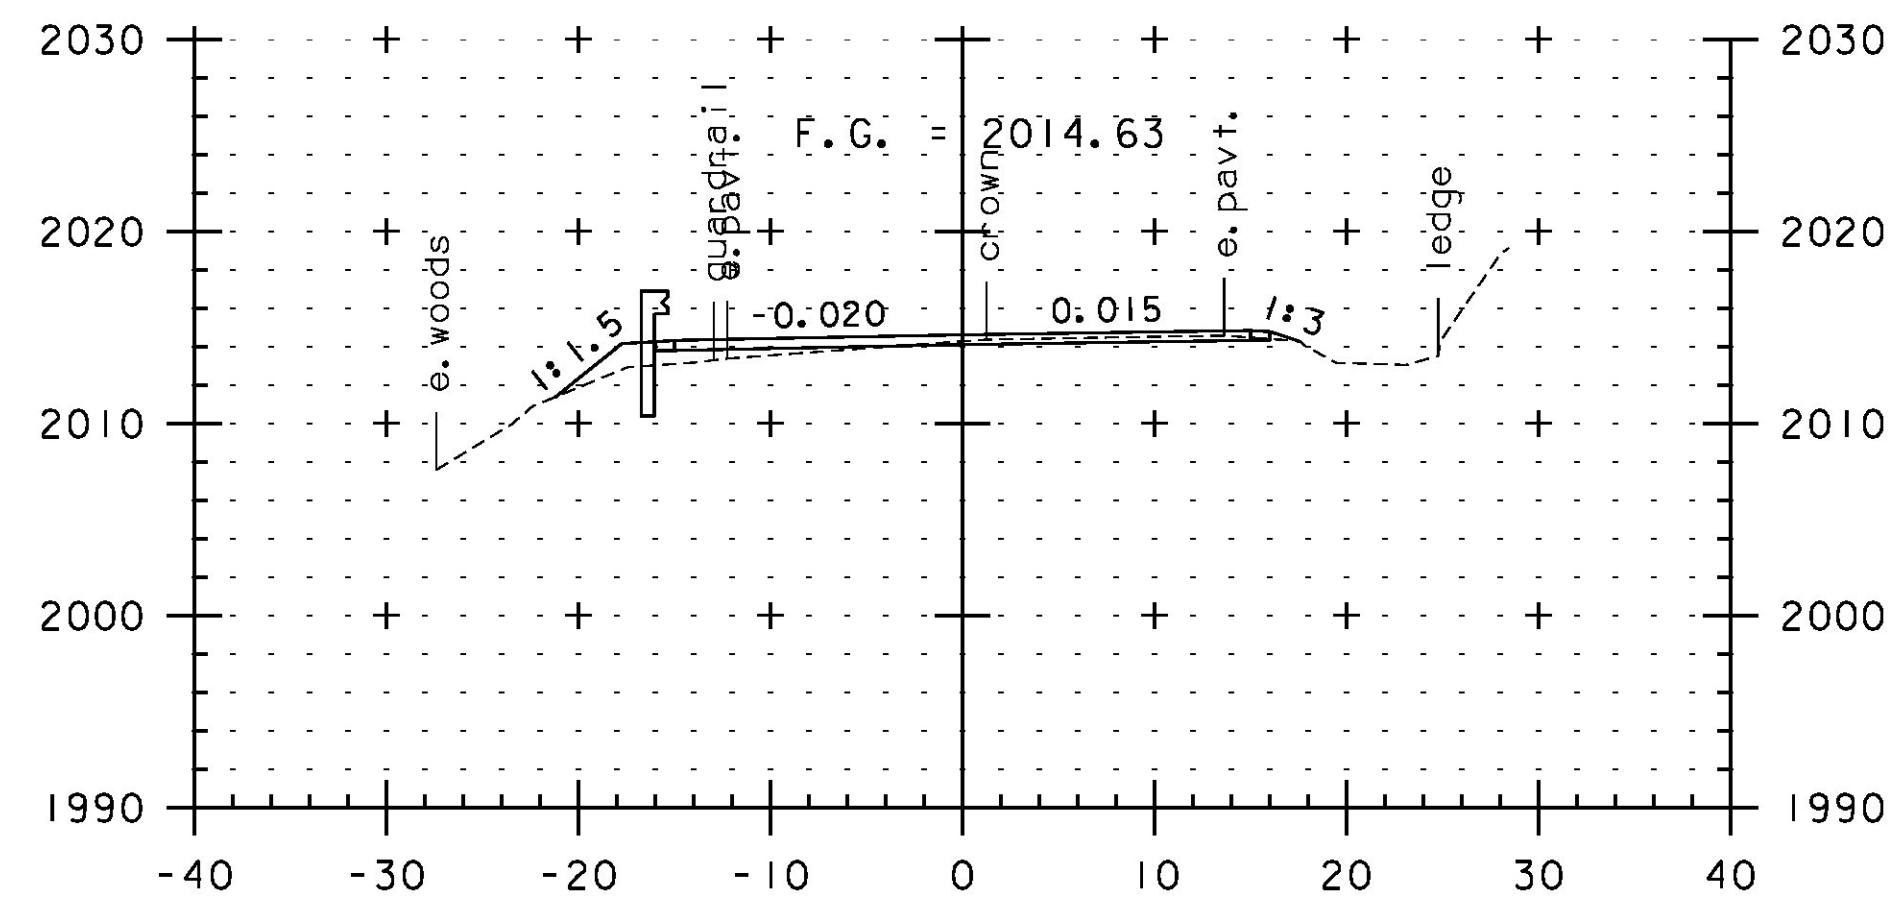

173+50

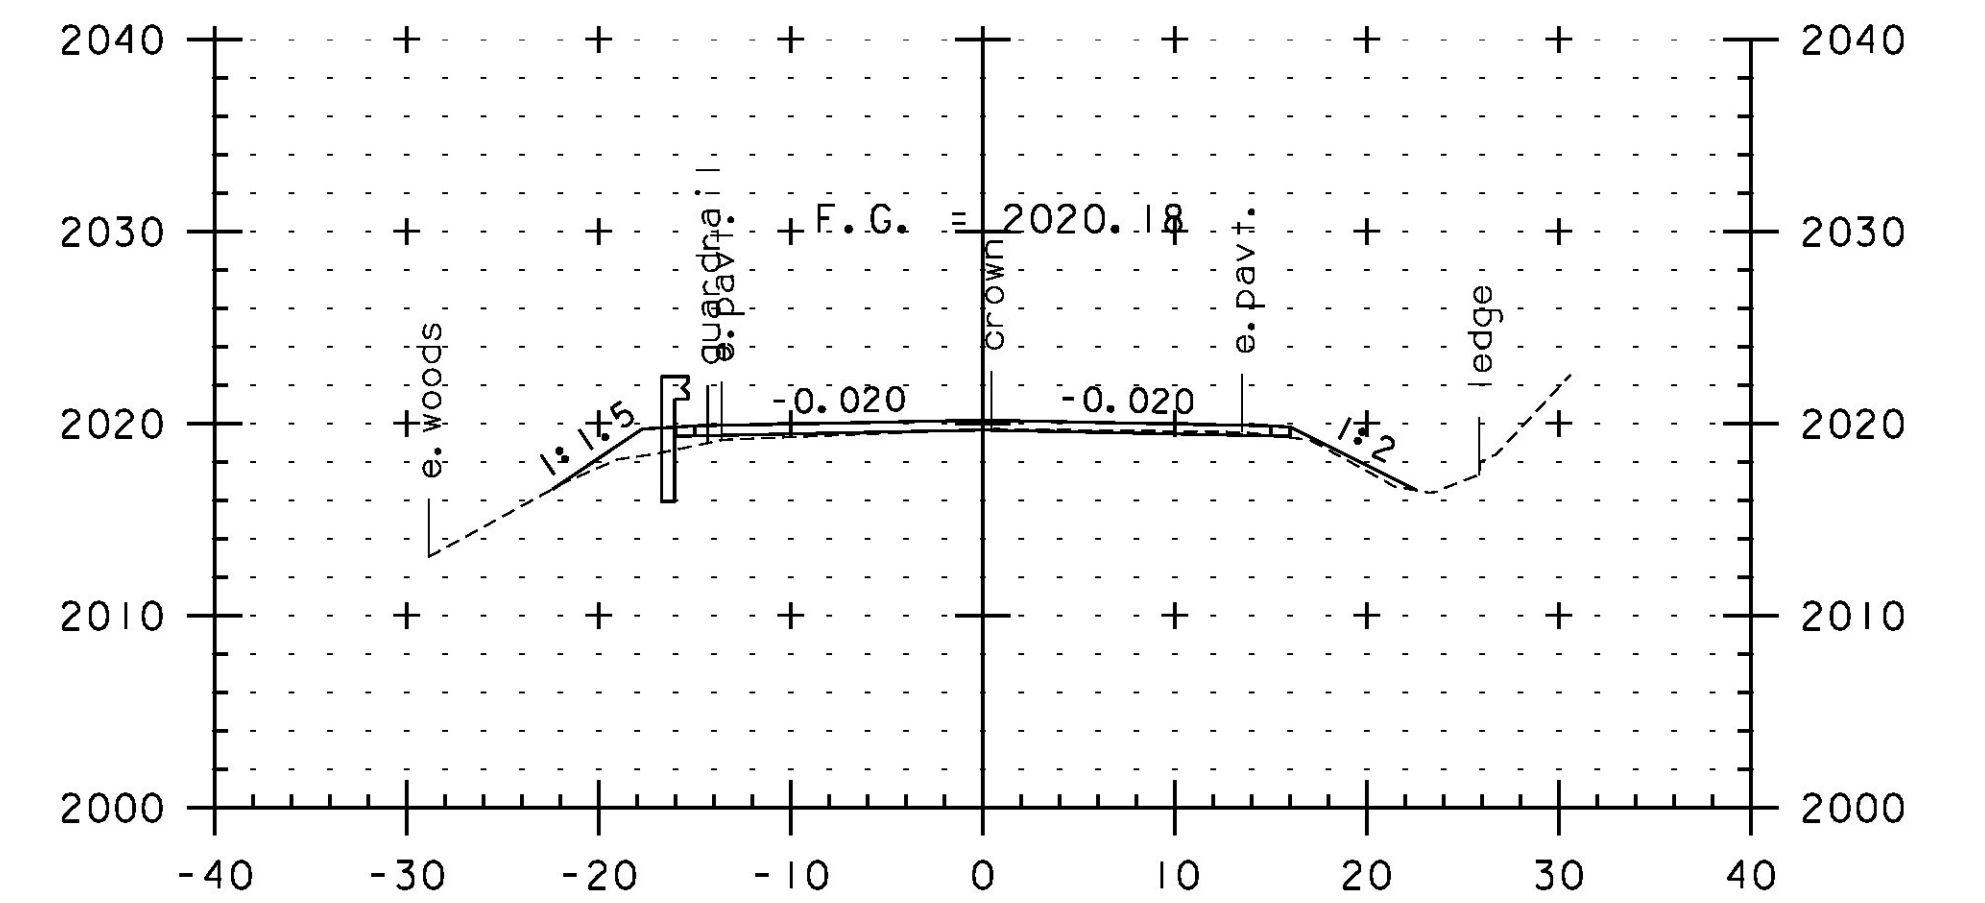

174+50

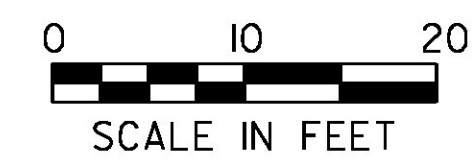

STA. 172+00 TO STA. 175+50

PROJECT NAME:	JAY-TROY	PLOT DATE:	5/16/2014
PROJECT NUMBER:	STP 2315(1)	DRAWN BY:	W. GORDON
FILE NAME:	z10b232xs.dgn	DESIGNED BY:	N. LEMAY
PROJECT LEADER:	P. SHEDD	CHECKED BY:	P. SHEDD
CROSS SECTION SHEET 34		SHEET	170 OF 244