




176+50

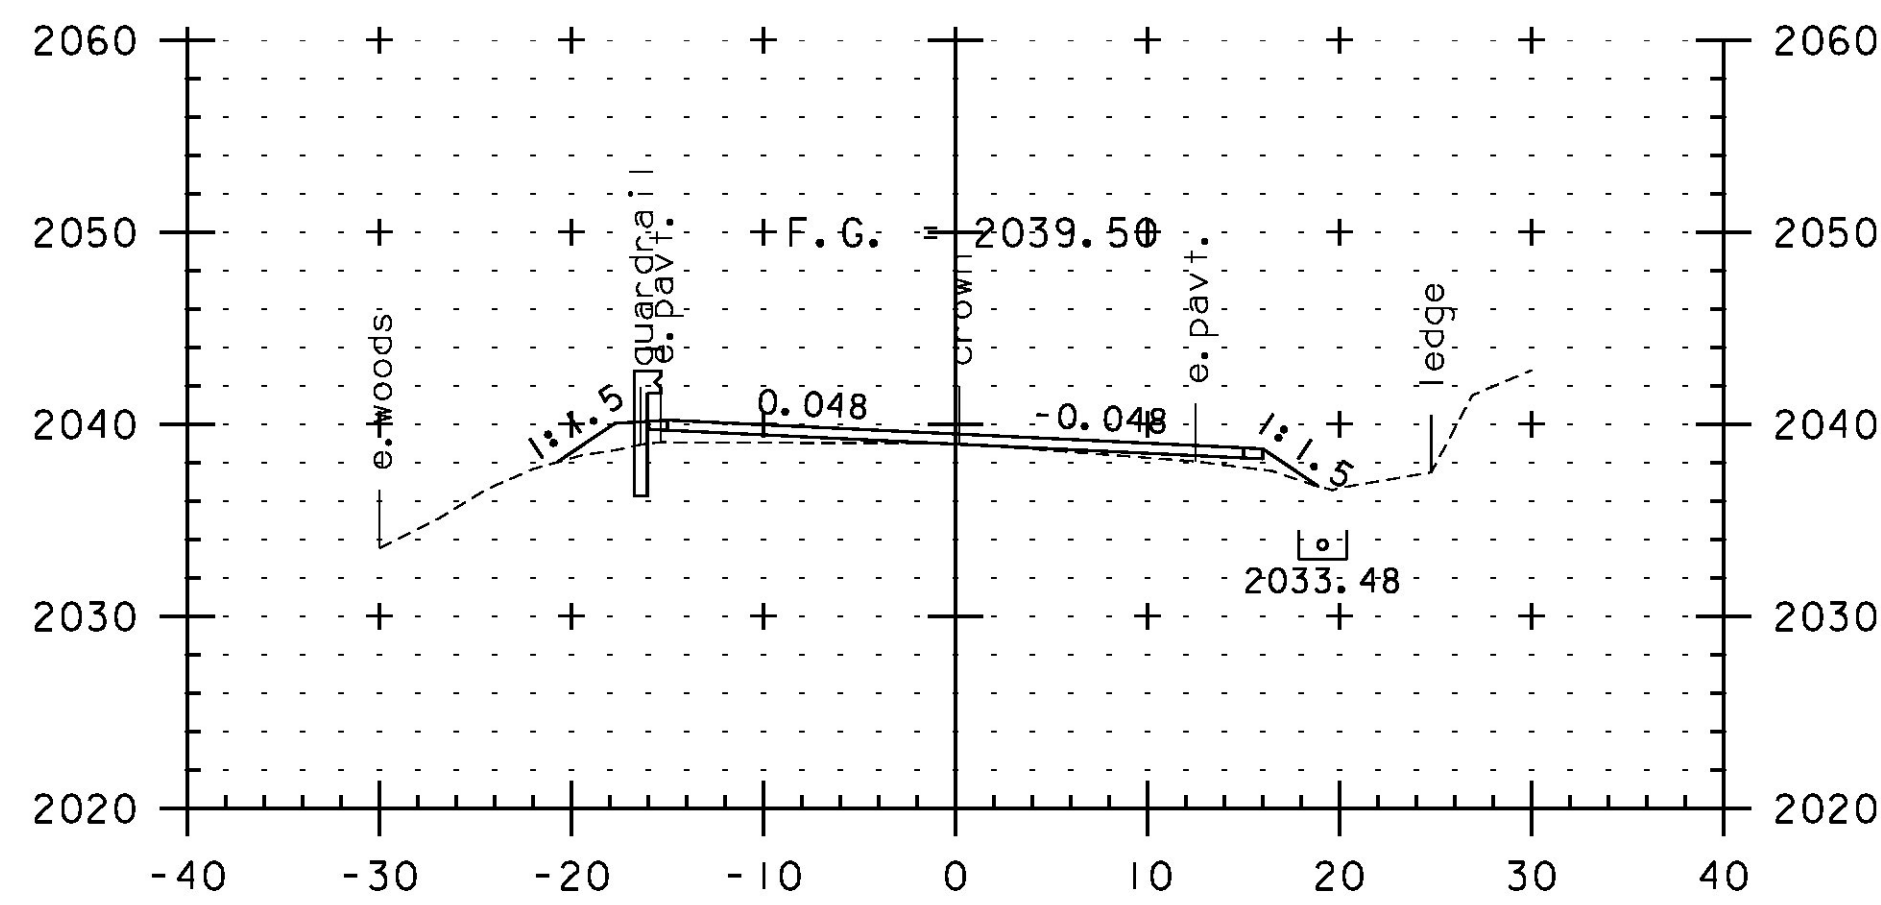


177+50

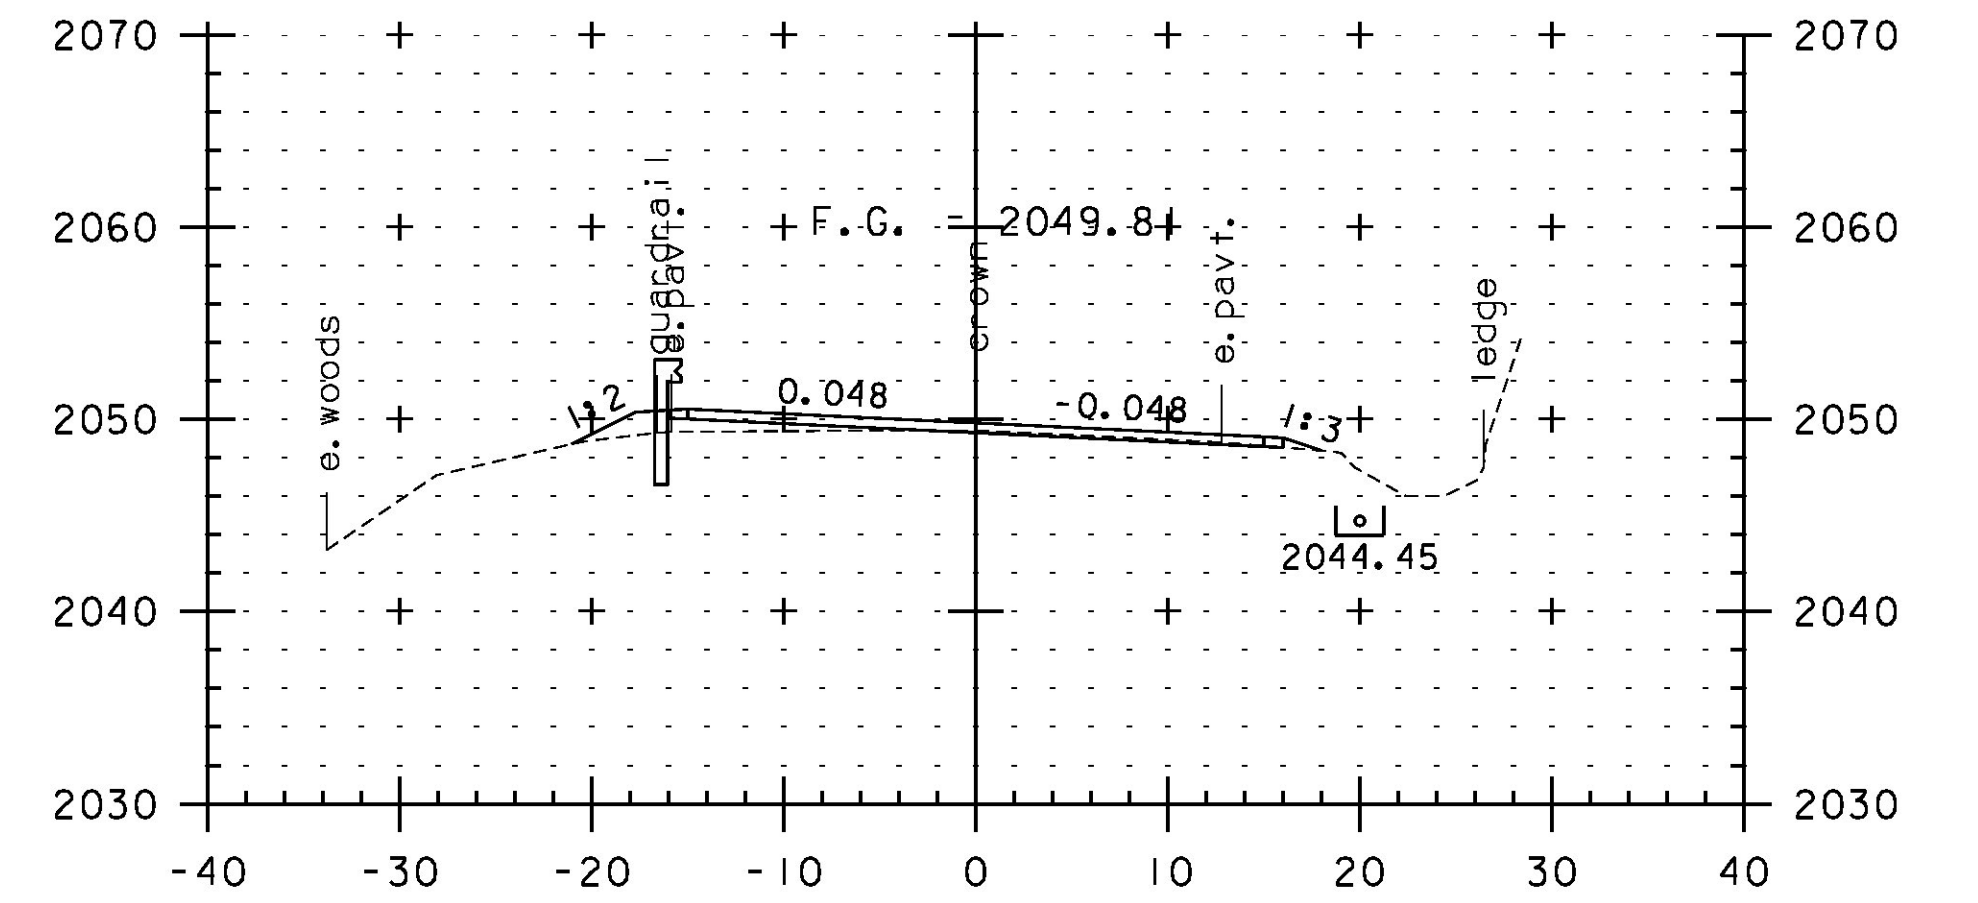


179+00

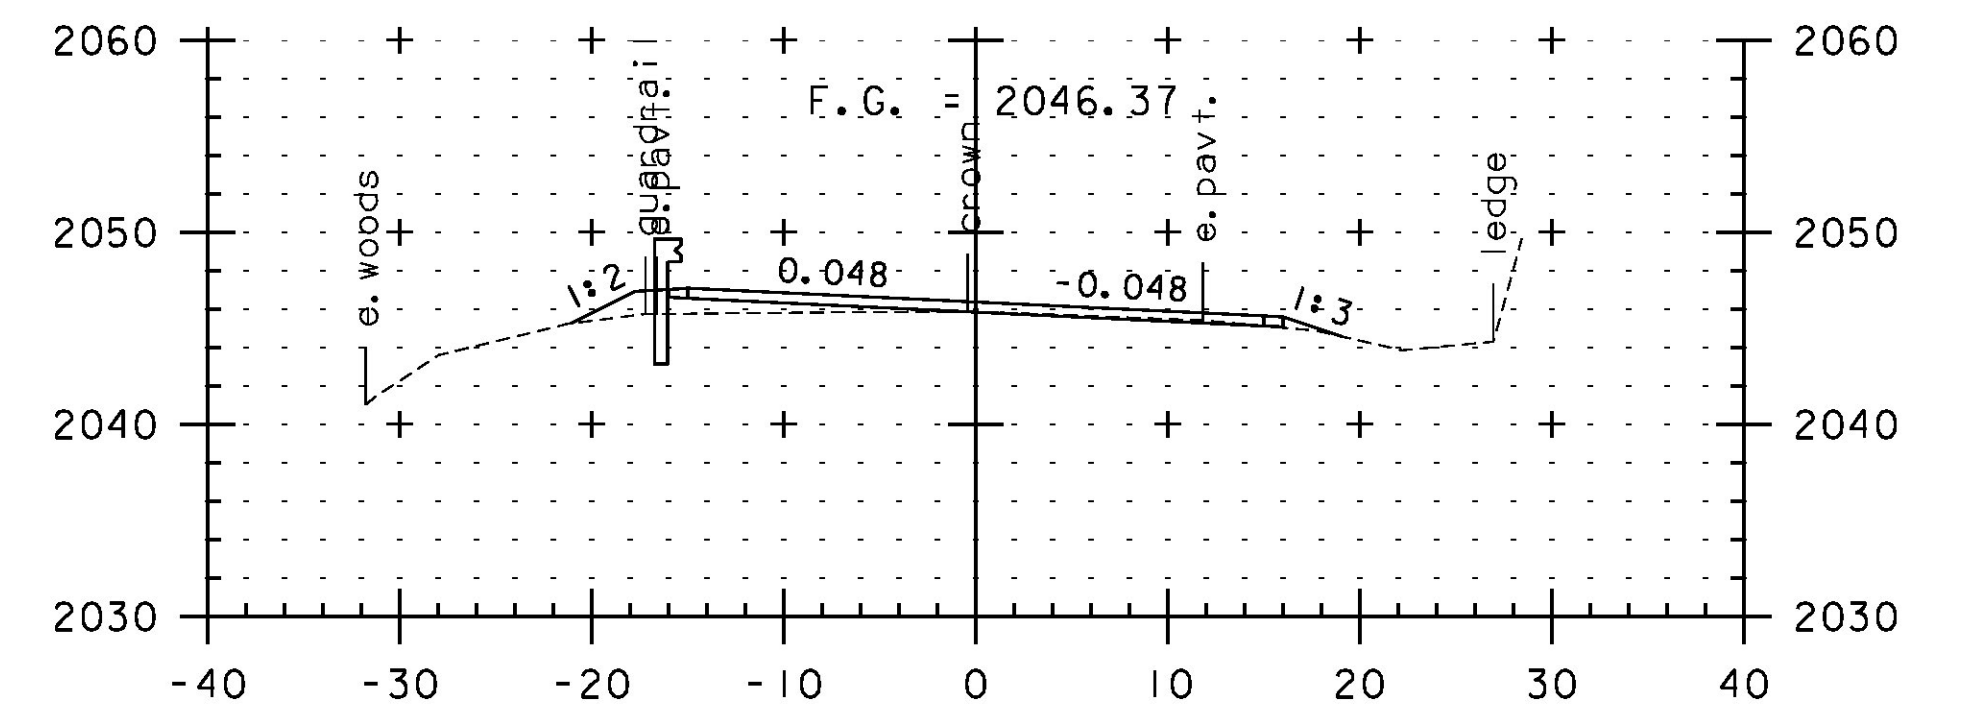


178+50

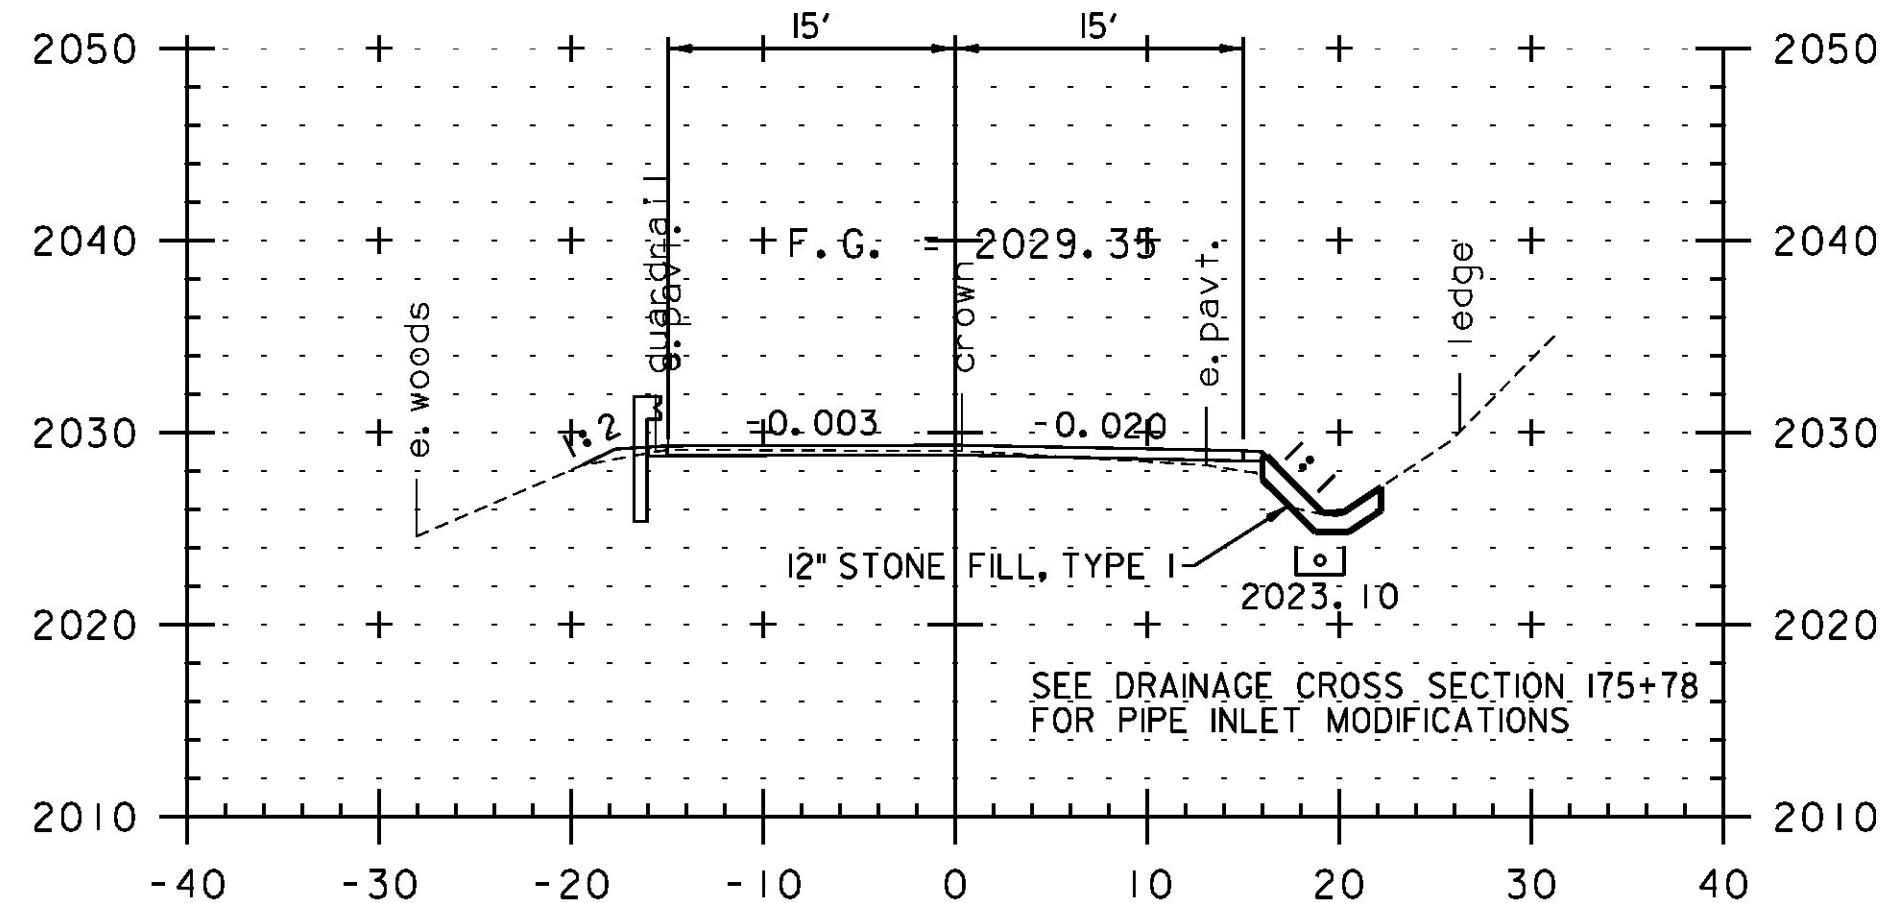


176+00

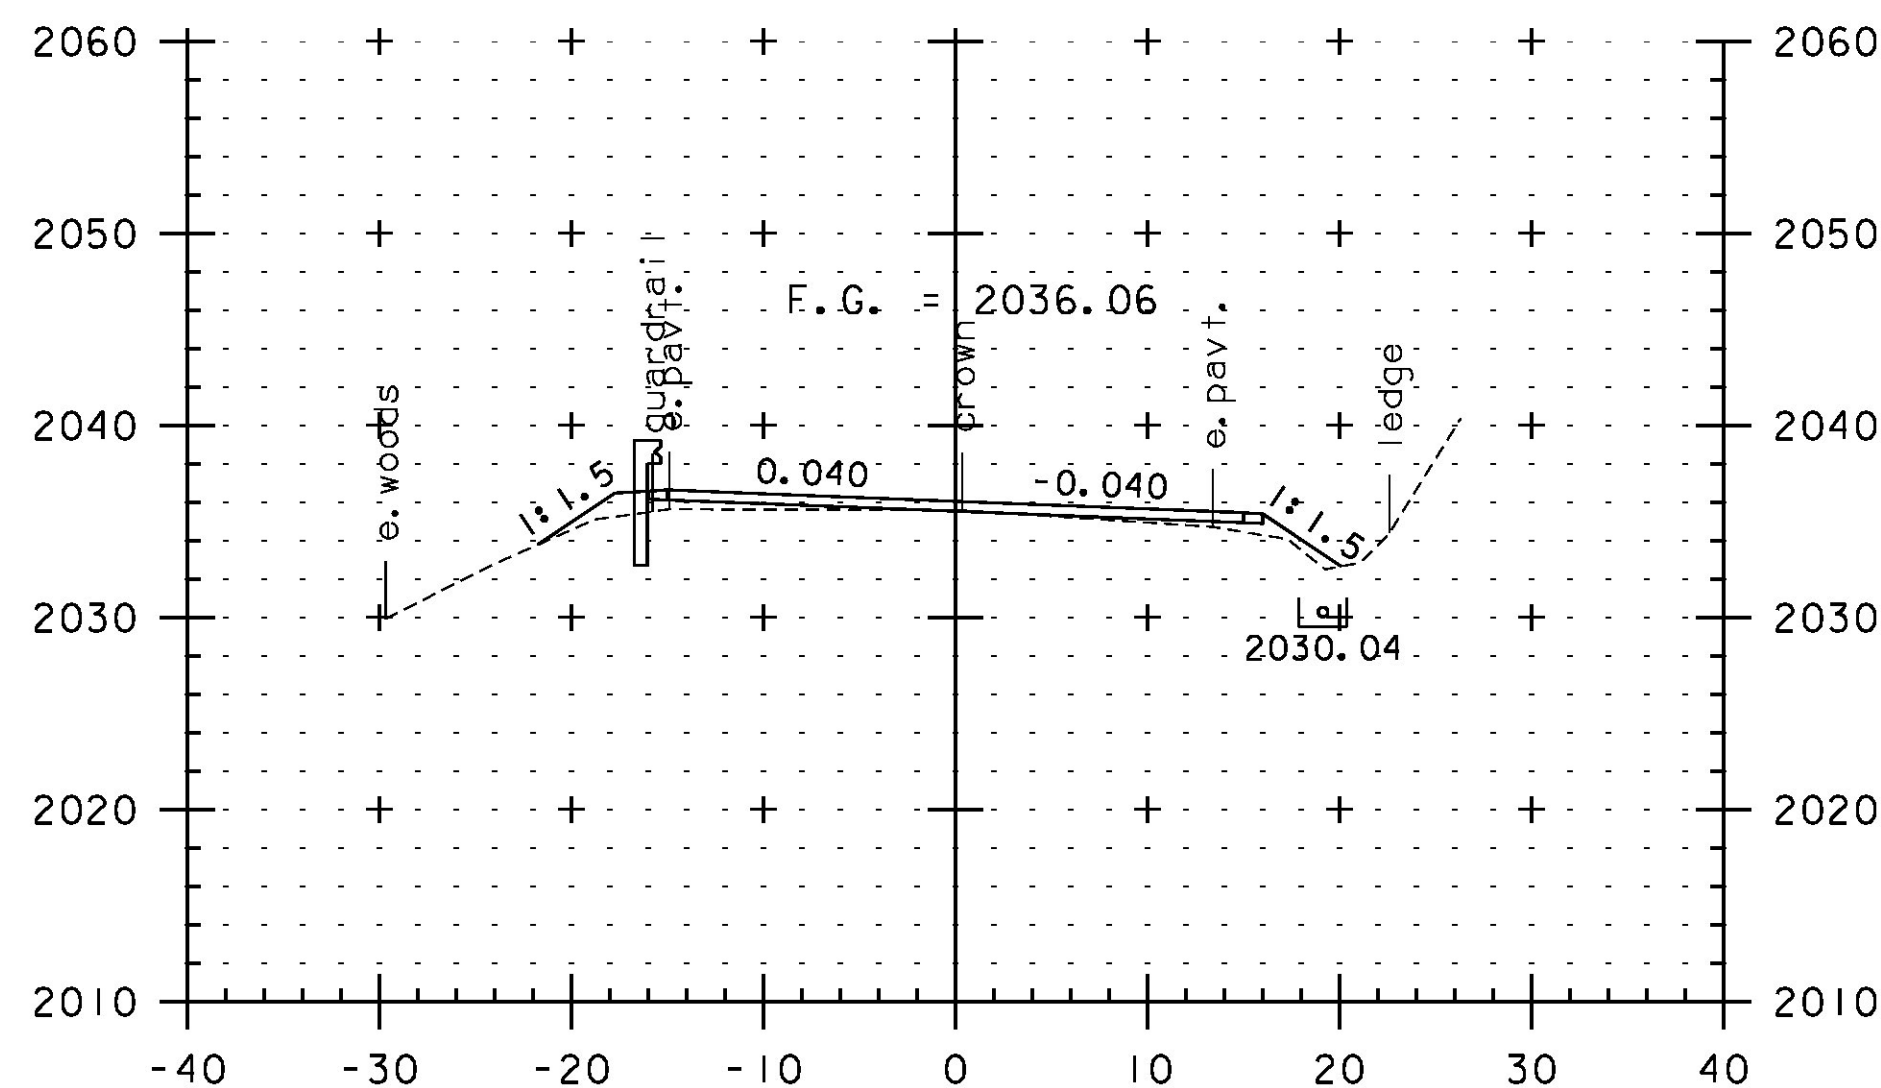

177+00

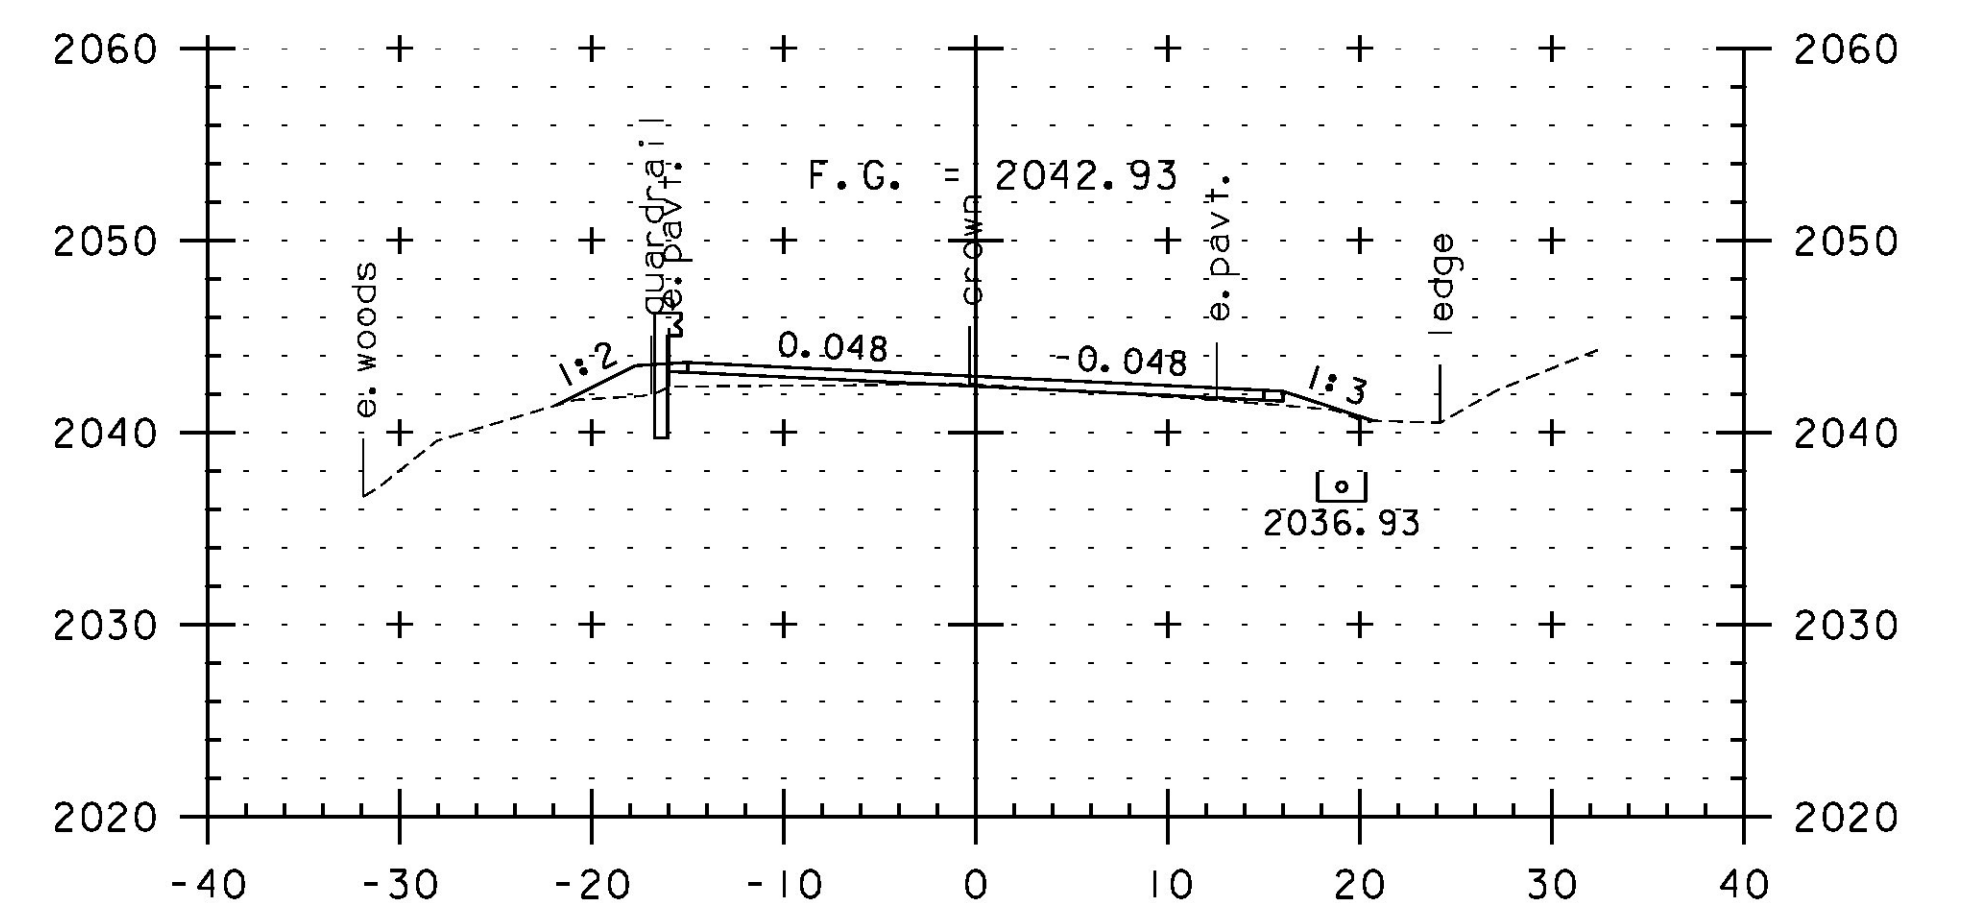

178+00

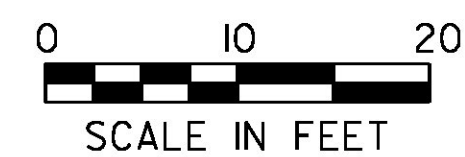

SCALE IN FEET

STA. 176+00 TO STA. 179+00

PROJECT NAME:	JAY-TROY	PLOT DATE:	5/16/2014
PROJECT NUMBER:	STP 2315(I)	DRAWN BY:	W. GORDON
FILE NAME:	z10b232xs.dgn	CHECKED BY:	P. SHEDD
PROJECT LEADER:	P. SHEDD	CROSS SECTION SHEET	35
DESIGNED BY:	N. LEMAY	SHEET	171 OF 244