




185+00

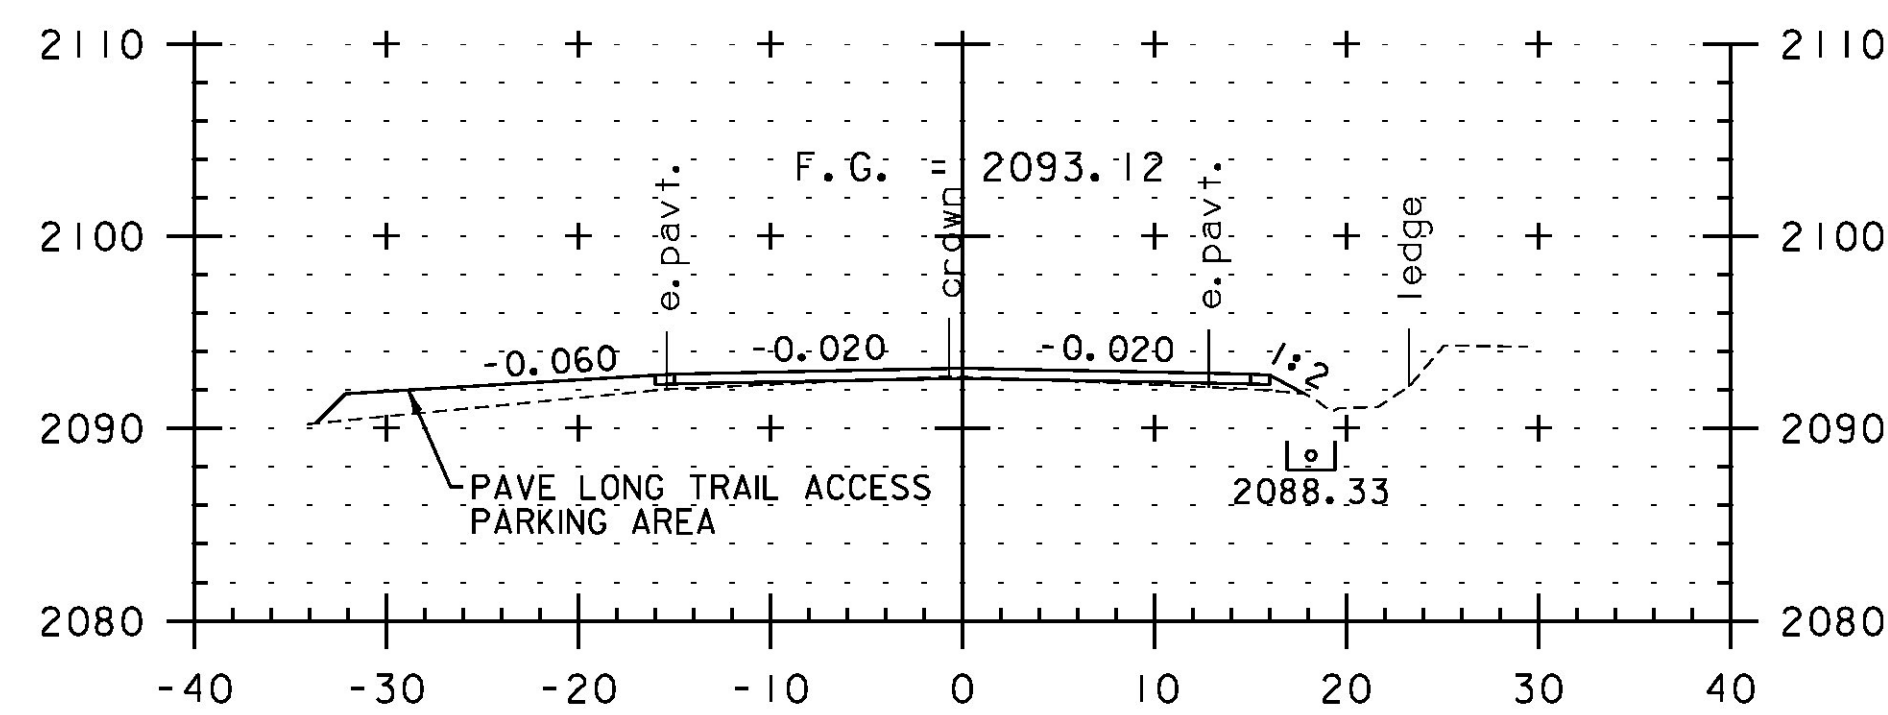


186+50

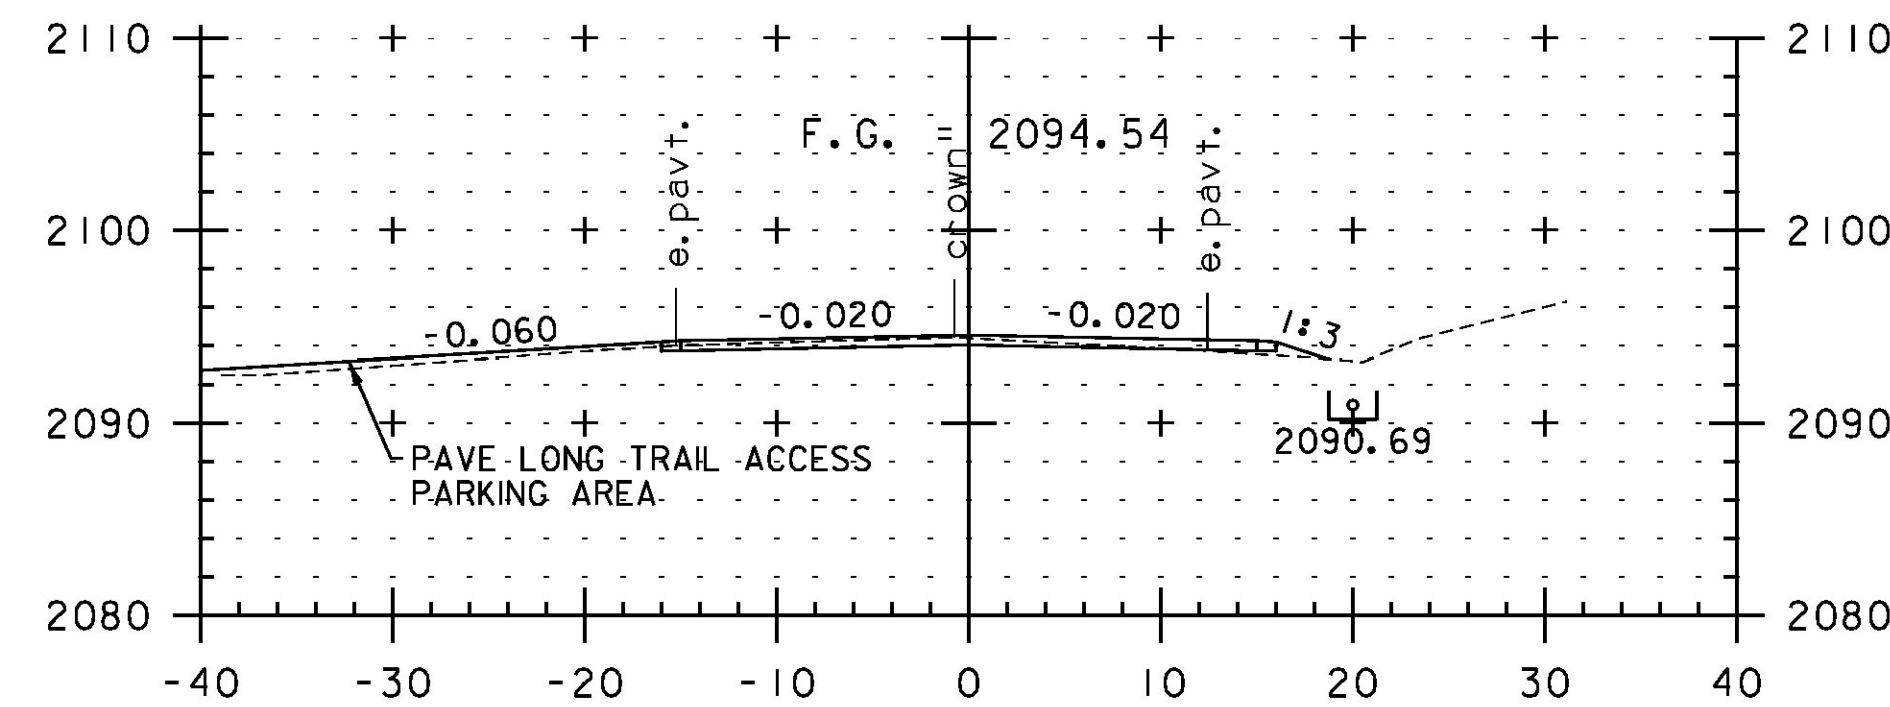


188+00

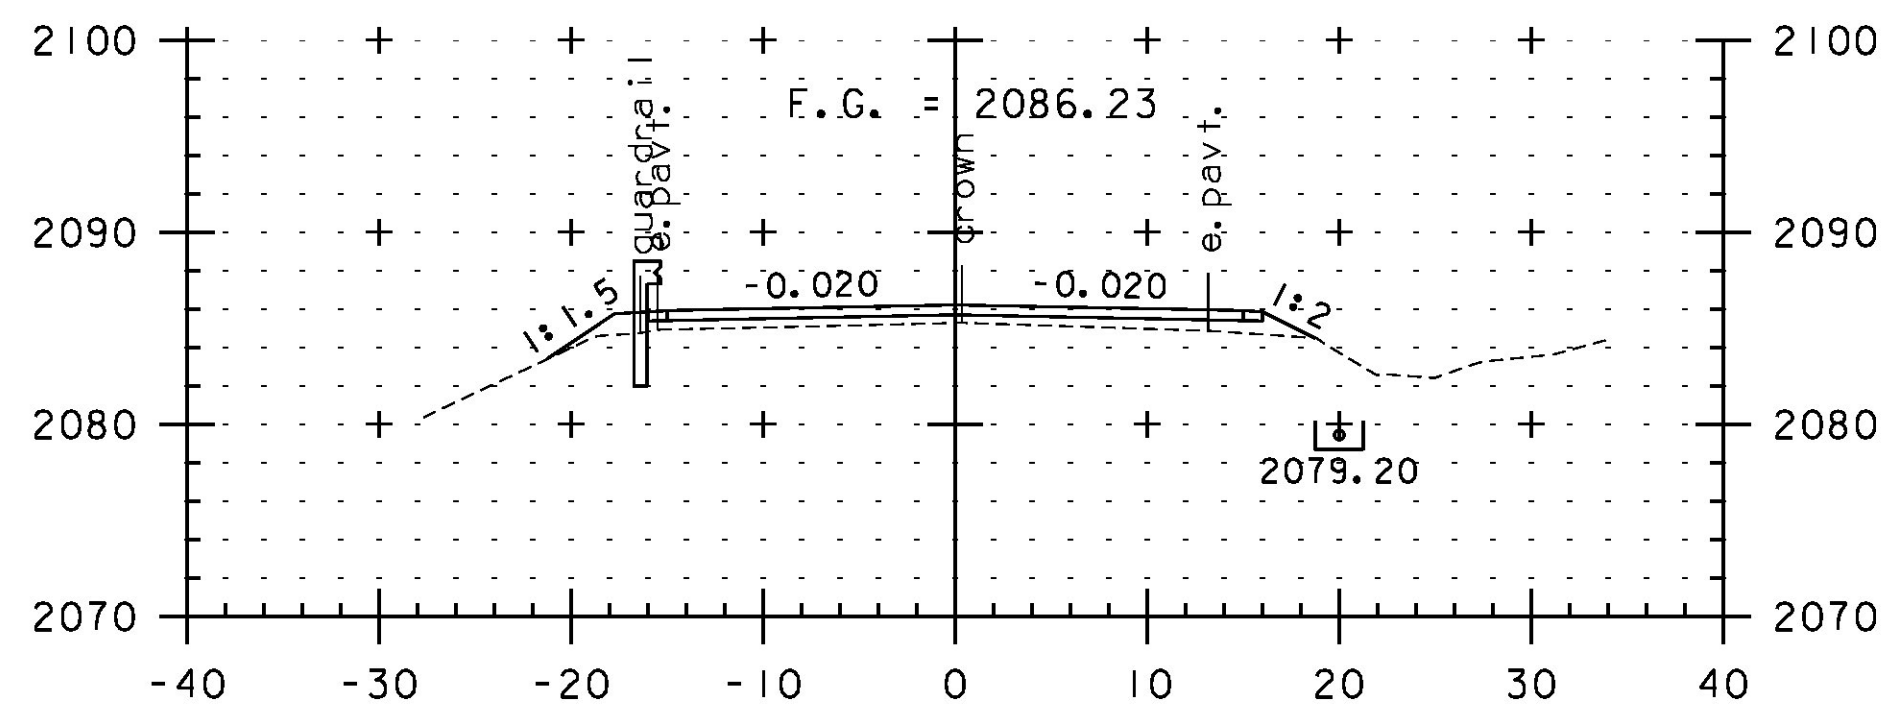


184+50

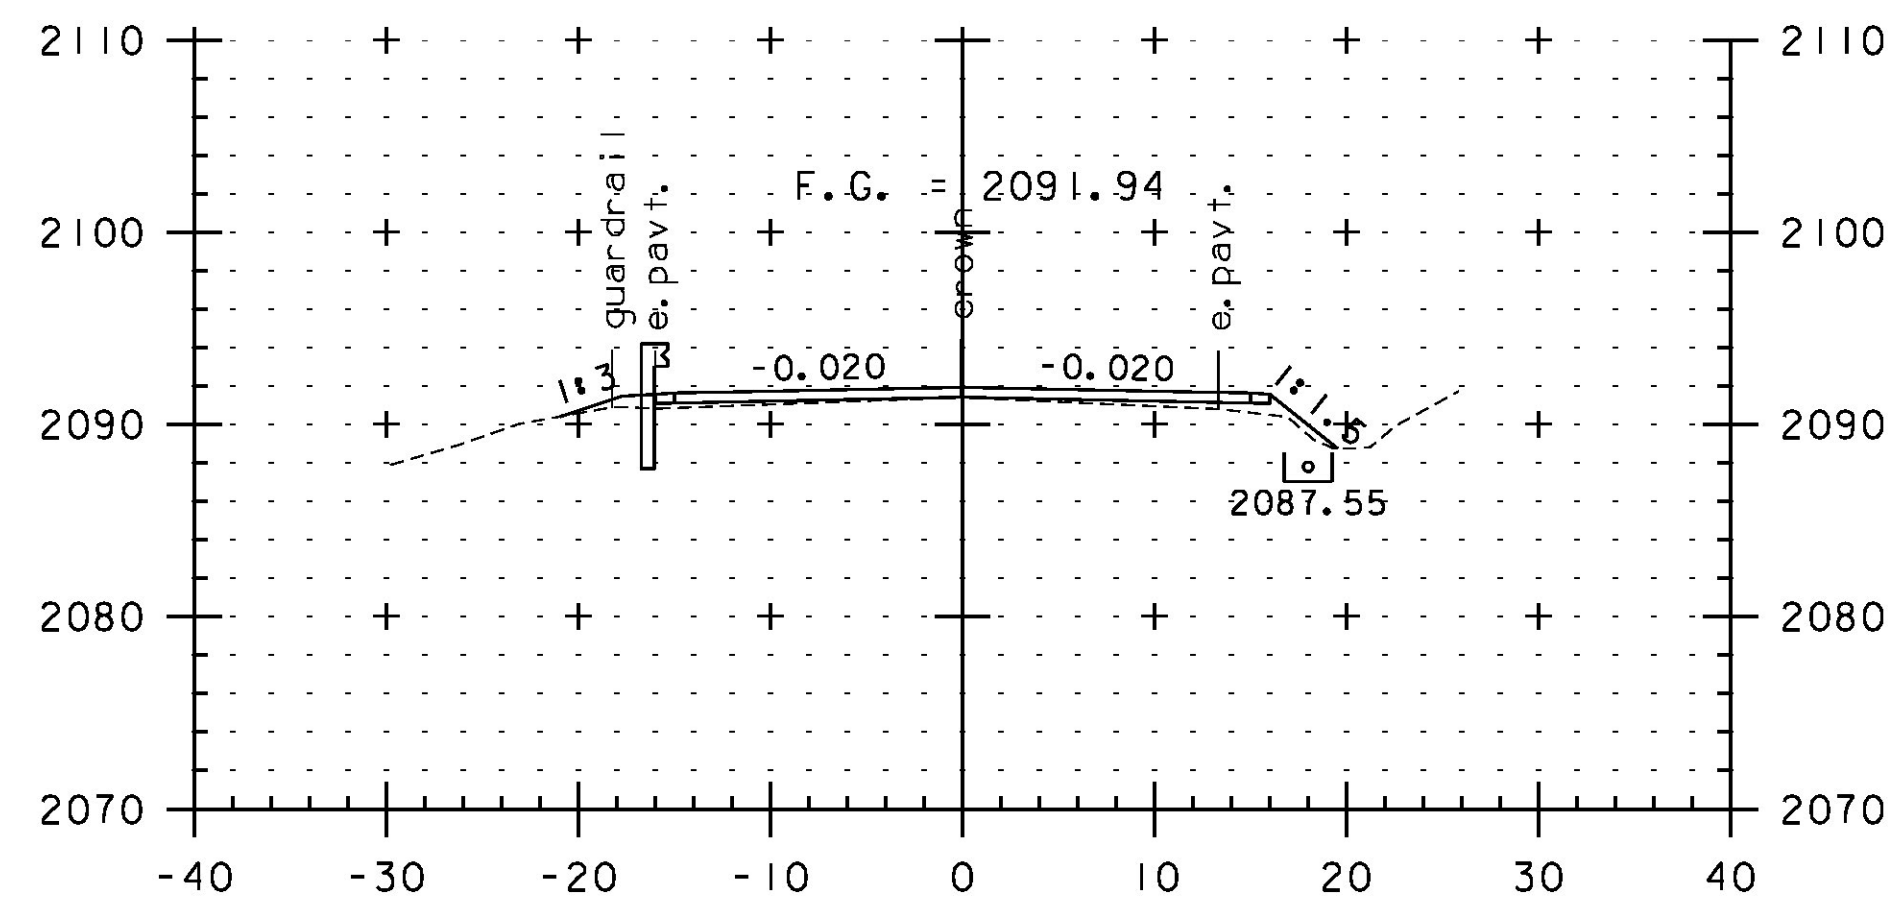


186+00

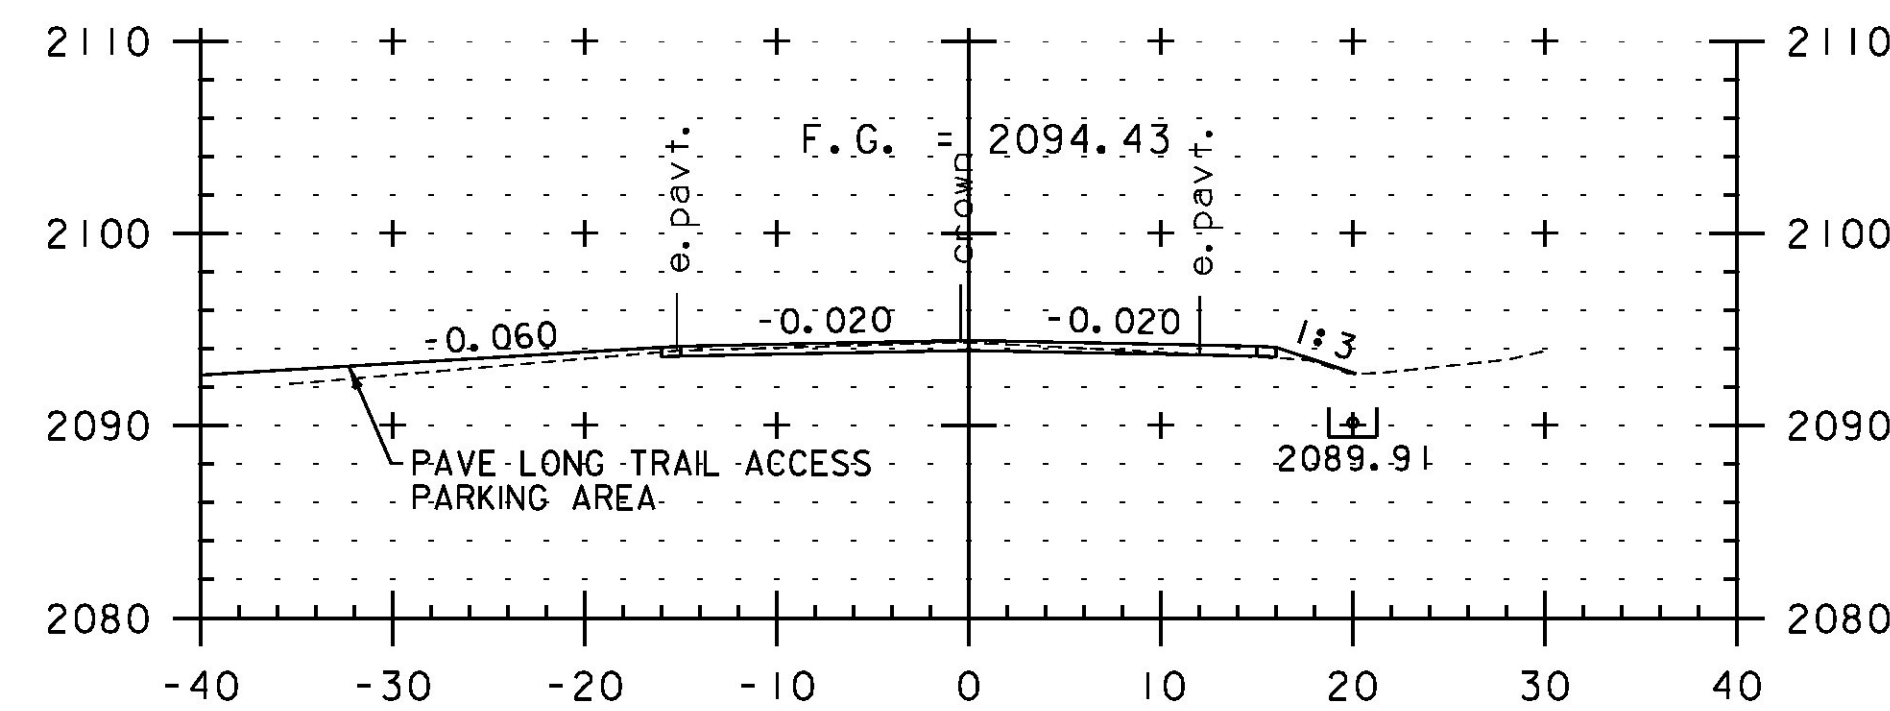


187+50

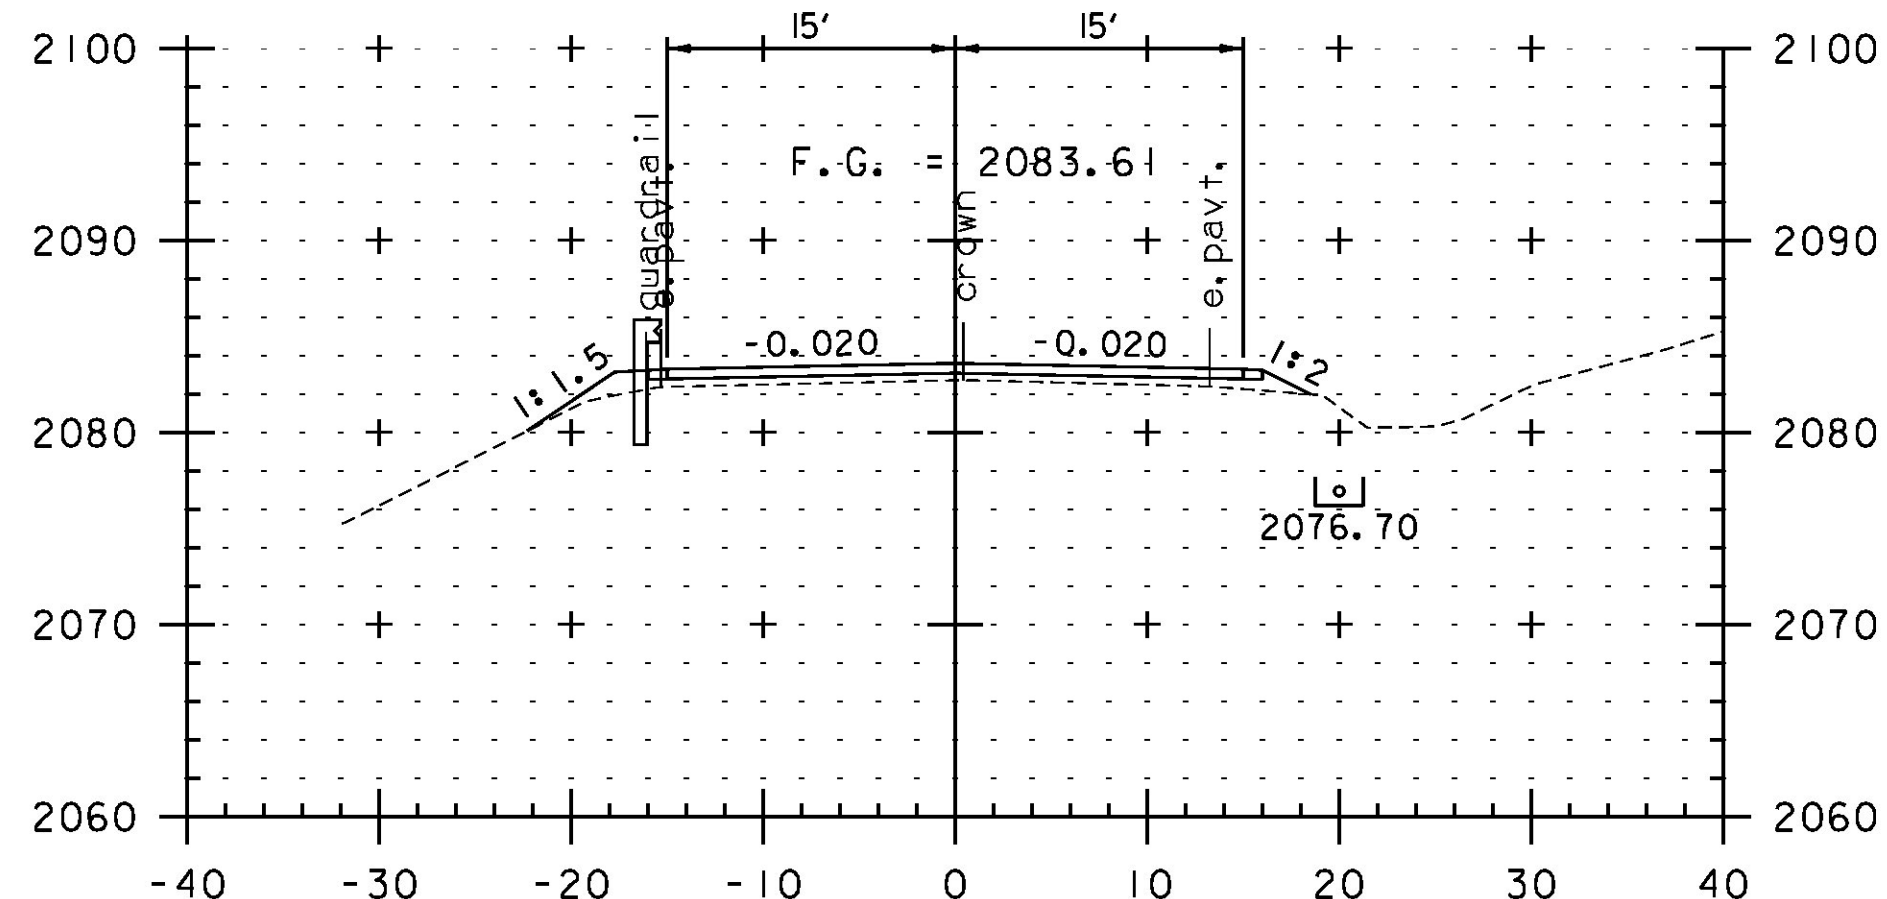

184+00

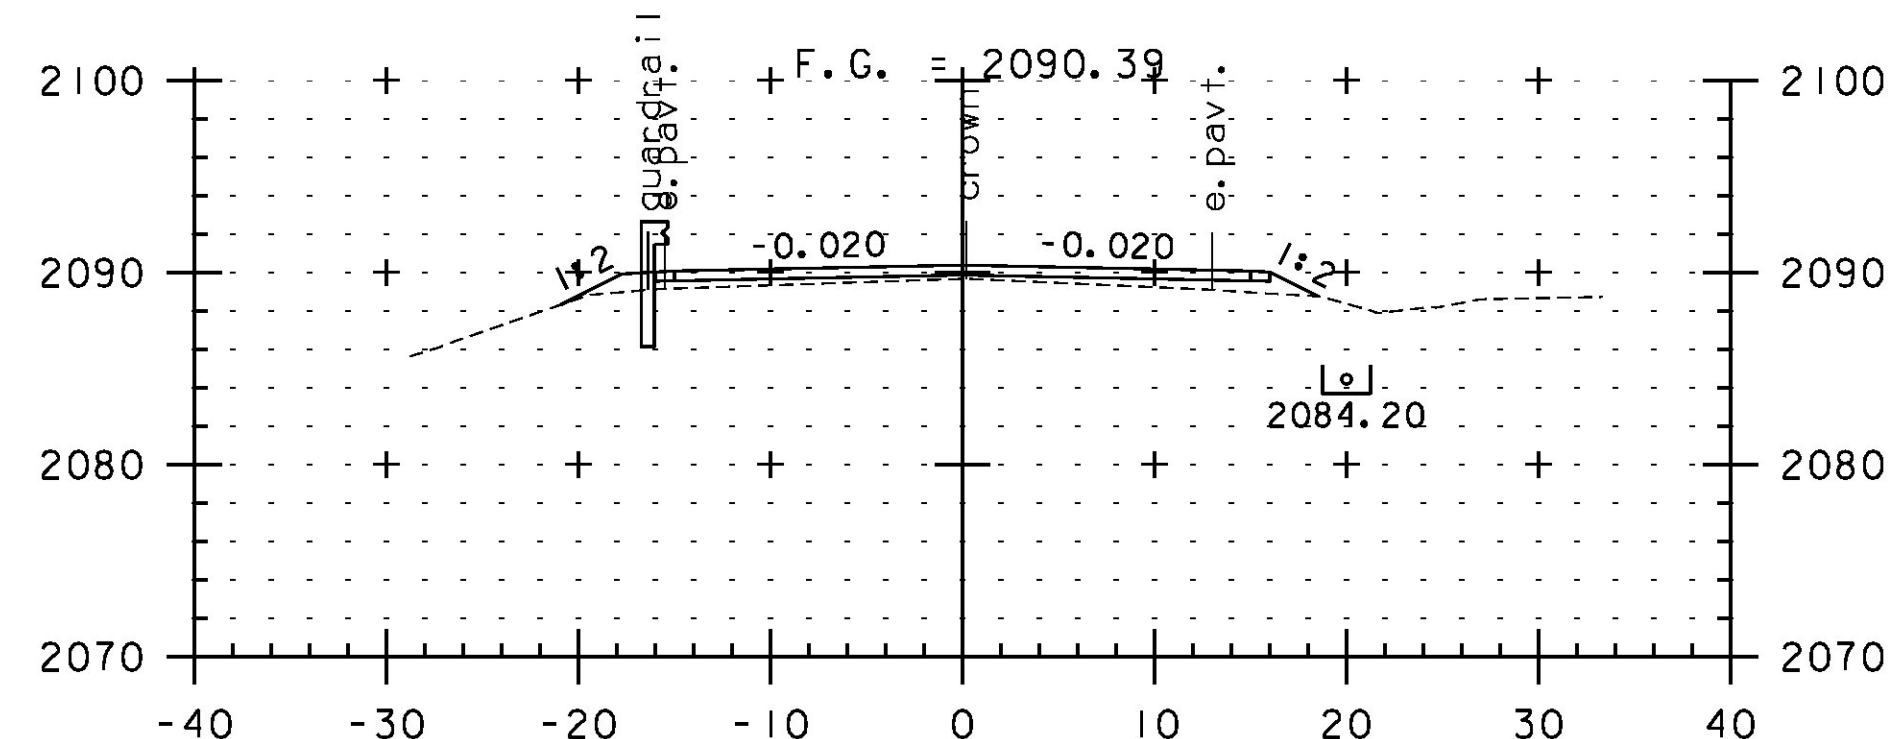

185+50

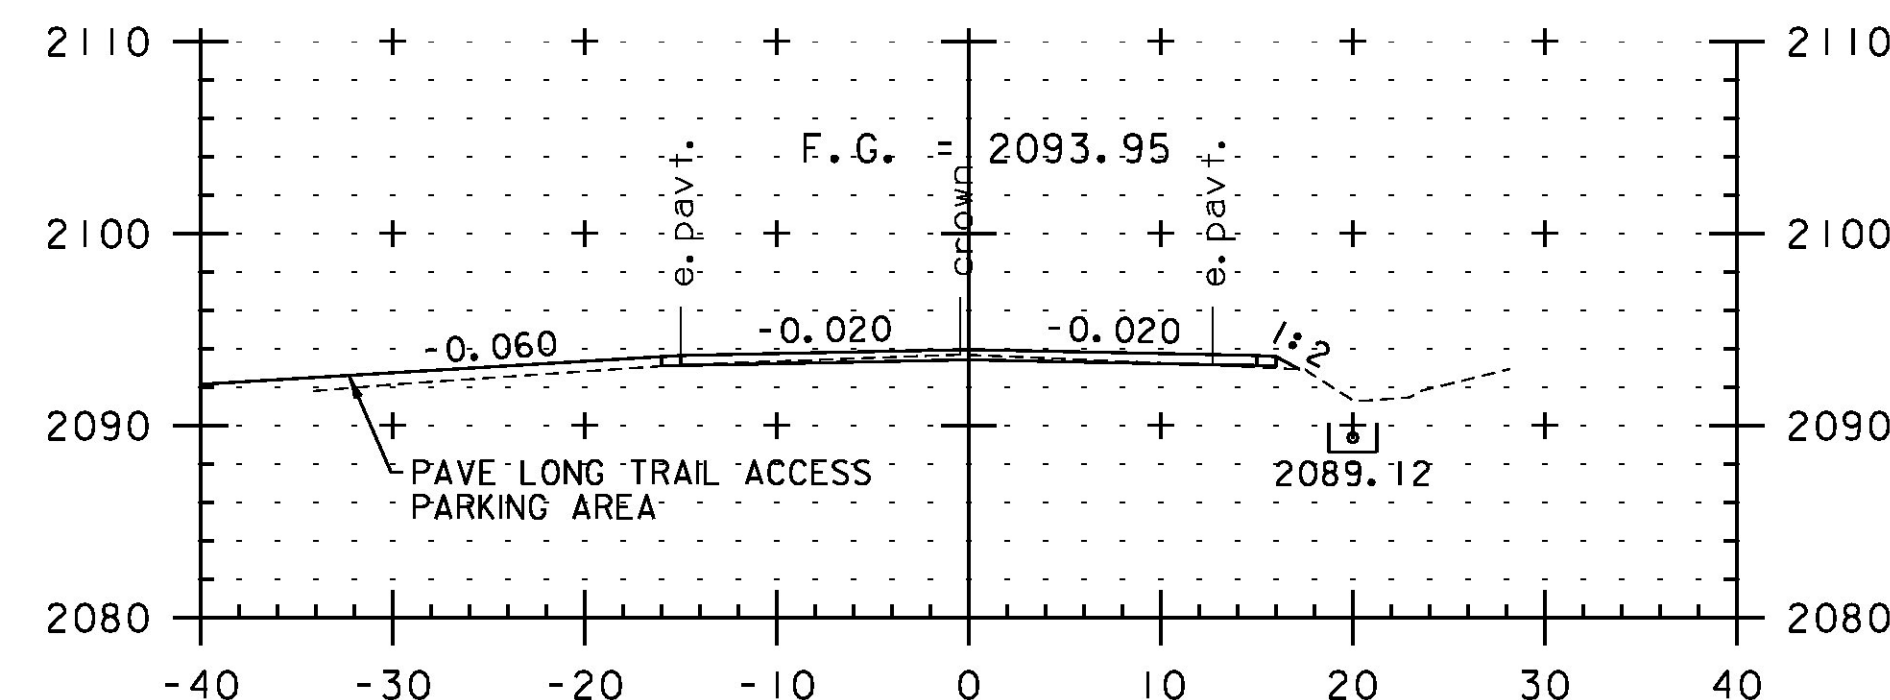

187+00



SCALE IN FEET

STA. 184+00 TO STA. 188+00

PROJECT NAME: JAY-TROY
PROJECT NUMBER: STP 2315(I)

FILE NAME: z10b232xs.dgn
PROJECT LEADER: P. SHEDD
DESIGNED BY: N. LEMAY
CROSS SECTION SHEET 37

PLOT DATE: 5/16/2014
DRAWN BY: W. GORDON
CHECKED BY: P. SHEDD
SHEET 173 OF 244