




189+50

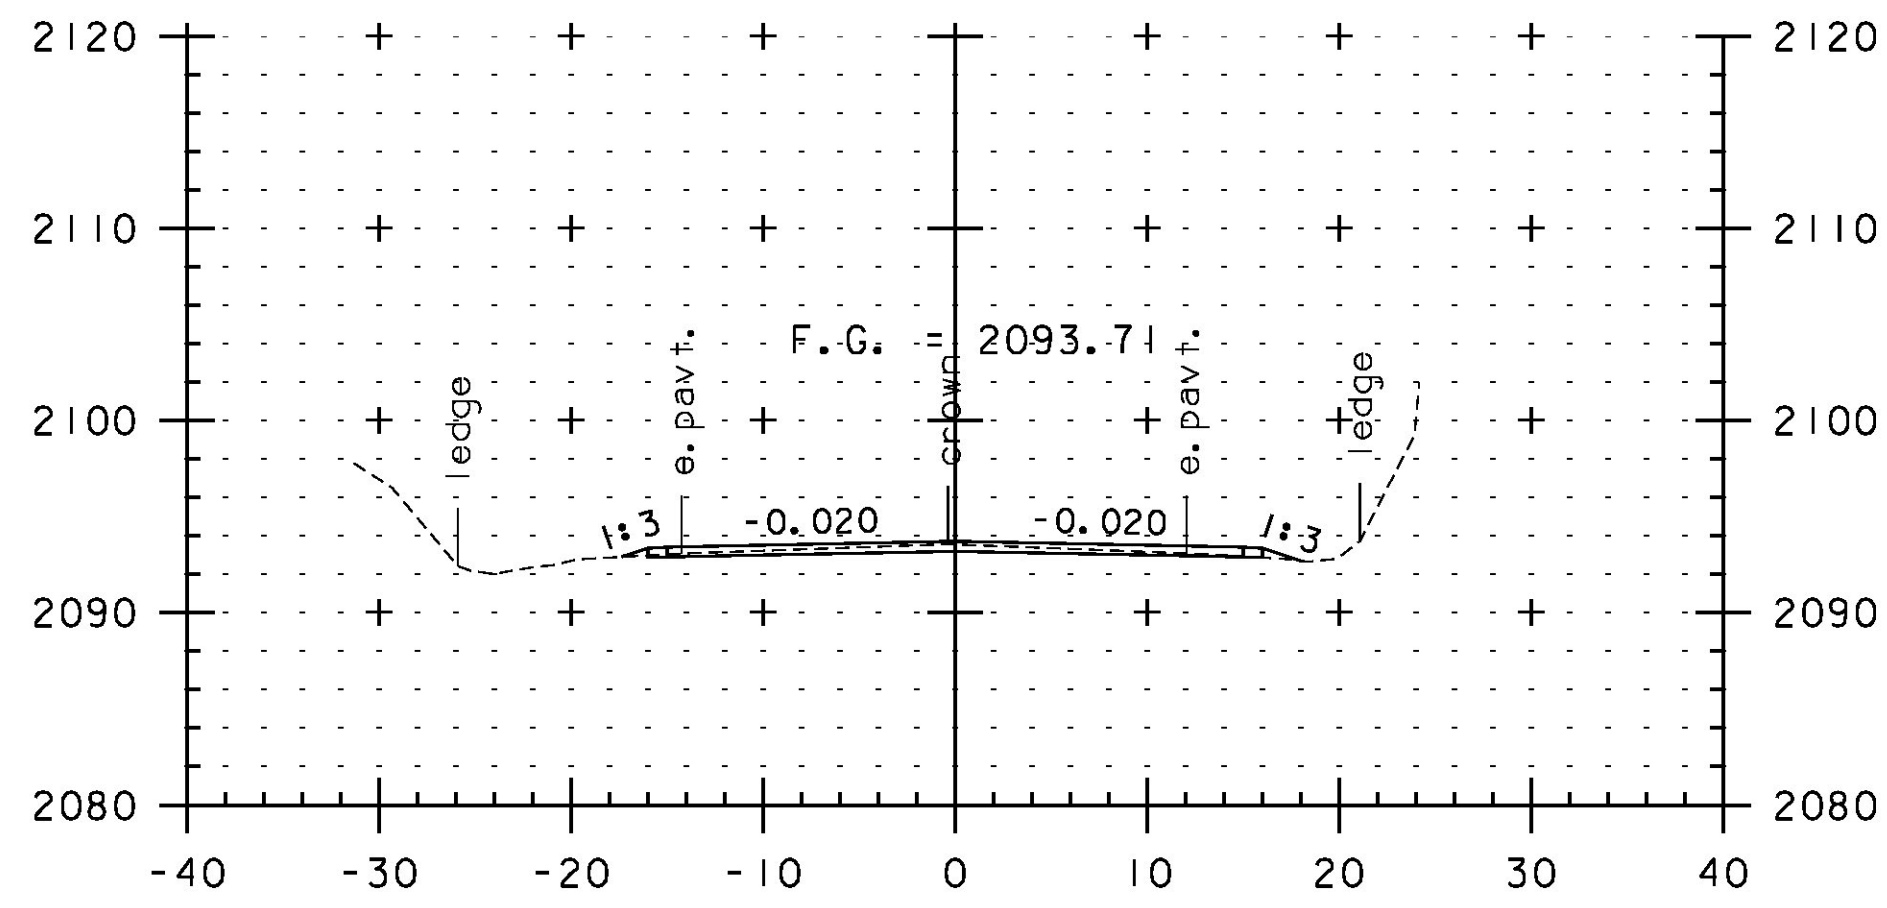


189+00

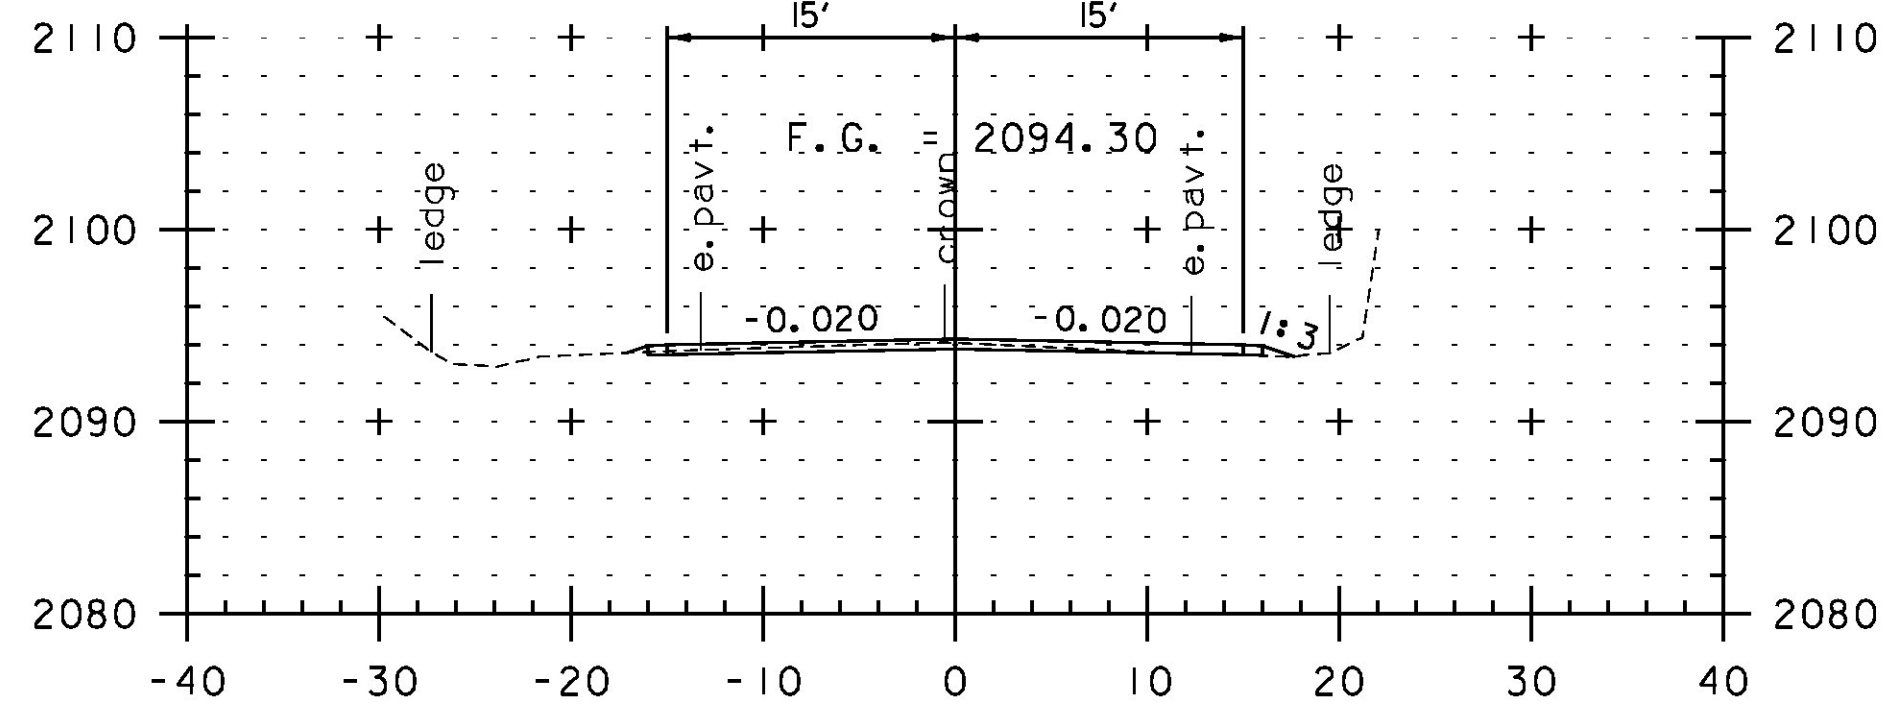


188+50

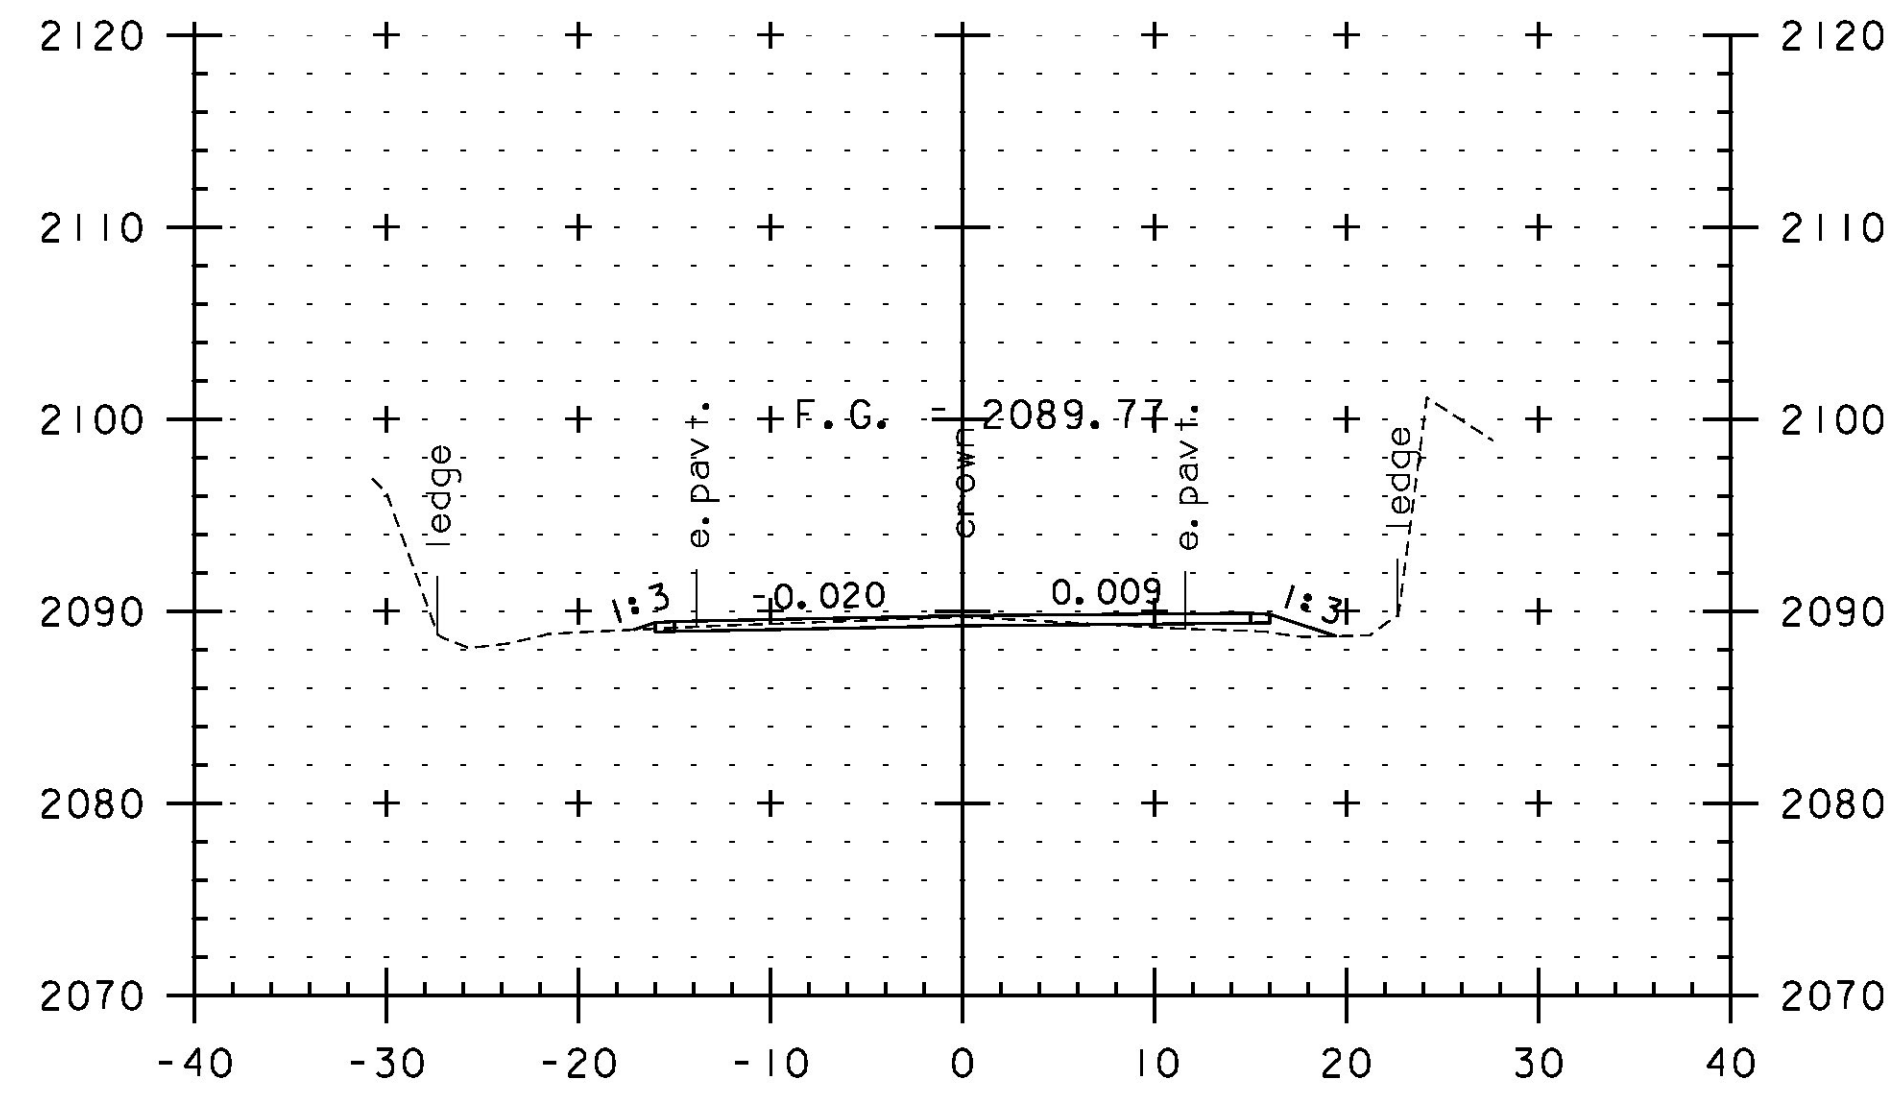


190+50

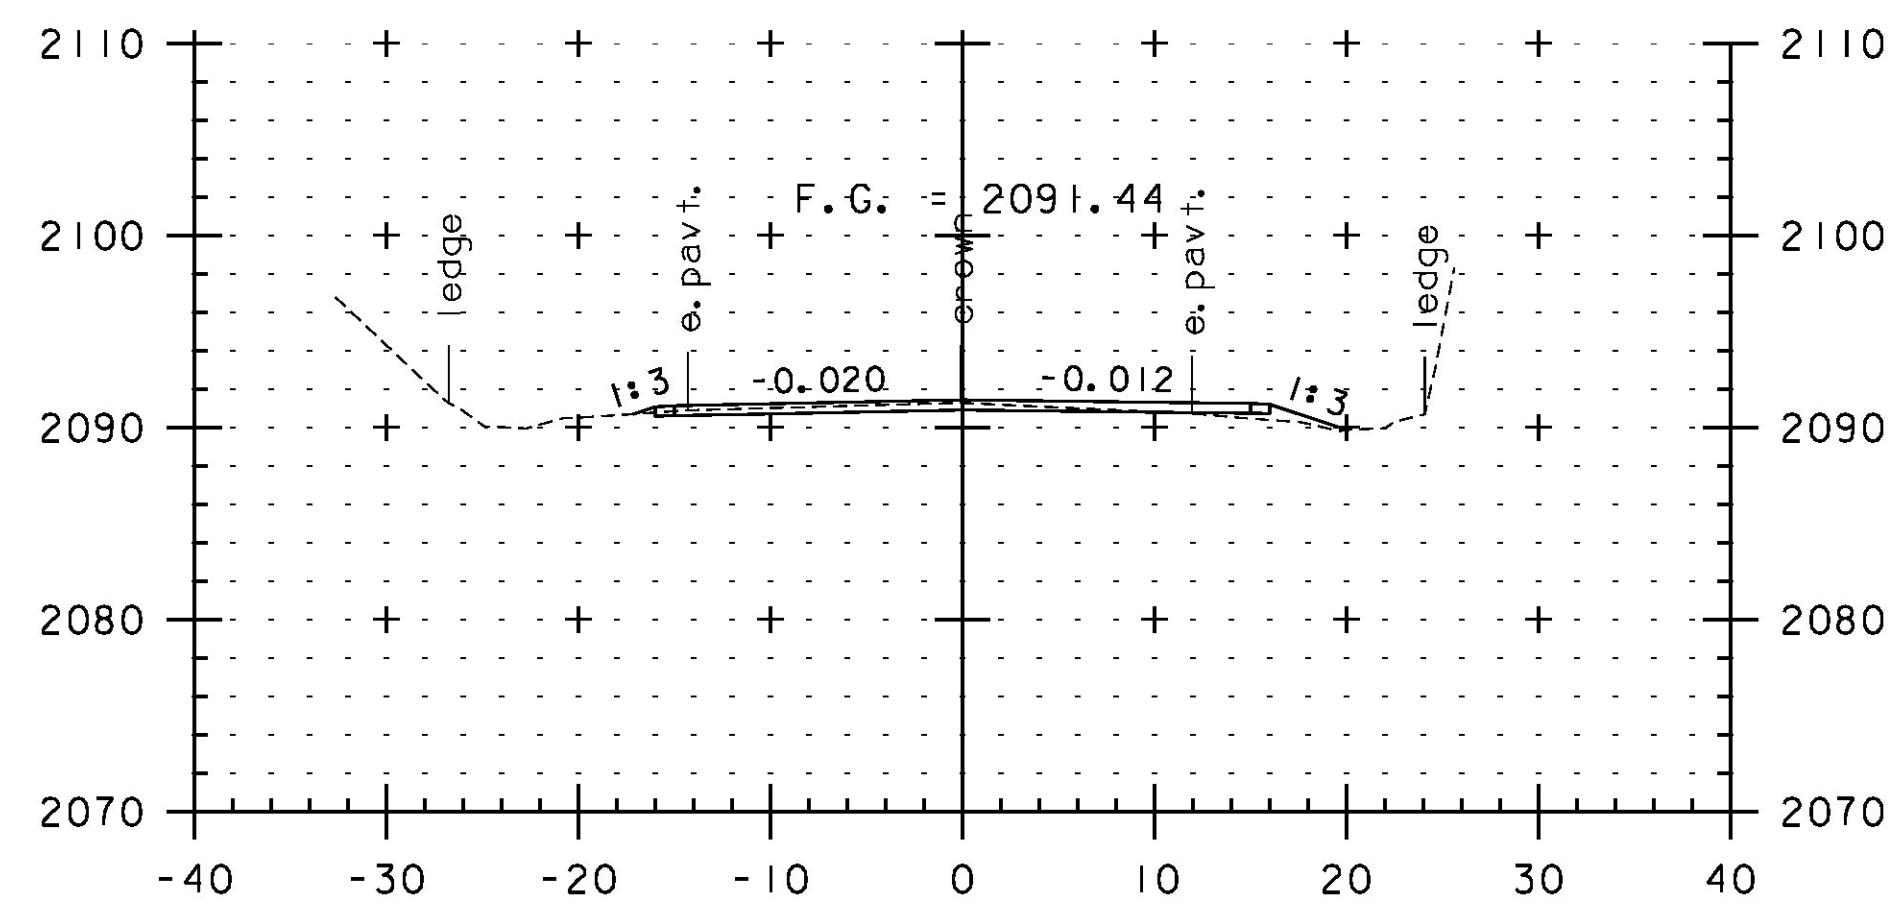


190+00

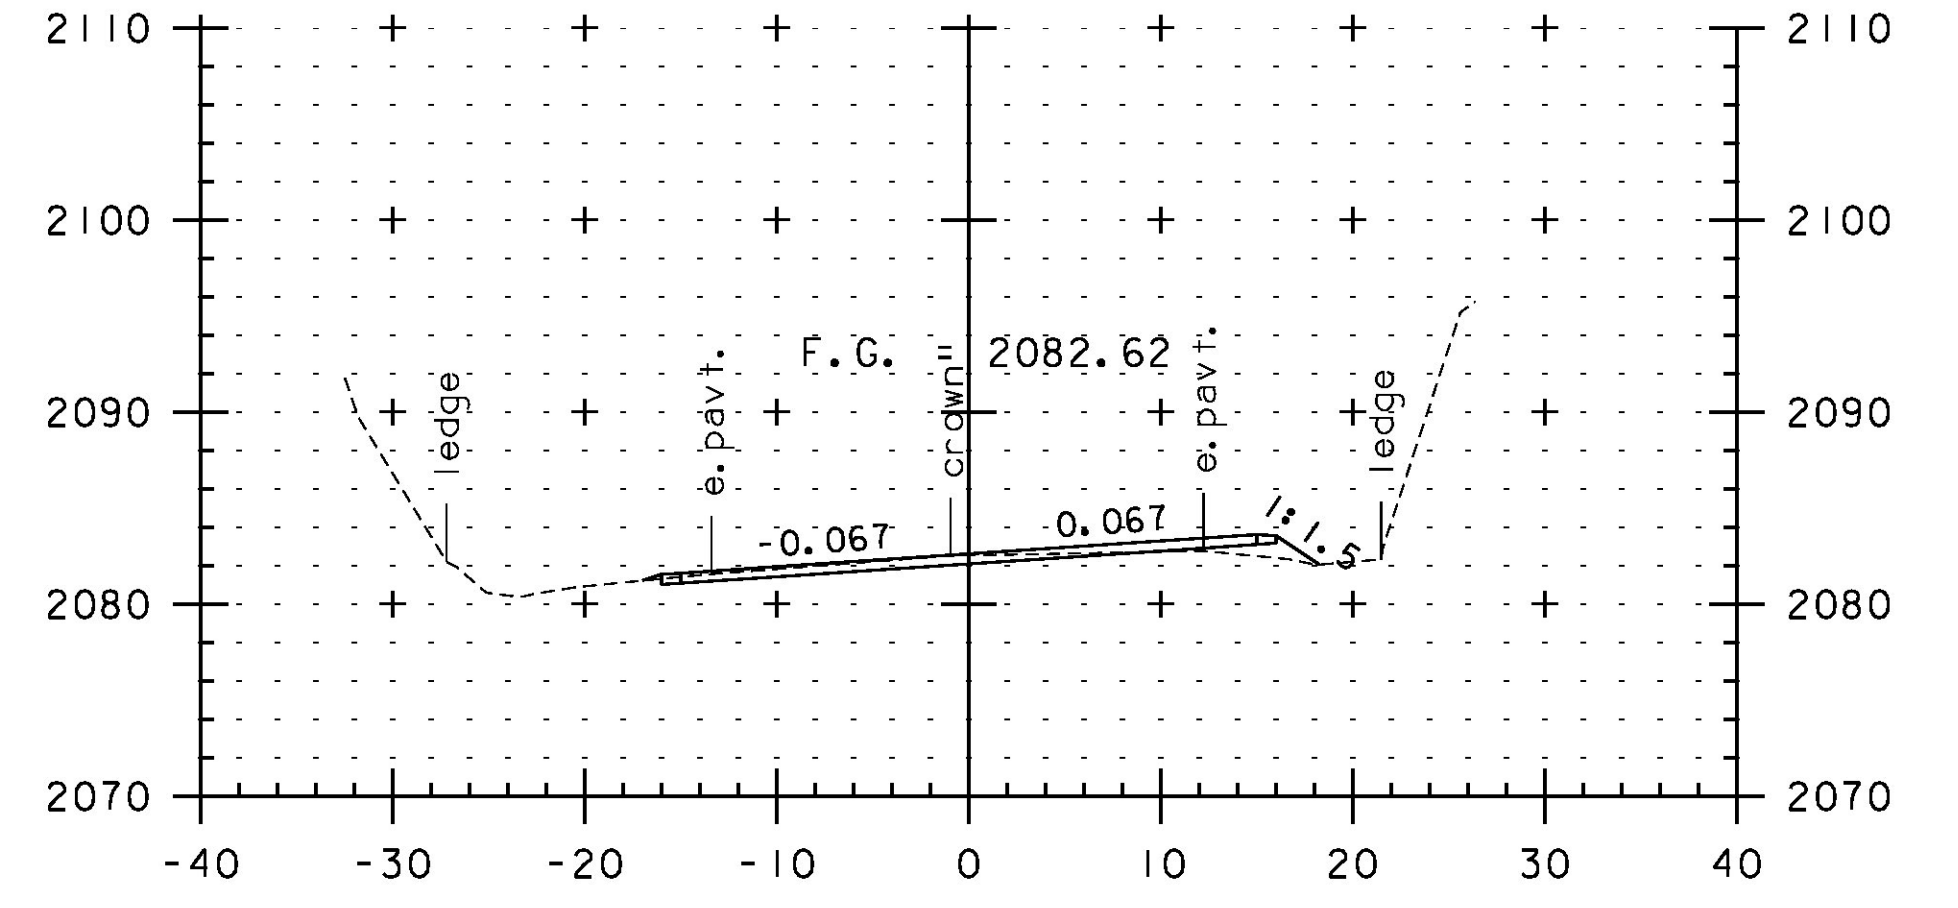


192+00

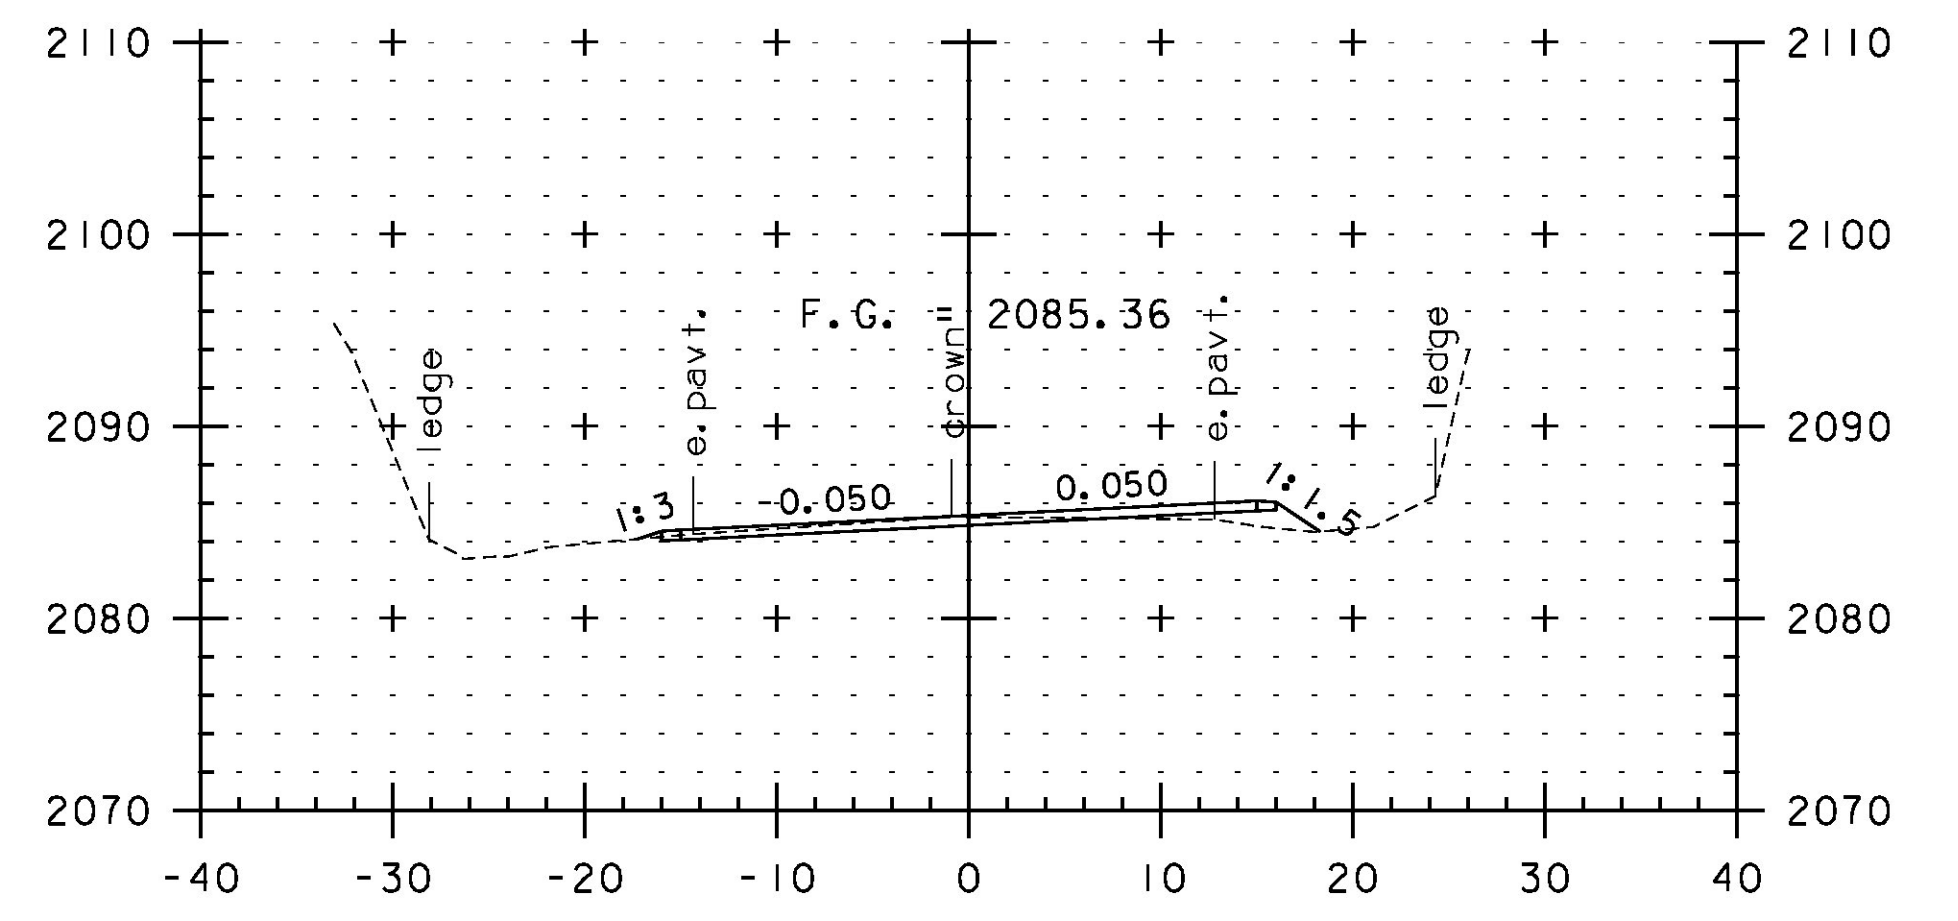

191+50

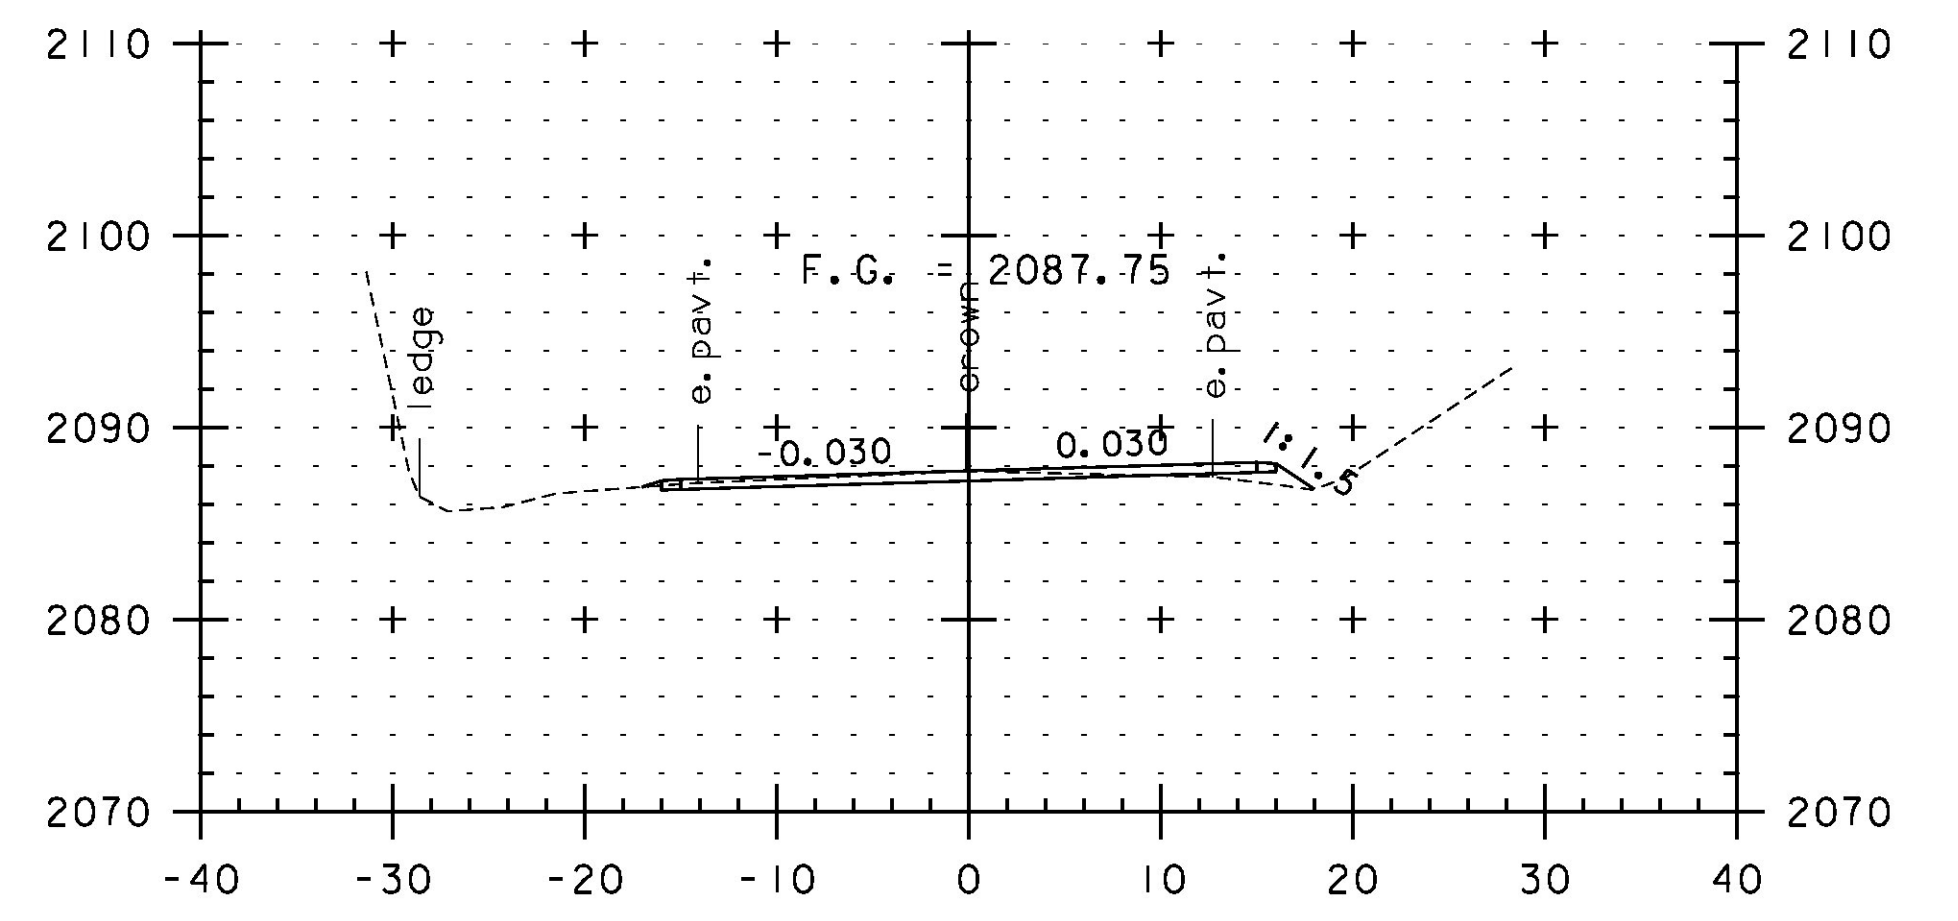

191+00

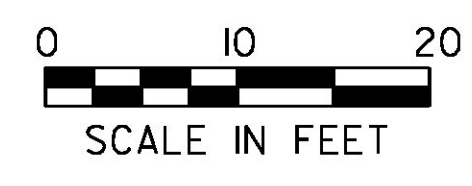

SCALE IN FEET

STA. 188+50 TO STA. 192+00

PROJECT NAME:	JAY-TROY	PLOT DATE:	5/16/2014
PROJECT NUMBER:	STP 2315(I)	DRAWN BY:	W. GORDON
FILE NAME:	z10b232xs.dgn	DESIGNED BY:	N. LEMAY
PROJECT LEADER:	P. SHEDD	CHECKED BY:	P. SHEDD
CROSS SECTION SHEET 38		SHEET	174 OF 244