




194+50

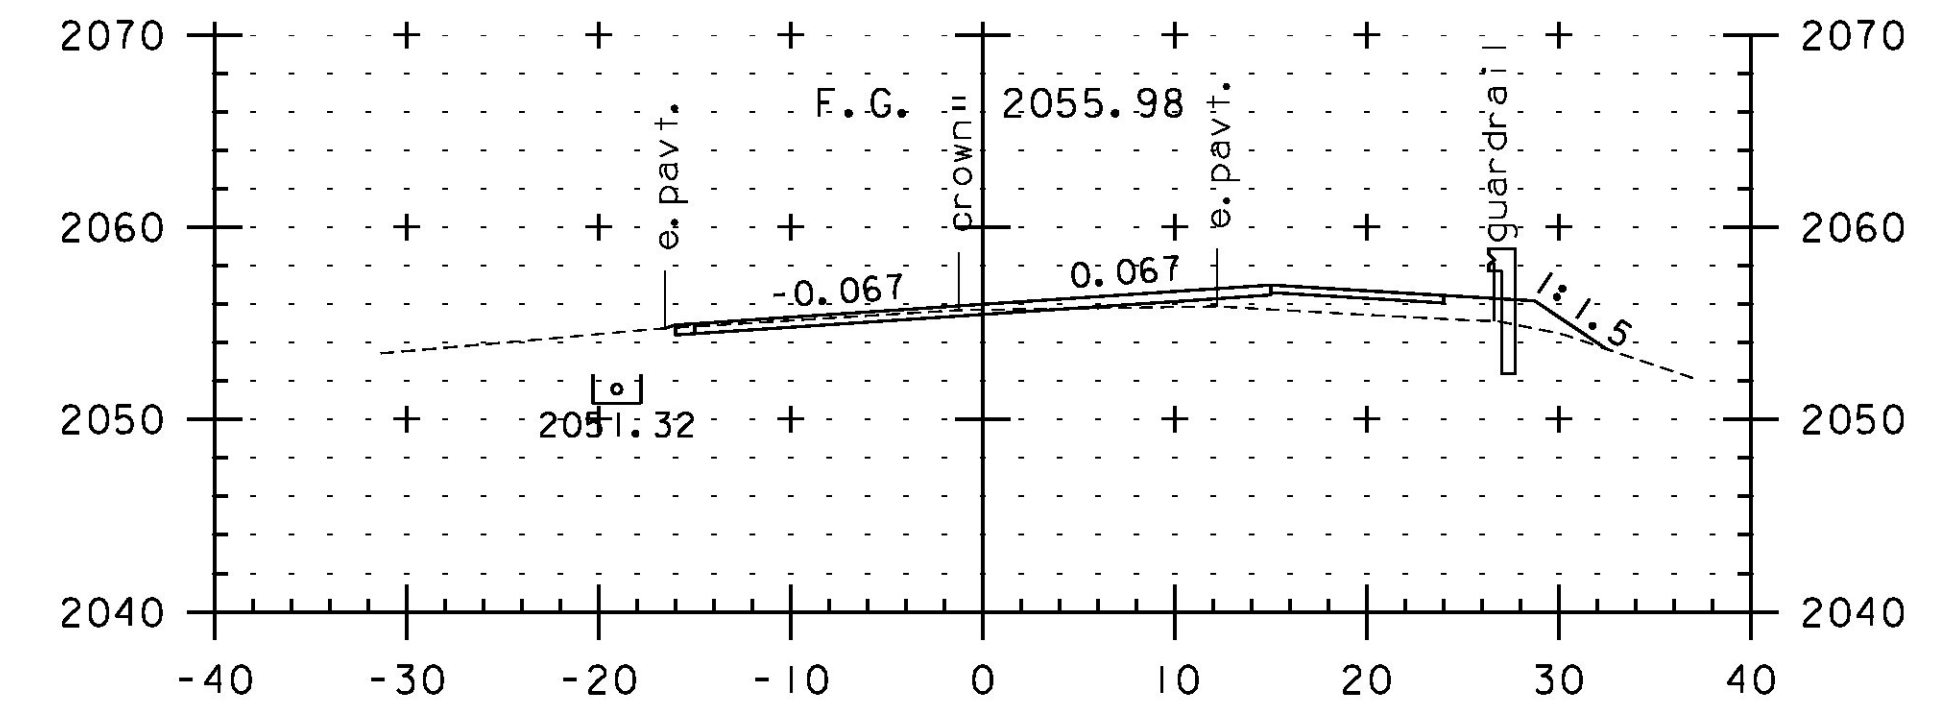


196+00

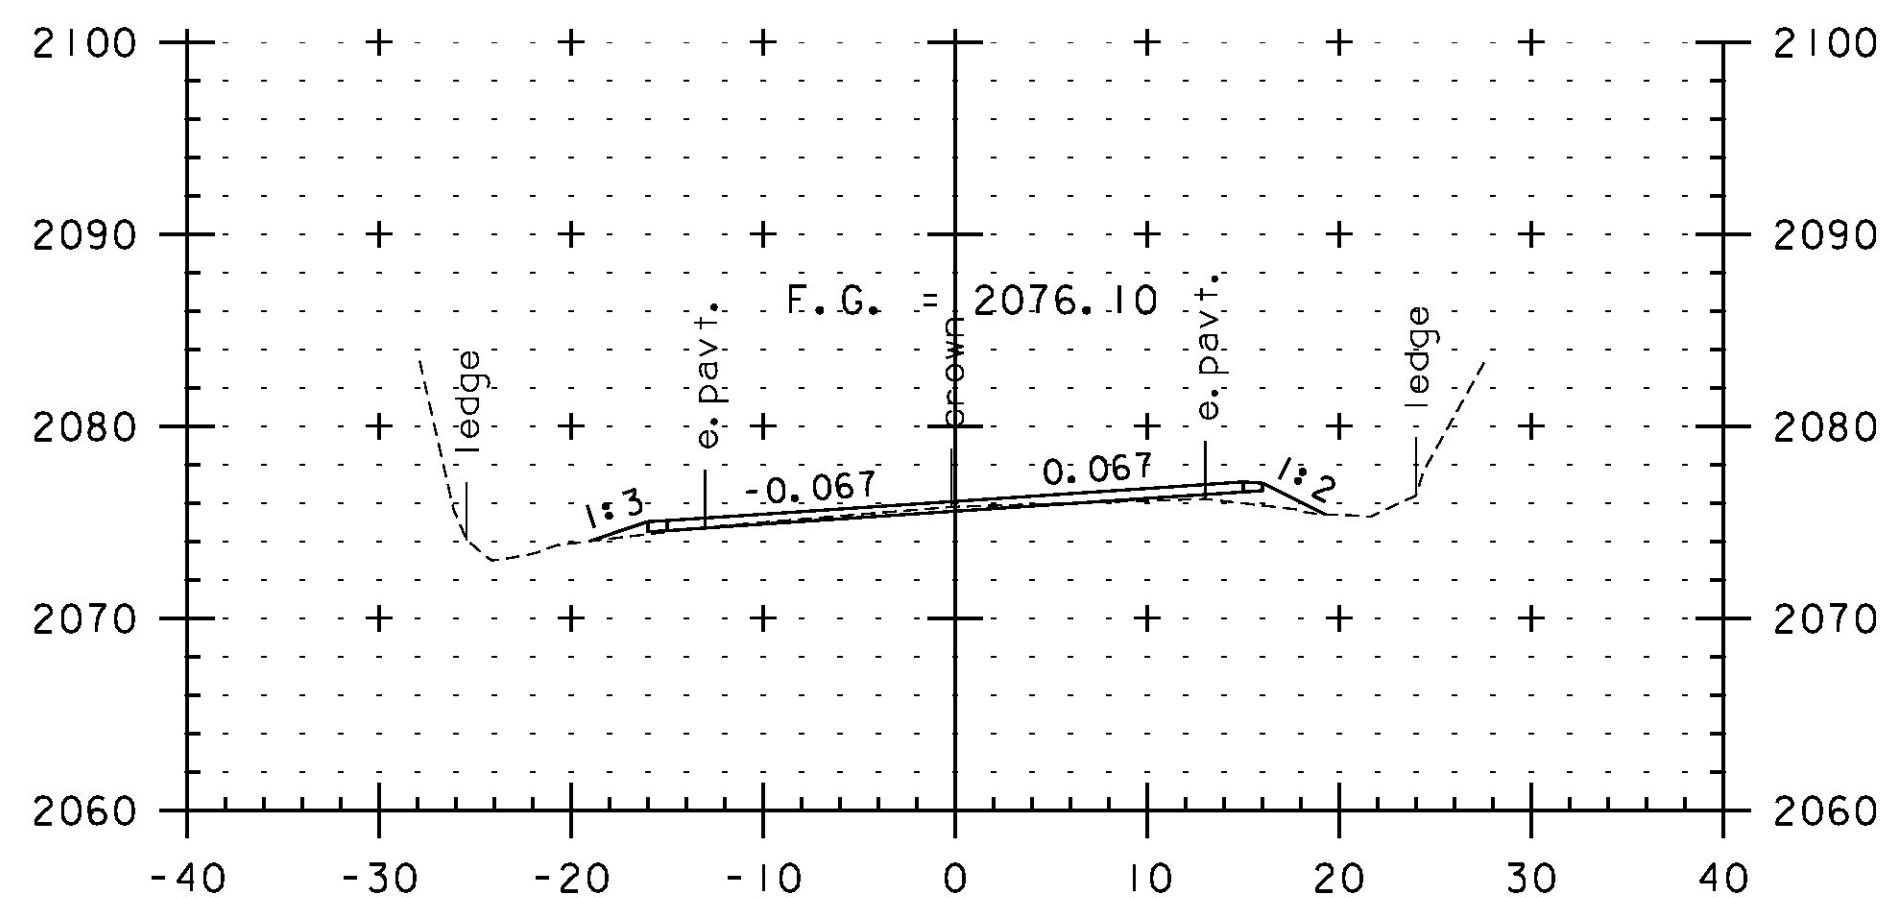


193+00

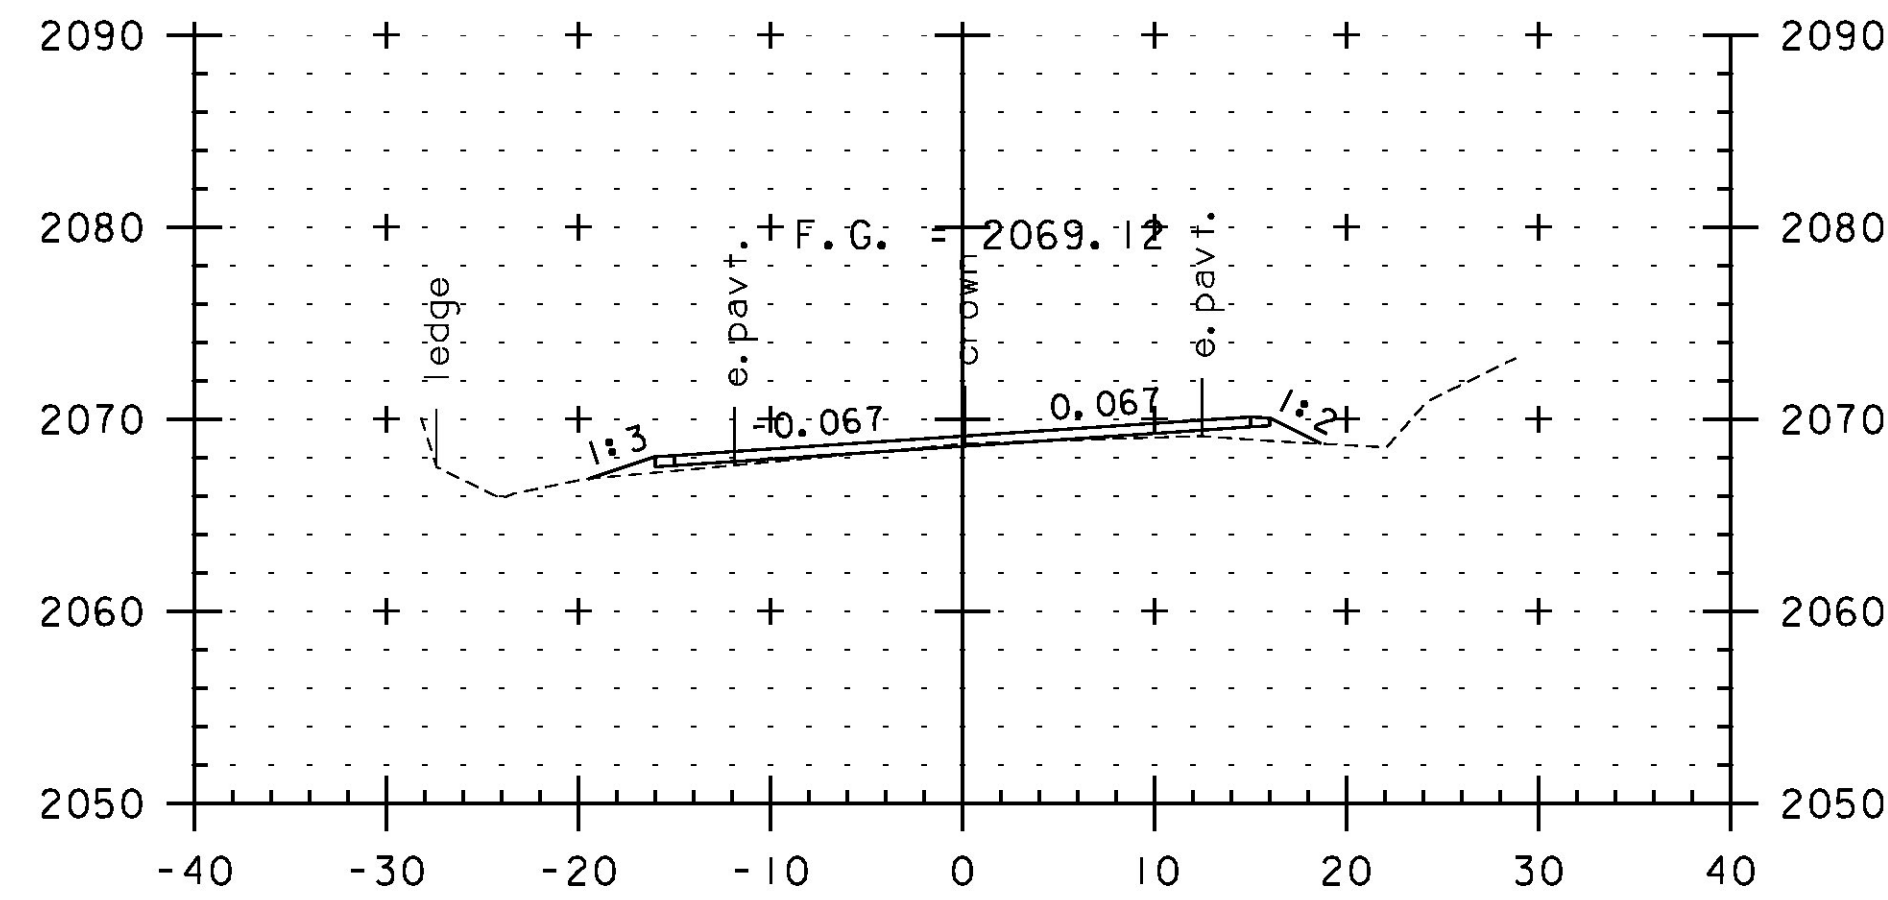


194+00

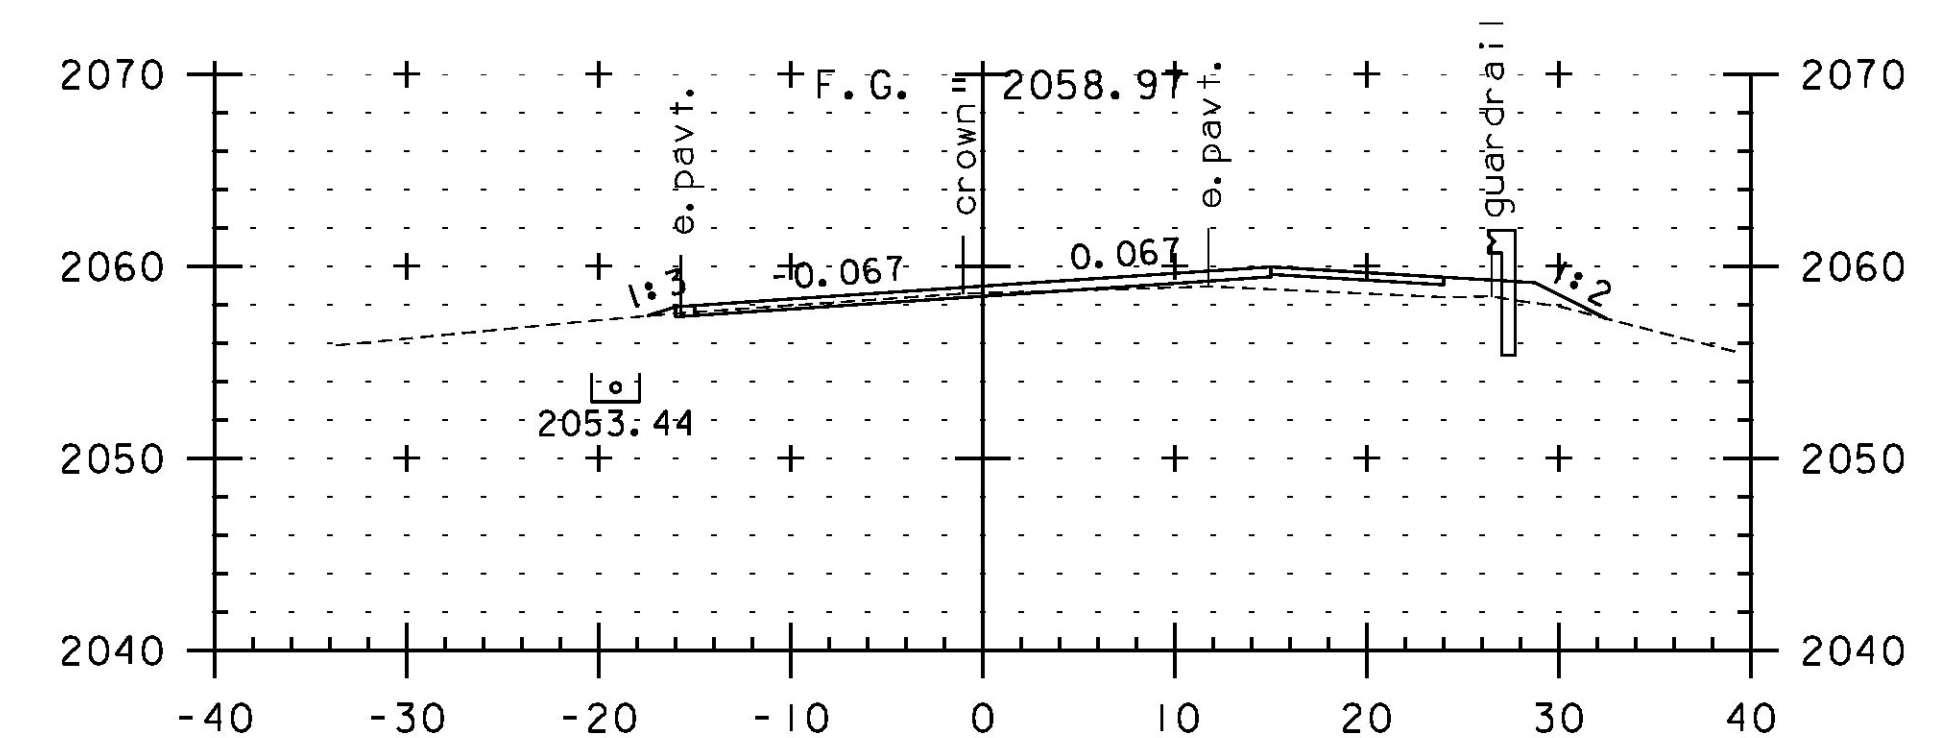


195+50

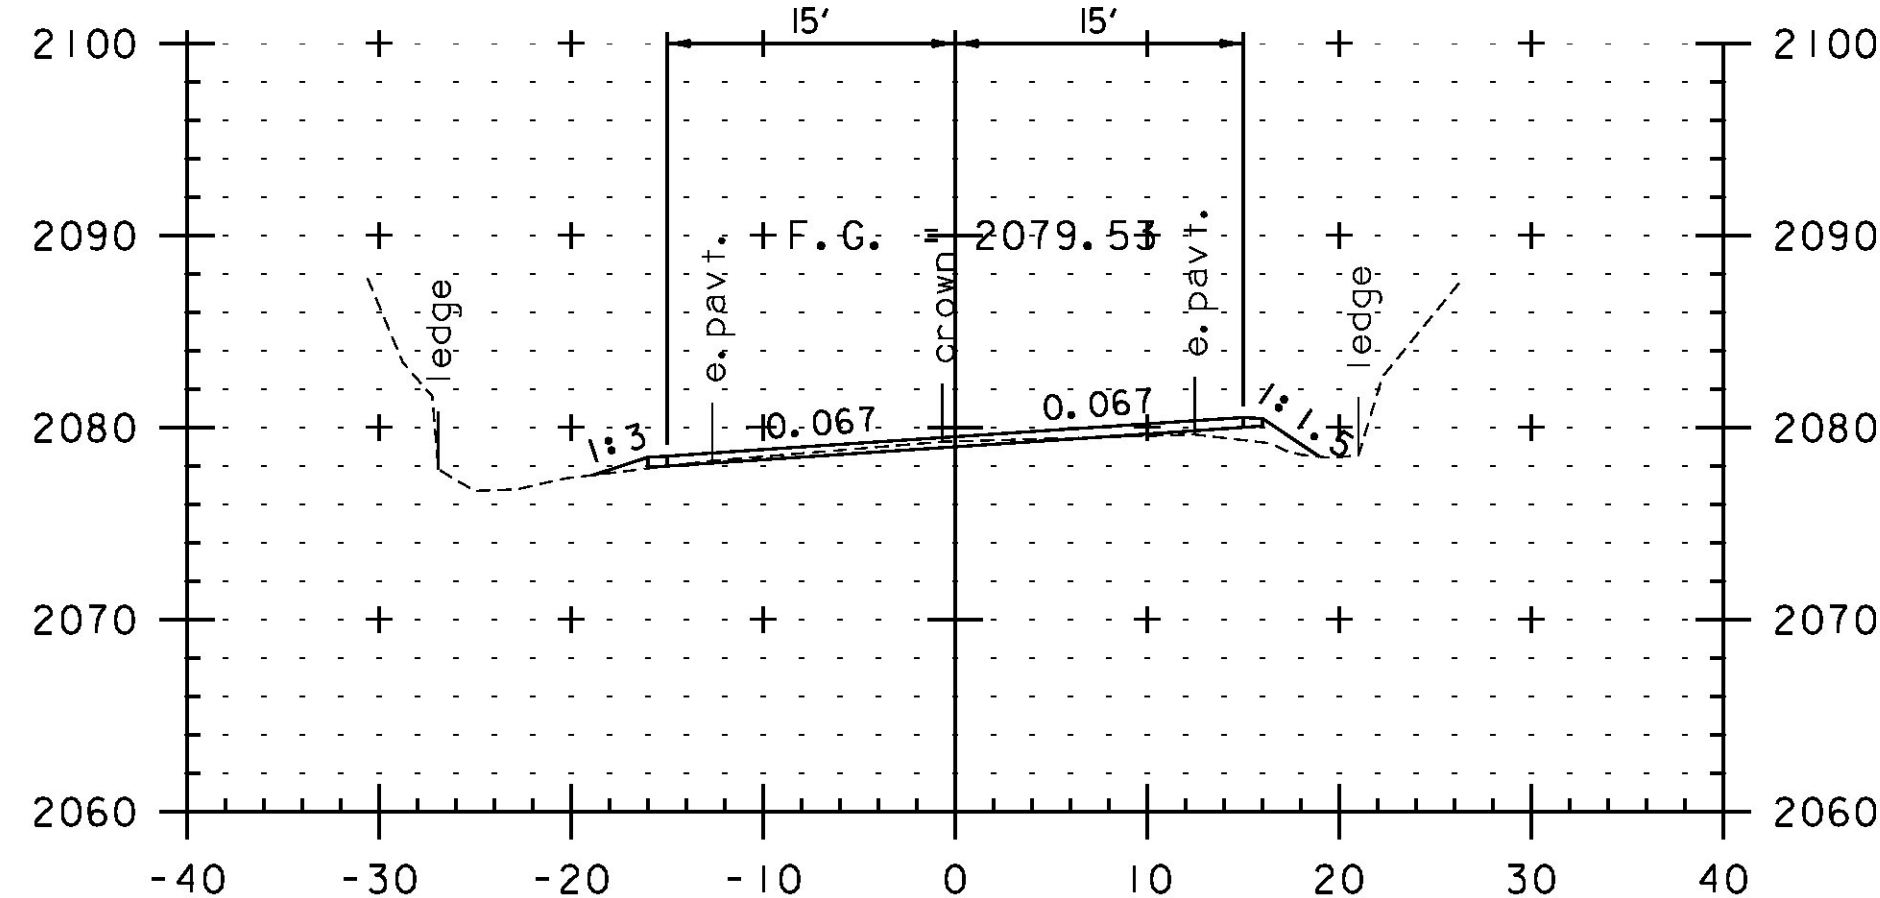


192+50

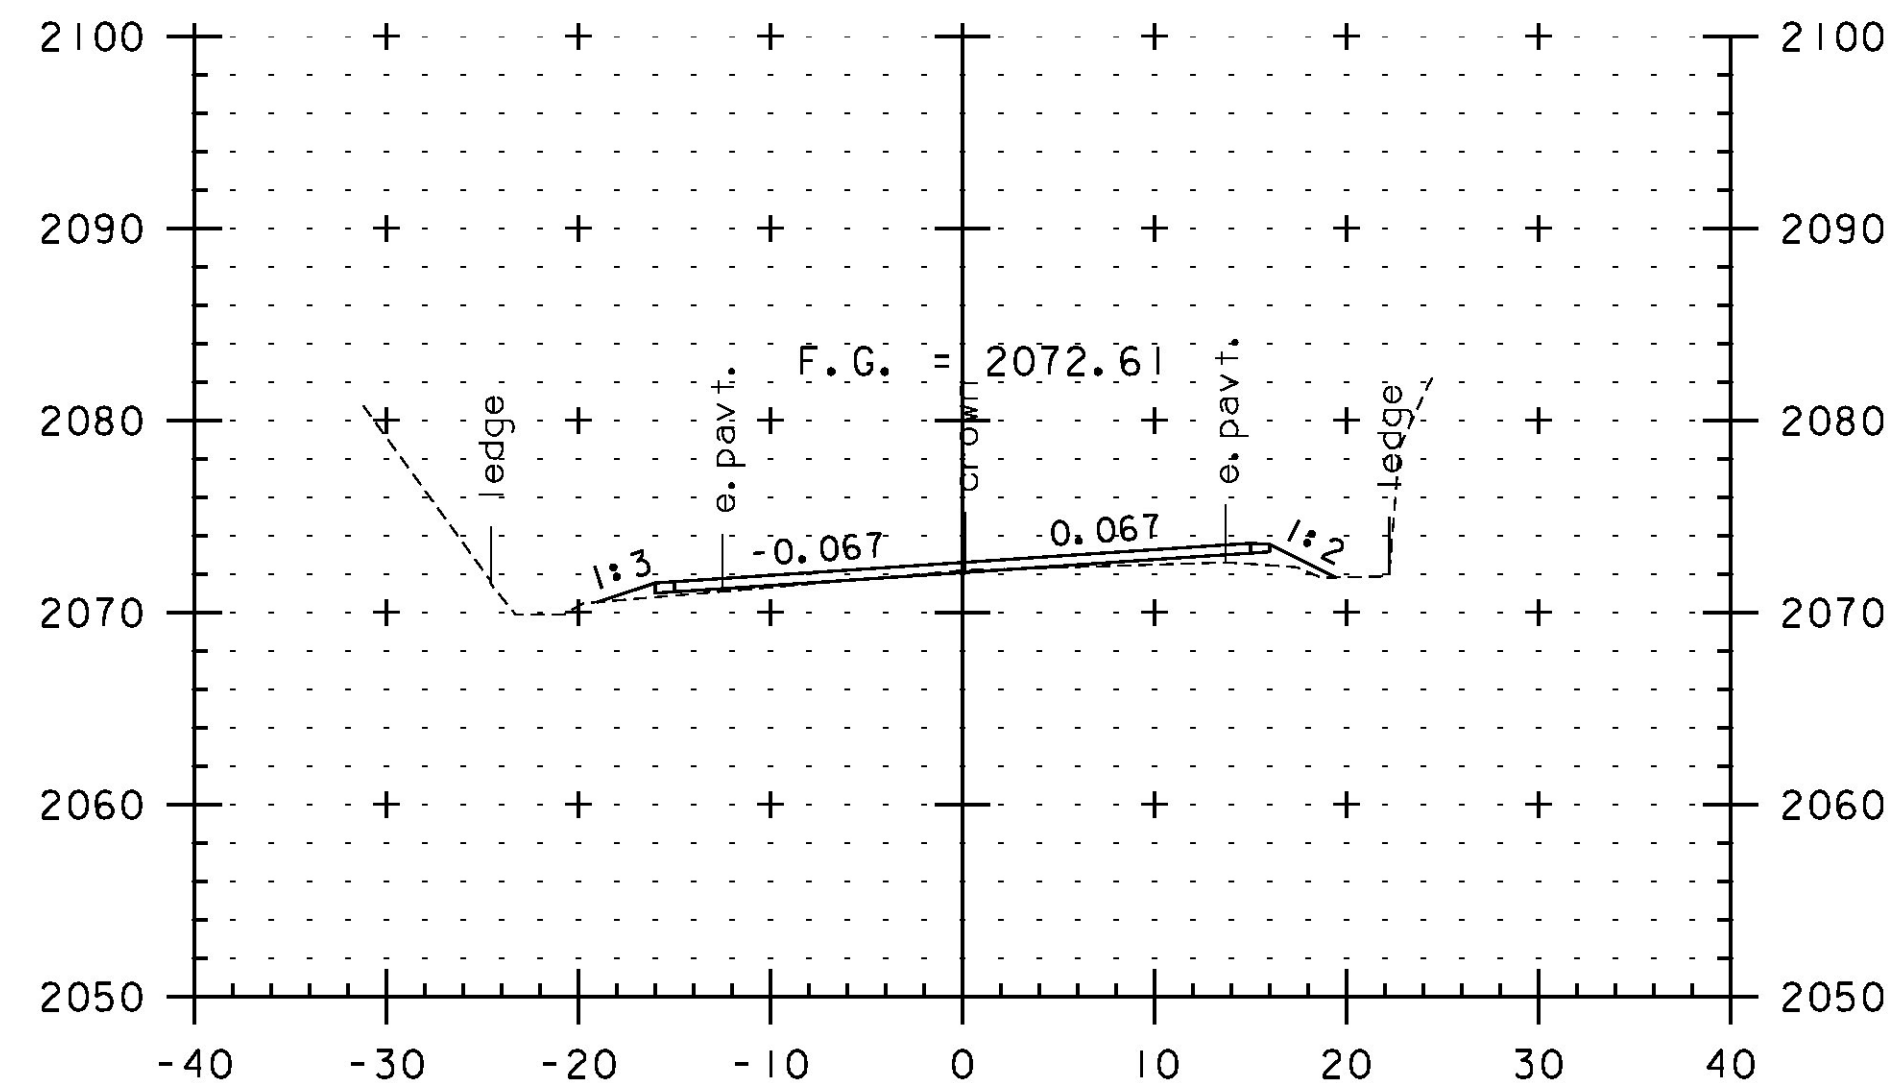

193+50

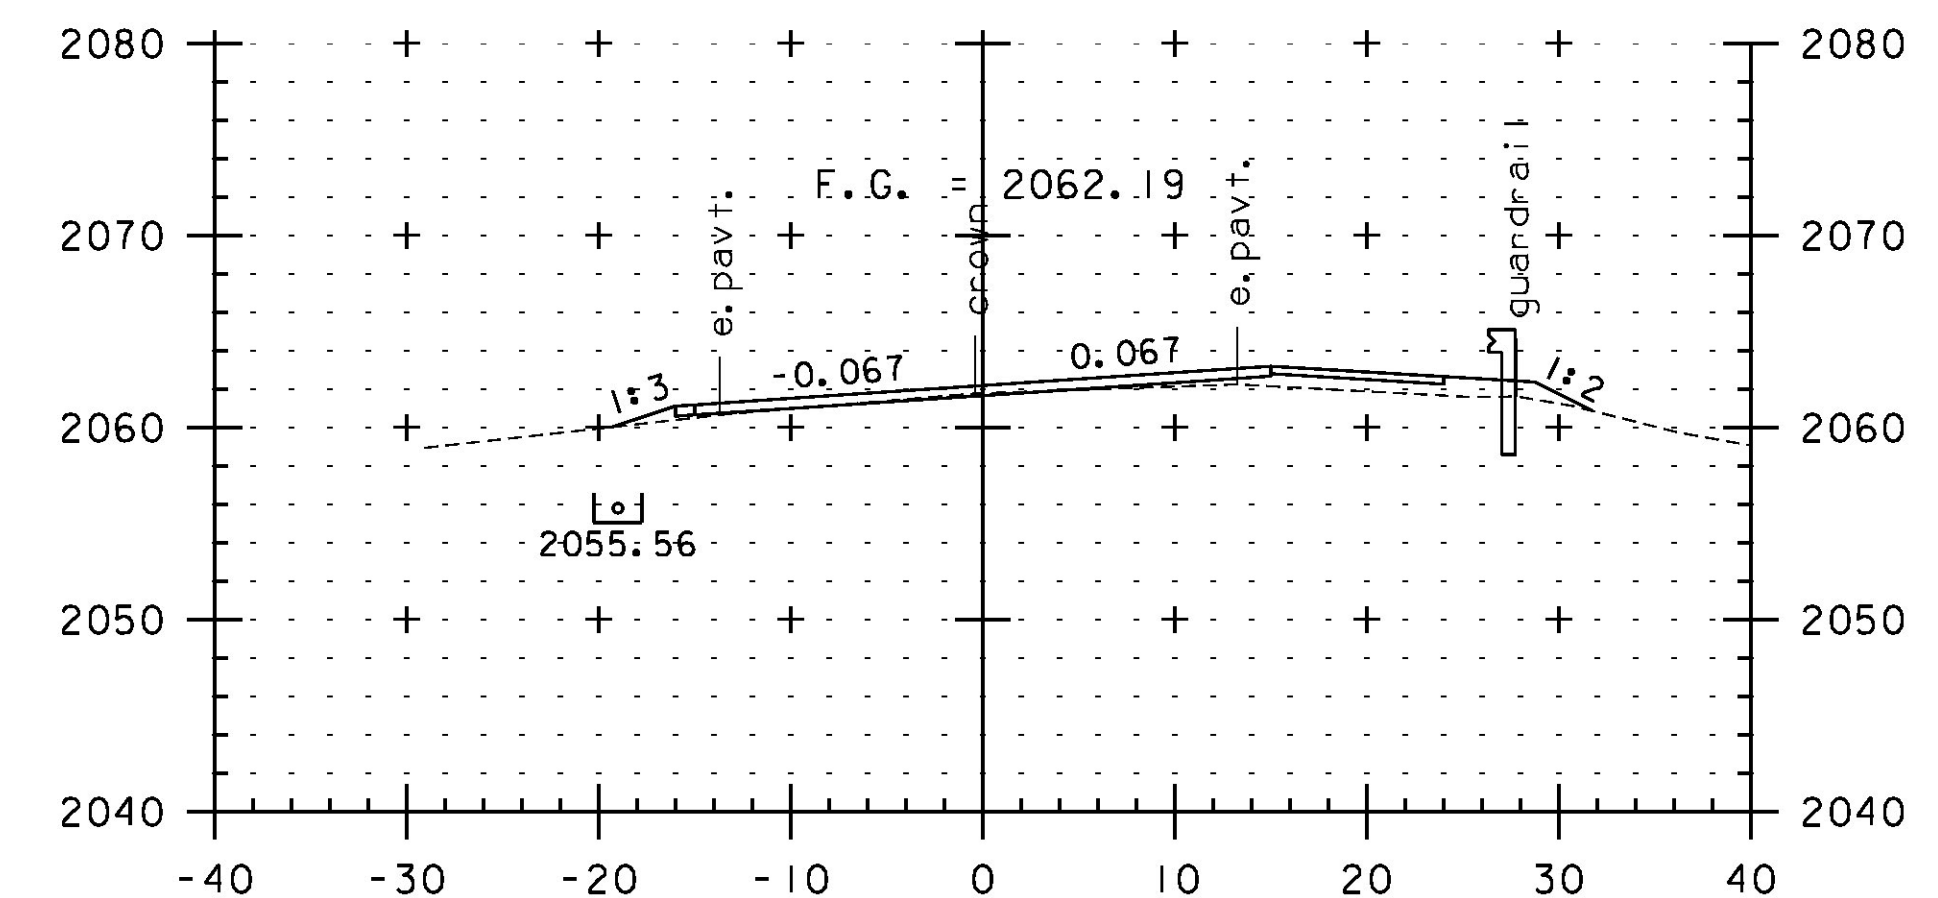

195+00

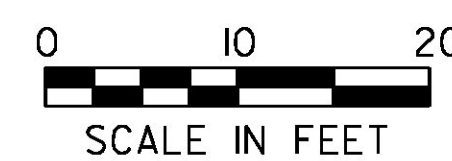

STA. 192+50 TO STA. 196+00

PROJECT NAME:	JAY-TROY	PLOT DATE:	5/16/2014
PROJECT NUMBER:	STP 2315(I)	DRAWN BY:	W. GORDON
FILE NAME:	z10b232xs.dgn	CHECKED BY:	P. SHEDD
PROJECT LEADER:	P. SHEDD	CROSS SECTION SHEET	39
DESIGNED BY:	N. LEMAY	SHEET	175 OF 244