




209+50

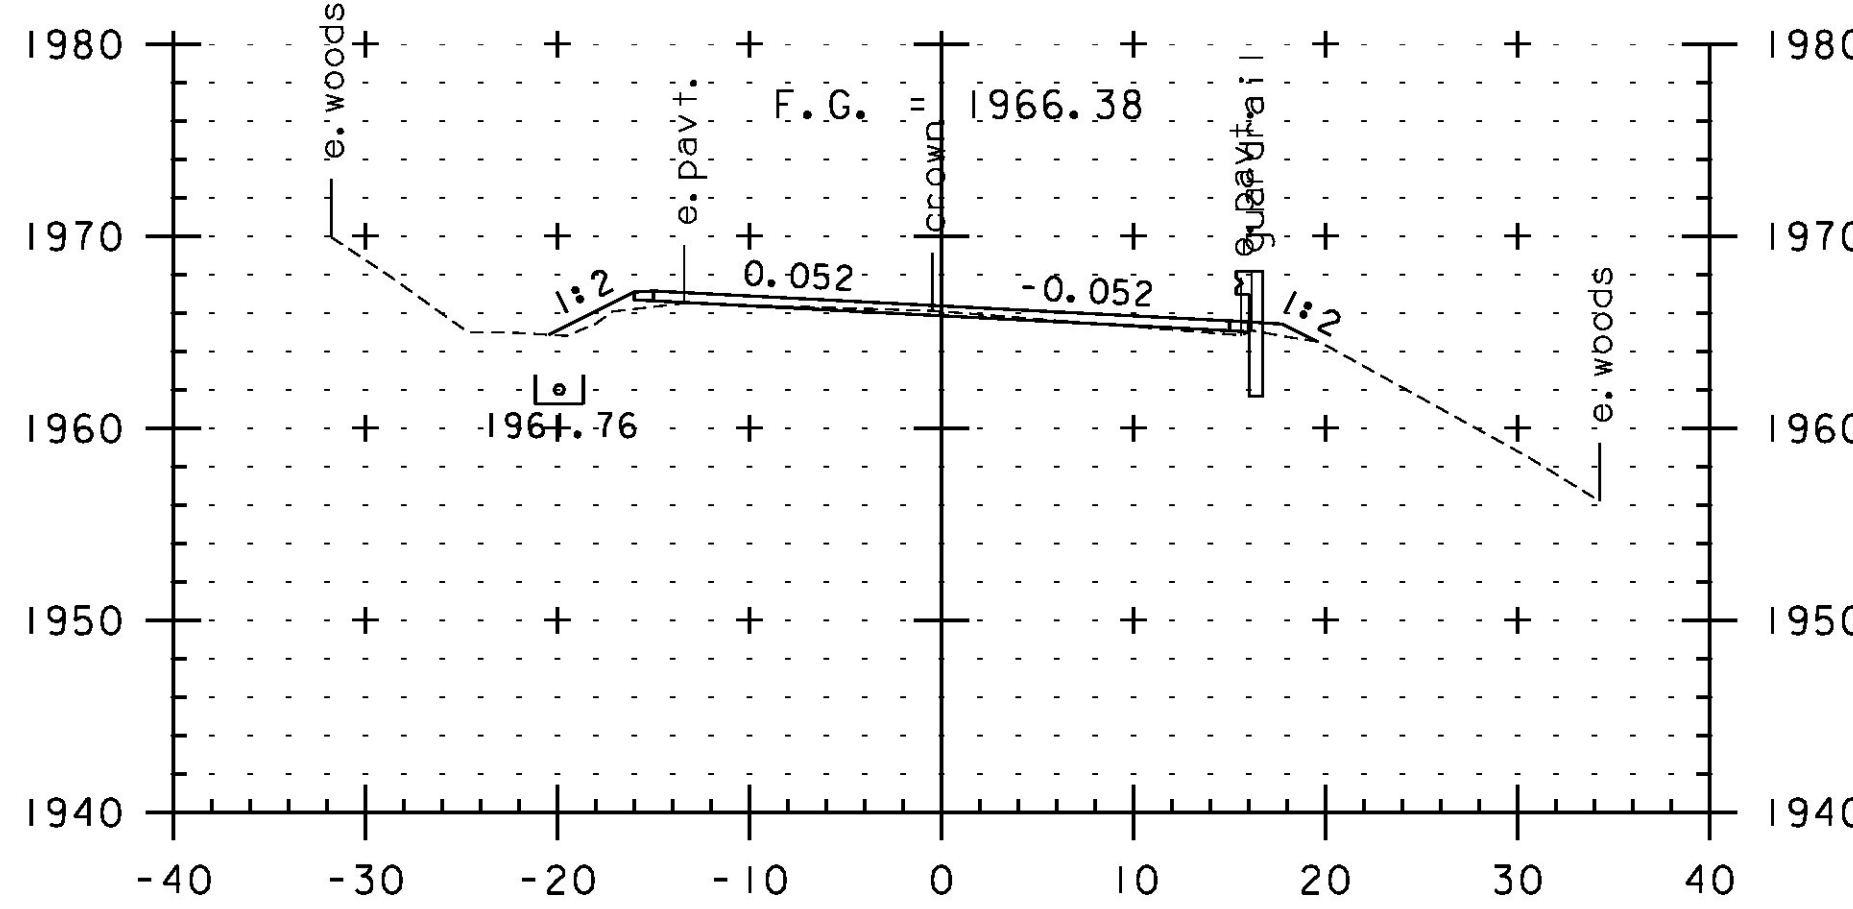


210+50

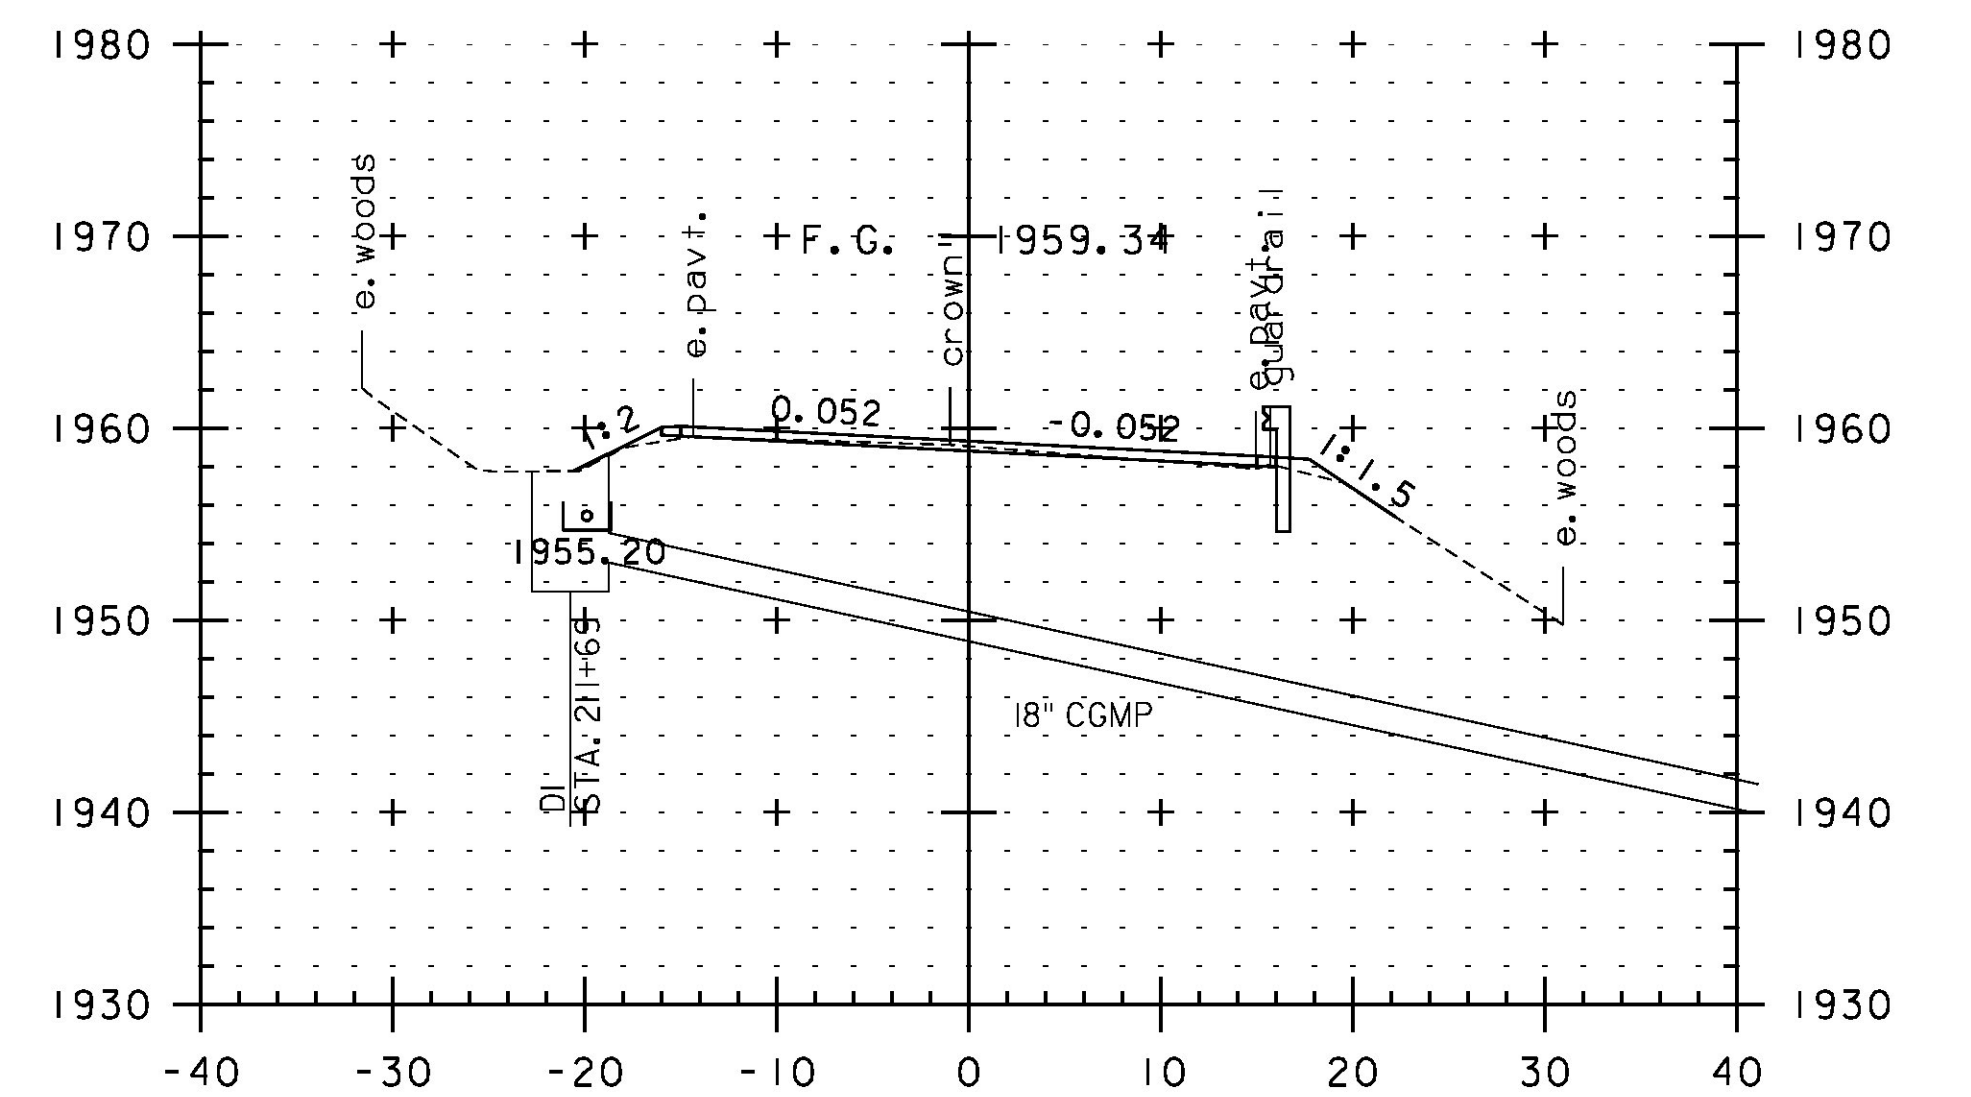


211+50

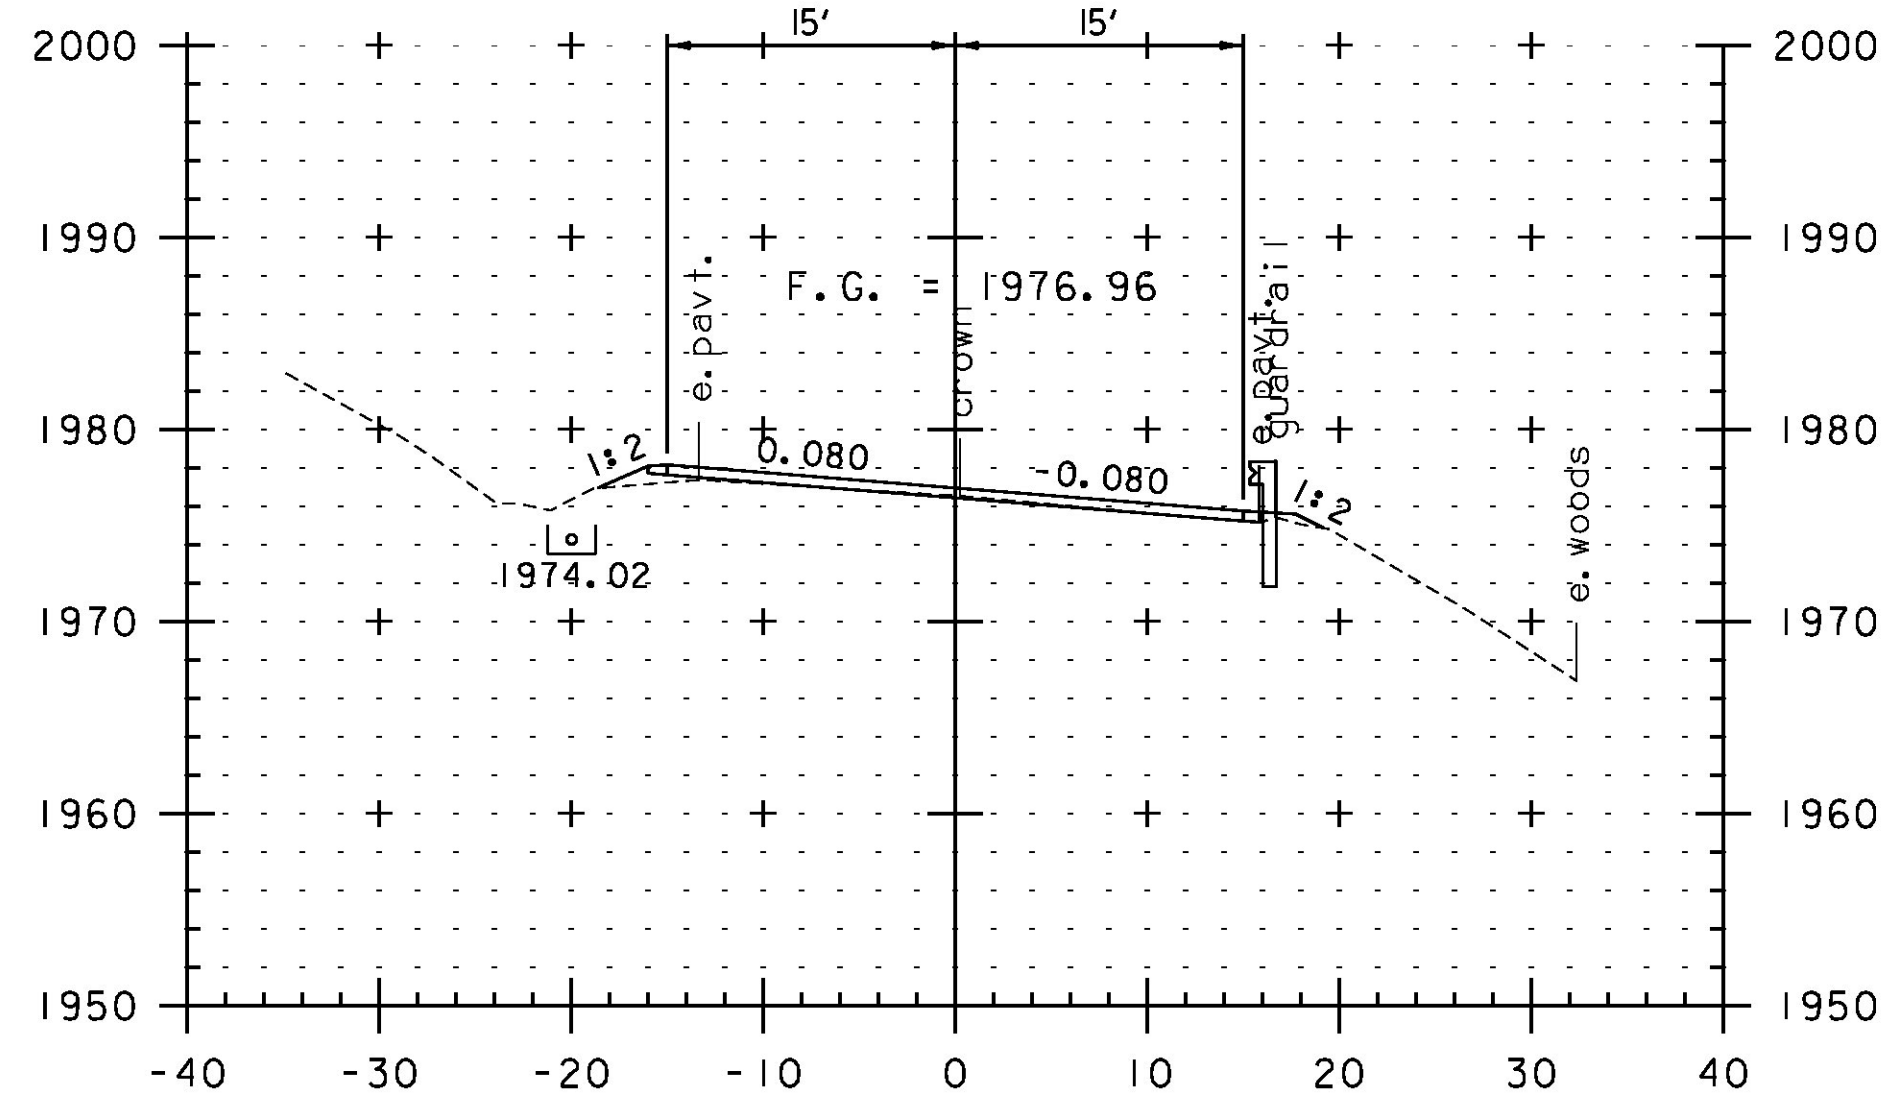


209+00

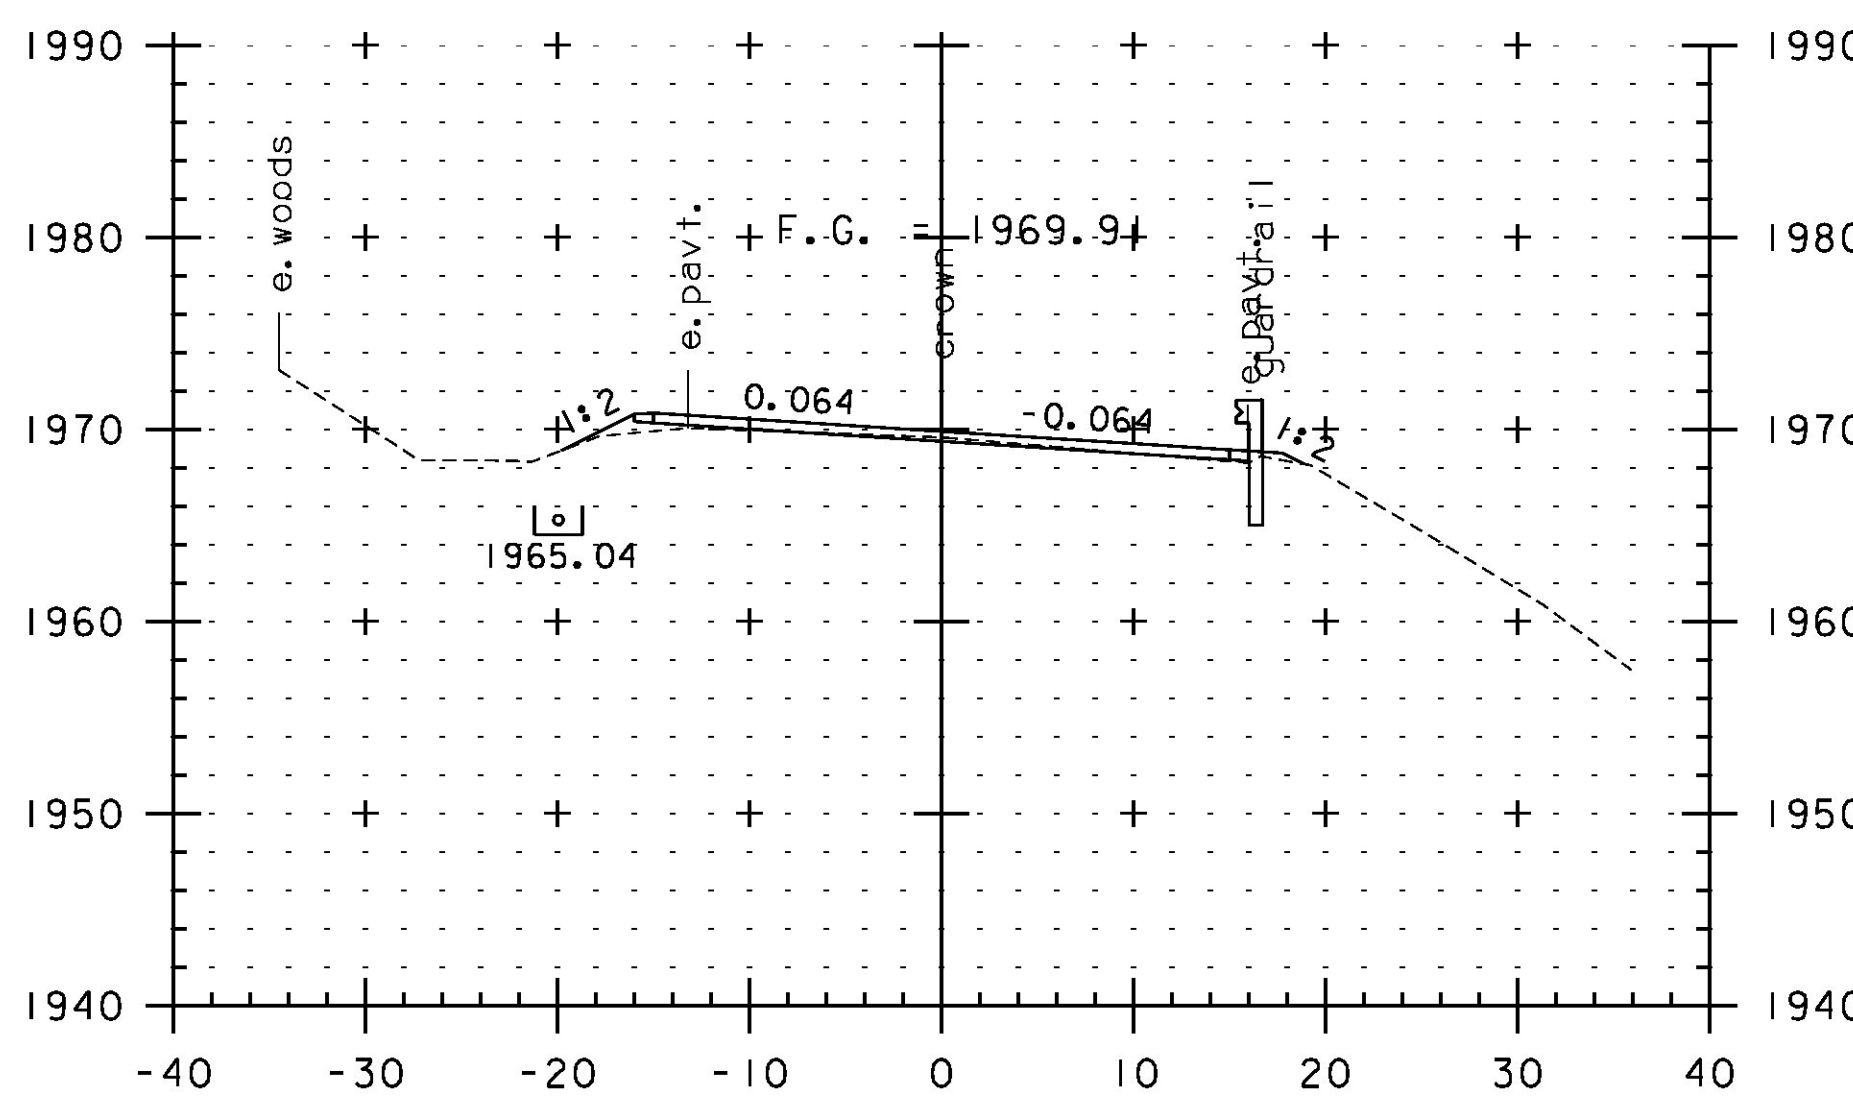

210+00

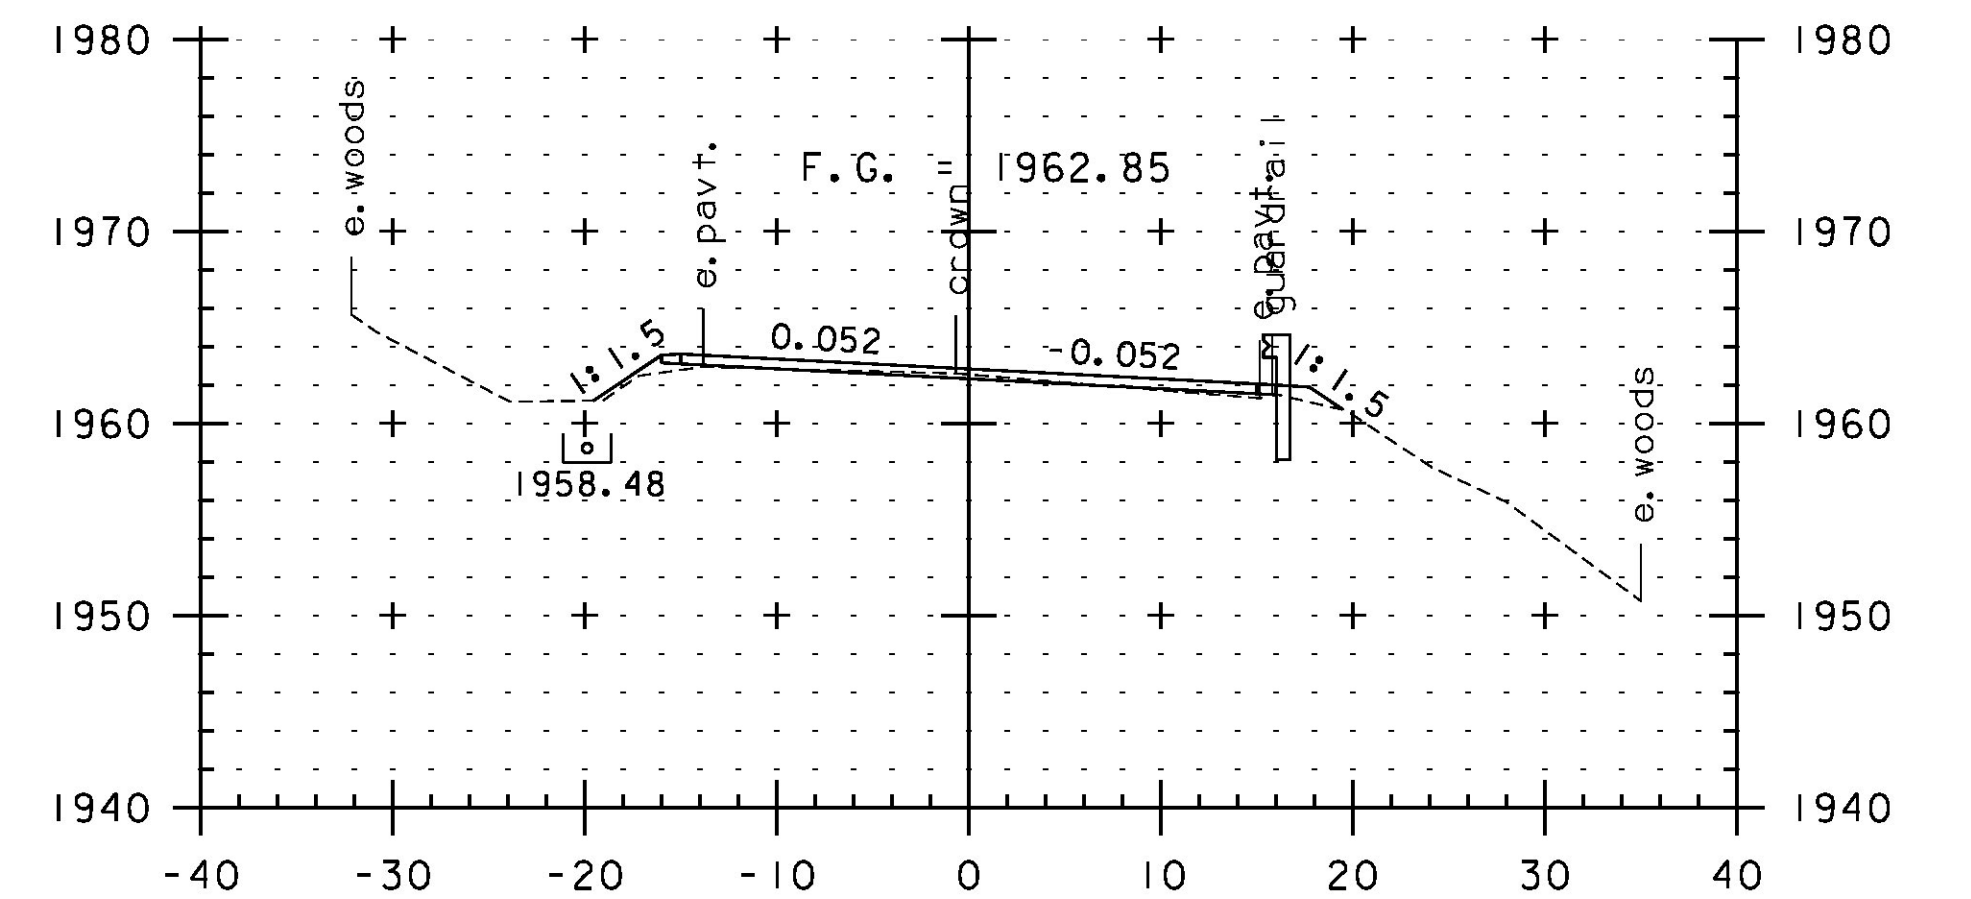

211+00

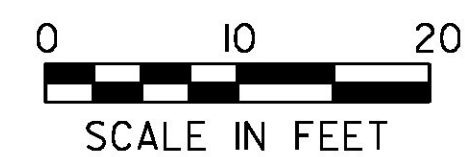

SCALE IN FEET

STA. 209+00 TO STA. 211+50

PROJECT NAME:	JAY-TROY	PLOT DATE:	5/16/2014
PROJECT NUMBER:	STP 2315(I)	DRAWN BY:	W. GORDON
FILE NAME:	z10b232xs.dgn	DESIGNED BY:	N. LEMAY
PROJECT LEADER:	P. SHEDD	CHECKED BY:	P. SHEDD
CROSS SECTION SHEET 44		SHEET	180 OF 244