




212+50

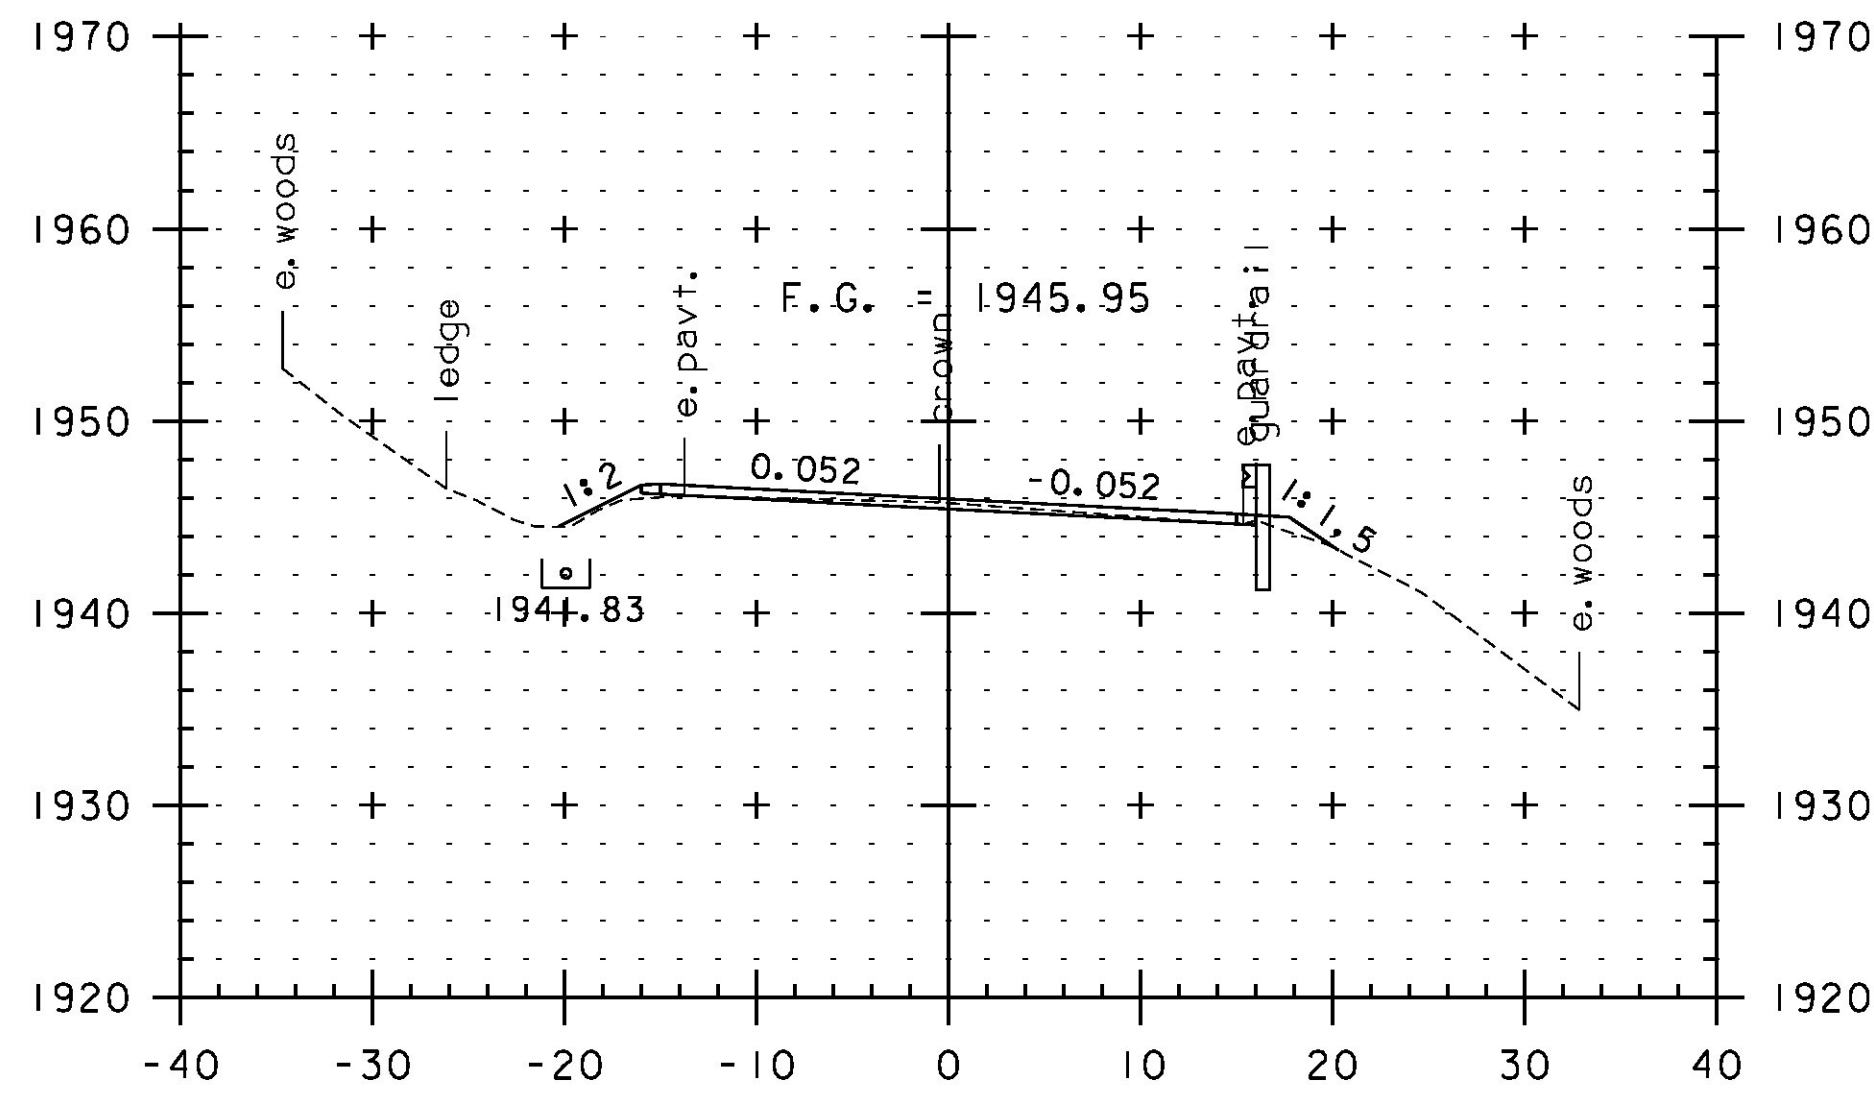


213+50

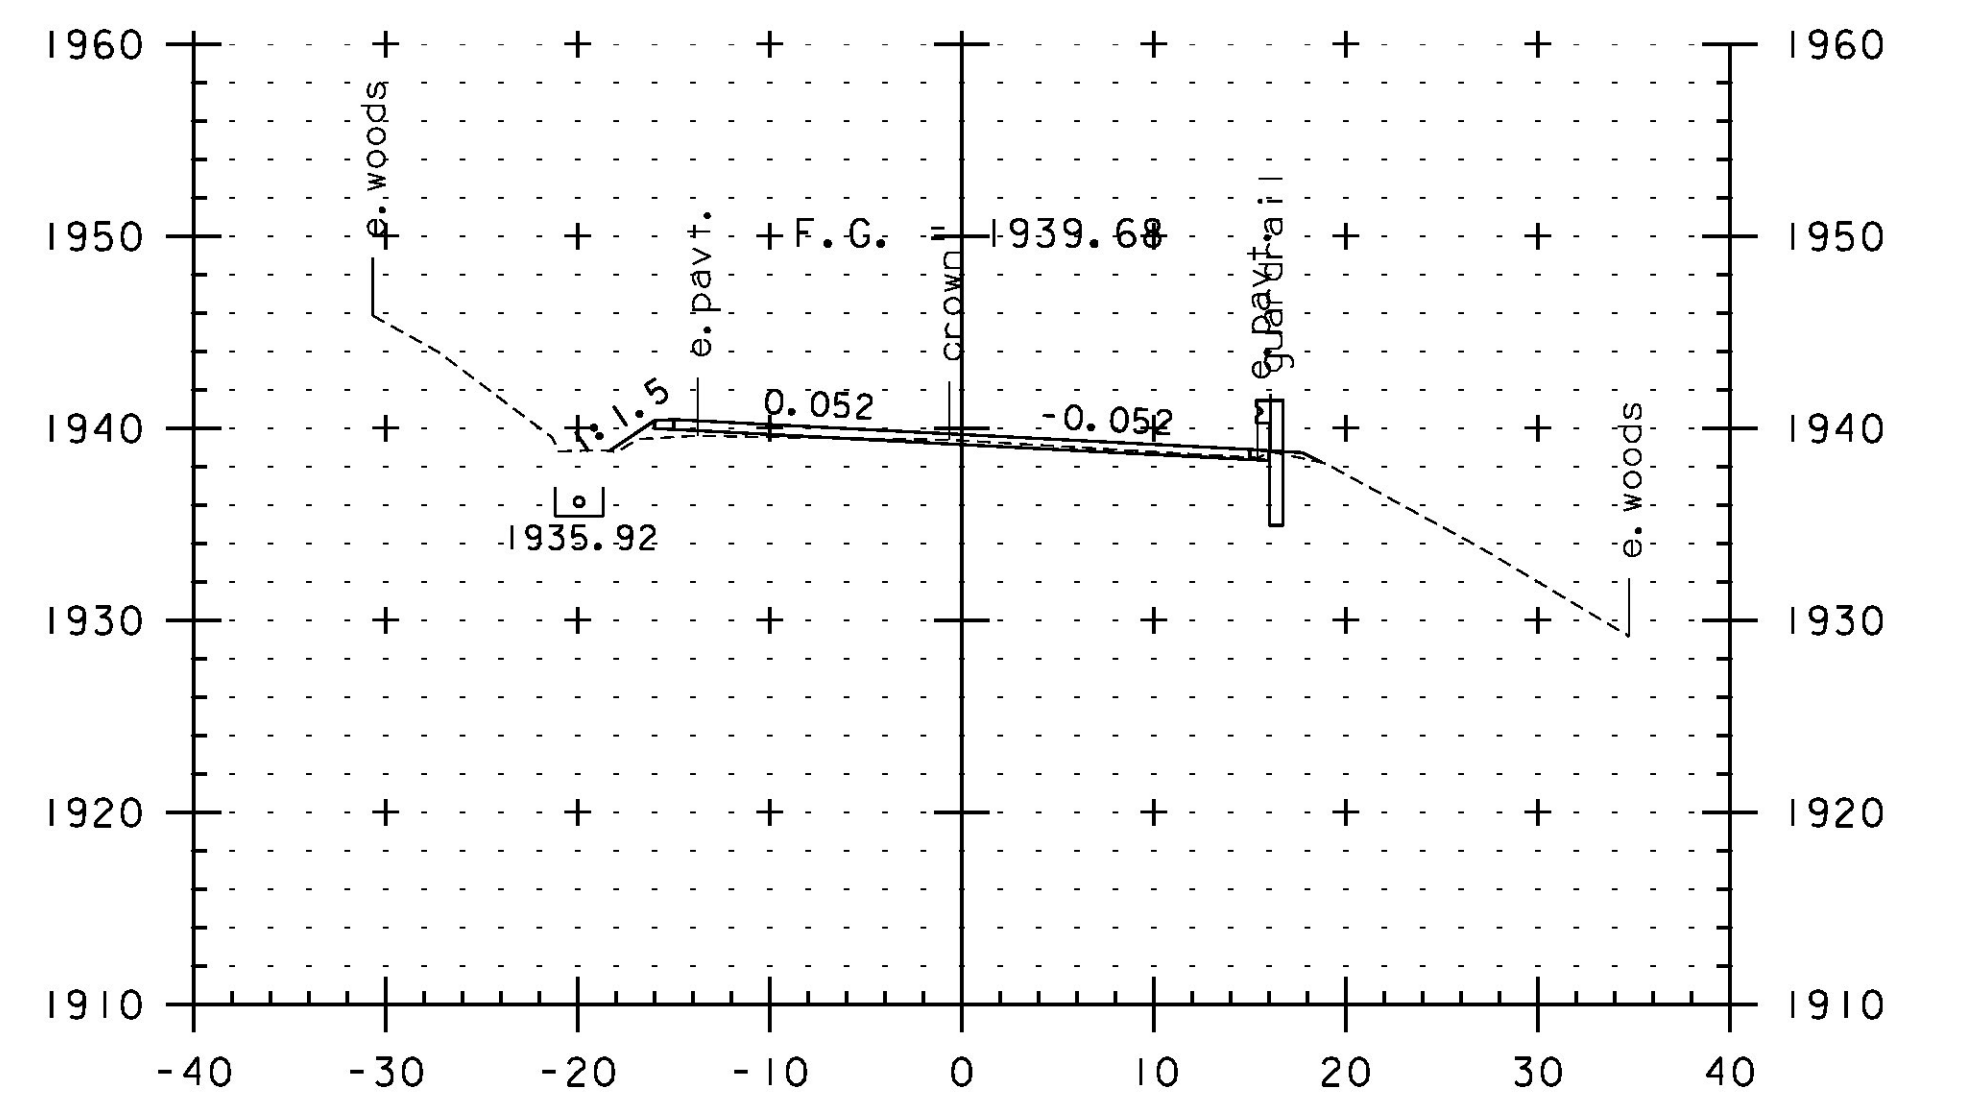


214+50

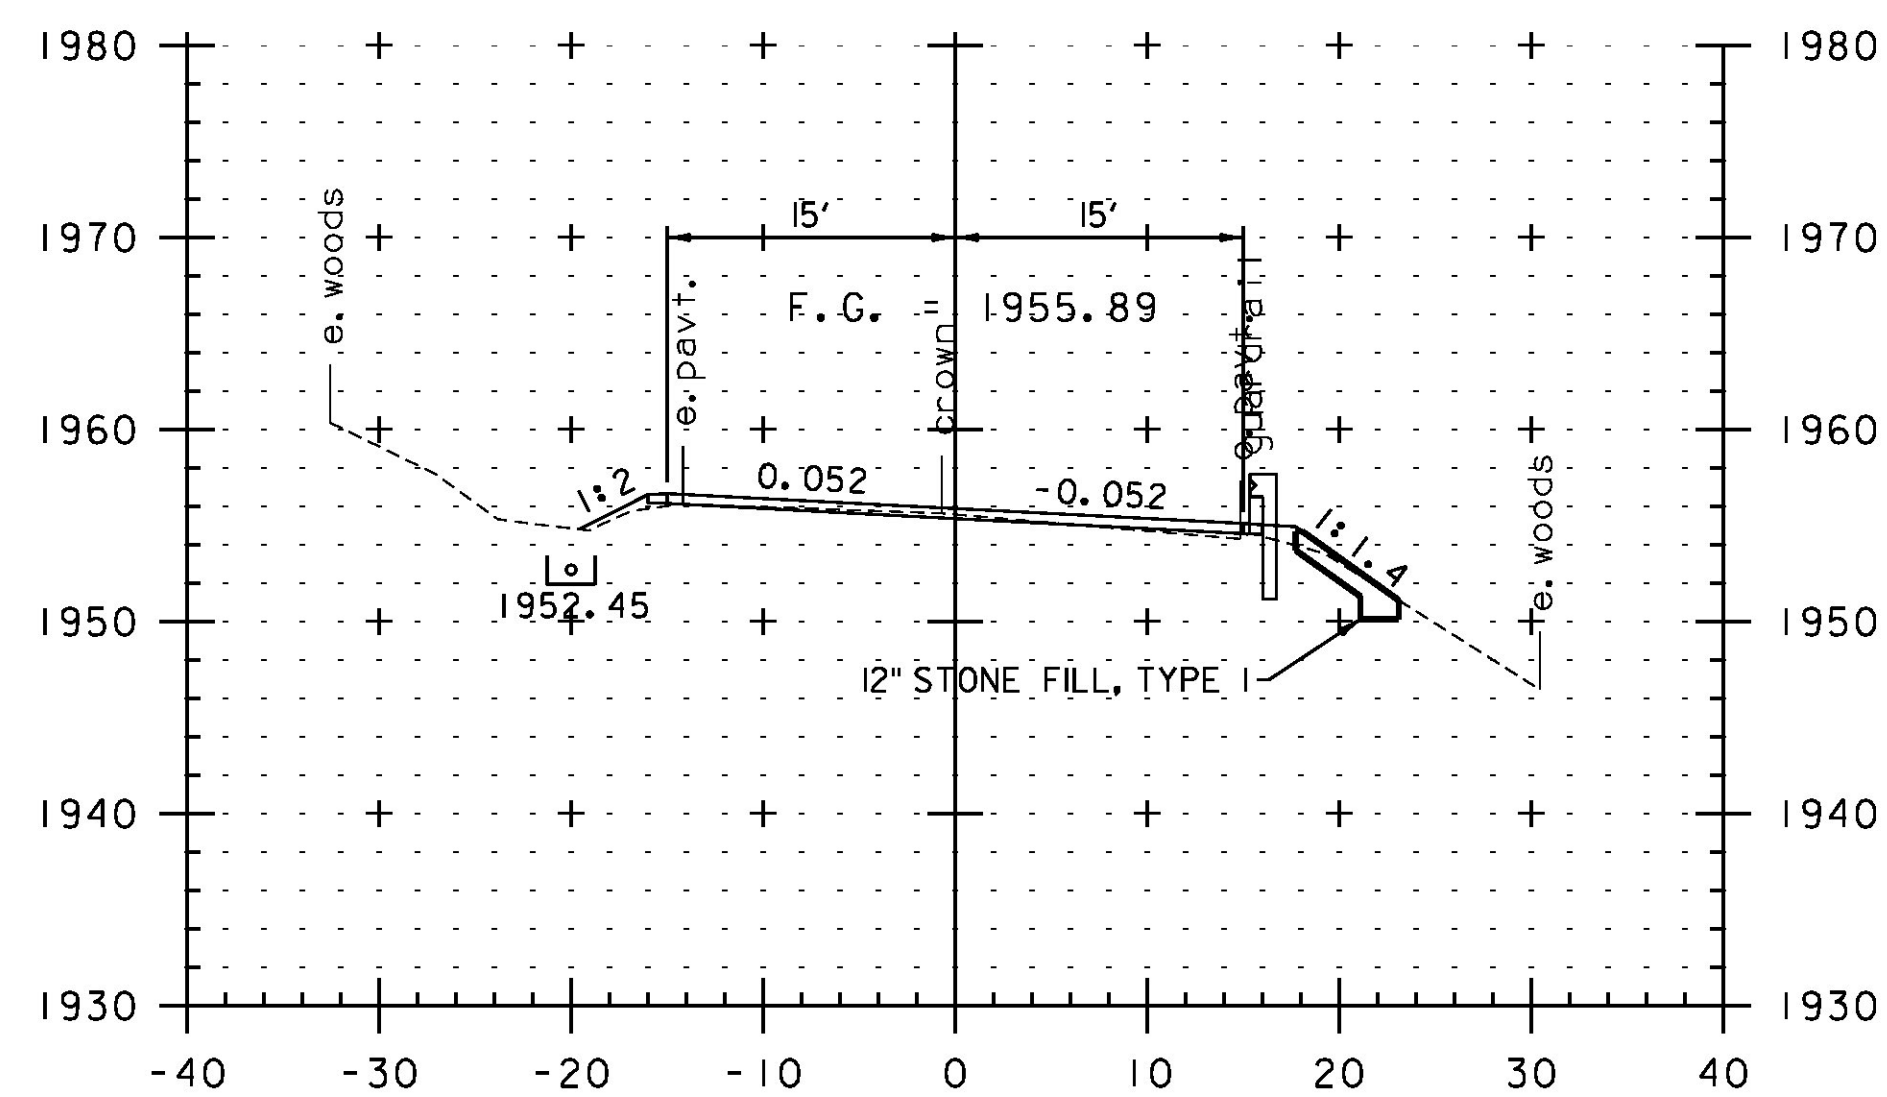


212+00

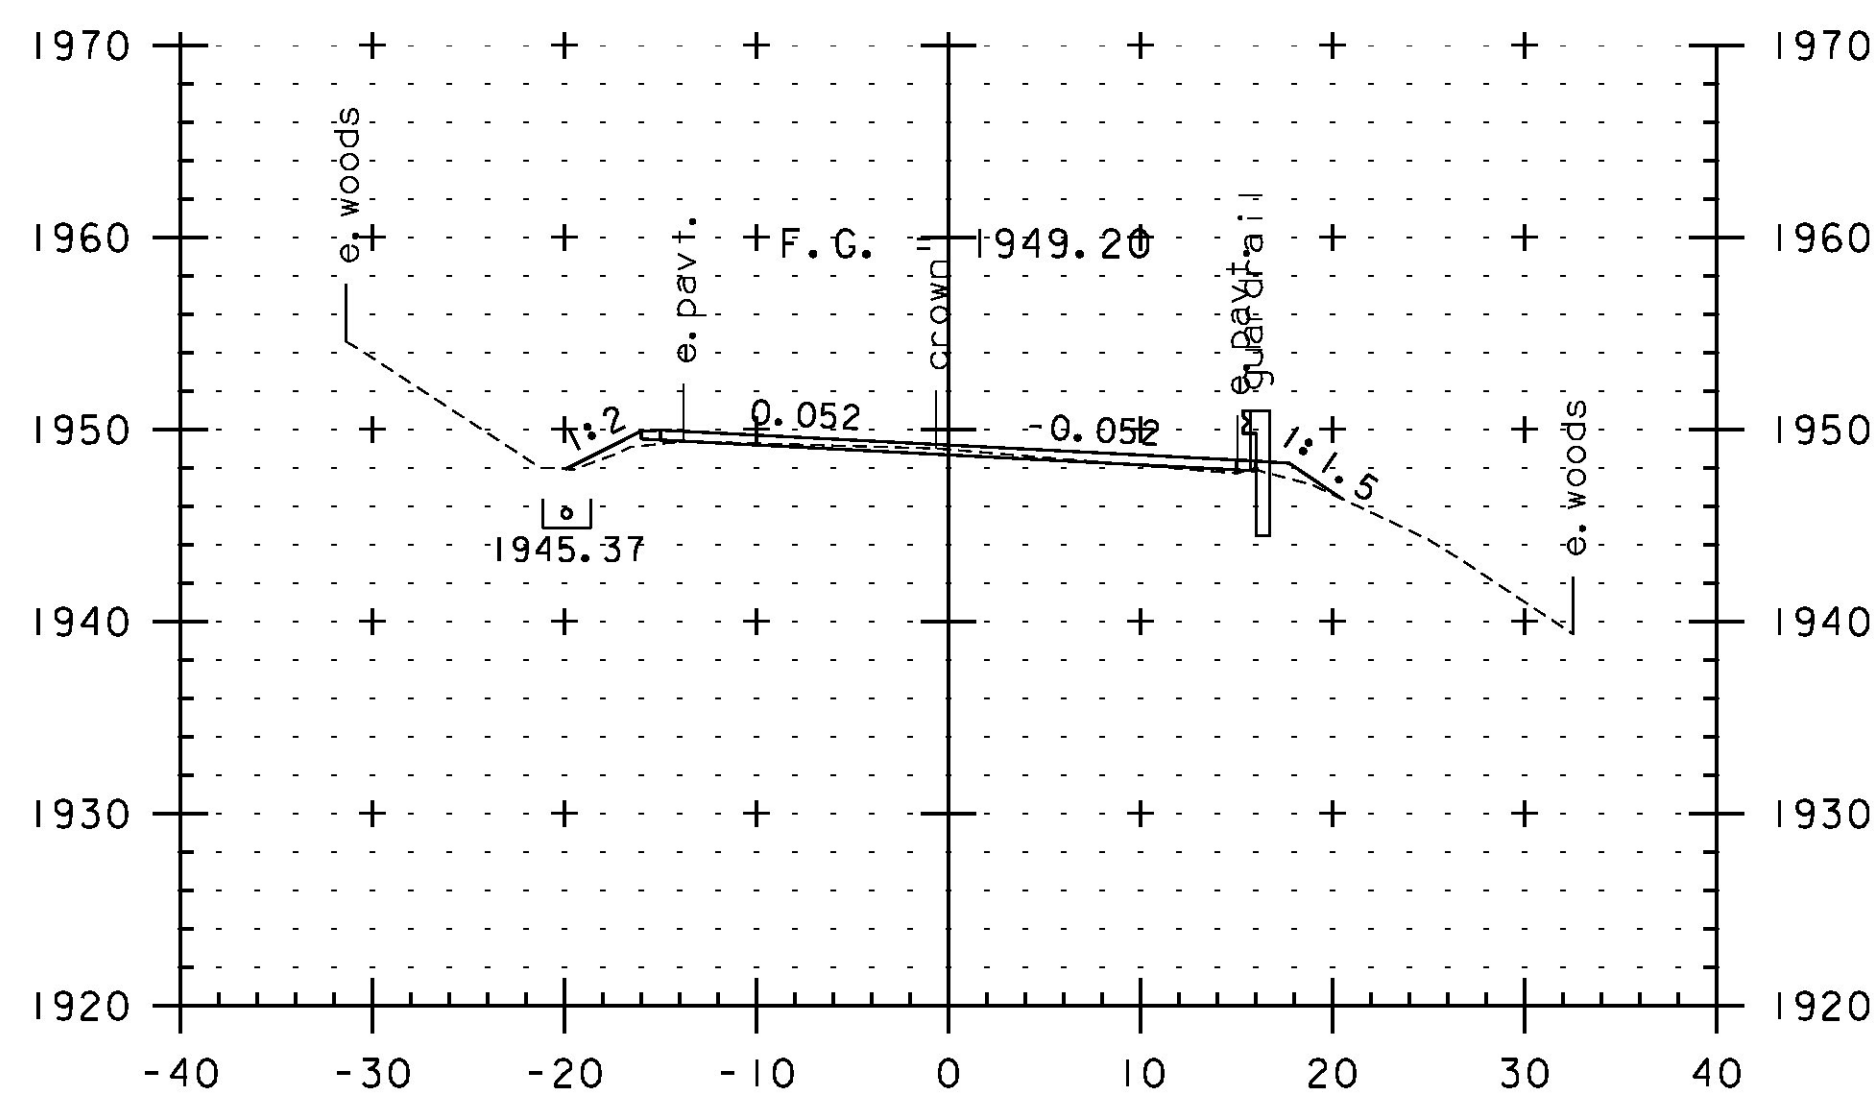

213+00

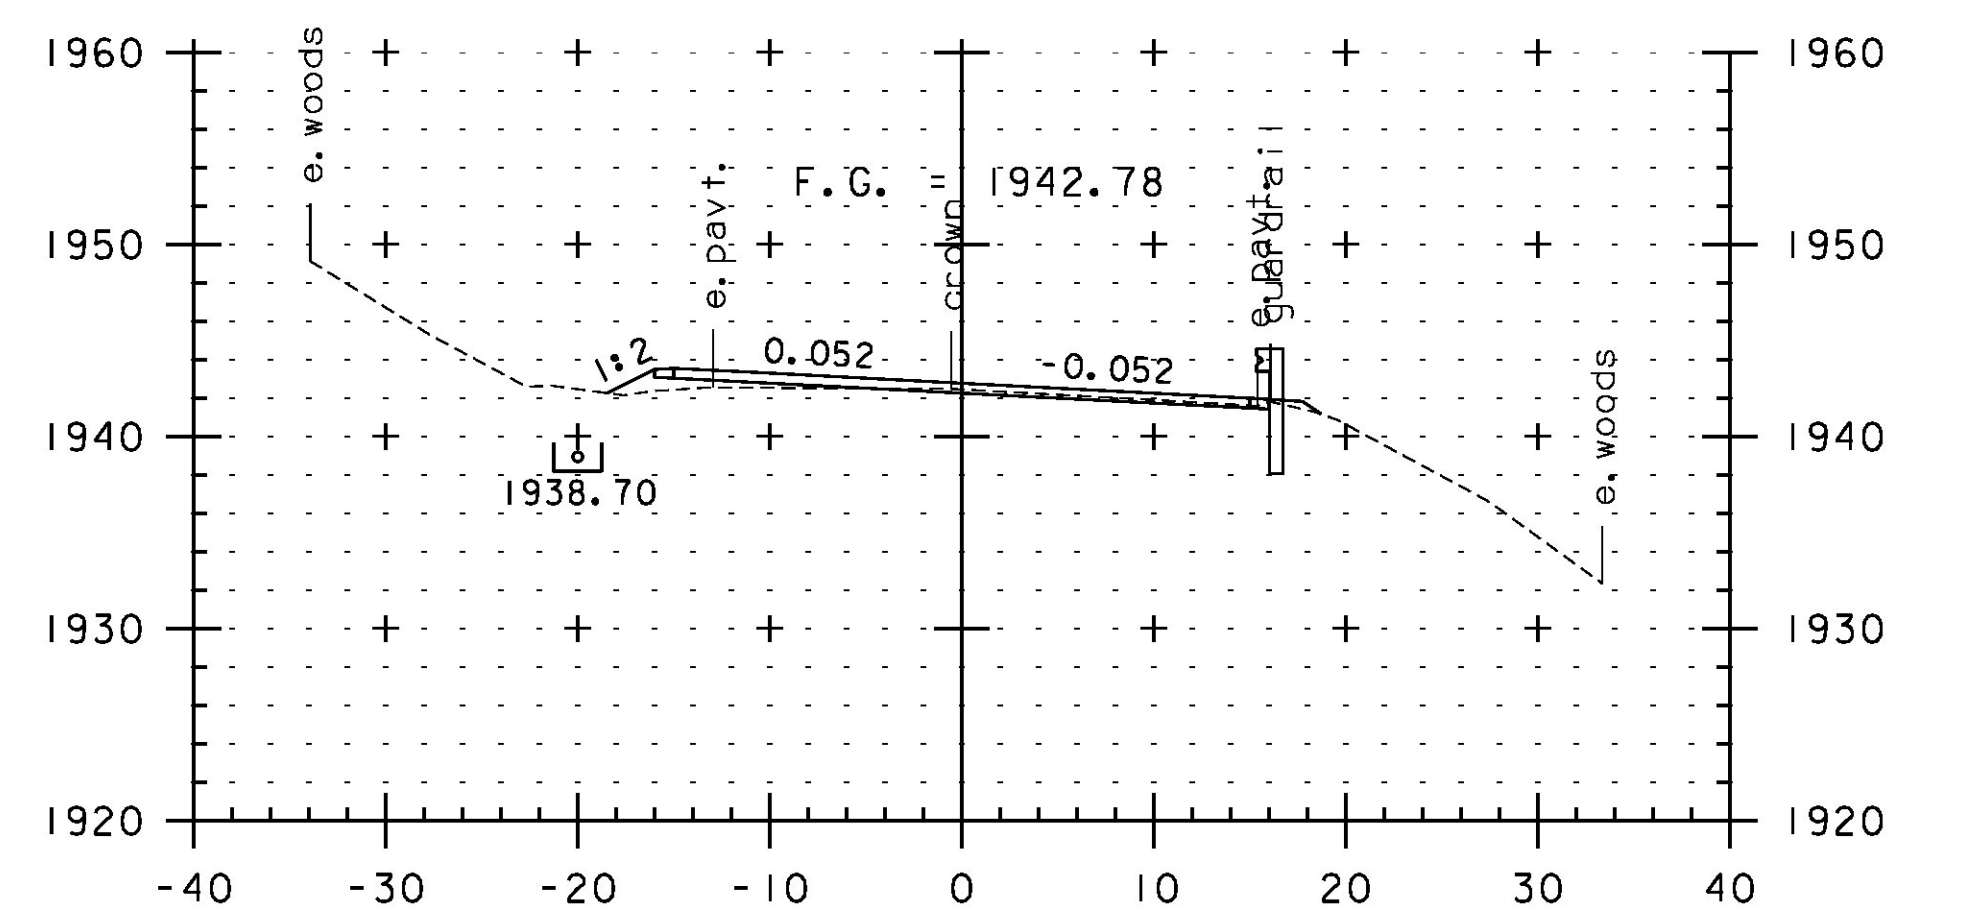

214+00

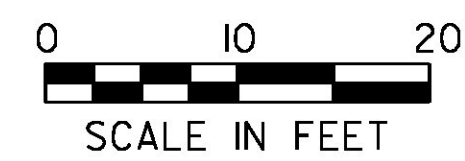

STA. 212+00 TO STA. 214+50

PROJECT NAME:	JAY-TROY	PLOT DATE:	5/16/2014
PROJECT NUMBER:	STP 2315(1)	DRAWN BY:	W. GORDON
FILE NAME:	z10b232xs.dgn	CHECKED BY:	P. SHEDD
PROJECT LEADER:	P. SHEDD	CROSS SECTION SHEET	45
DESIGNED BY:	N. LEMAY	SHEET	181 OF 244