




215+50

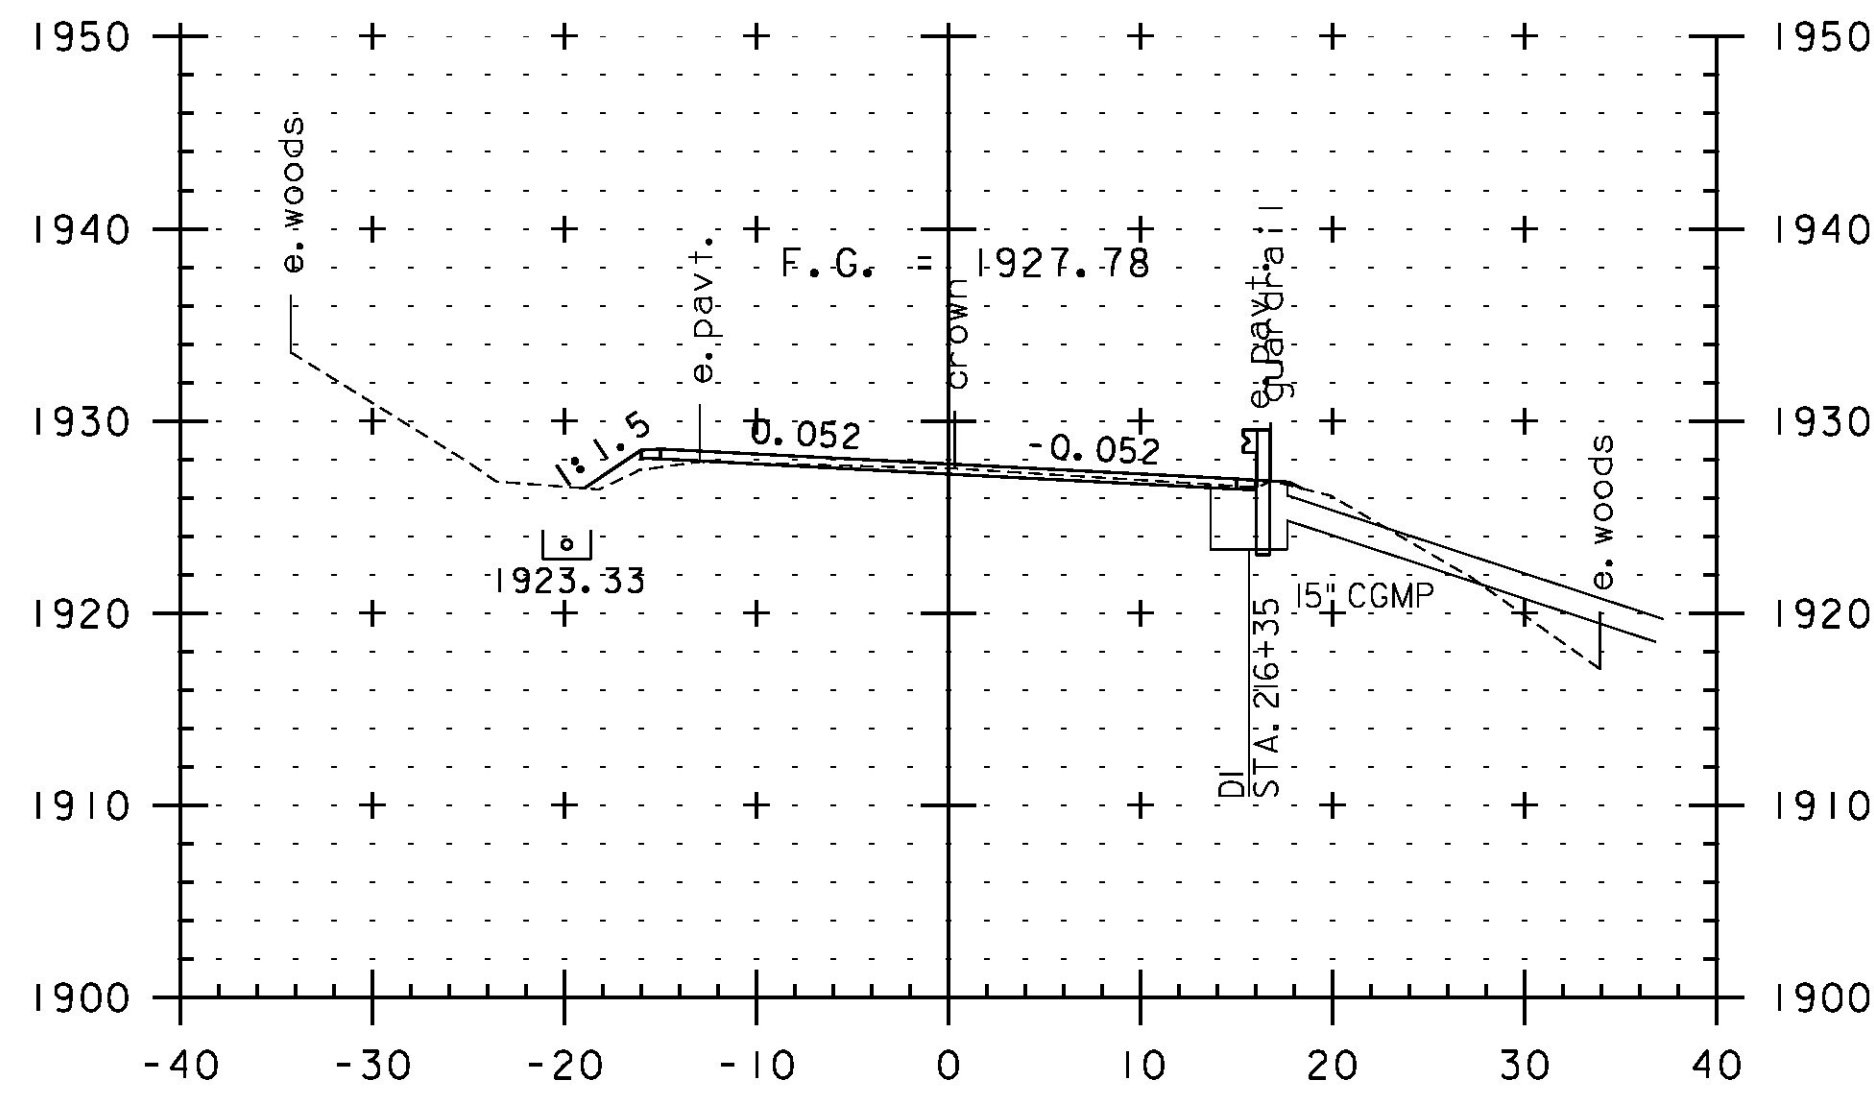


216+50

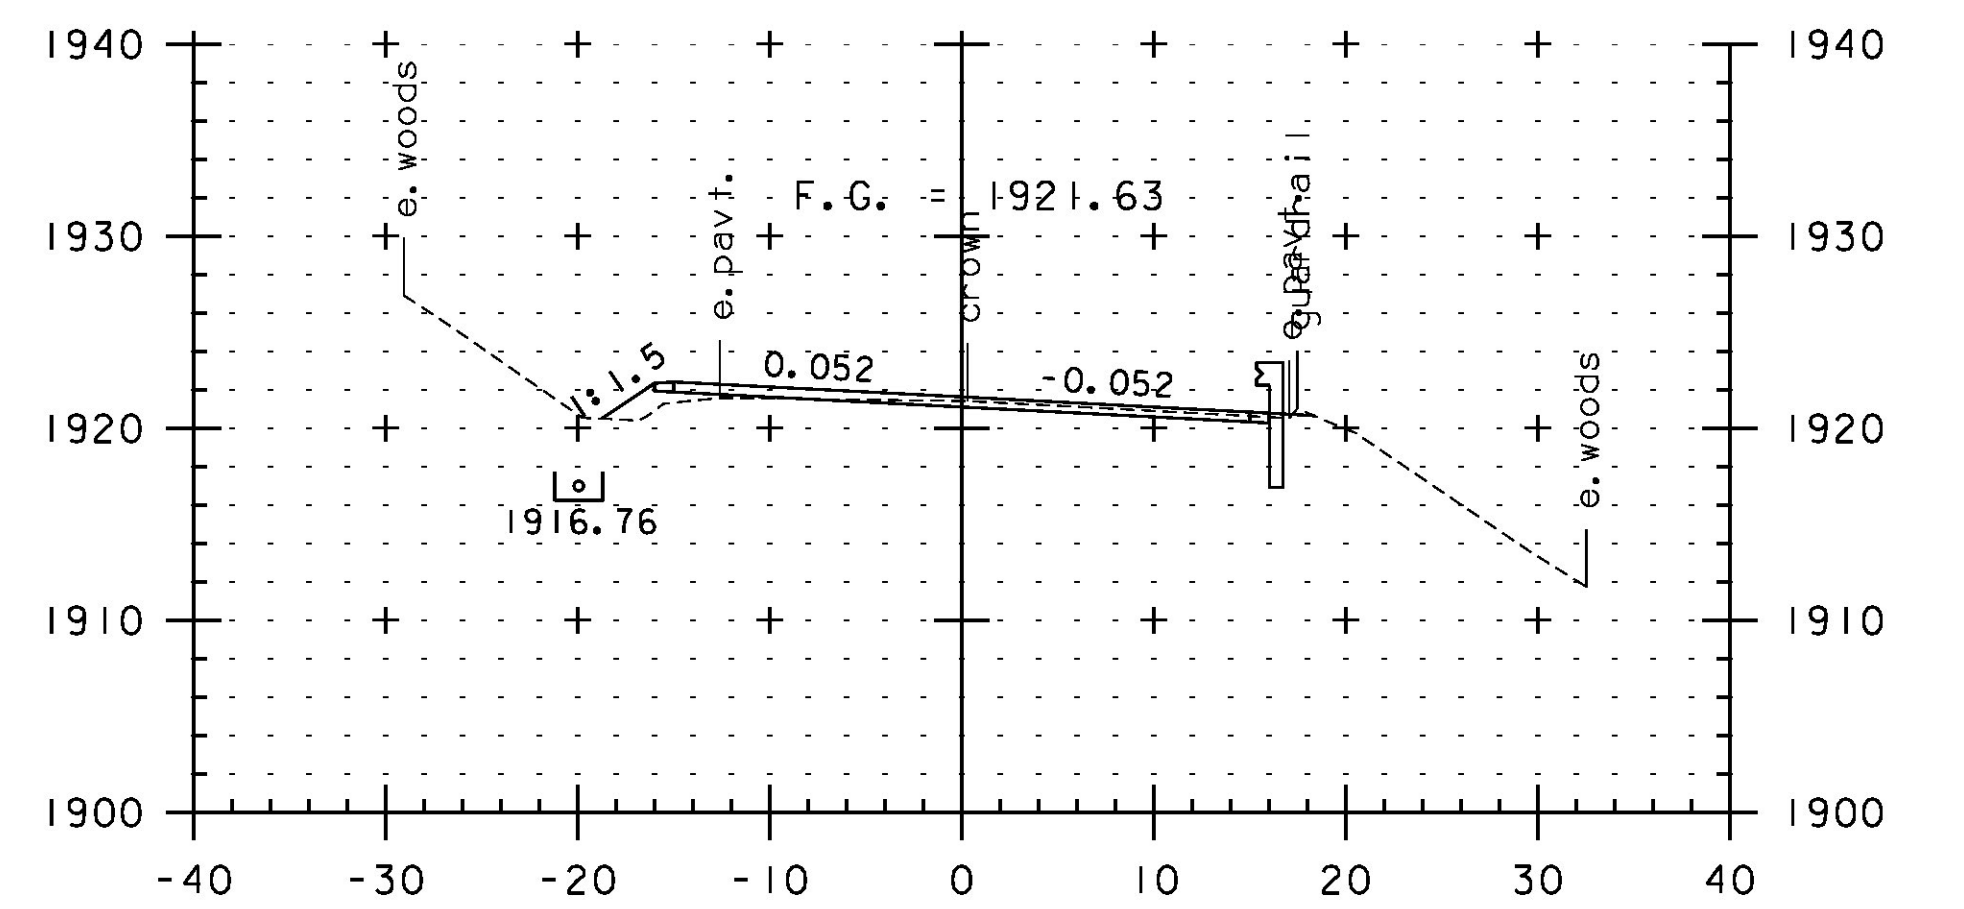


217+50

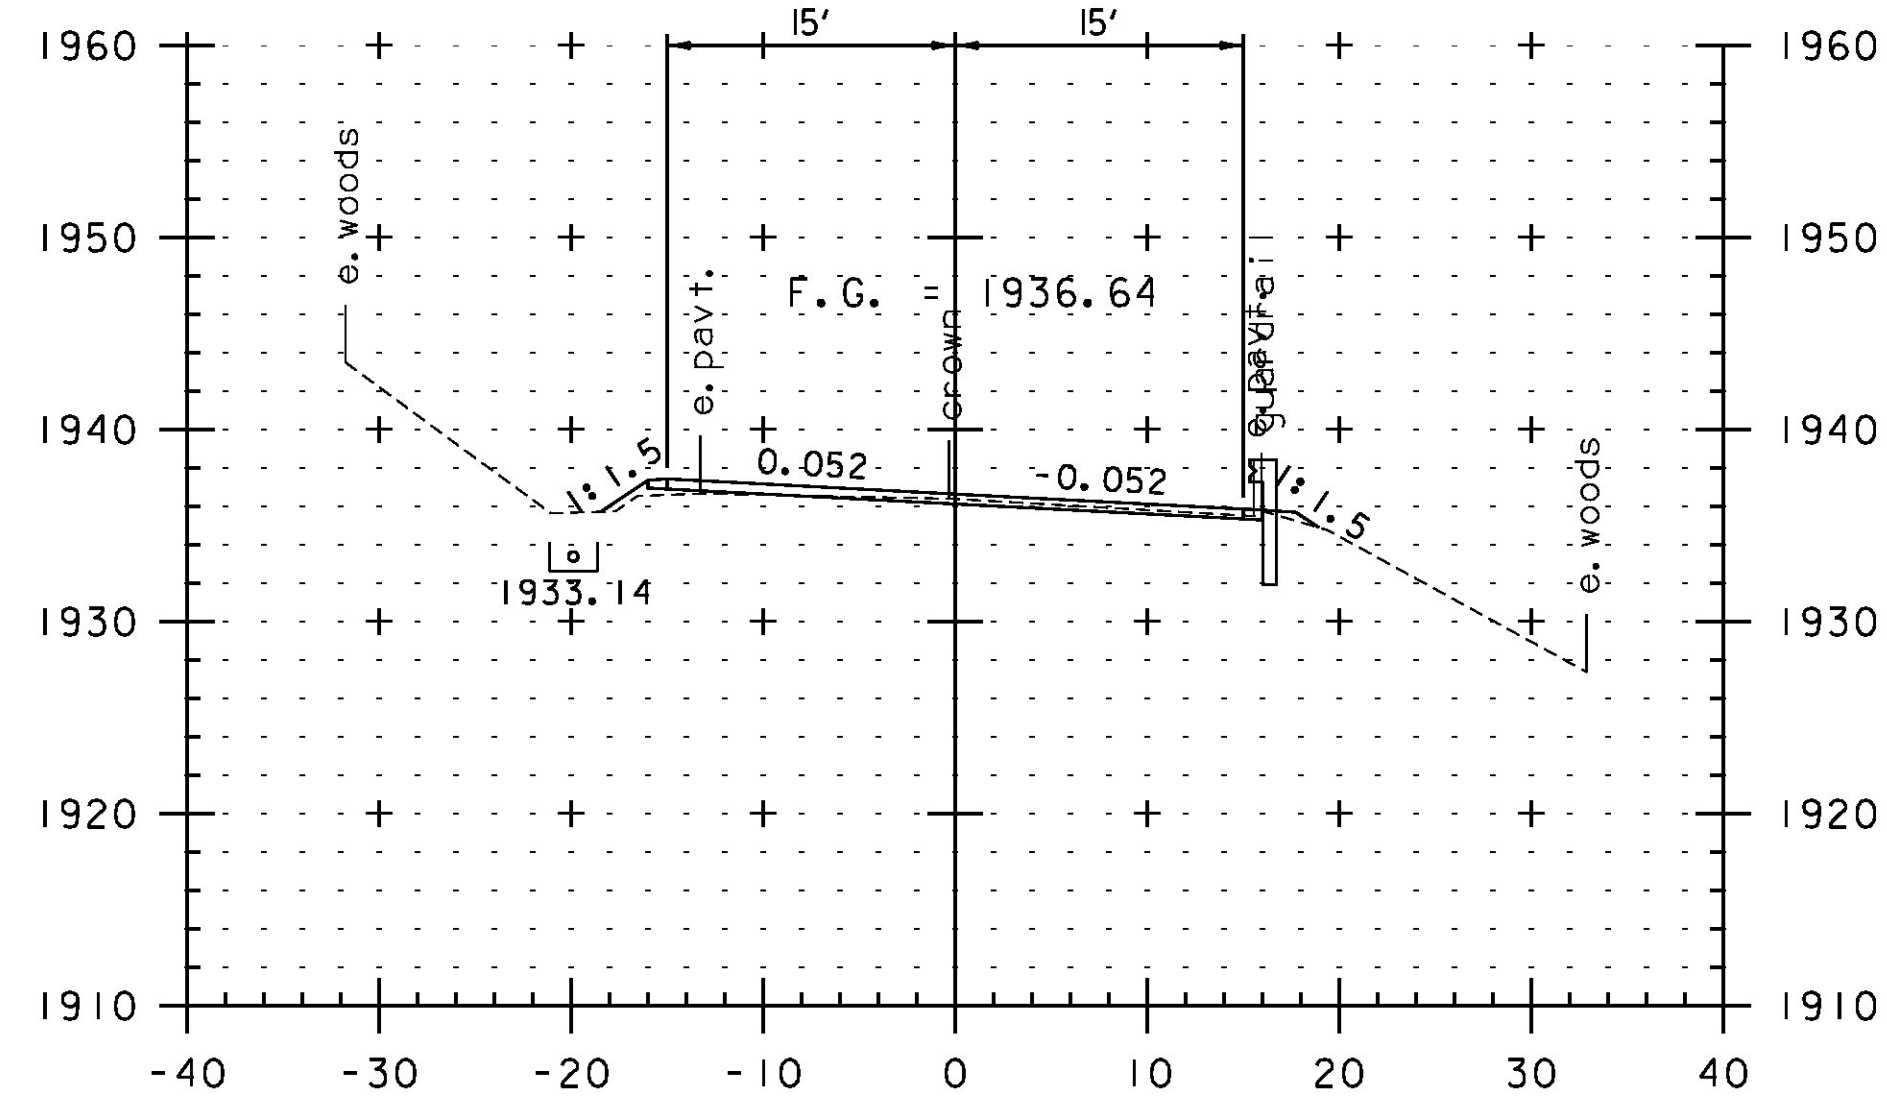


215+00

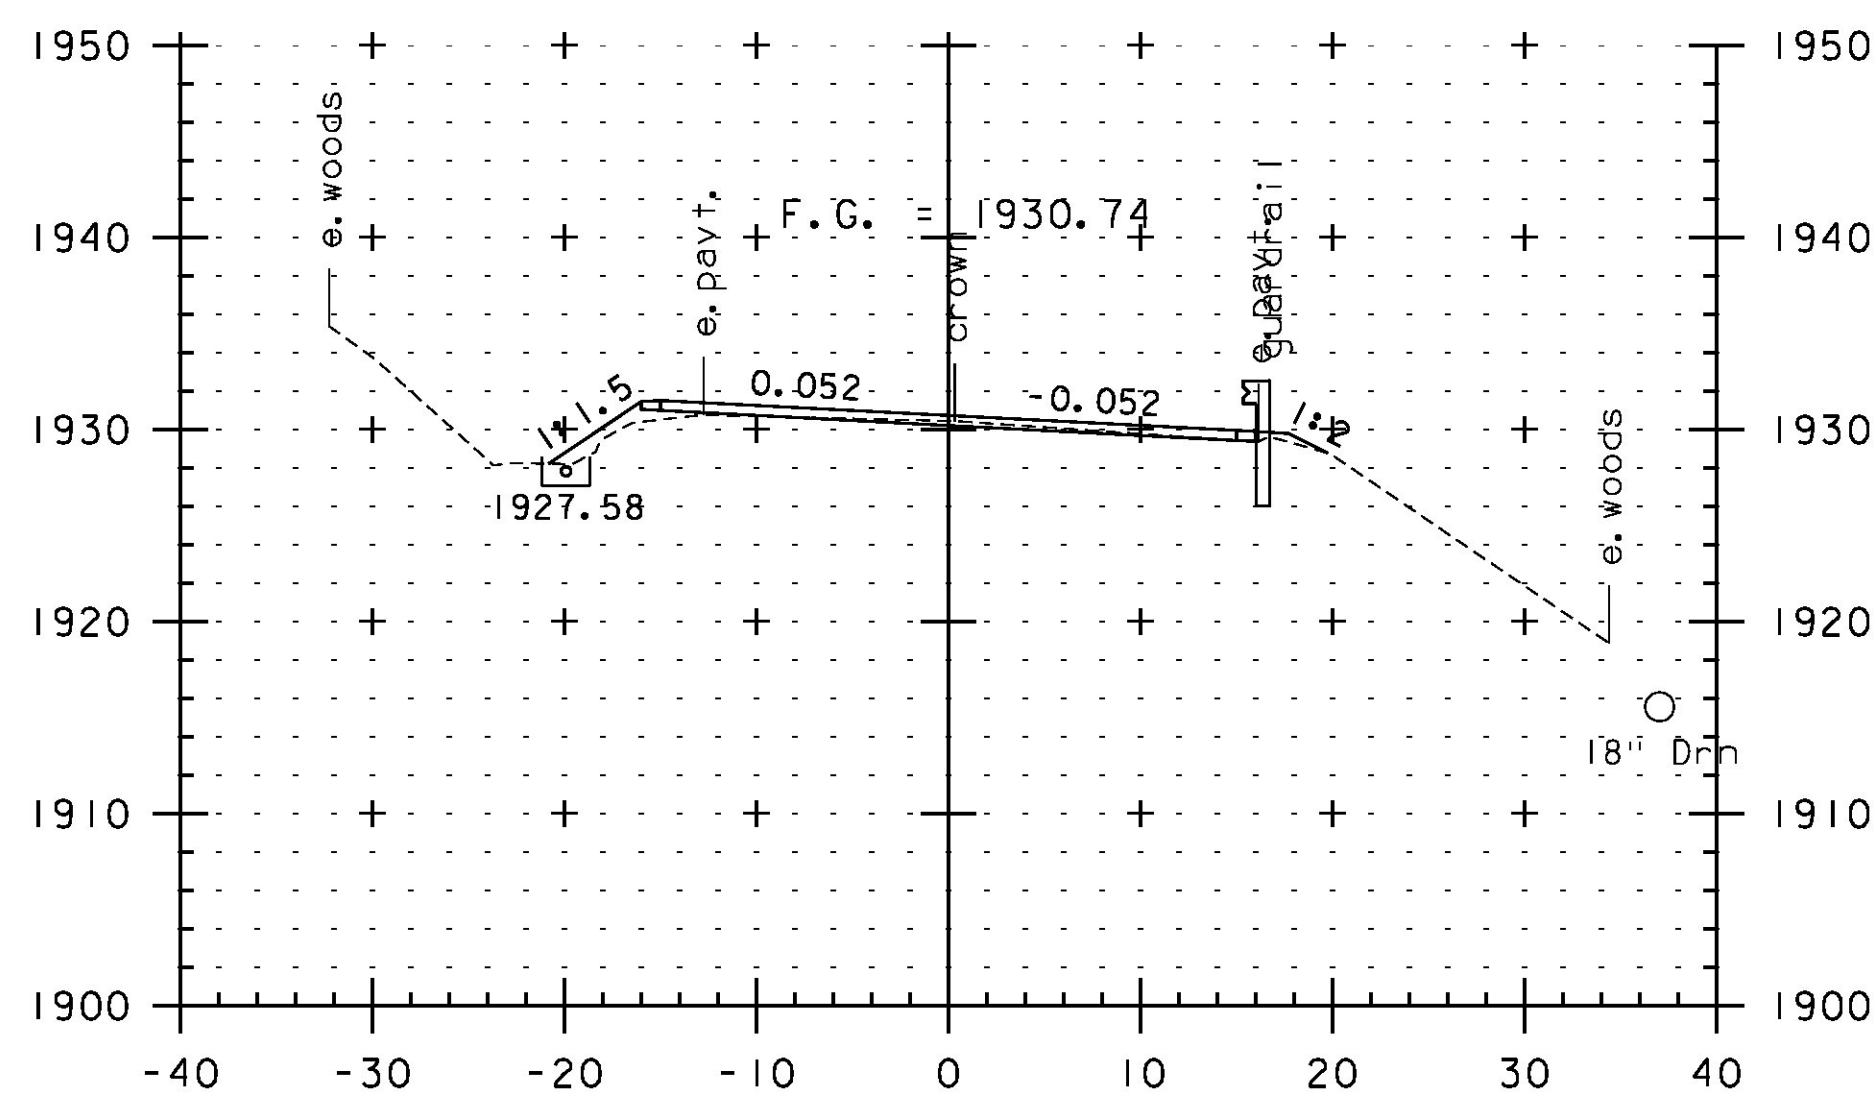

216+00

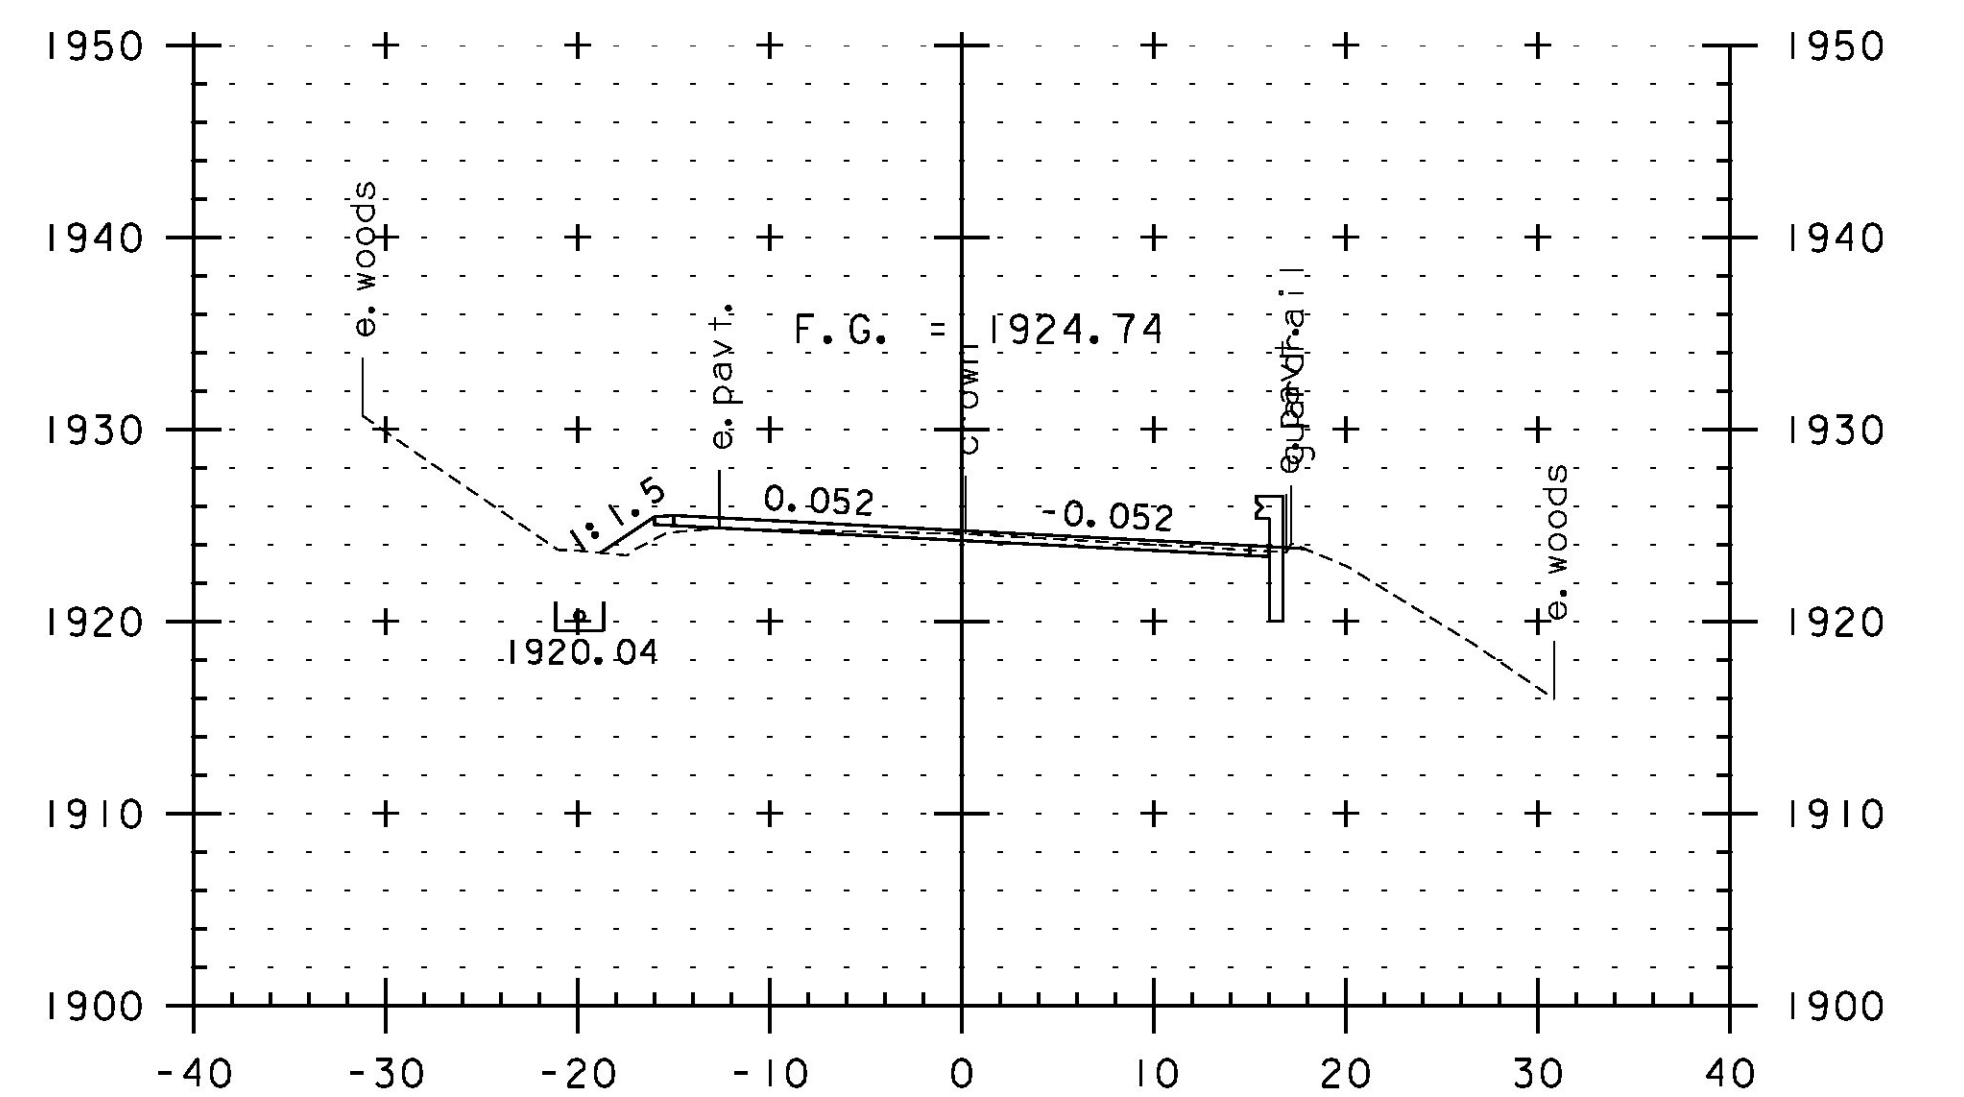

217+00

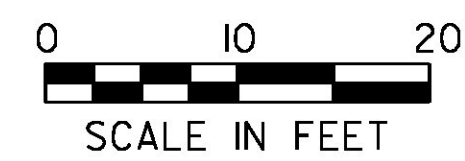

STA. 215+00 TO STA. 217+50

PROJECT NAME:	JAY-TROY	PLOT DATE:	5/16/2014
PROJECT NUMBER:	STP 2315(I)	DRAWN BY:	W. GORDON
FILE NAME:	z10b232xs.dgn	DESIGNED BY:	N. LEMAY
PROJECT LEADER:	P. SHEDD	CHECKED BY:	P. SHEDD
CROSS SECTION SHEET	46	SHEET	182 OF 244