




225+00

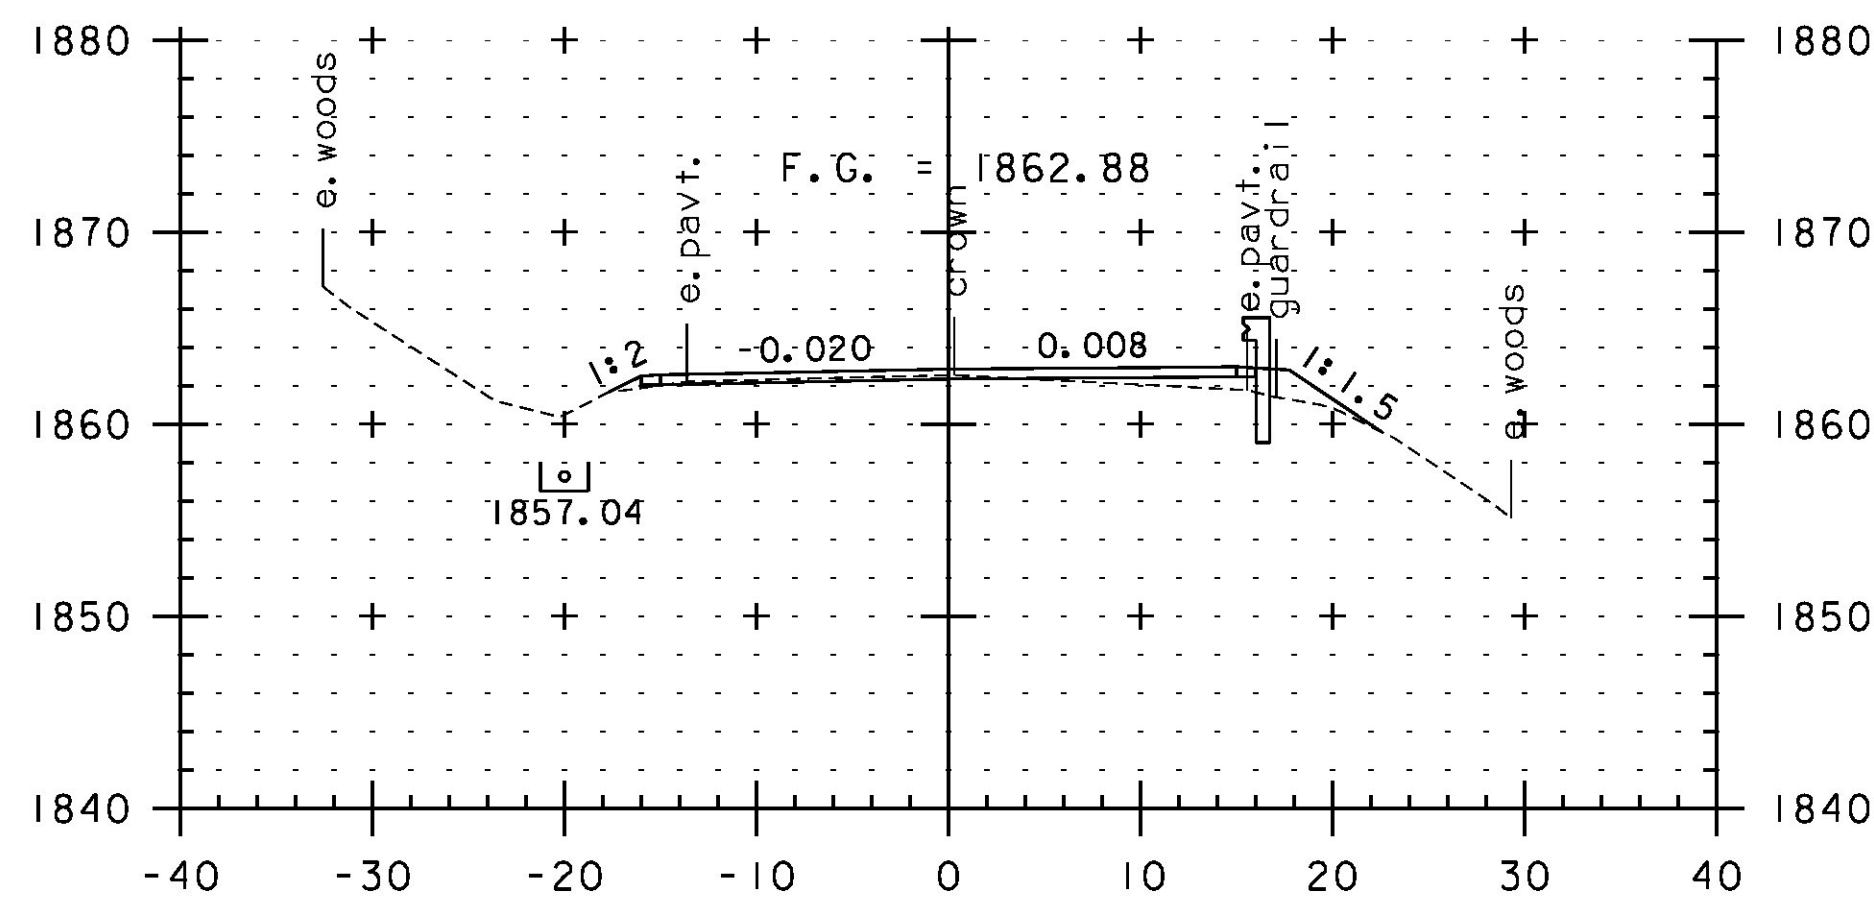


226+00

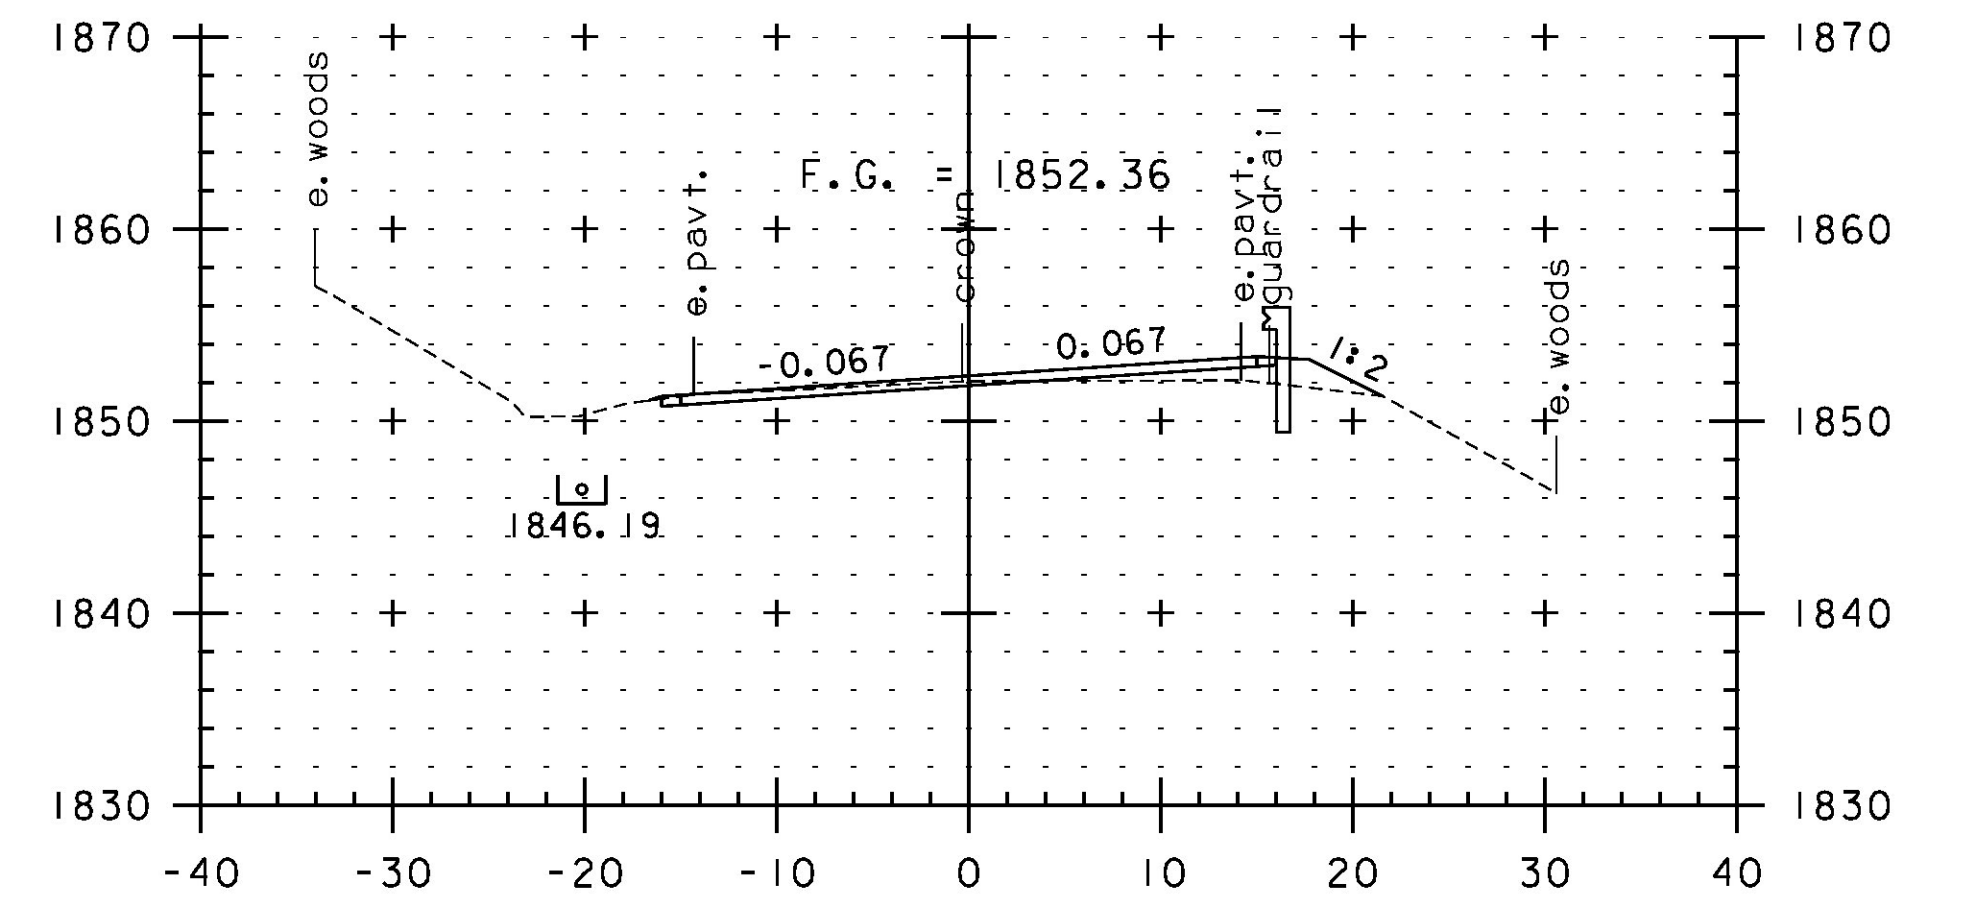


227+50

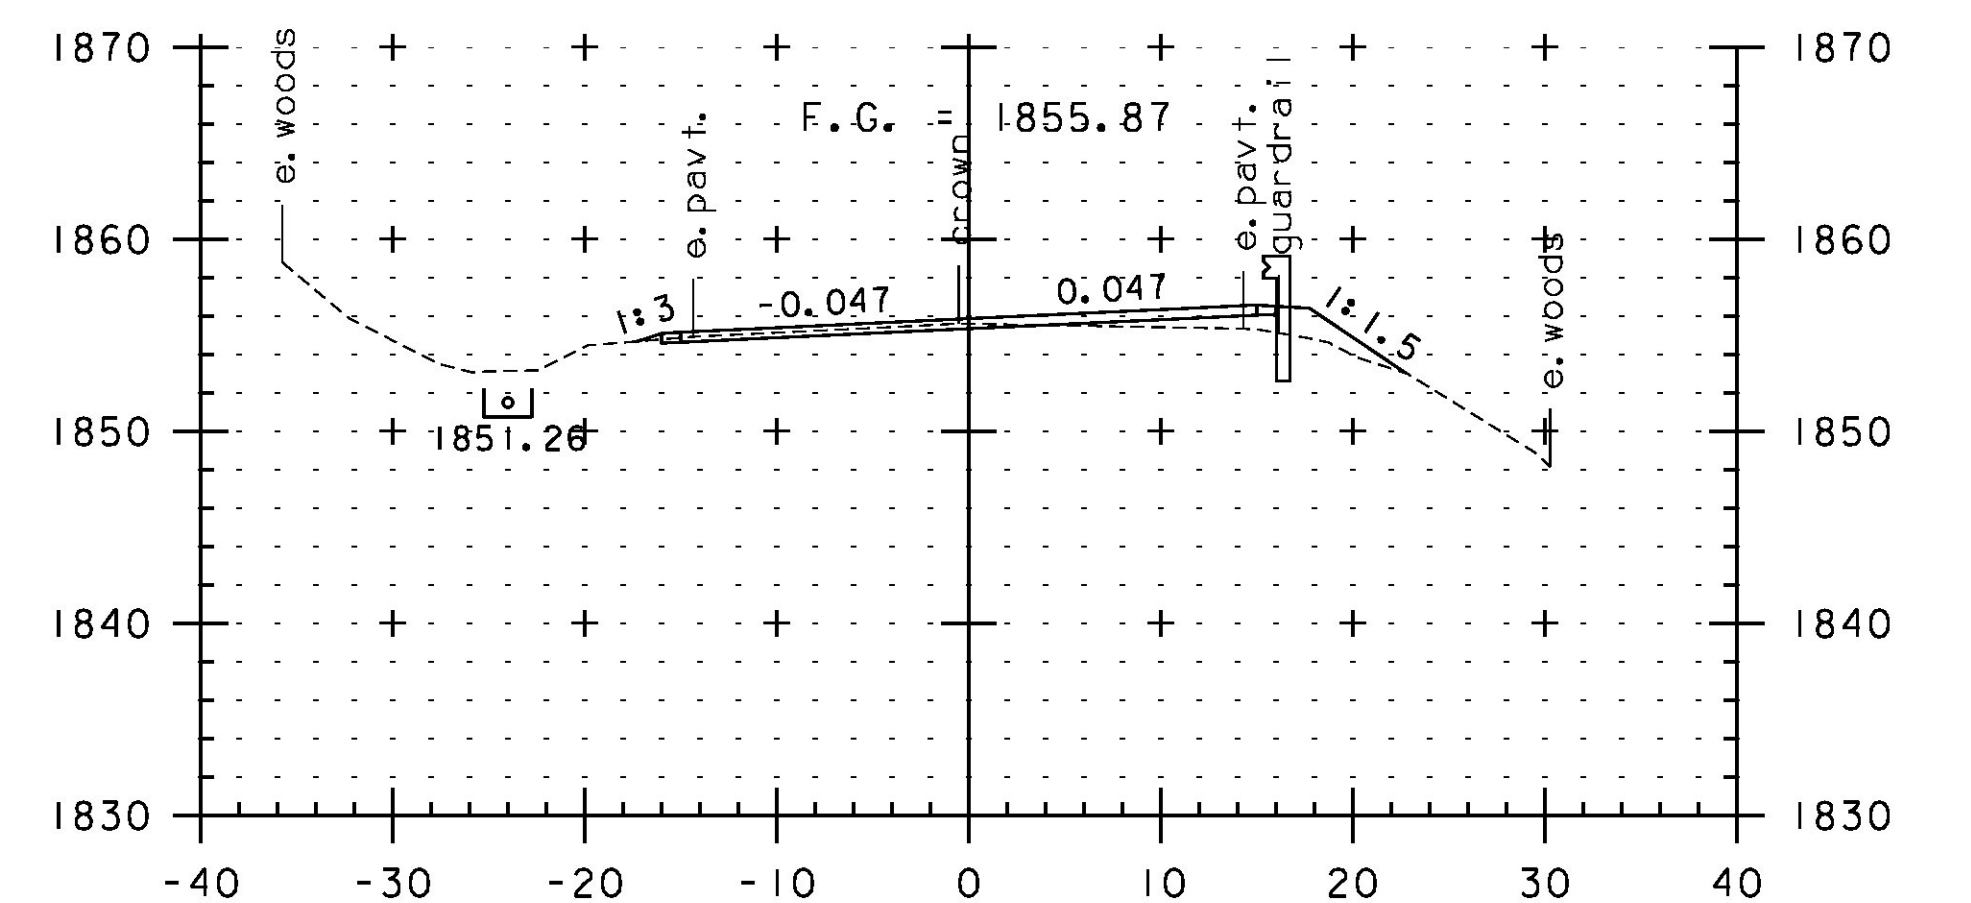


227+00

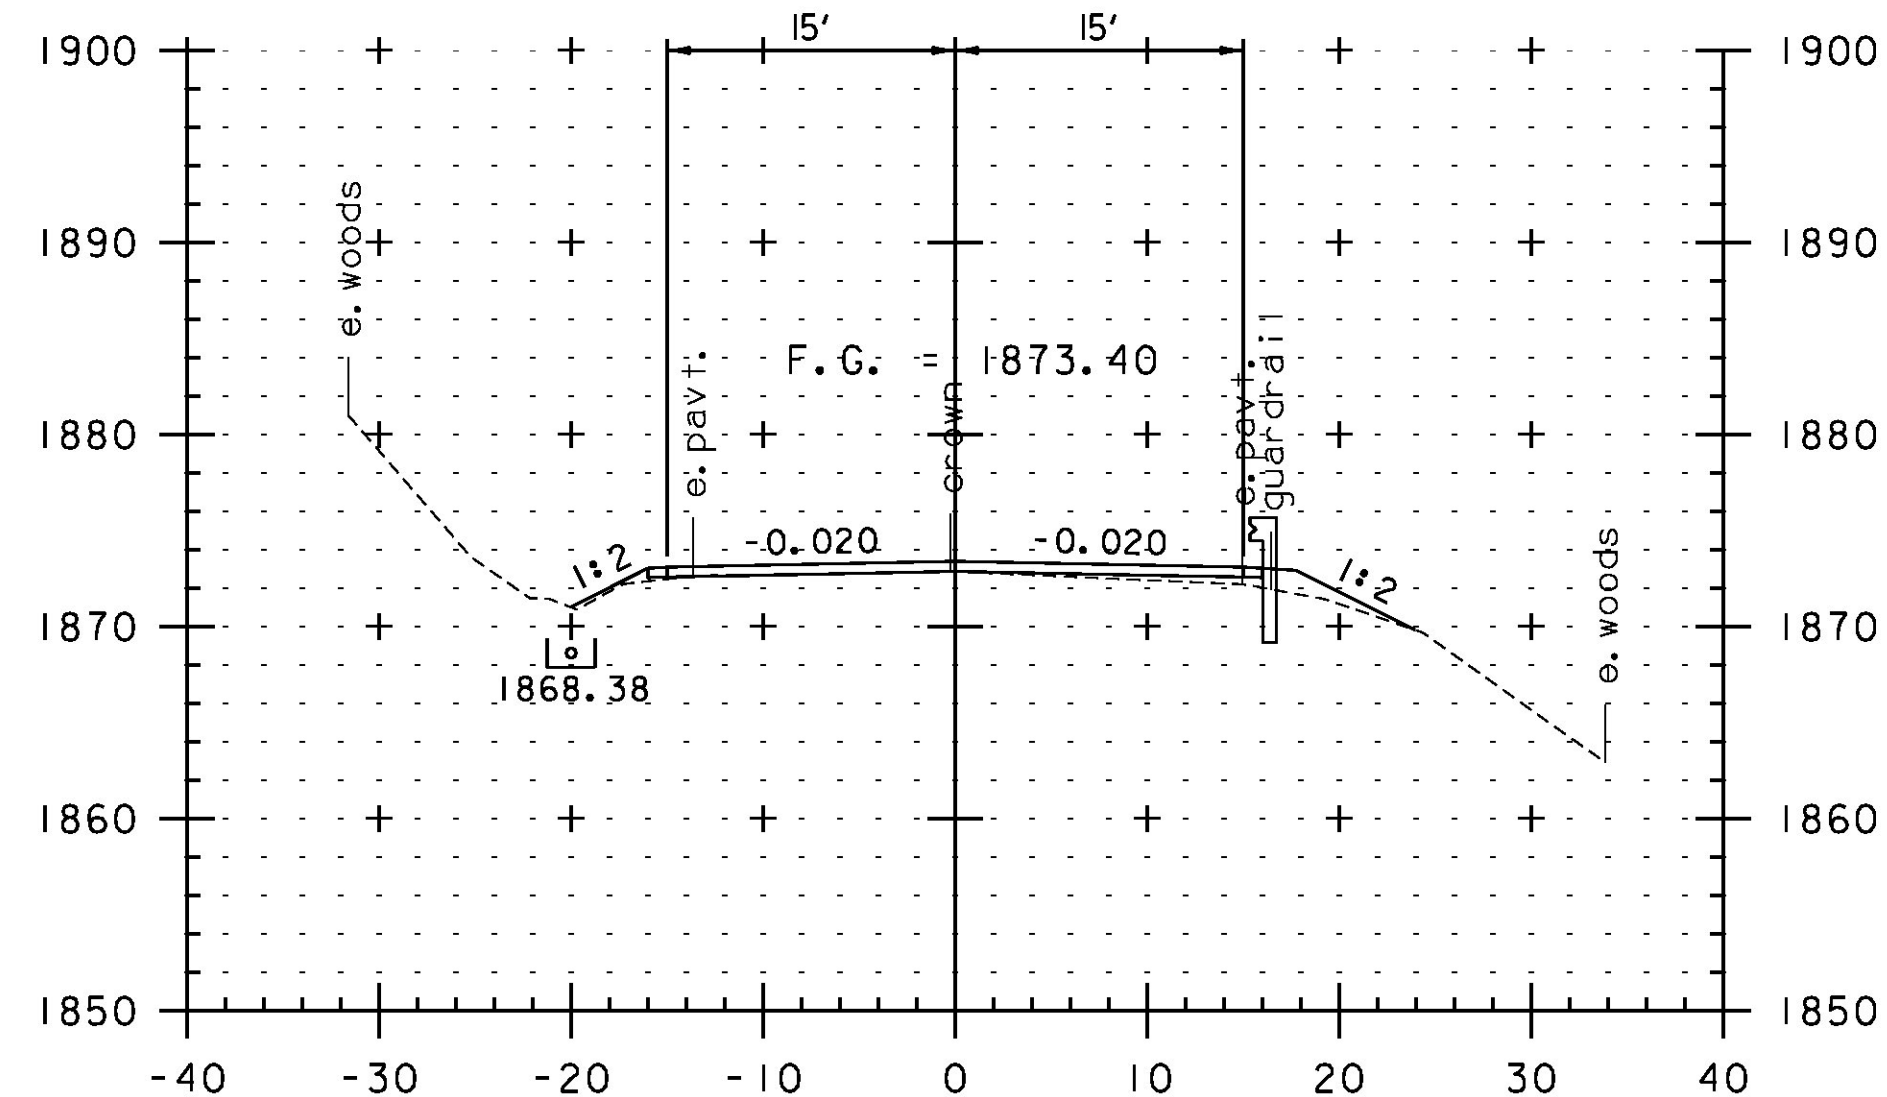


224+50

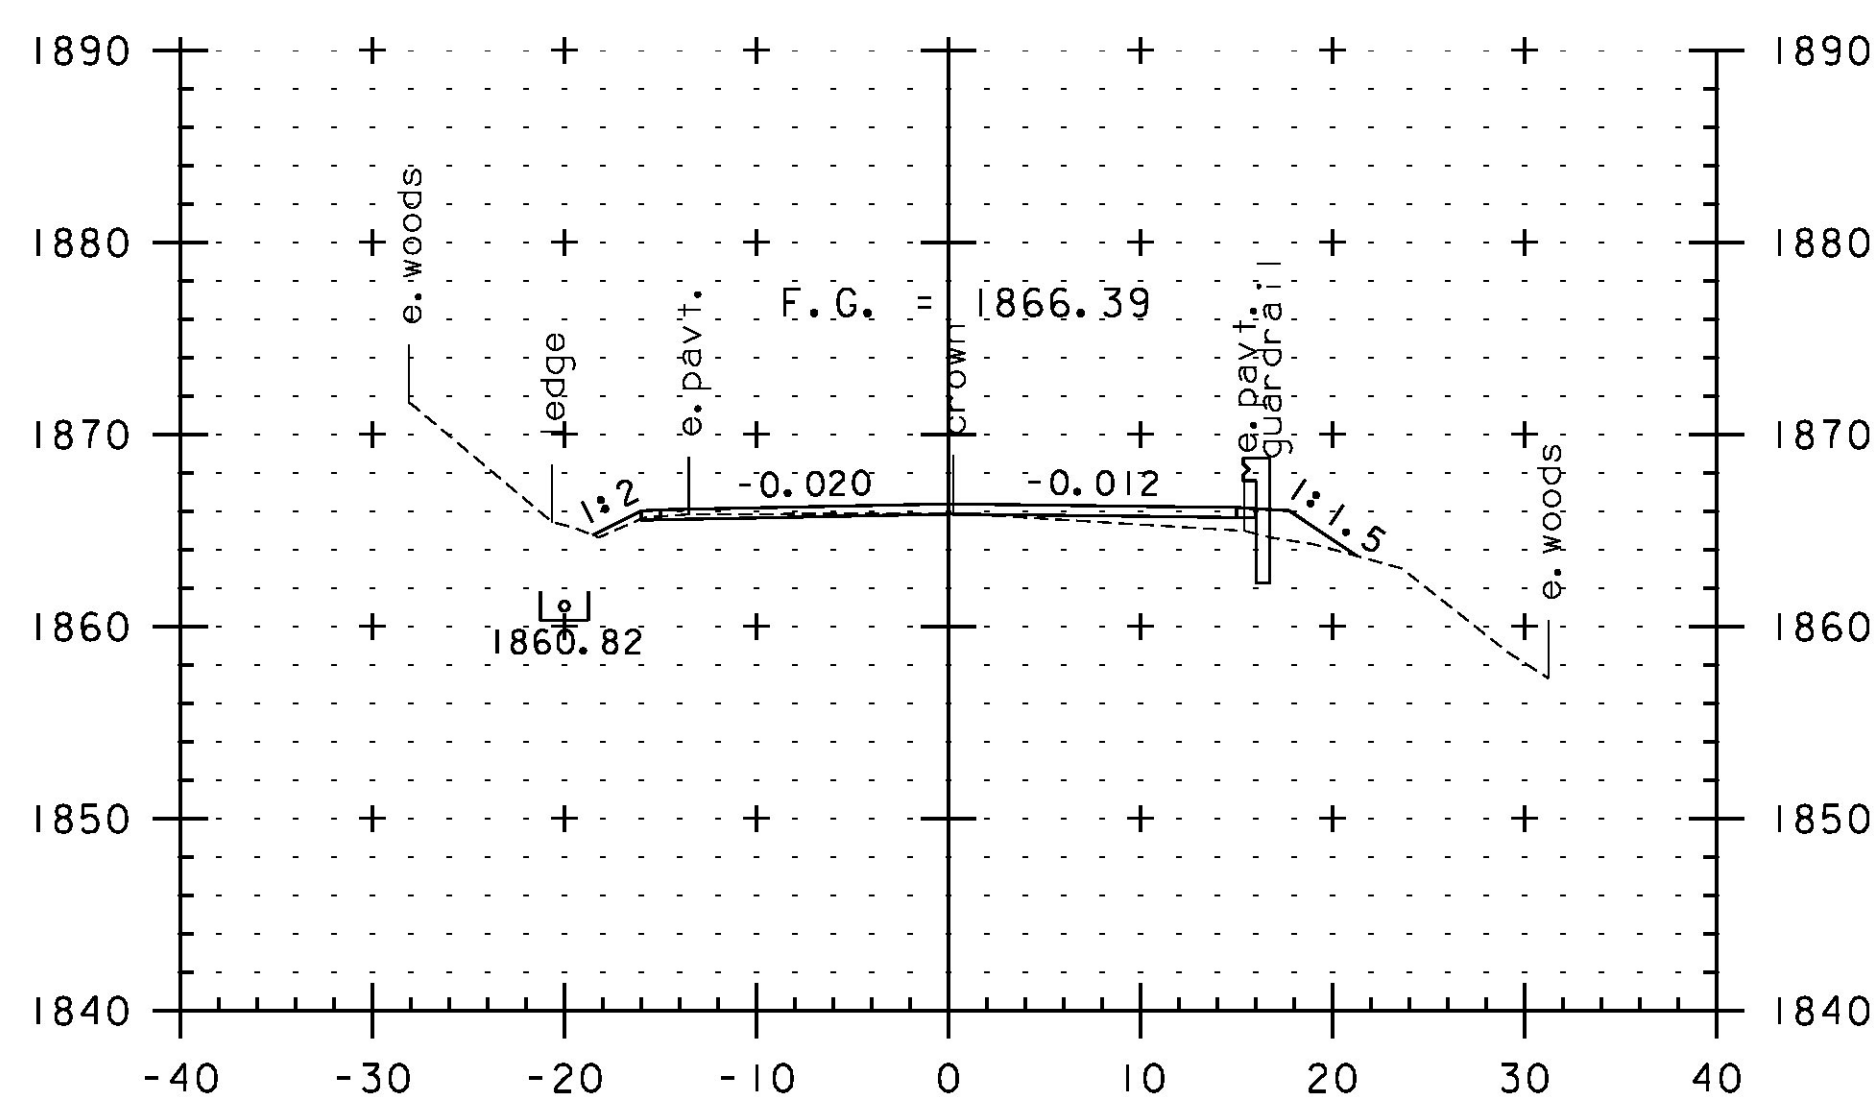

225+50

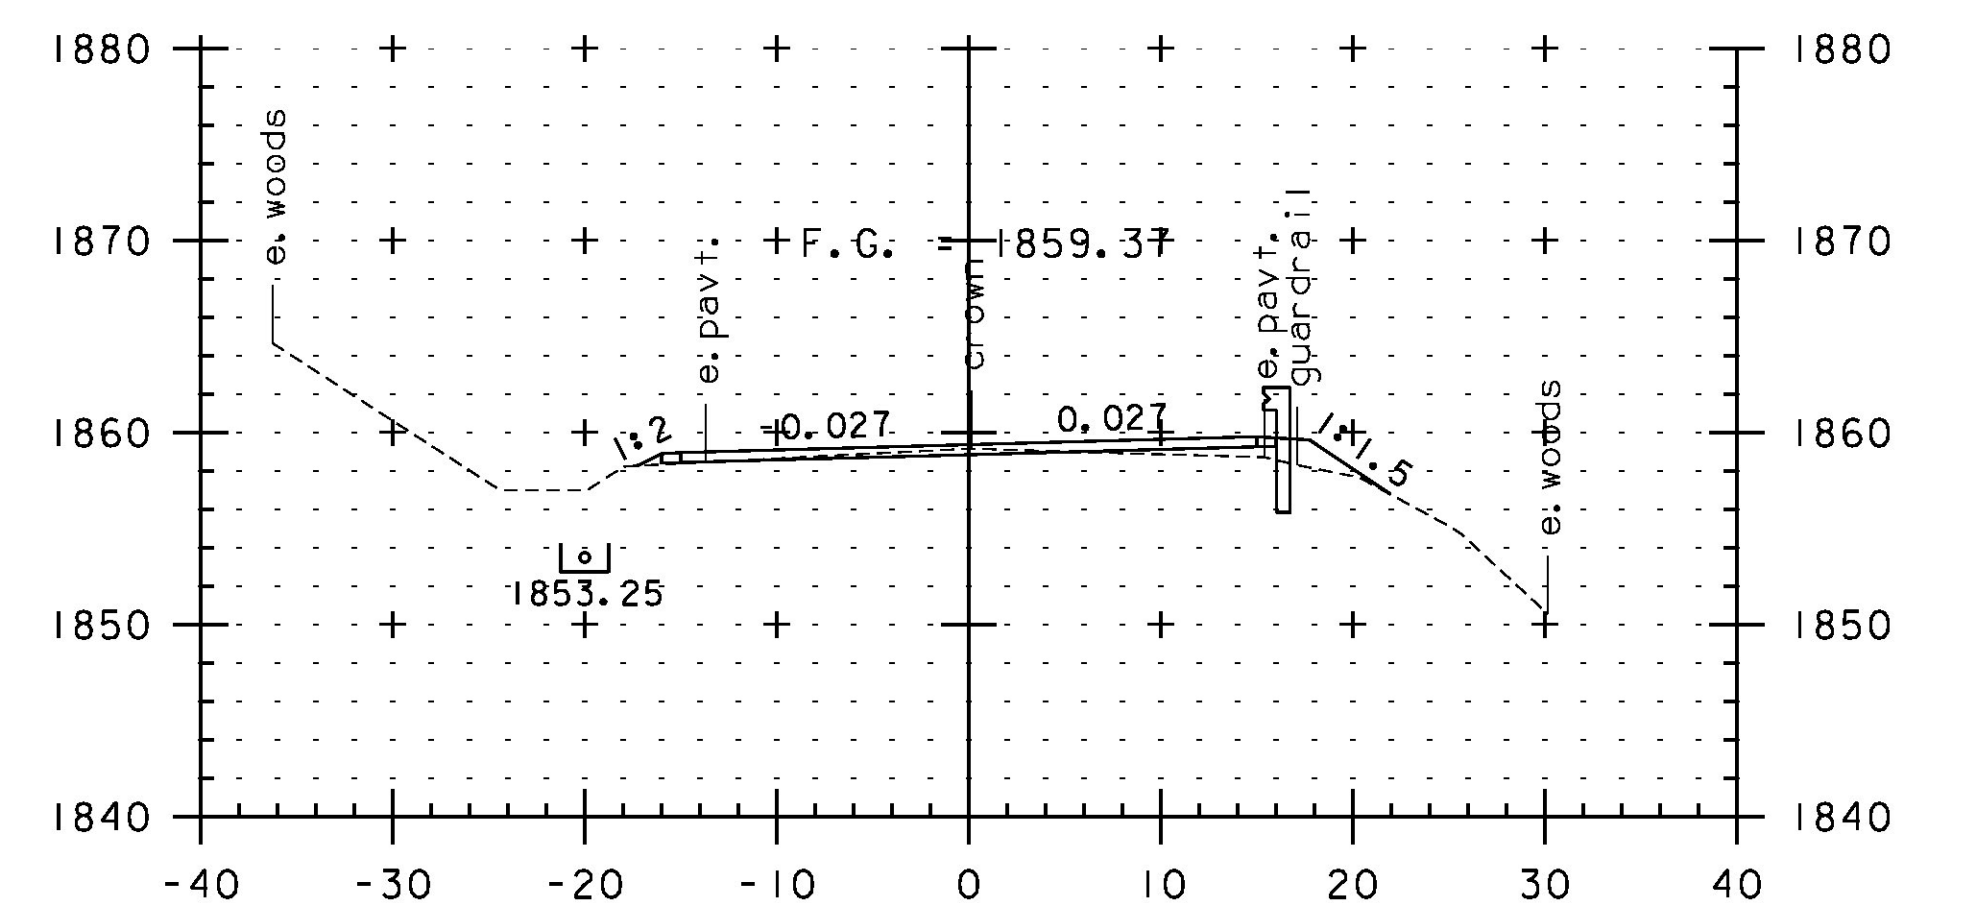

226+50

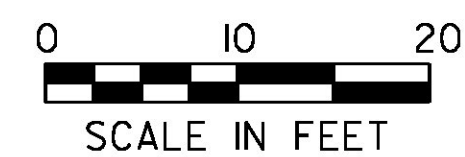

SCALE IN FEET

STA. 224+50 TO STA. 227+50

| | | | |
|-----------------|---------------|---------------------|------------|
| PROJECT NAME: | JAY-TROY | PLOT DATE: | 5/16/2014 |
| PROJECT NUMBER: | STP 2315(I) | DRAWN BY: | W. GORDON |
| FILE NAME: | z10b232xs.dgn | CHECKED BY: | P. SHEDD |
| PROJECT LEADER: | P. SHEDD | CROSS SECTION SHEET | 49 |
| DESIGNED BY: | N. LEMAY | SHEET | 185 OF 244 |