




228+50

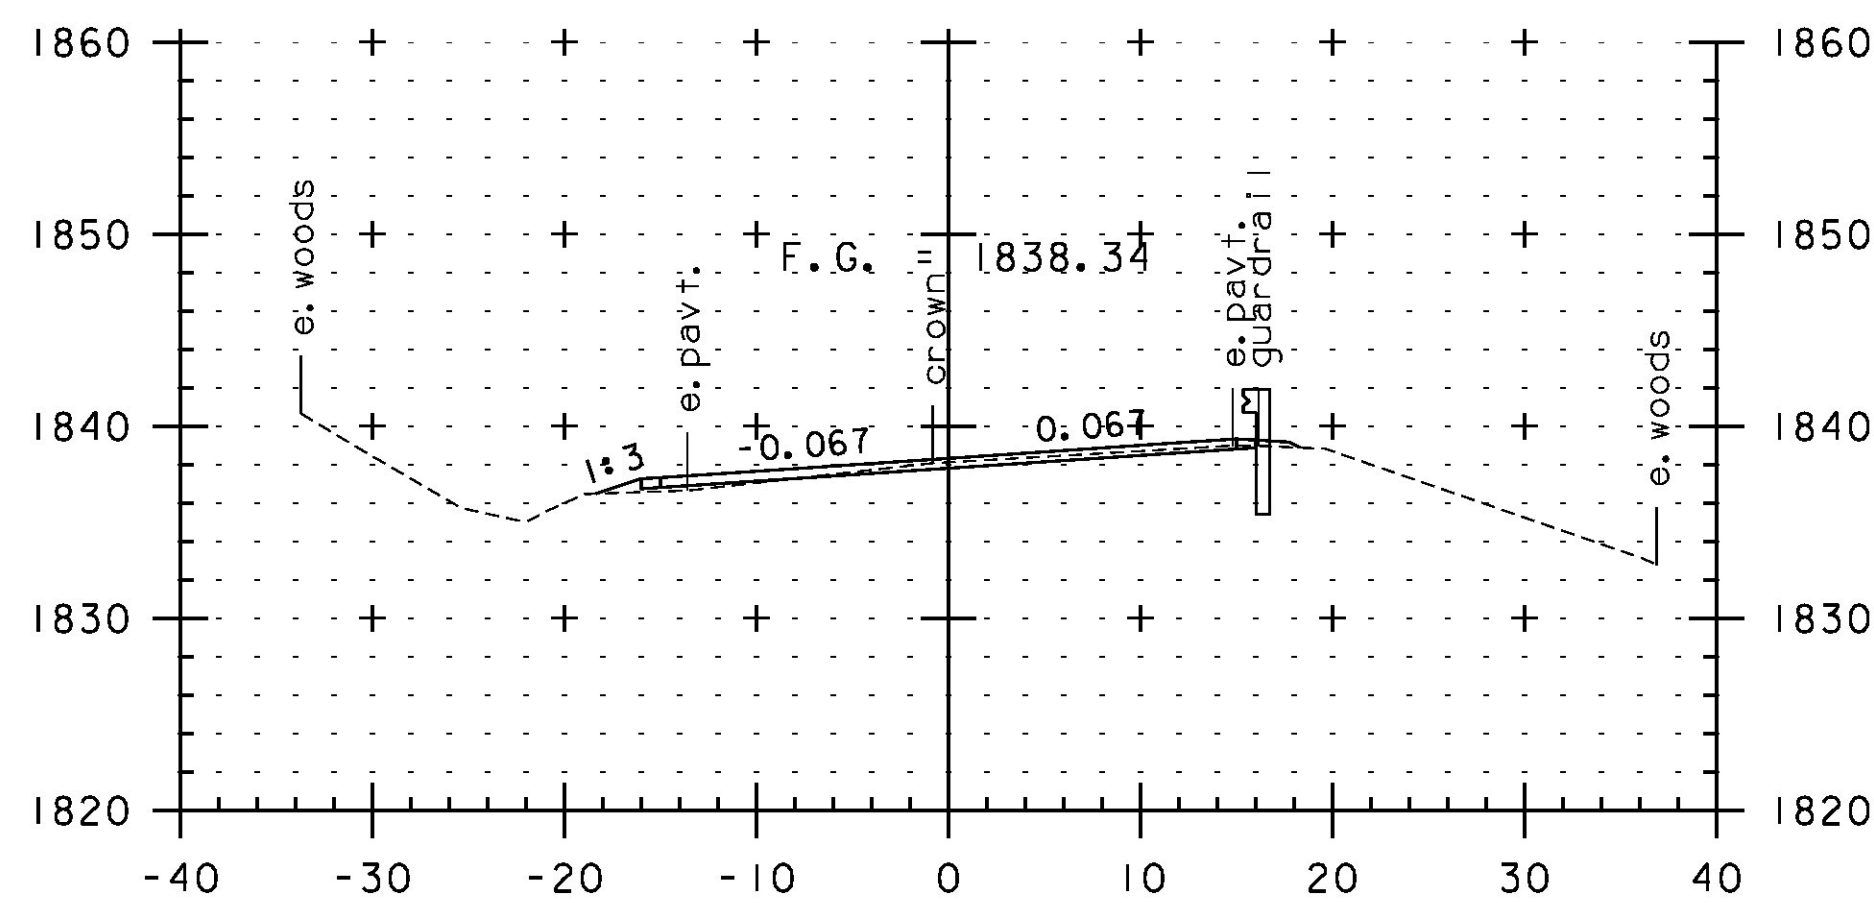


229+50

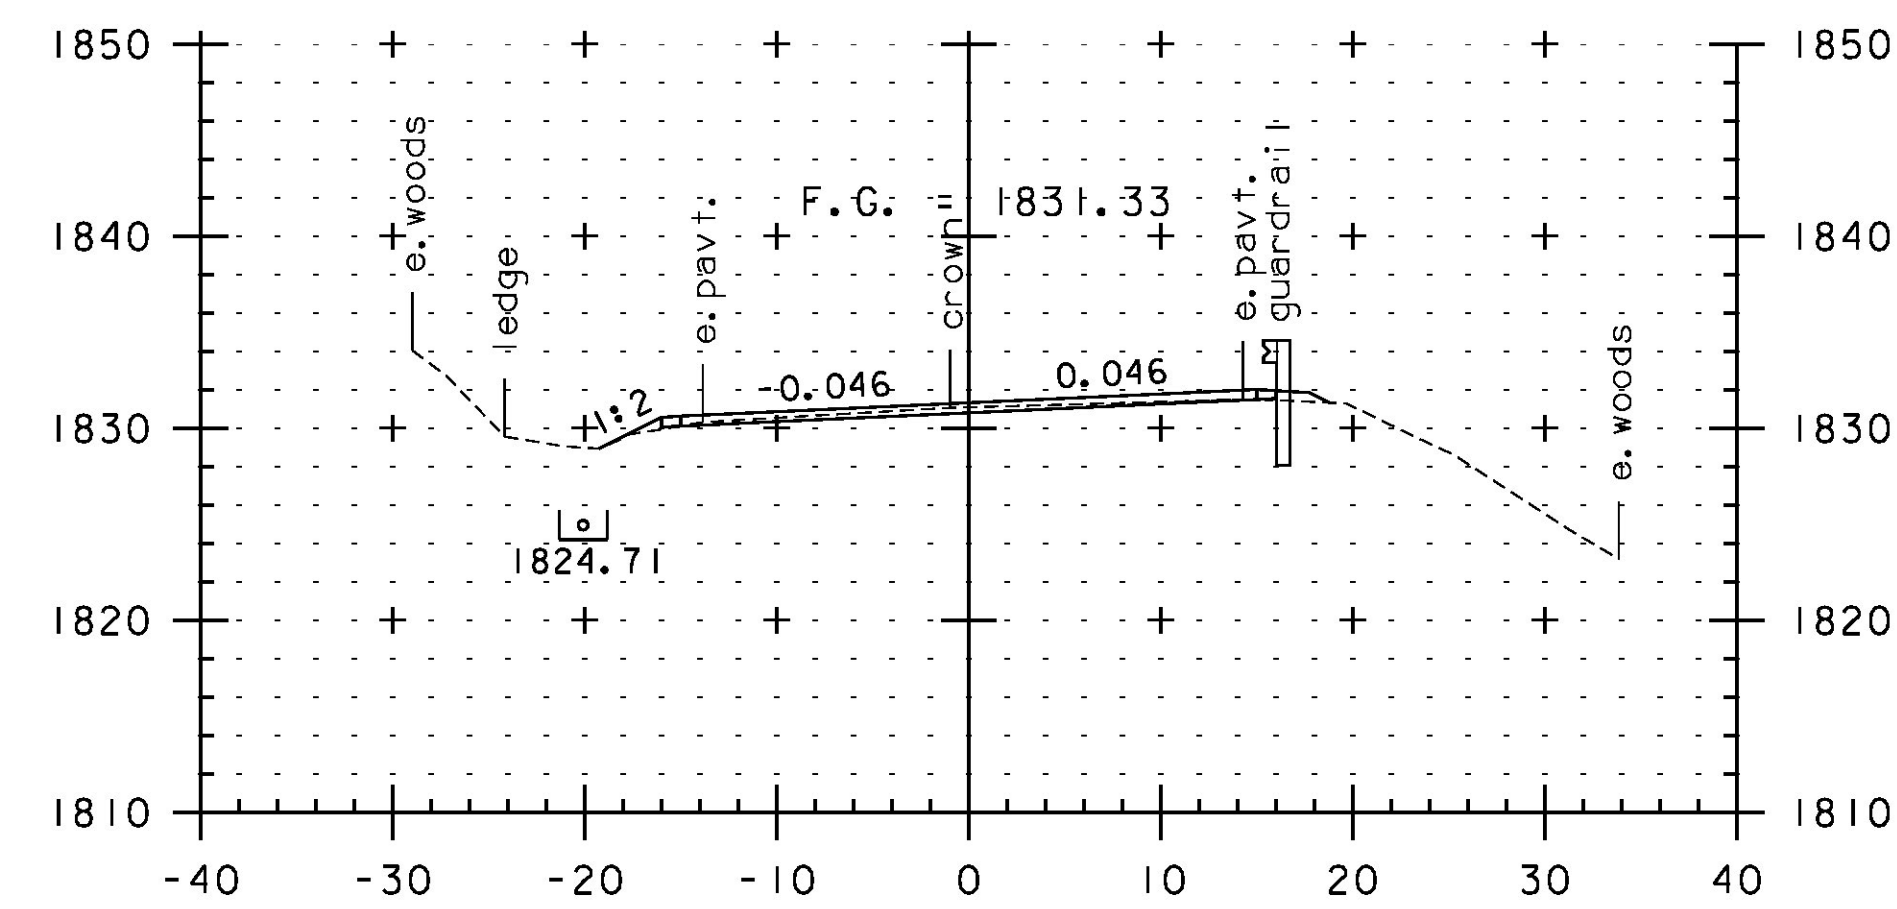


230+50

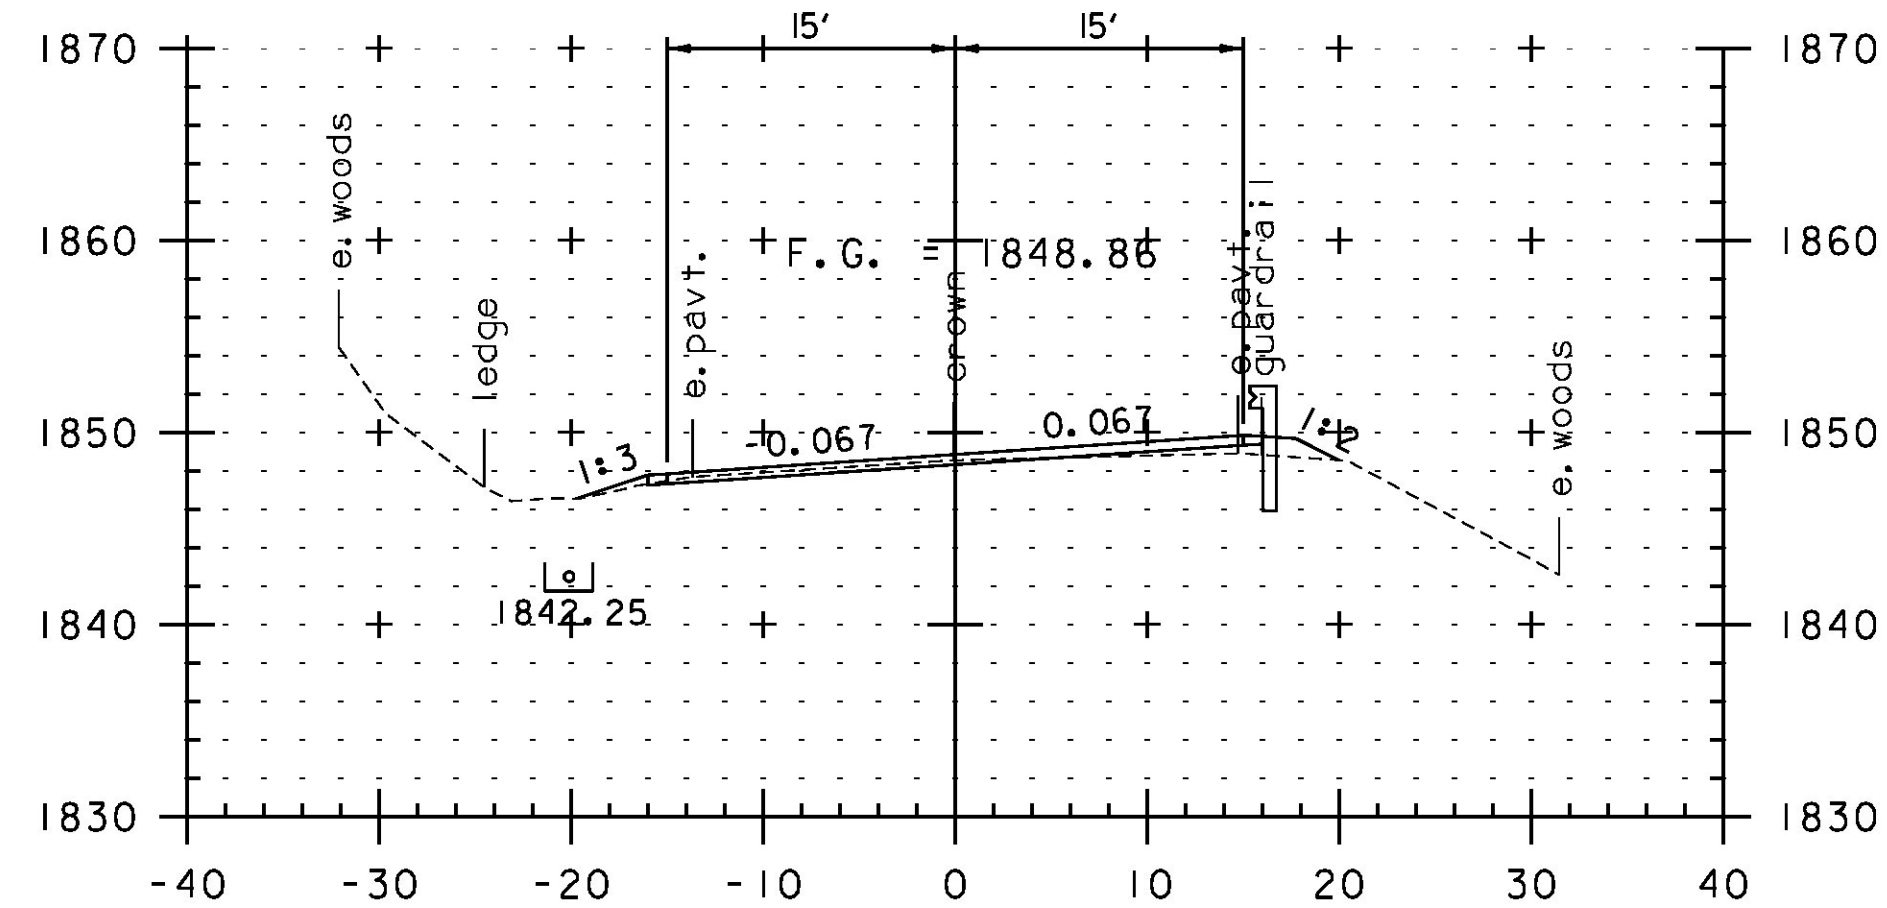


228+00

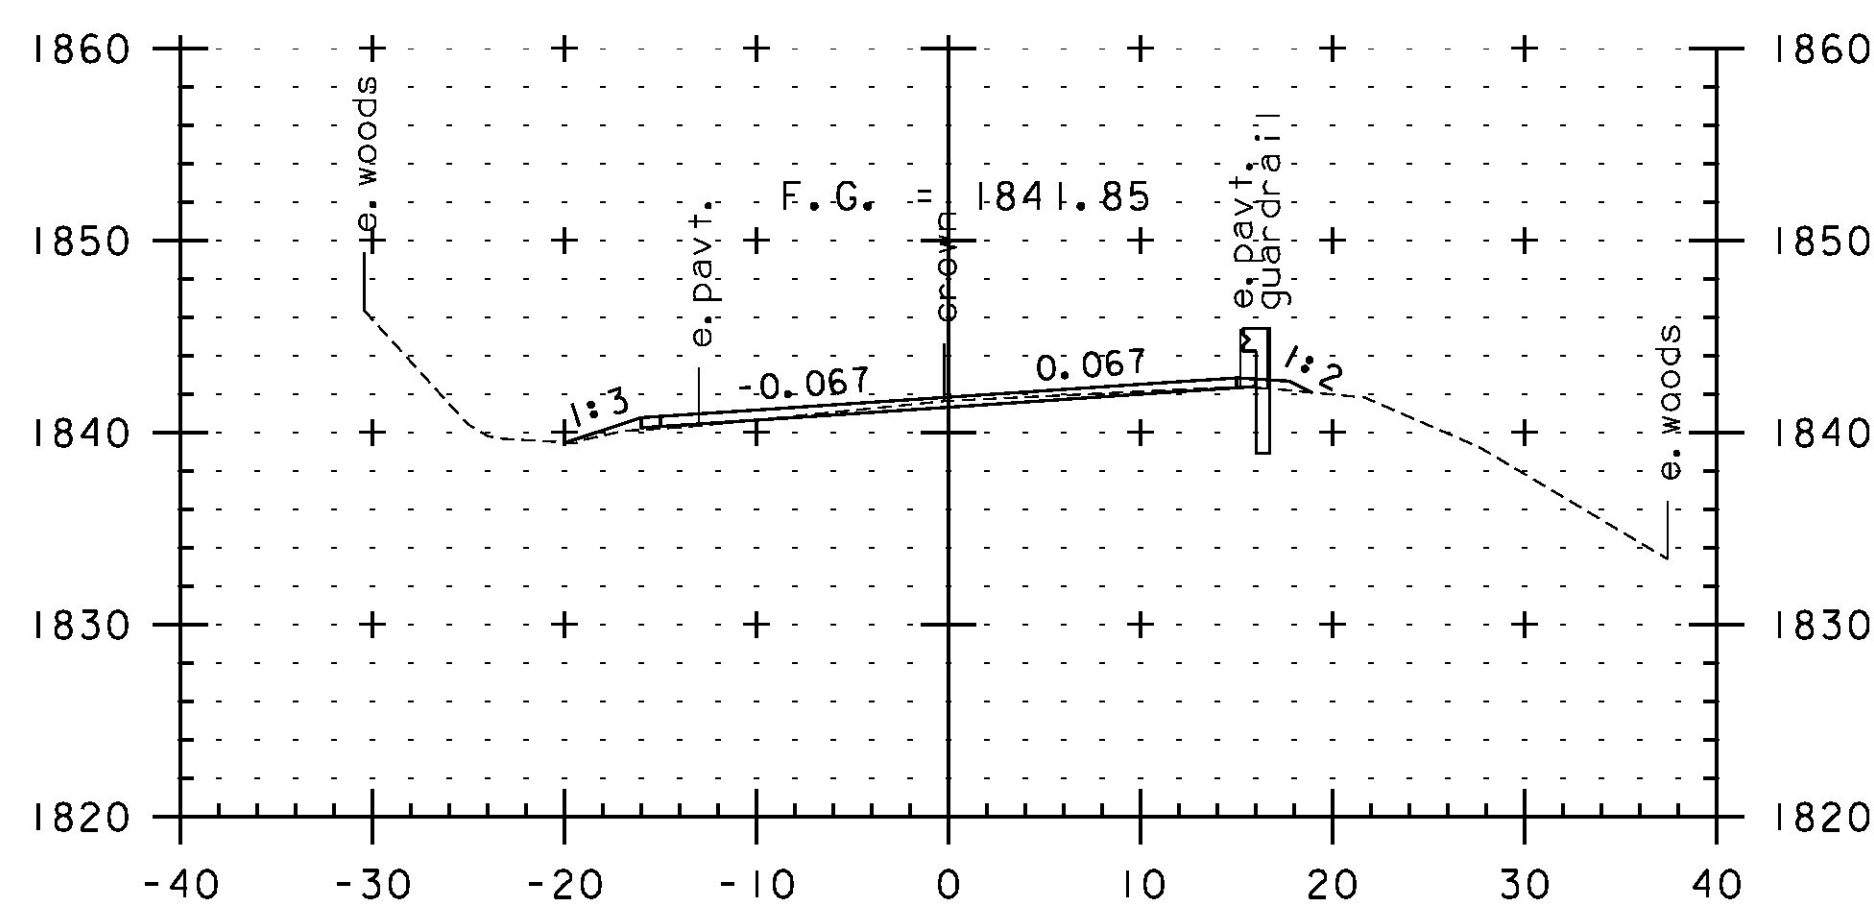

229+00

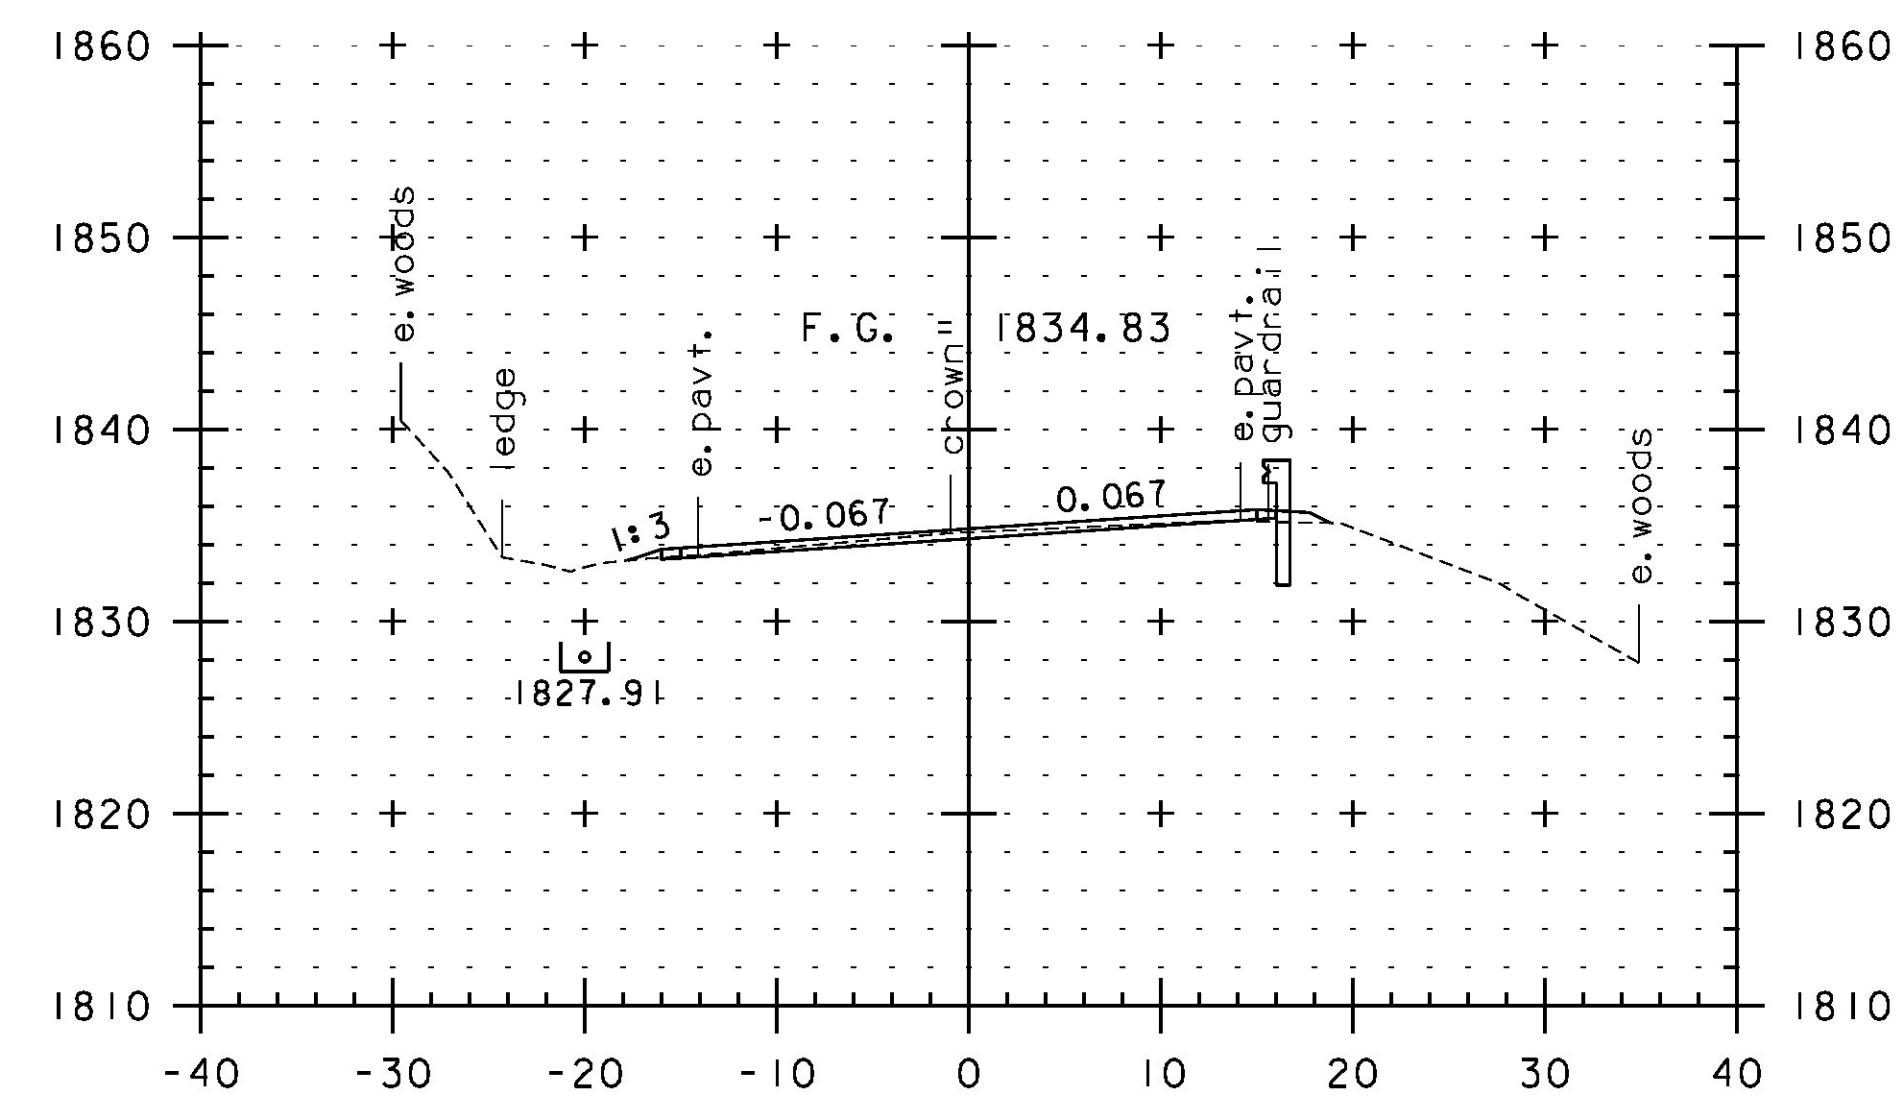

230+00

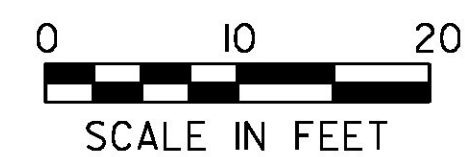

SCALE IN FEET

STA. 228+00 TO STA. 230+50

PROJECT NAME:	JAY-TROY	PLOT DATE:	5/16/2014
PROJECT NUMBER:	STP 2315(I)	DRAWN BY:	W. GORDON
FILE NAME:	z10b232xs.dgn	CHECKED BY:	P. SHEDD
PROJECT LEADER:	P. SHEDD	CROSS SECTION SHEET 50	SHEET 186 OF 244
DESIGNED BY:	N. LEMAY		