




231+50

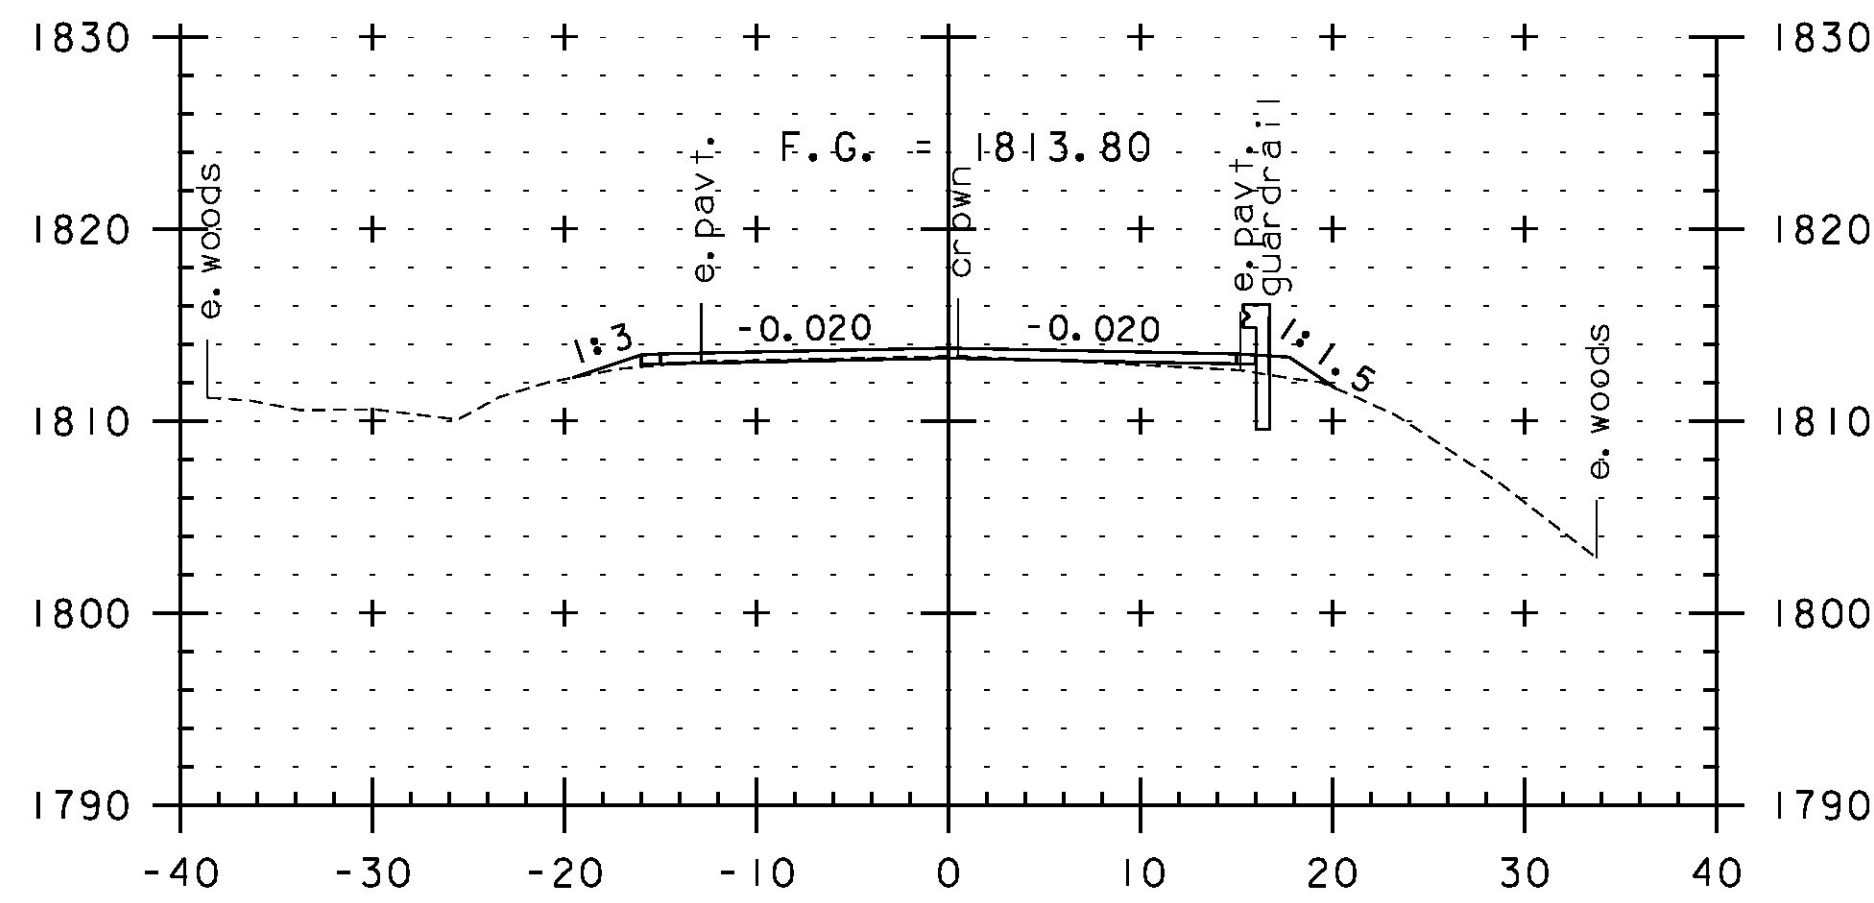


233+00

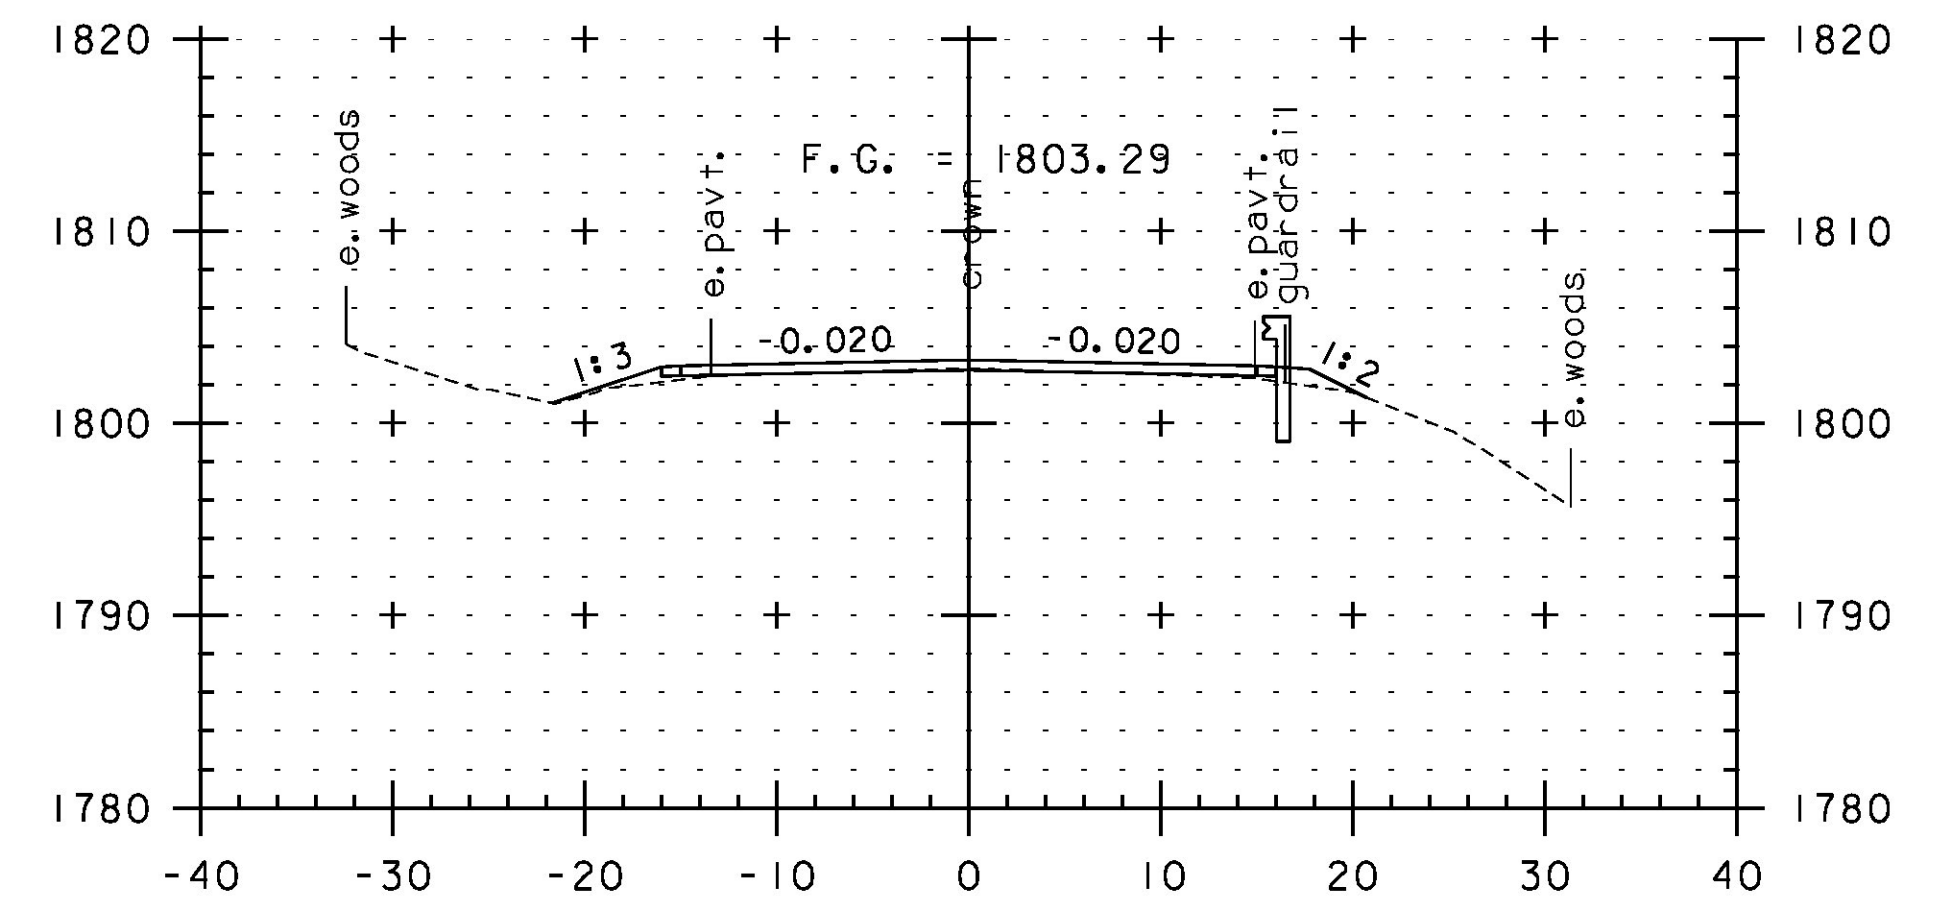


234+50

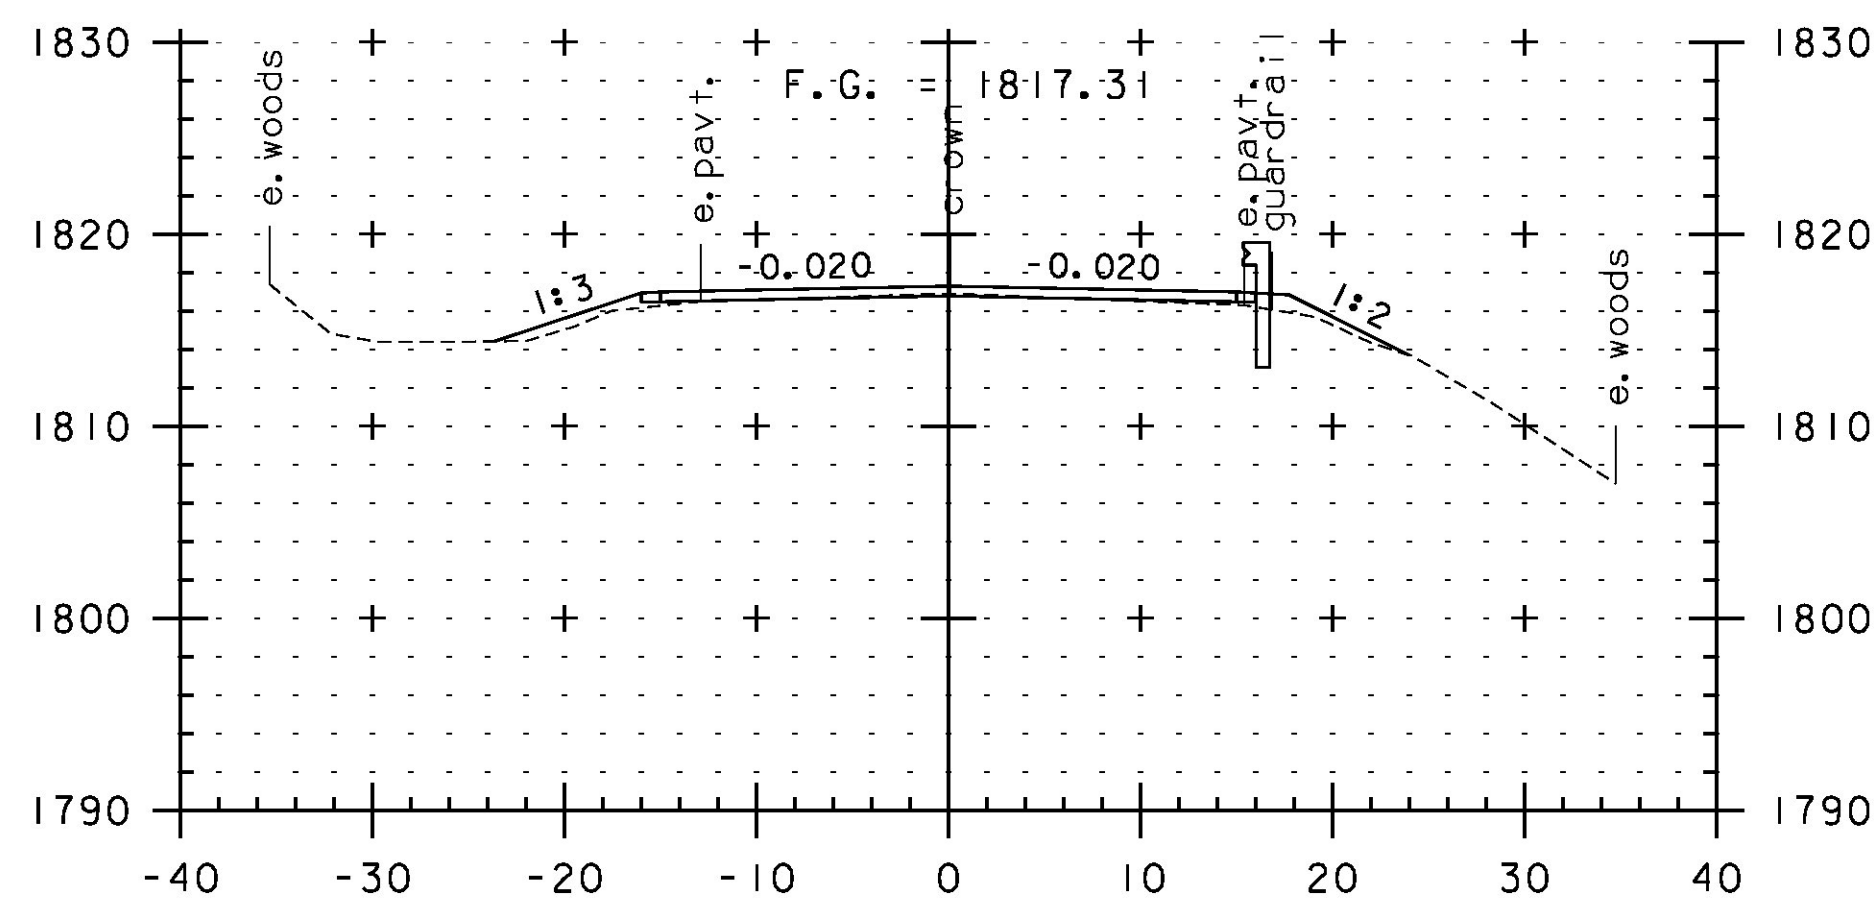


232+50

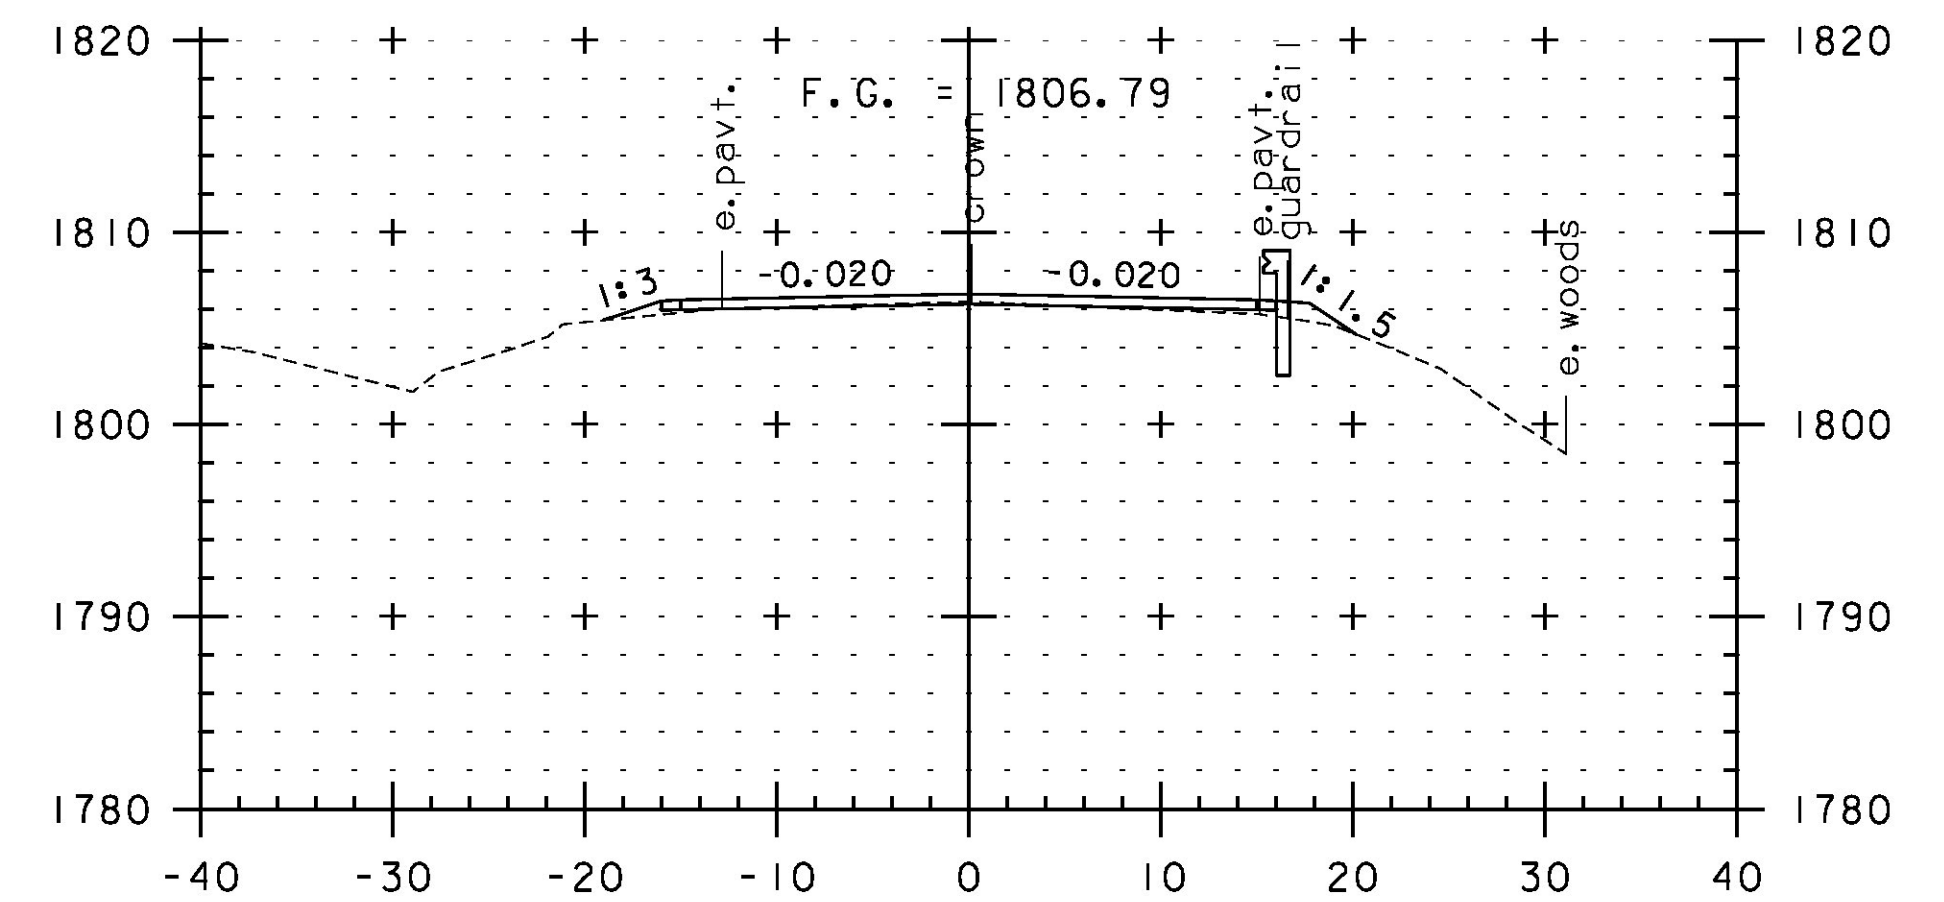


234+00

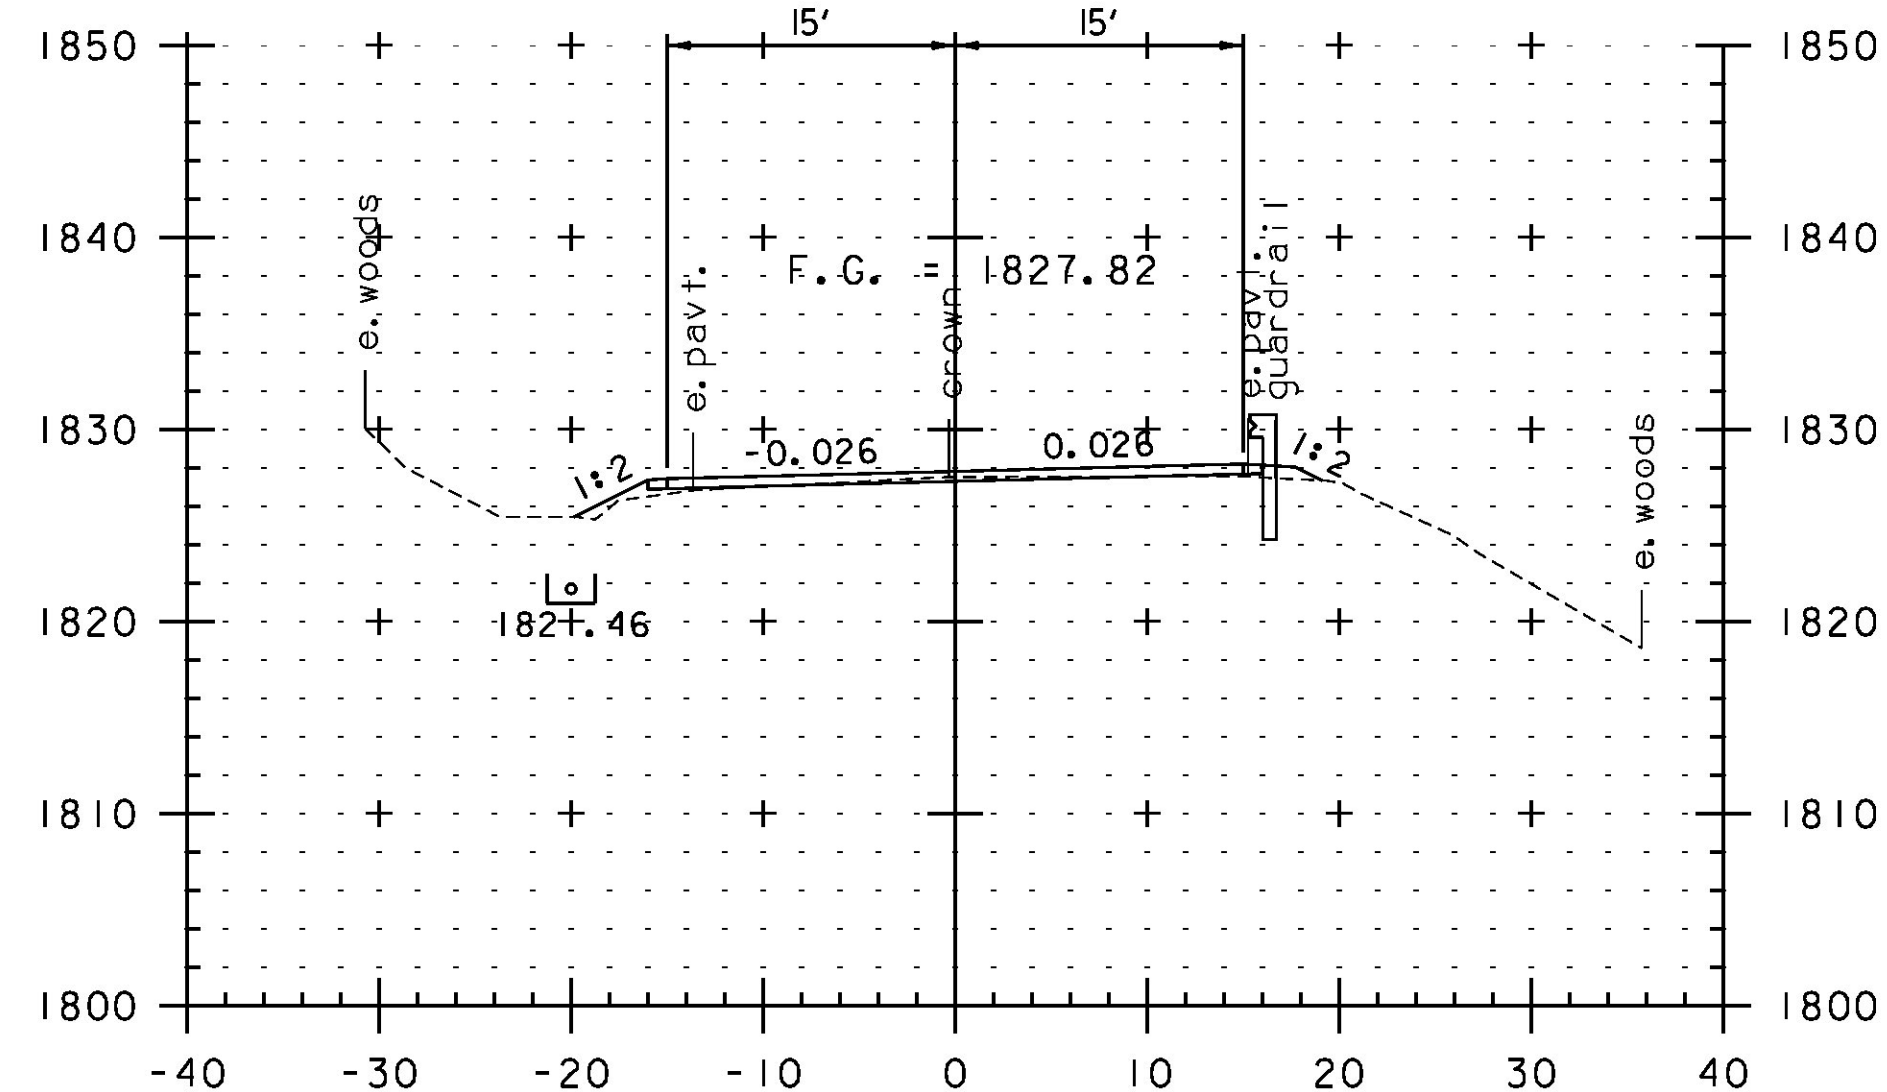


231+00

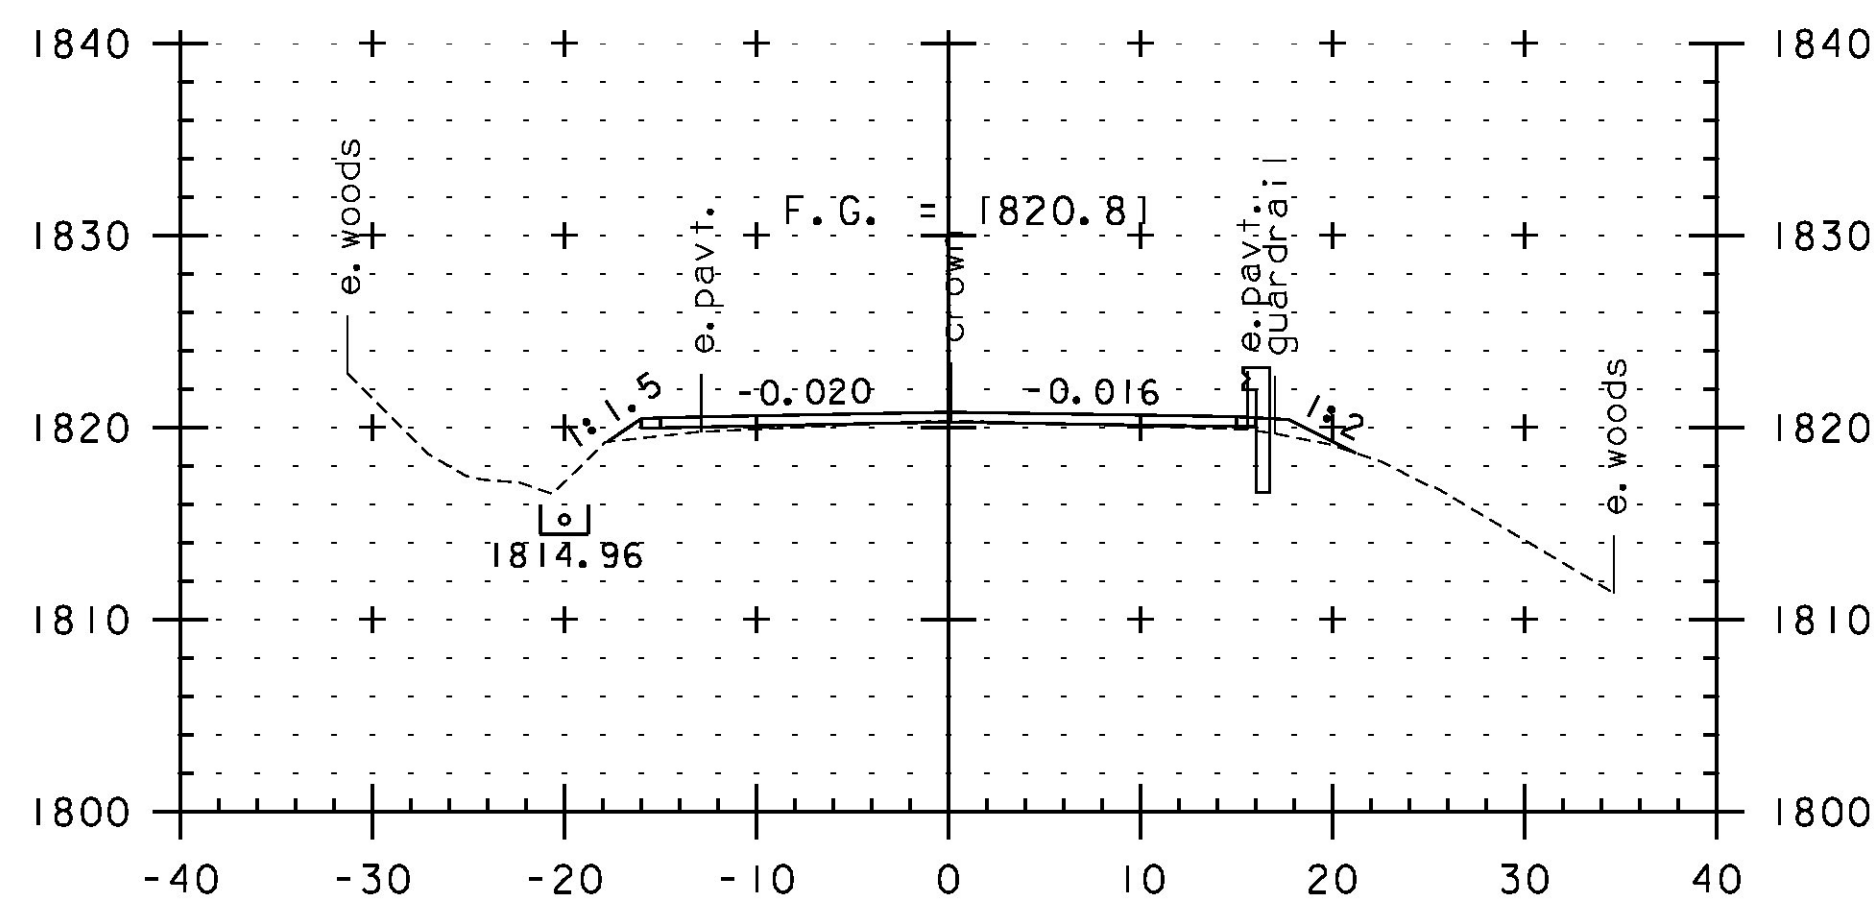

232+00

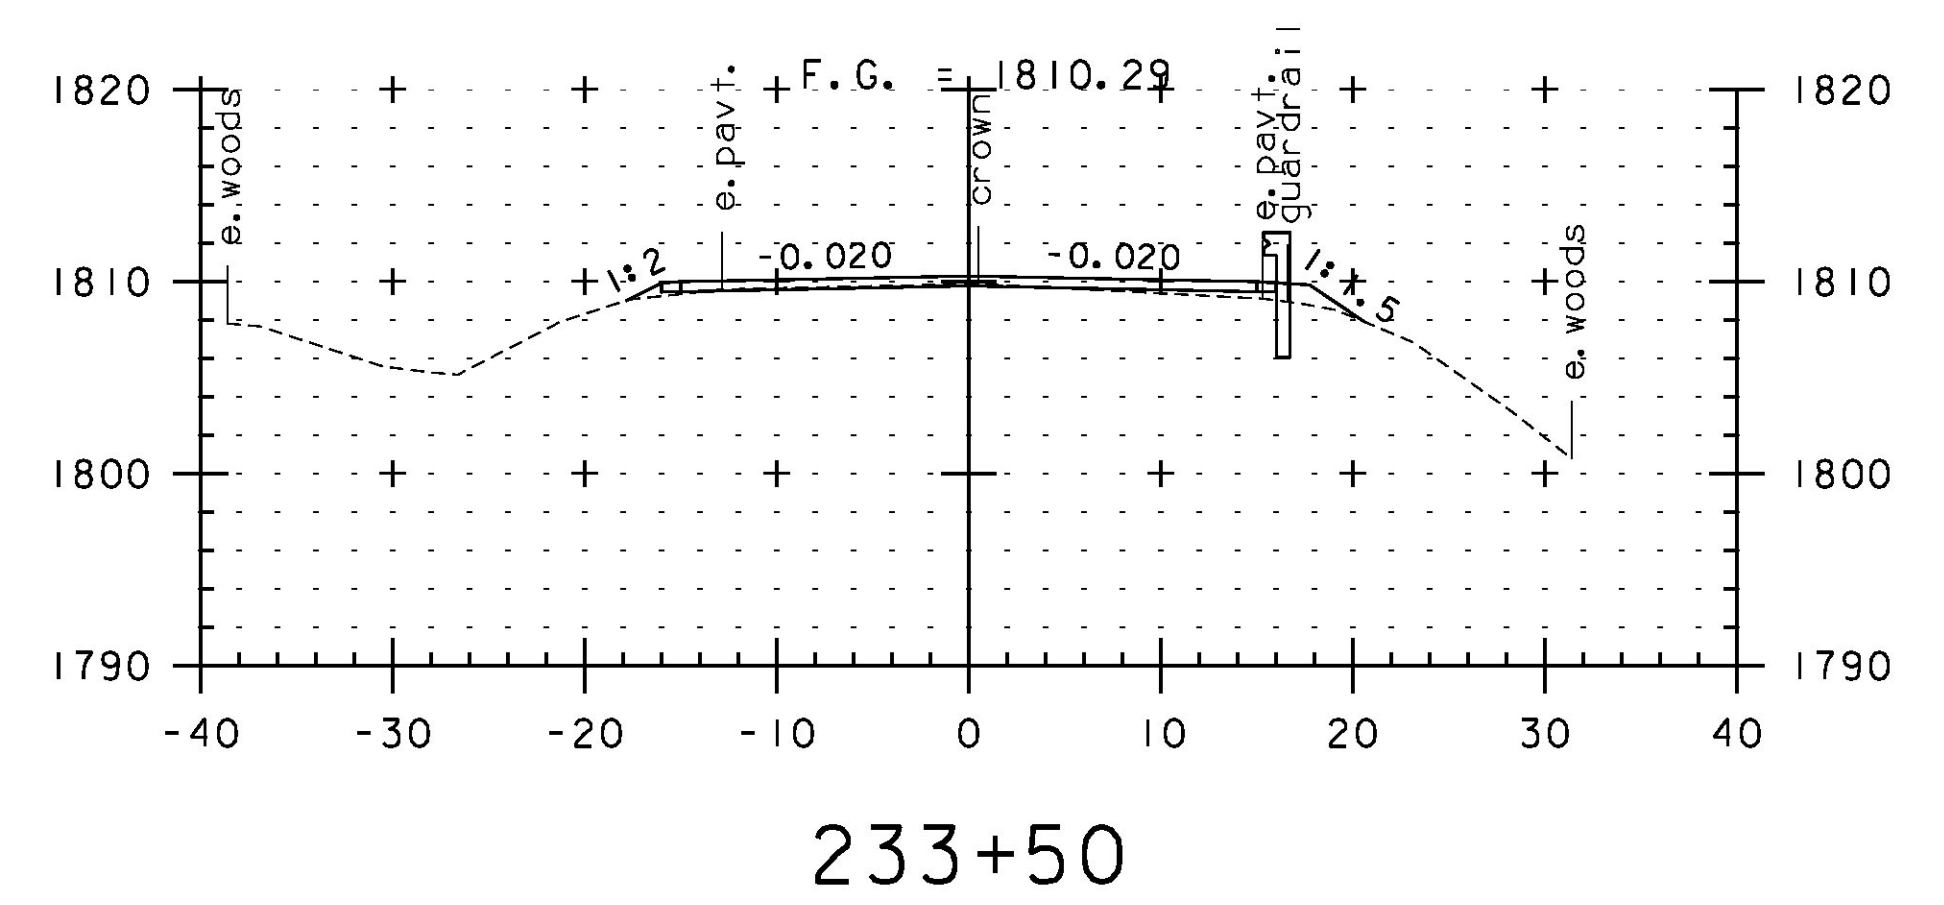

233+50

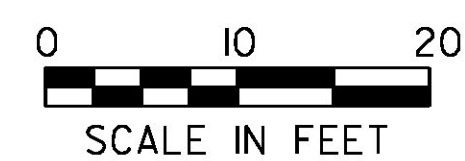

STA. 231+00 TO STA. 234+50

PROJECT NAME:	JAY-TROY	PLOT DATE:	5/16/2014
PROJECT NUMBER:	STP 2315(I)	DRAWN BY:	W. GORDON
FILE NAME:	z10b232xs.dgn	CHECKED BY:	P. SHEDD
PROJECT LEADER:	P. SHEDD	CROSS SECTION SHEET 51	SHEET 187 OF 244
DESIGNED BY:	N. LEMAY		