




239+00

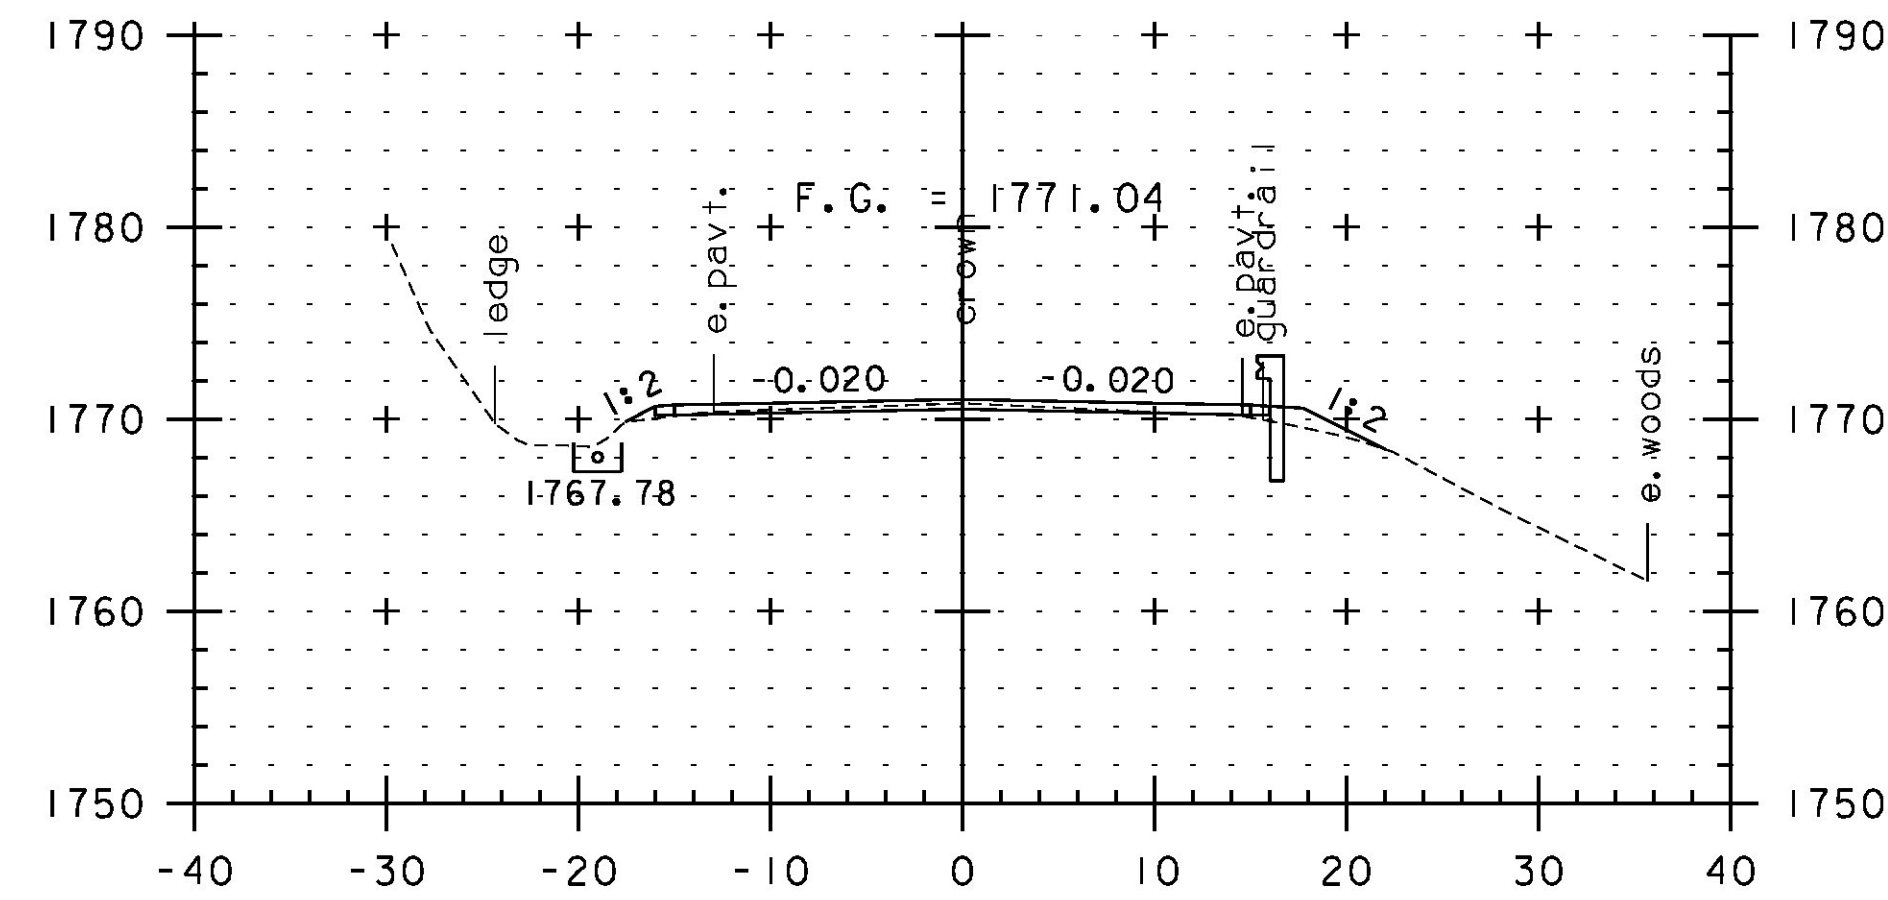


240+00

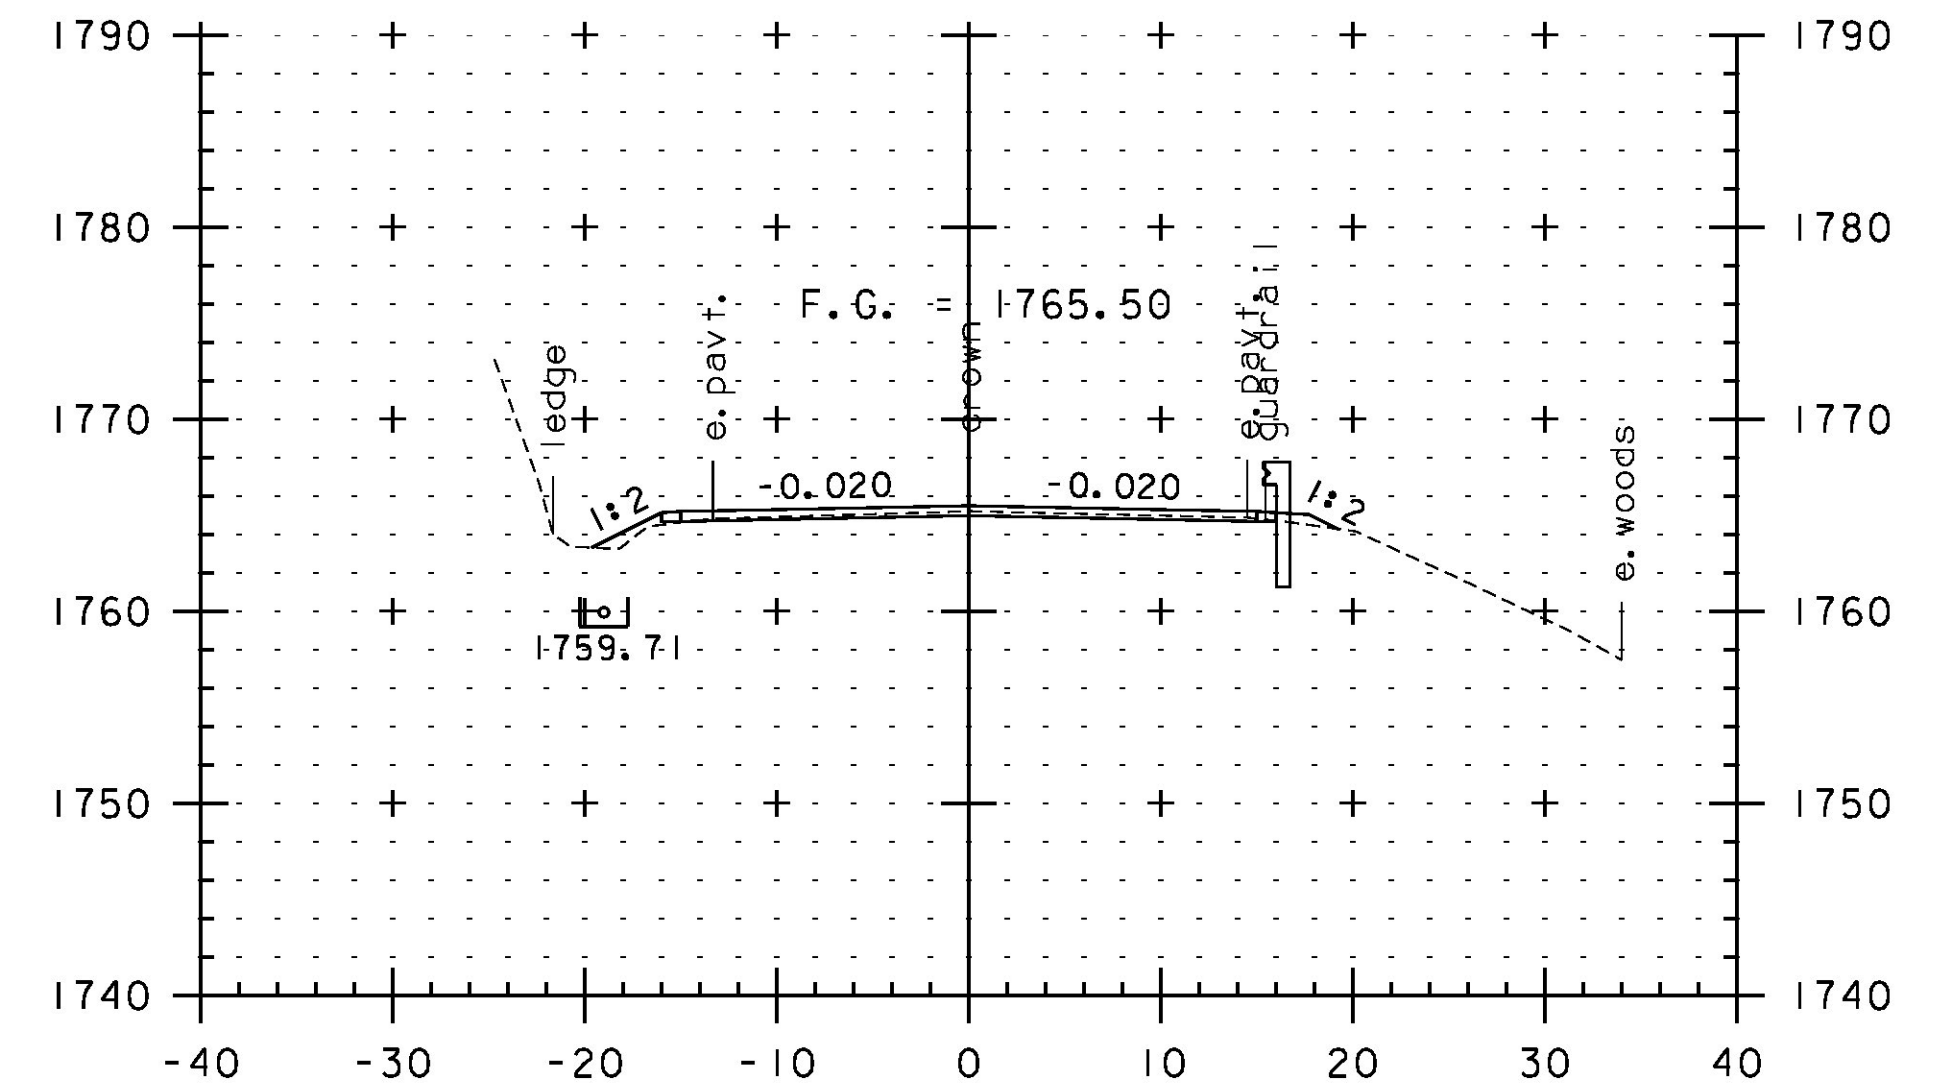


241+00

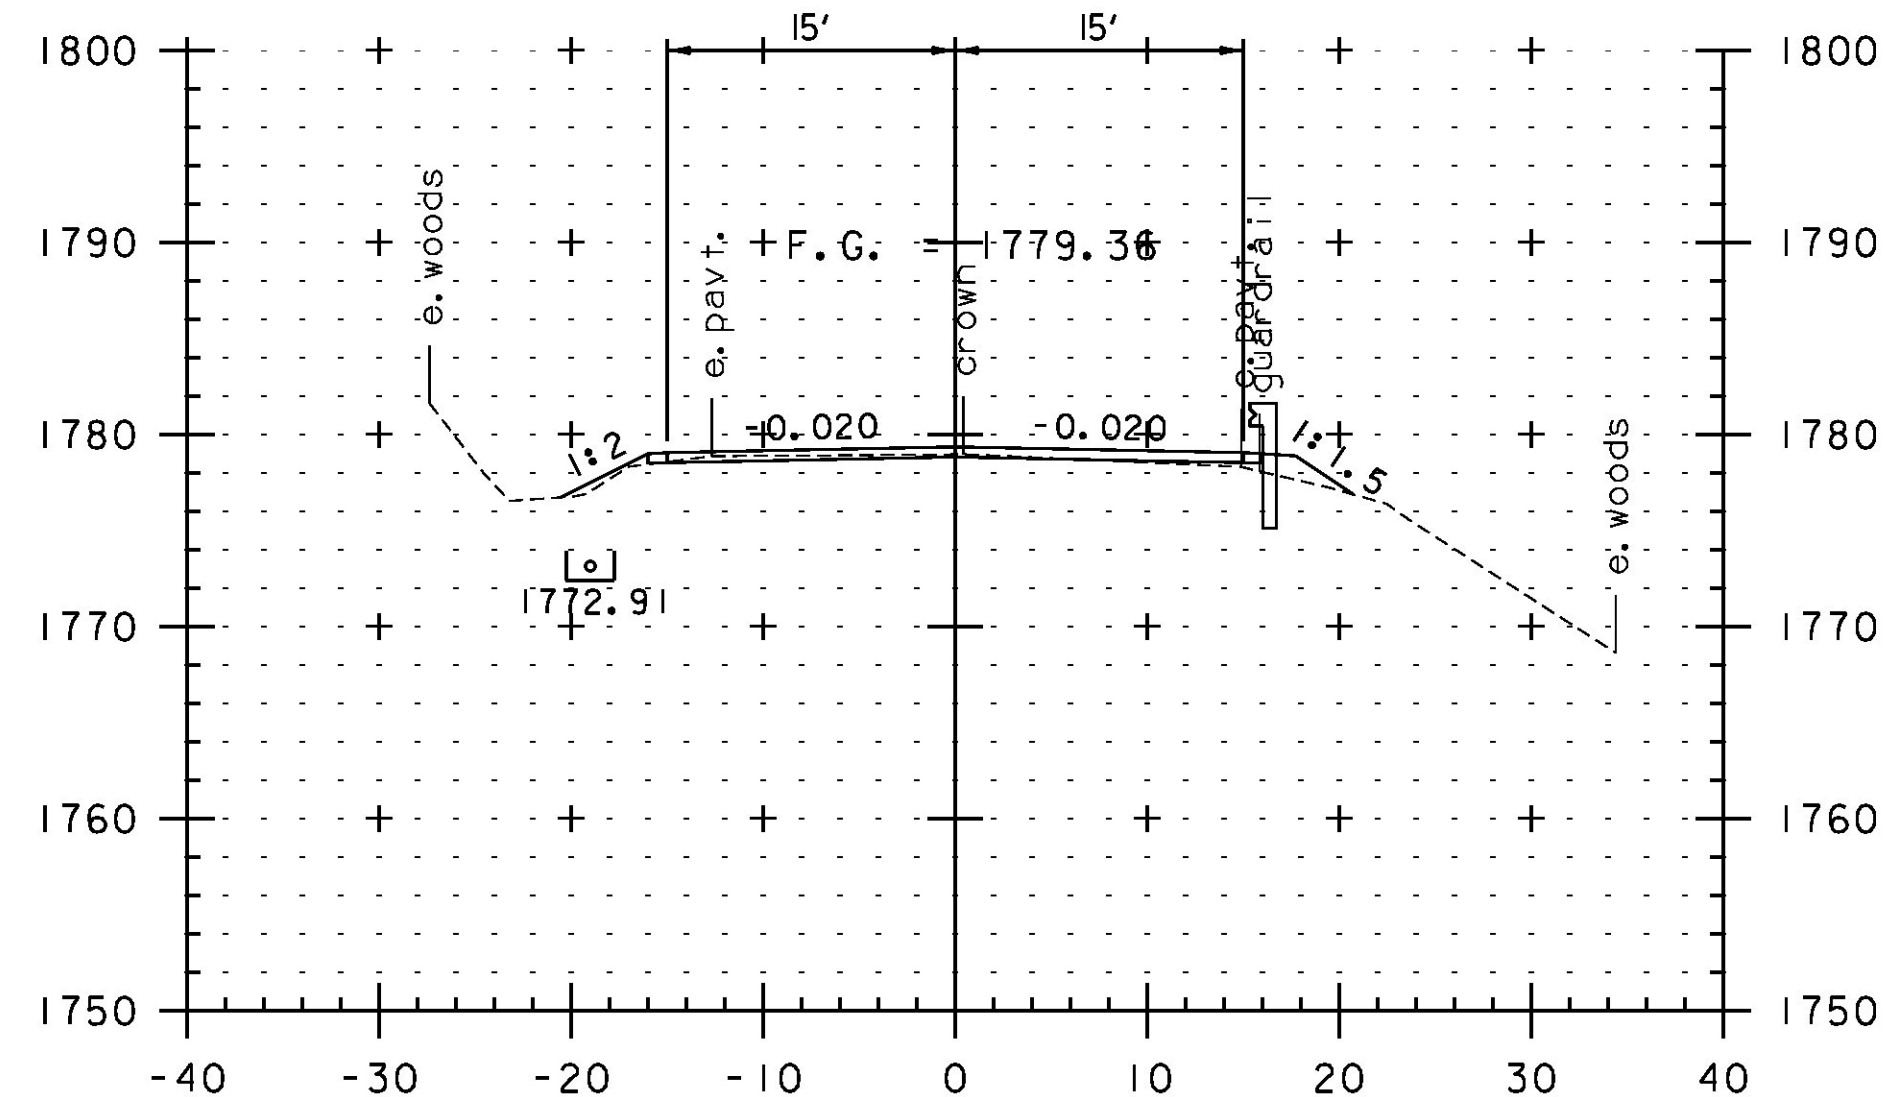


238+50

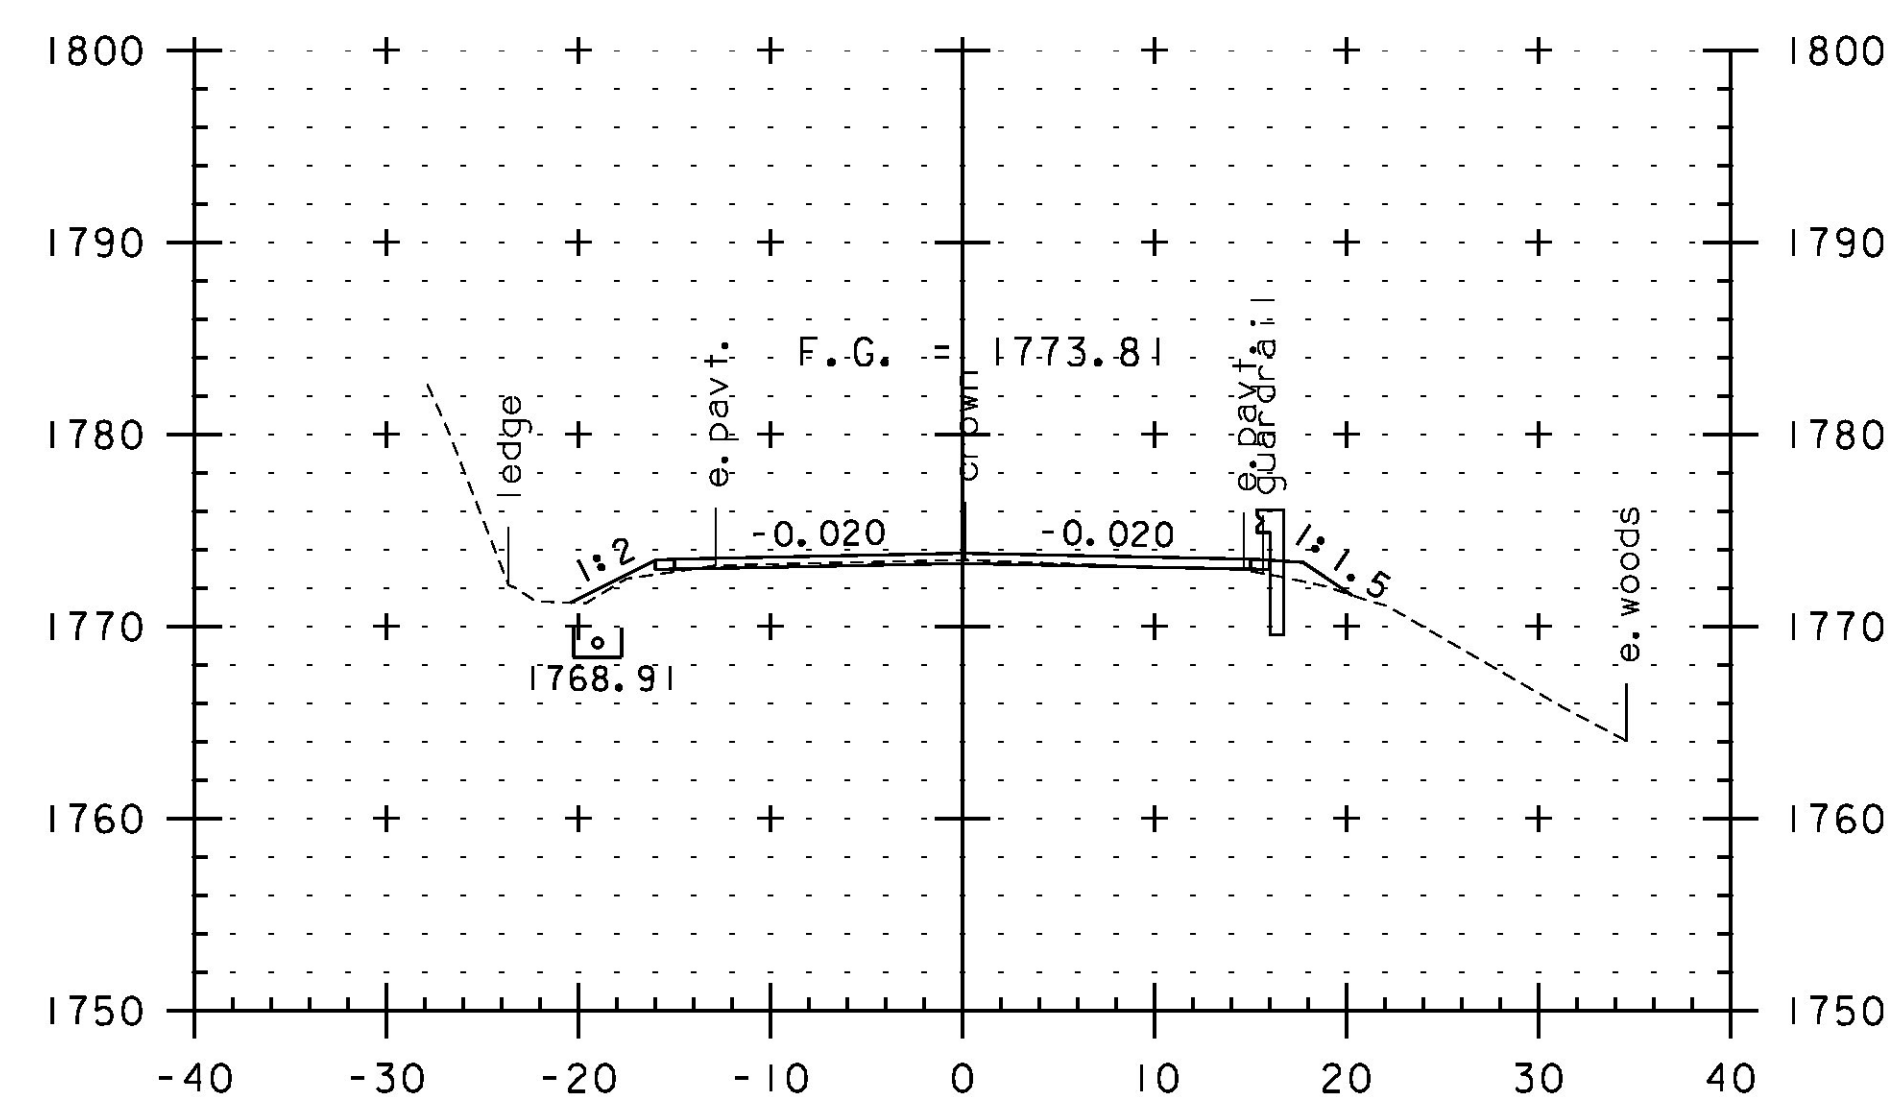

239+50

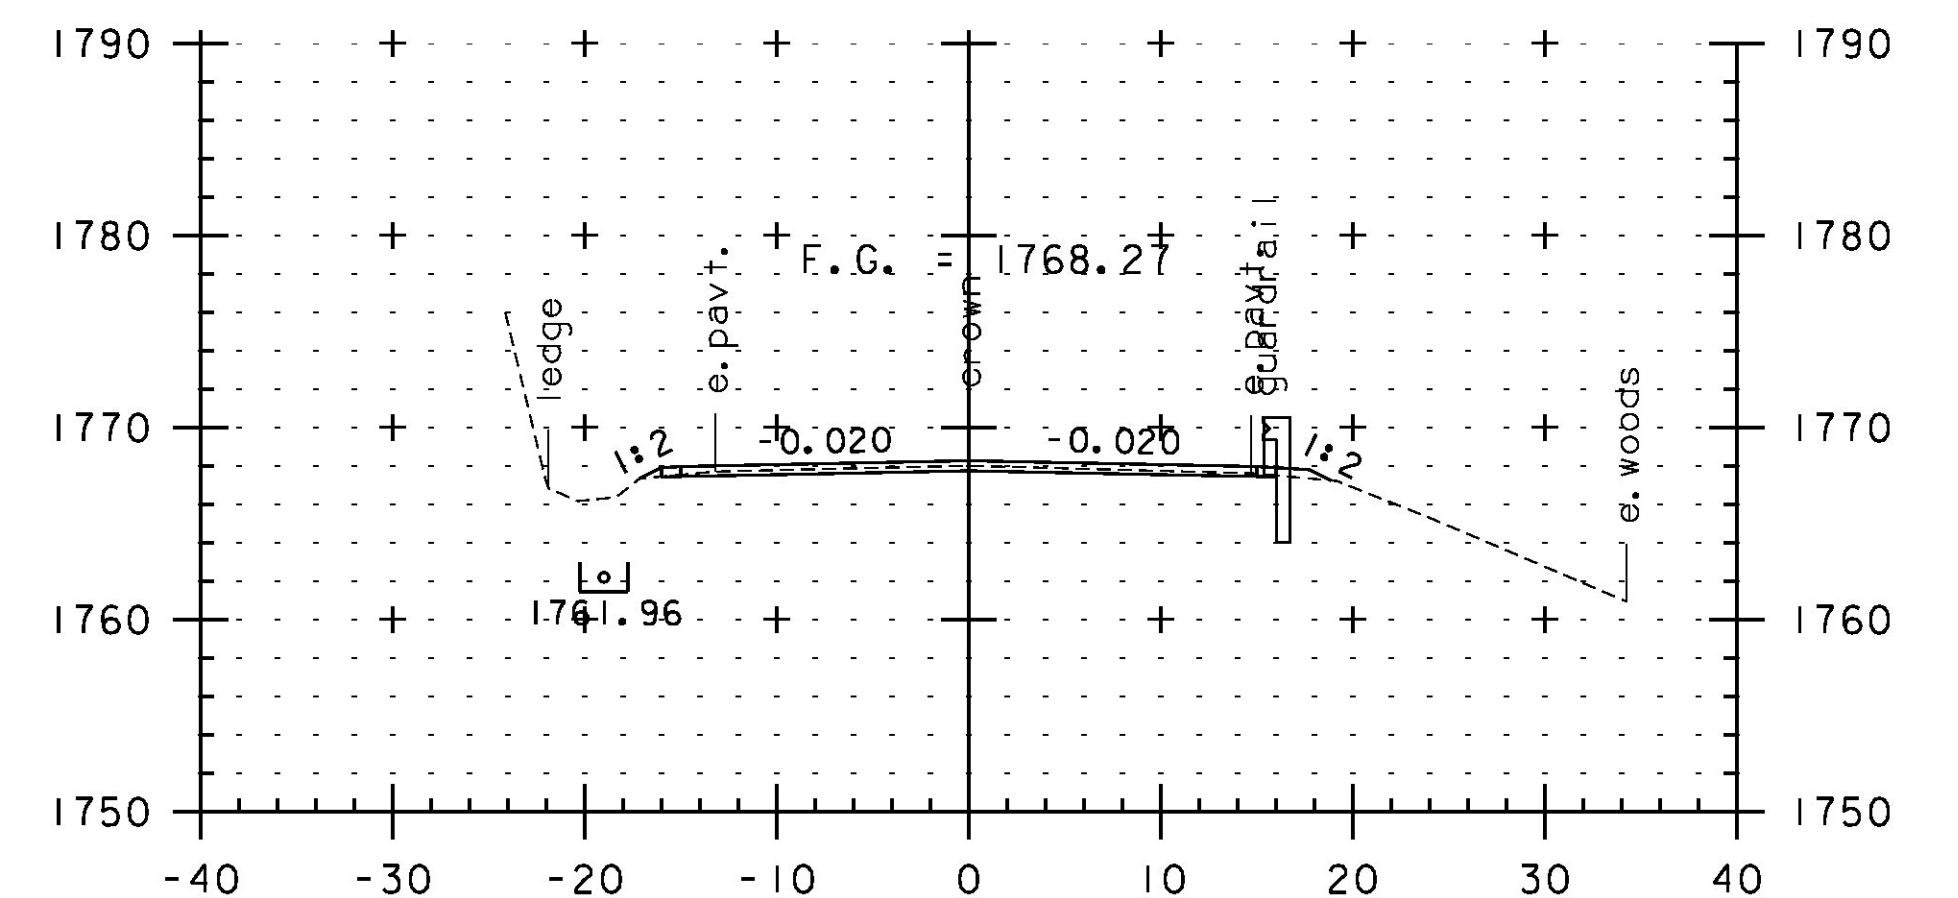

240+50

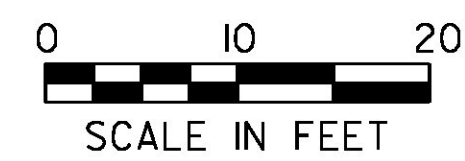

STA. 238+50 TO STA. 241+00

PROJECT NAME:	JAY-TROY	PLOT DATE:	5/16/2014
PROJECT NUMBER:	STP 2315(I)	DRAWN BY:	W. GORDON
FILE NAME:	z10b232xs.dgn	CHECKED BY:	P. SHEDD
PROJECT LEADER:	P. SHEDD	CROSS SECTION SHEET 53	SHEET 189 OF 244
DESIGNED BY:	N. LEMAY		