




245+50

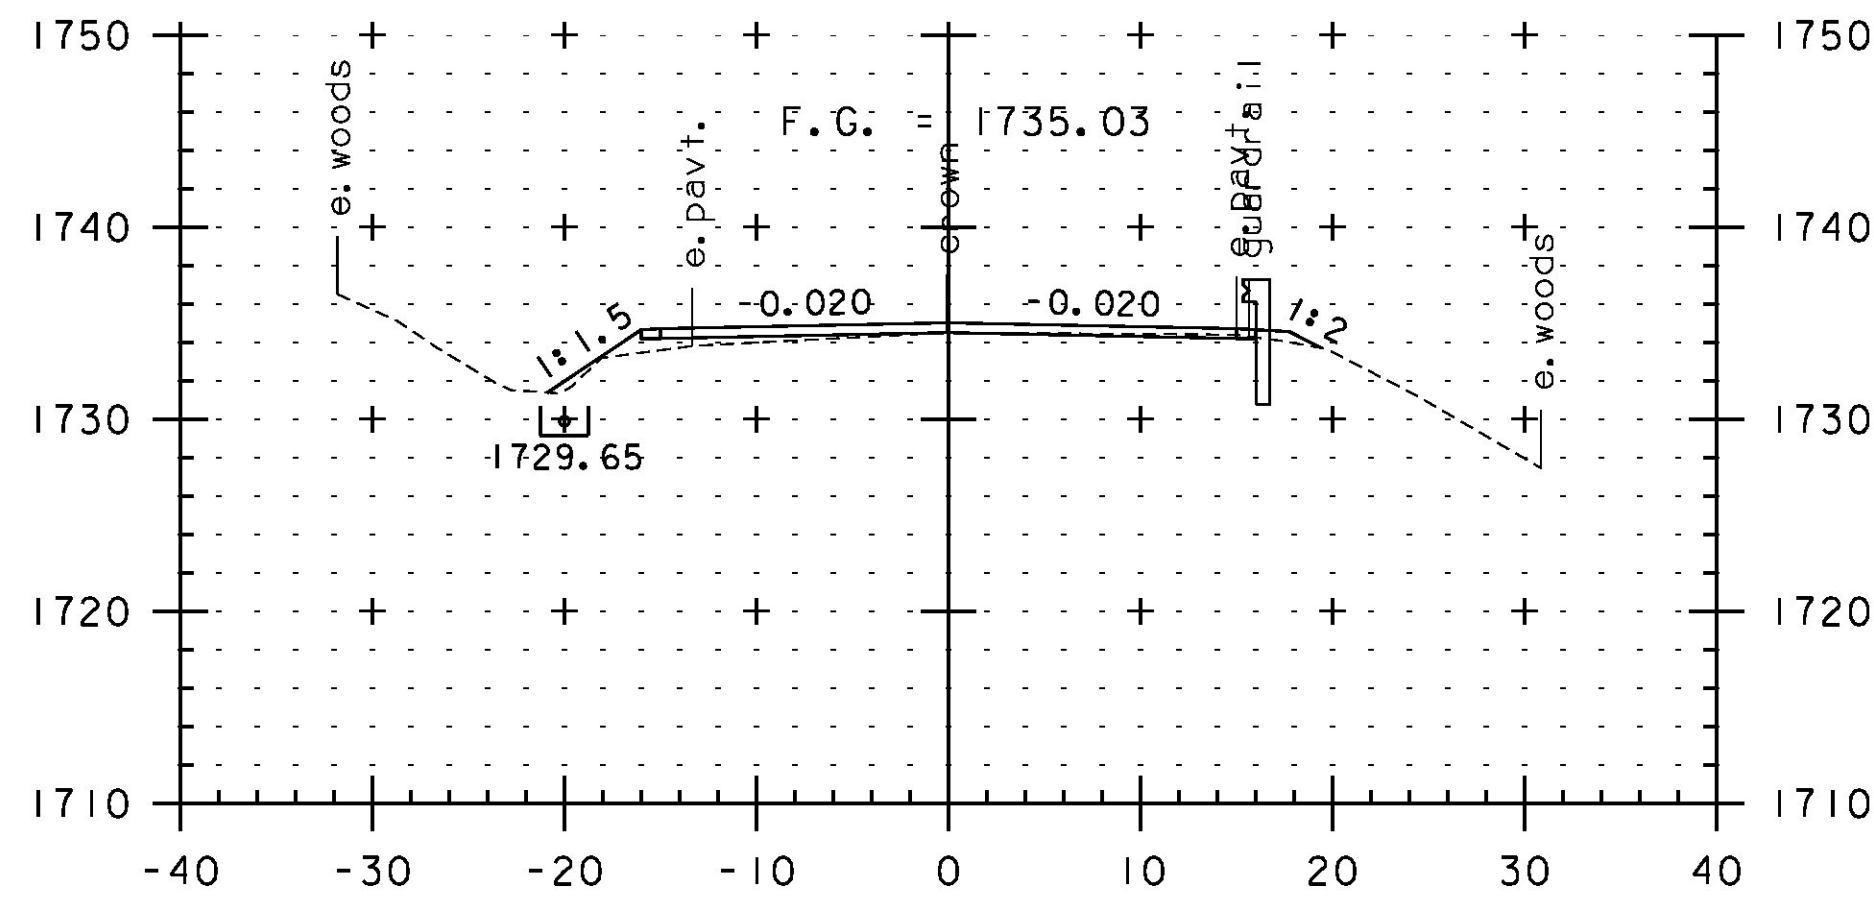


246+50

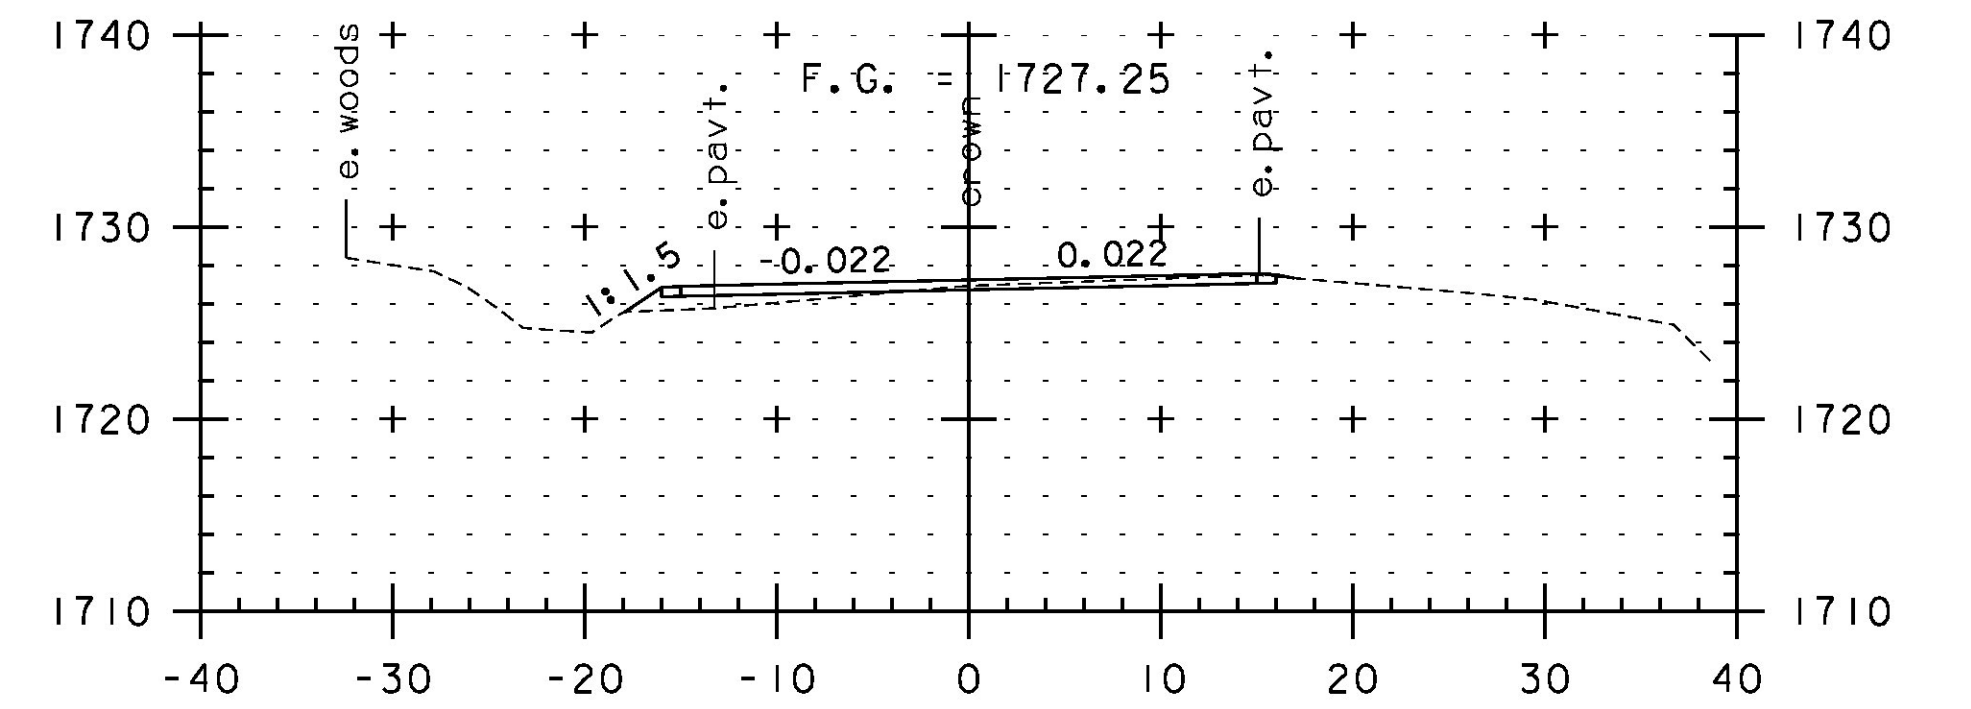


248+00

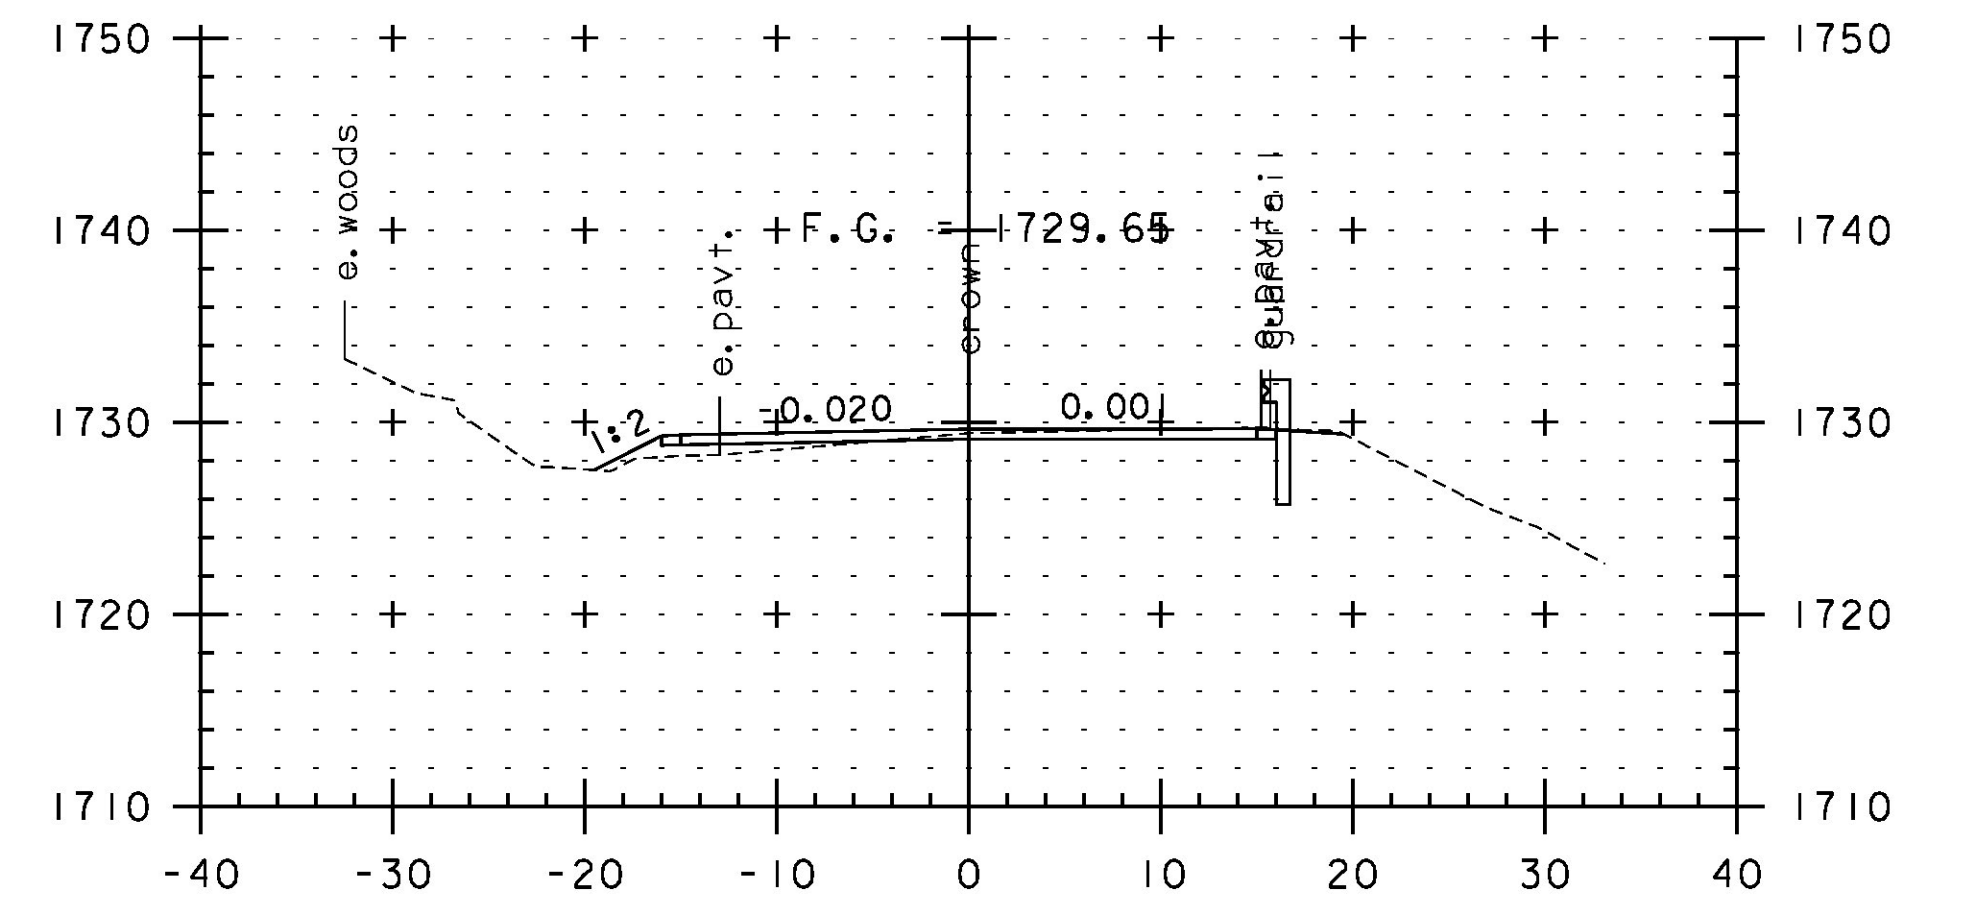


247+50

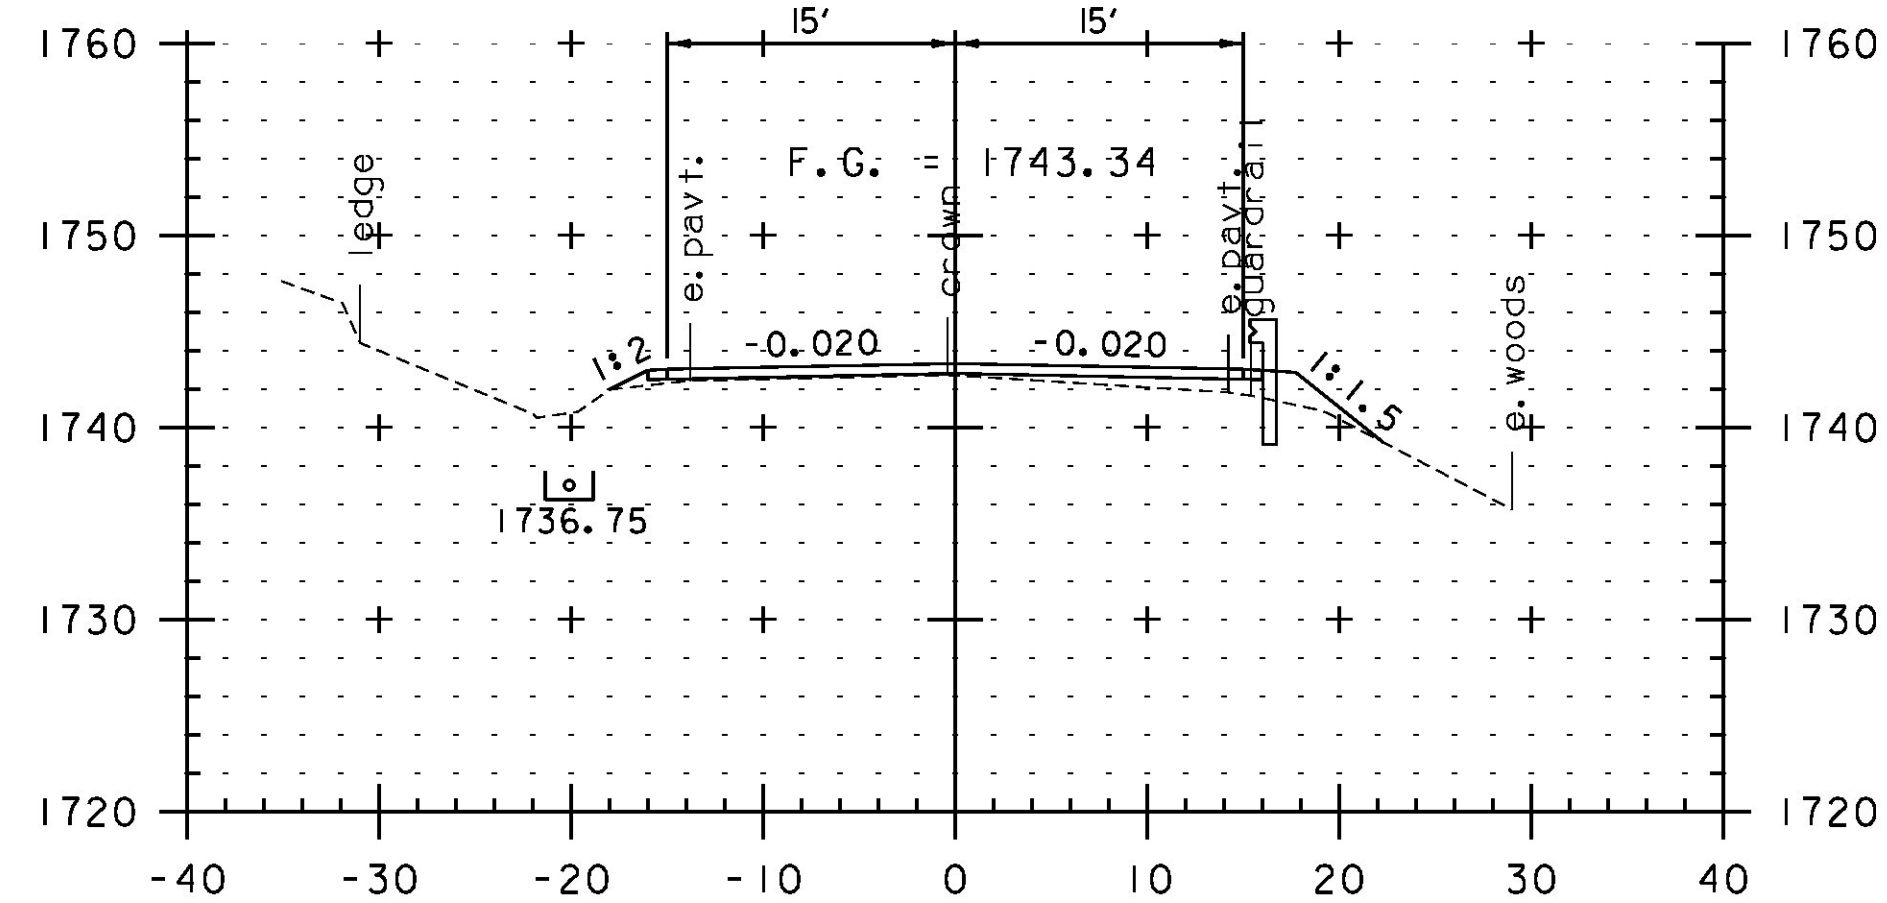


245+00

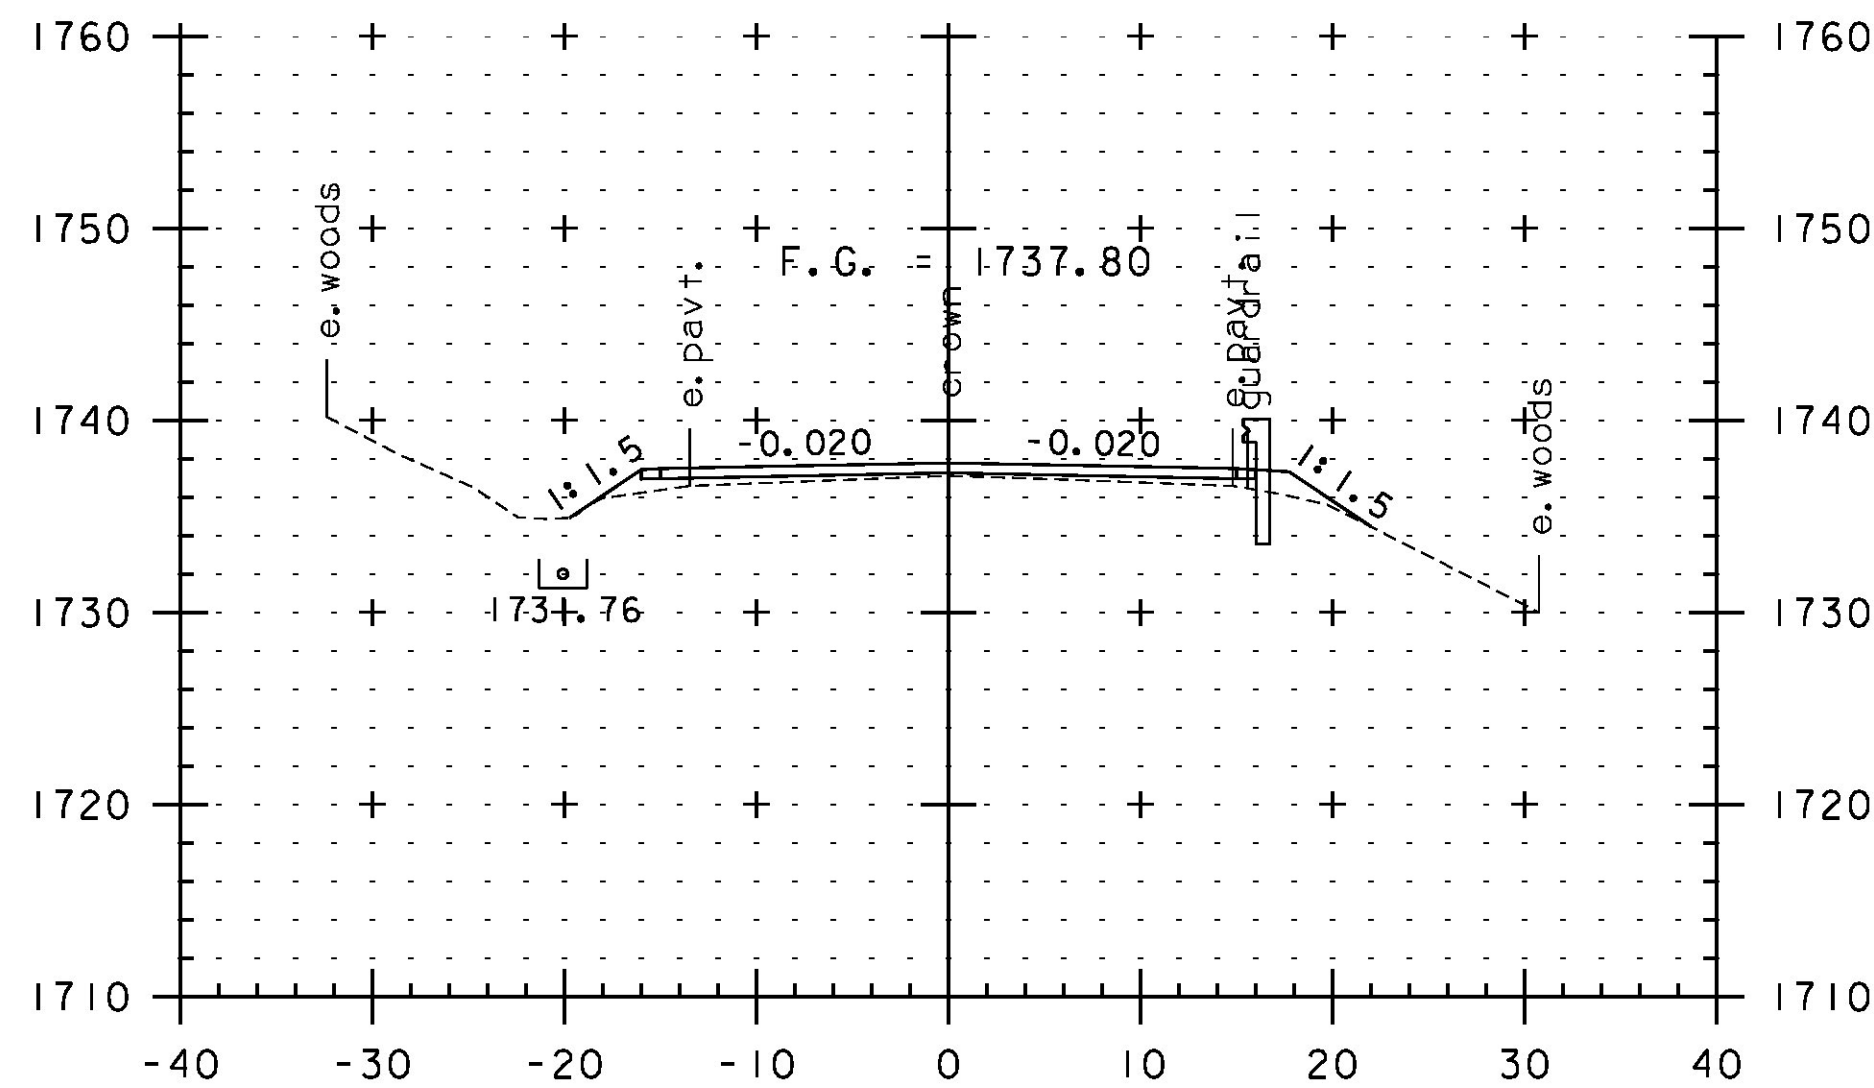

246+00

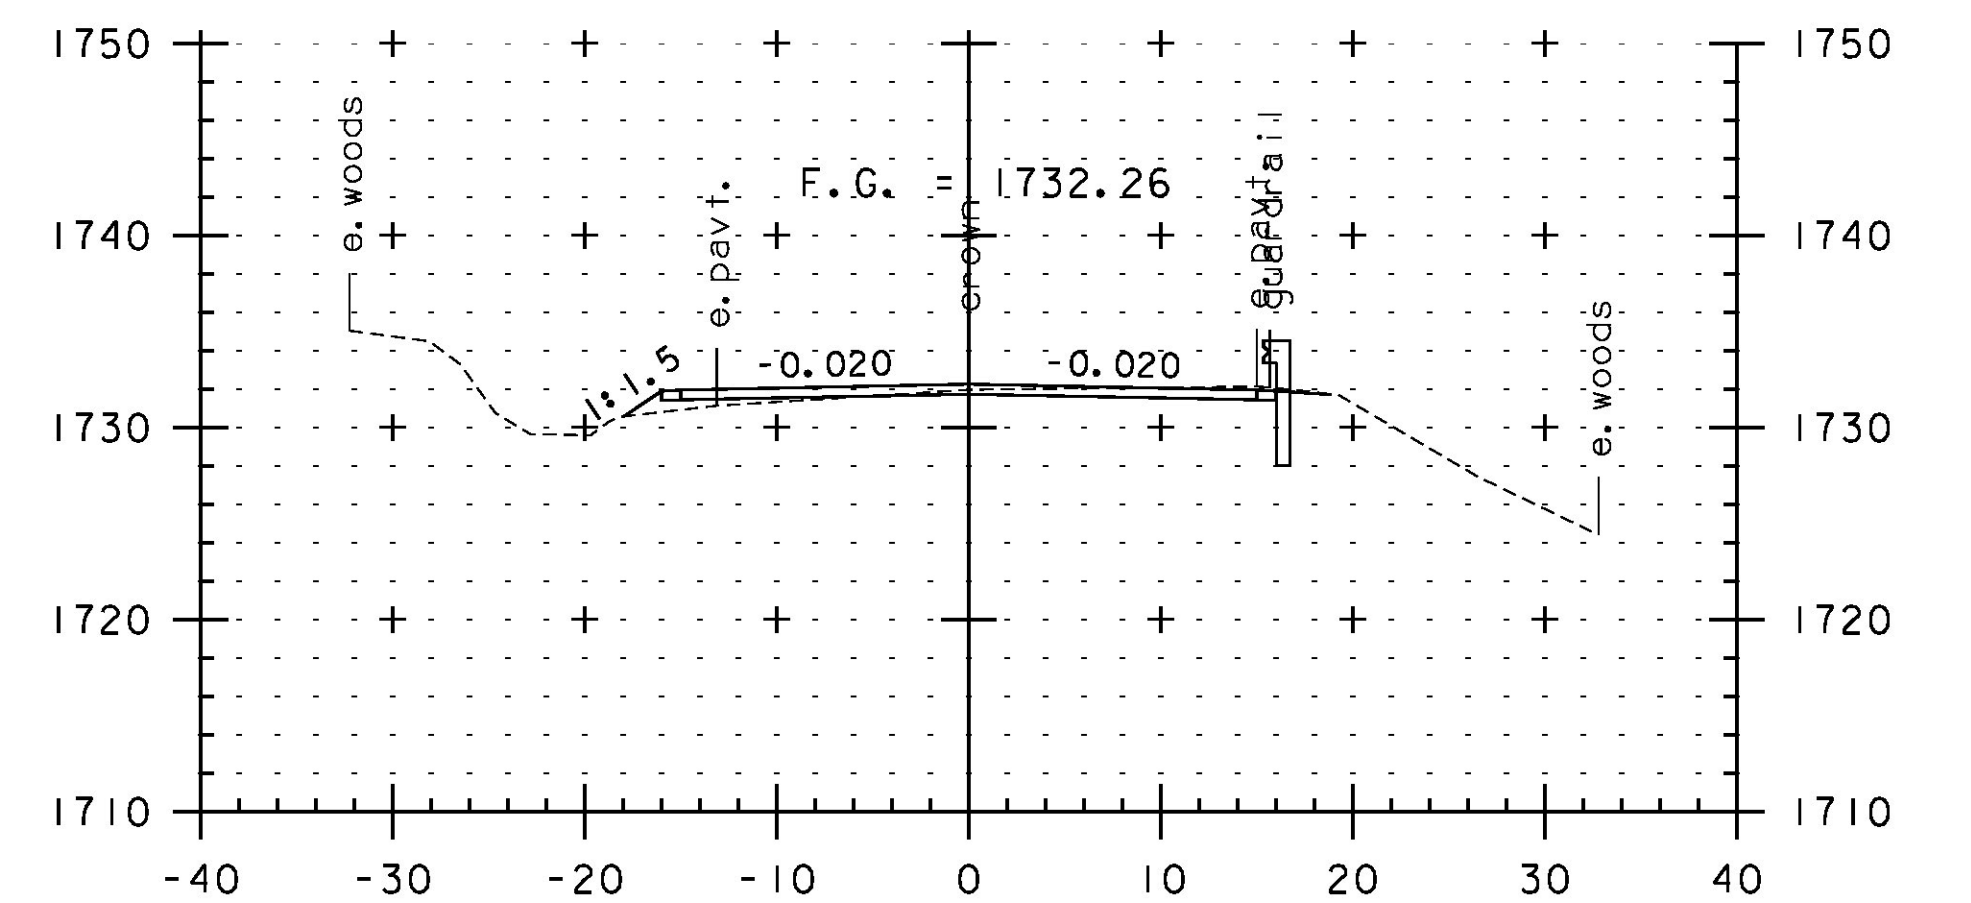

247+00

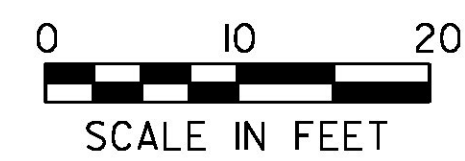

STA. 245+00 TO STA. 248+00

PROJECT NAME:	JAY-TROY	PLOT DATE:	5/16/2014
PROJECT NUMBER:	STP 2315(I)	DRAWN BY:	W. GORDON
FILE NAME:	z10b232xs.dgn	CHECKED BY:	P. SHEDD
PROJECT LEADER:	P. SHEDD	CROSS SECTION SHEET	55
DESIGNED BY:	N. LEMAY	SHEET	191 OF 244