




249+50

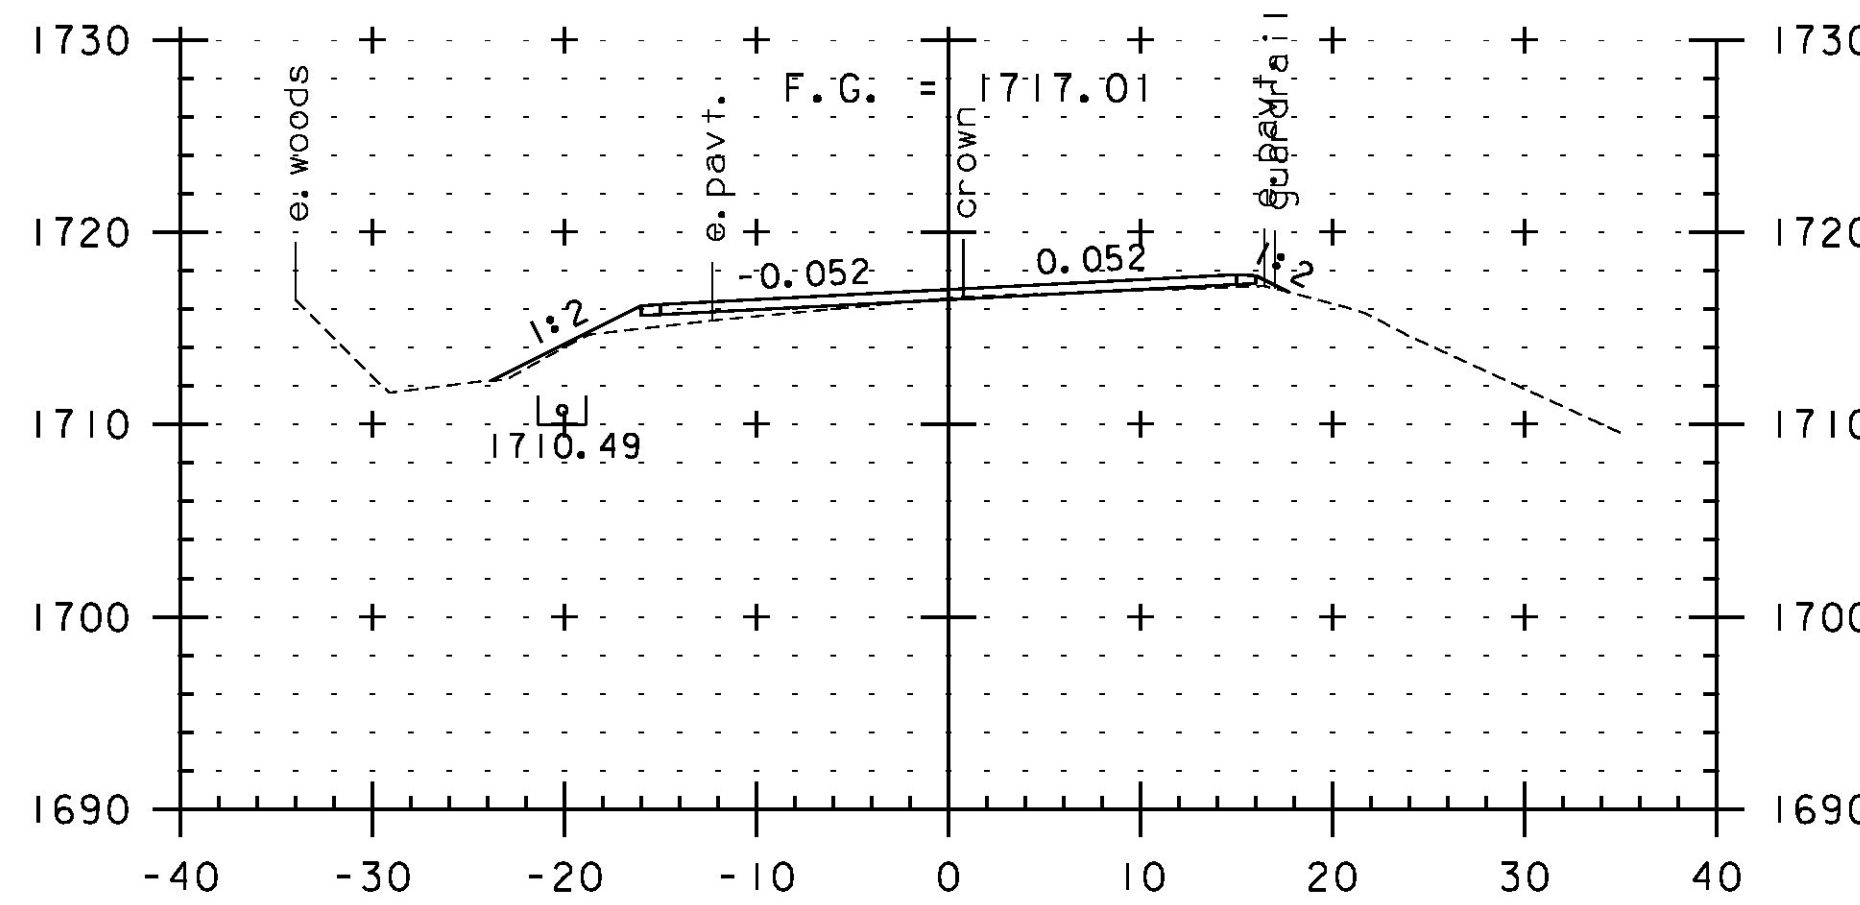


251+00

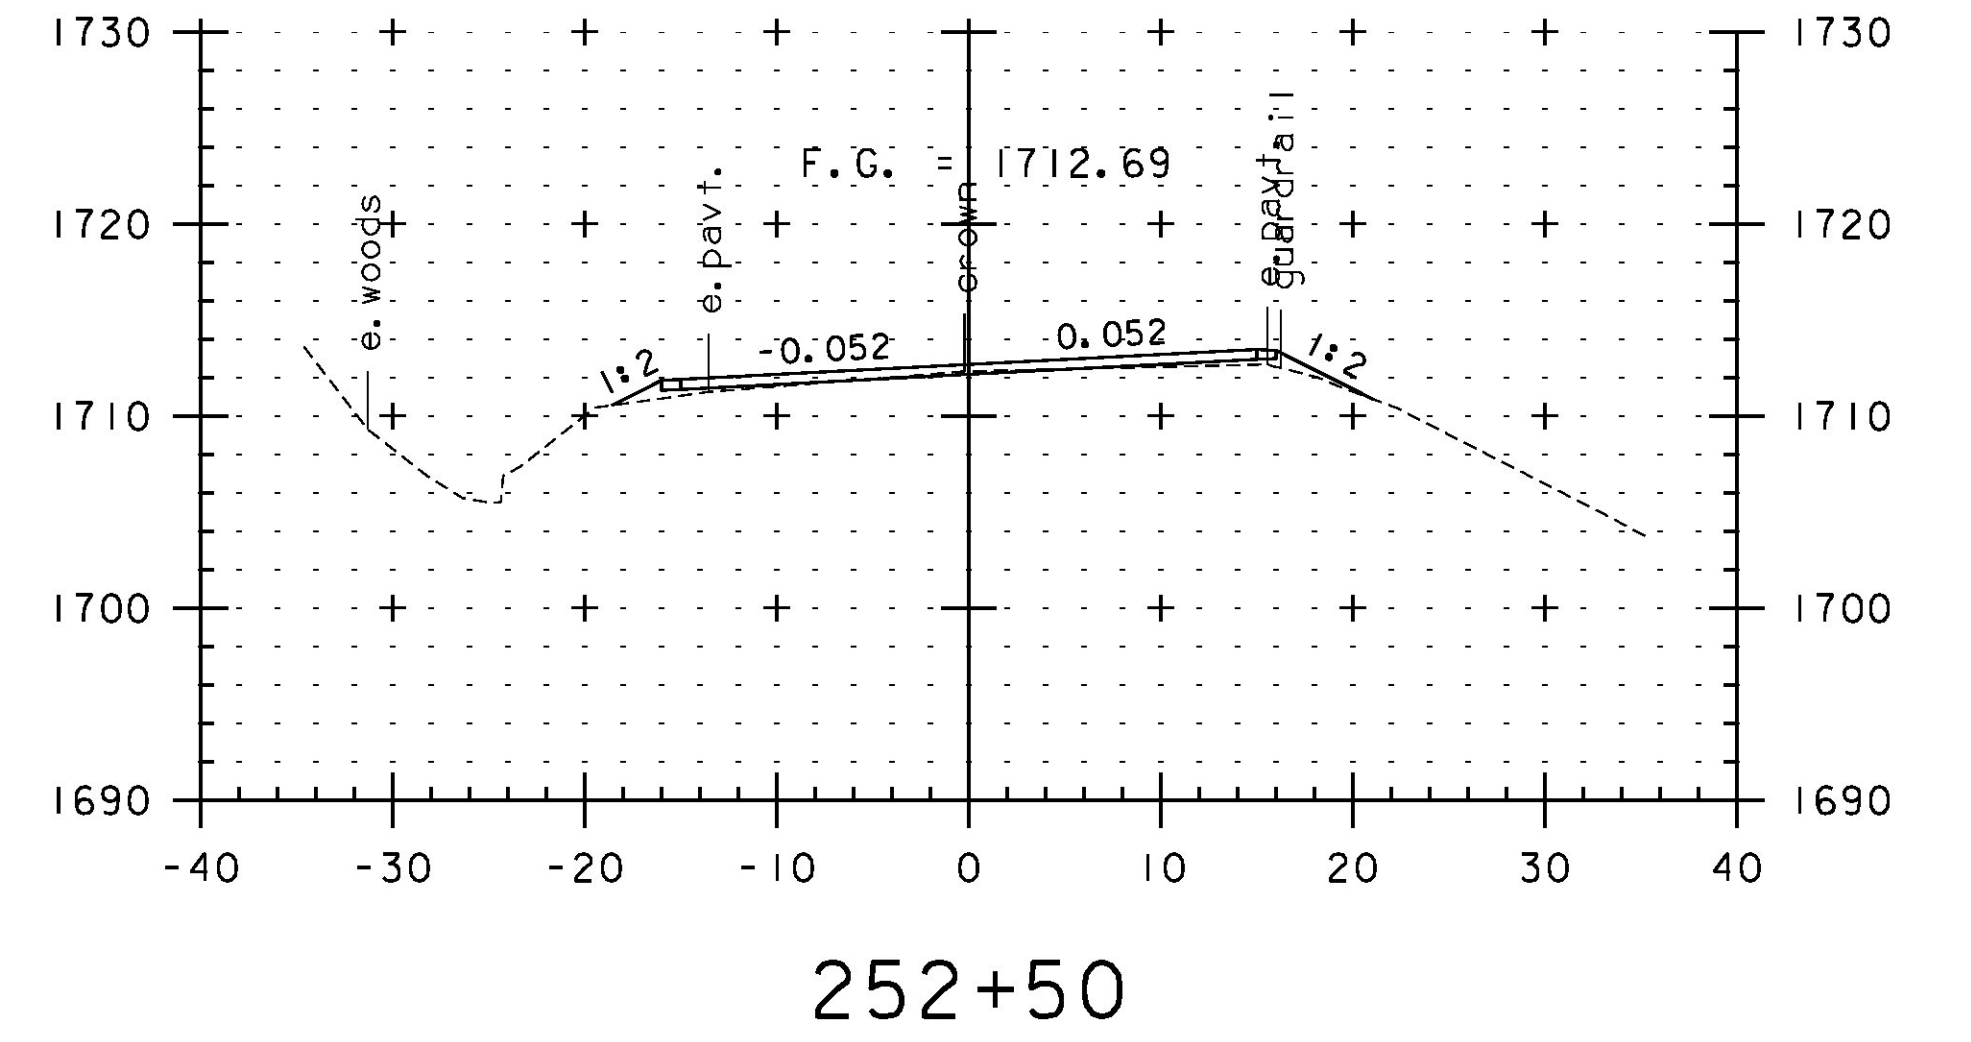


252+50

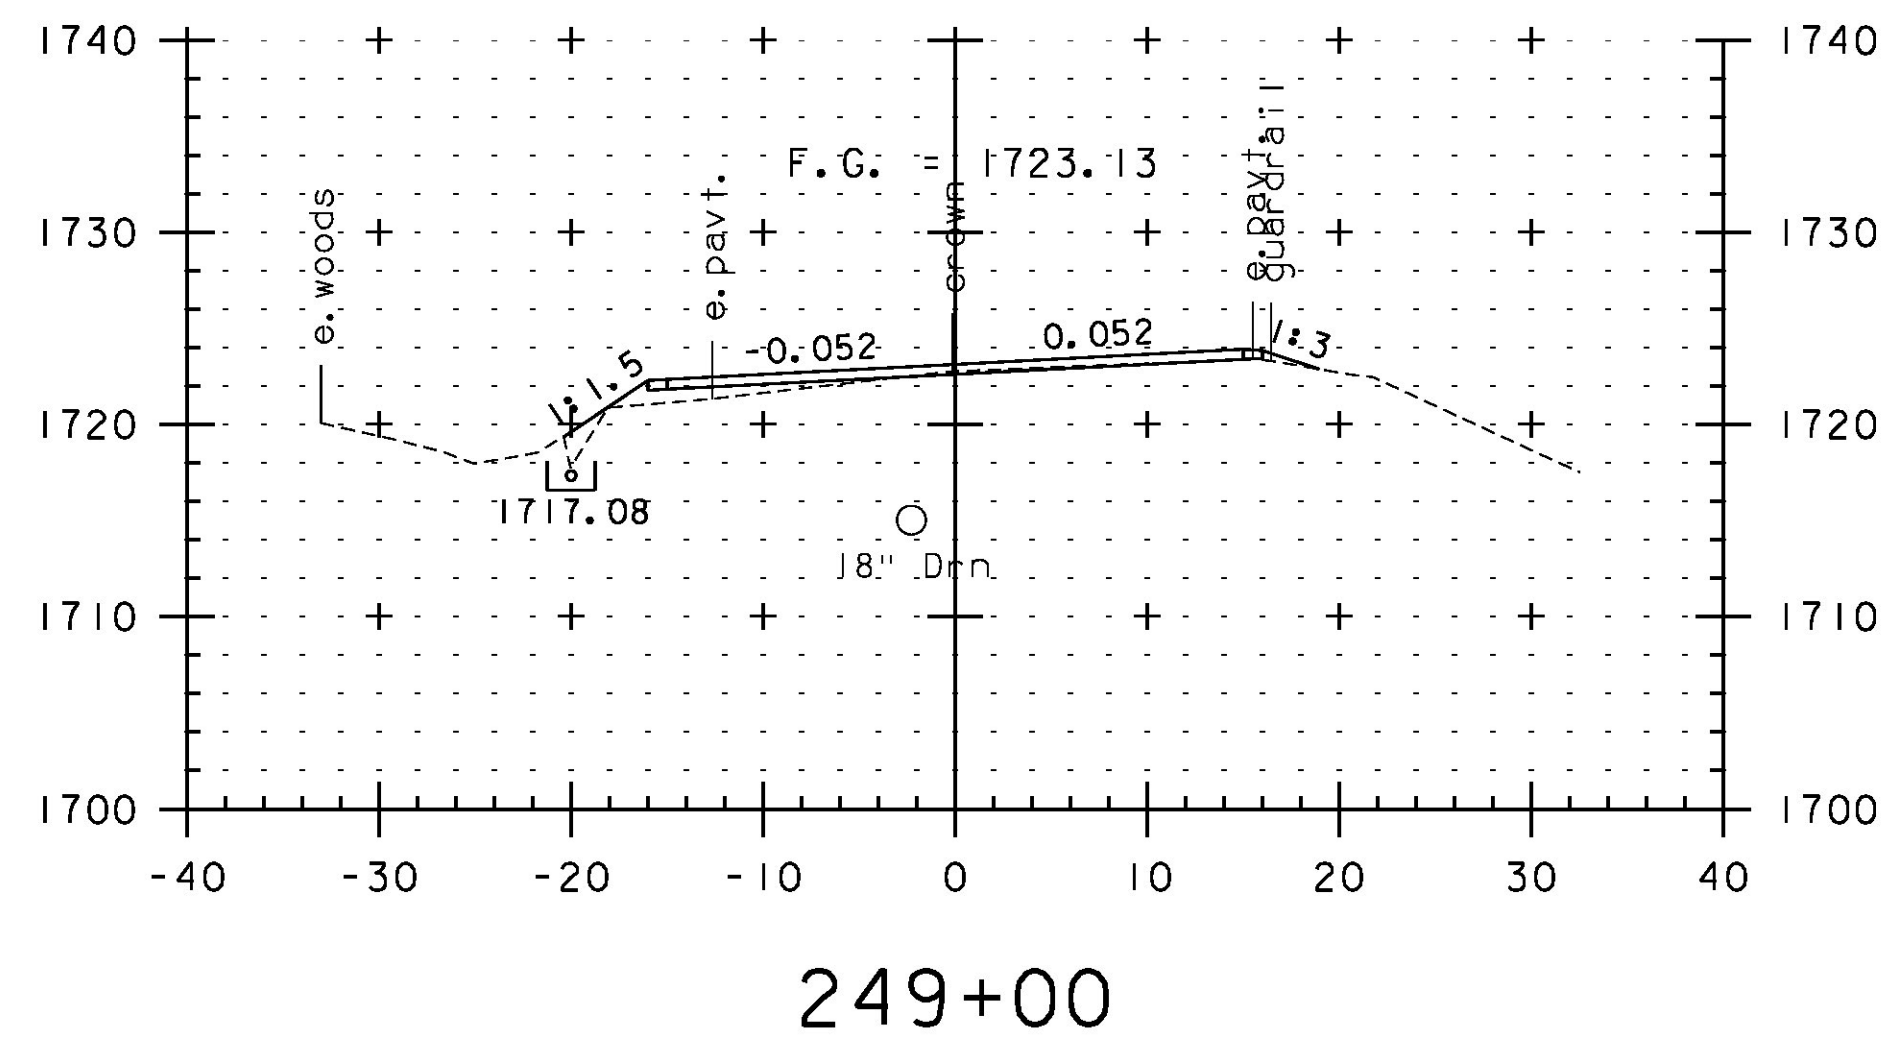


249+00

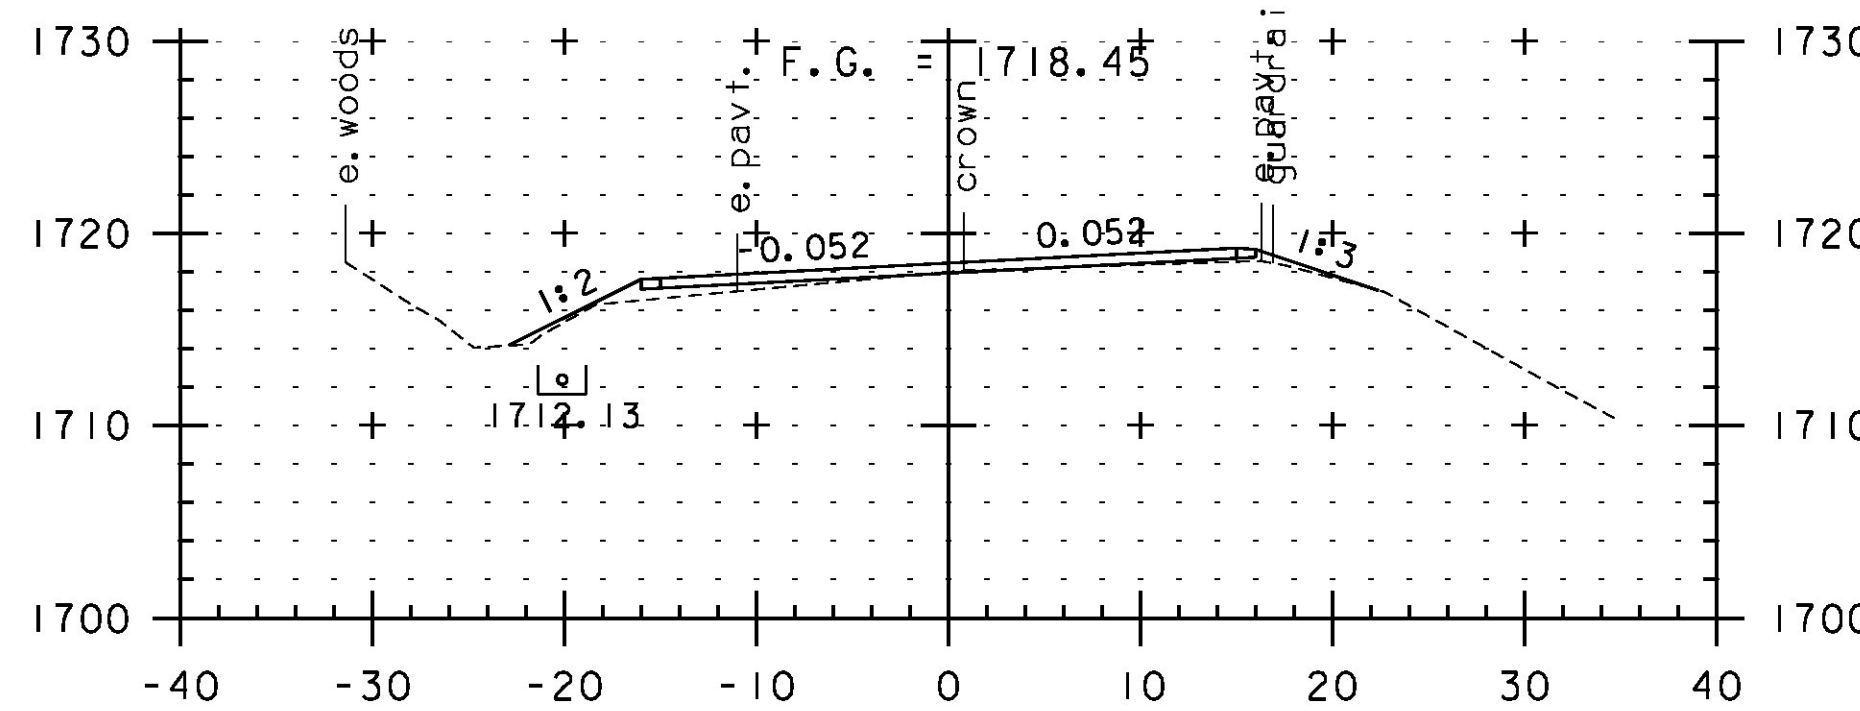


250+50

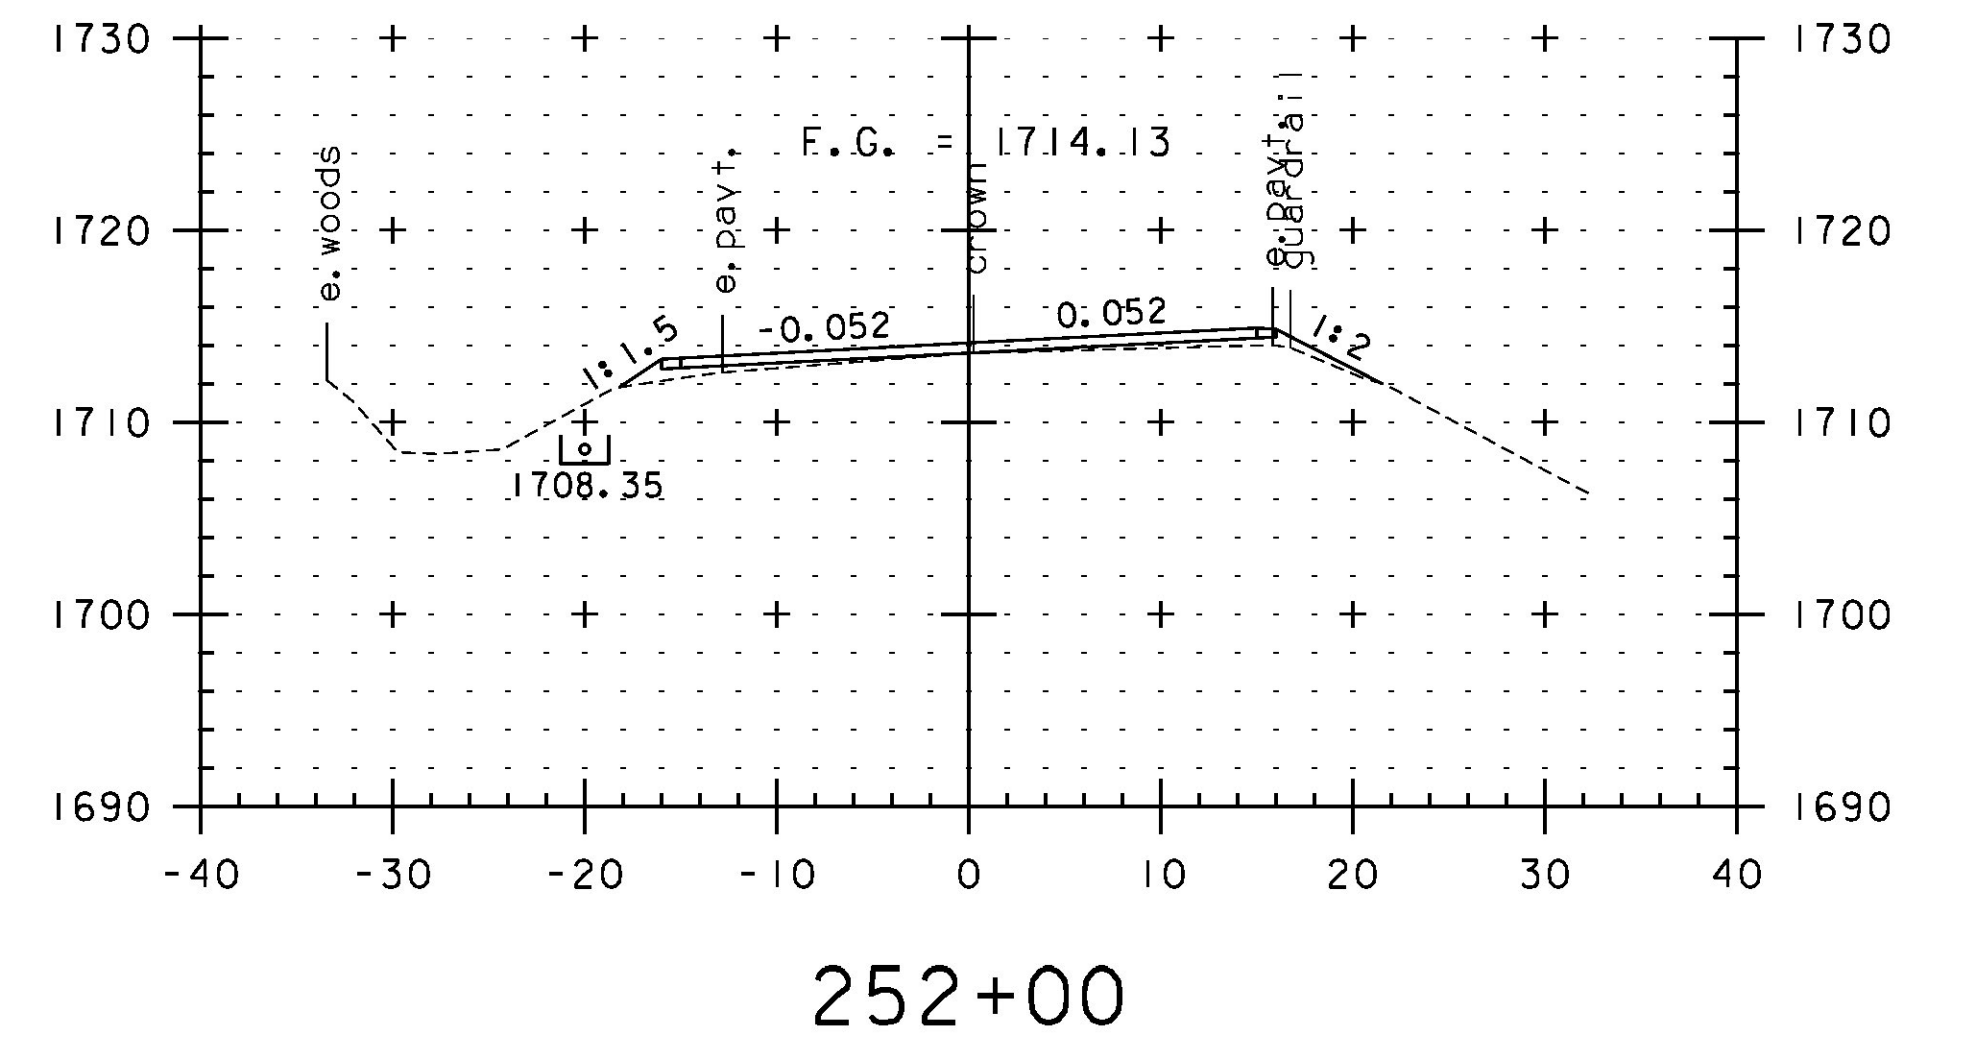


252+00

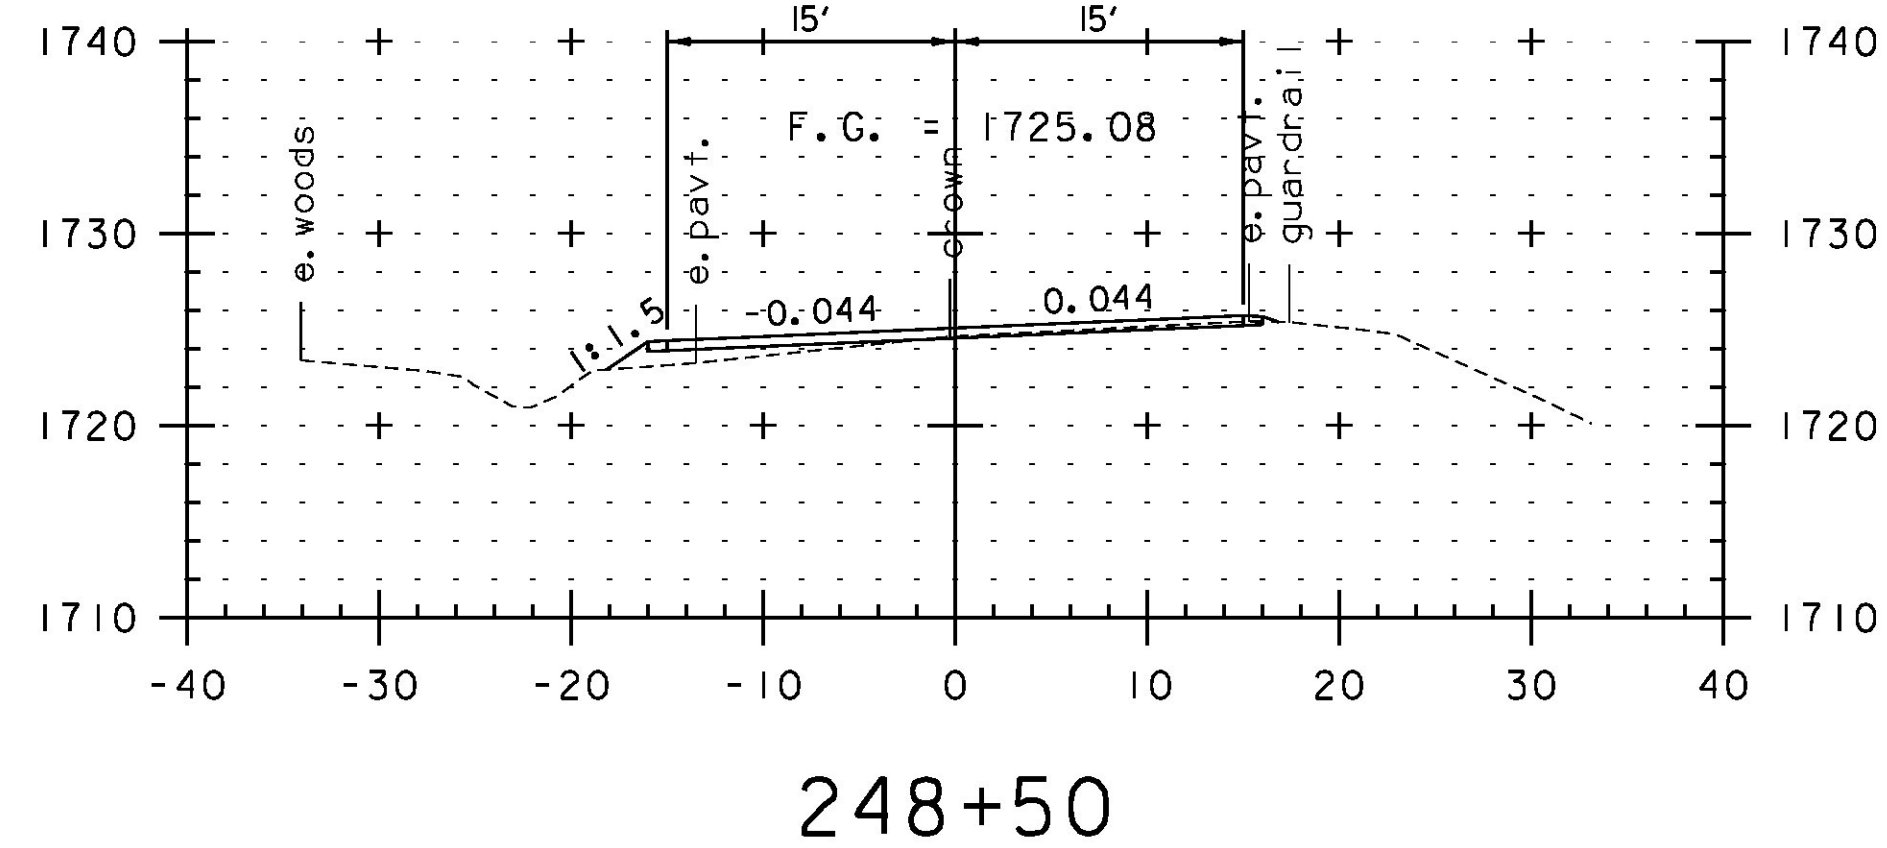

248+50

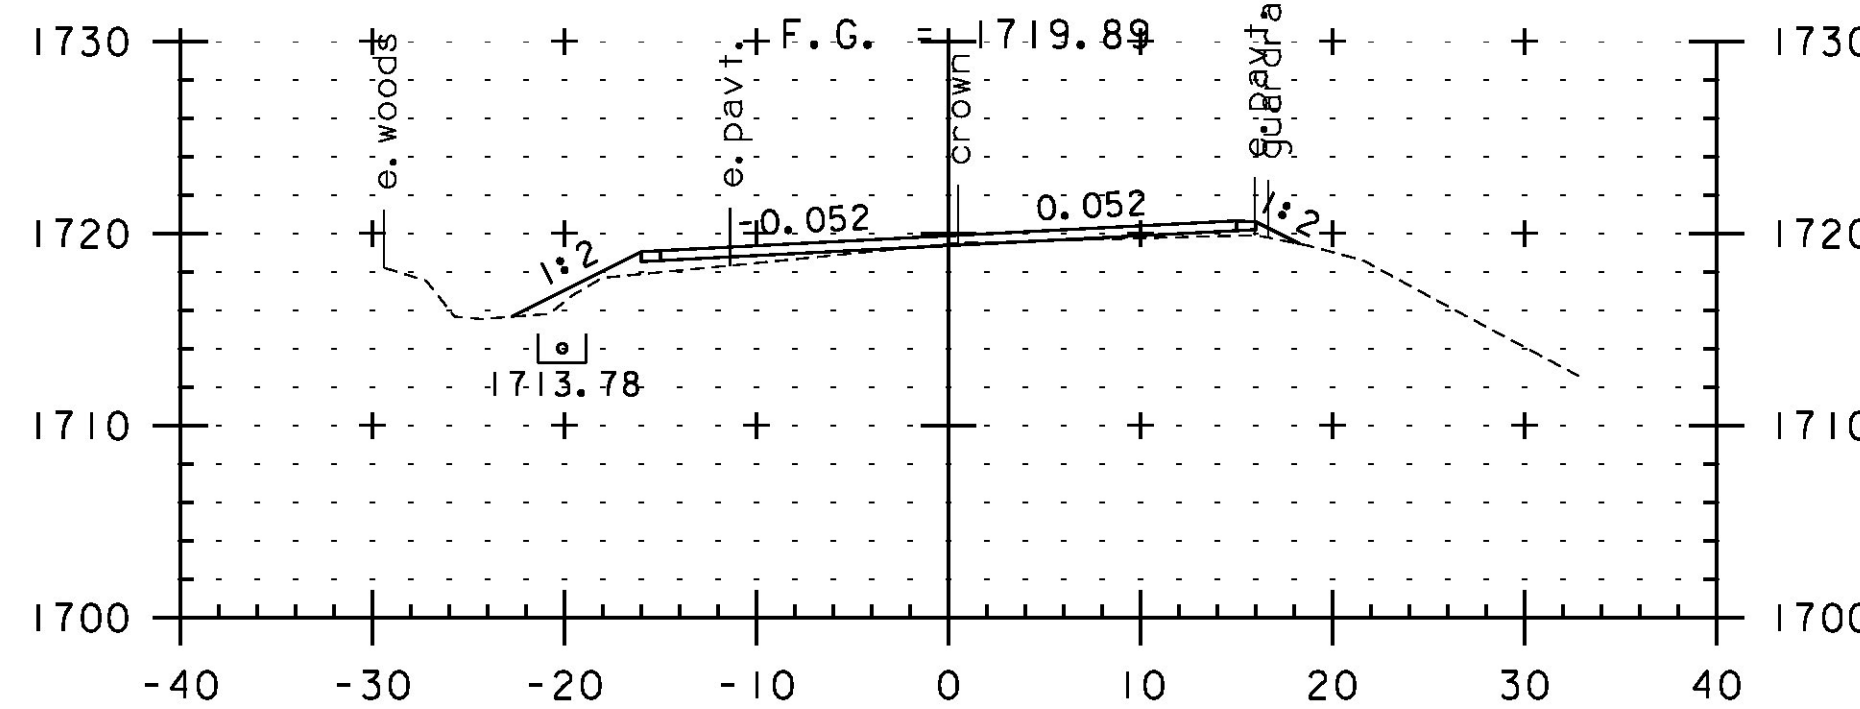

250+00

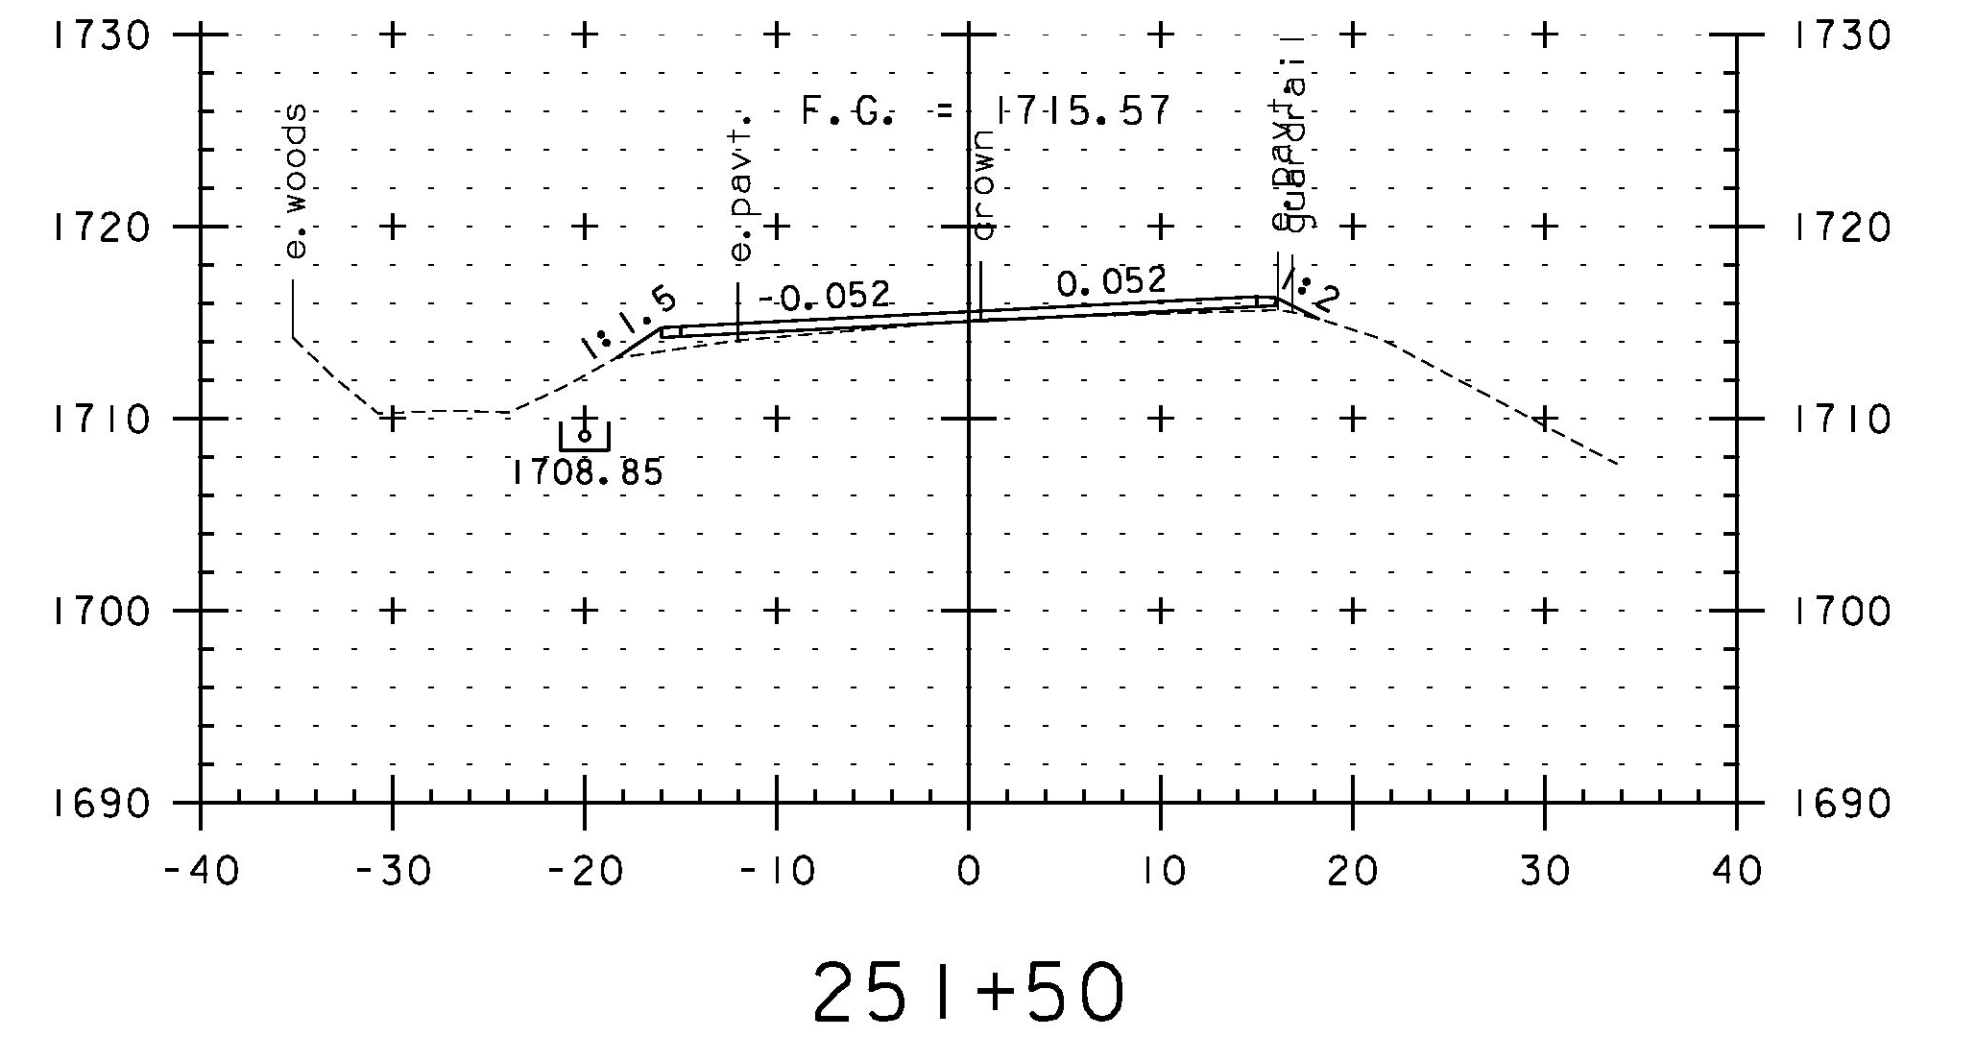

251+50



SCALE IN FEET

STA. 248+50 TO STA. 252+50

PROJECT NAME:	JAY-TROY	PLOT DATE:	5/16/2014
PROJECT NUMBER:	STP 2315(1)	DRAWN BY:	W. GORDON
FILE NAME:	z10b232xs.dgn	CHECKED BY:	P. SHEDD
PROJECT LEADER:	P. SHEDD	CROSS SECTION SHEET	56
DESIGNED BY:	N. LEMAY	SHEET	192 OF 244