




255+00

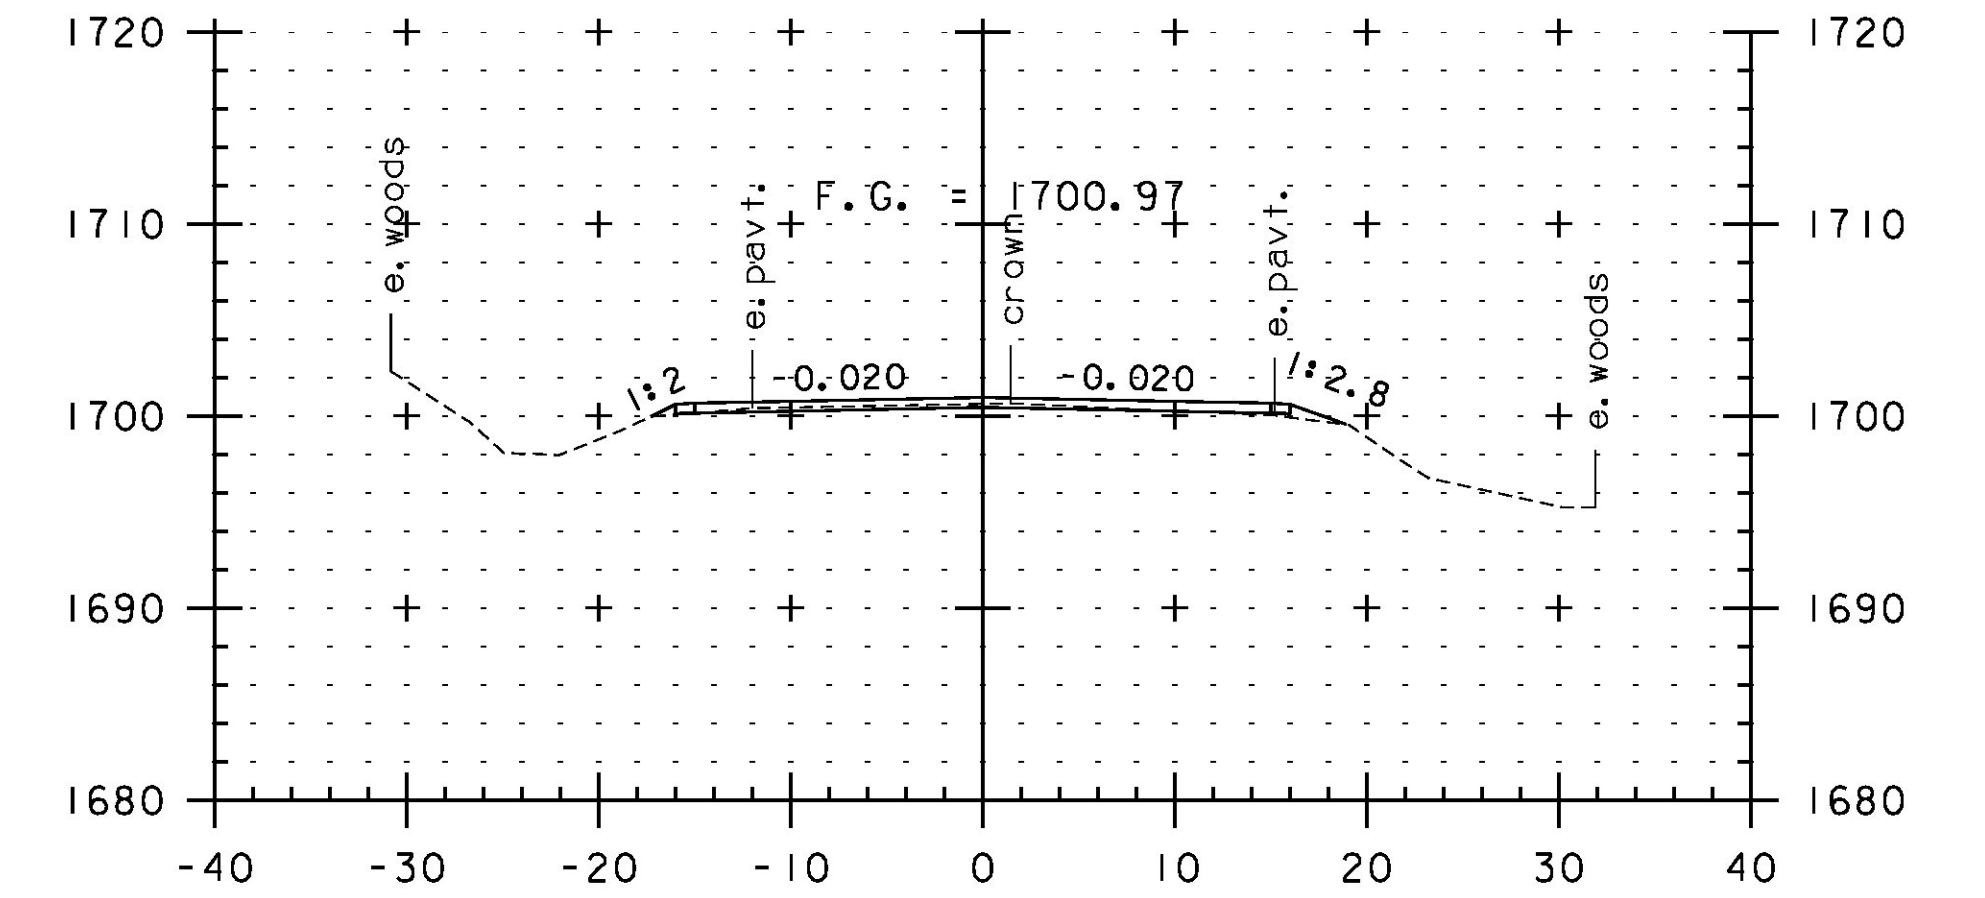


256+50

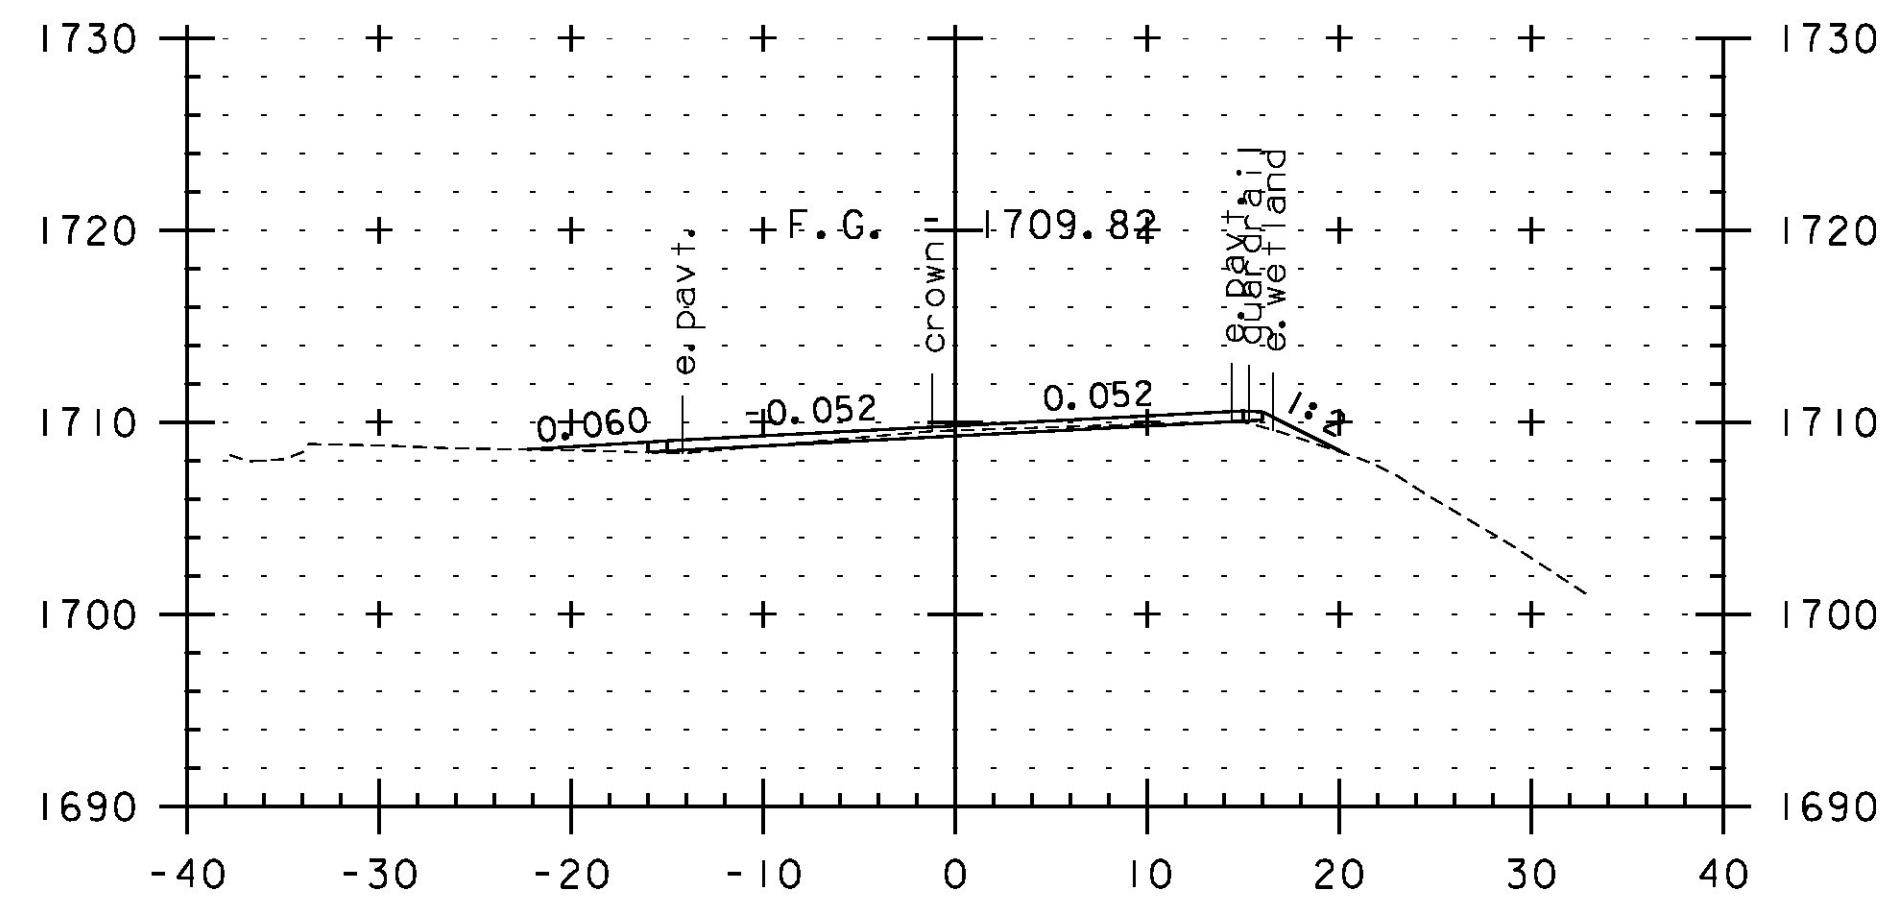


253+50

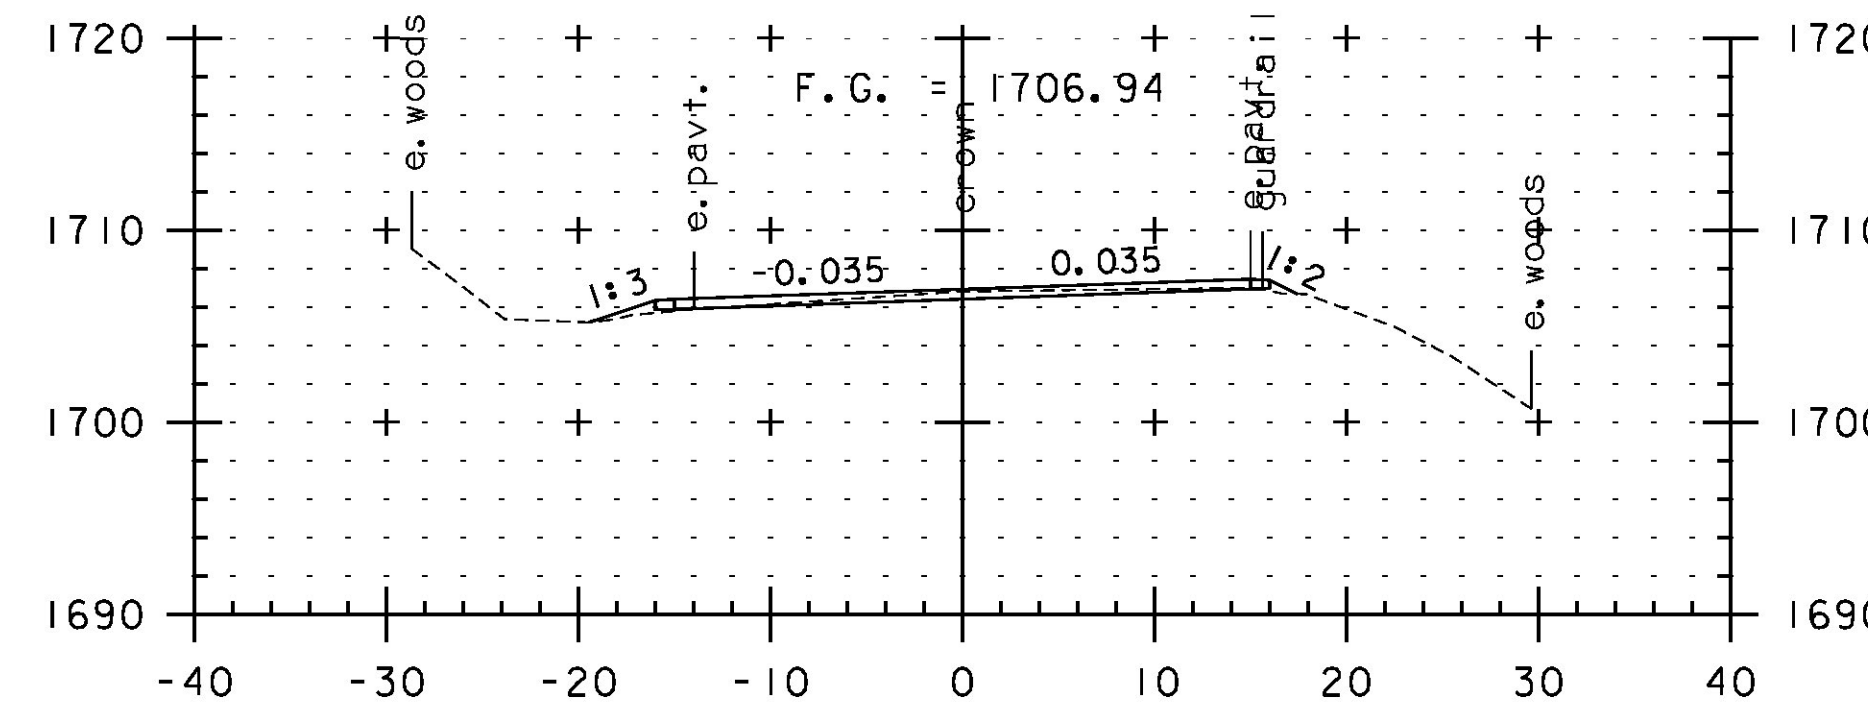


254+50

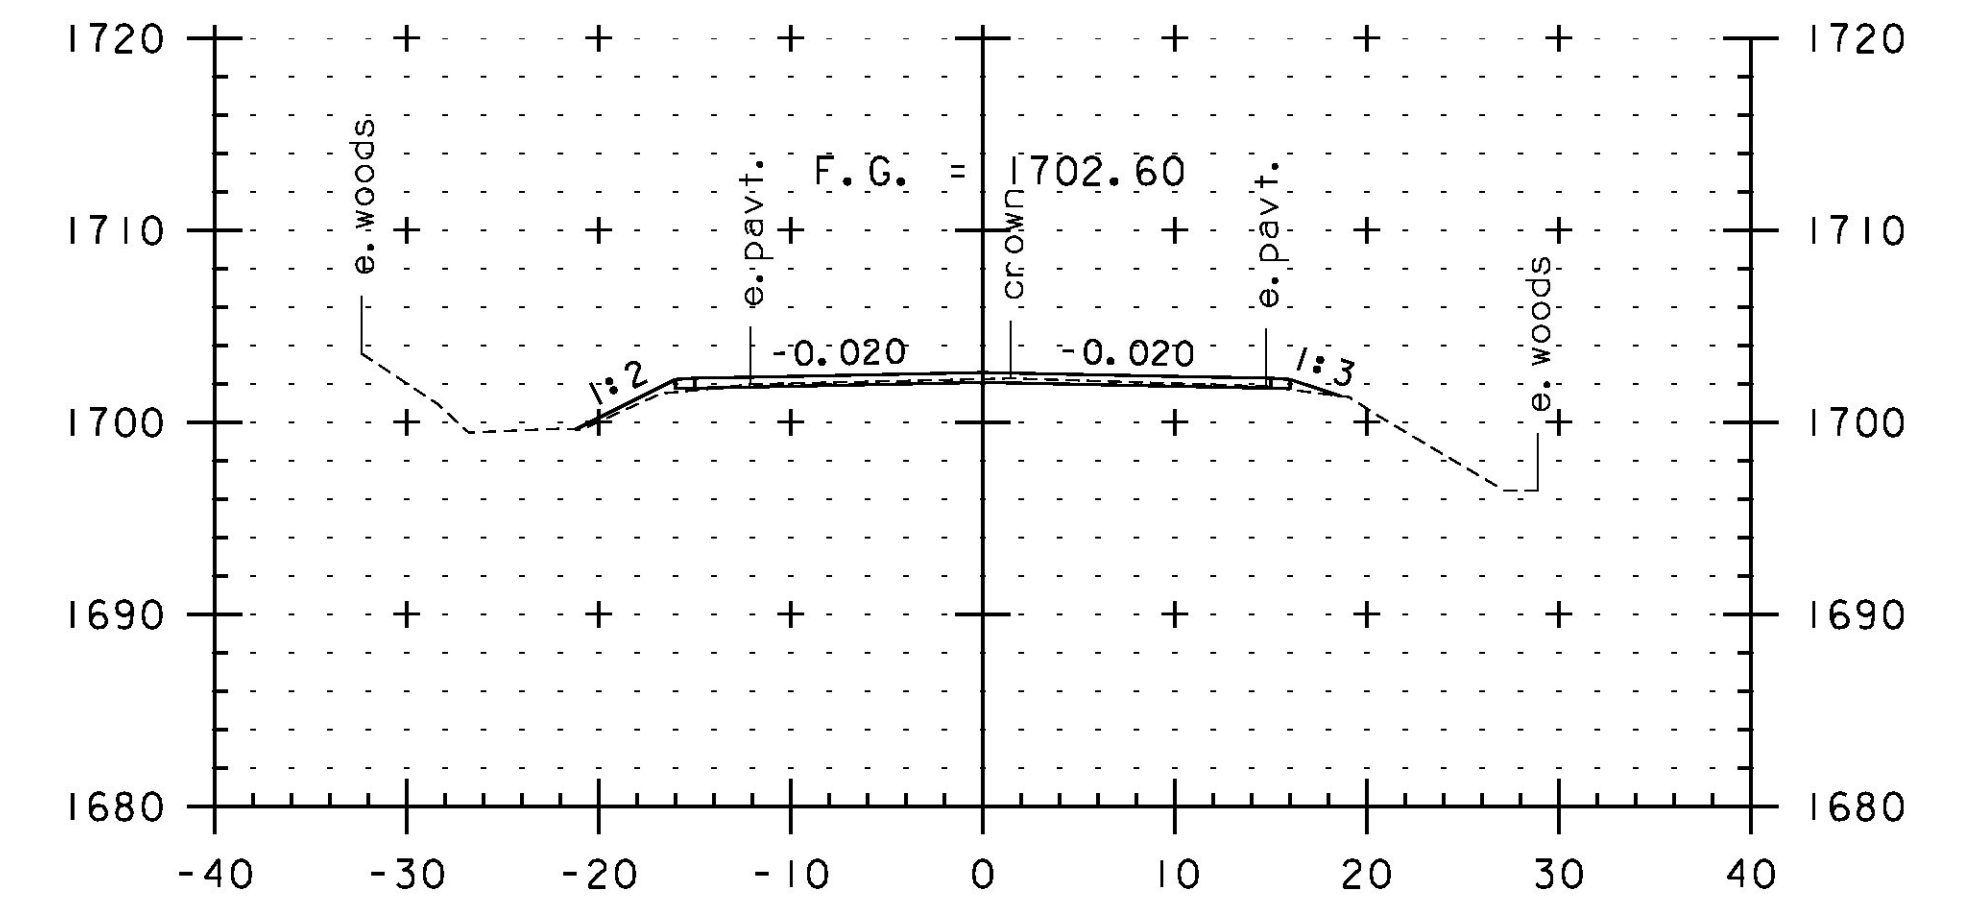


256+00

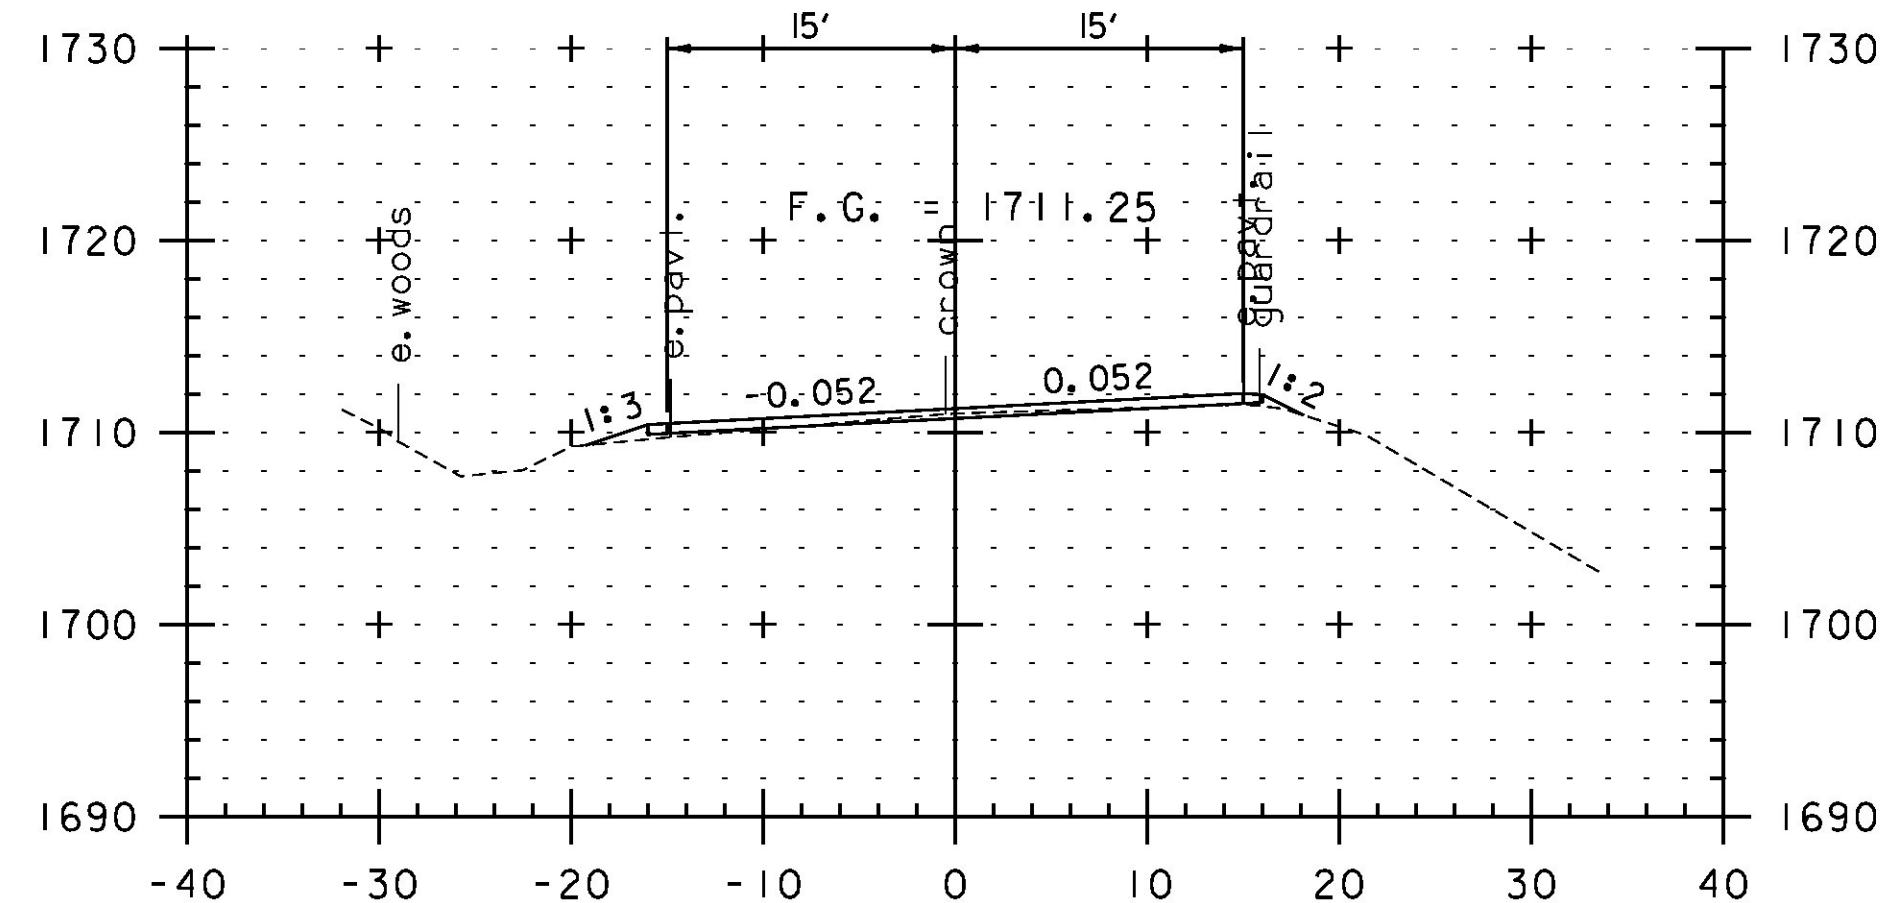


253+00

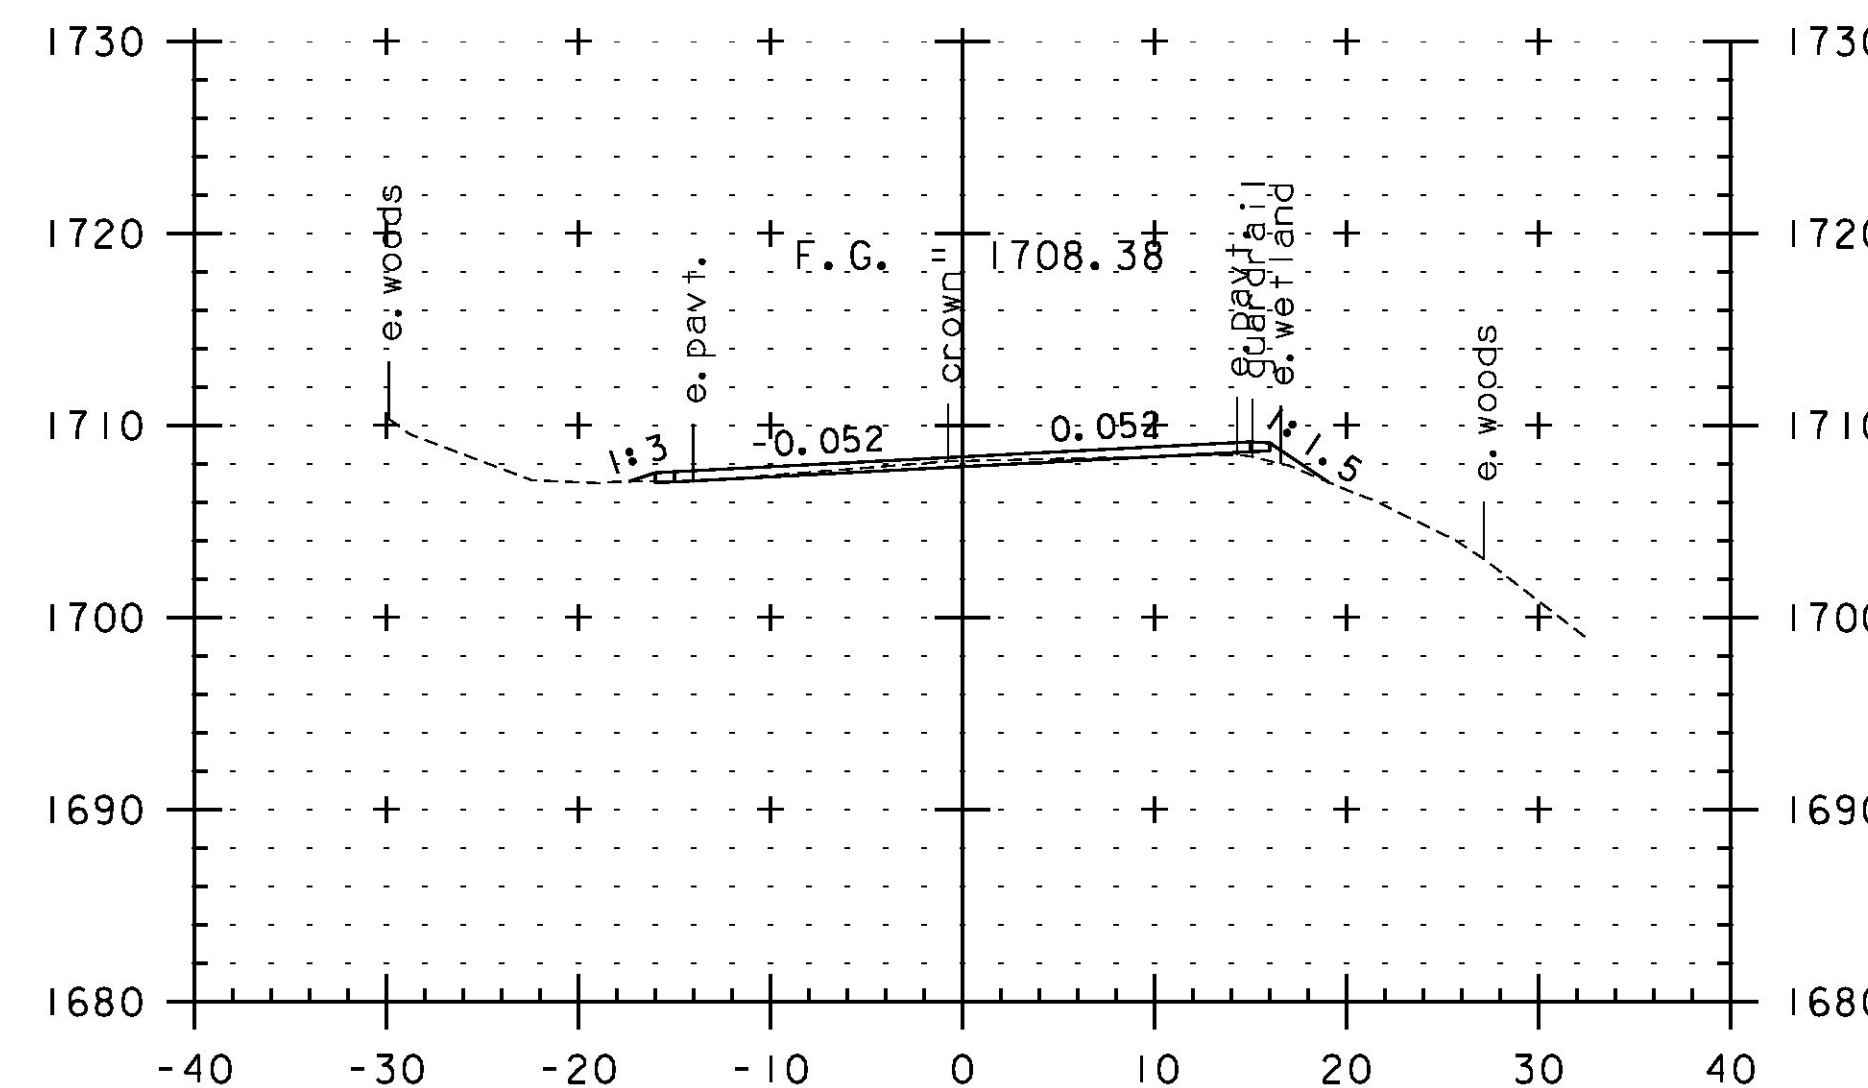

254+00

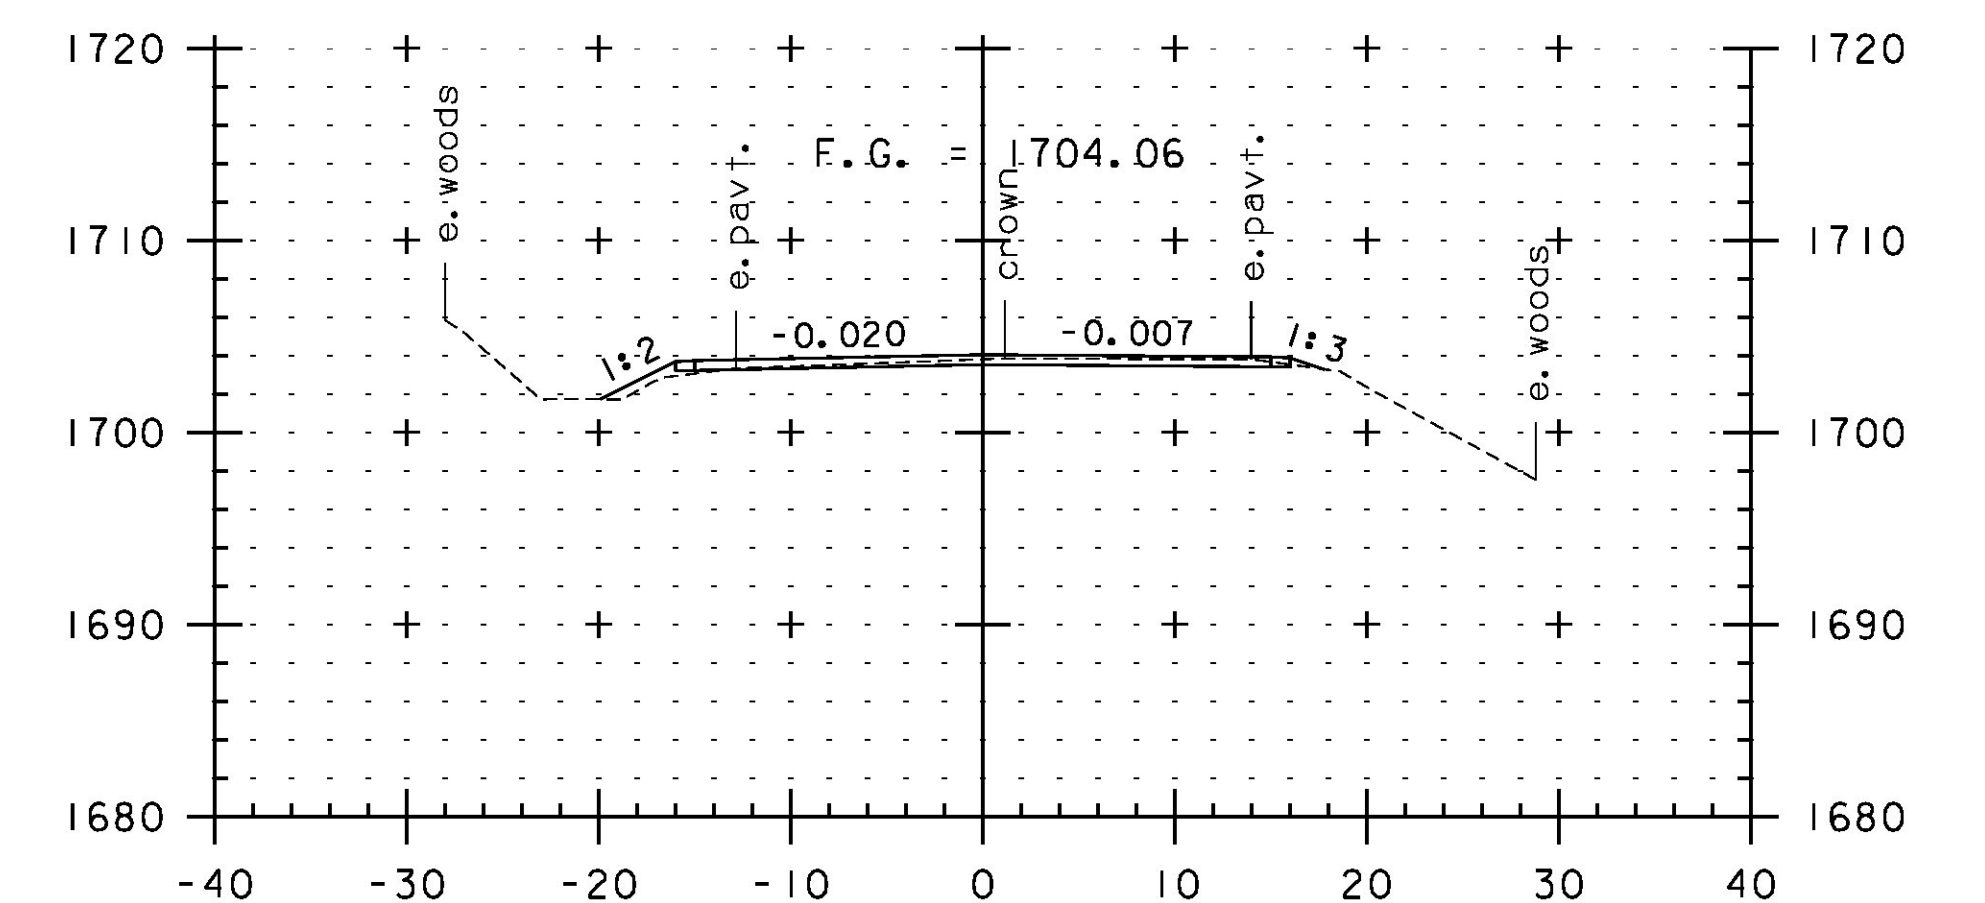

255+50

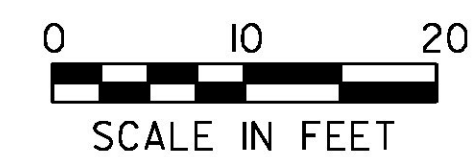

STA. 253+00 TO STA. 256+50

PROJECT NAME:	JAY-TROY	PLOT DATE:	5/16/2014
PROJECT NUMBER:	STP 2315(I)	DRAWN BY:	W. GORDON
FILE NAME:	z10b232xs.dgn	DESIGNED BY:	N. LEMAY
PROJECT LEADER:	P. SHEDD	CHECKED BY:	P. SHEDD
CROSS SECTION SHEET 57		SHEET	193 OF 244