




258+00

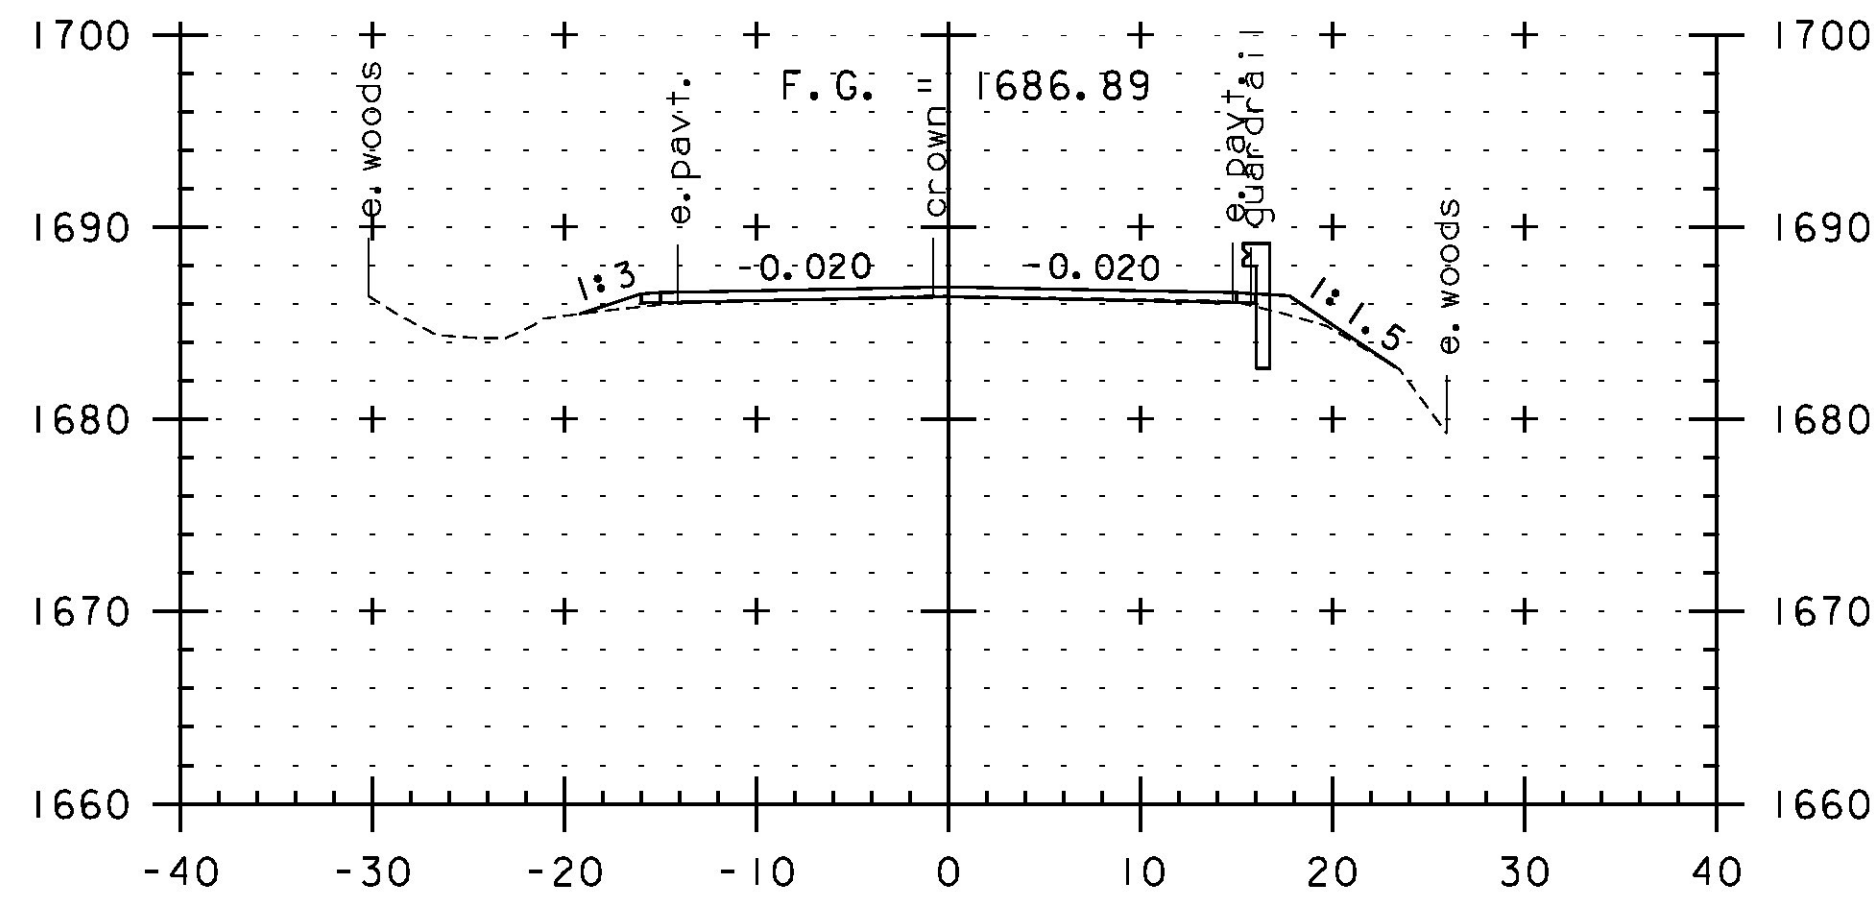


259+50

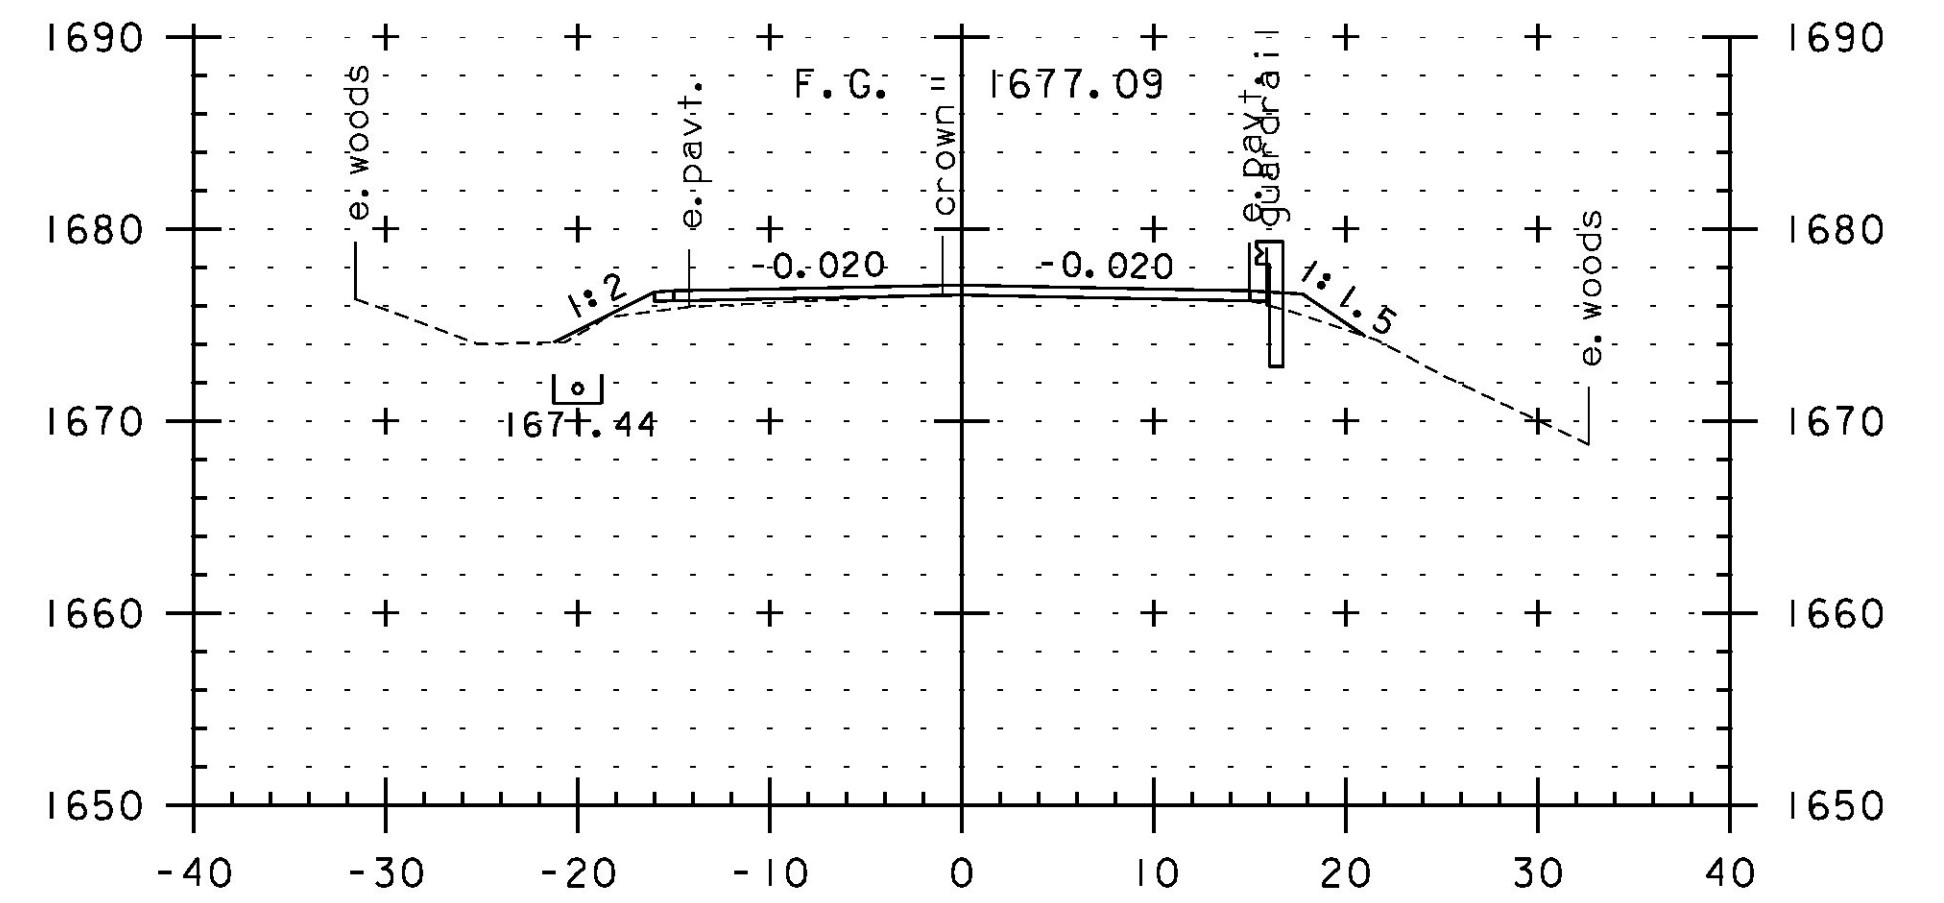


261+00

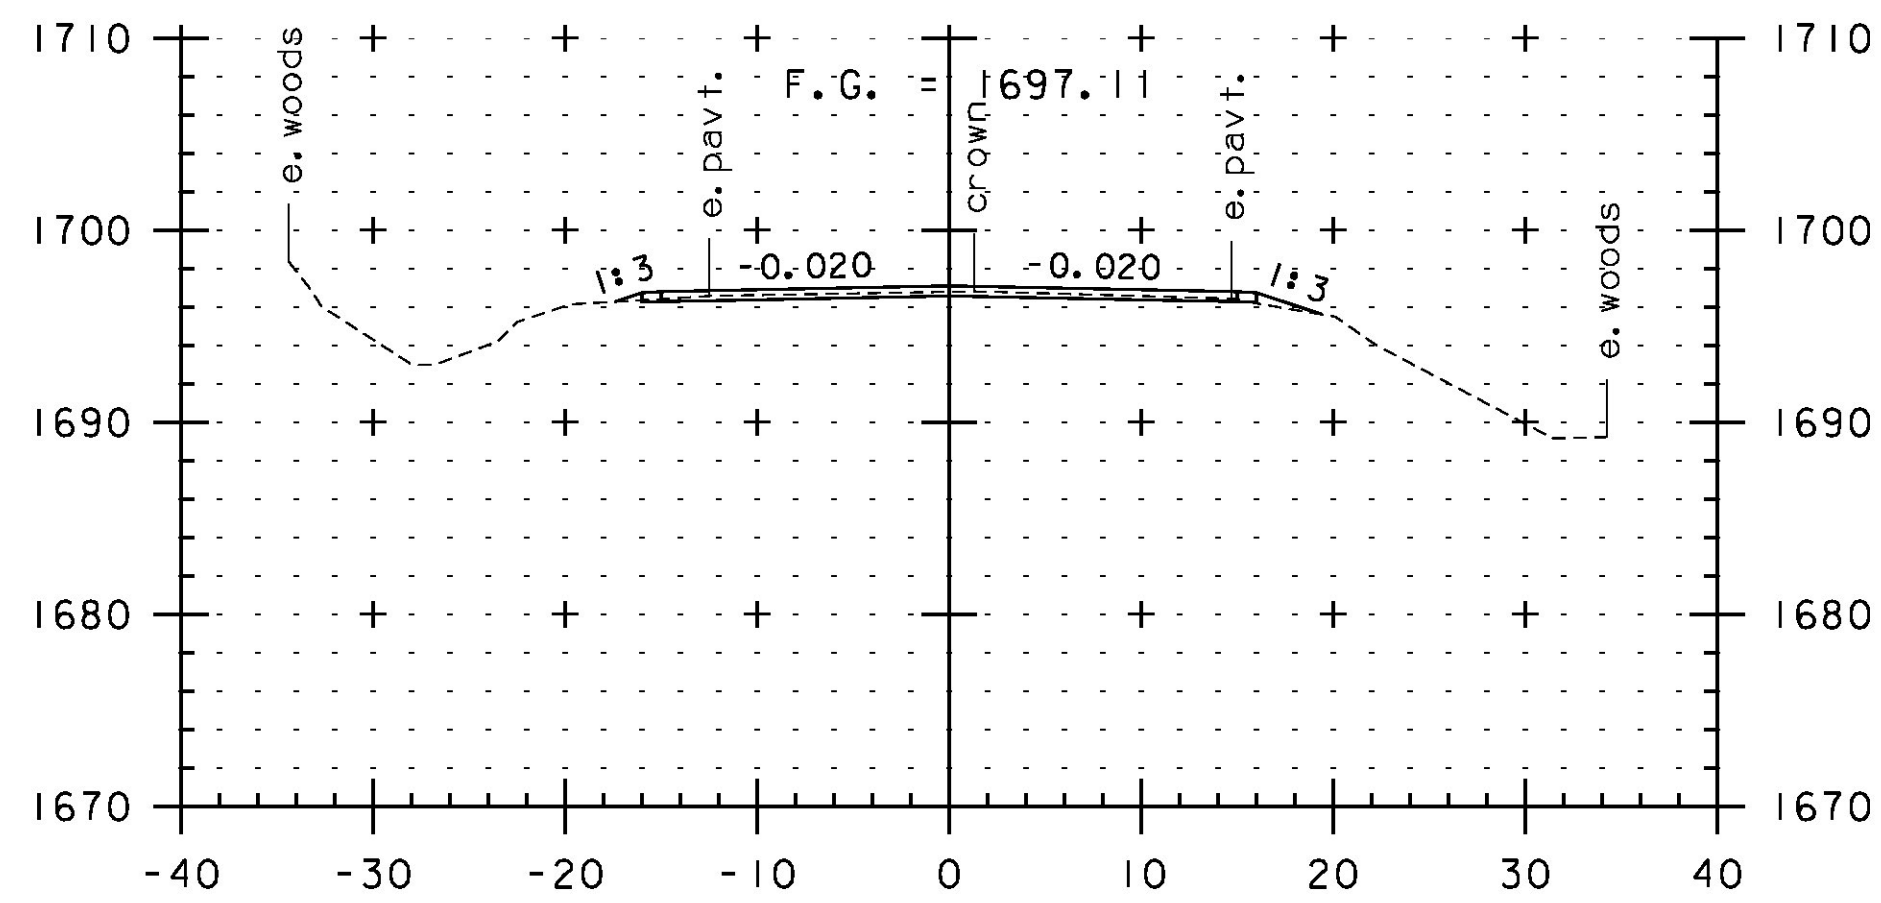


257+50

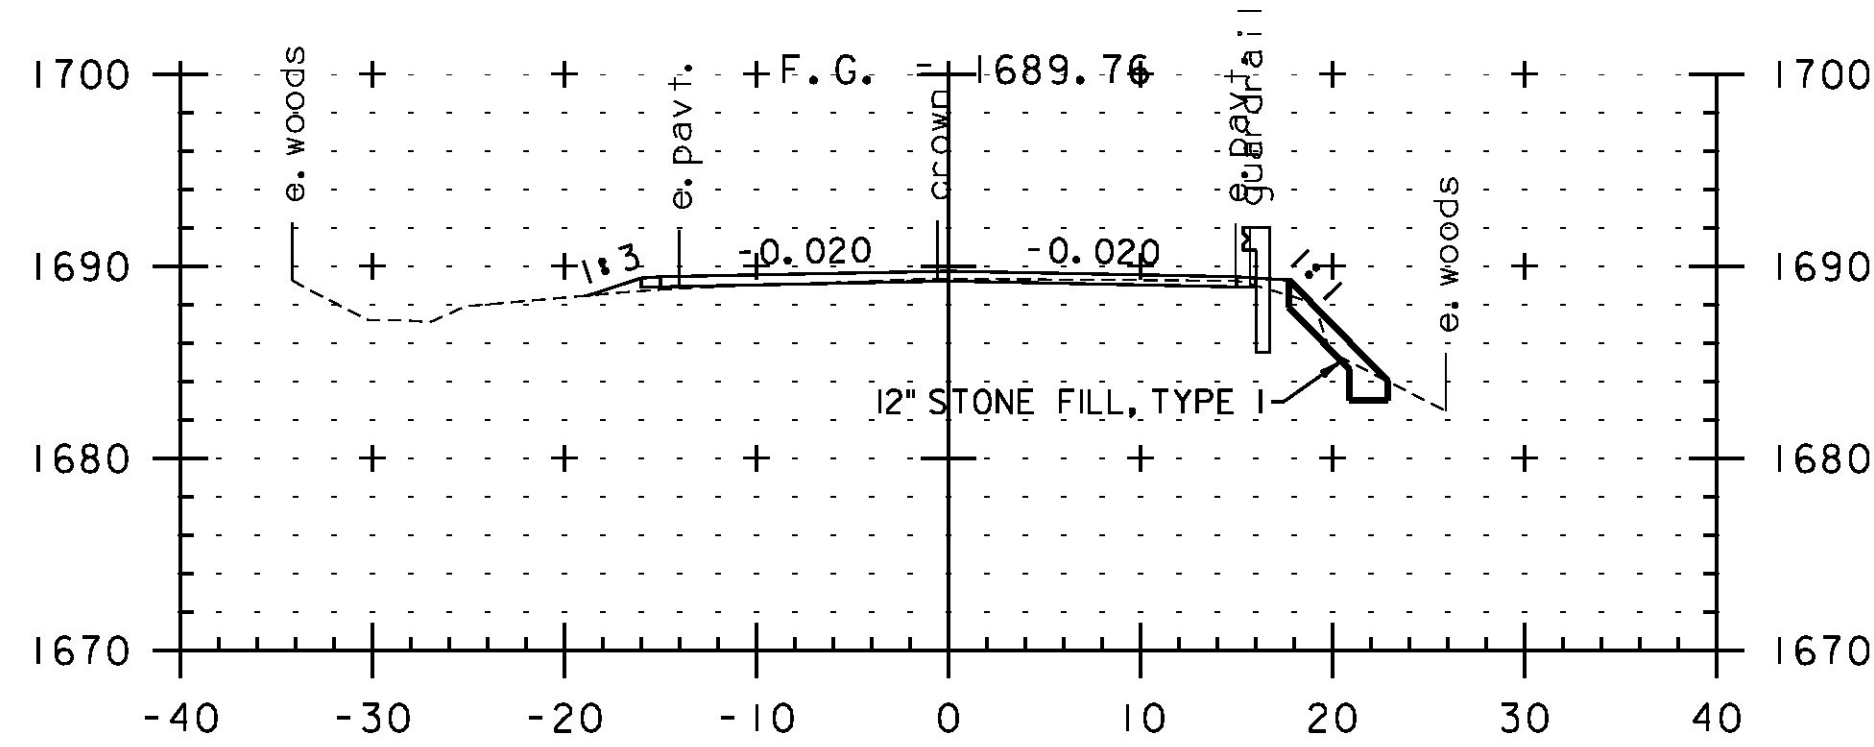


259+00

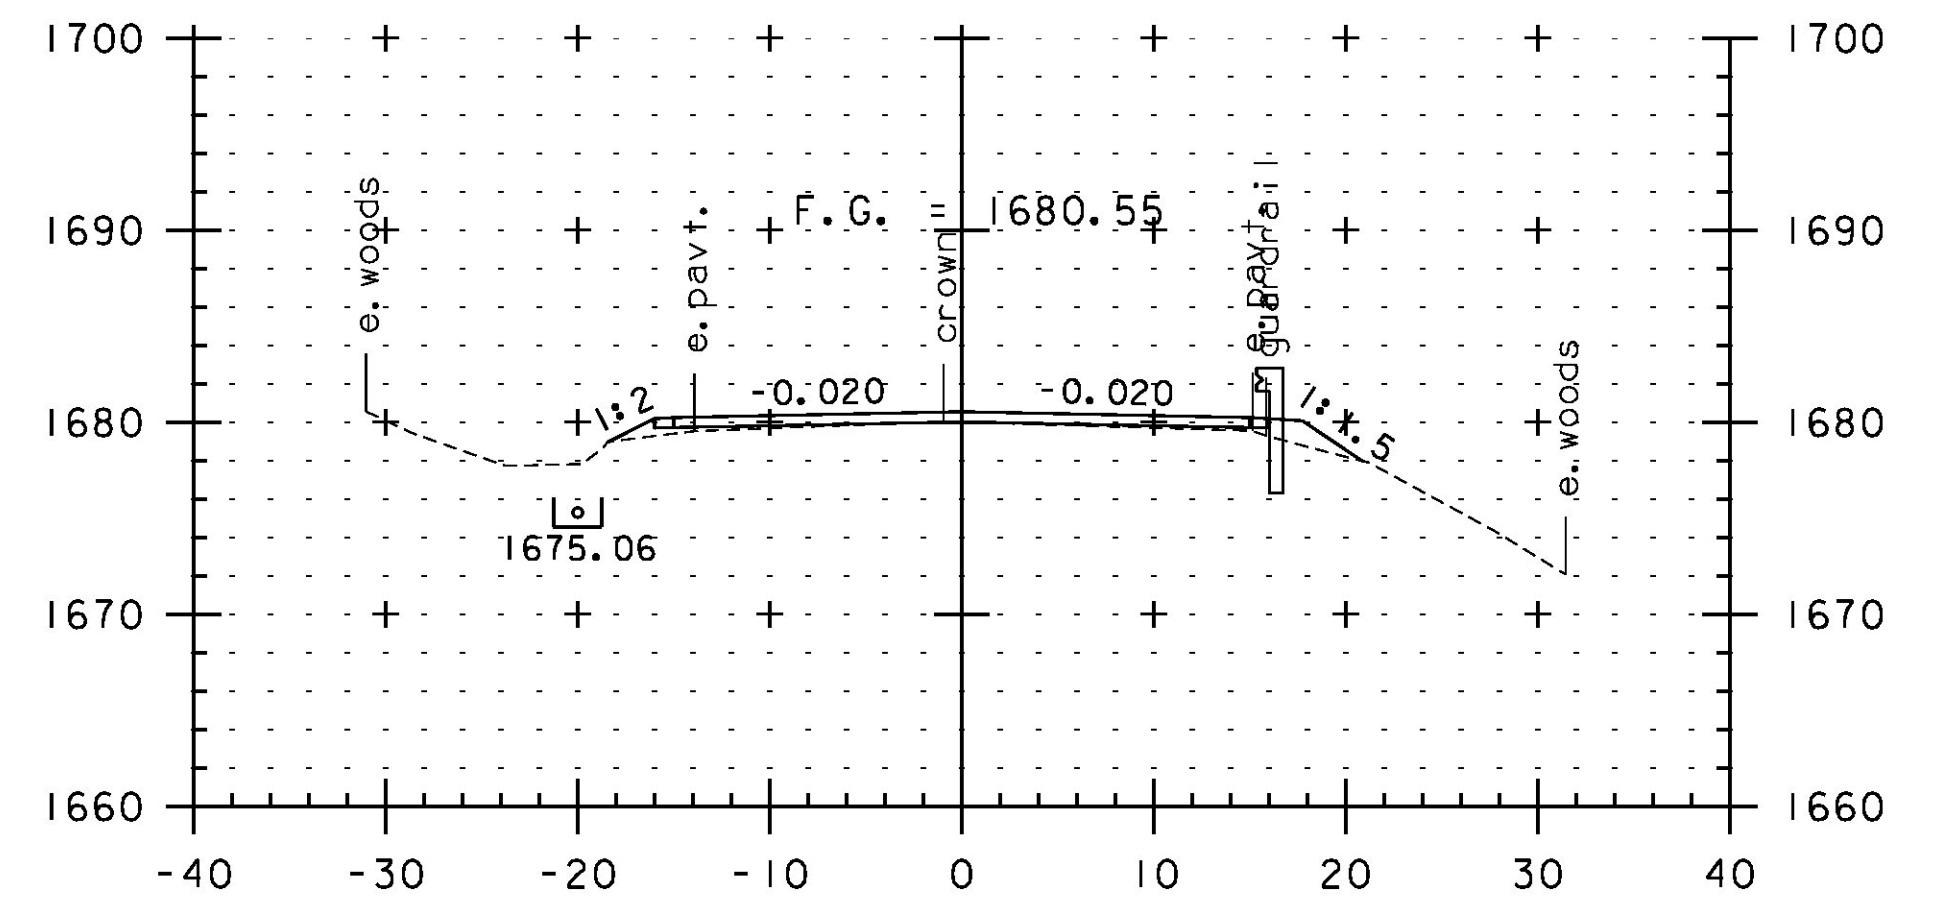


260+50

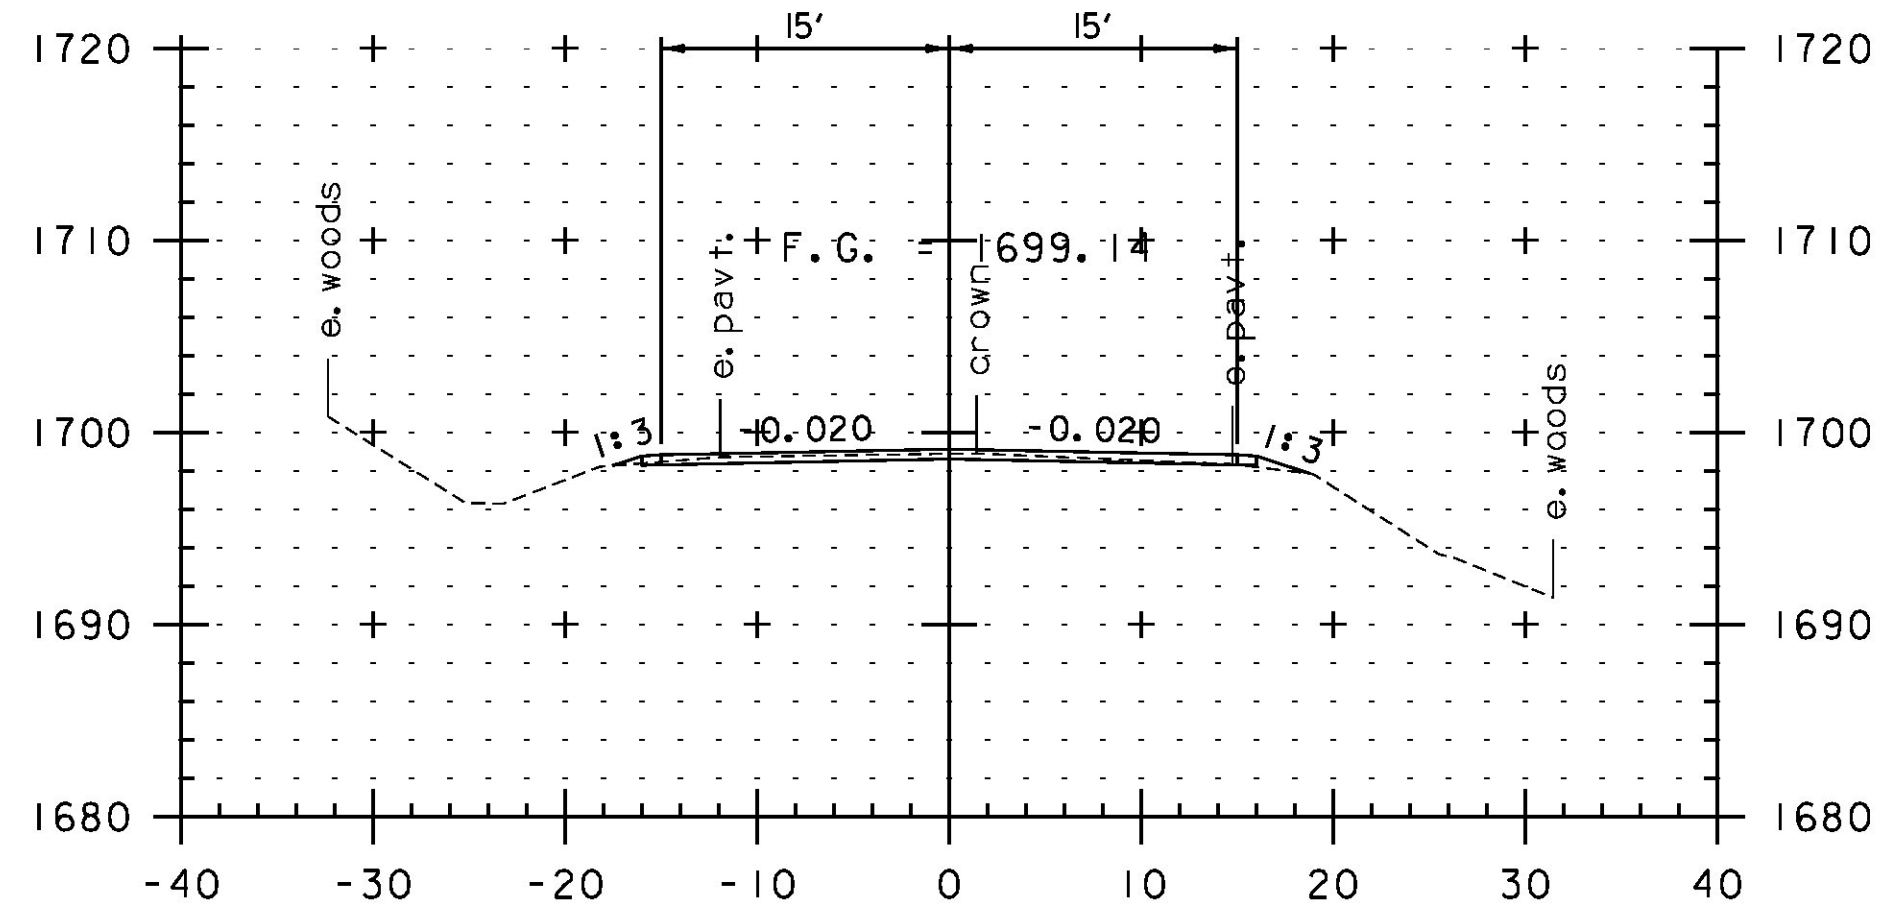

257+00

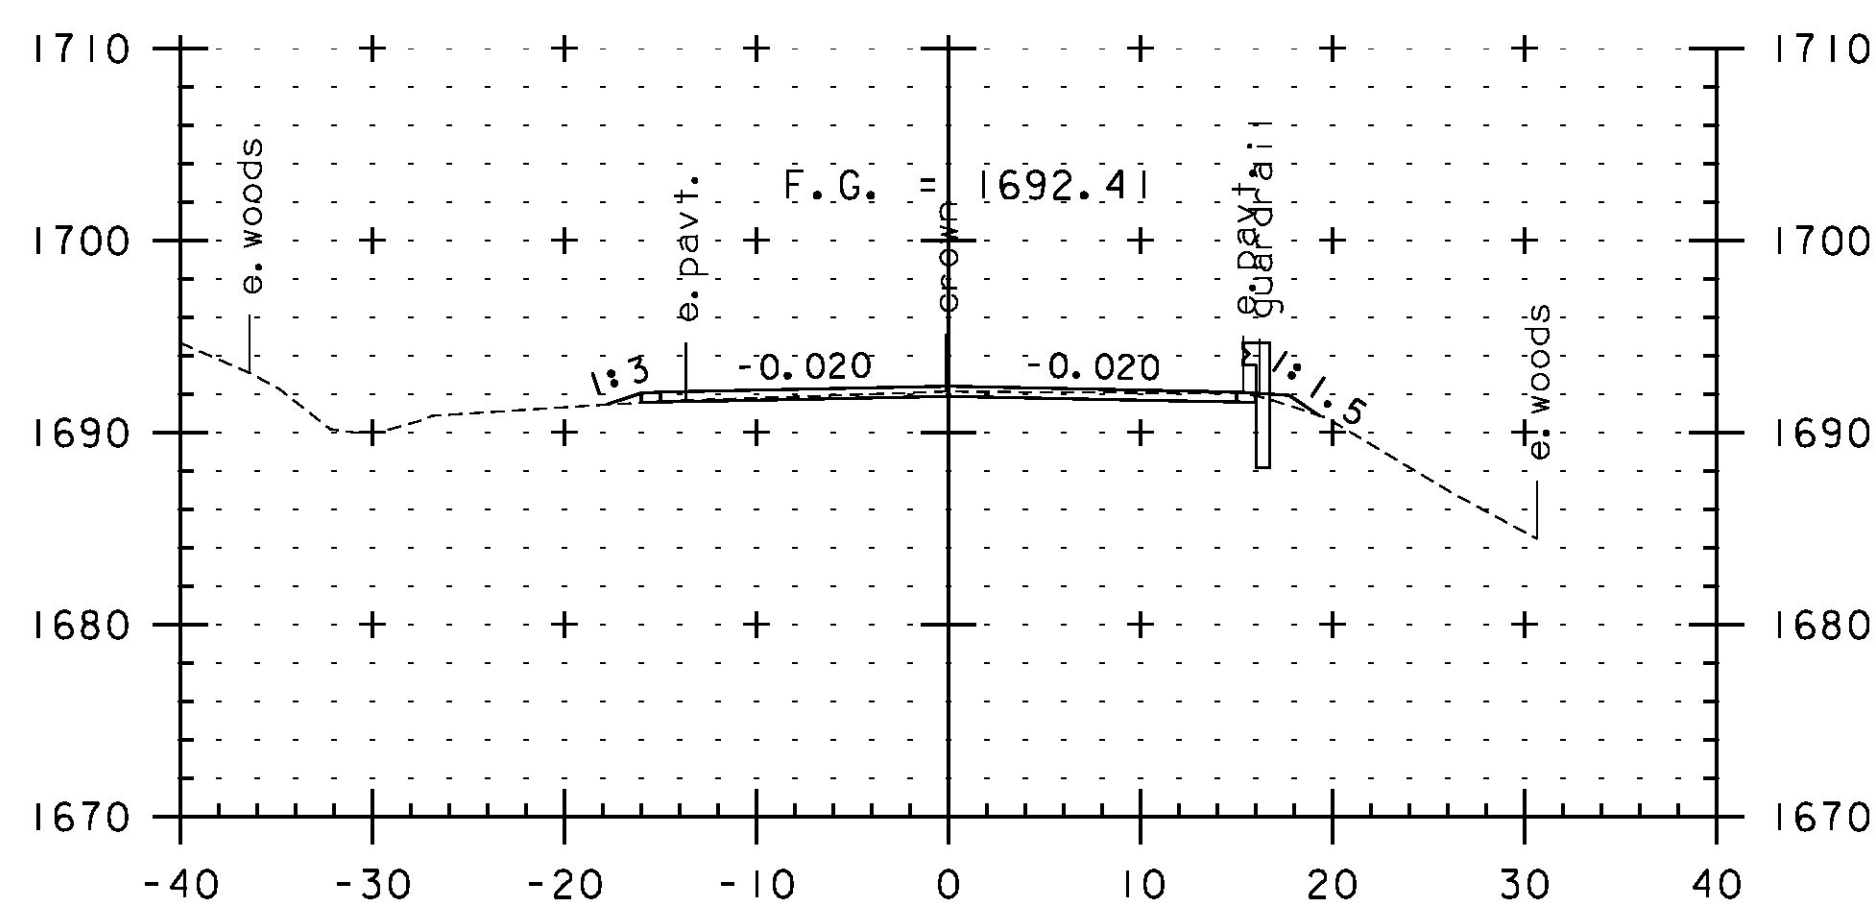

258+50

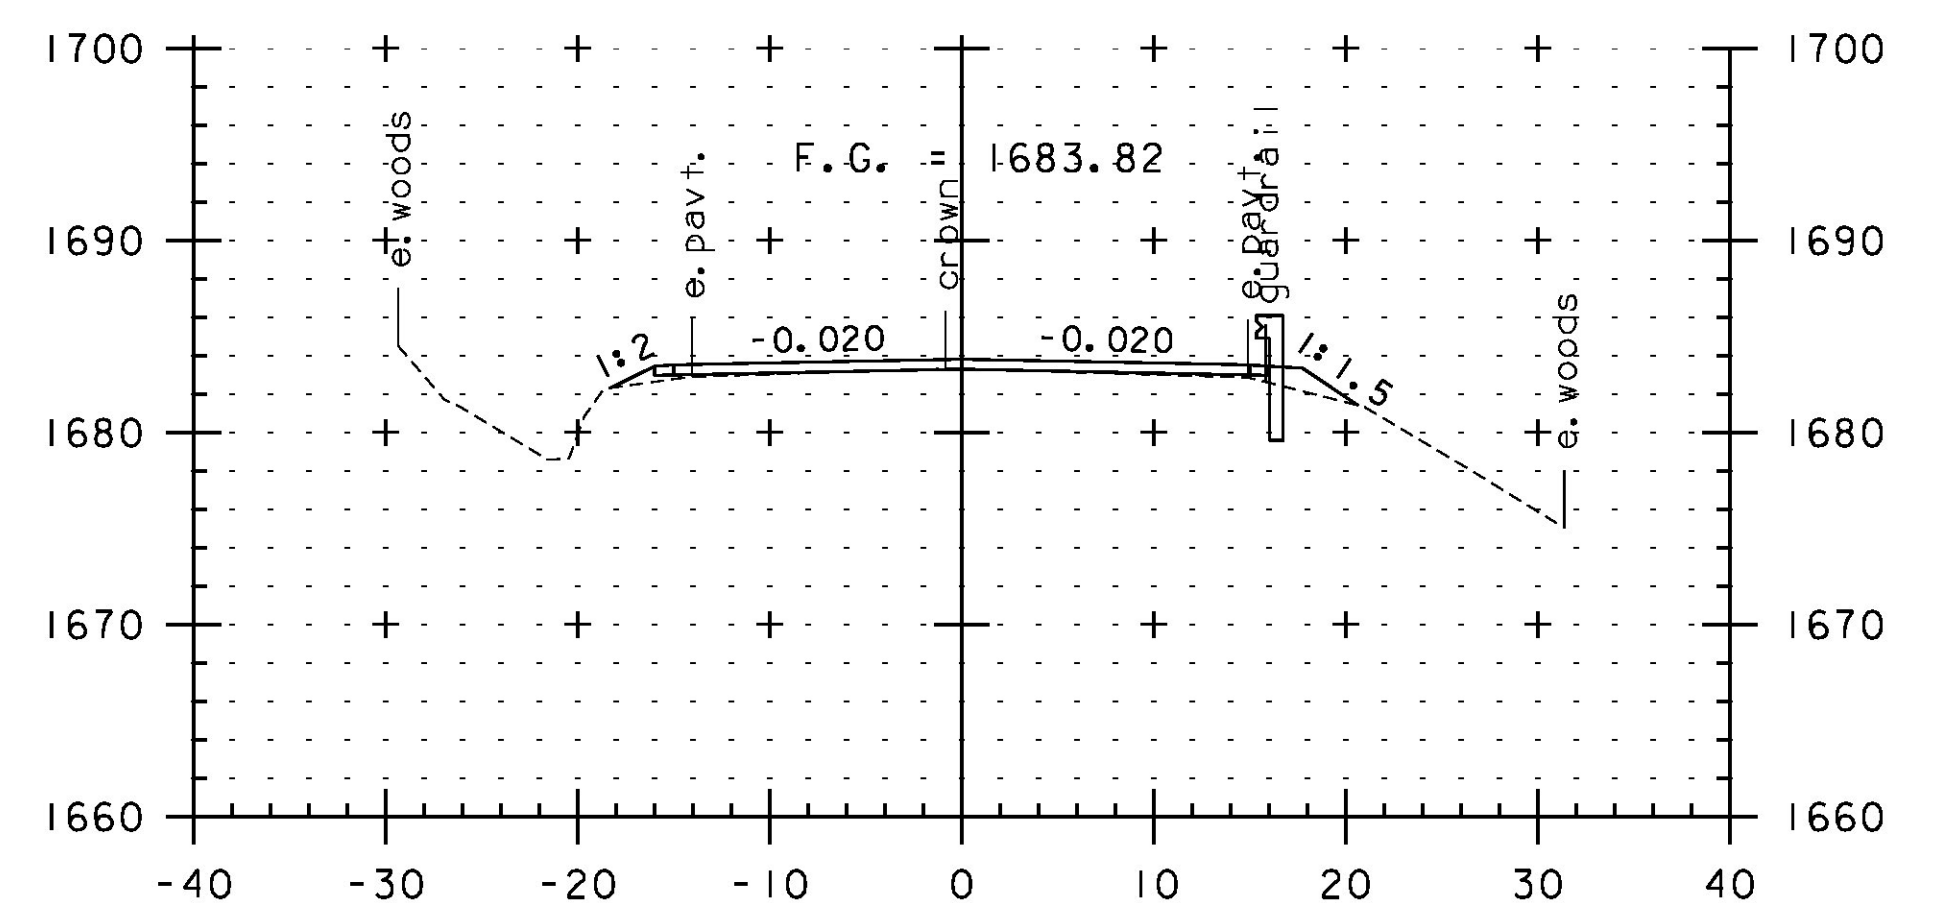

260+00



SCALE IN FEET

STA. 257+00 TO STA. 261+00

PROJECT NAME: JAY-TROY  
PROJECT NUMBER: STP 2315(1)

FILE NAME: z10b232xs.dgn  
PROJECT LEADER: P. SHEDD  
DESIGNED BY: N. LEMAY  
CROSS SECTION SHEET 58

PLOT DATE: 5/16/2014  
DRAWN BY: W. GORDON  
CHECKED BY: P. SHEDD  
SHEET 194 OF 244