




276+00

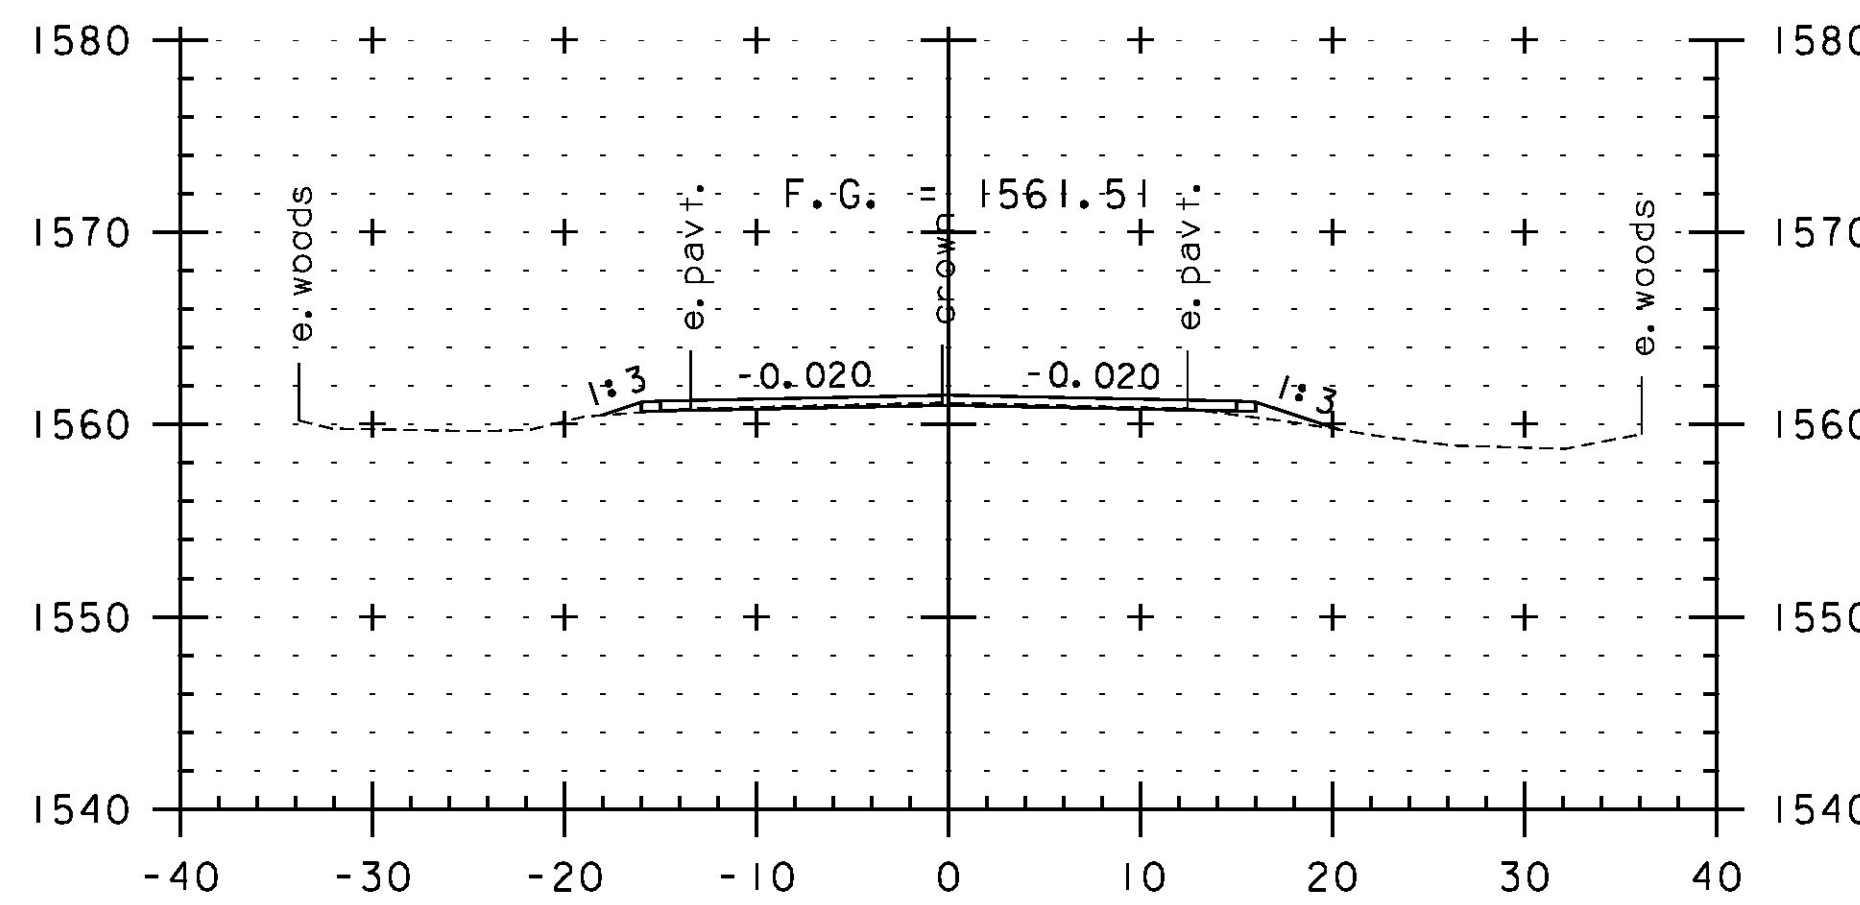


277+50

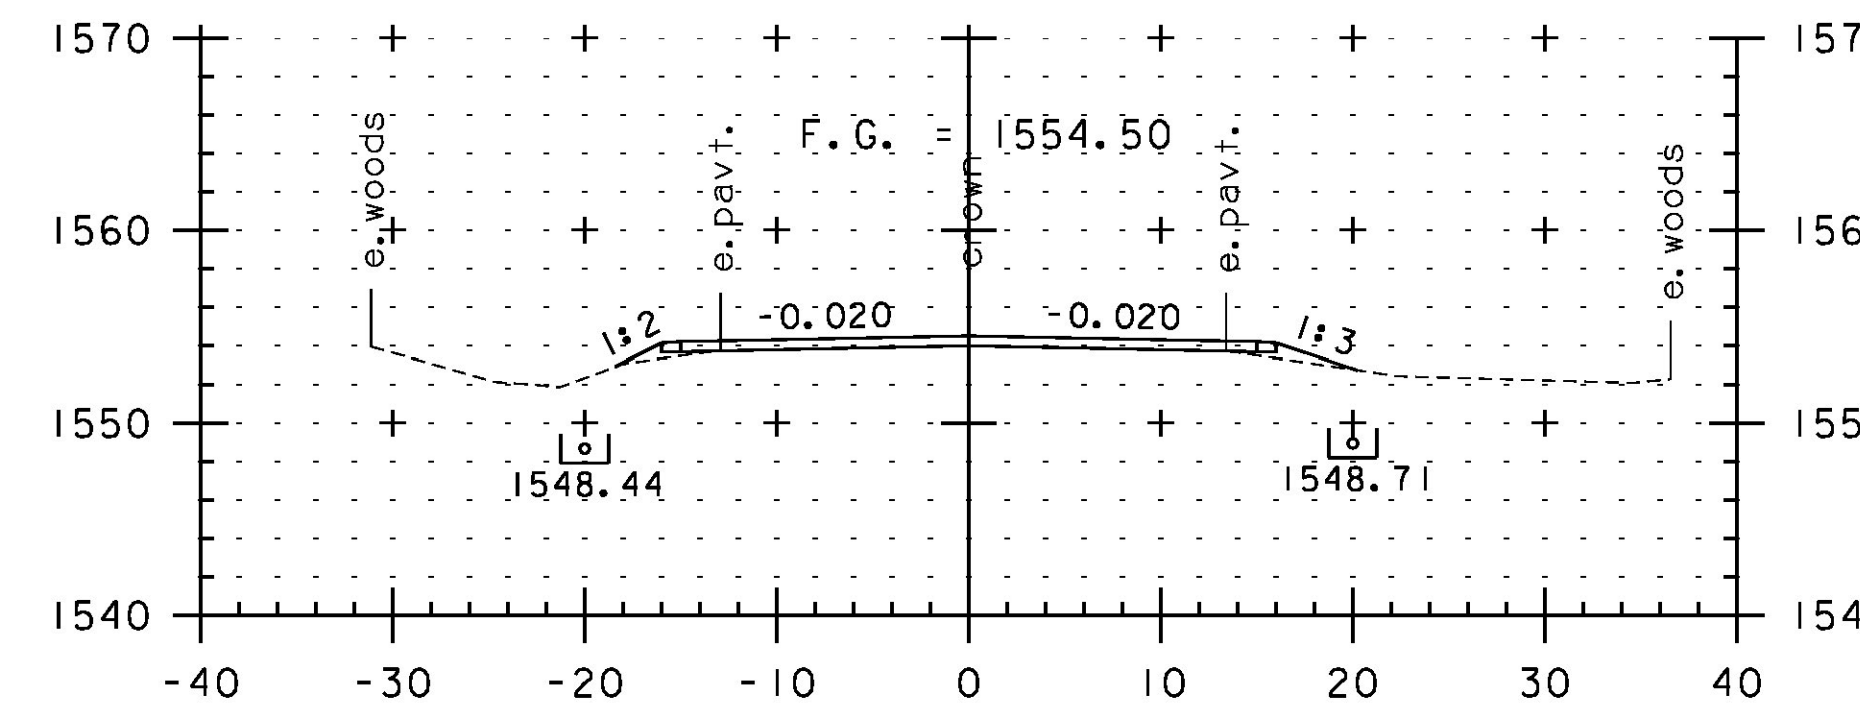


278+50

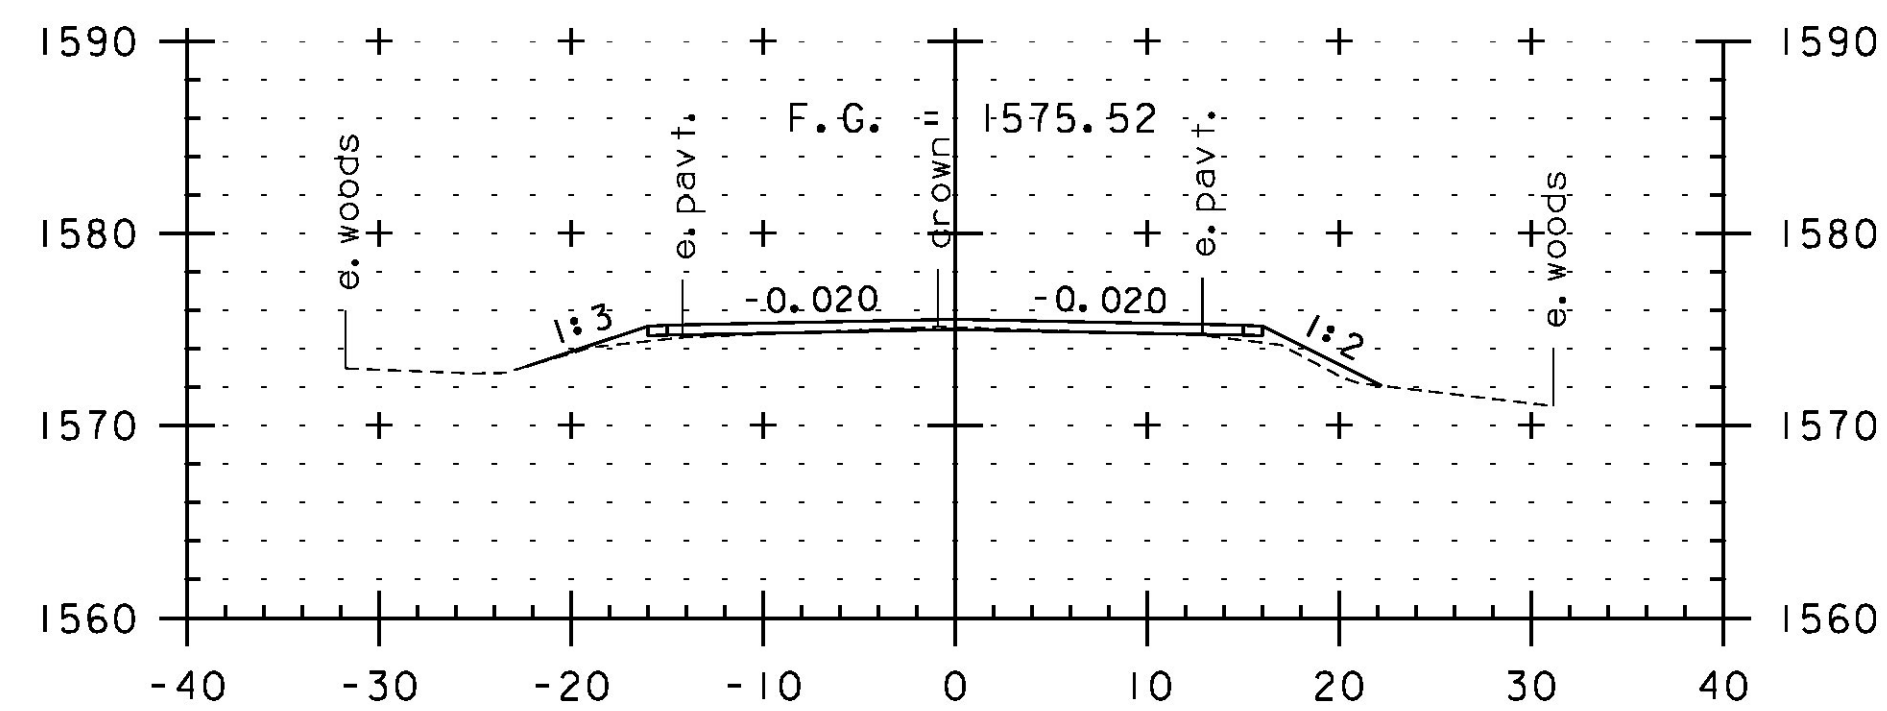


275+50

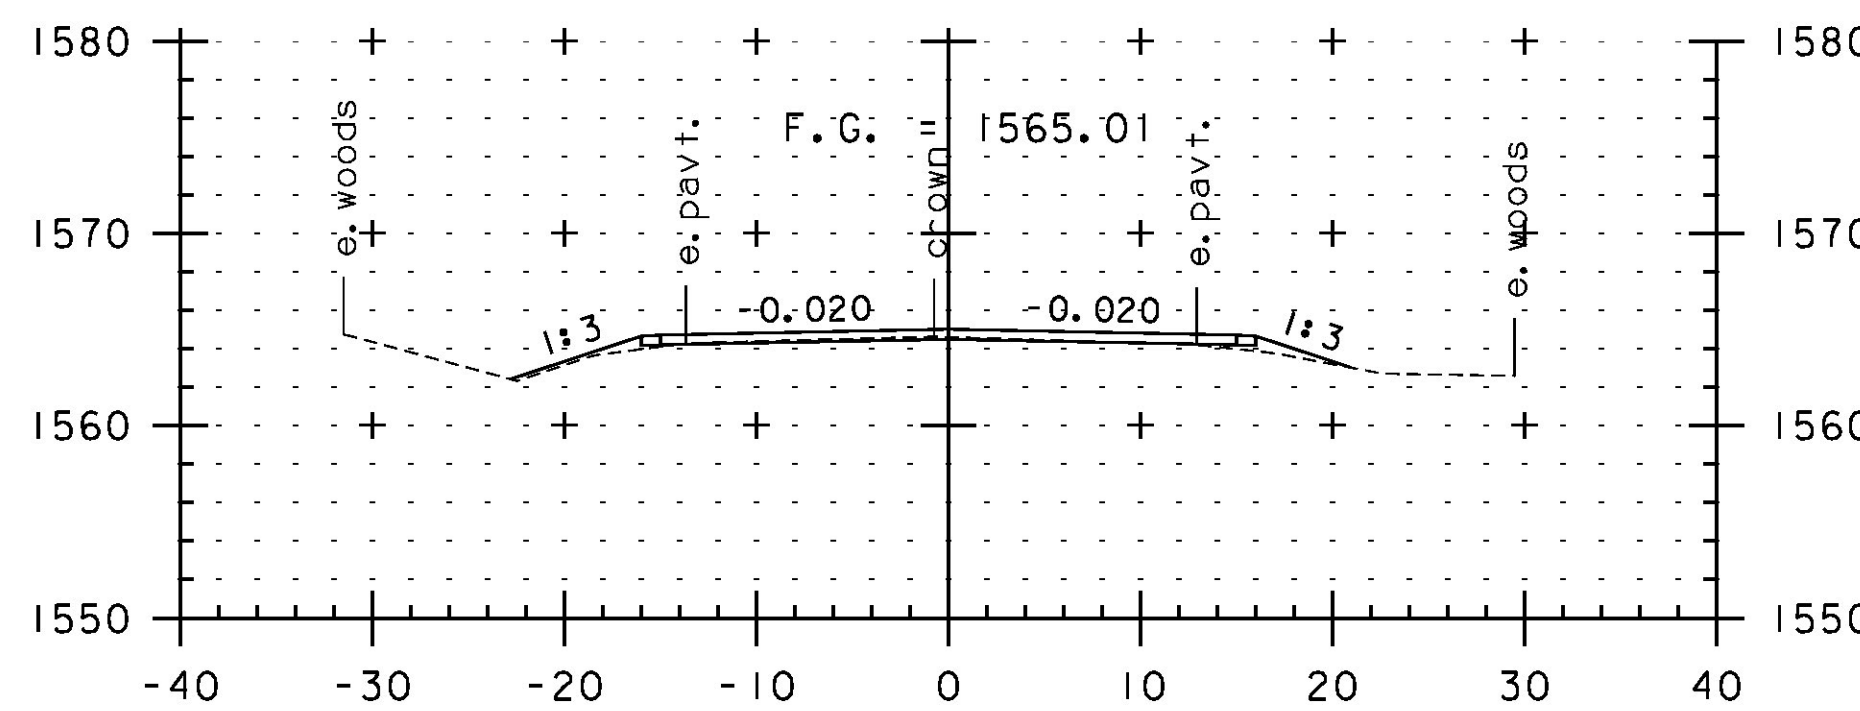


277+00

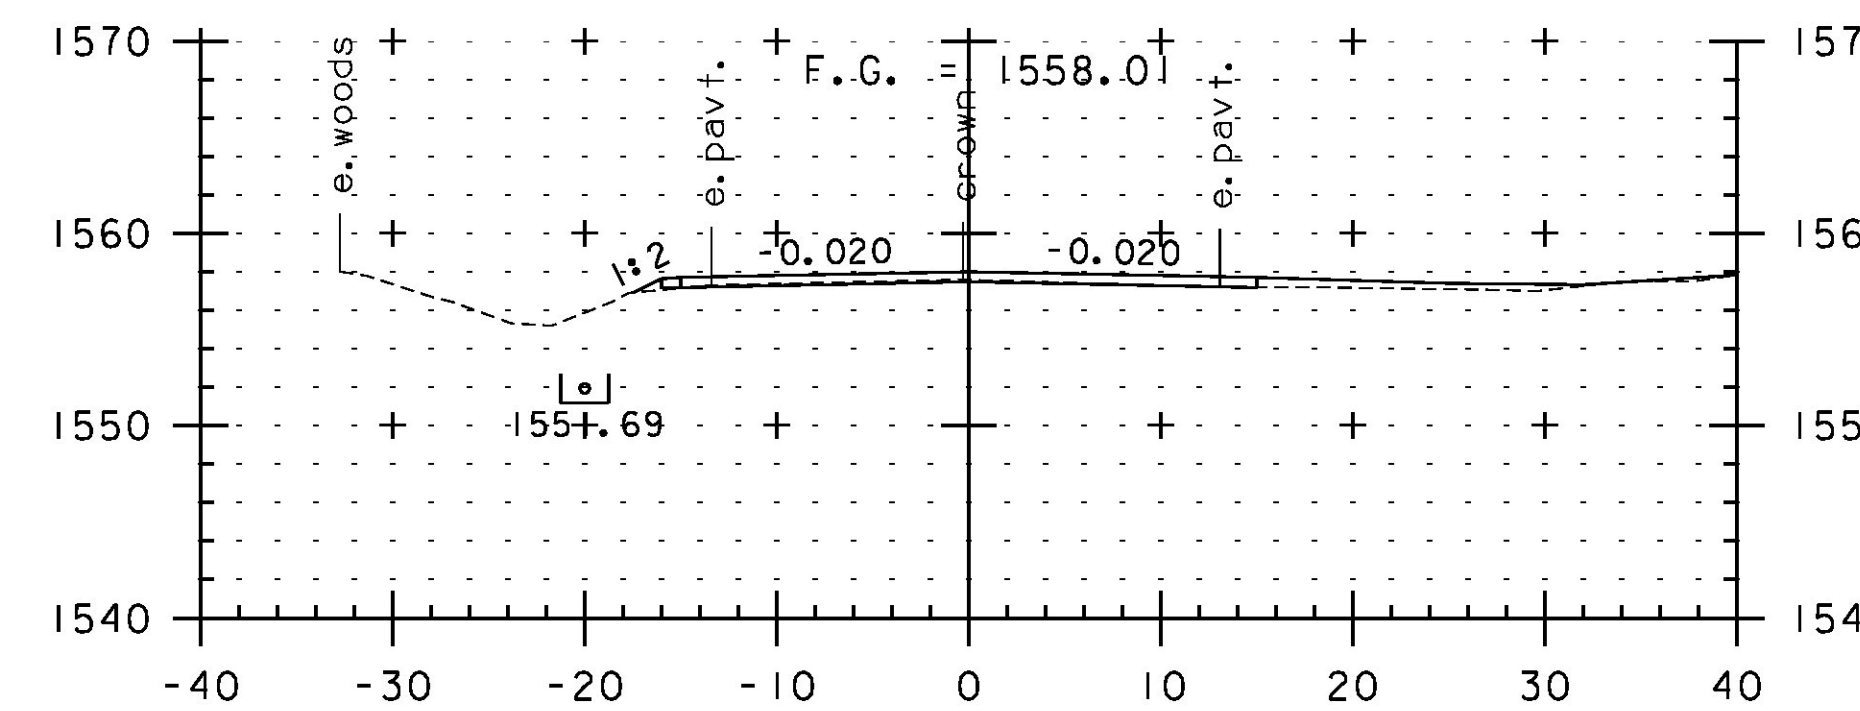


278+00

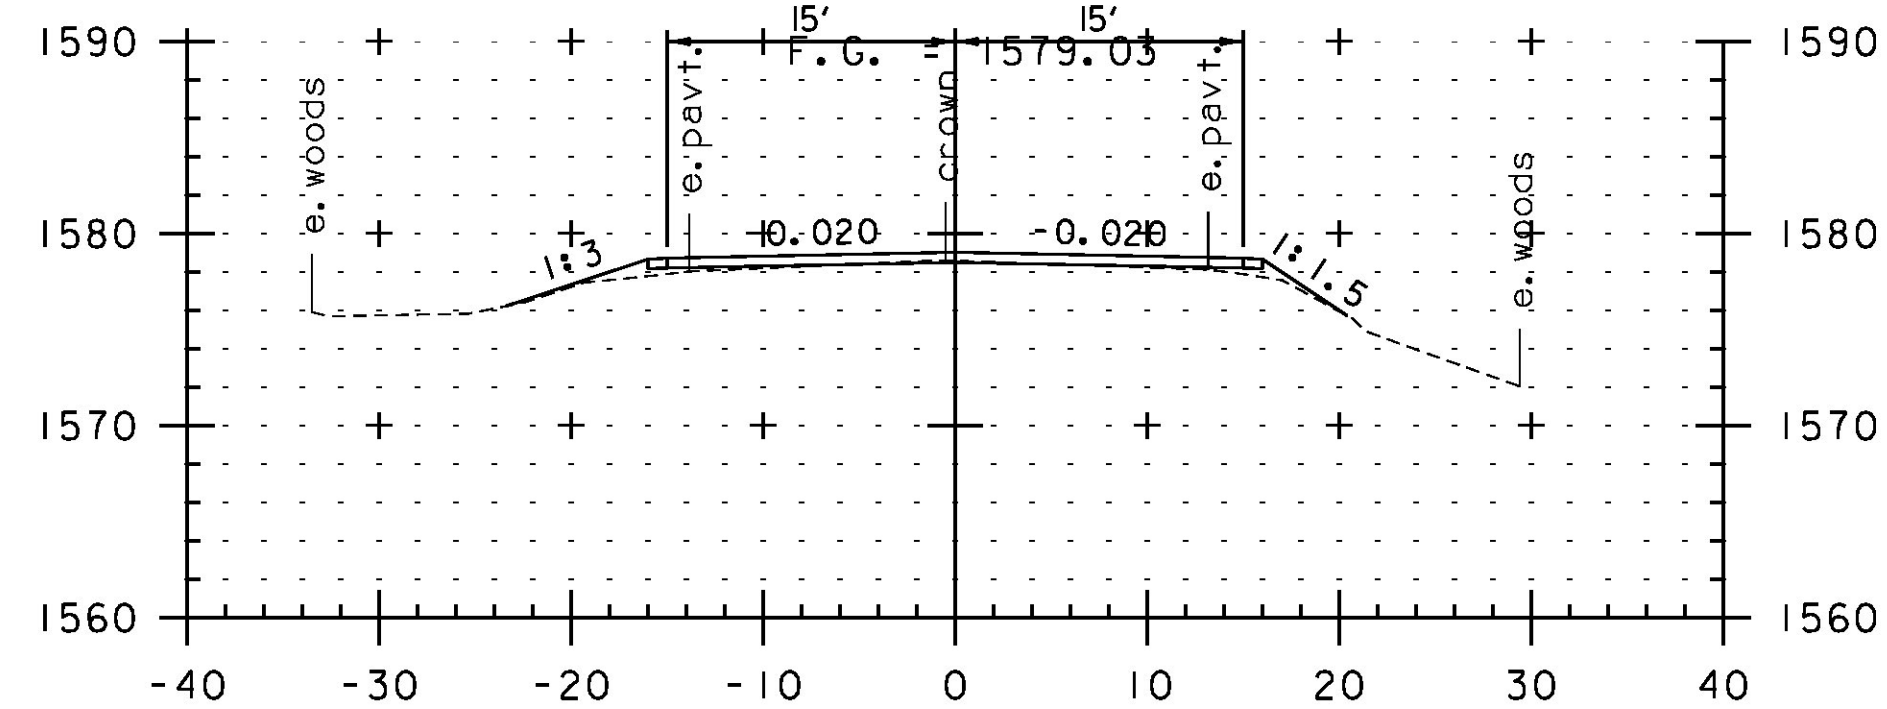

275+00

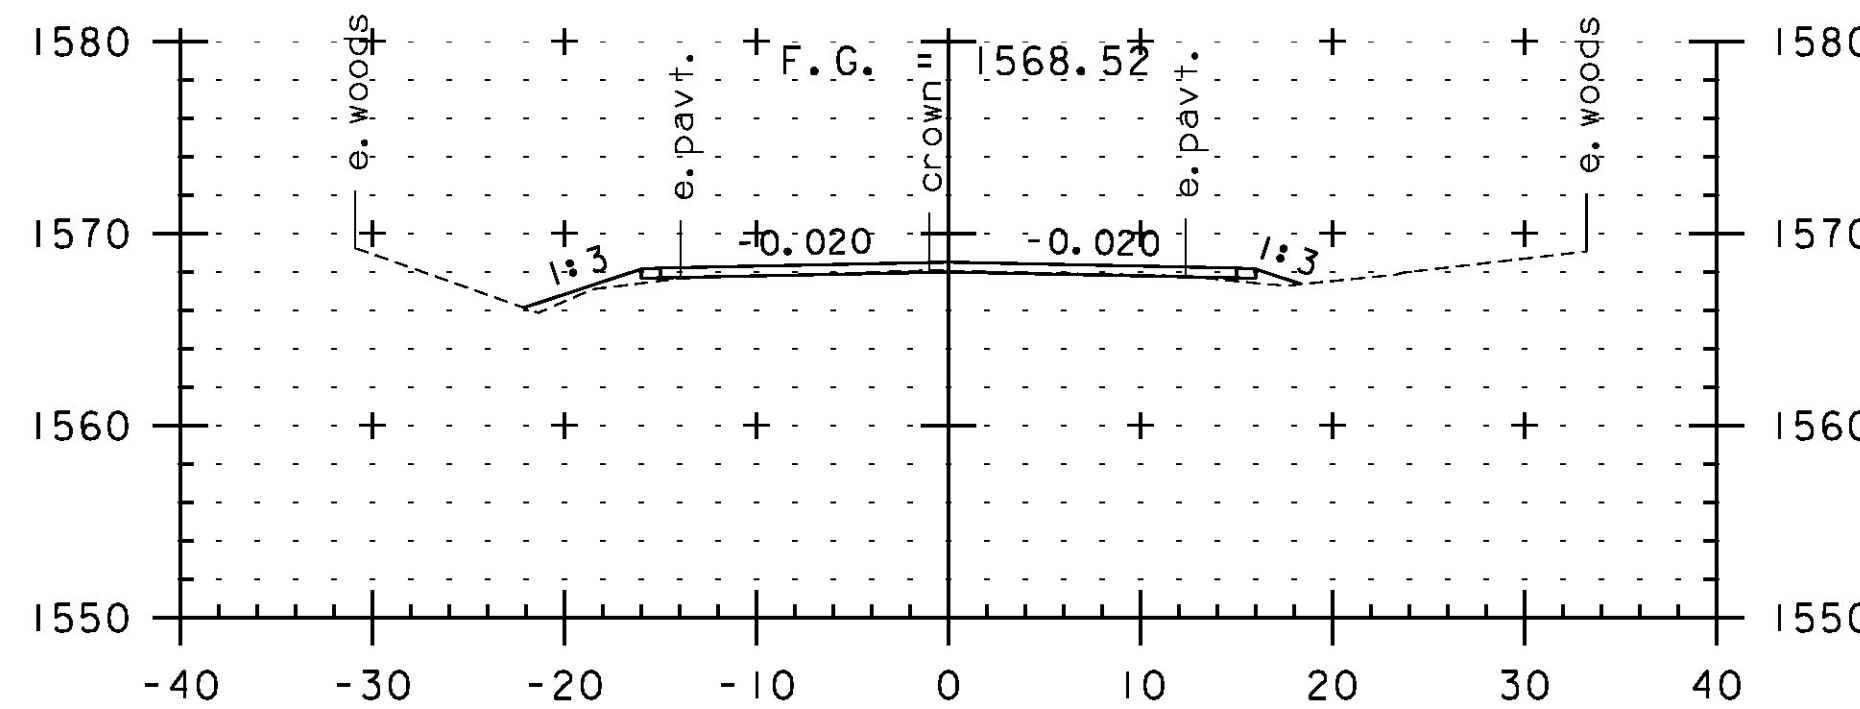

276+50

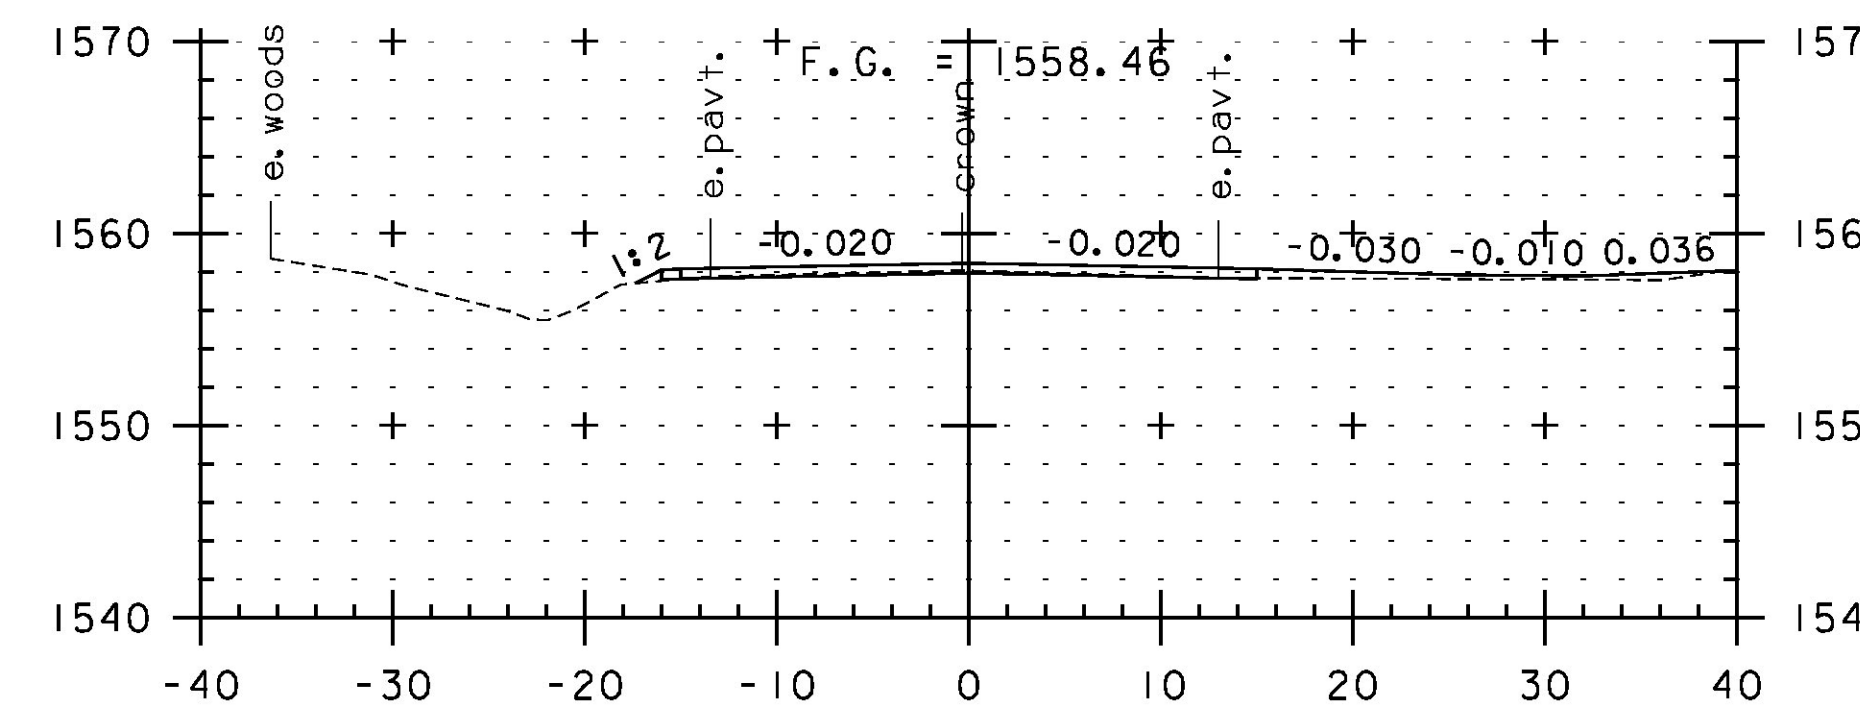

277+93  
TH 21 RT



SCALE IN FEET

STA. 275+00 TO STA. 278+50

PROJECT NAME:	JAY-TROY	PLOT DATE:	5/16/2014
PROJECT NUMBER:	STP 2315(I)	DRAWN BY:	W. GORDON
FILE NAME:	z10b232xs.dgn	DESIGNED BY:	N. LEMAY
PROJECT LEADER:	P. SHEDD	CHECKED BY:	P. SHEDD
CROSS SECTION SHEET 62		SHEET	198 OF 244