




280+00

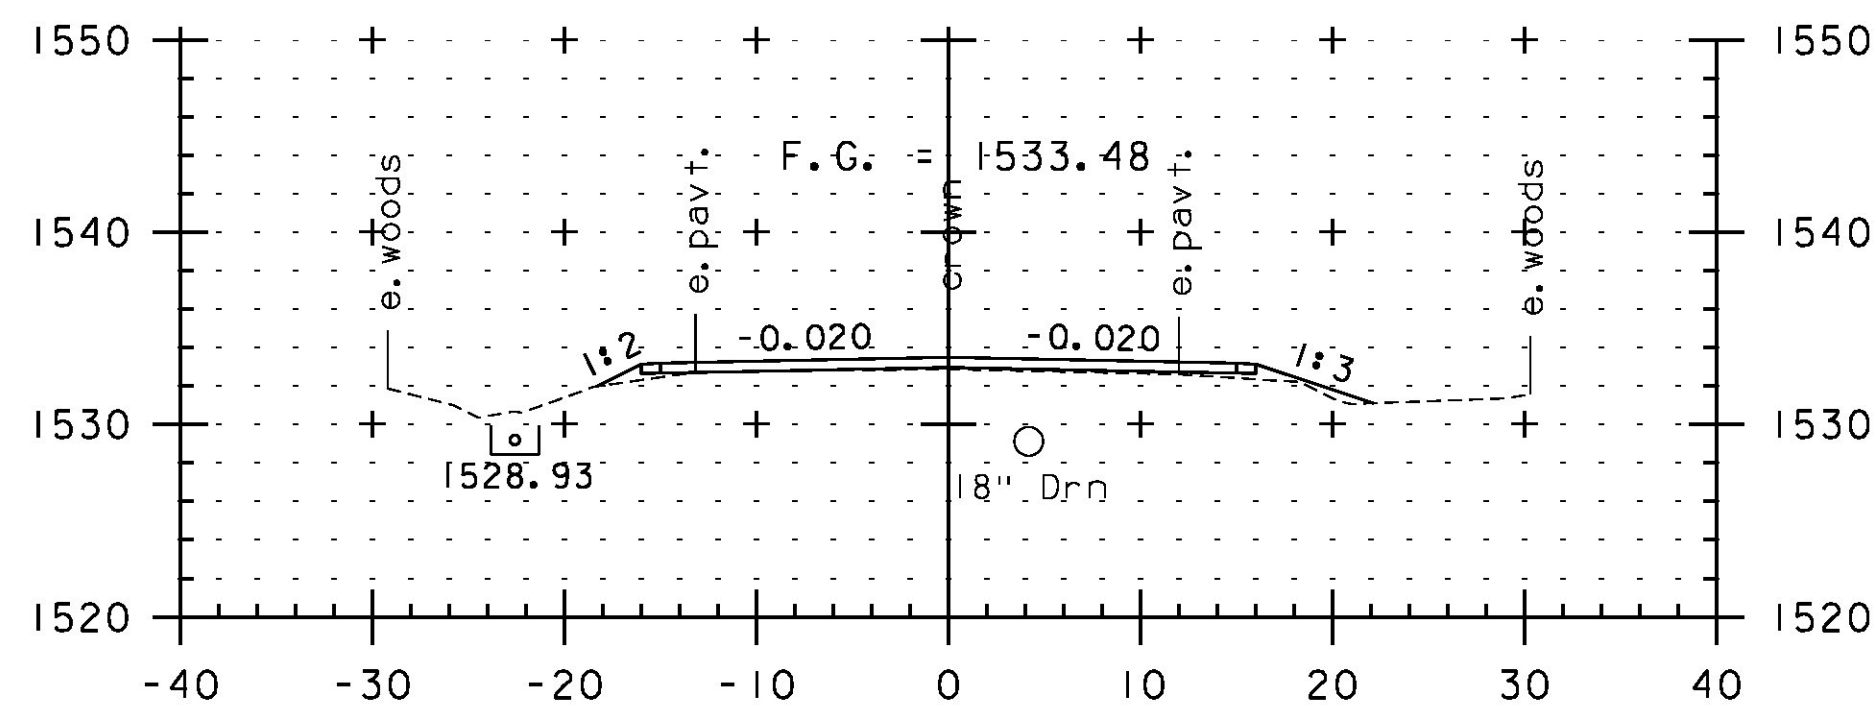


281+50

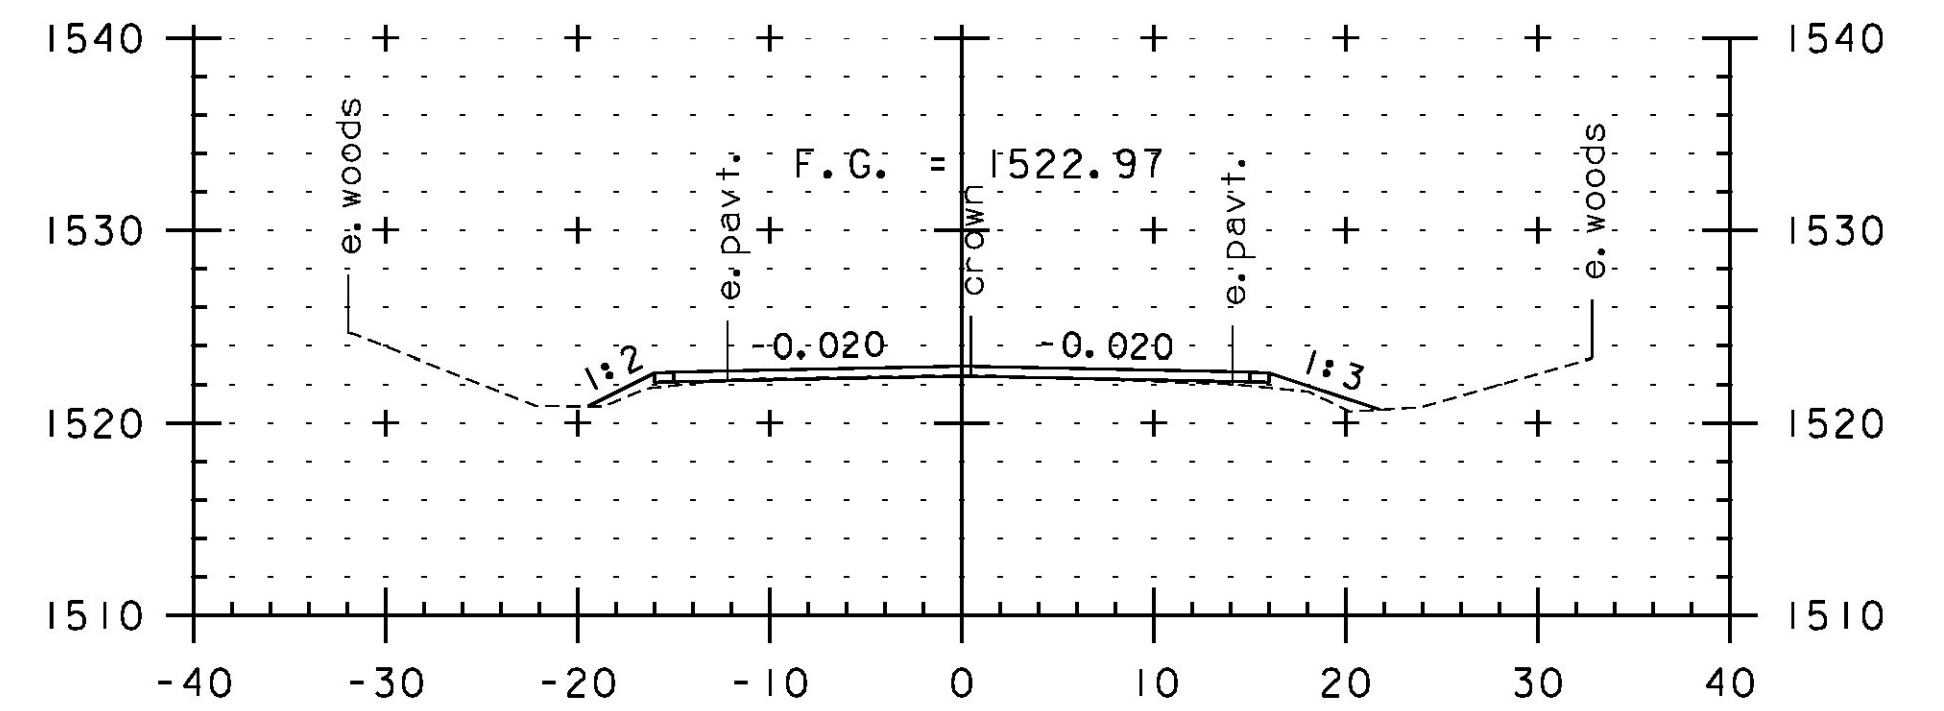


283+00

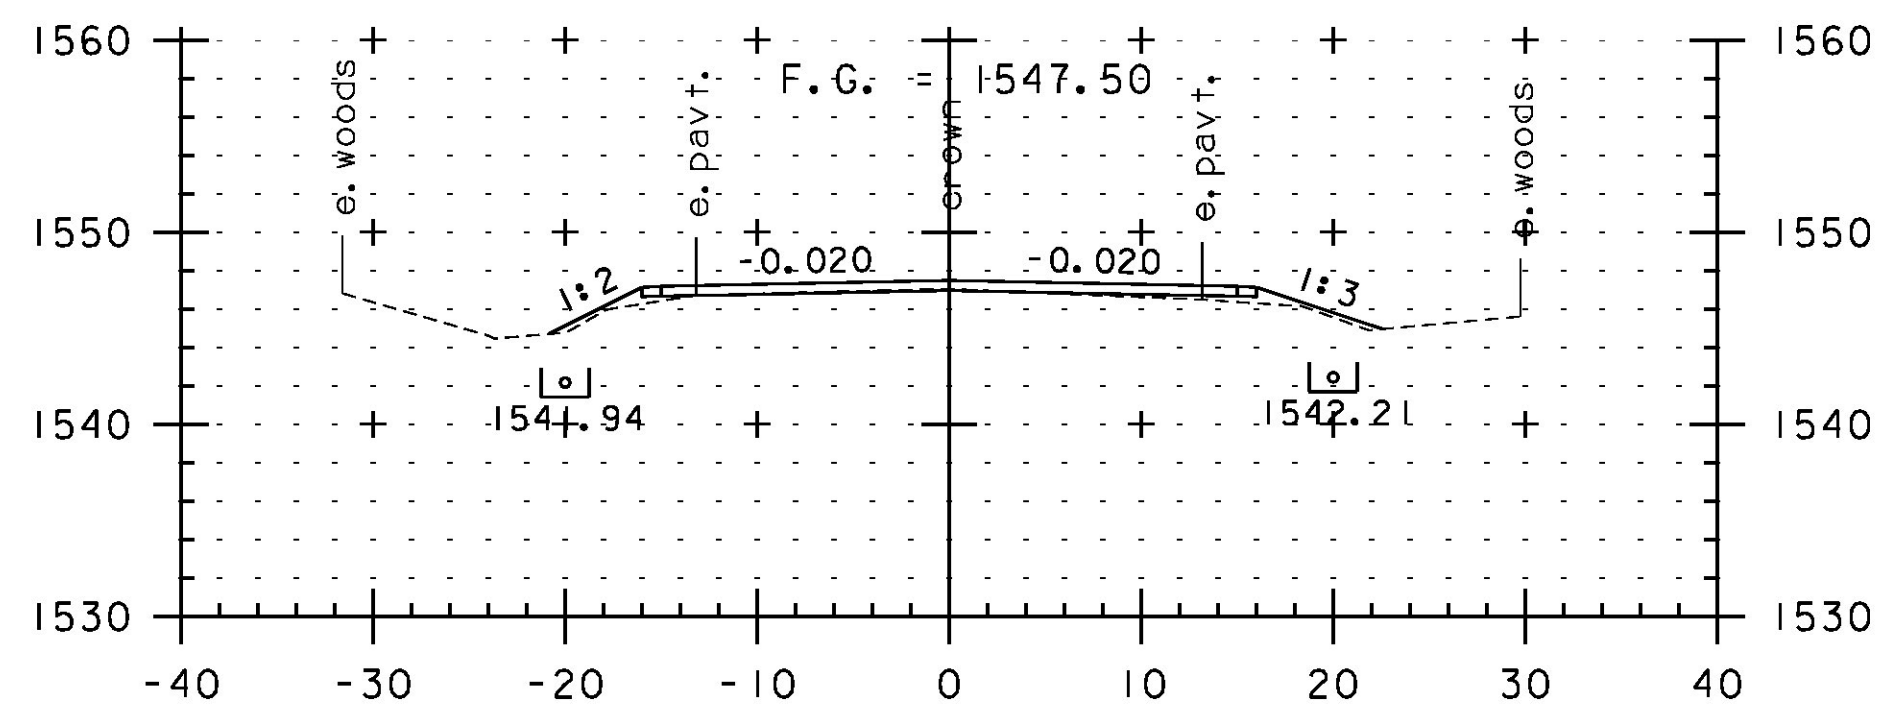


279+50

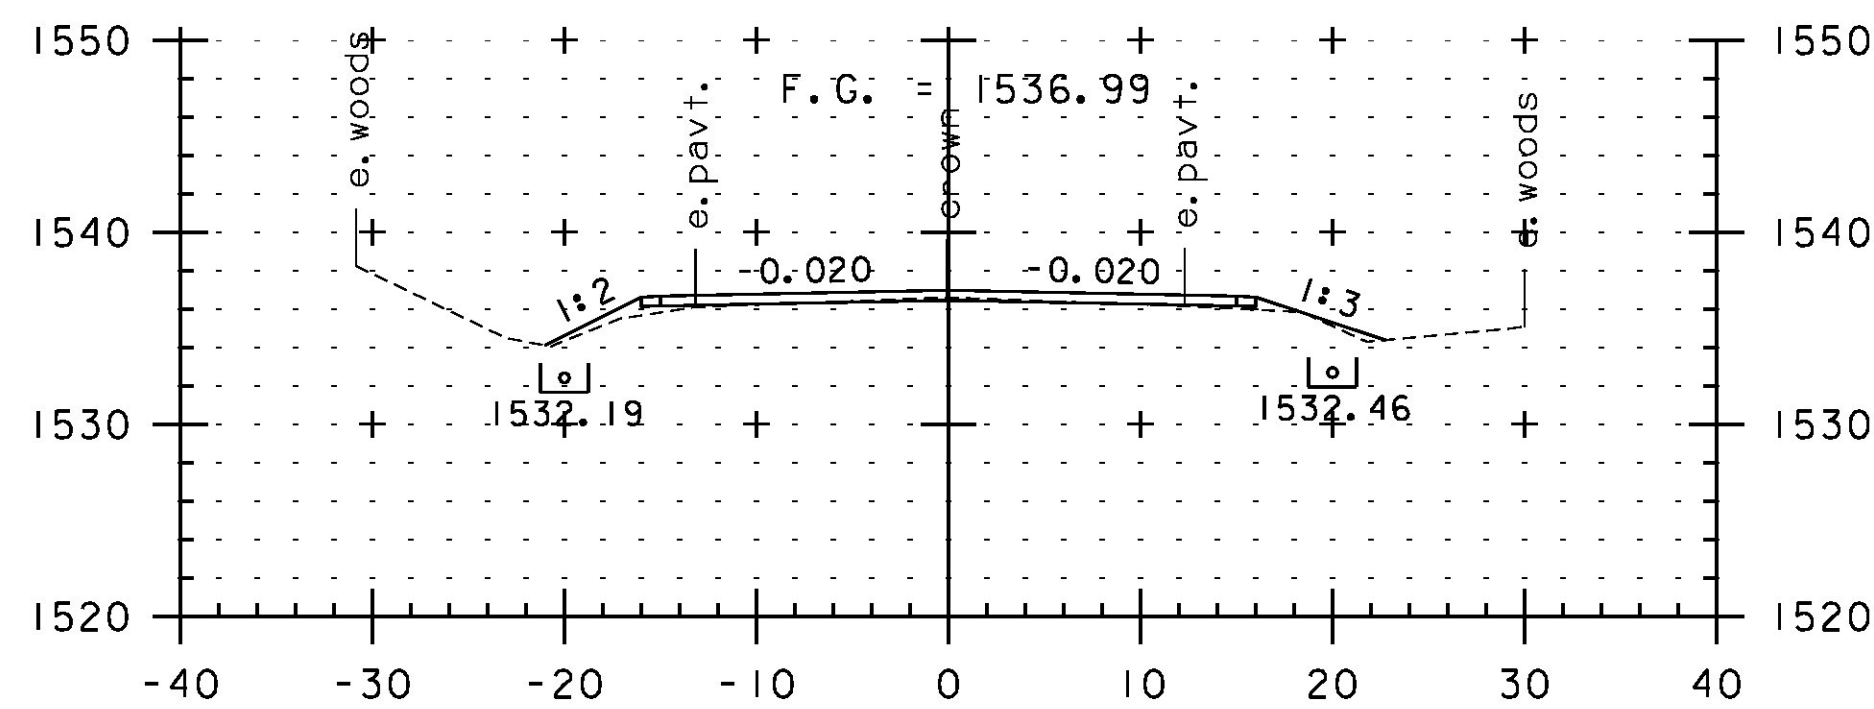


281+00

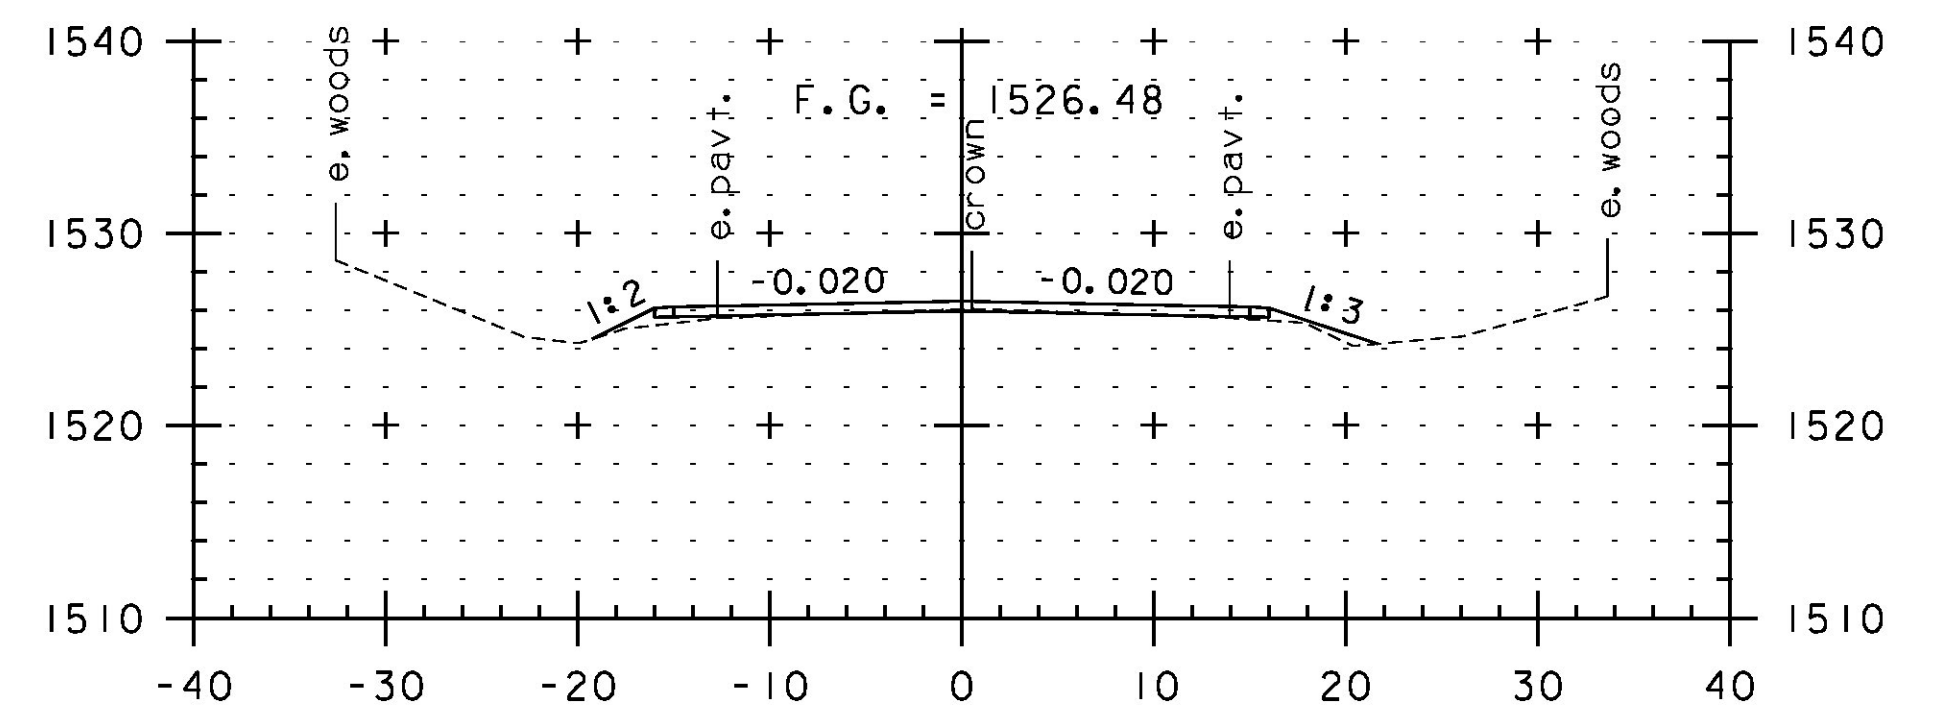


282+50

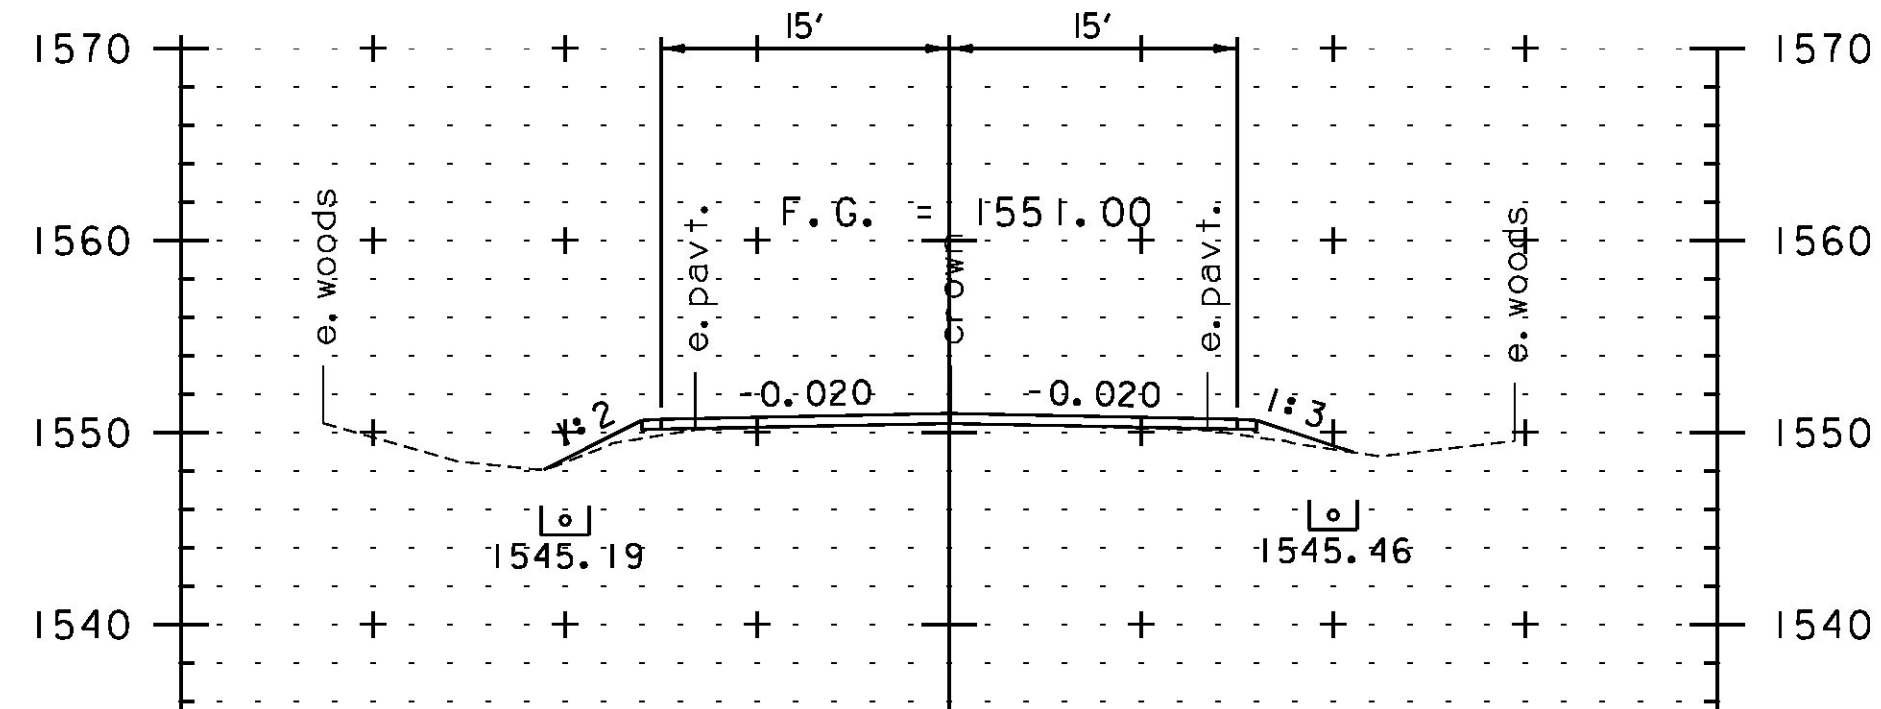

279+00

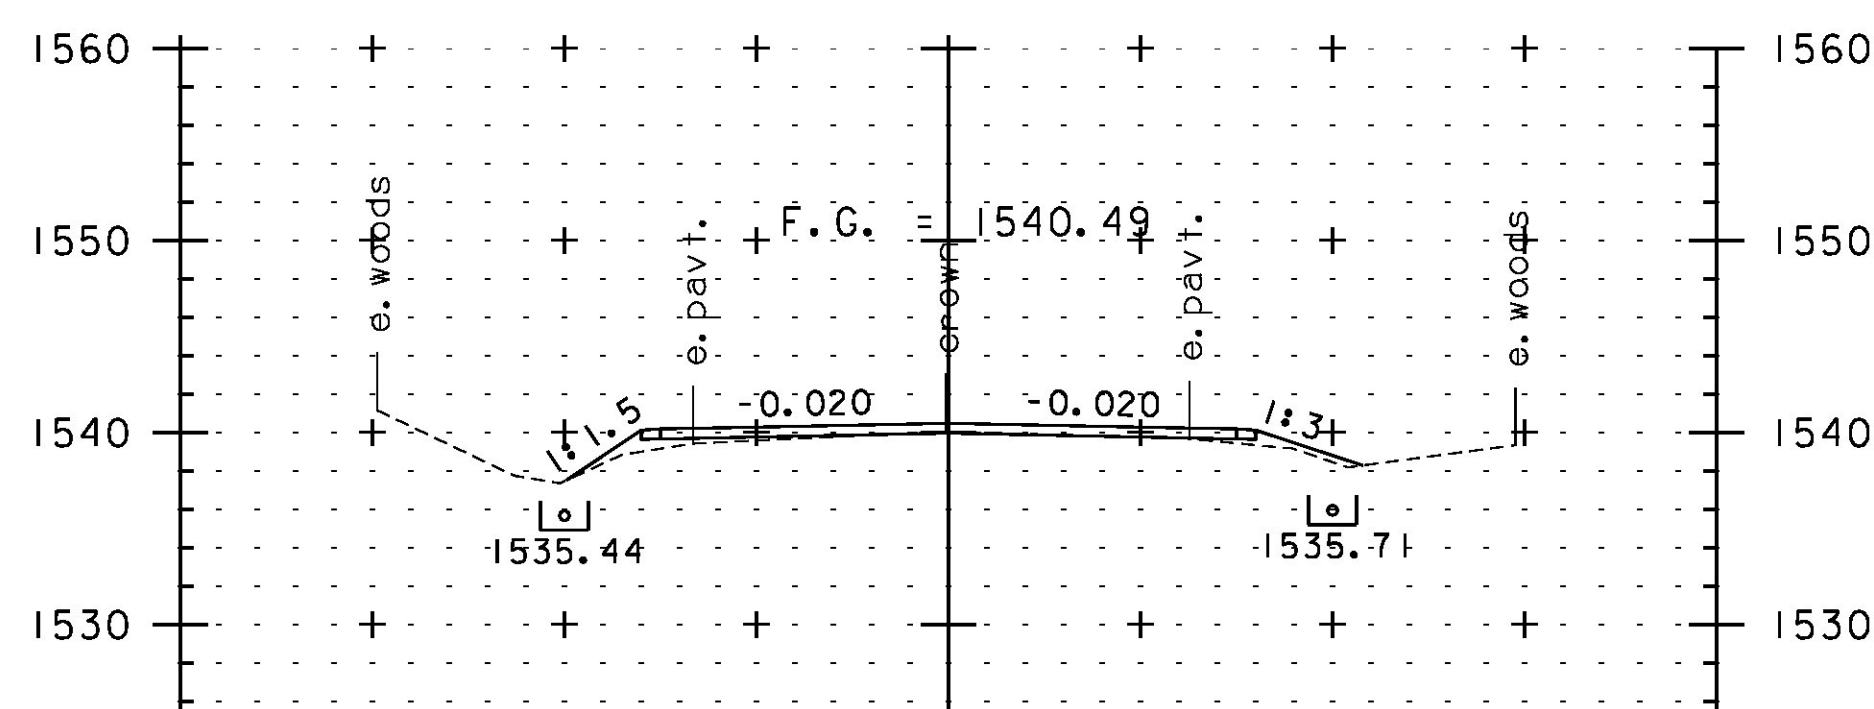

280+50

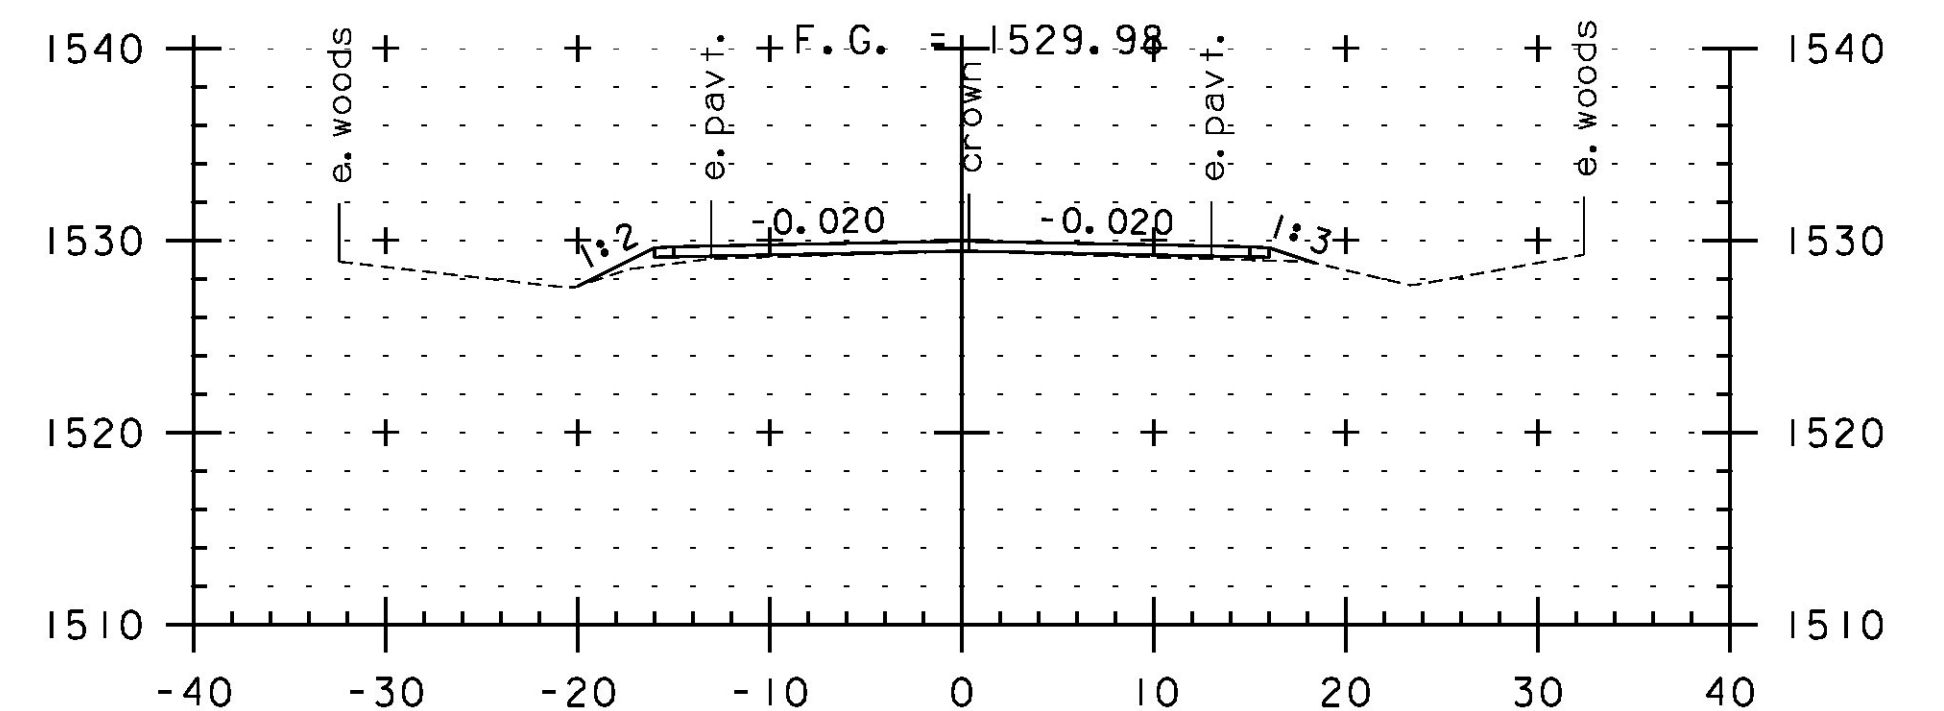

282+00



SCALE IN FEET

STA. 279+00 TO STA. 283+00

PROJECT NAME:	JAY-TROY	PLOT DATE:	5/16/2014
PROJECT NUMBER:	STP 2315(1)	DRAWN BY:	W. GORDON
FILE NAME:	z10b232xs.dgn	DESIGNED BY:	N. LEMAY
PROJECT LEADER:	P. SHEDD	CHECKED BY:	P. SHEDD
CROSS SECTION SHEET 63		SHEET	199 OF 244