




288+50

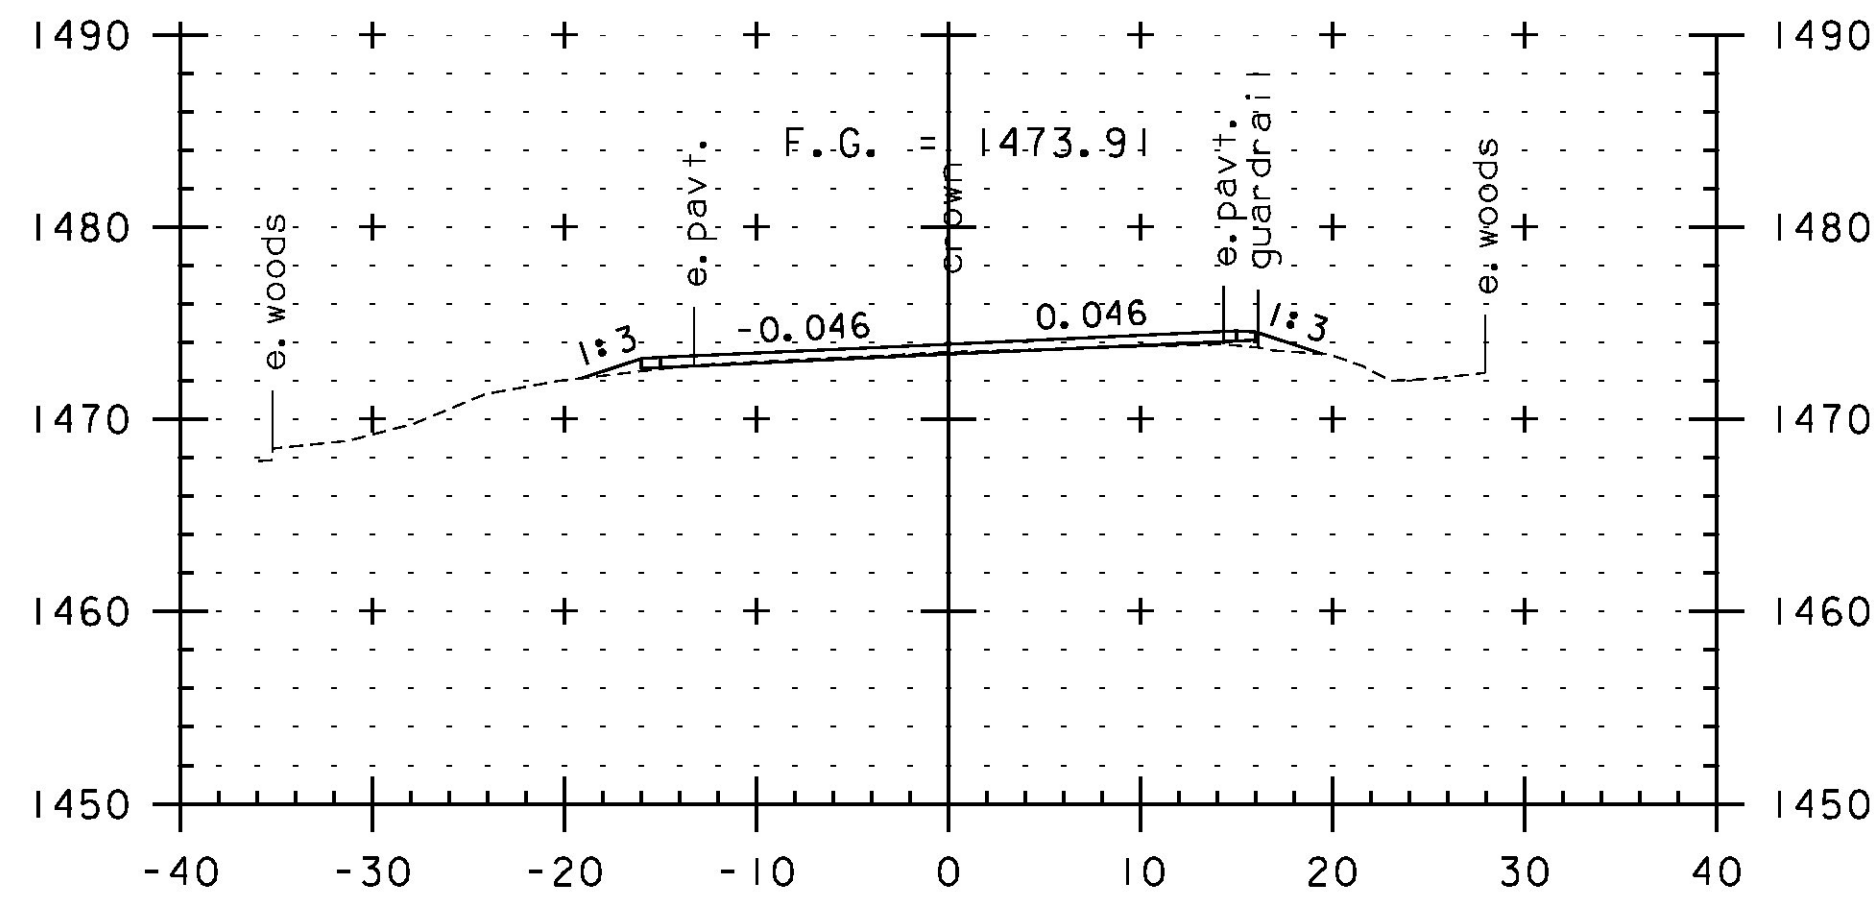


290+00

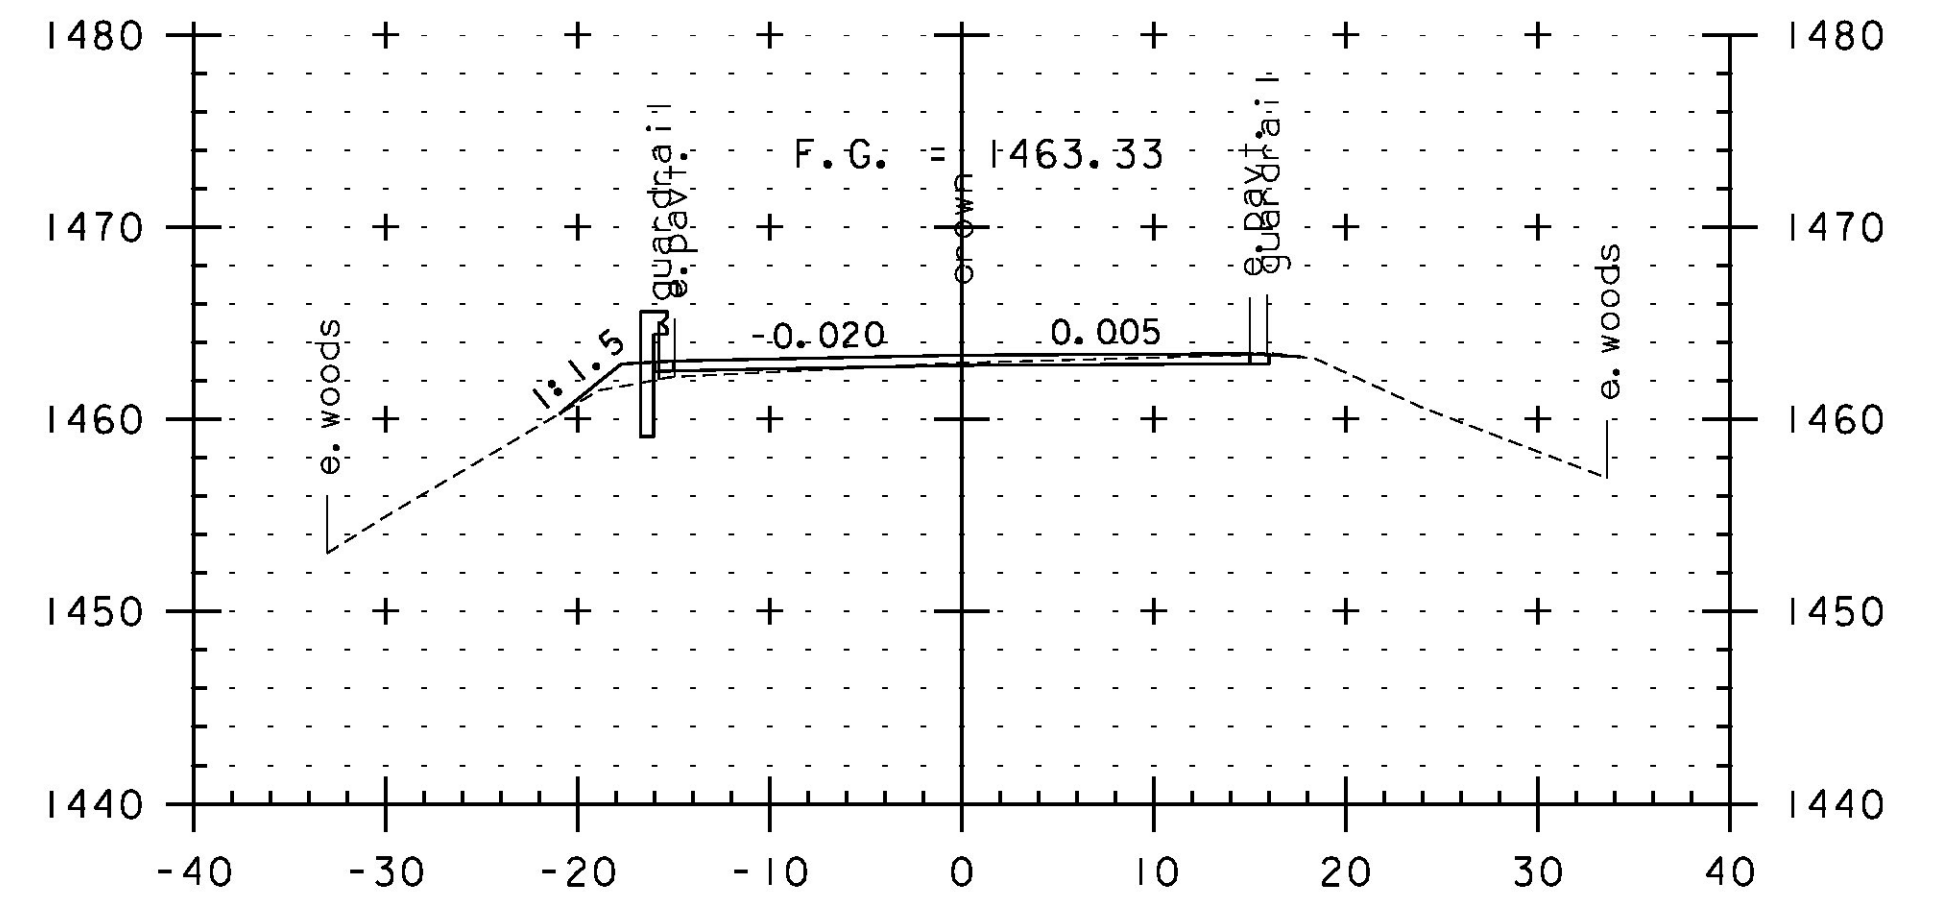


291+50

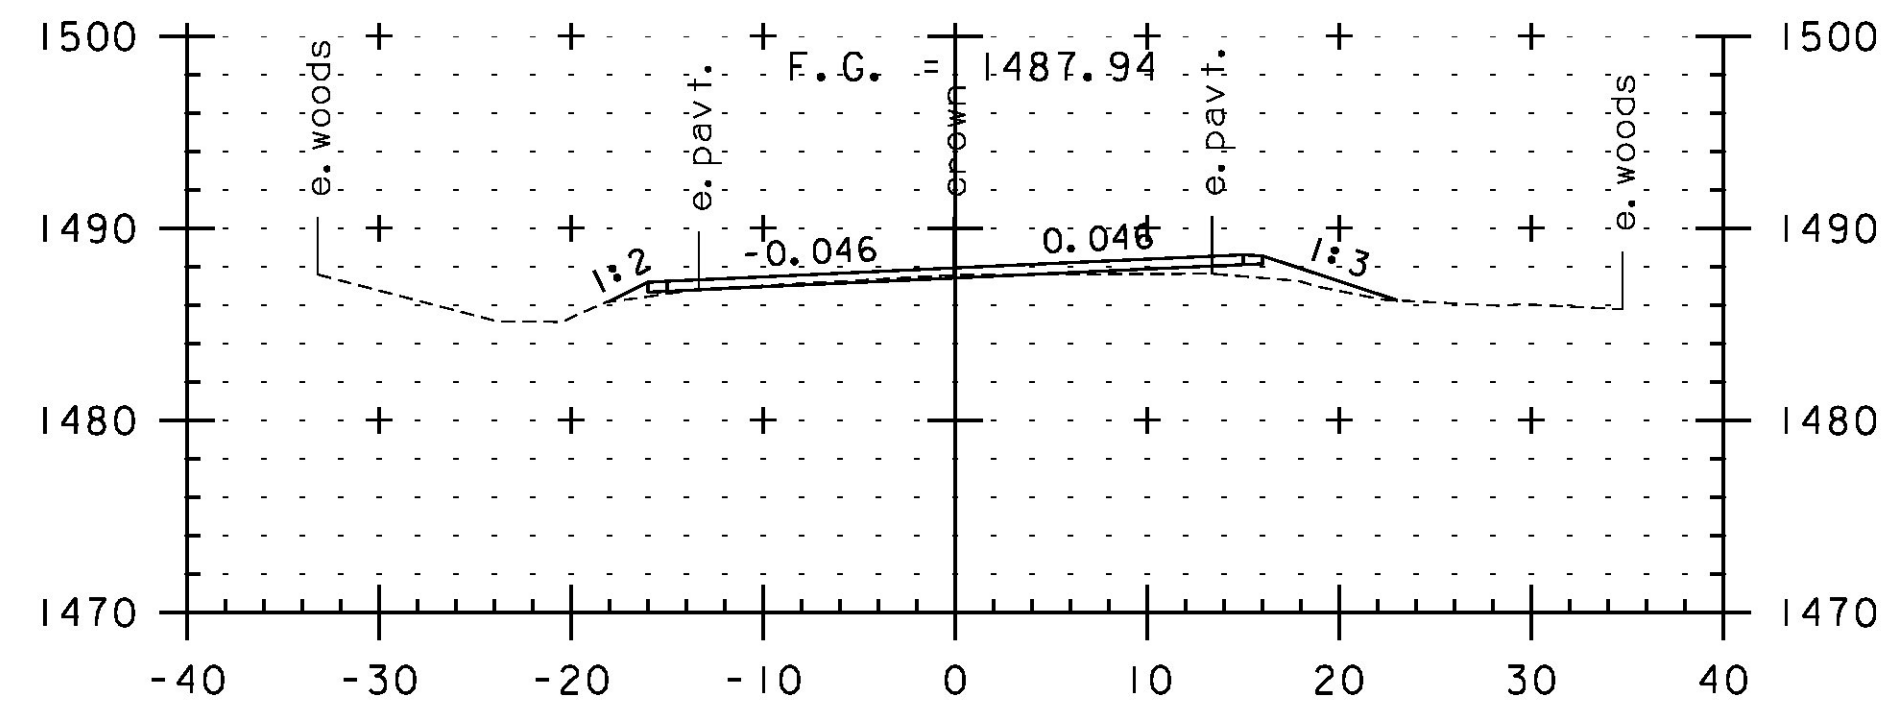


288+00

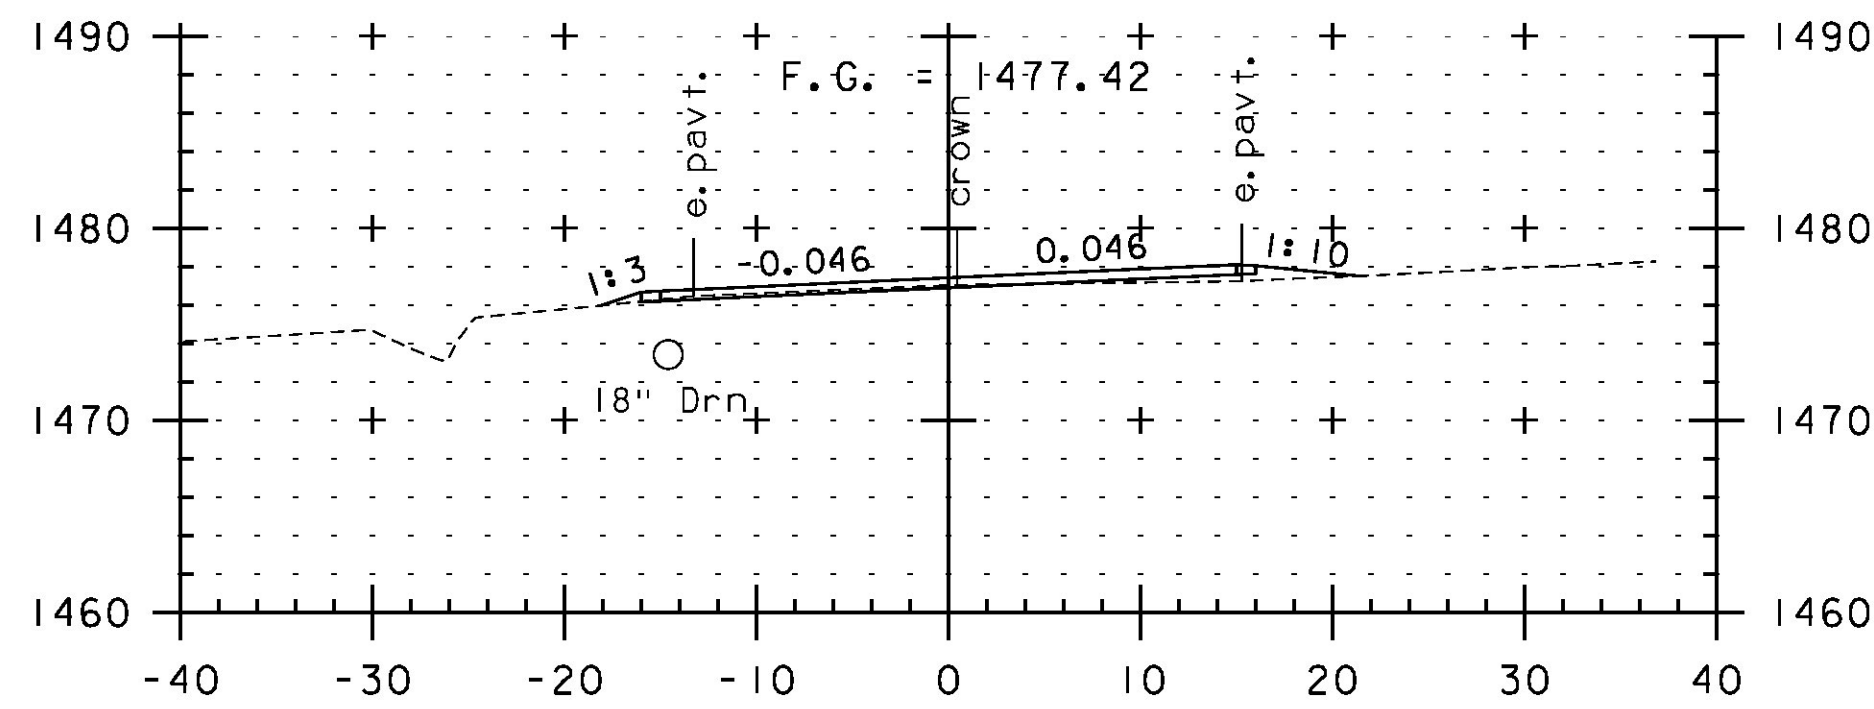


289+50

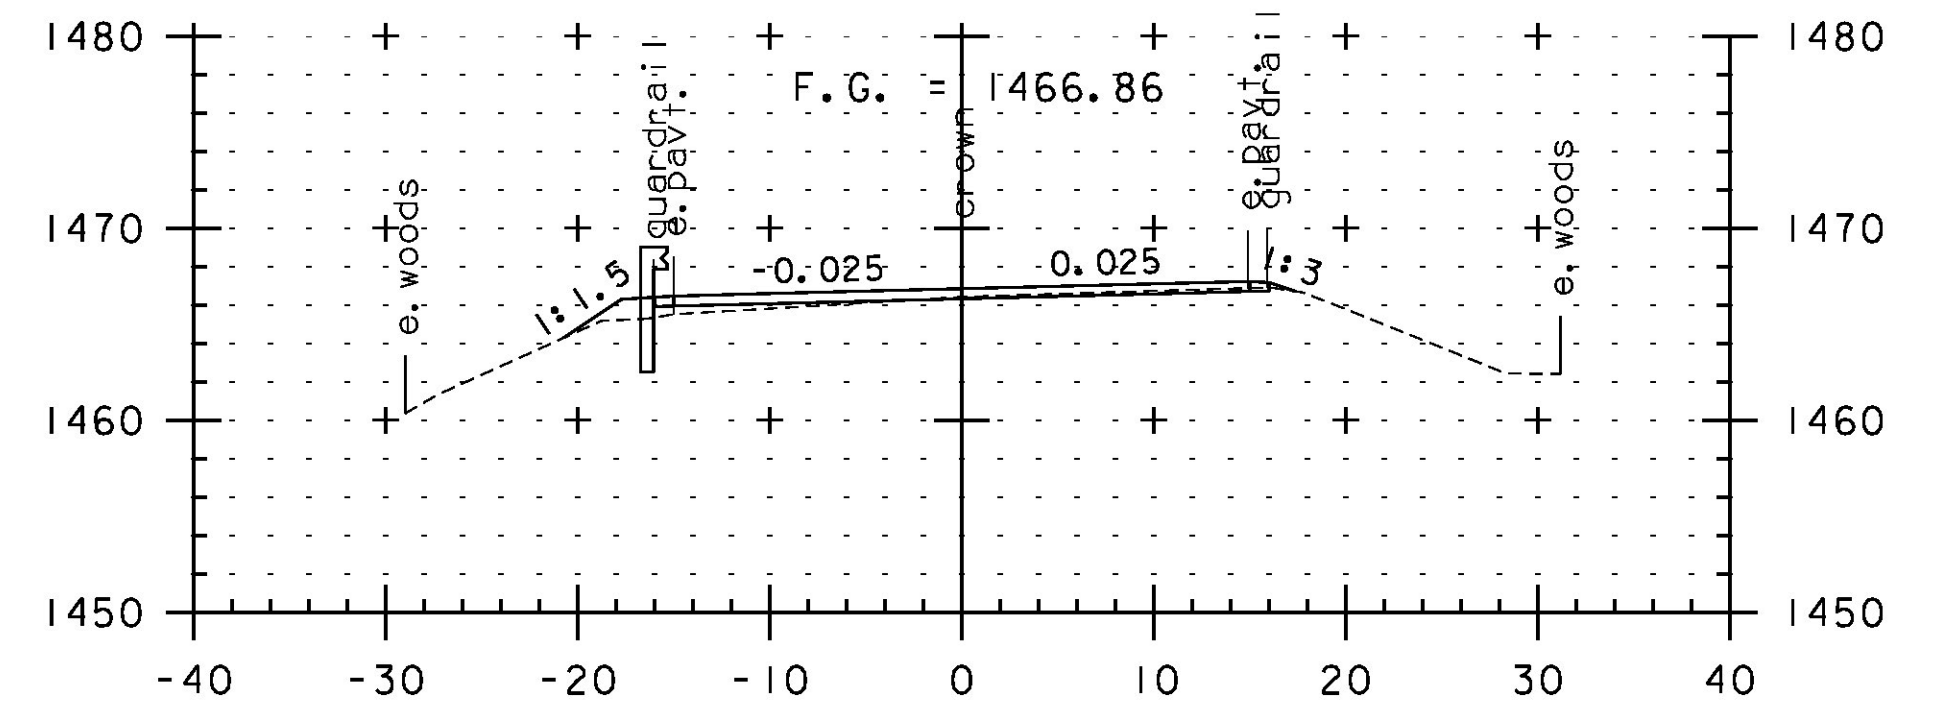


291+00

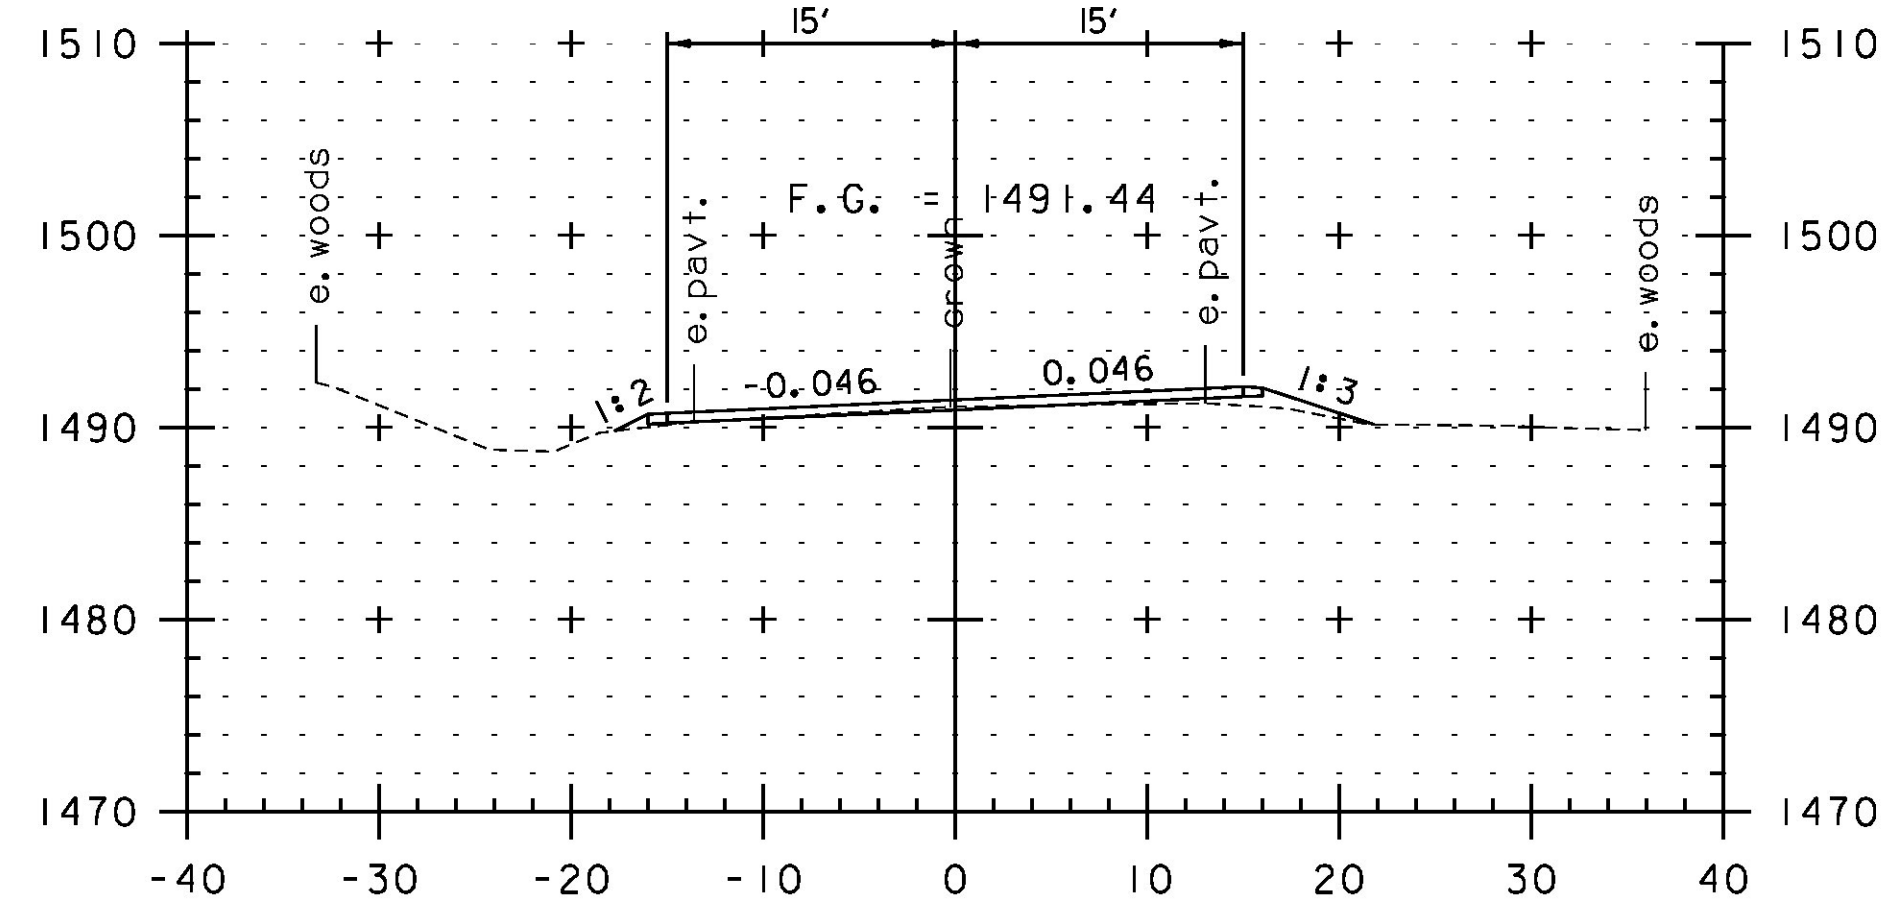

287+50

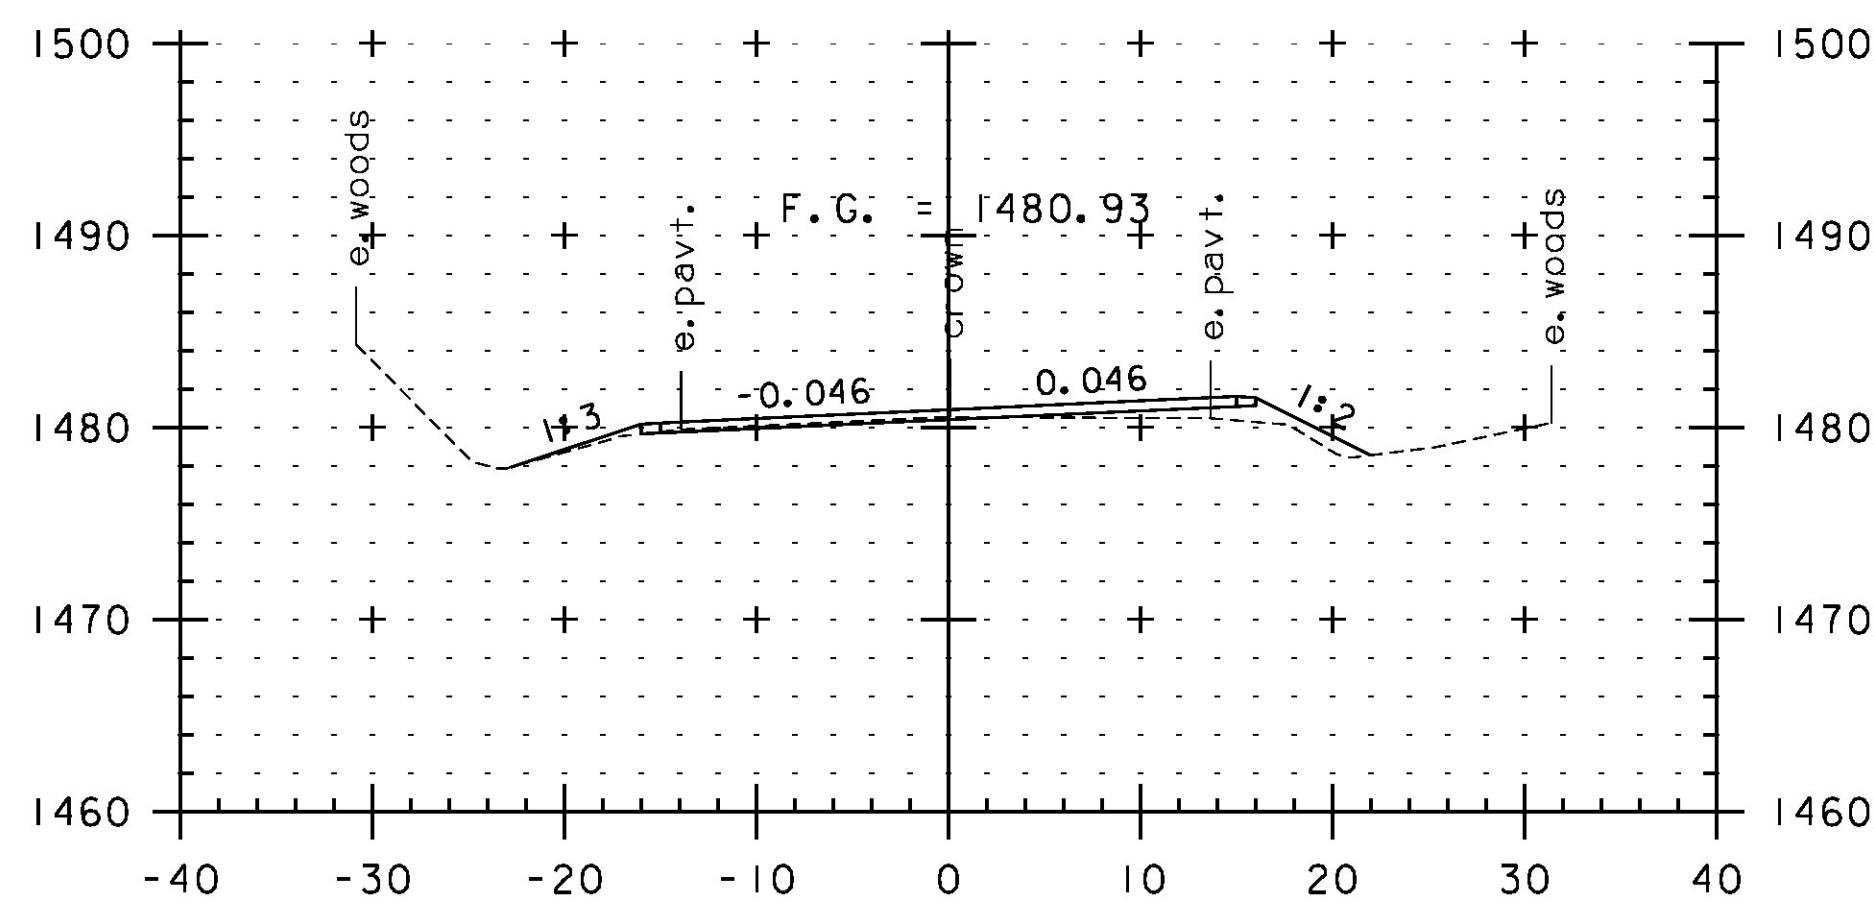

289+00

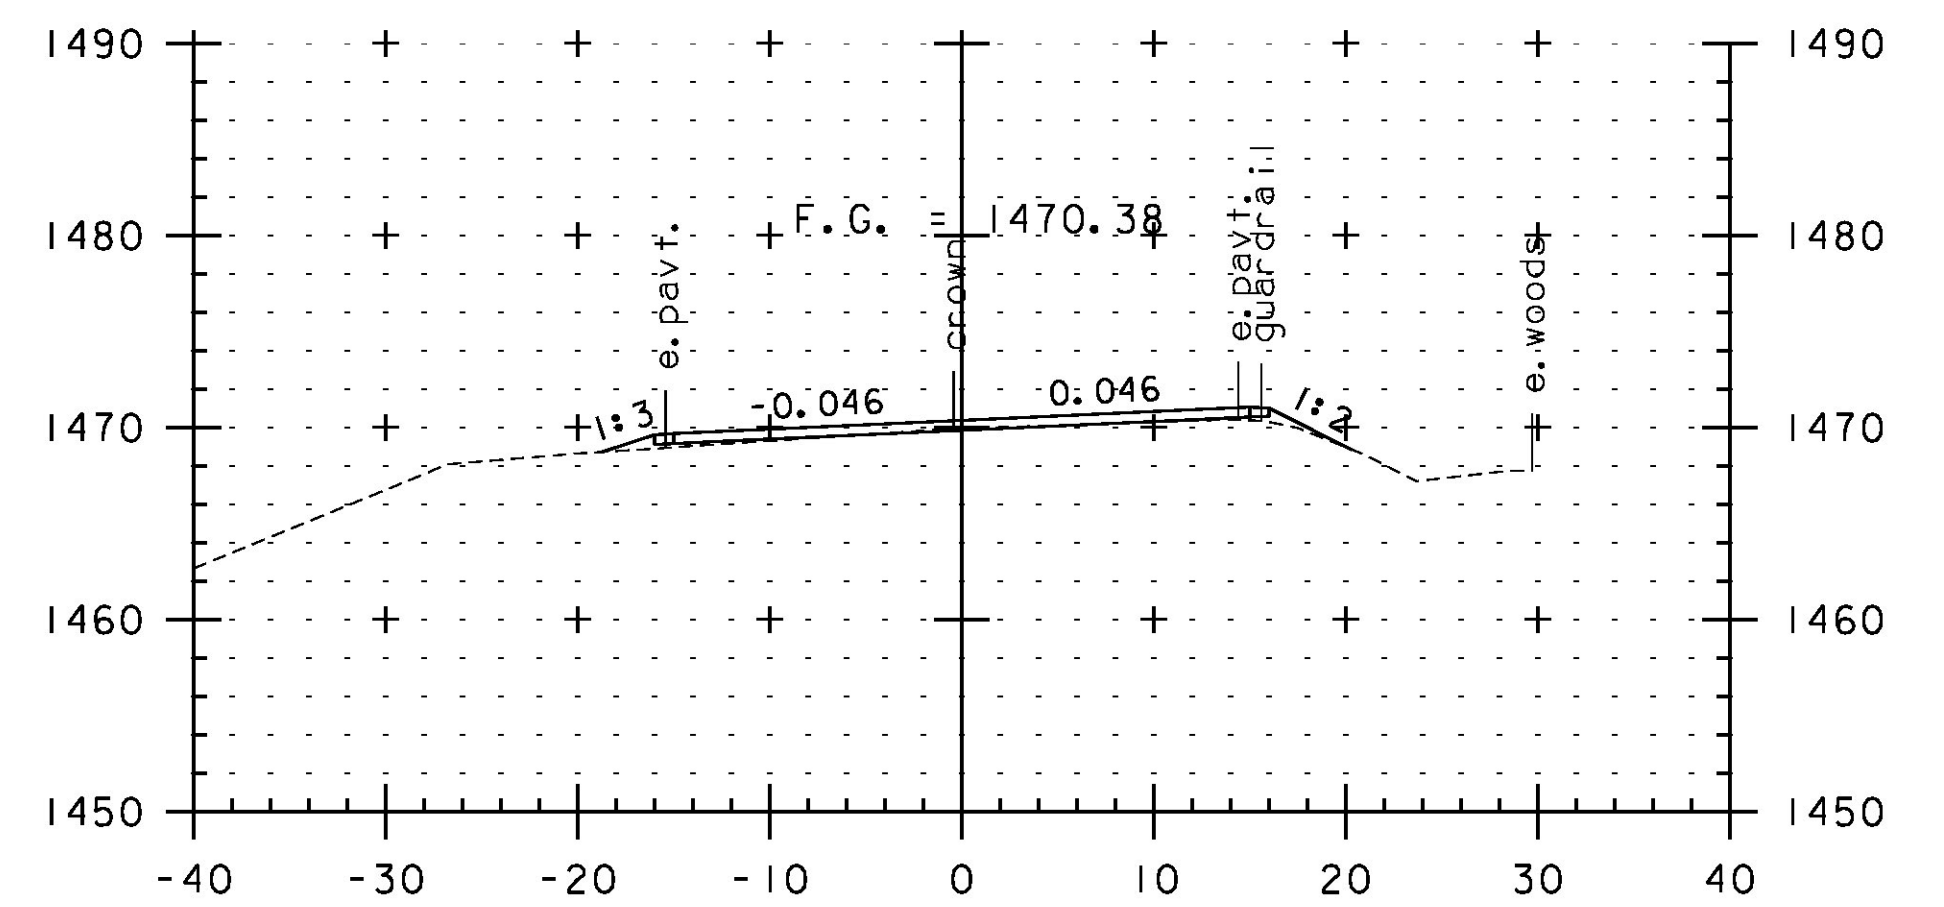

290+50



STA. 287+50 TO STA. 291+50

PROJECT NAME:	JAY-TROY	PLOT DATE:	5/16/2014
PROJECT NUMBER:	STP 2315(I)	DRAWN BY:	W. GORDON
FILE NAME:	z10b232xs.dgn	CHECKED BY:	P. SHEDD
PROJECT LEADER:	P. SHEDD	CROSS SECTION SHEET	65
DESIGNED BY:	N. LEMAY	SHEET	201 OF 244