




293+00

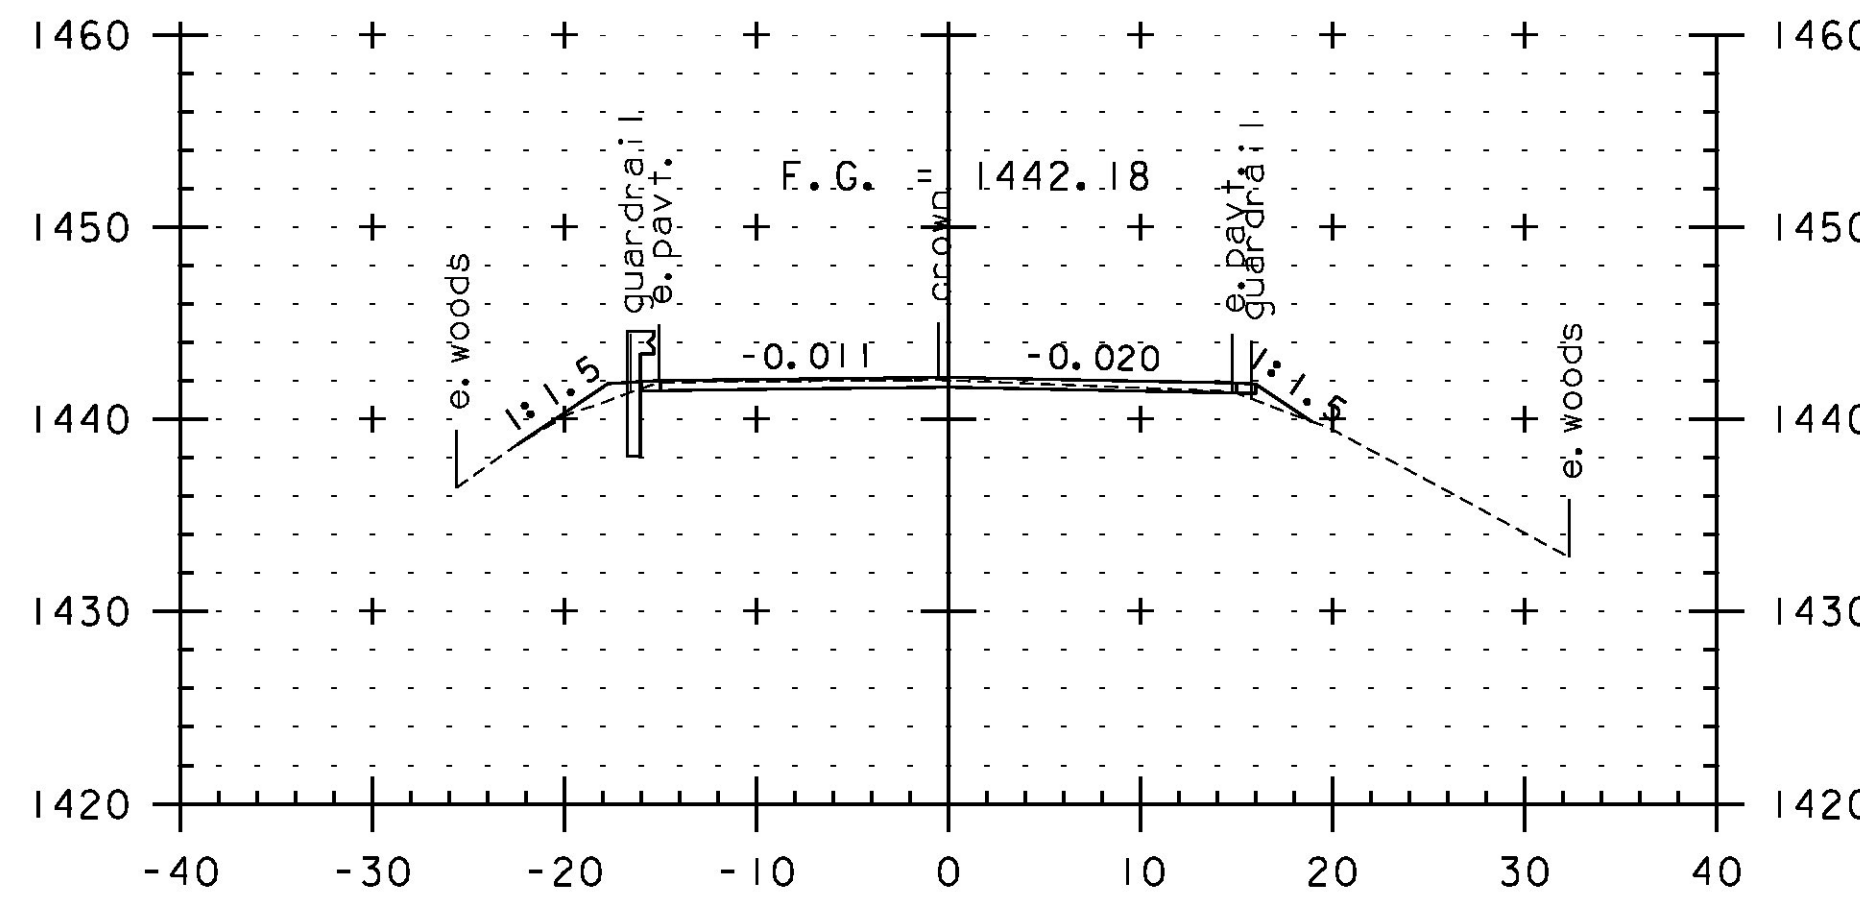


294+50

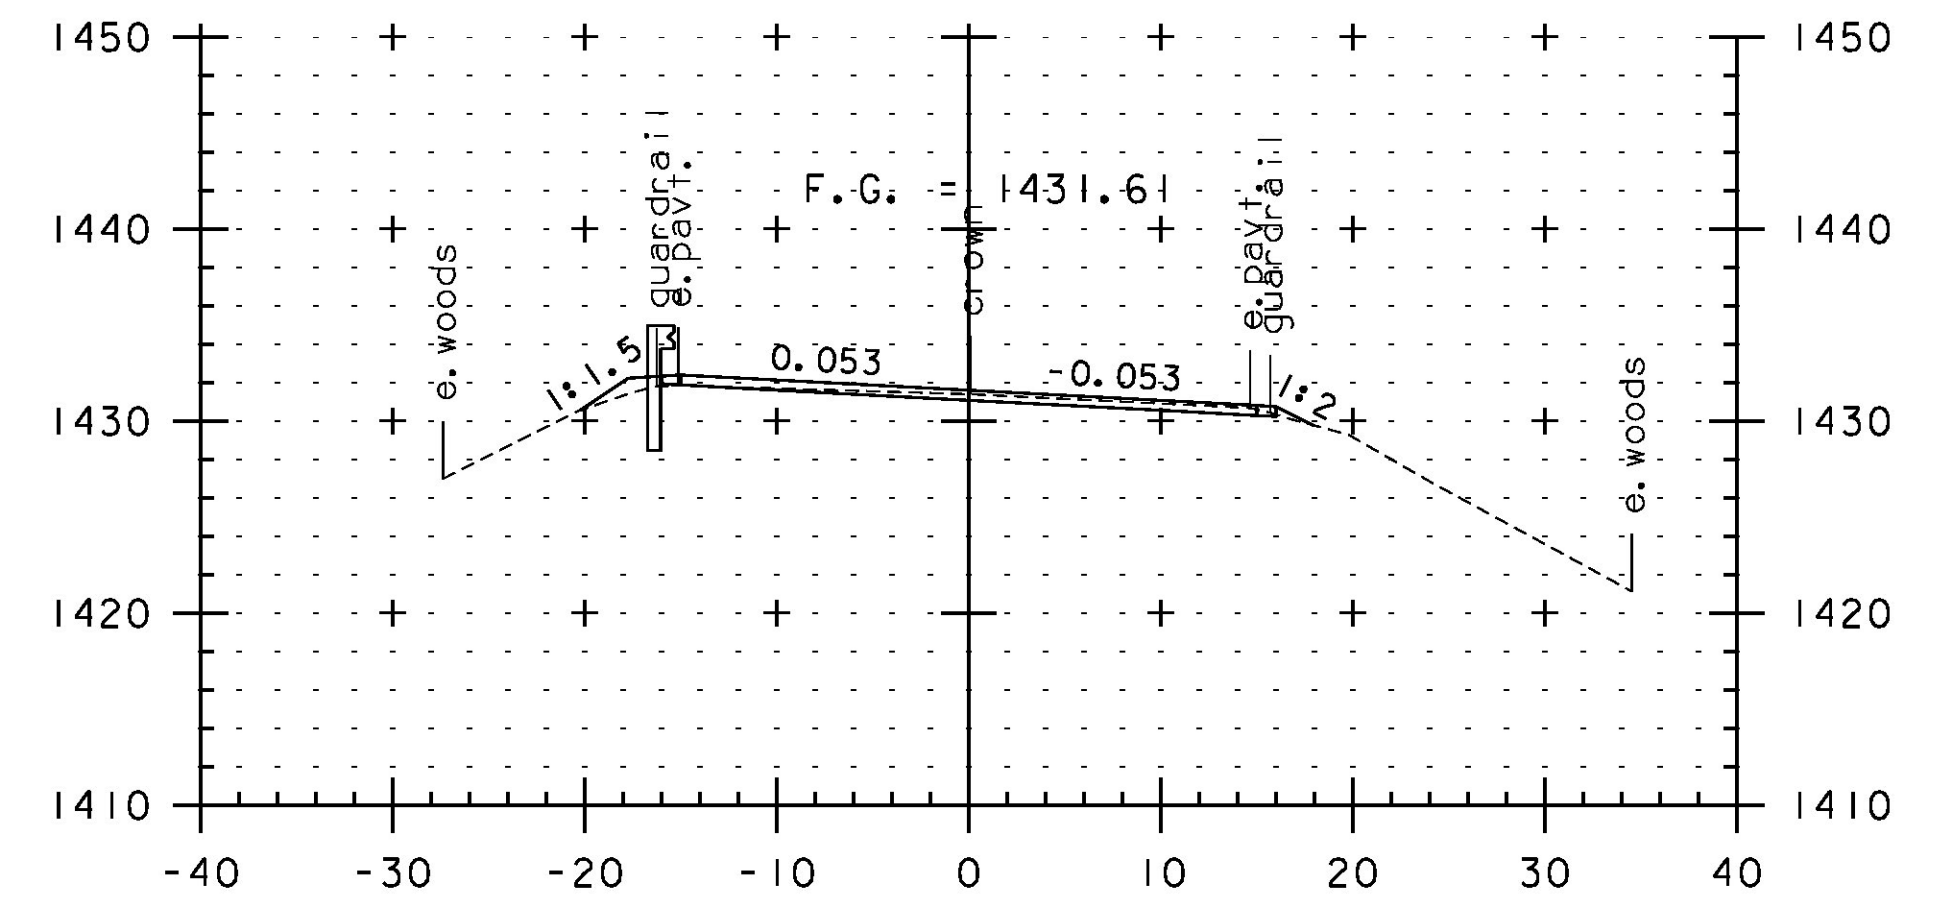


296+00

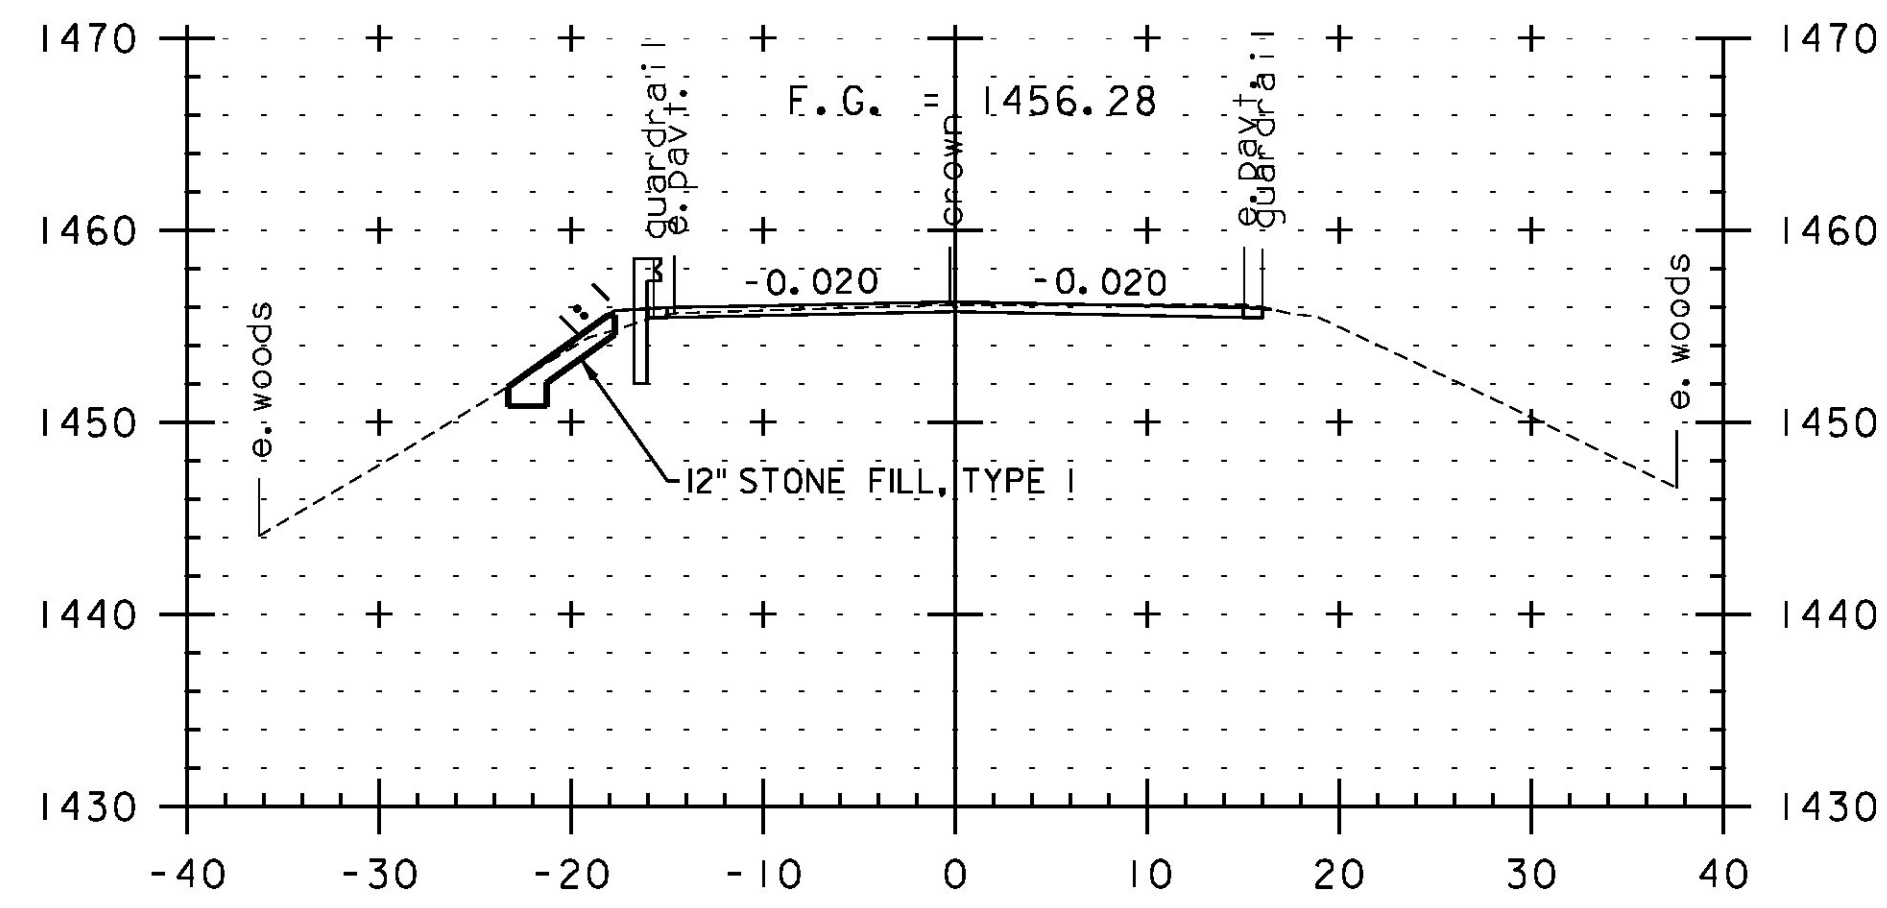


292+50

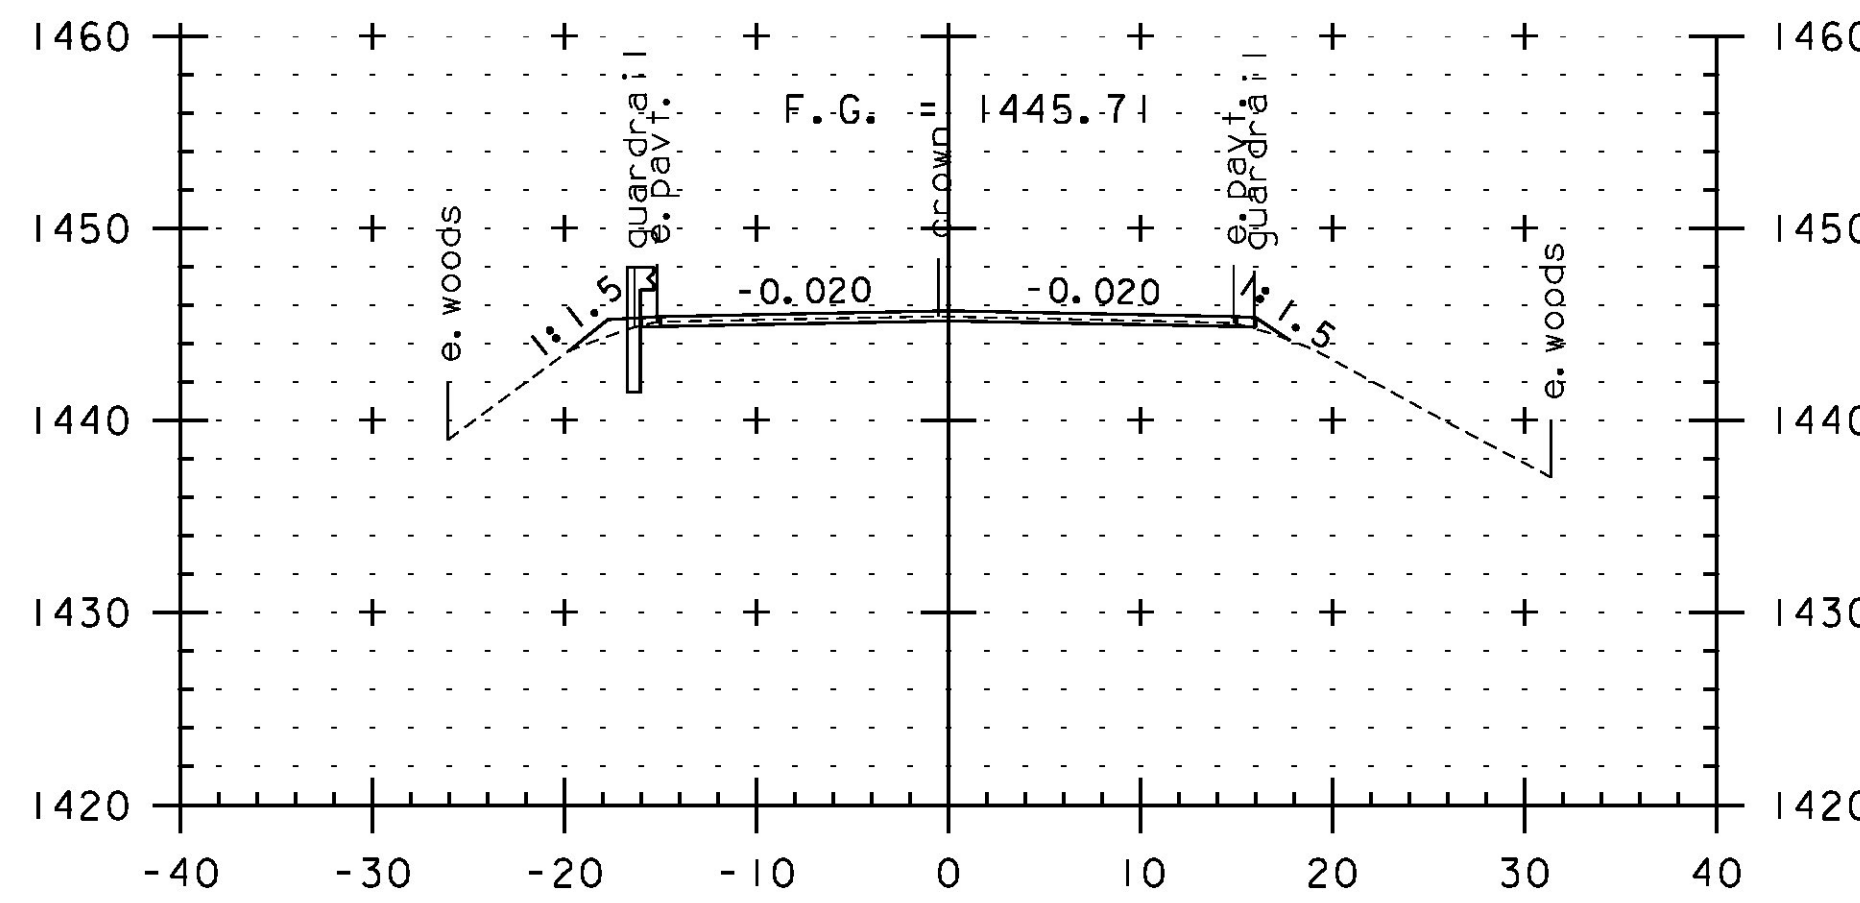


294+00

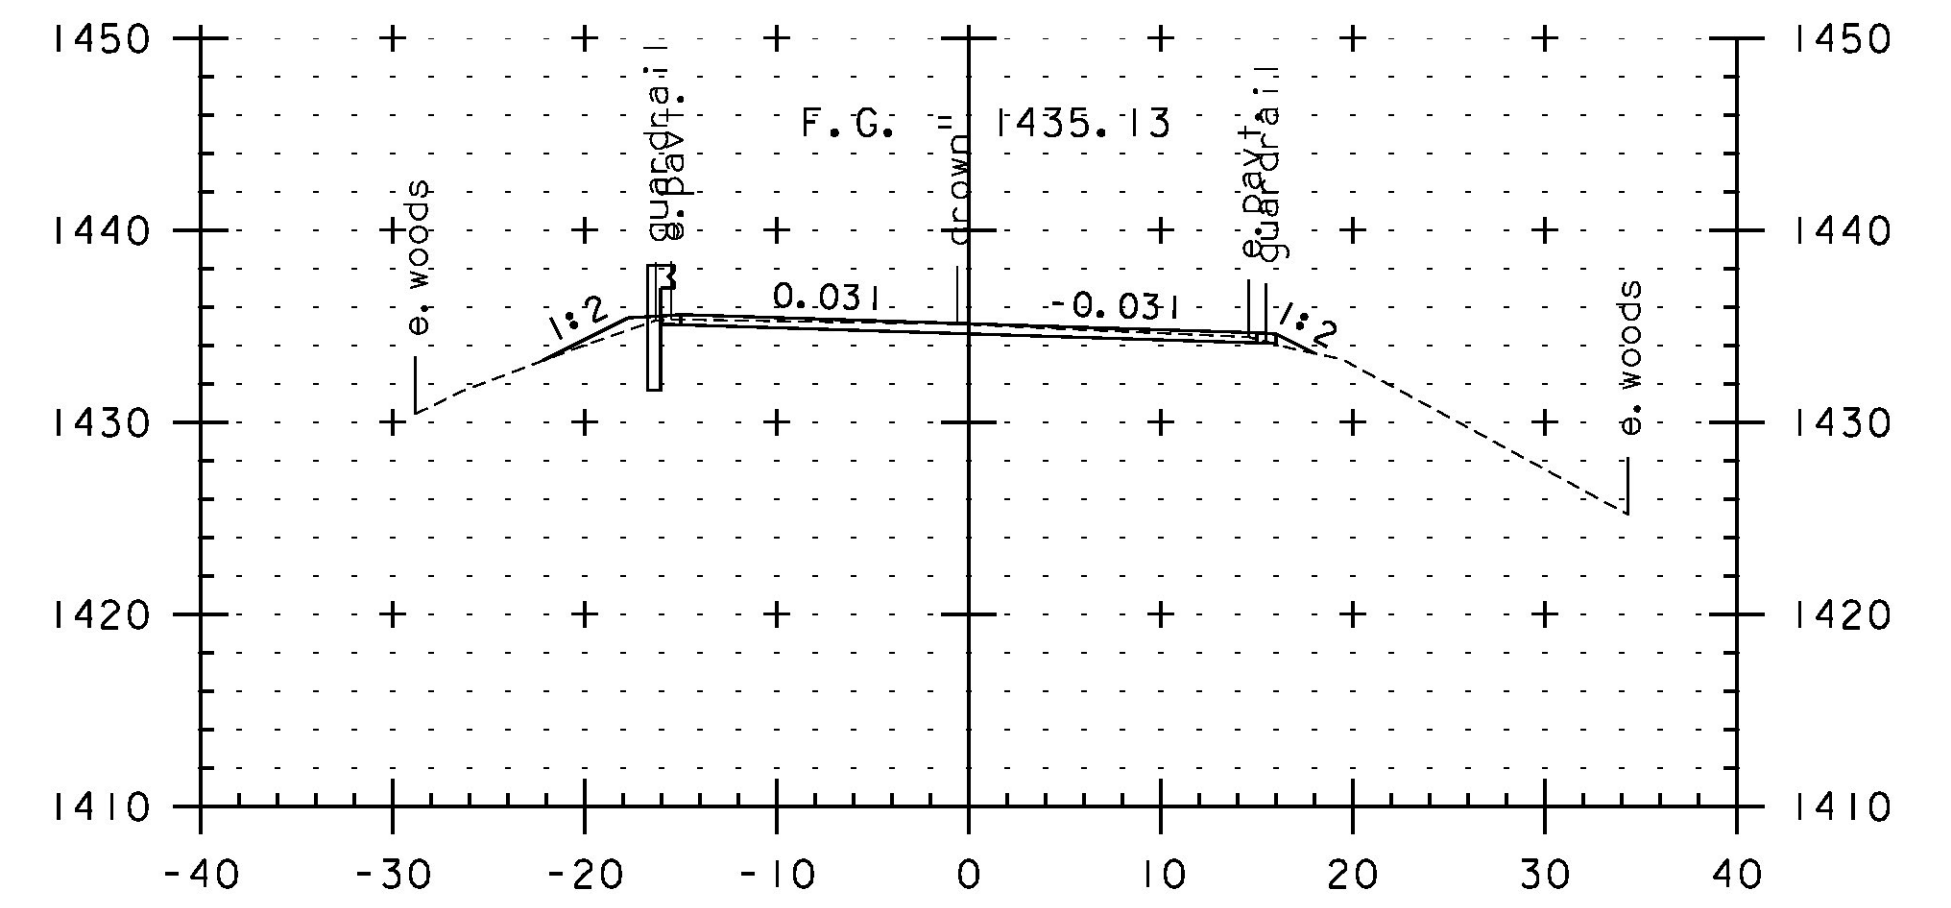


295+50

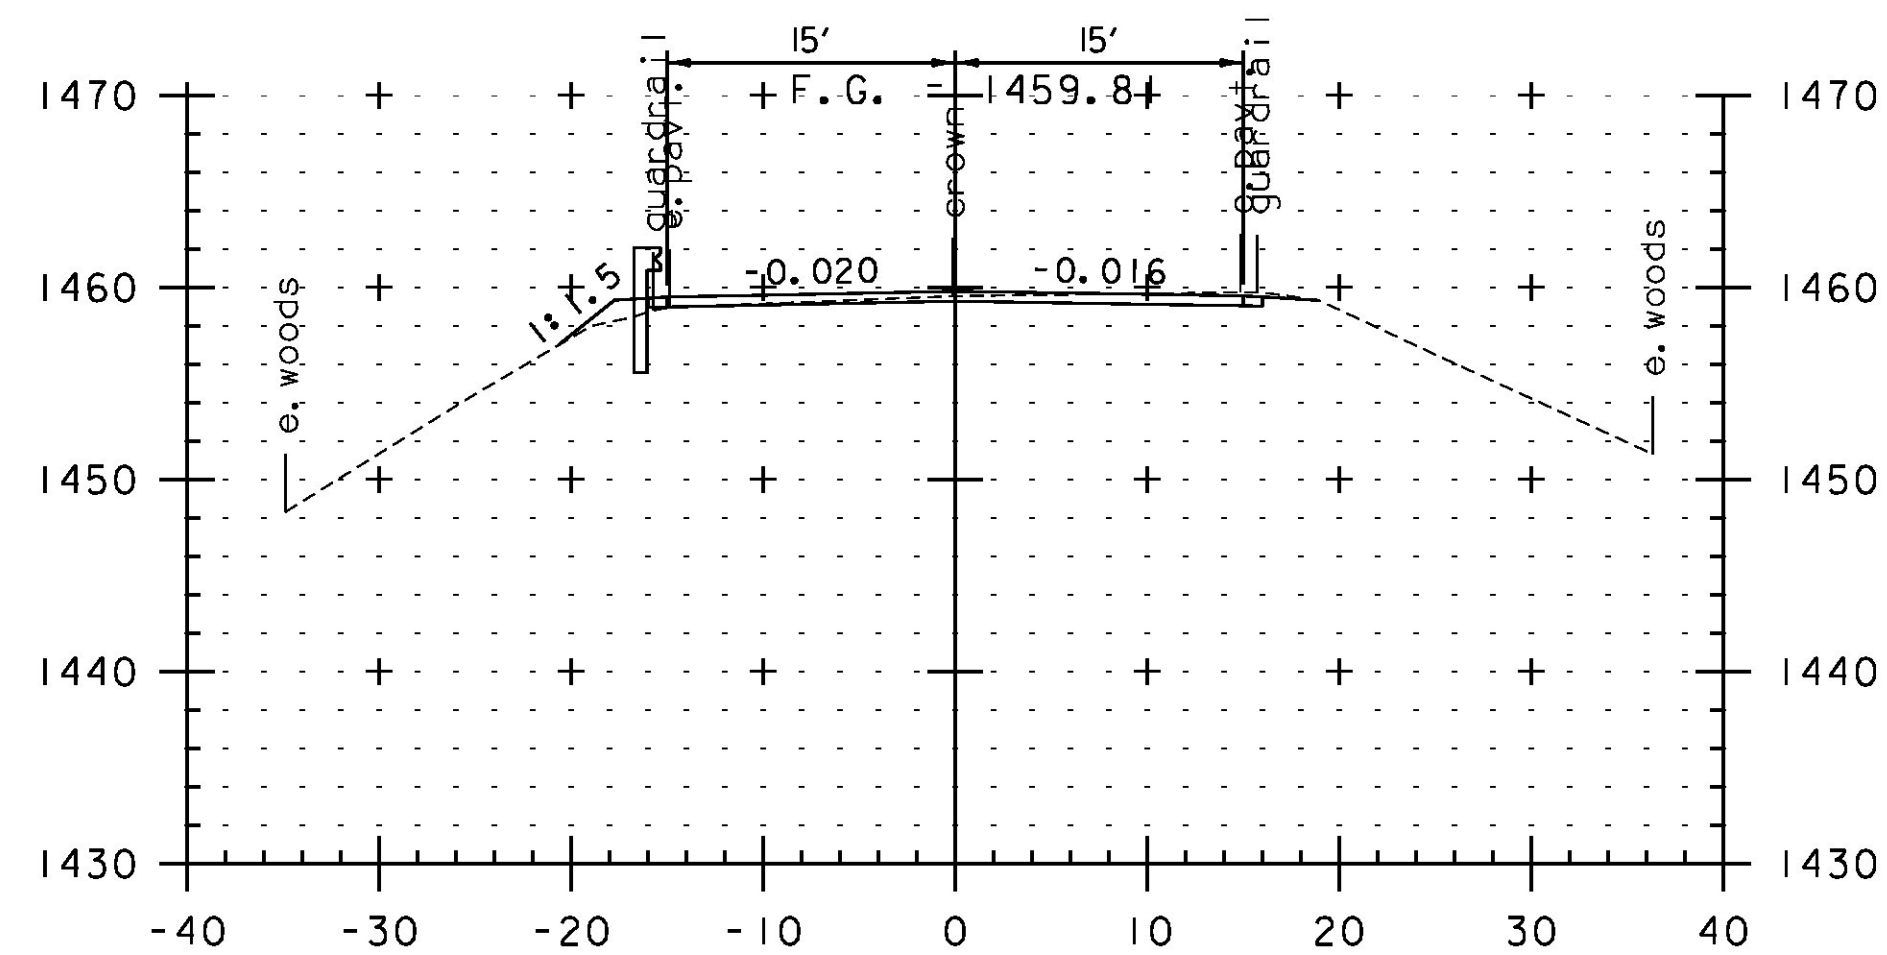

292+00

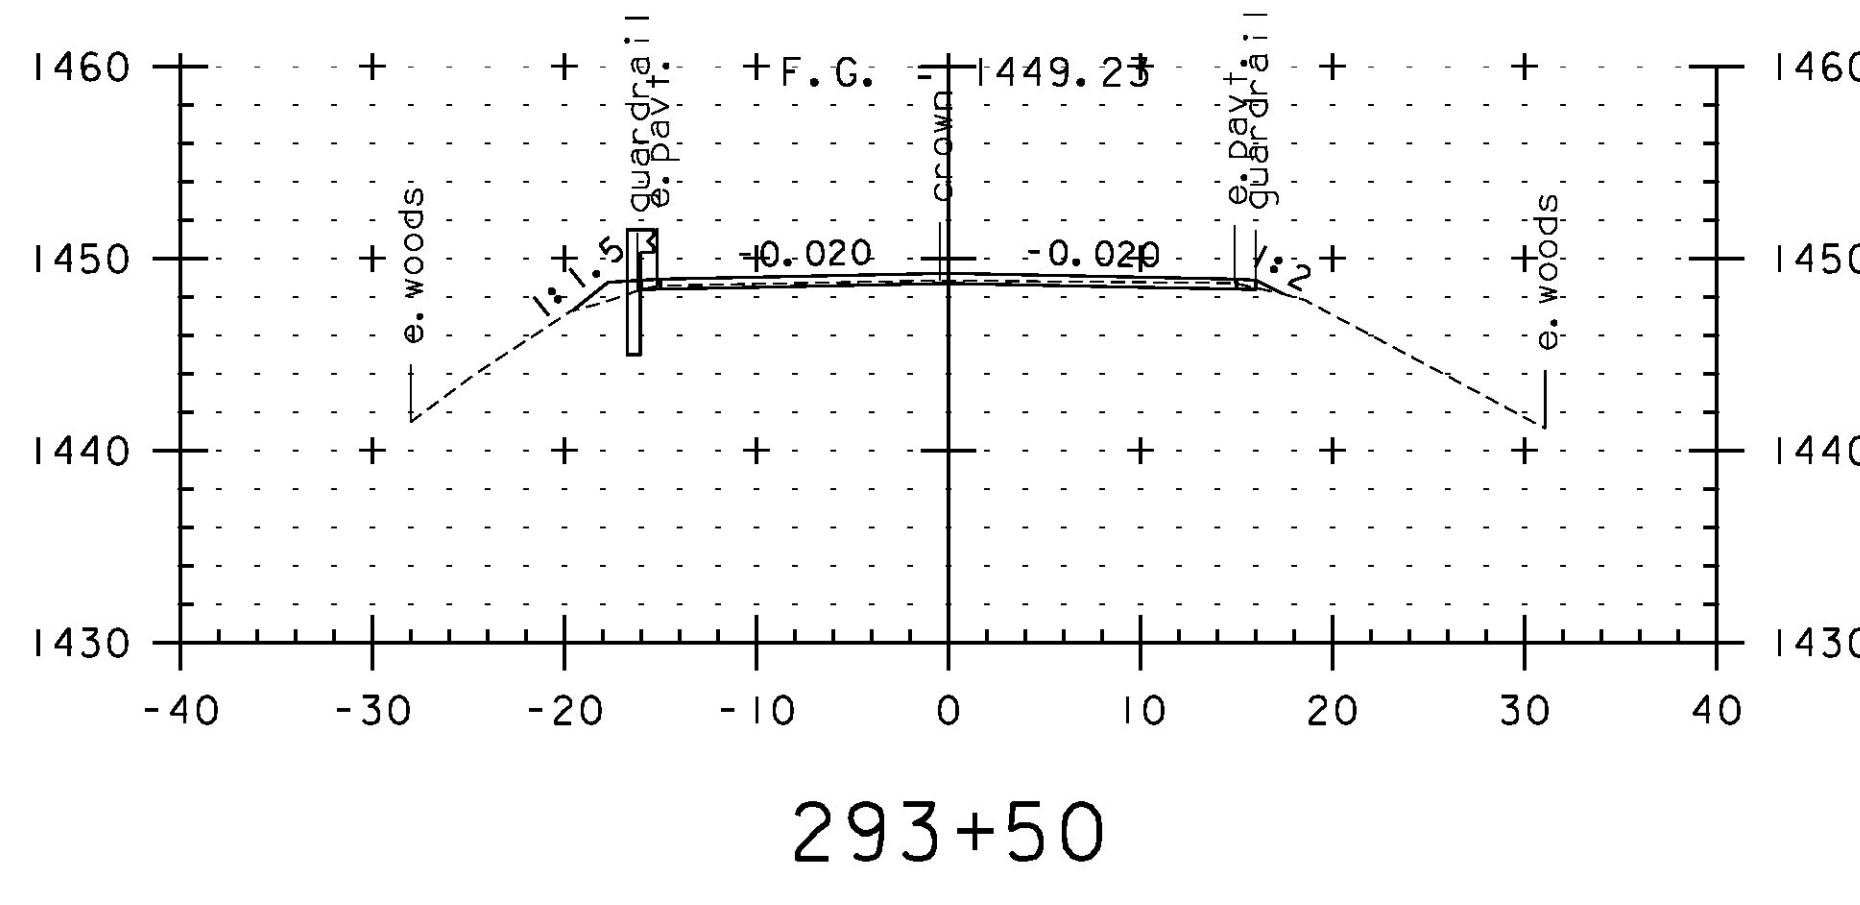

293+50

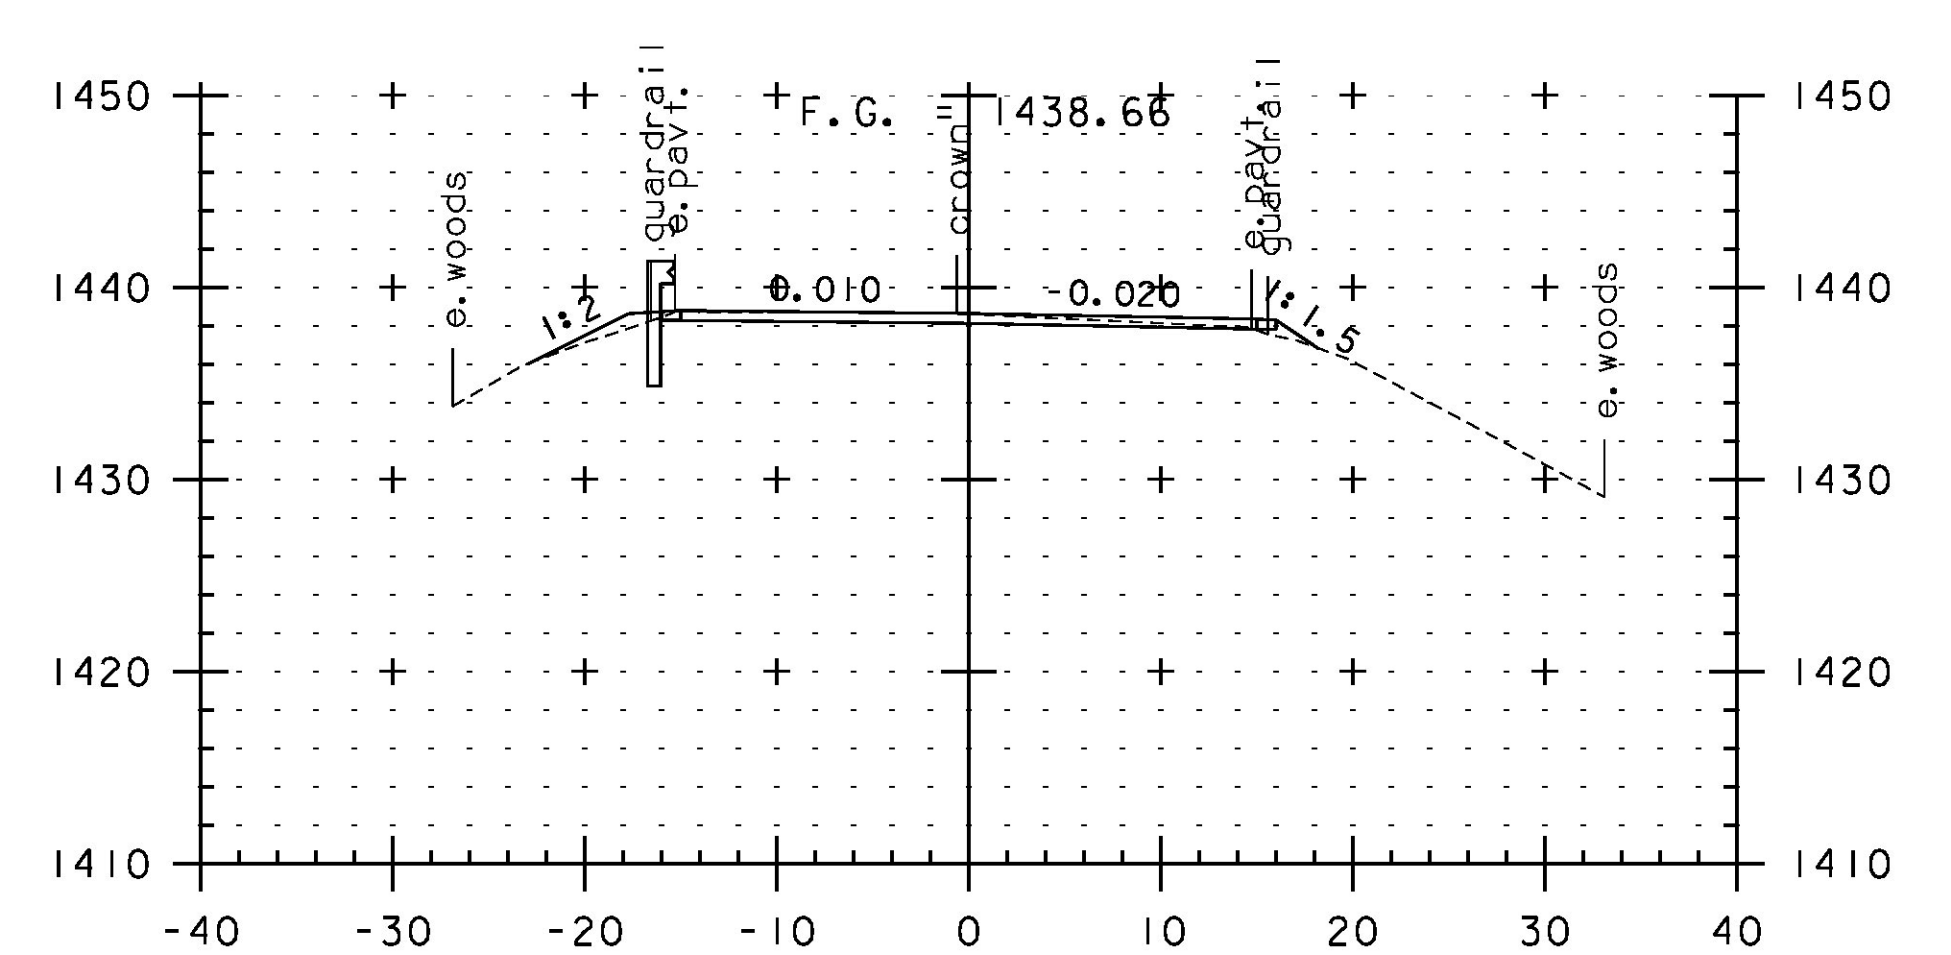

295+00



SCALE IN FEET

STA. 292+00 TO STA. 296+00

PROJECT NAME: JAY-TROY
PROJECT NUMBER: STP 2315(I)

FILE NAME: z10b232xs.dgn
PROJECT LEADER: P. SHEDD
DESIGNED BY: N. LEMAY
CROSS SECTION SHEET 66

PLOT DATE: 5/16/2014
DRAWN BY: W. GORDON
CHECKED BY: P. SHEDD
SHEET 202 OF 244