




297+50

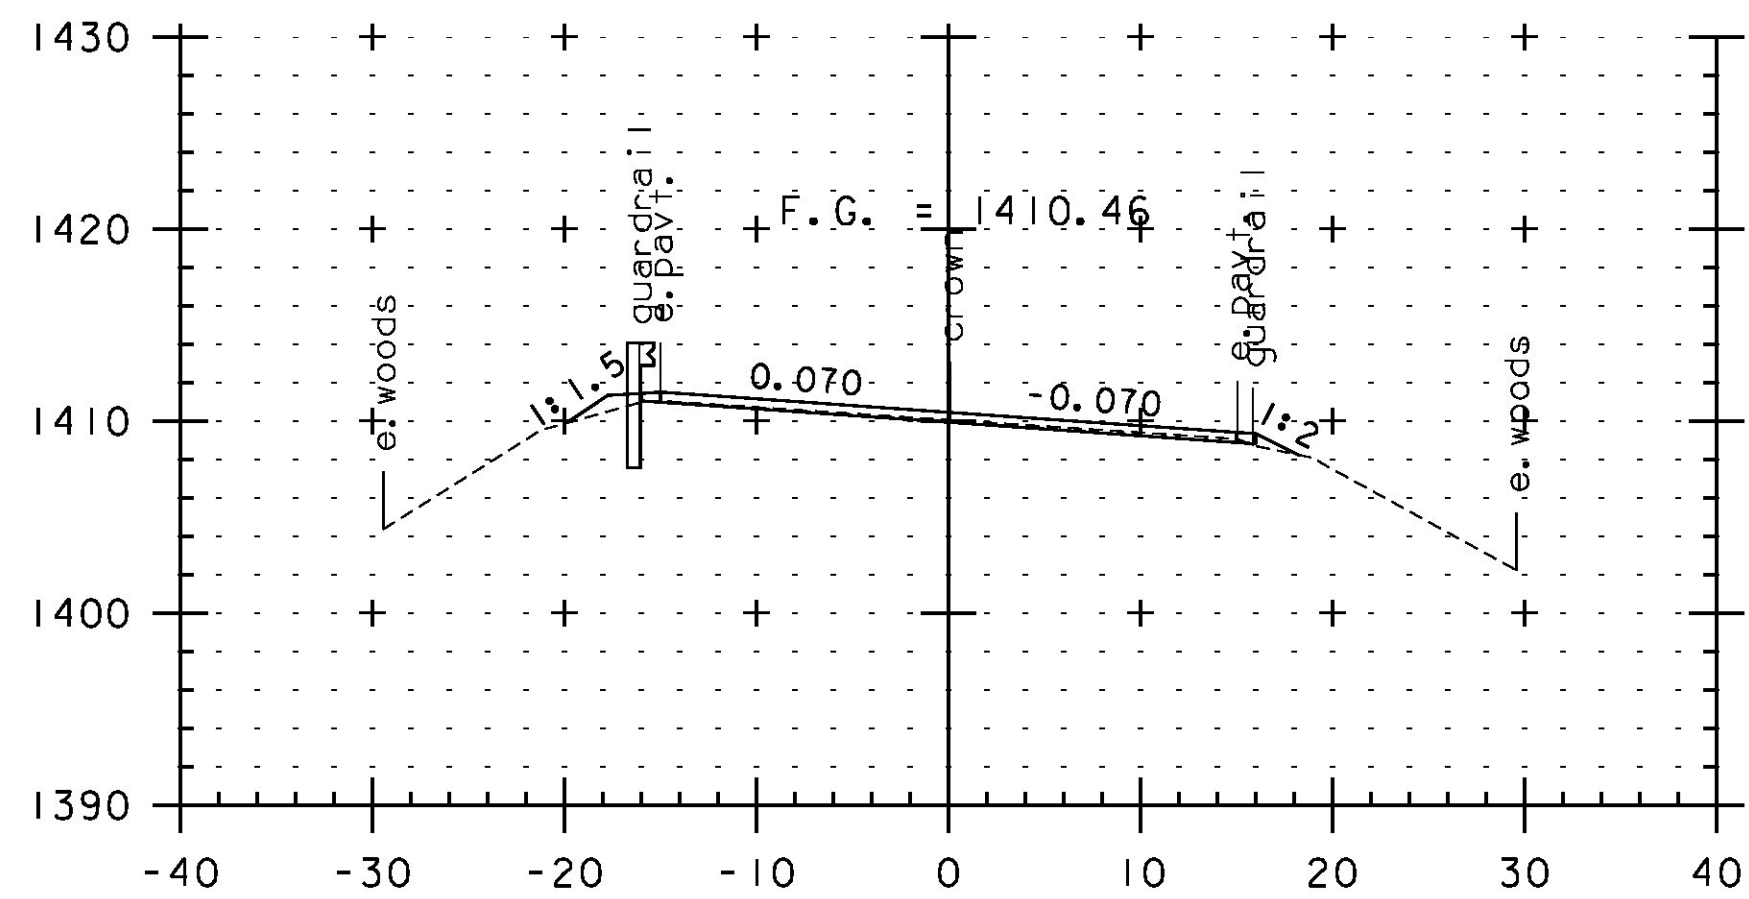


299+00

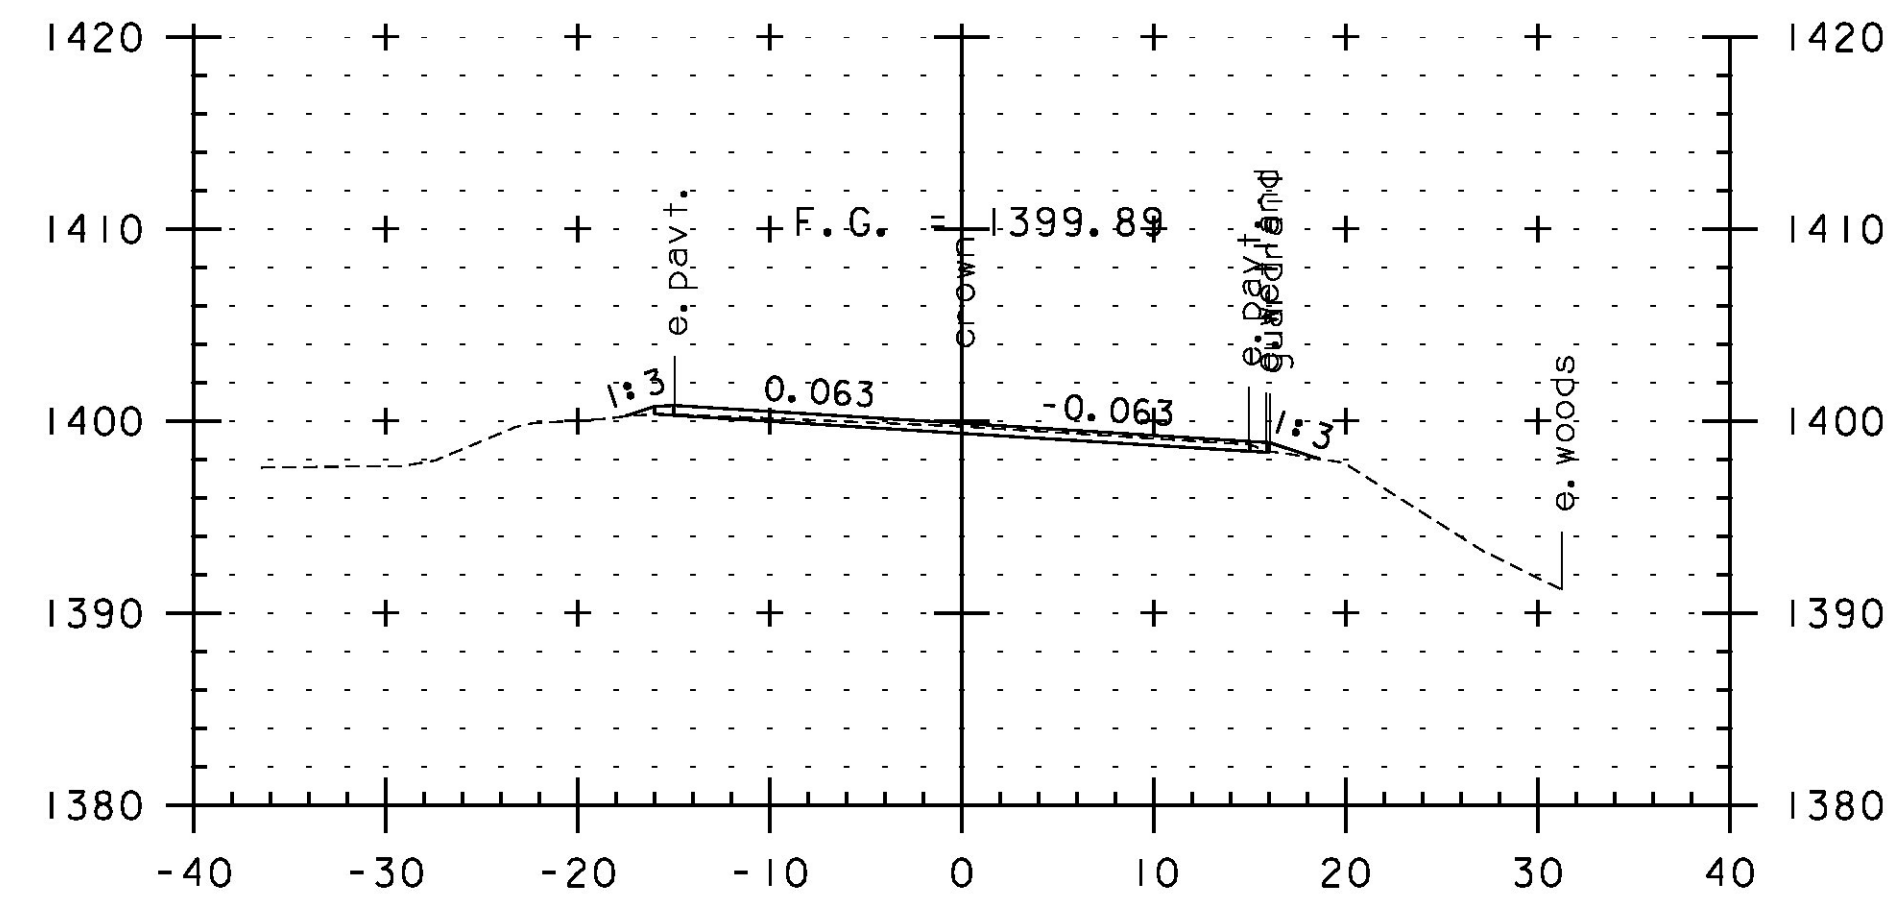


300+50

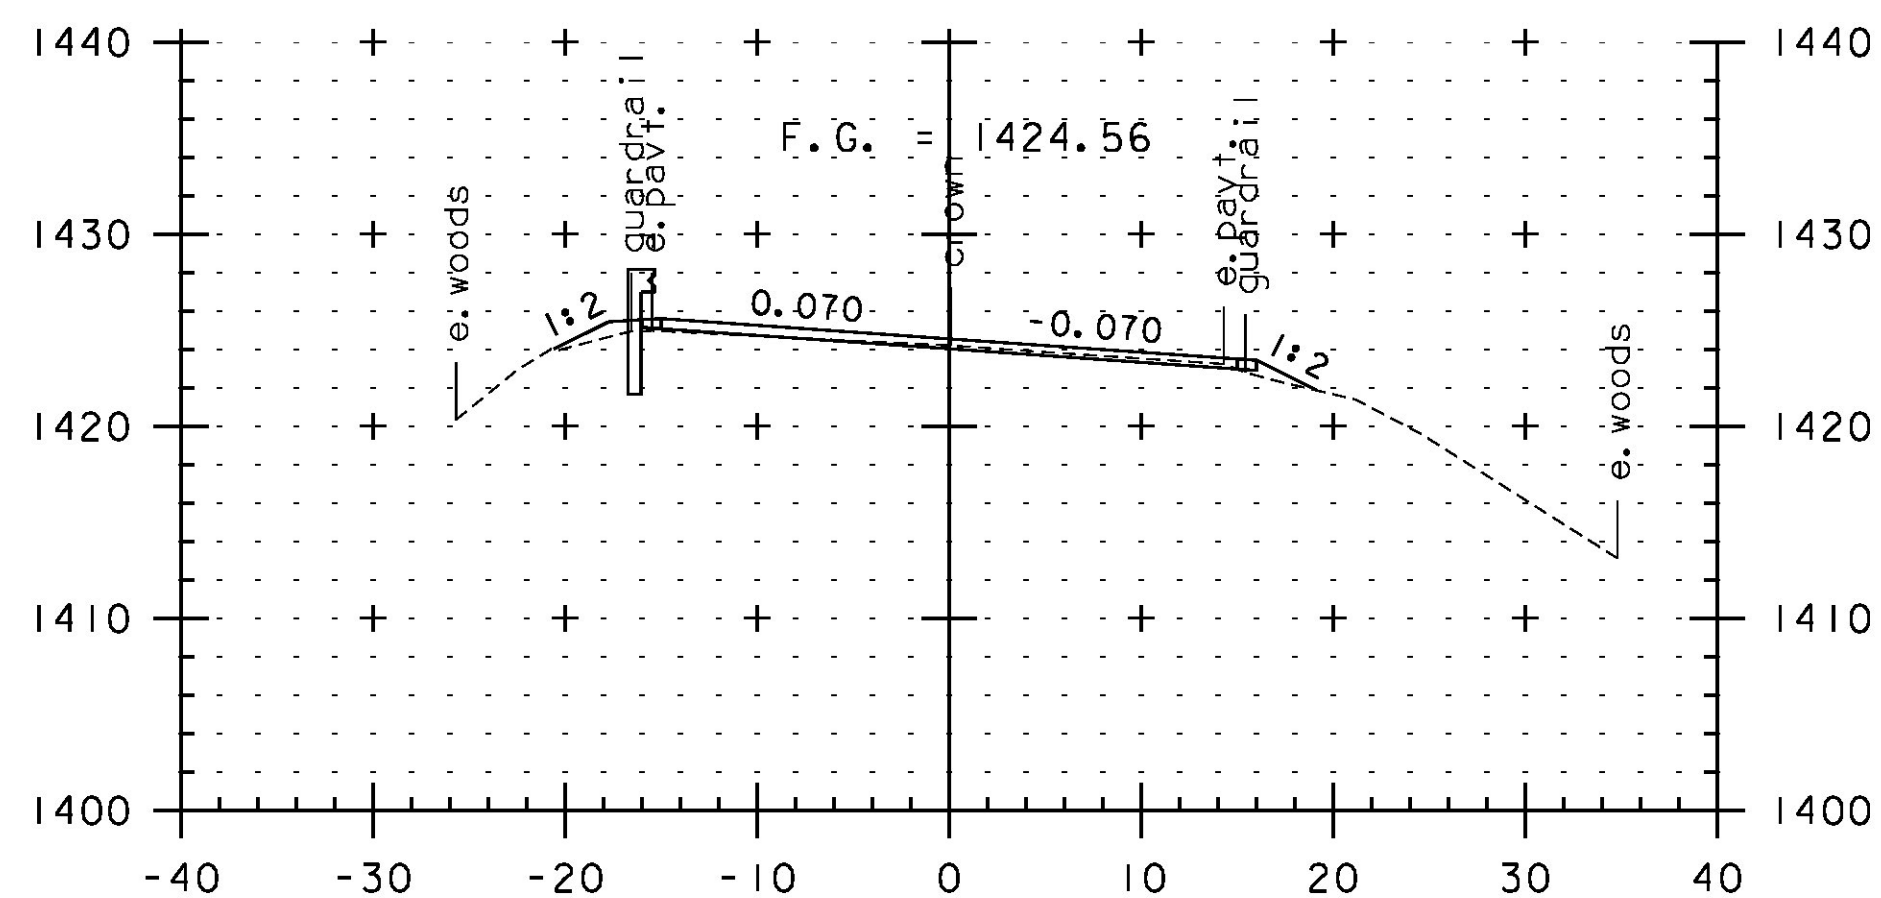


297+00

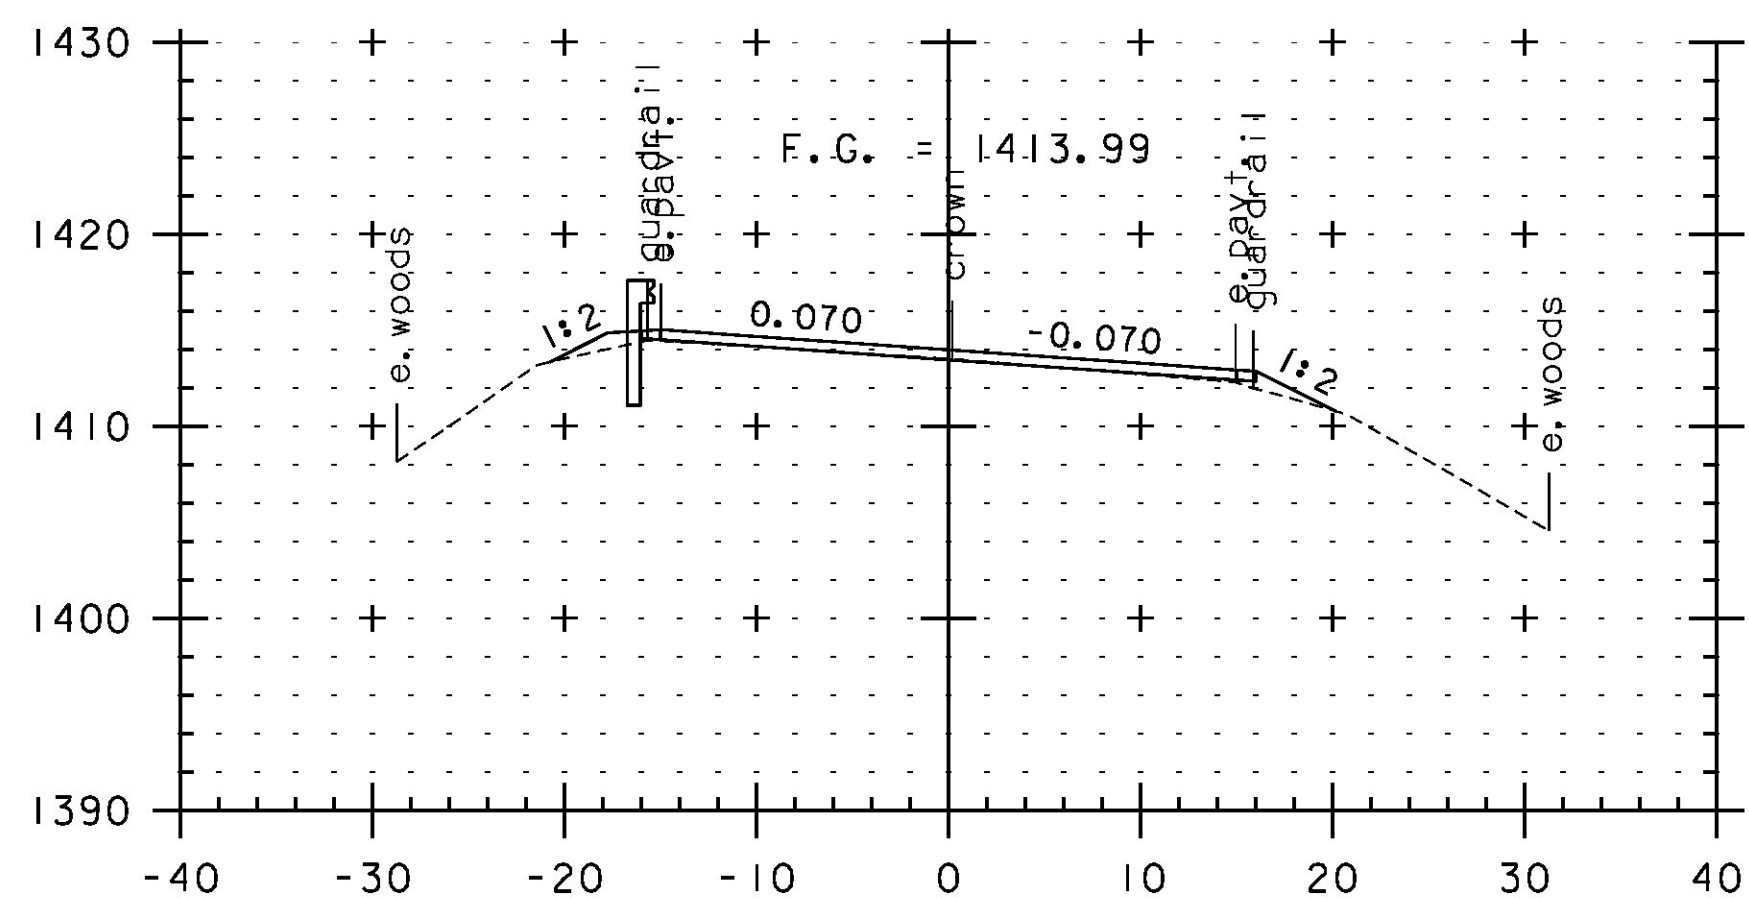


298+50

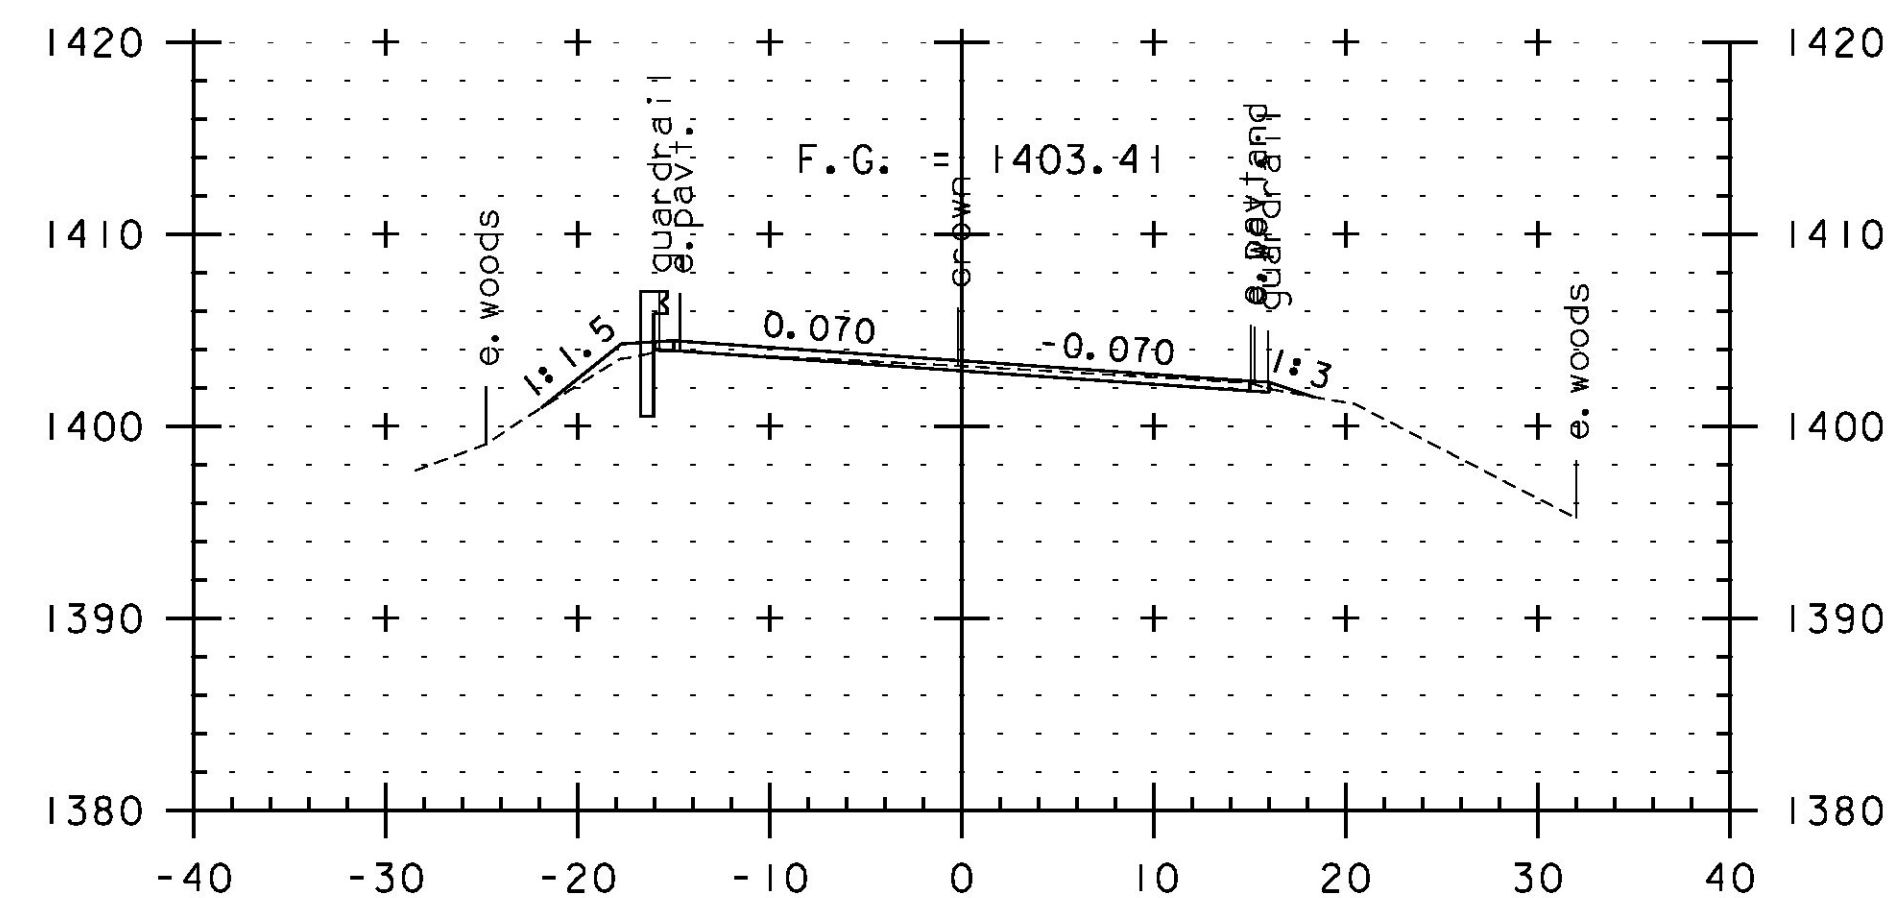


300+00

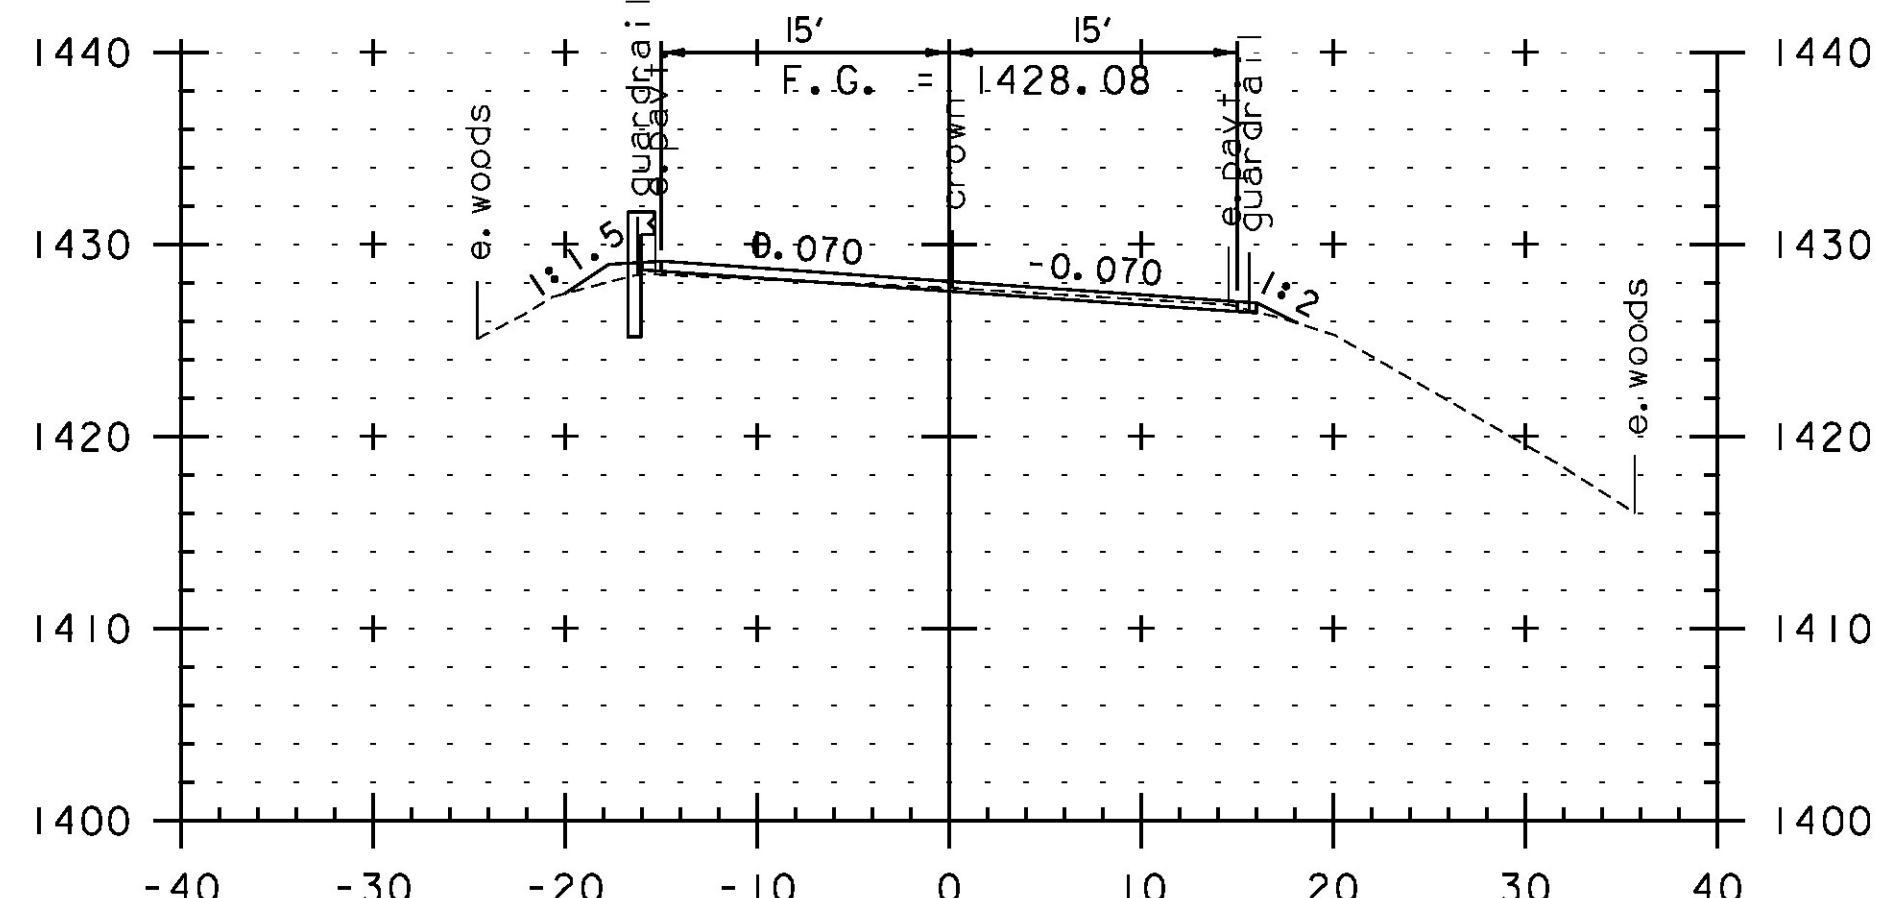

296+50

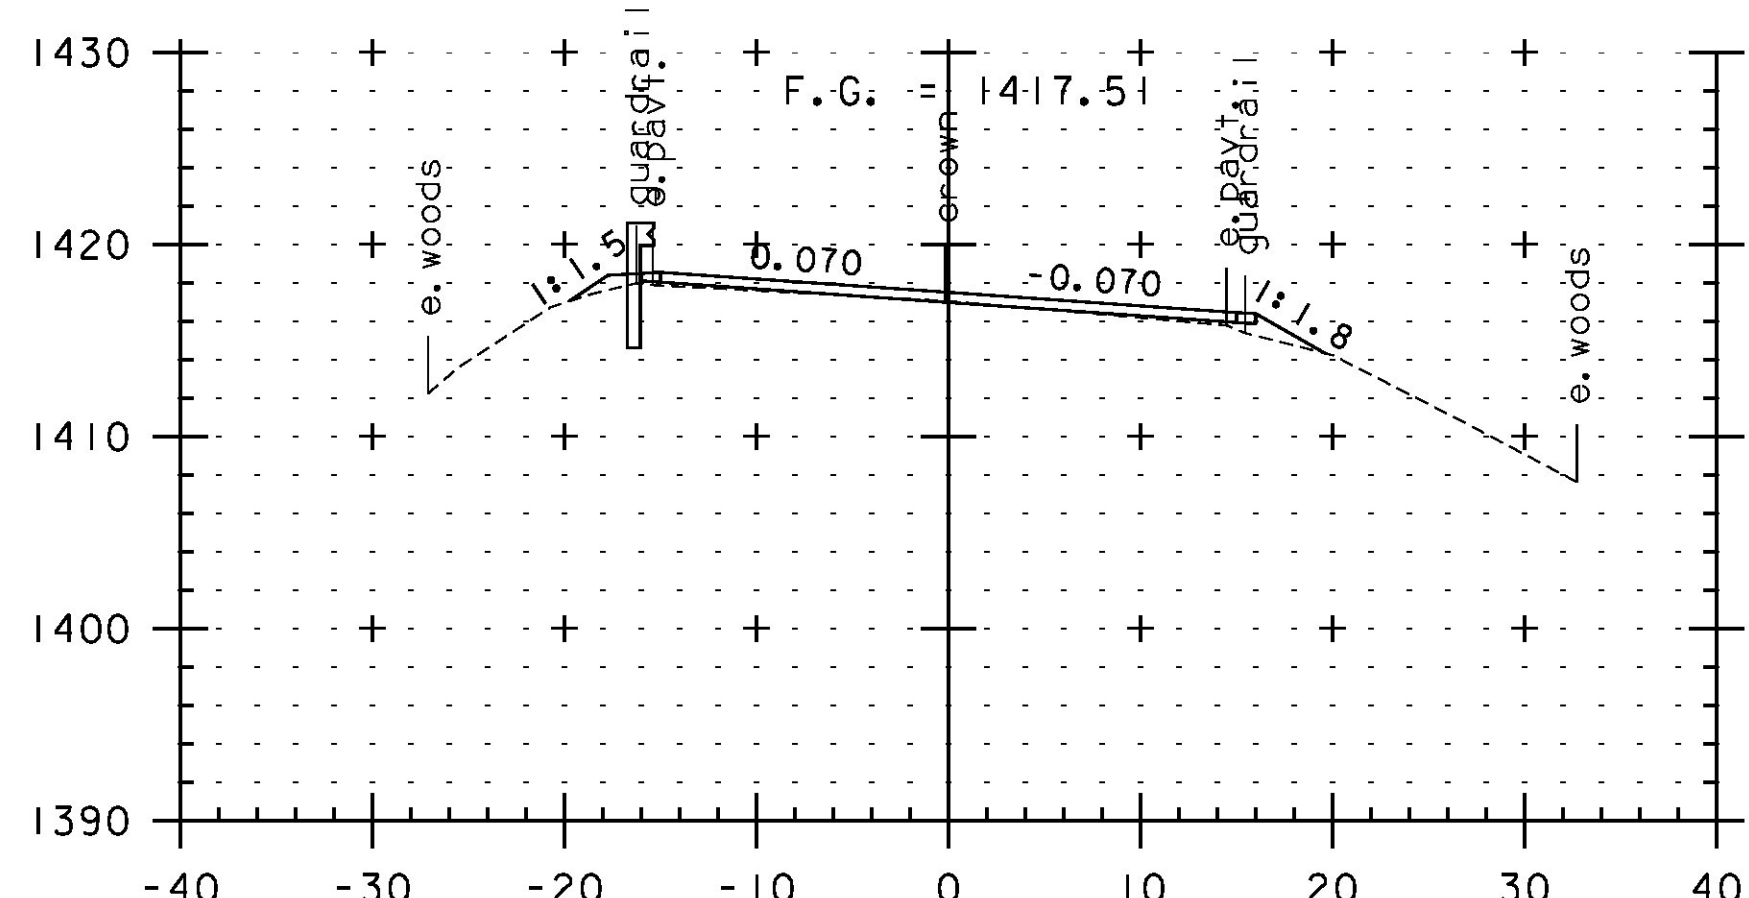

298+00

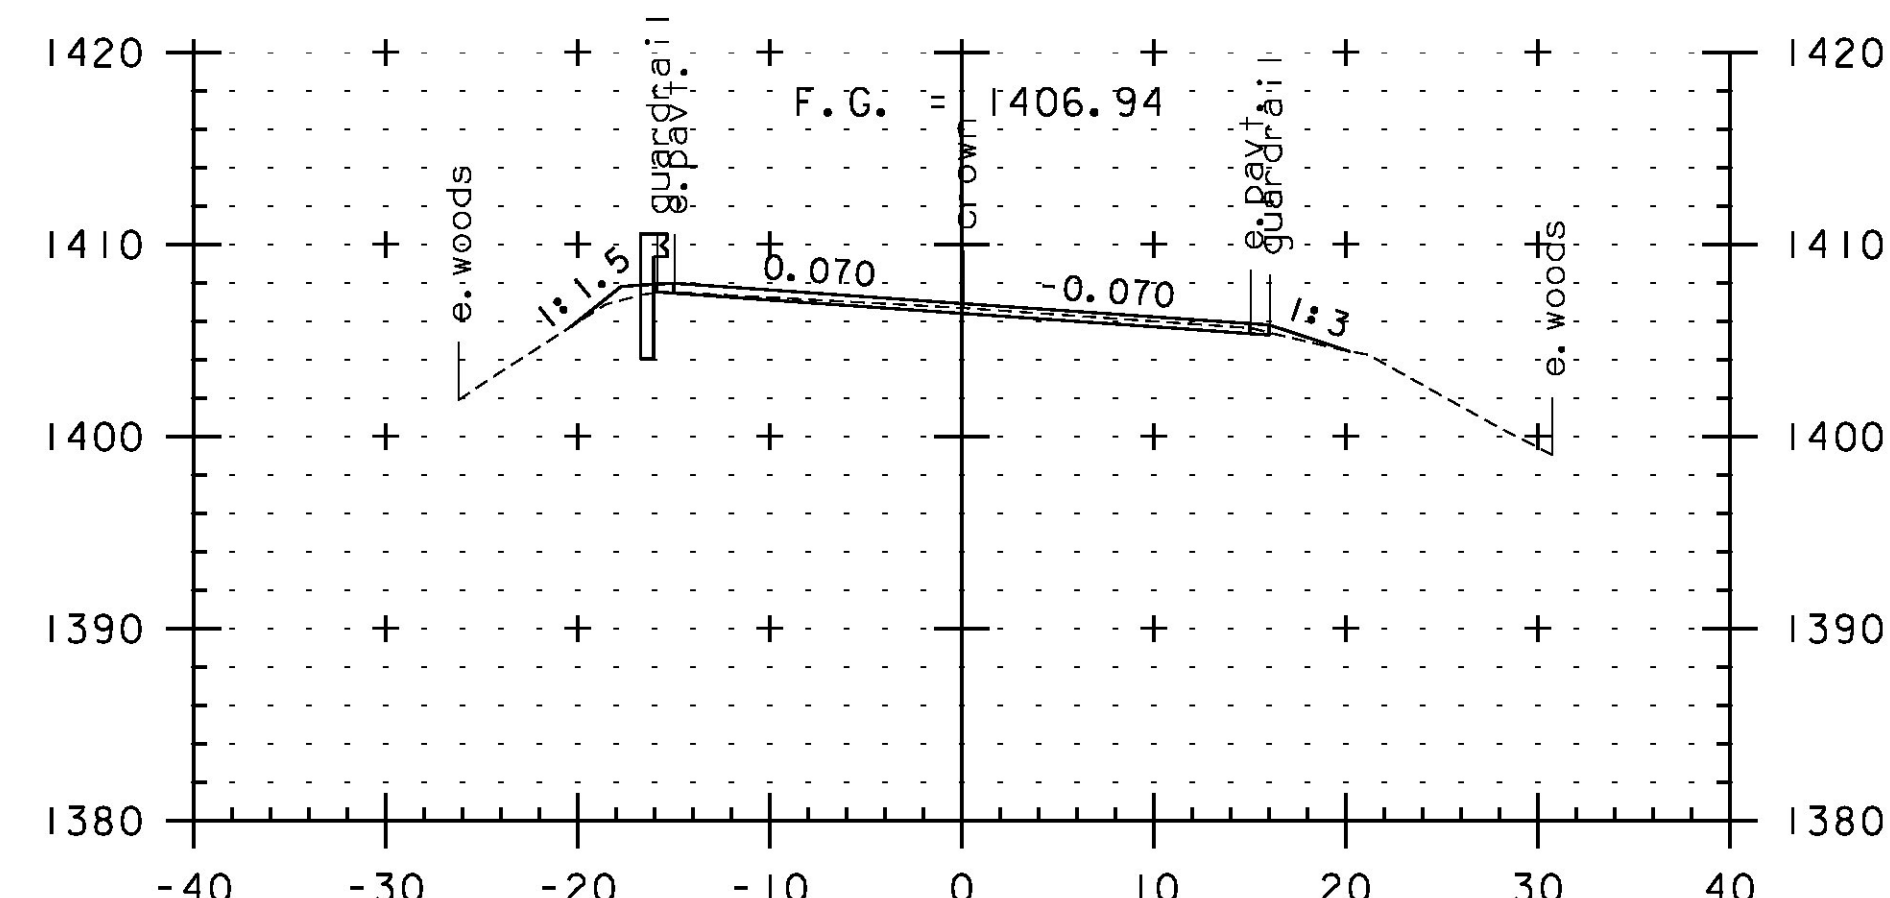

299+50



SCALE IN FEET

STA. 296+50 TO STA. 300+50

PROJECT NAME:	JAY-TROY	PLOT DATE:	5/16/2014
PROJECT NUMBER:	STP 2315(1)	DRAWN BY:	W. GORDON
FILE NAME:	z10b232xs.dgn	CHECKED BY:	P. SHEDD
PROJECT LEADER:	P. SHEDD	CROSS SECTION SHEET	67
DESIGNED BY:	N. LEMAY	SHEET	203 OF 244