




301+50

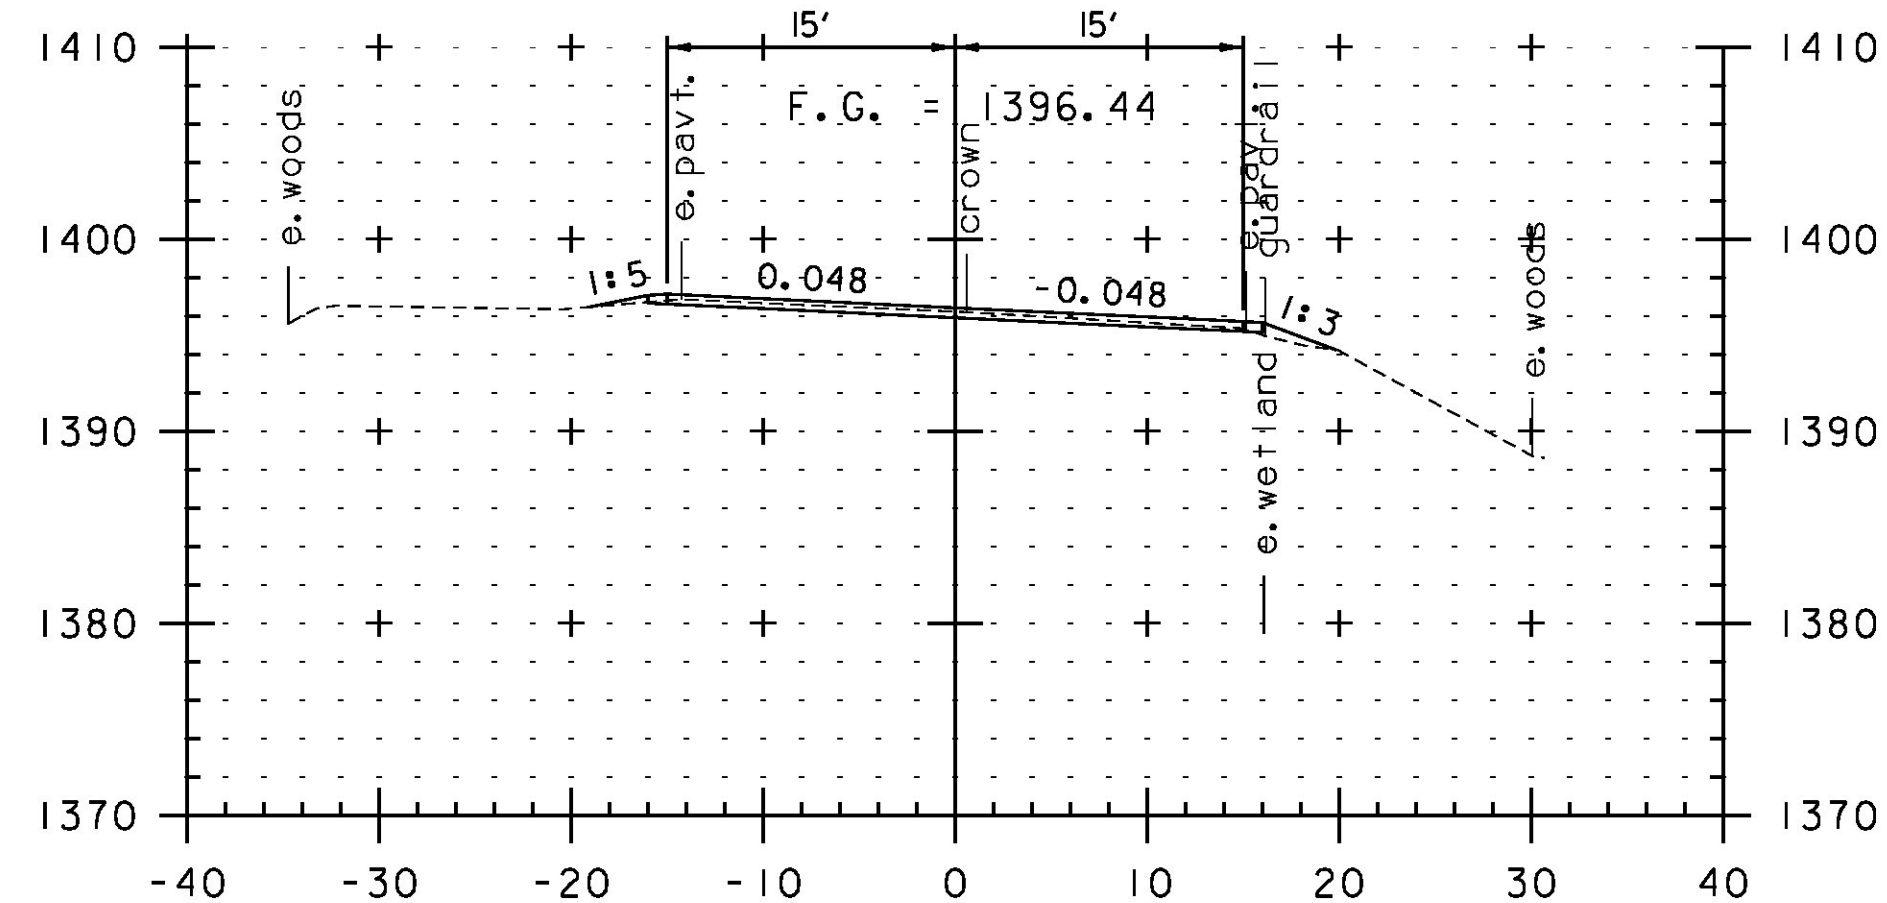


301+00

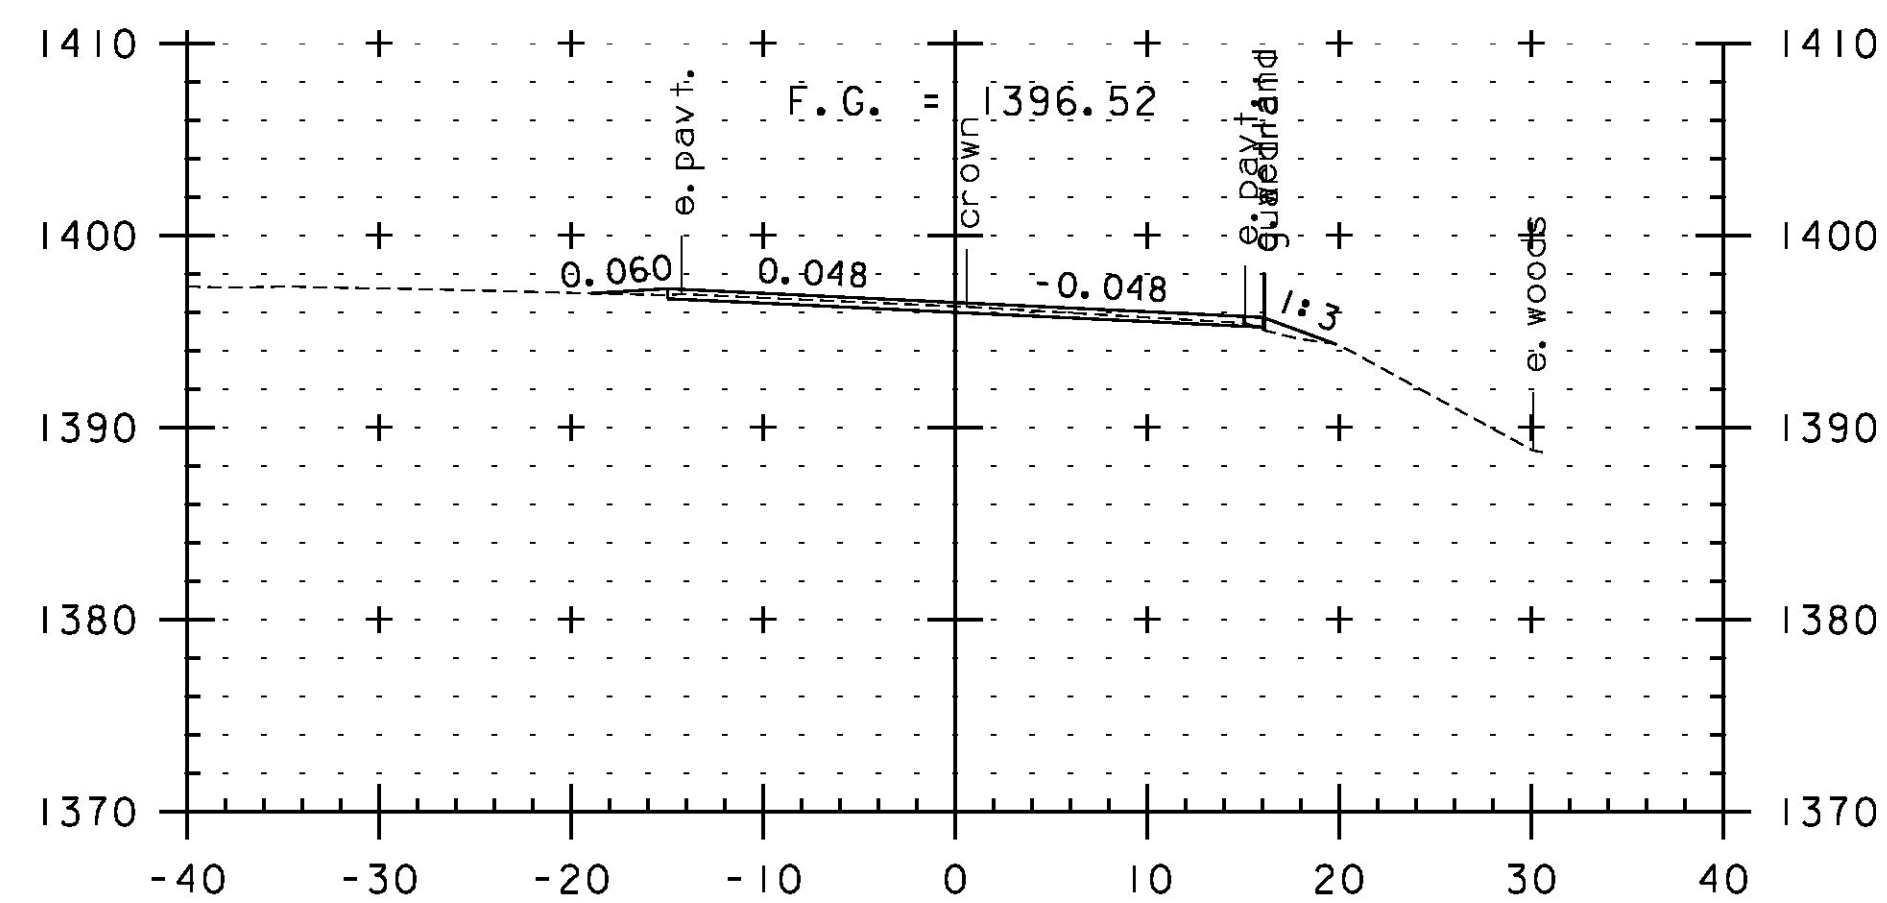


300+99
TH 28 LT

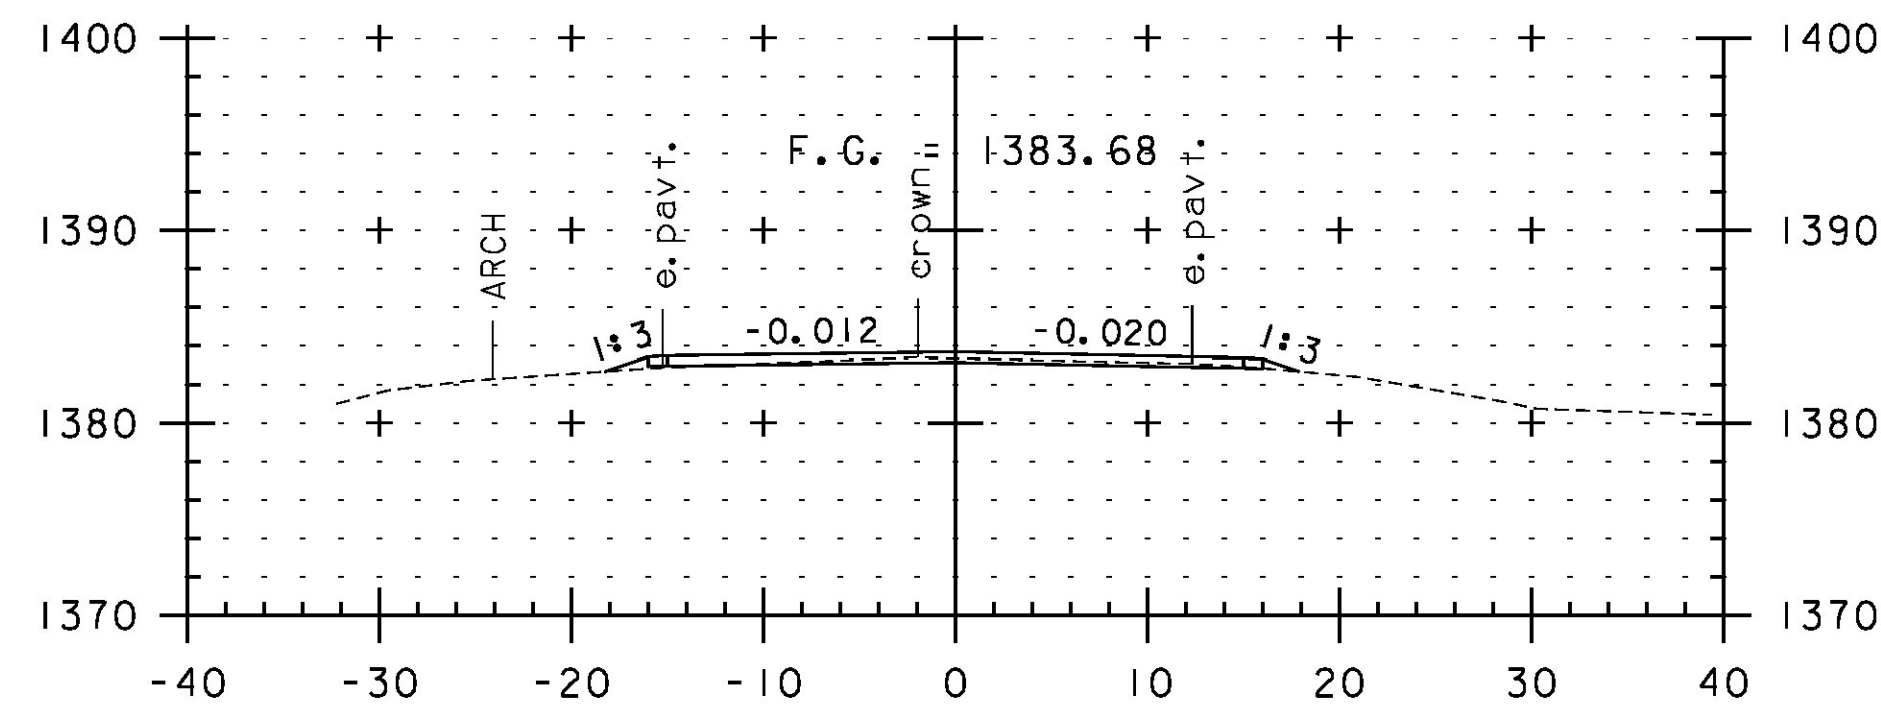


303+00

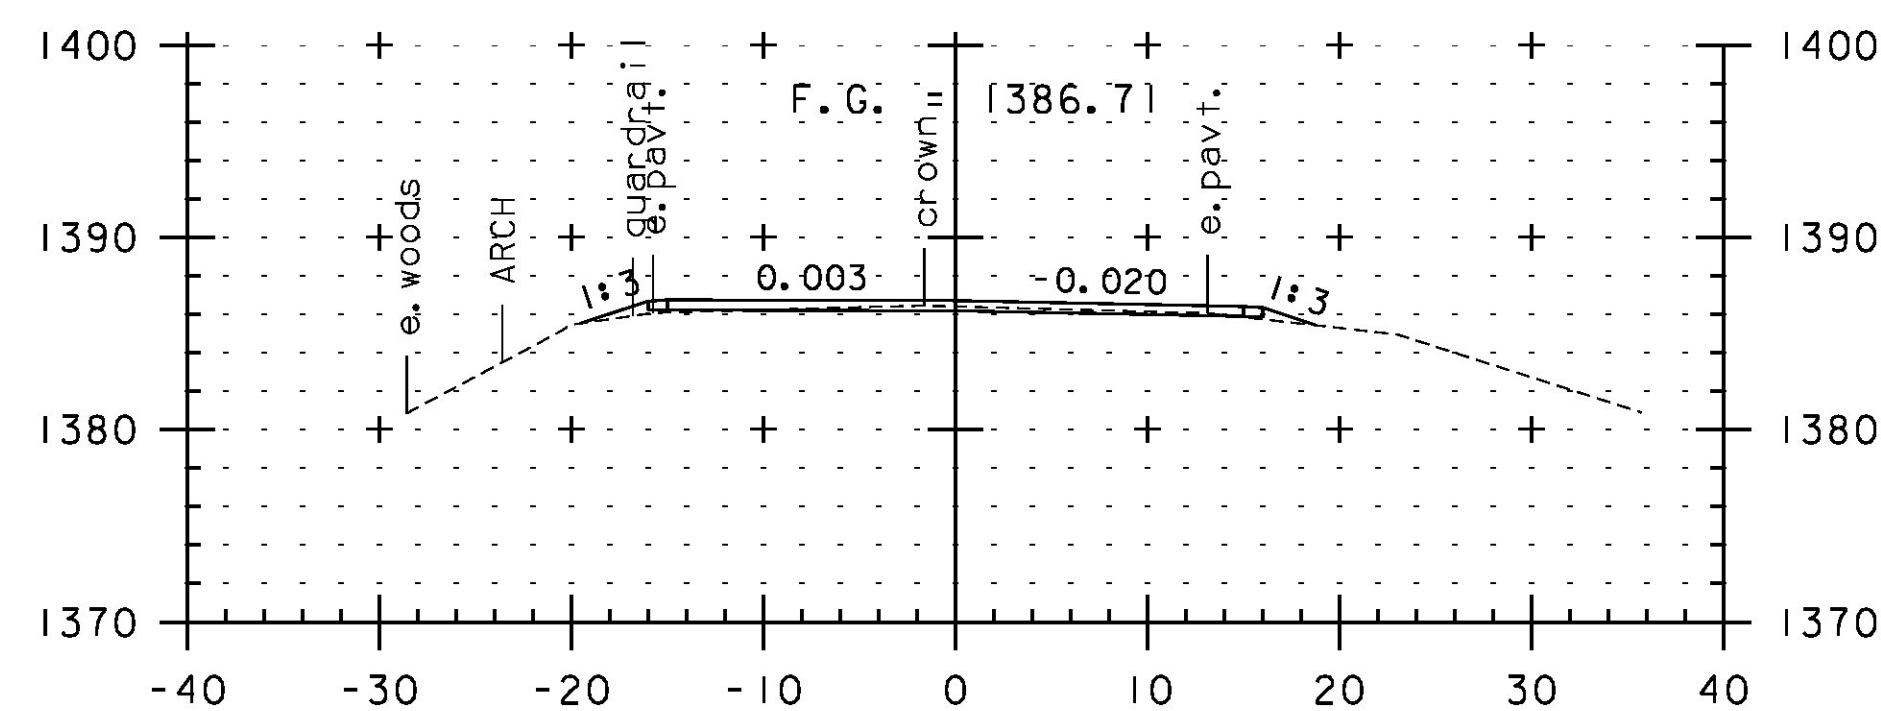


302+50

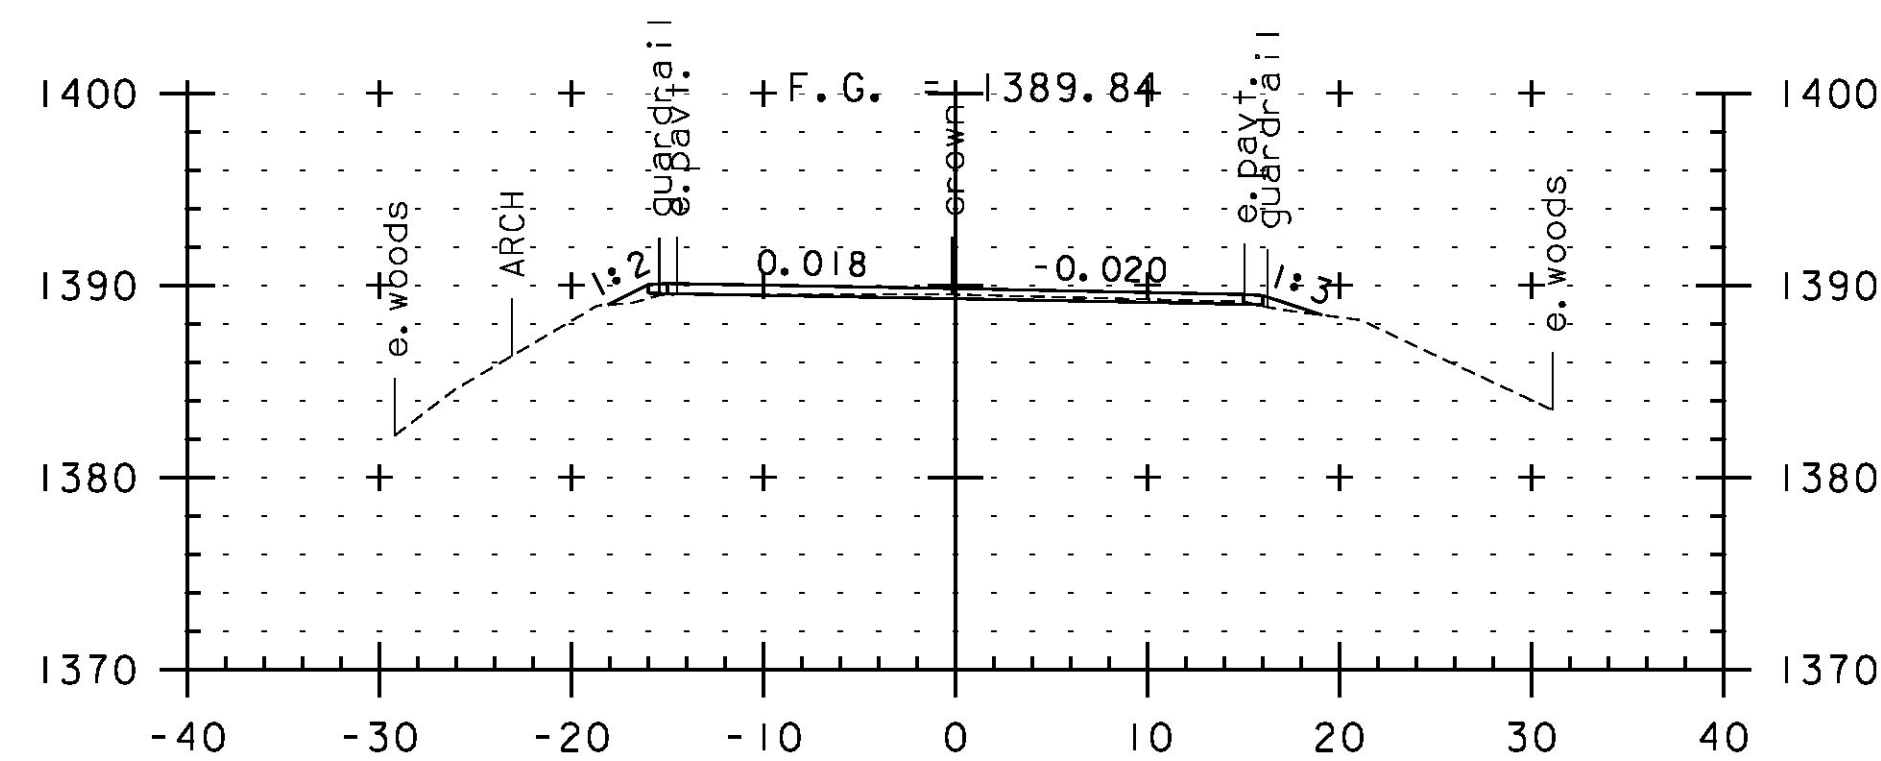


302+00

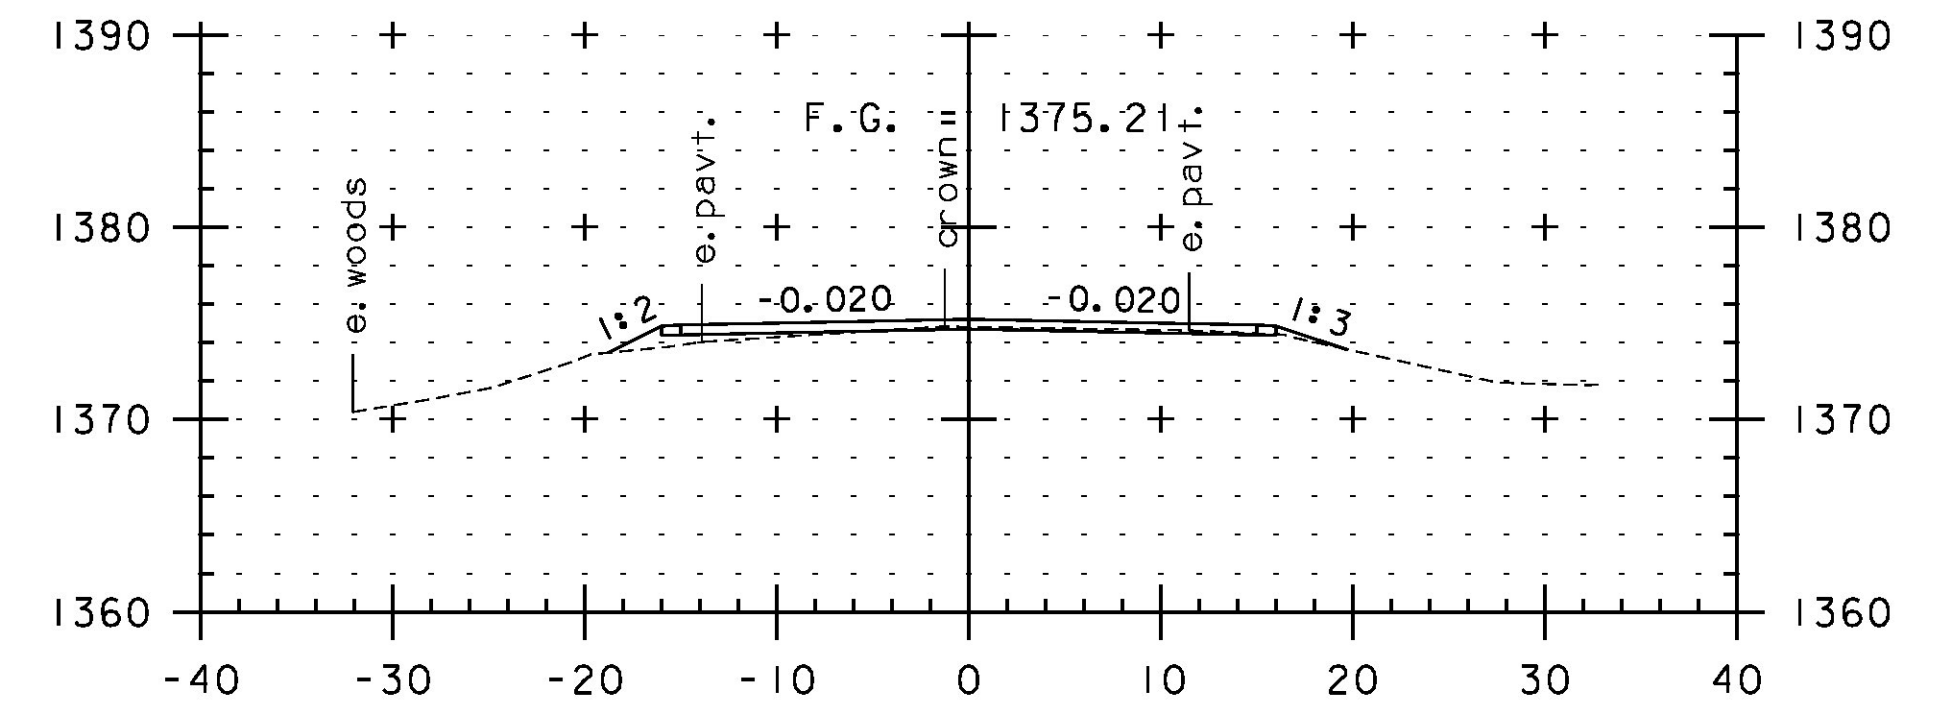


304+50

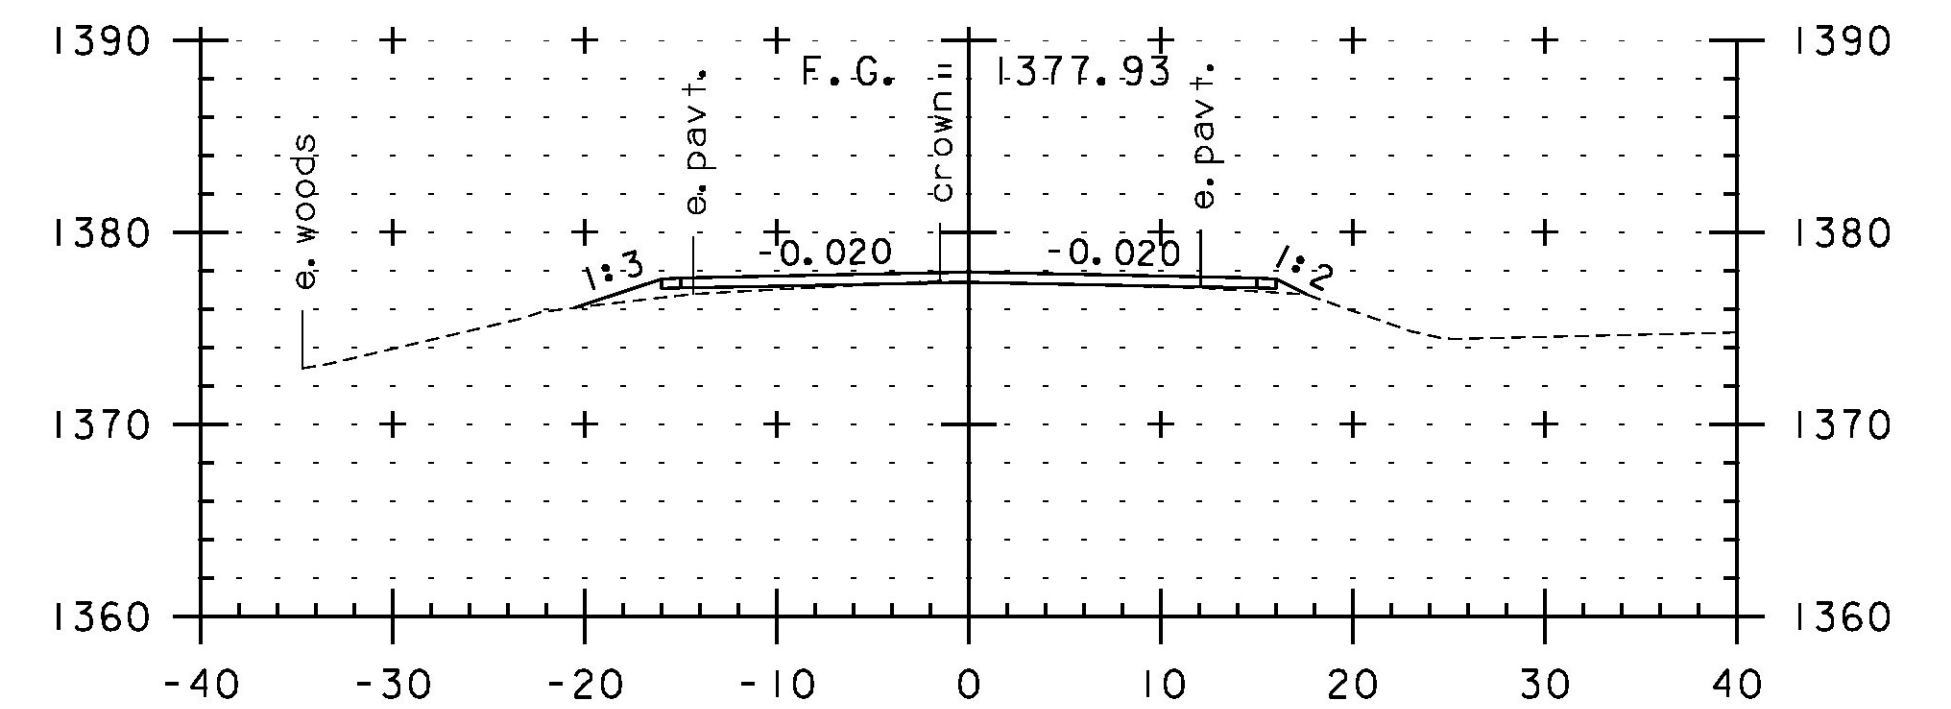

304+00

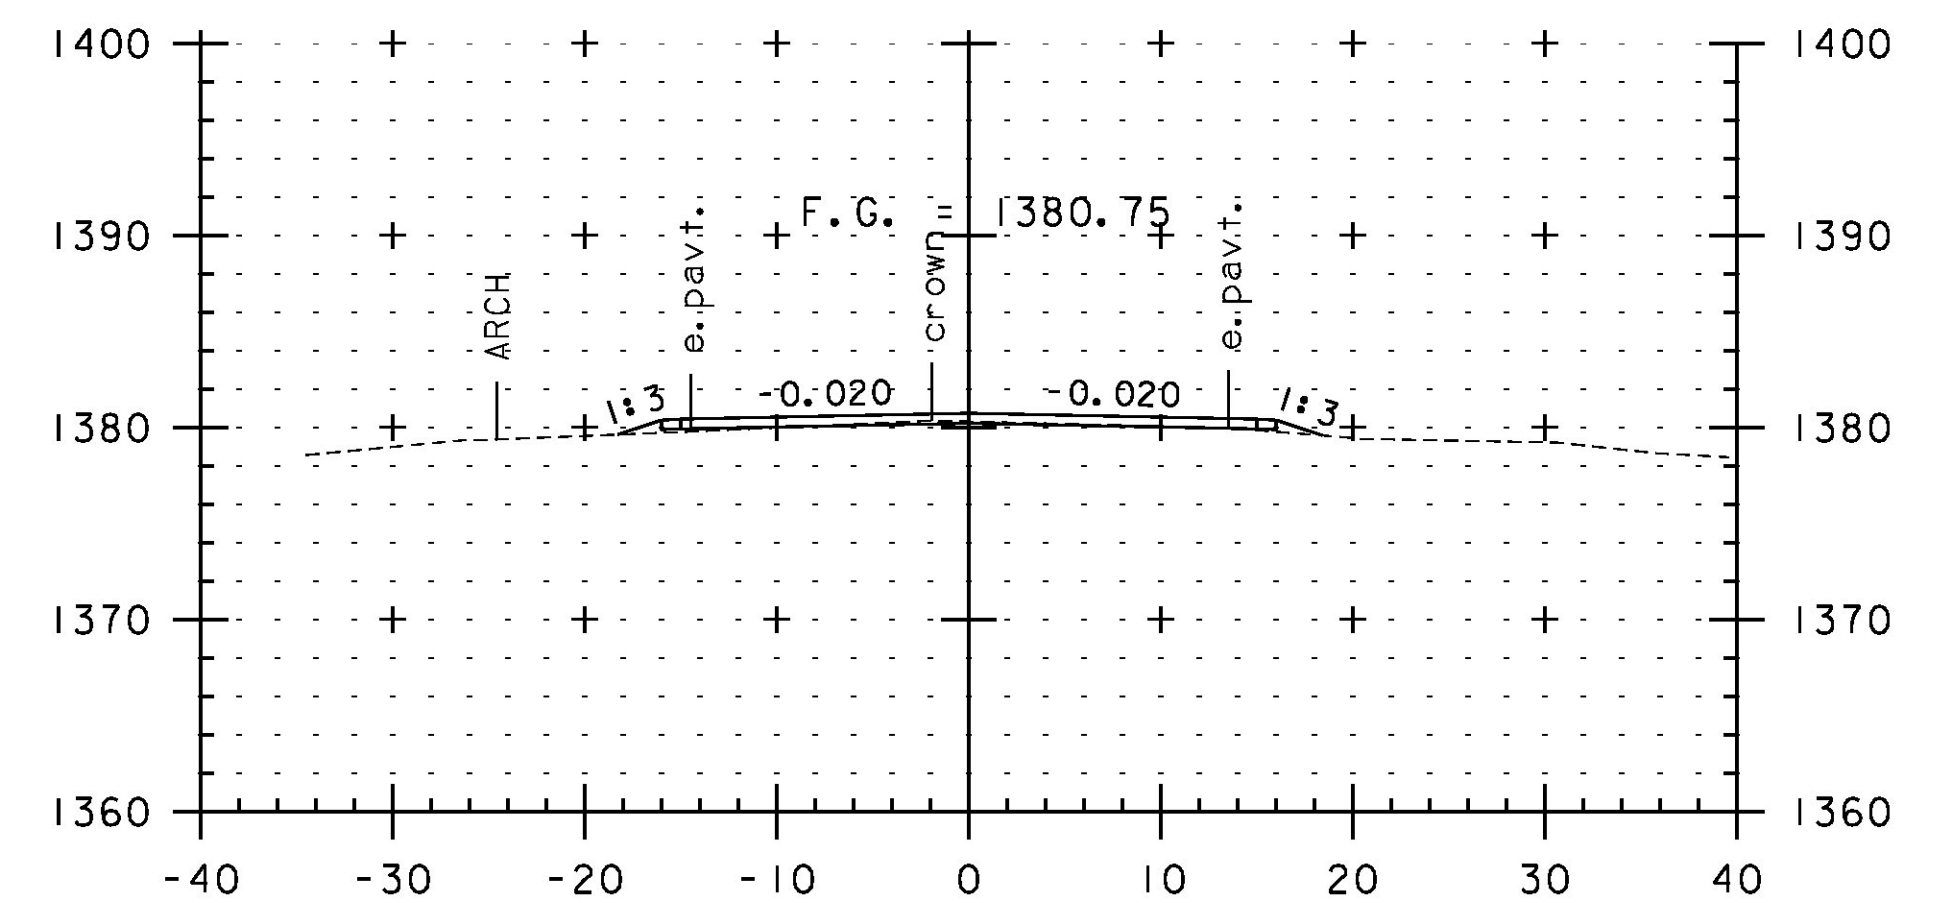

303+50

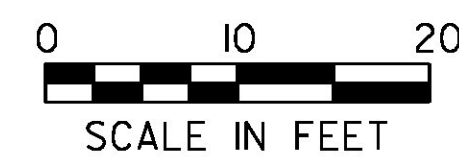

SCALE IN FEET

STA. 300+99 TO STA. 304+50

PROJECT NAME:	JAY-TROY	PLOT DATE:	5/16/2014
PROJECT NUMBER:	STP 2315(1)	DRAWN BY:	W. GORDON
FILE NAME:	z10b232xs.dgn	CHECKED BY:	P. SHEDD
PROJECT LEADER:	P. SHEDD	CROSS SECTION SHEET	68
DESIGNED BY:	N. LEMAY	SHEET	204 OF 244