




310+50

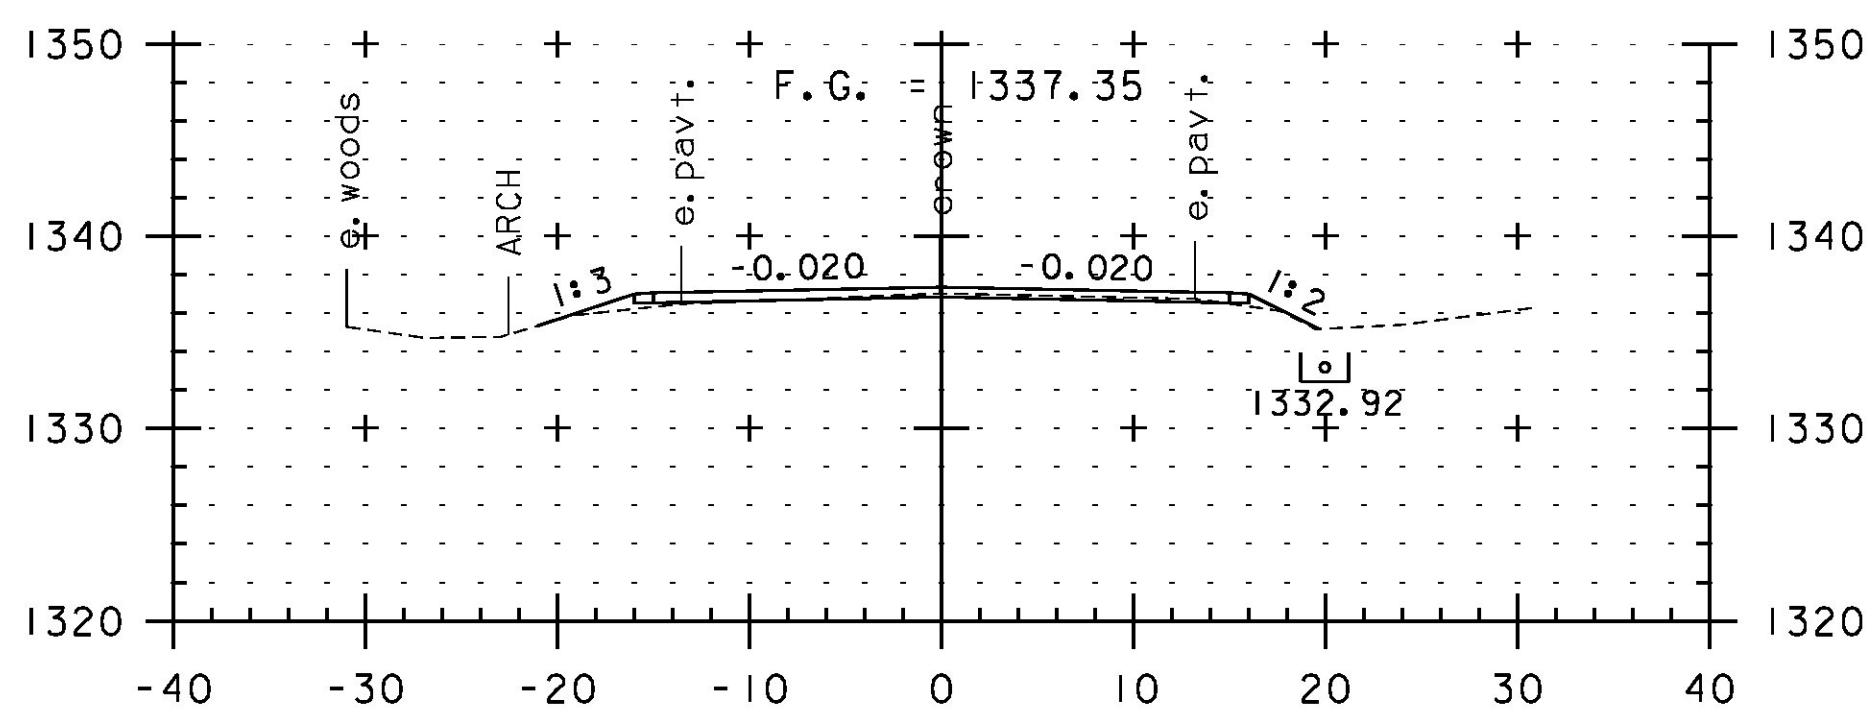


312+00

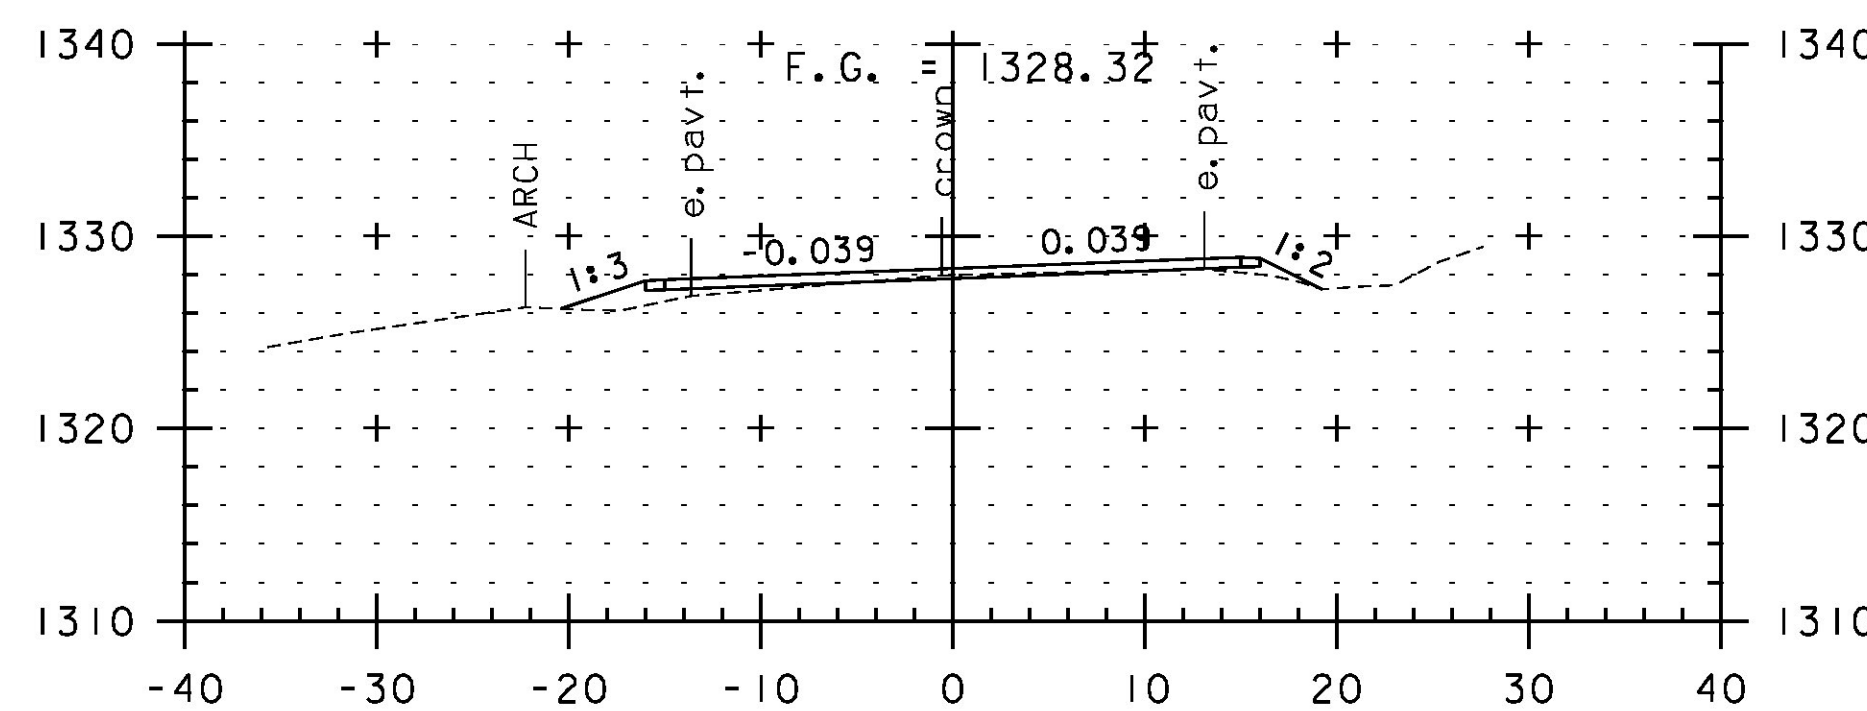


313+50

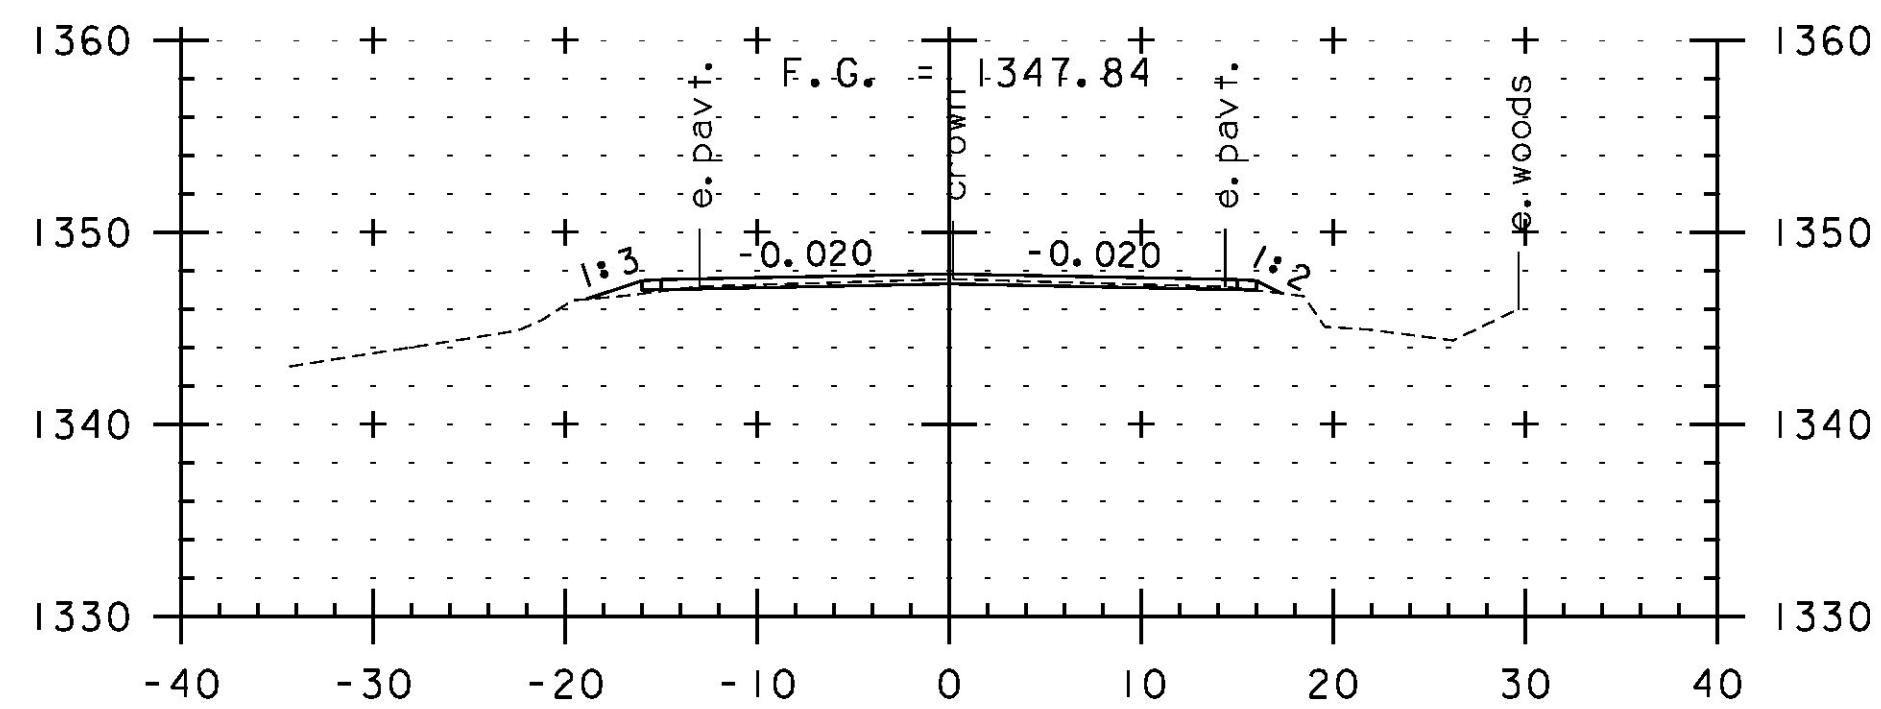


310+00

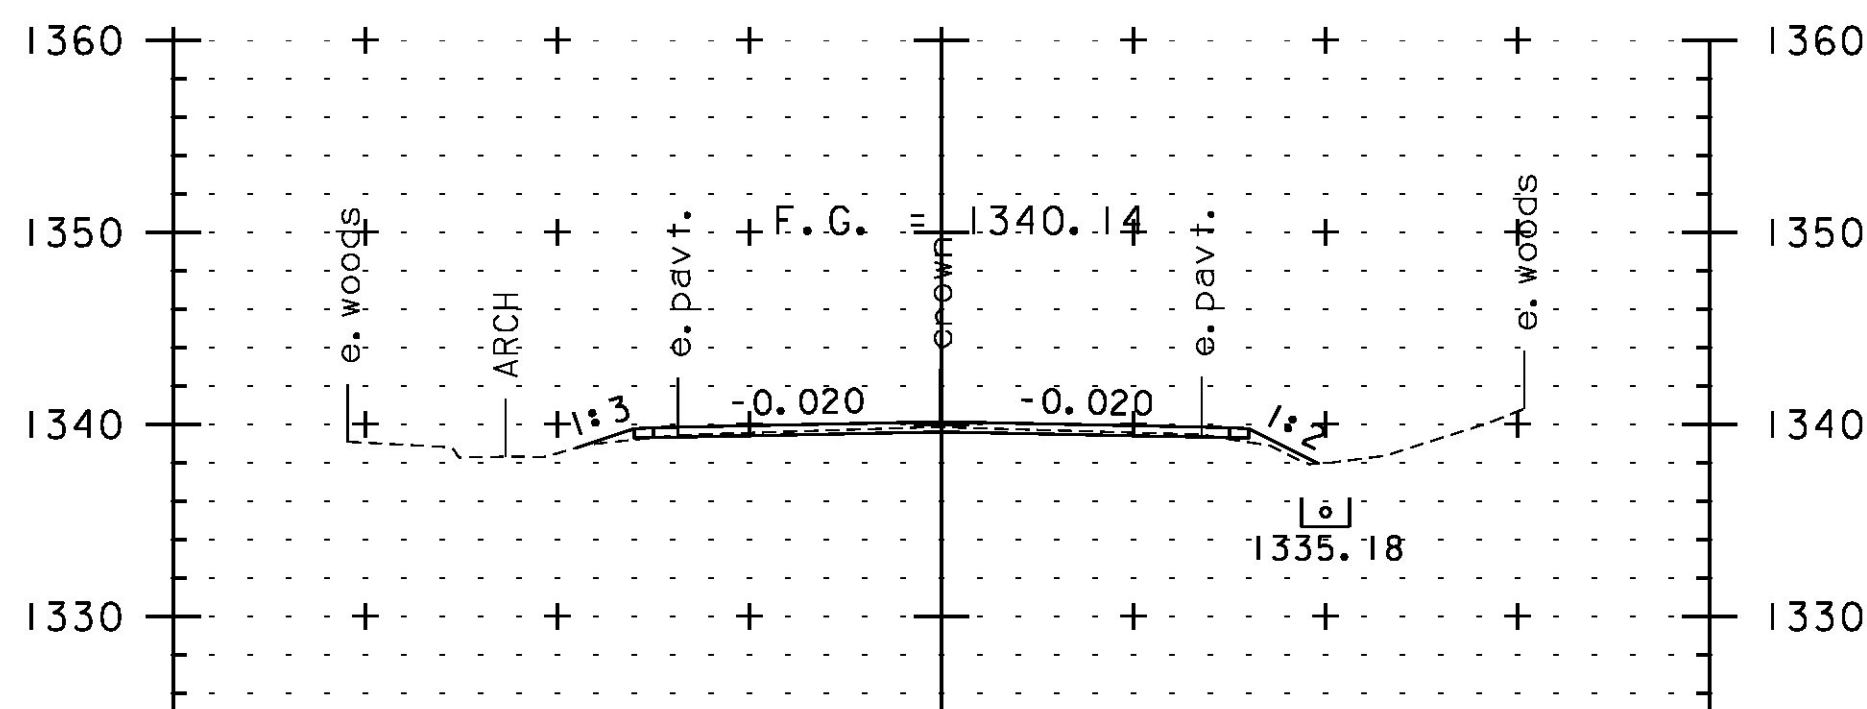


311+50

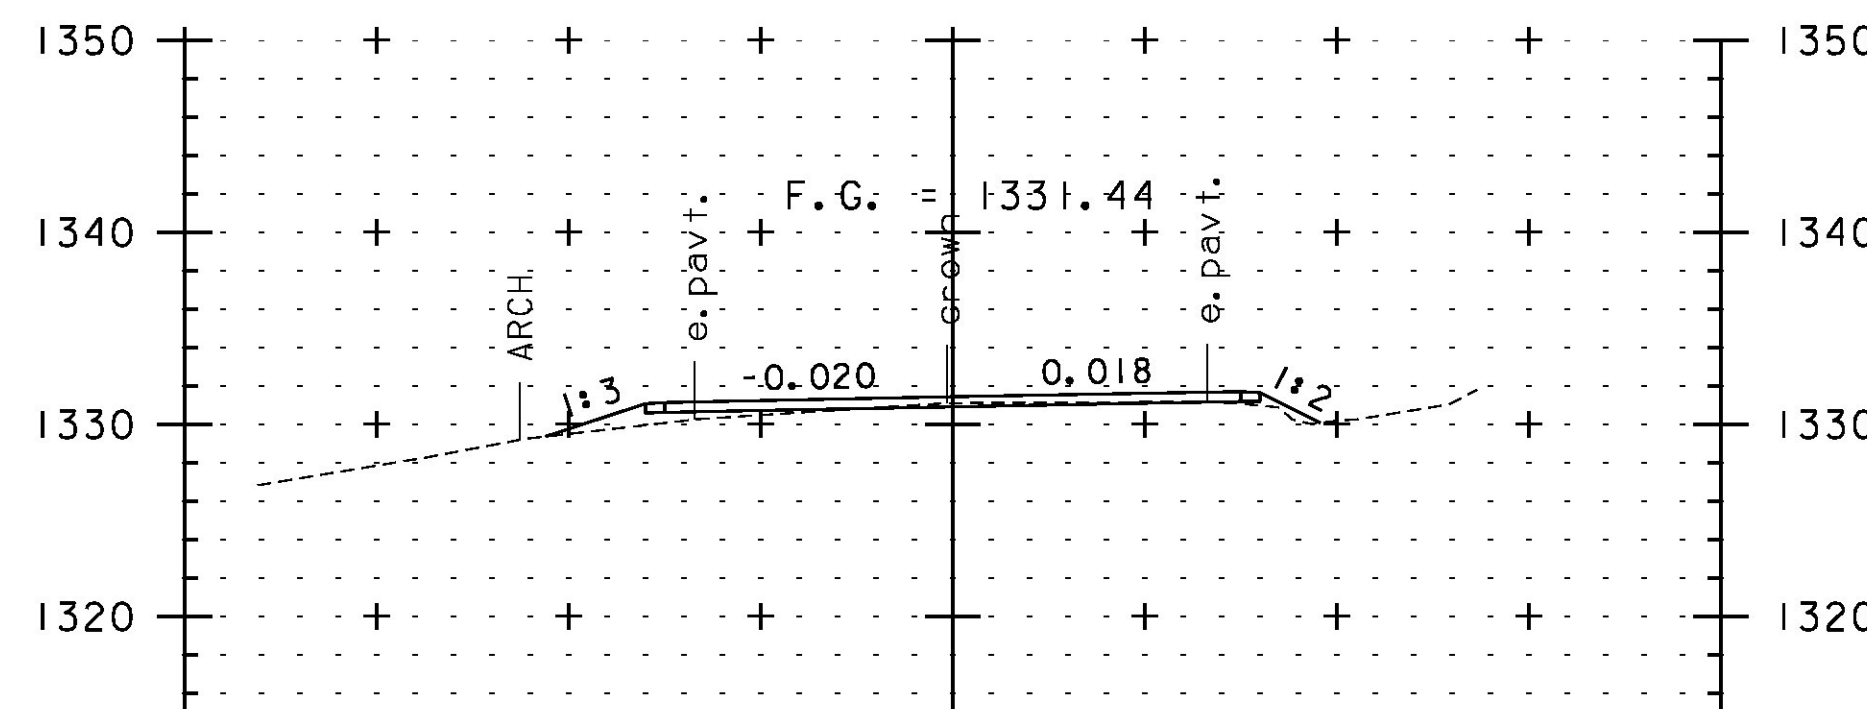


313+00

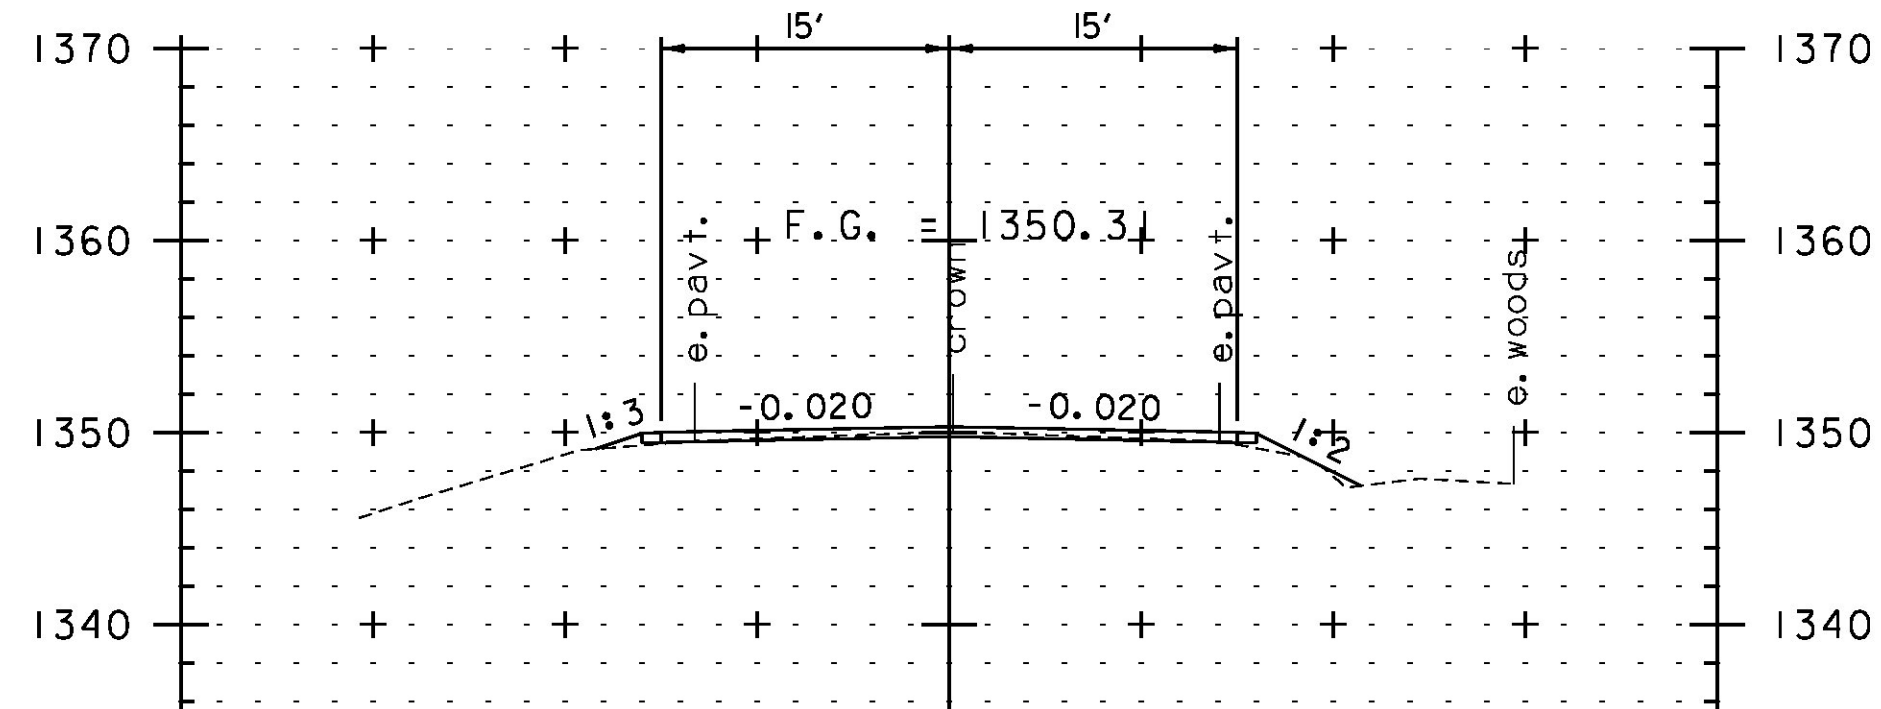

309+50

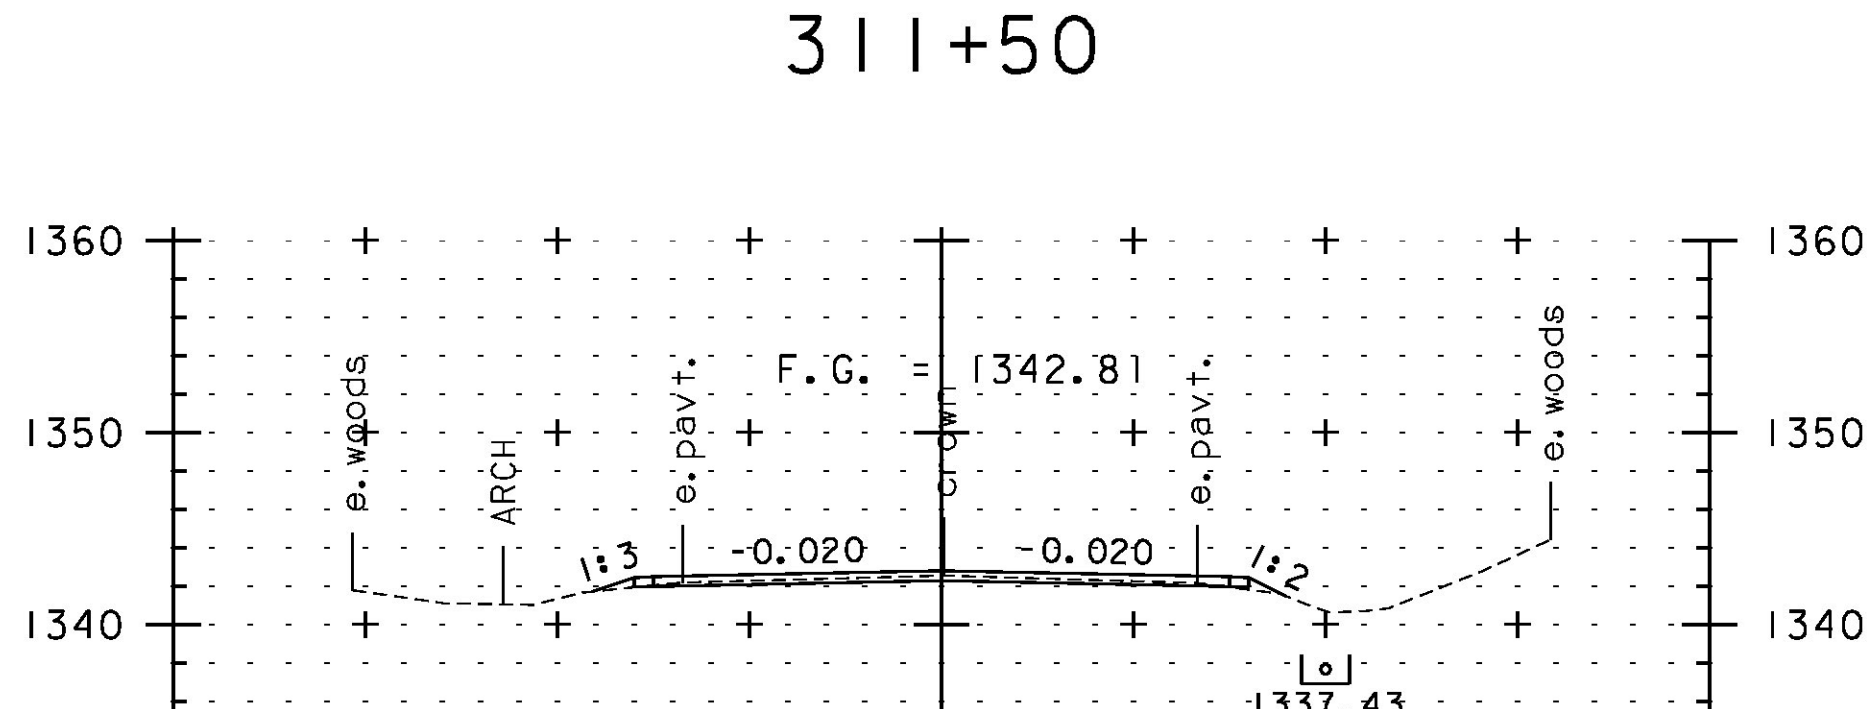

311+00

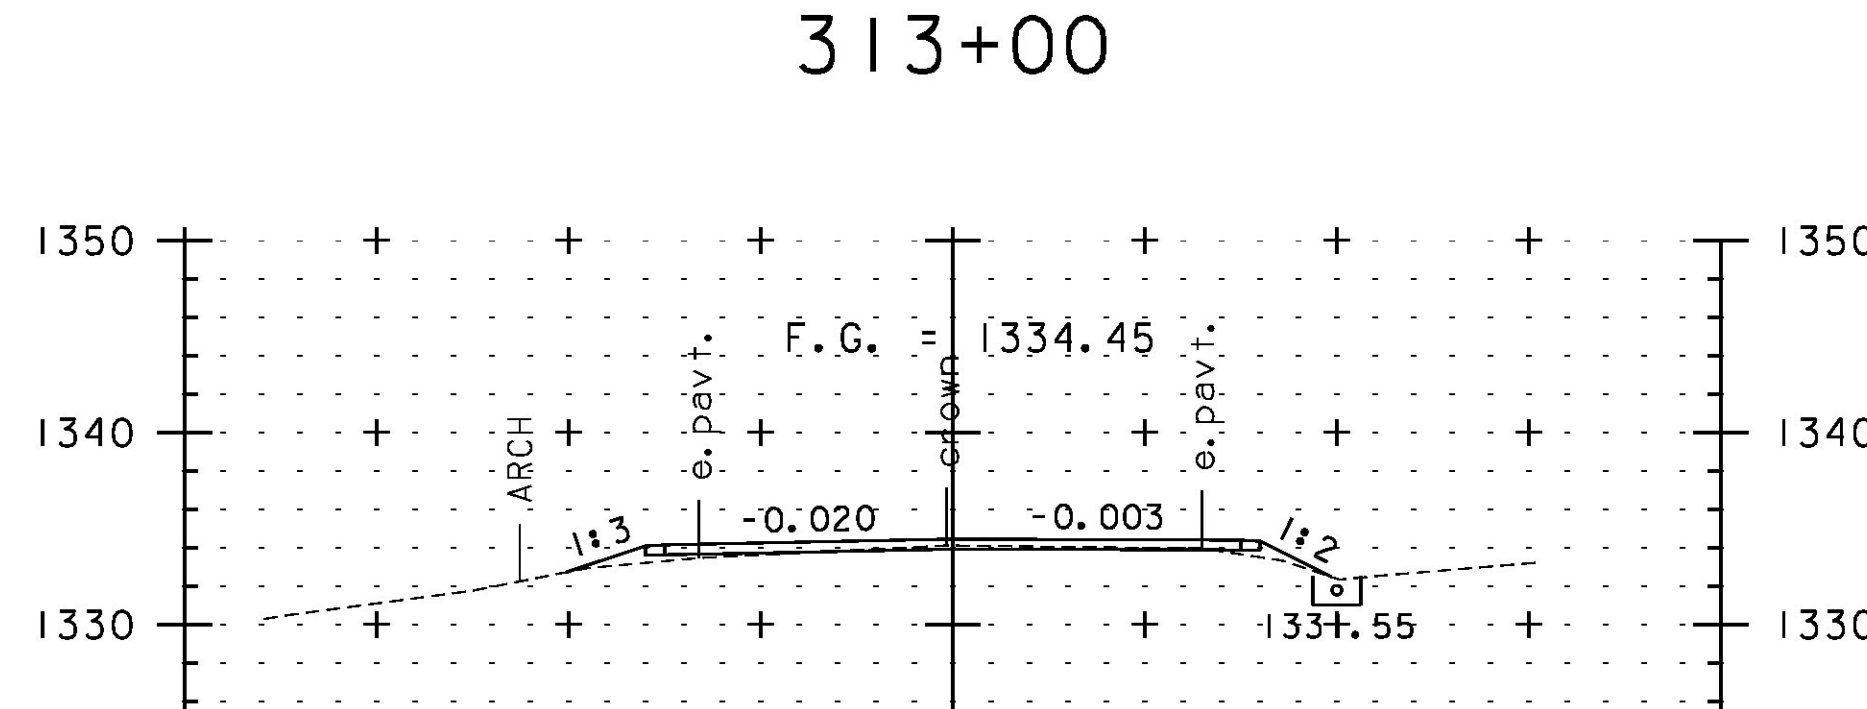

312+50



SCALE IN FEET

STA. 309+50 TO STA. 313+50

PROJECT NAME: JAY-TROY
PROJECT NUMBER: STP 2315(I)

FILE NAME: z10b232xs.dgn
PROJECT LEADER: P. SHEDD
DESIGNED BY: N. LEMAY
CROSS SECTION SHEET 70

PLOT DATE: 5/16/2014
DRAWN BY: W. GORDON
CHECKED BY: P. SHEDD
SHEET 206 OF 244