




315+00

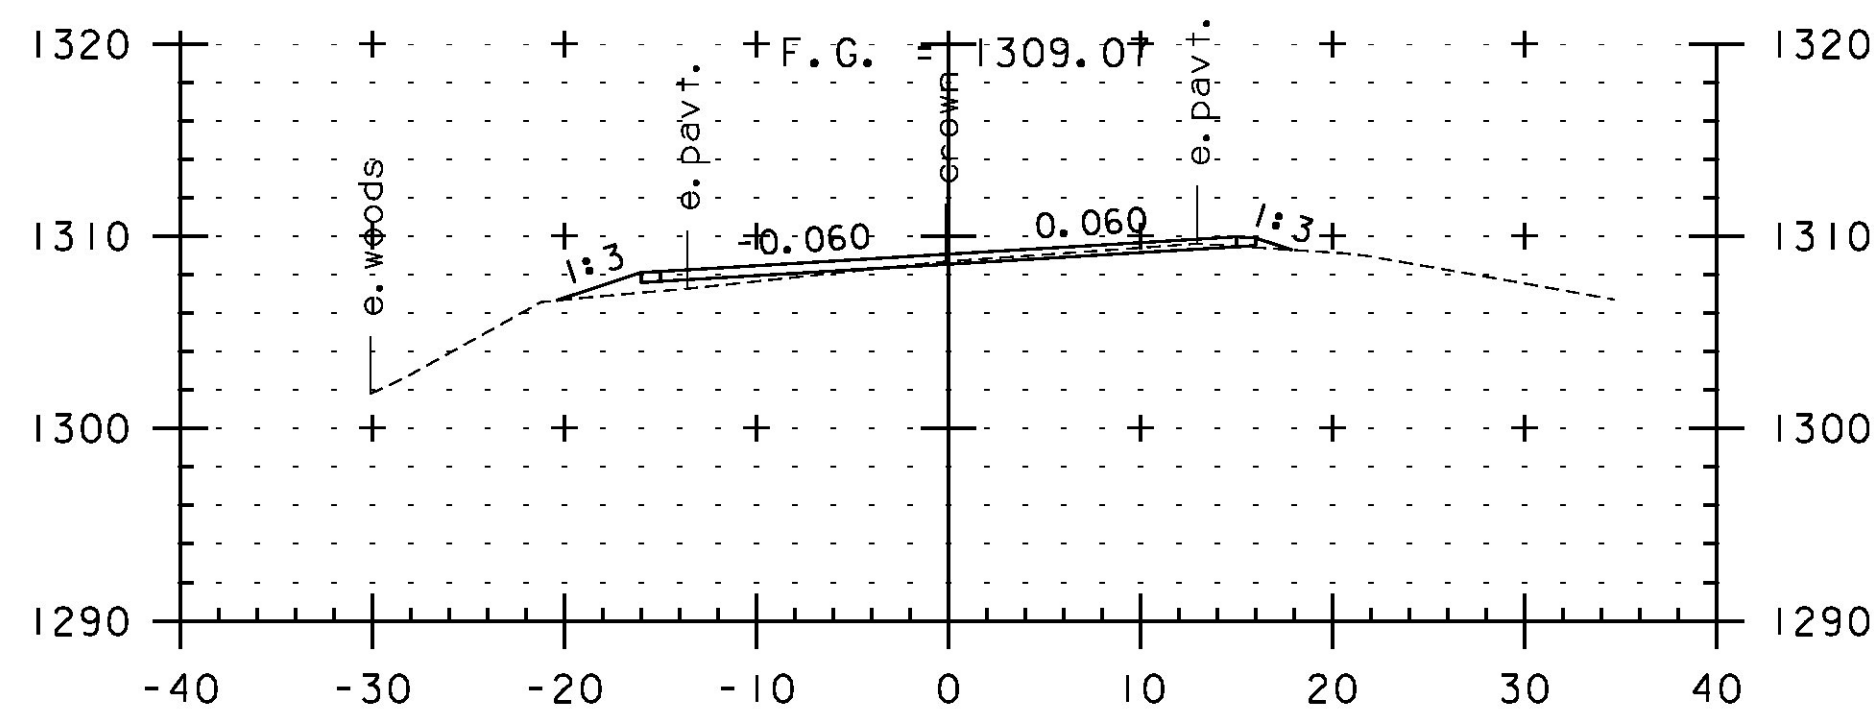


316+50

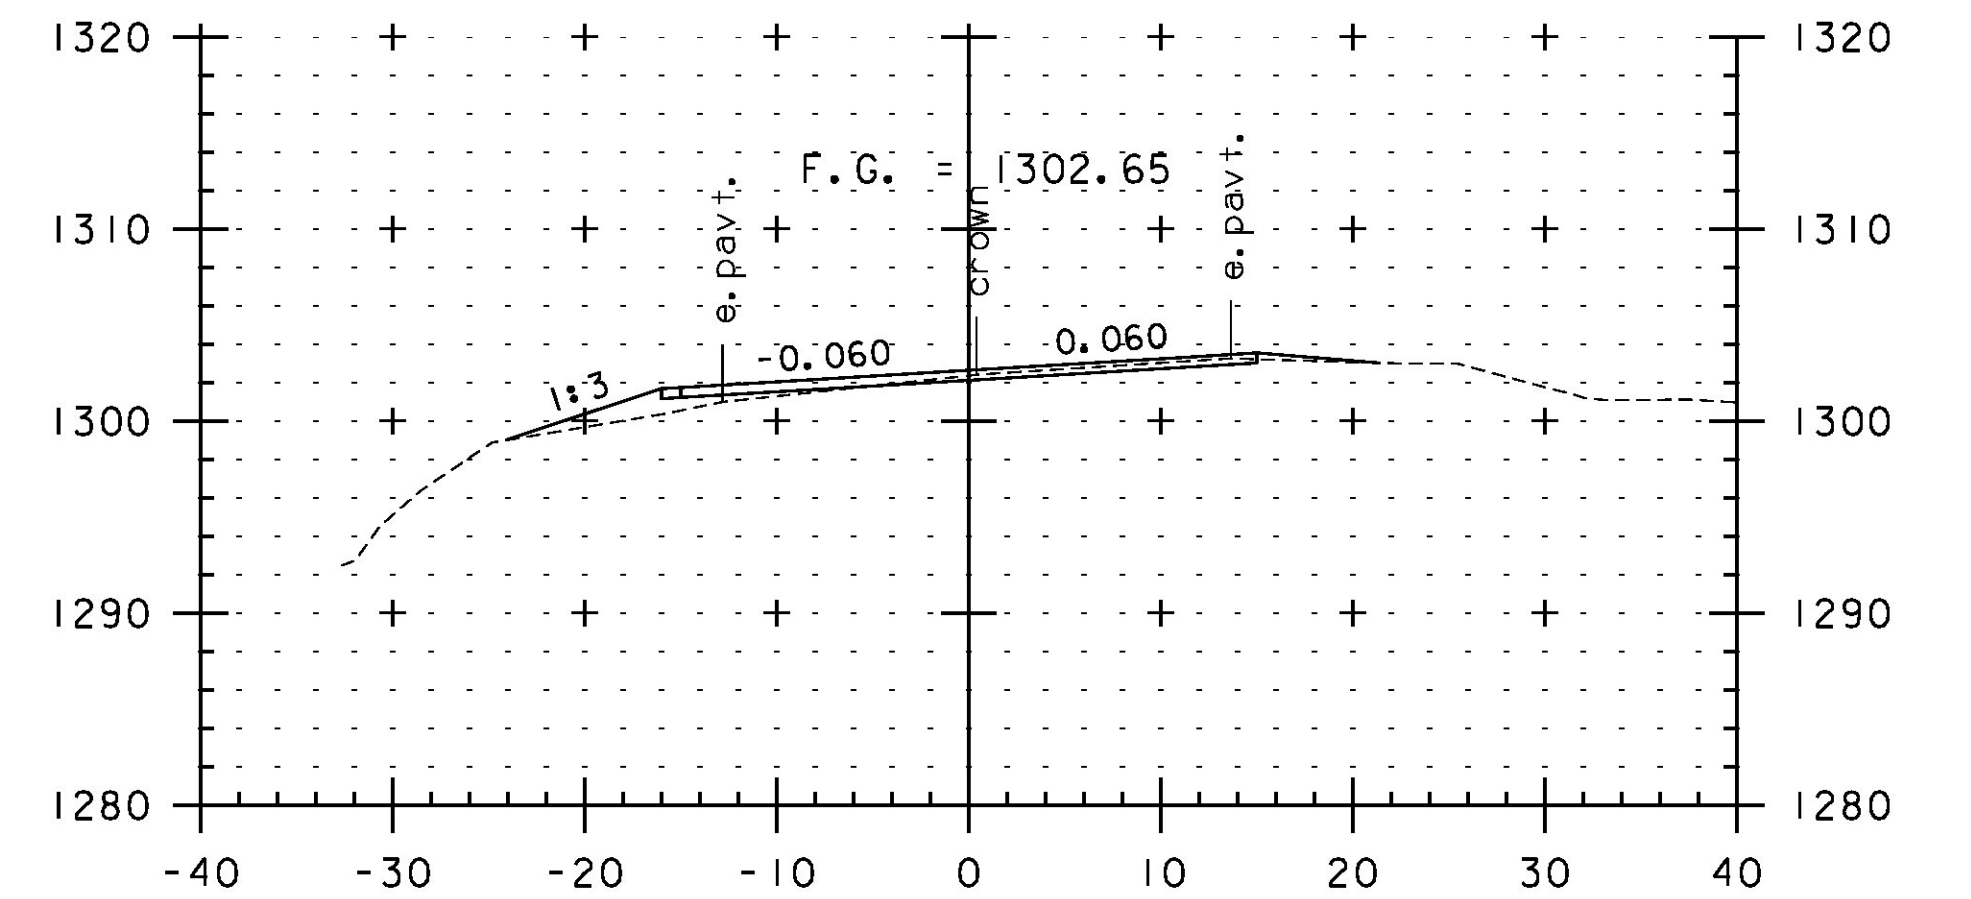


317+50

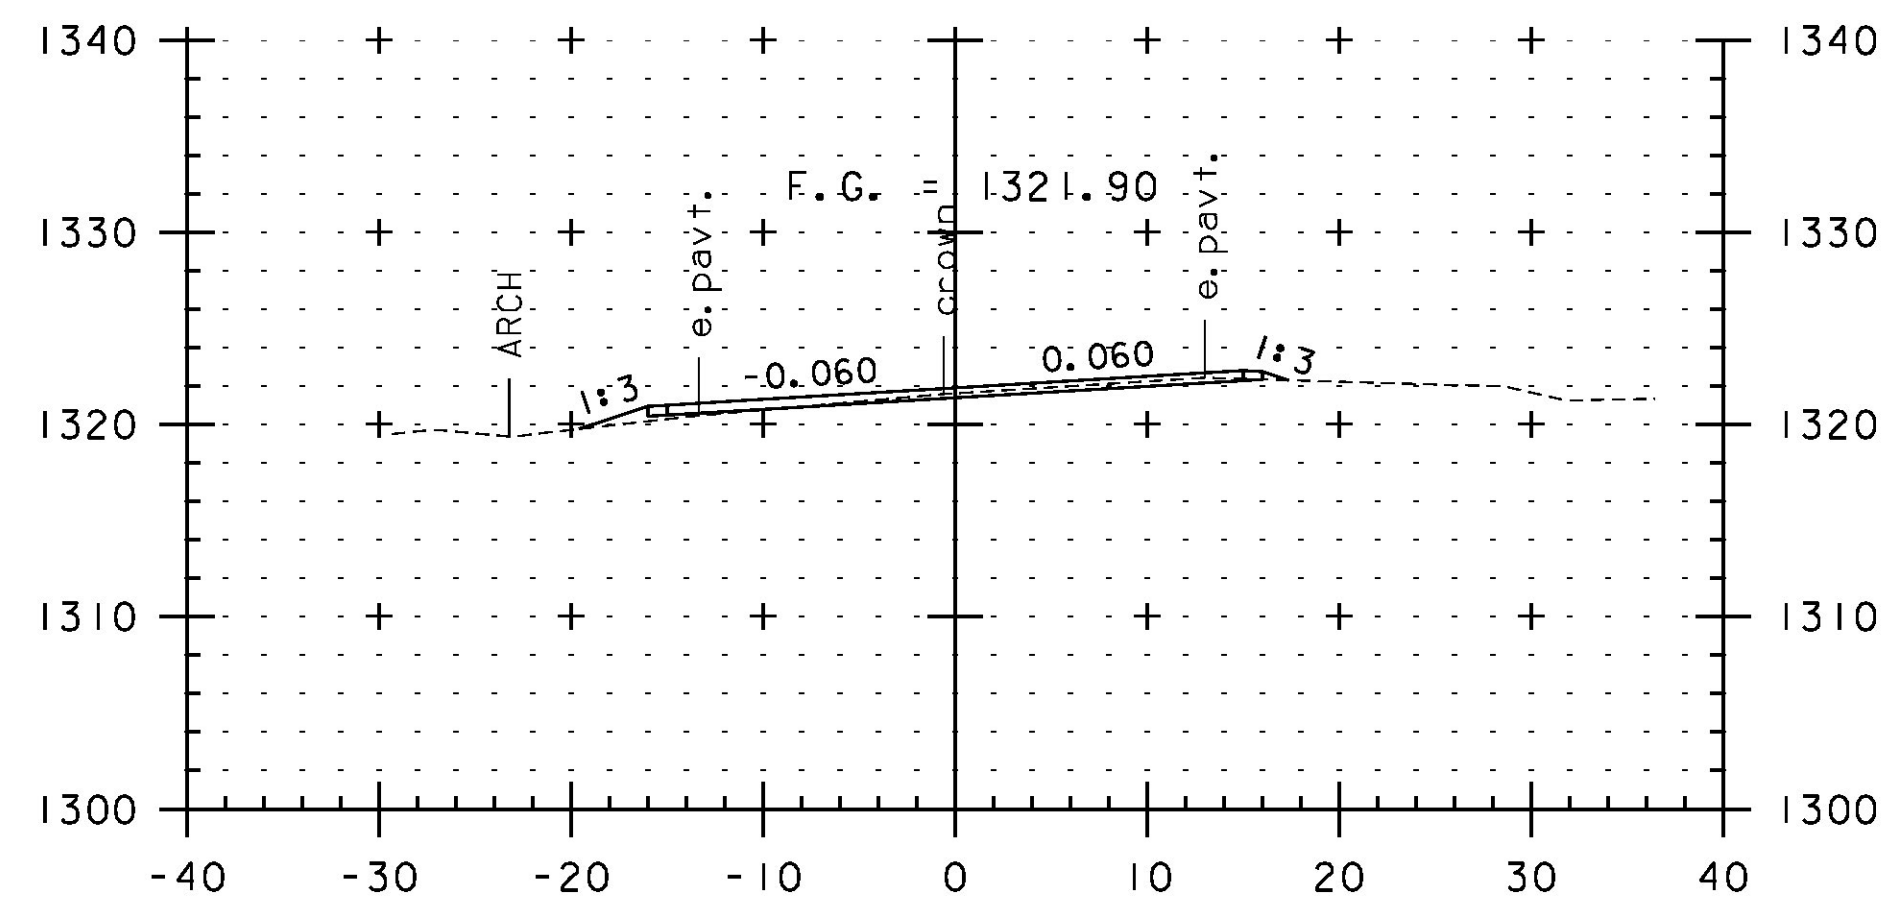


314+50

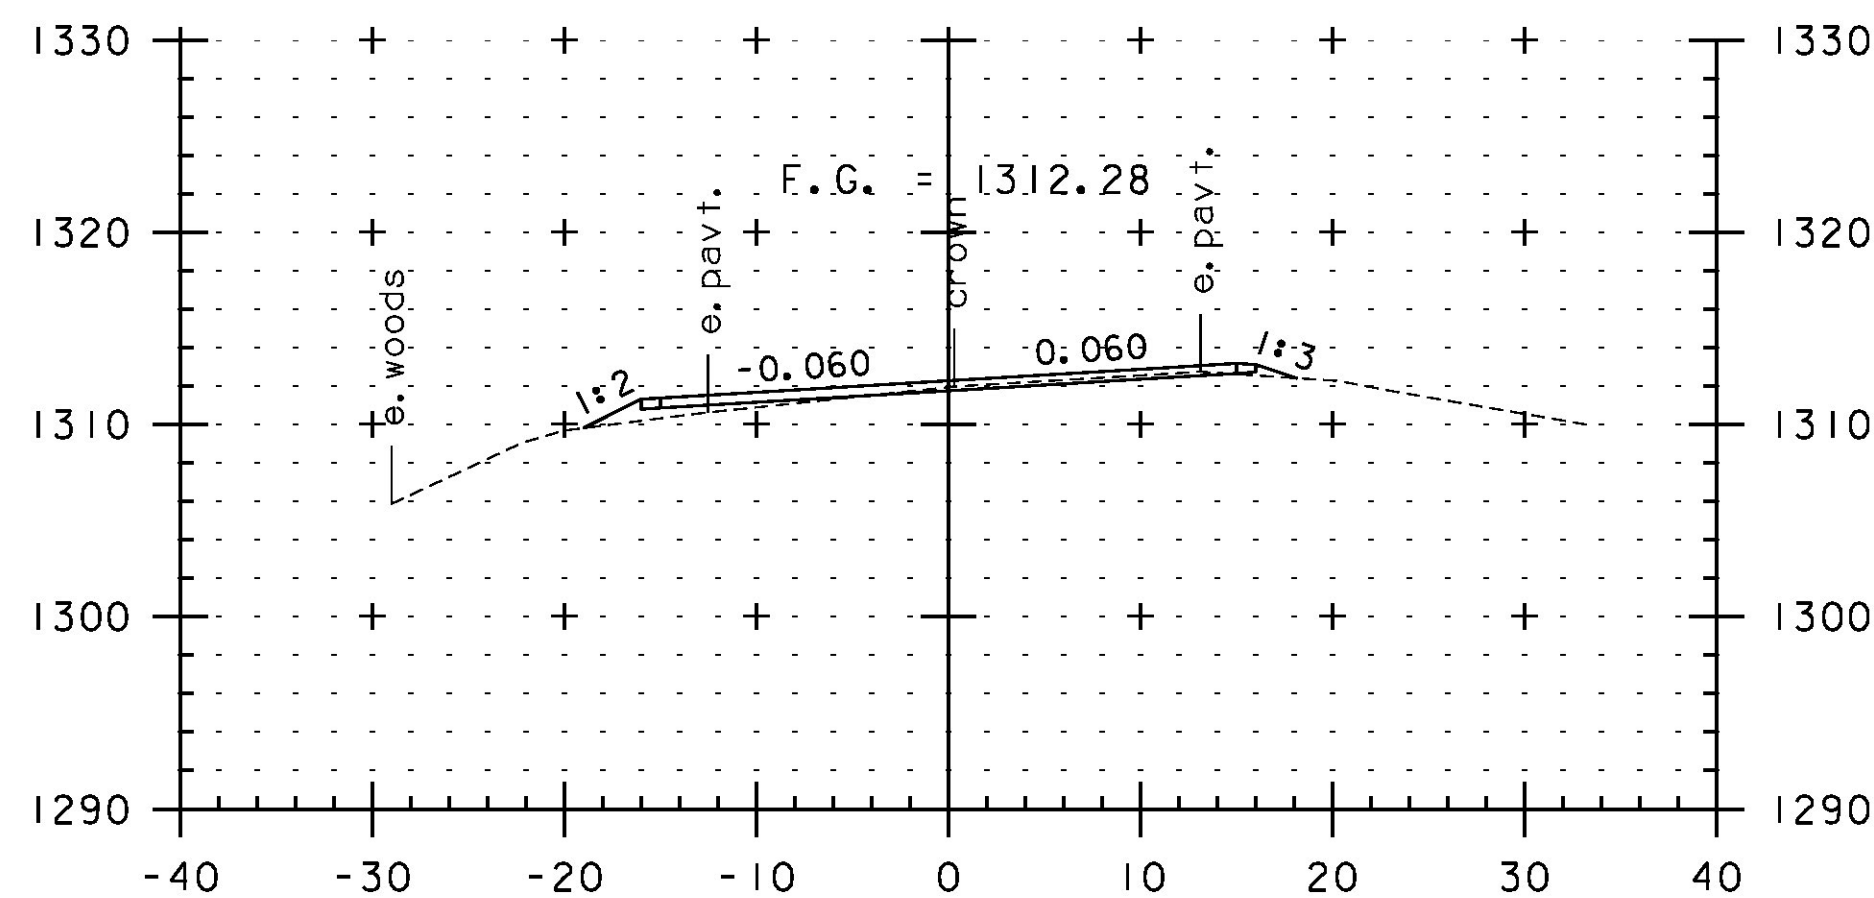


316+00

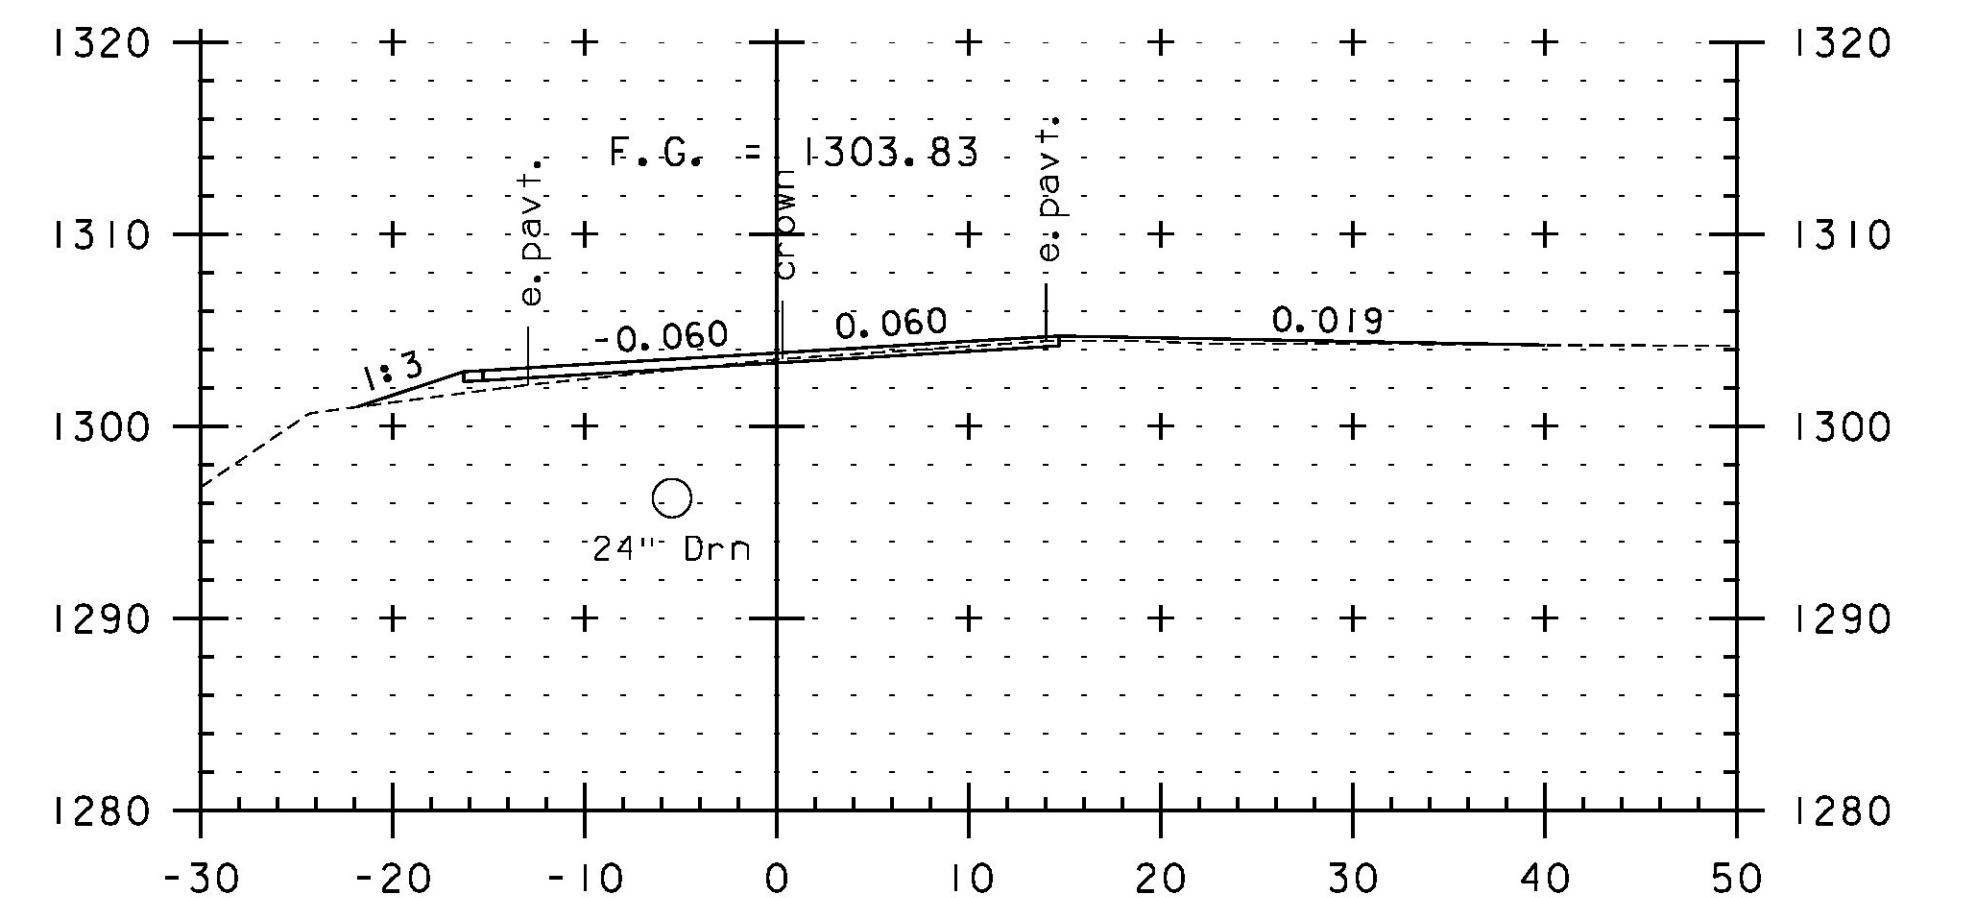


317+32  
TH 12 RT

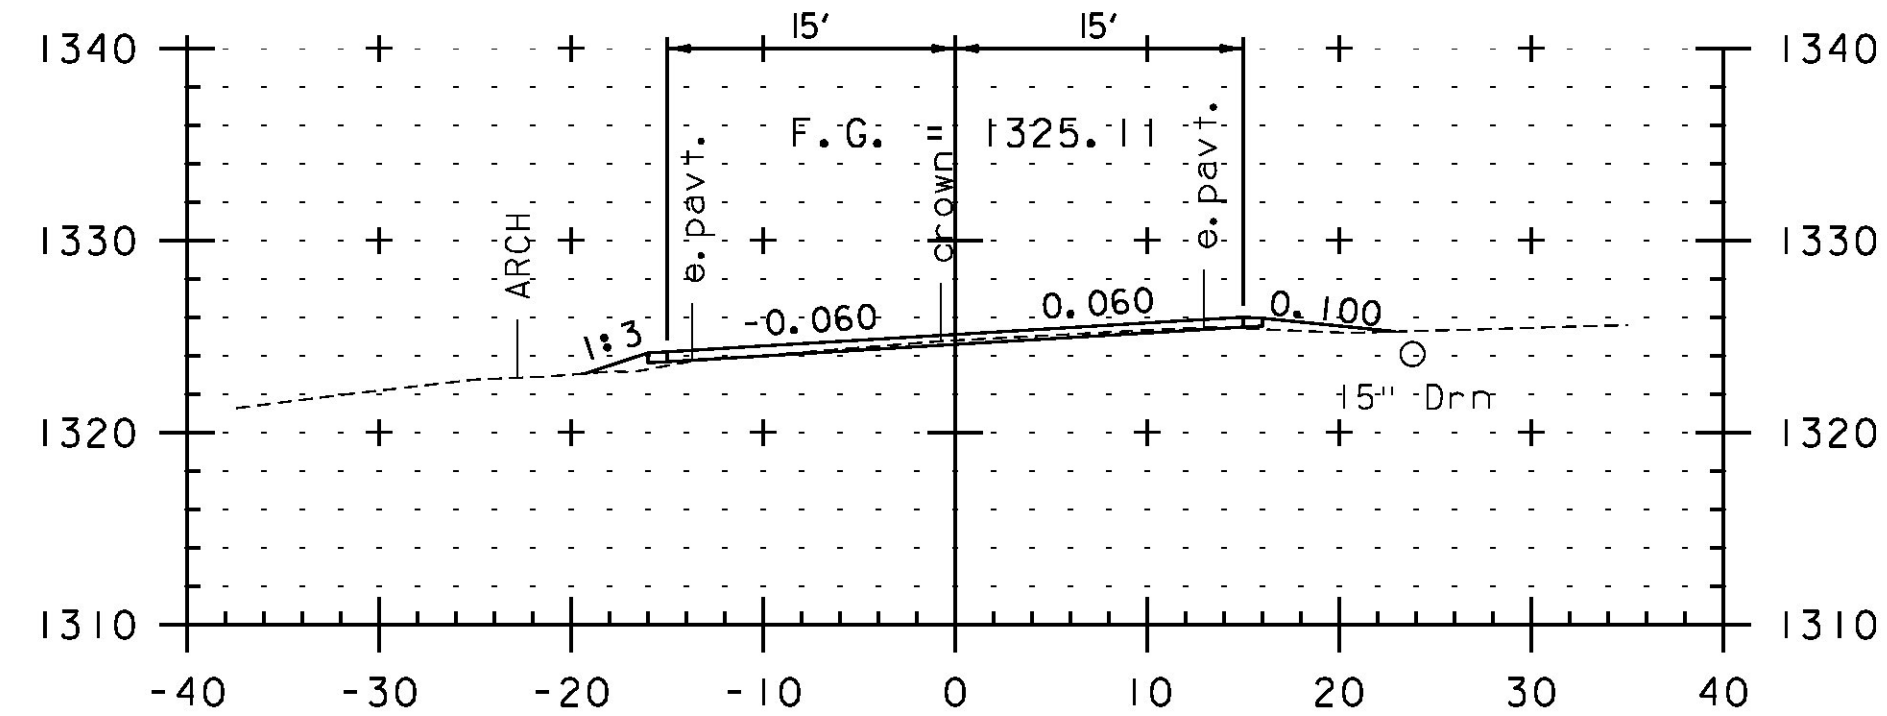

314+00

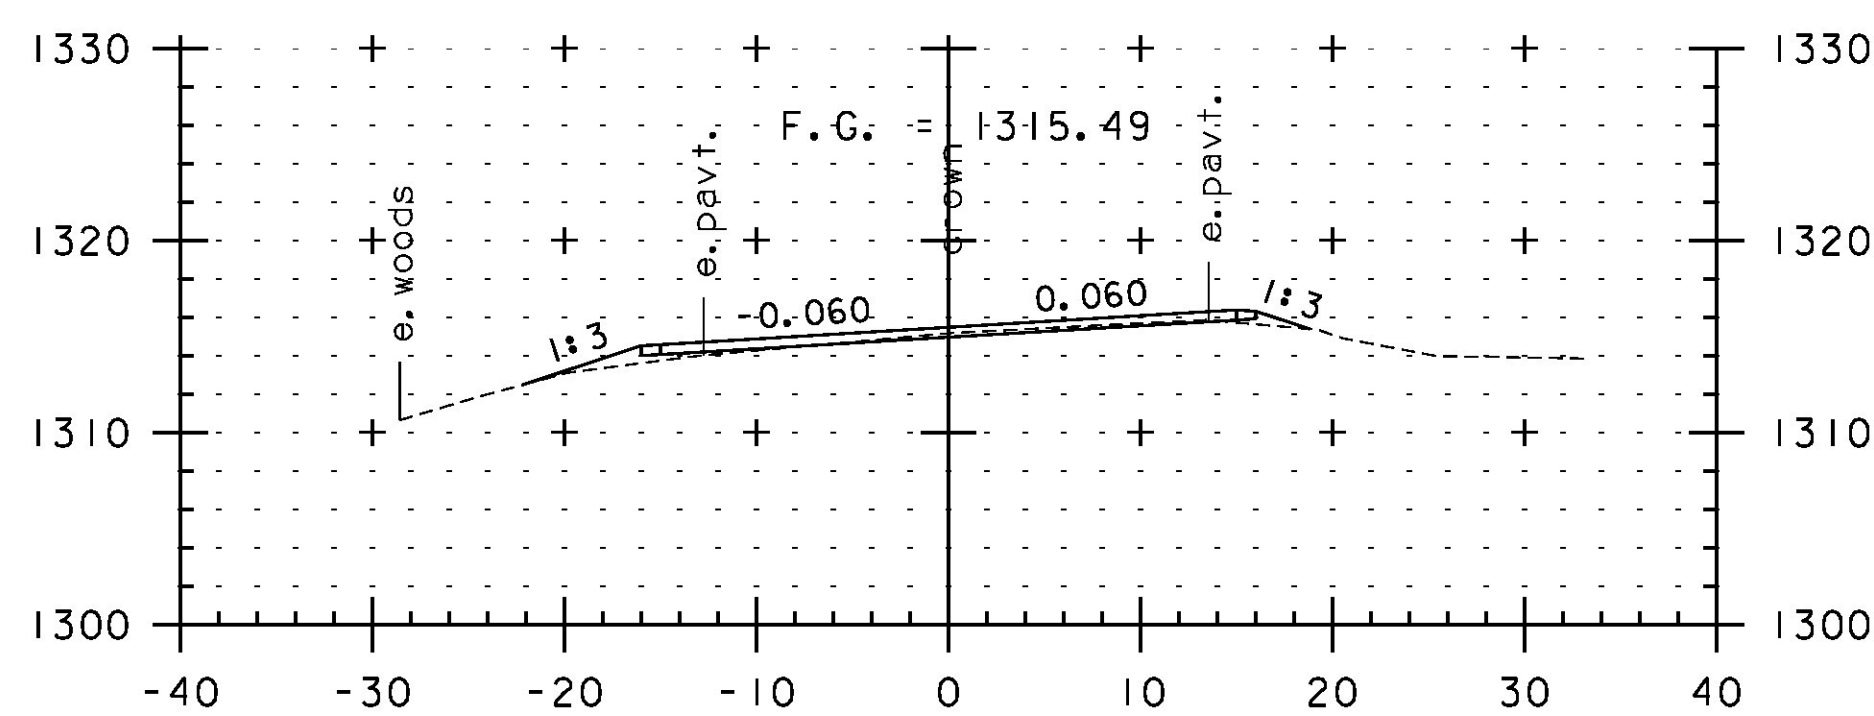

315+50

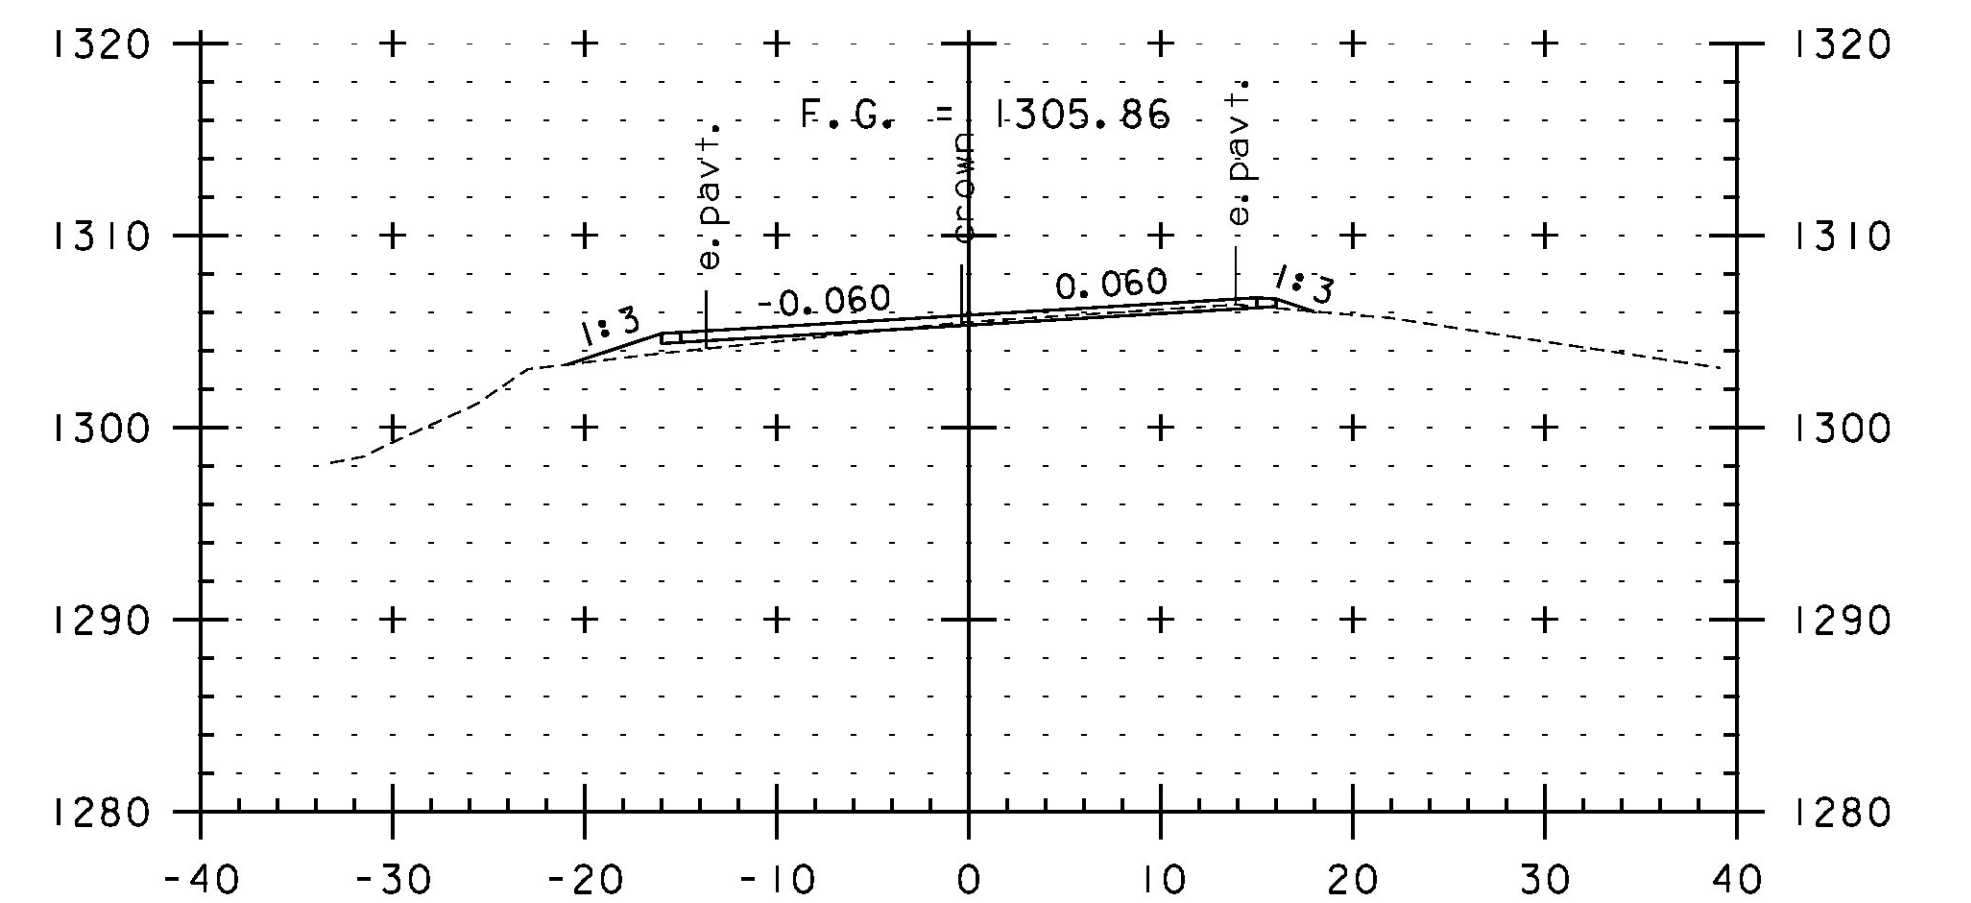

317+00



SCALE IN FEET

STA. 314+00 TO STA. 317+50

PROJECT NAME: JAY-TROY  
PROJECT NUMBER: STP 2315(I)

FILE NAME: z10b232xs.dgn  
PROJECT LEADER: P. SHEDD  
DESIGNED BY: N. LEMAY  
CROSS SECTION SHEET 71

PLOT DATE: 5/16/2014  
DRAWN BY: W. GORDON  
CHECKED BY: P. SHEDD  
SHEET 207 OF 244