




319+00

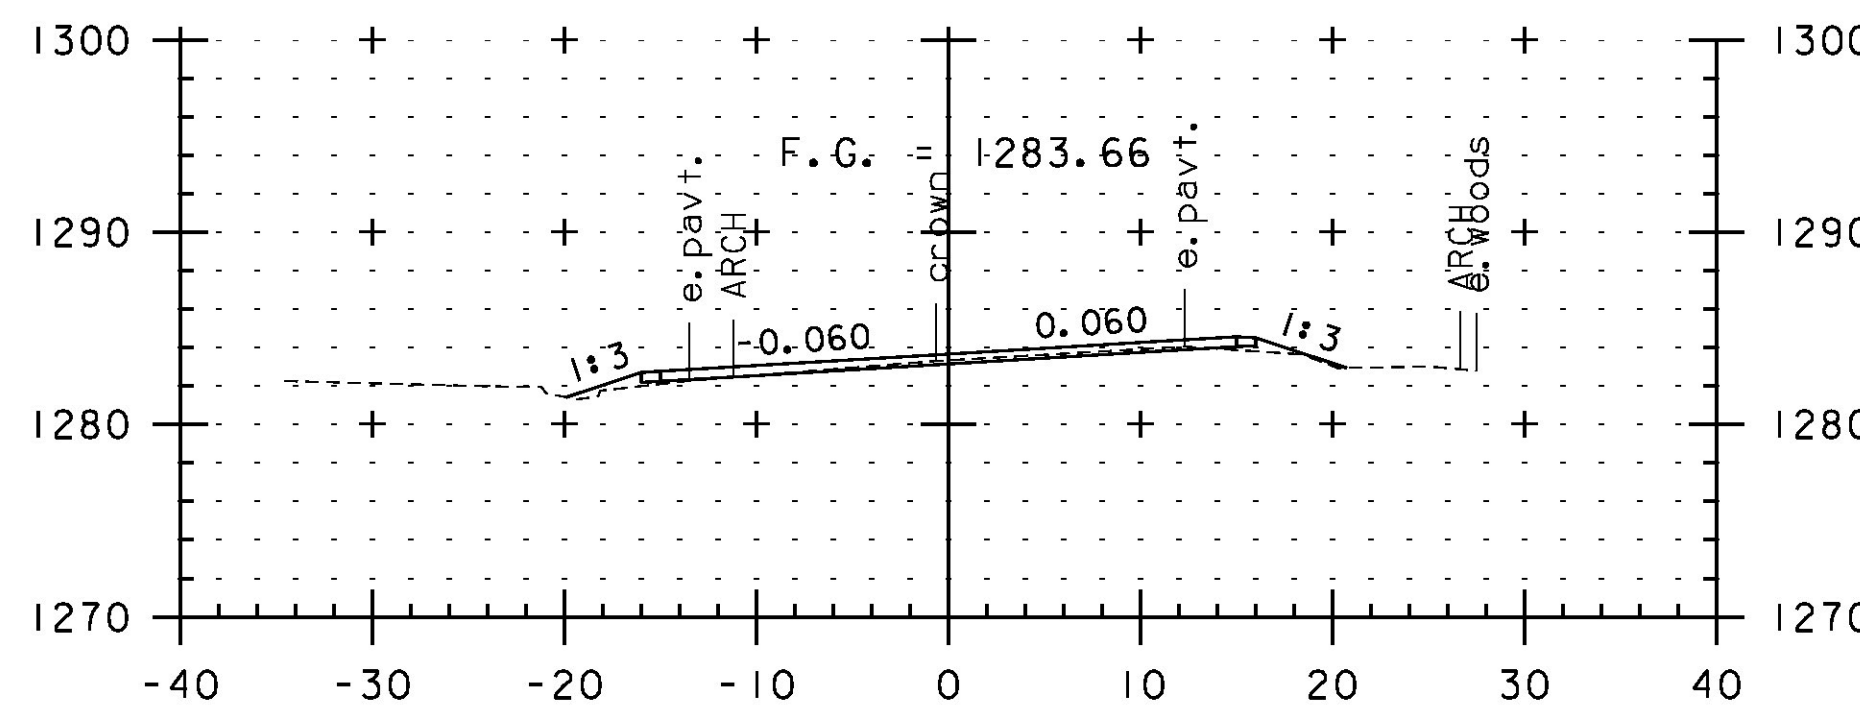


320+50

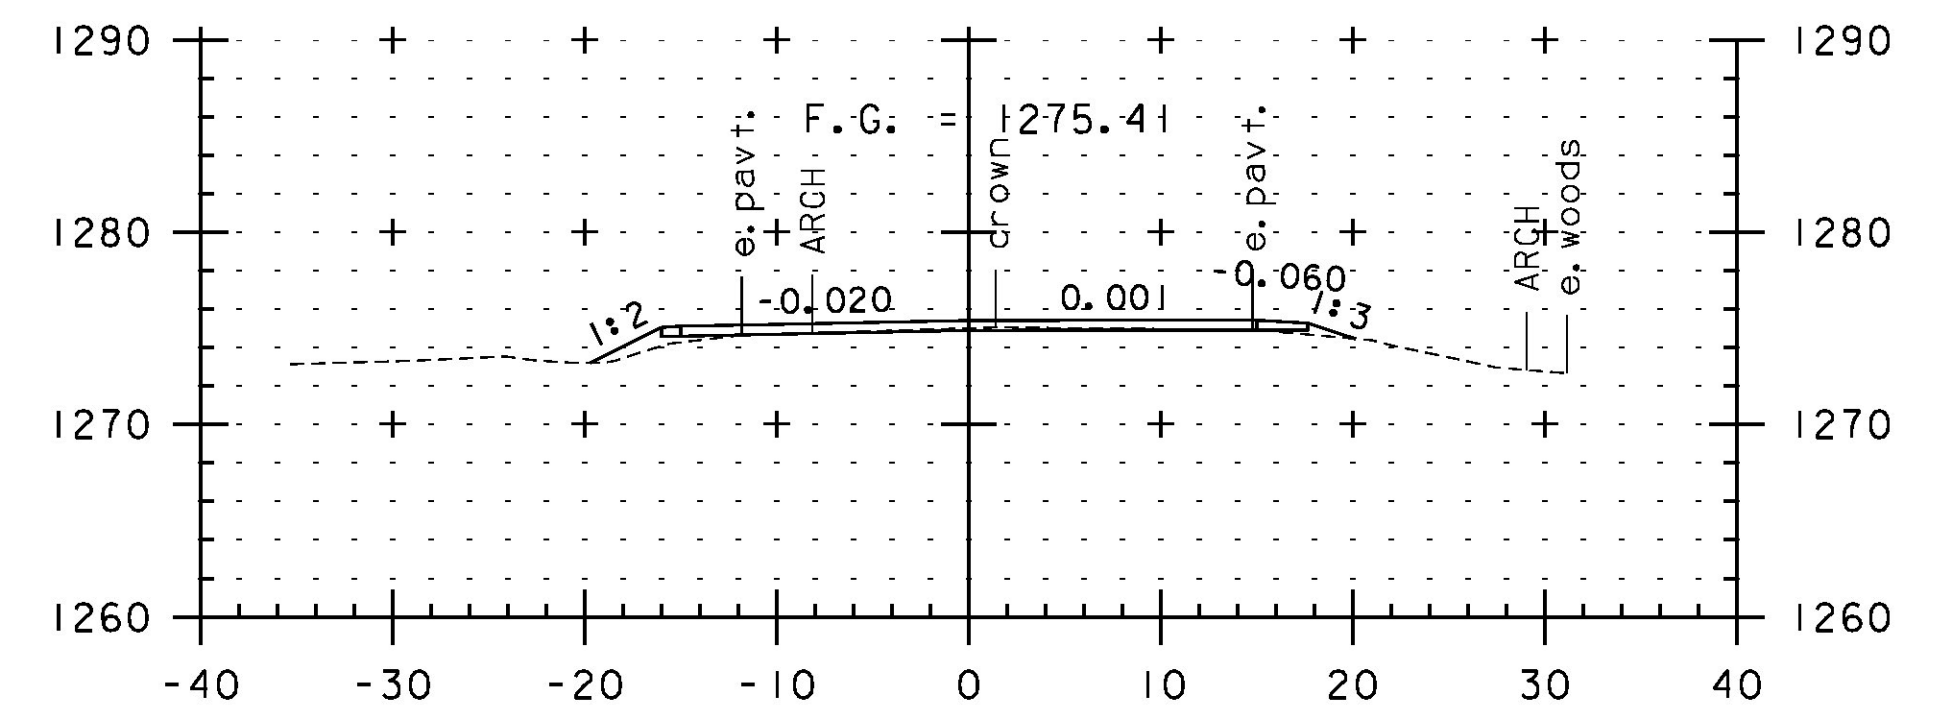


322+00

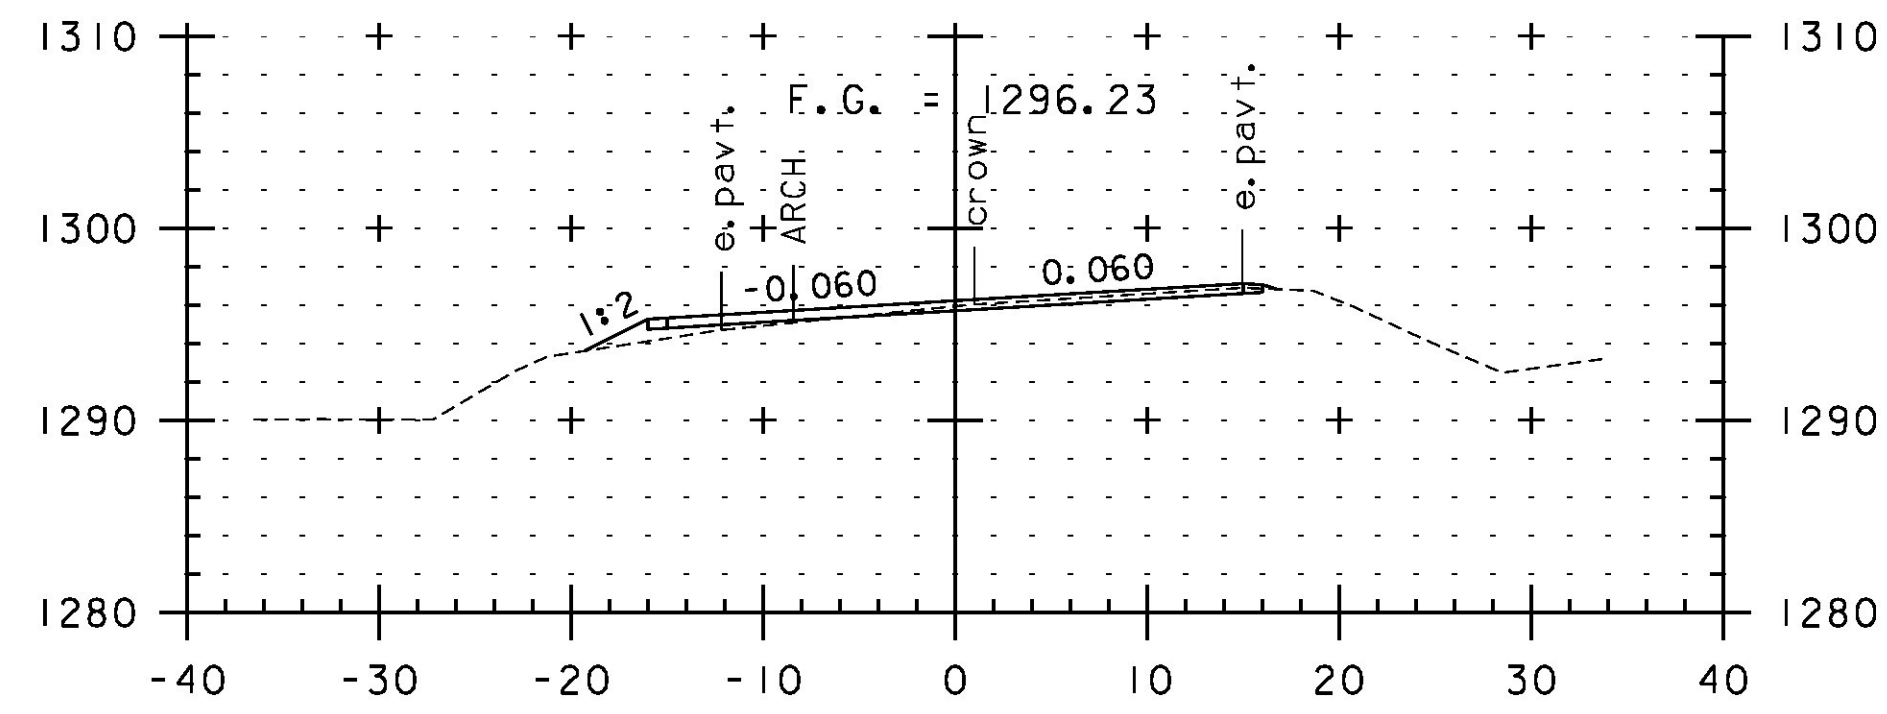


318+50

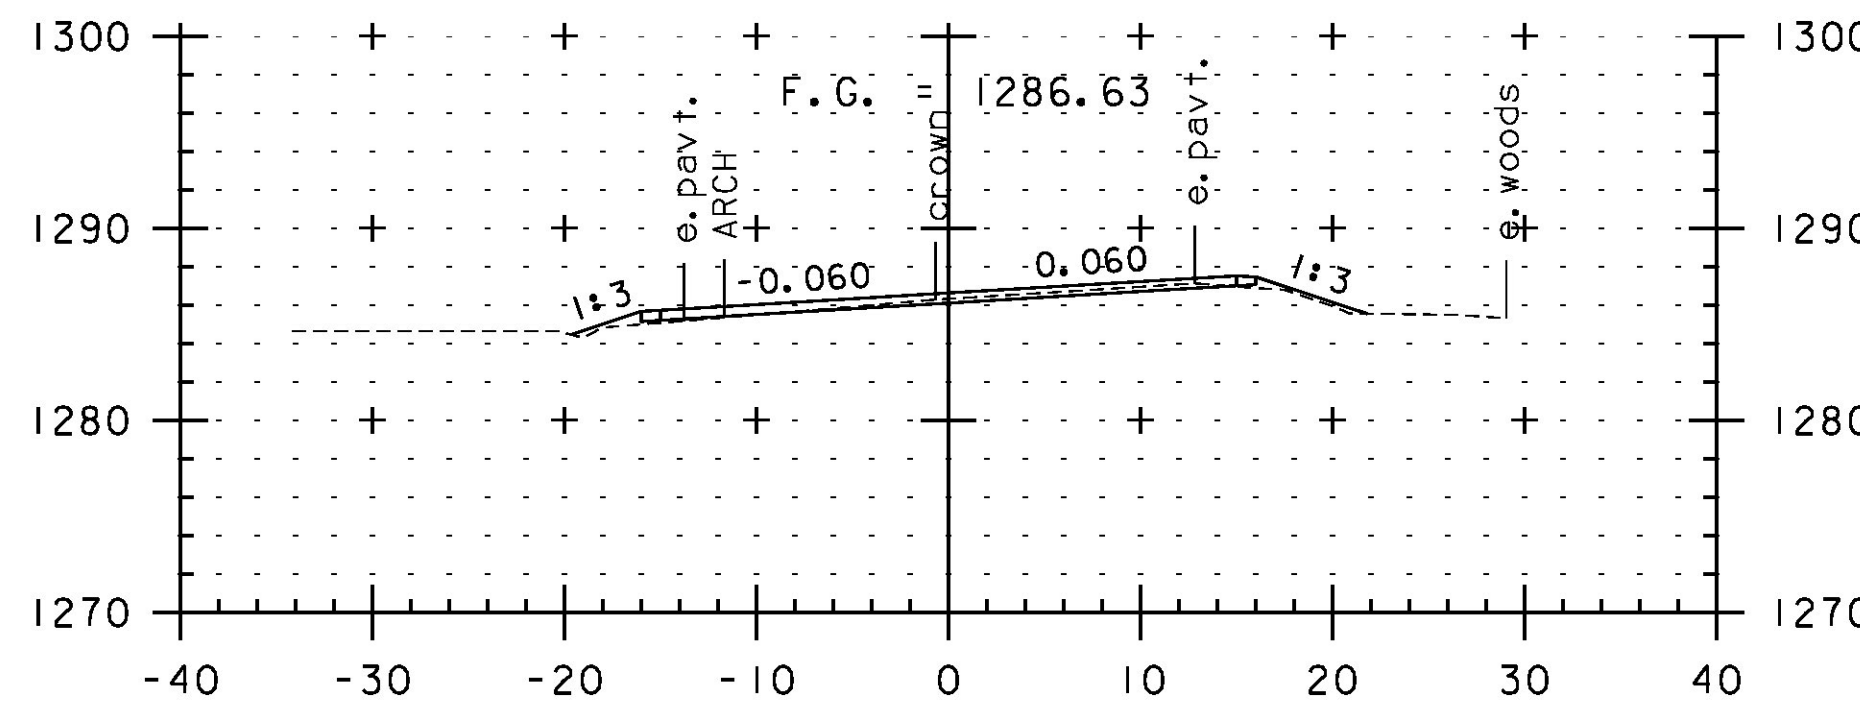


320+00

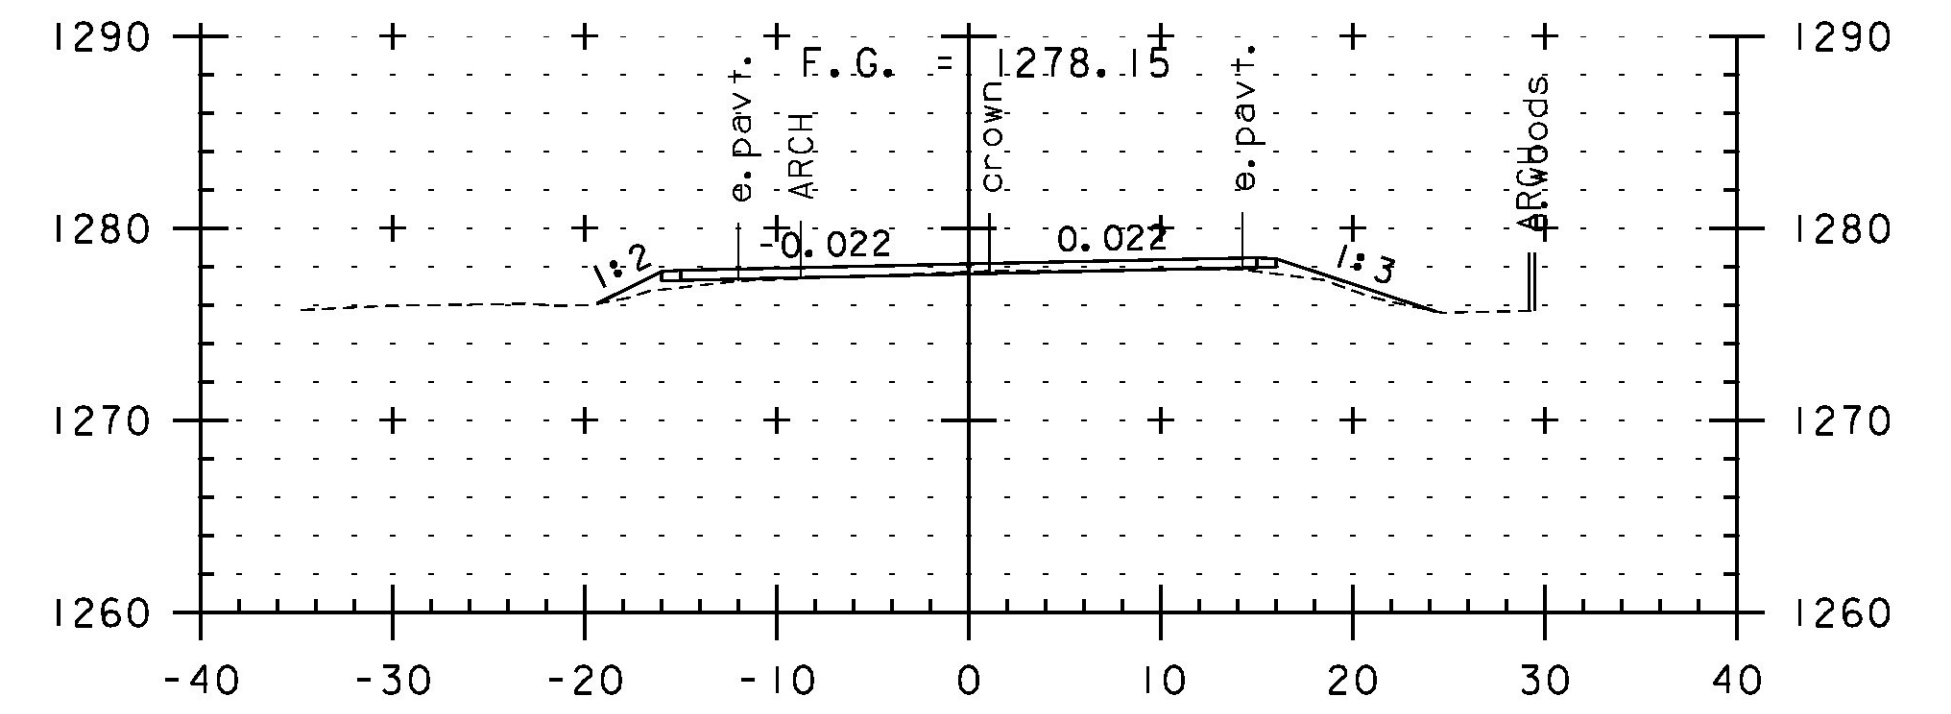


321+50

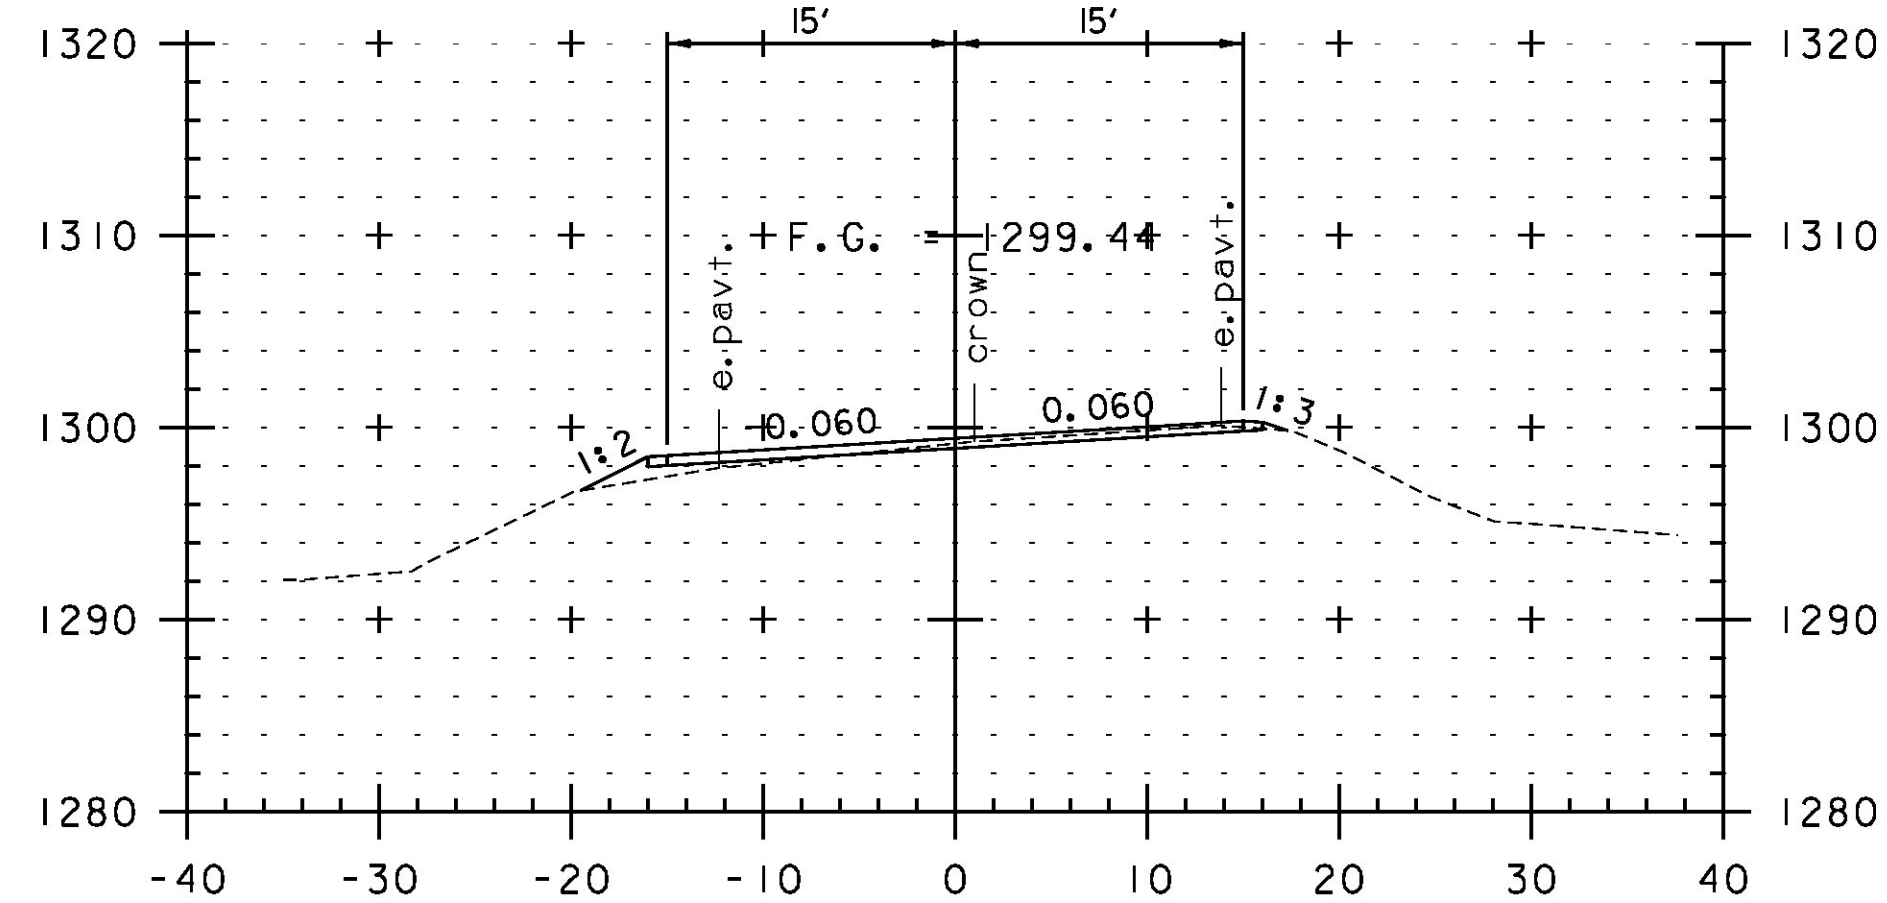

318+00

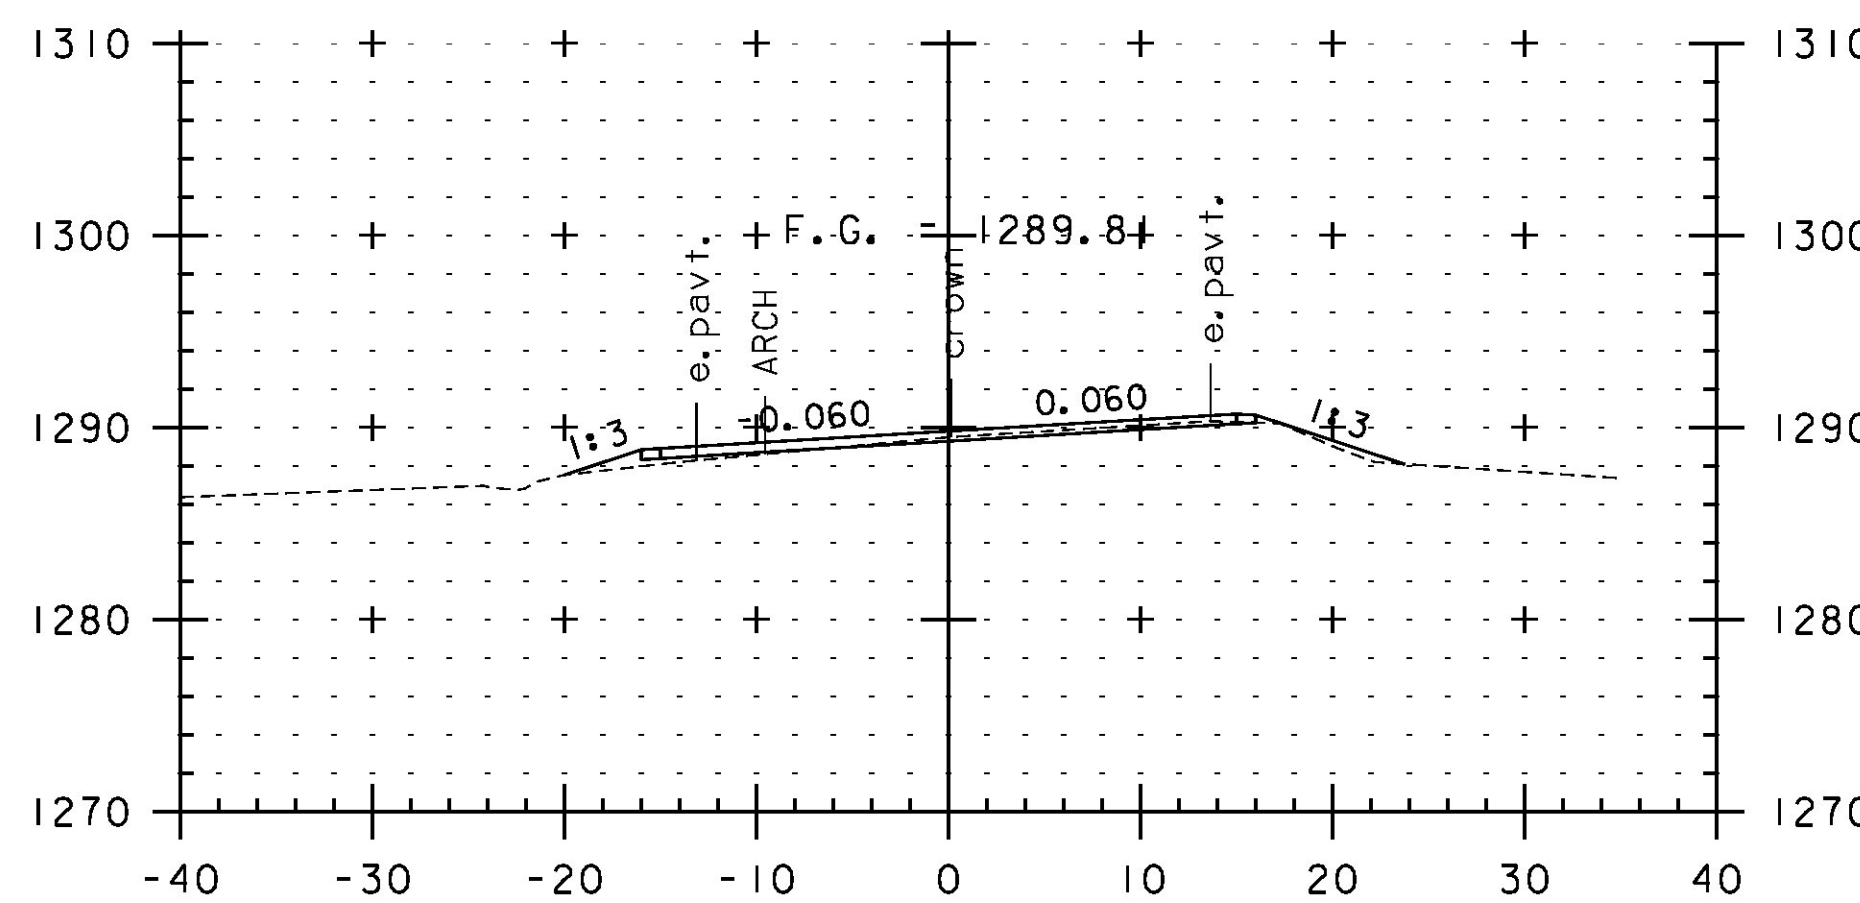

319+50

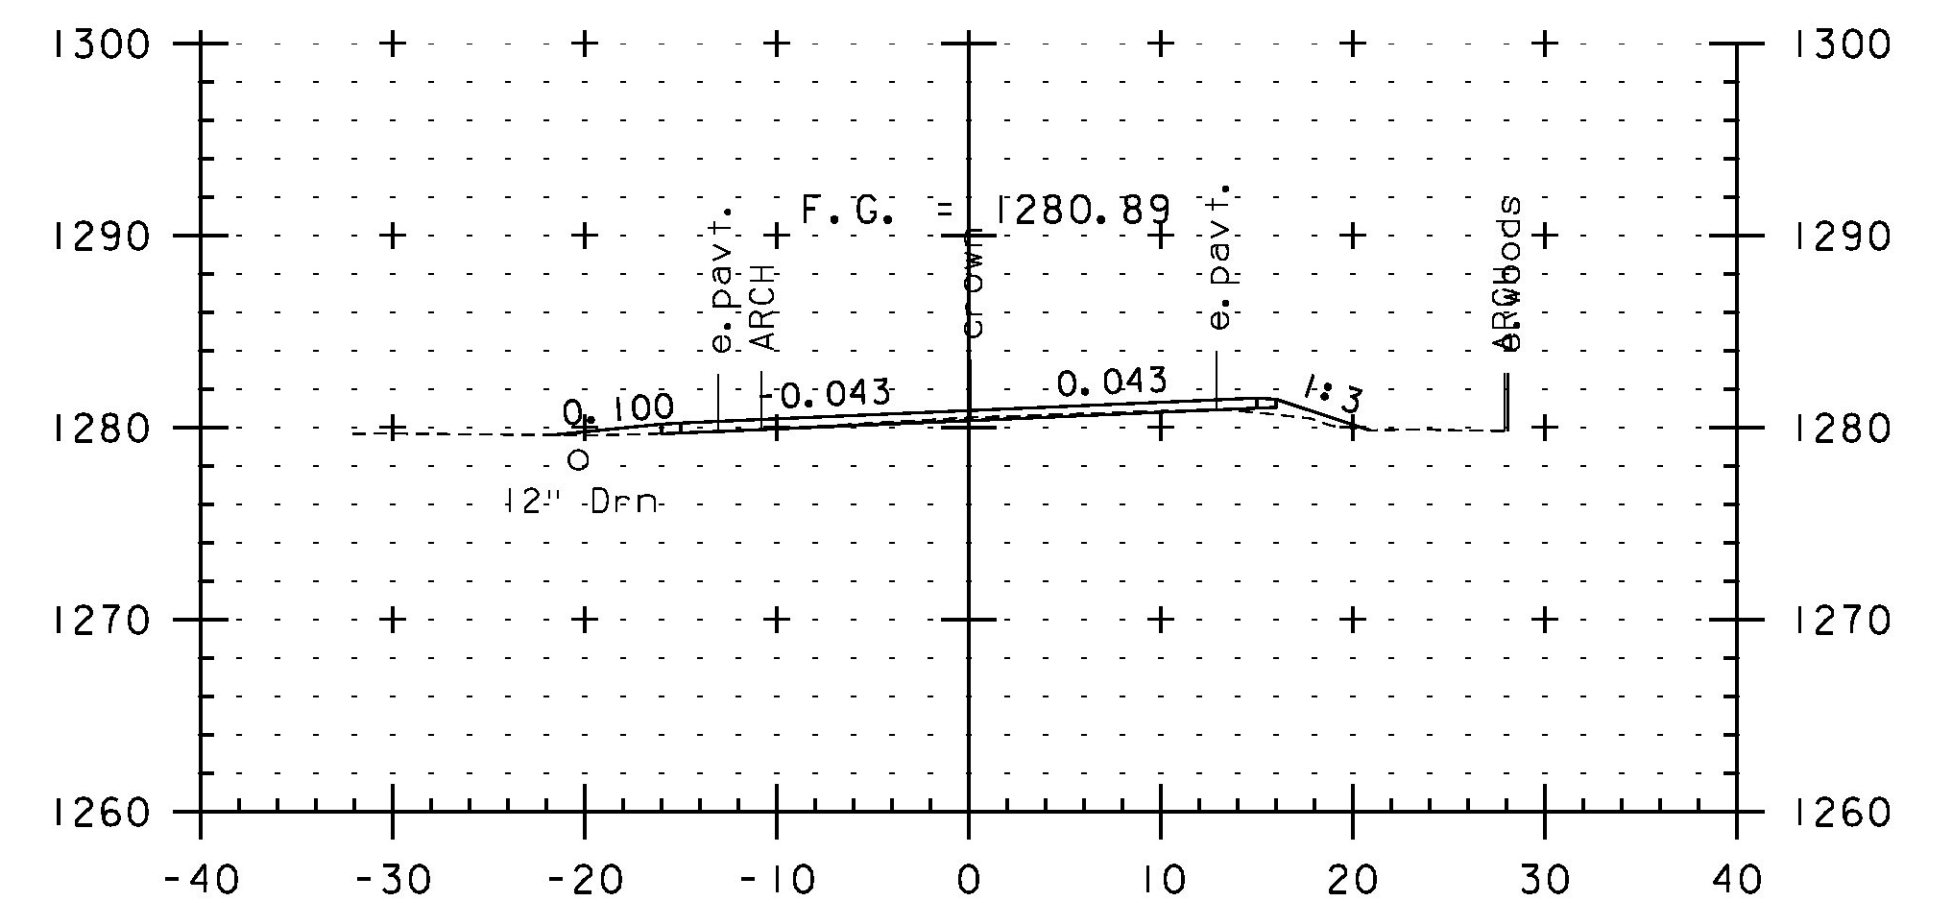

321+00



STA. 318+00 TO STA. 322+00

PROJECT NAME: JAY-TROY
PROJECT NUMBER: STP 2315(I)

FILE NAME: z10b232xs.dgn
PROJECT LEADER: P. SHEDD
DESIGNED BY: N. LEMAY
CROSS SECTION SHEET 72

PLOT DATE: 5/16/2014
DRAWN BY: W. GORDON
CHECKED BY: P. SHEDD
SHEET 208 OF 244