




326+00

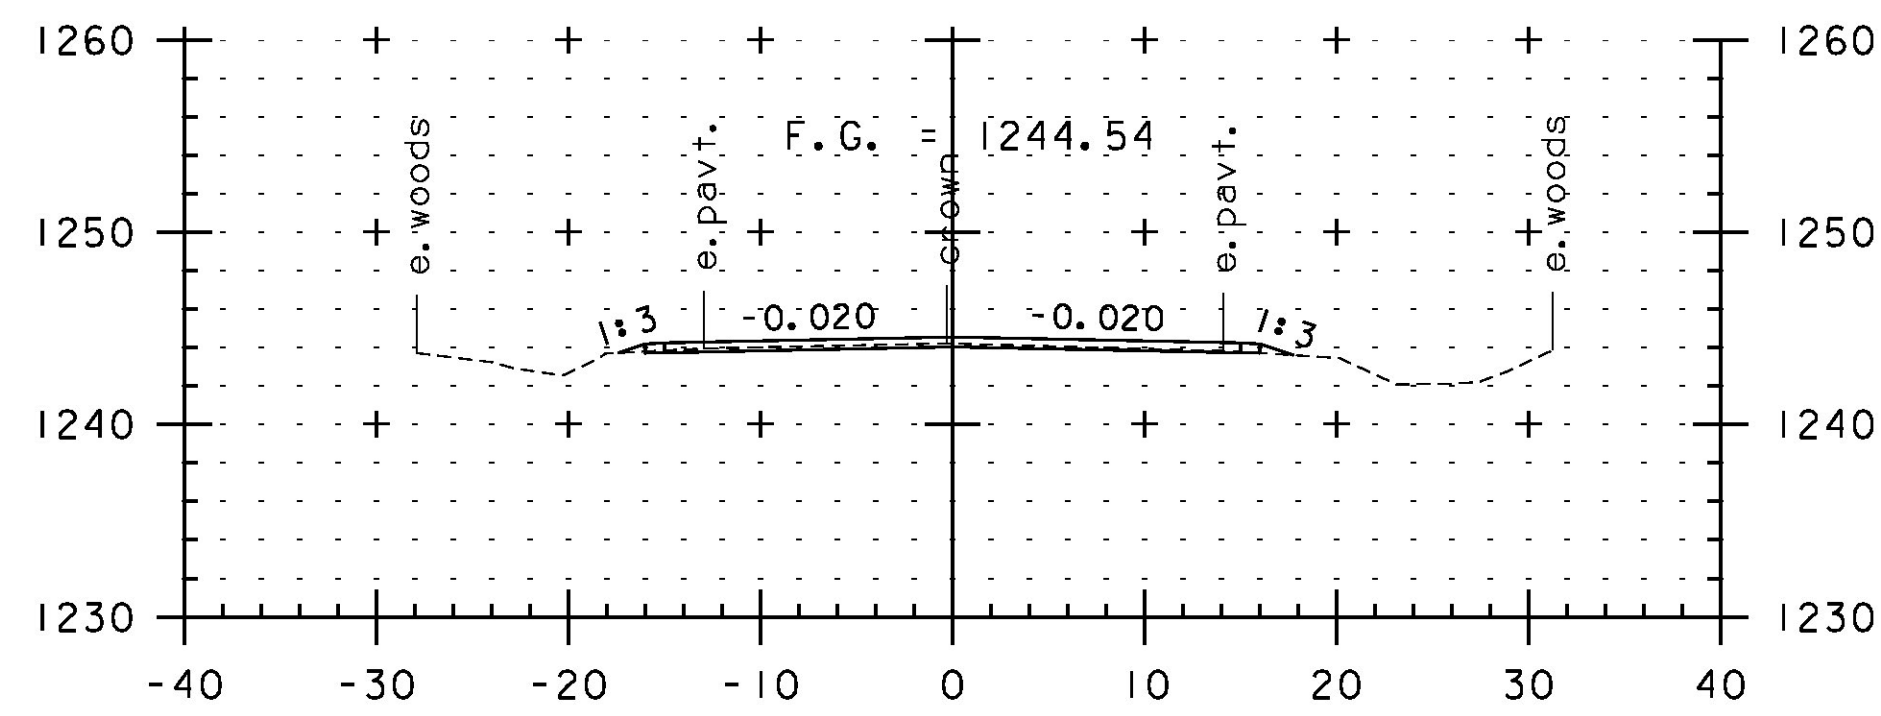


327+50

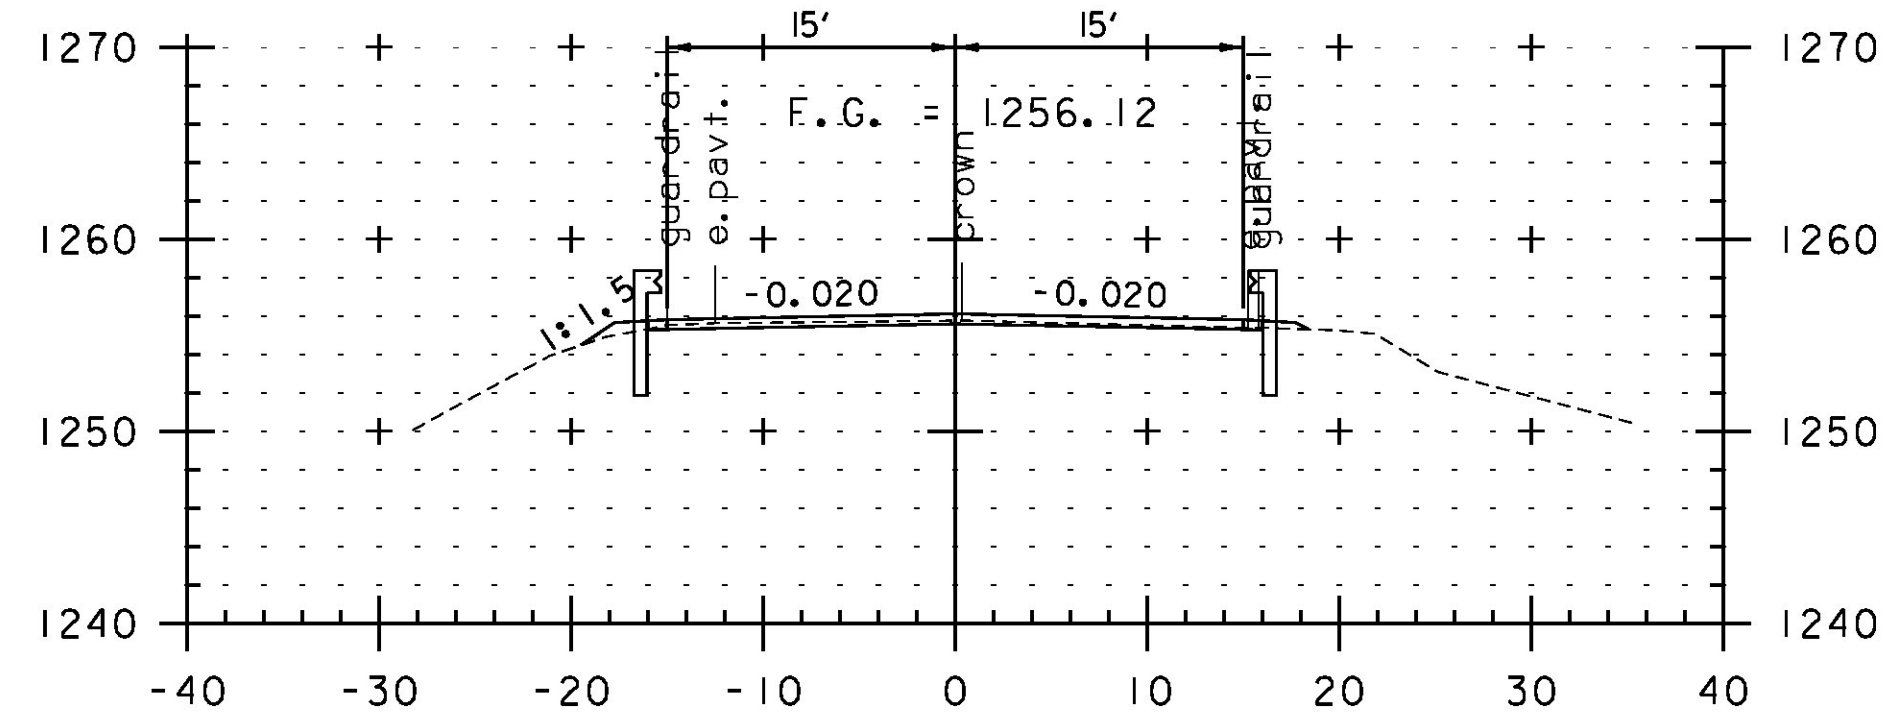


325+50

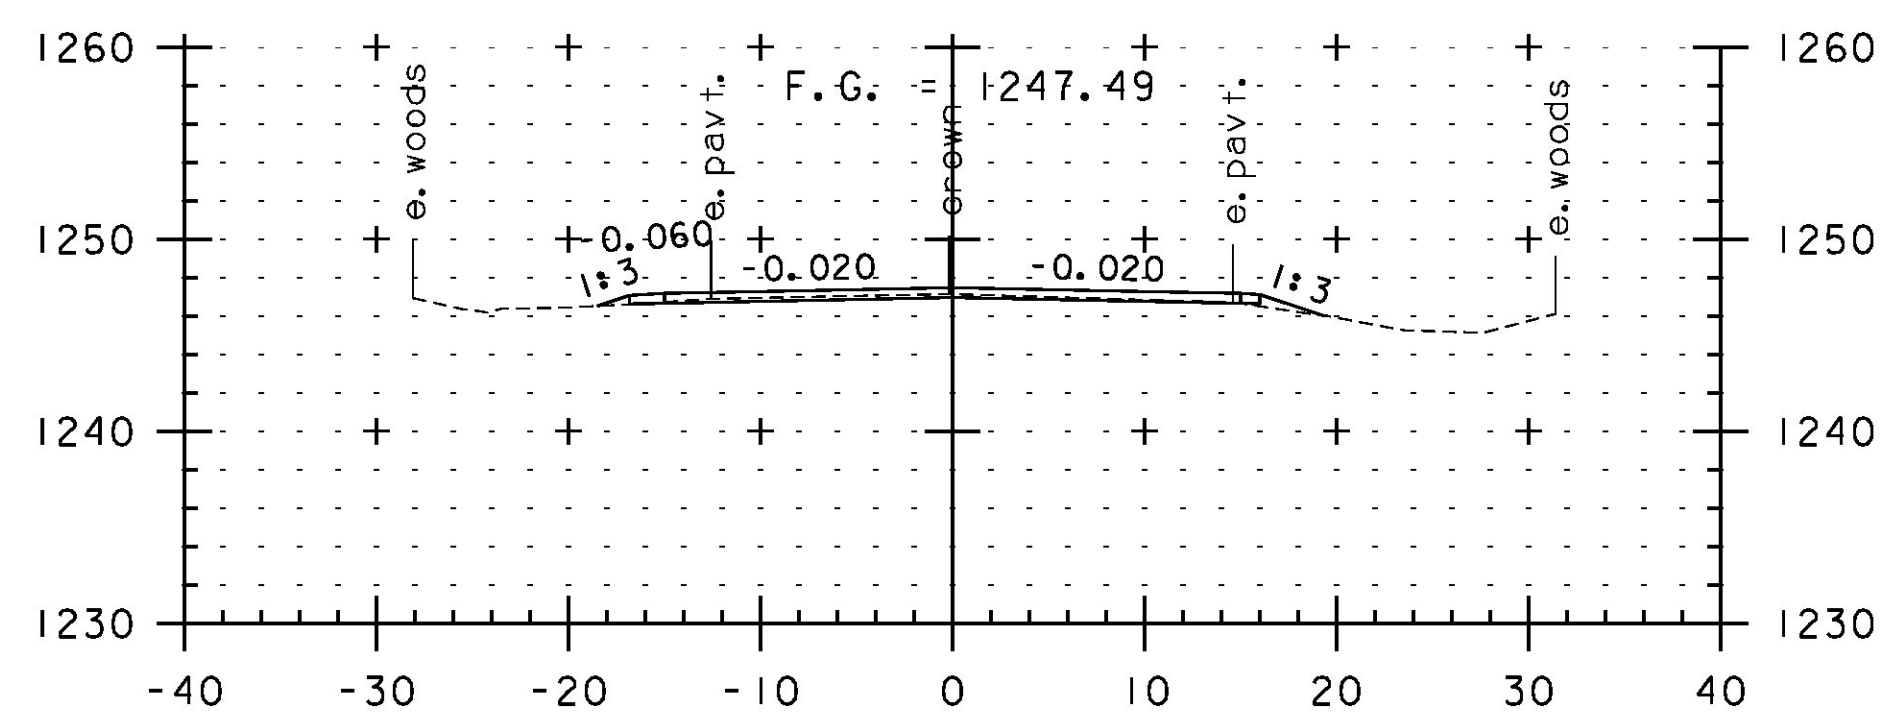


327+00

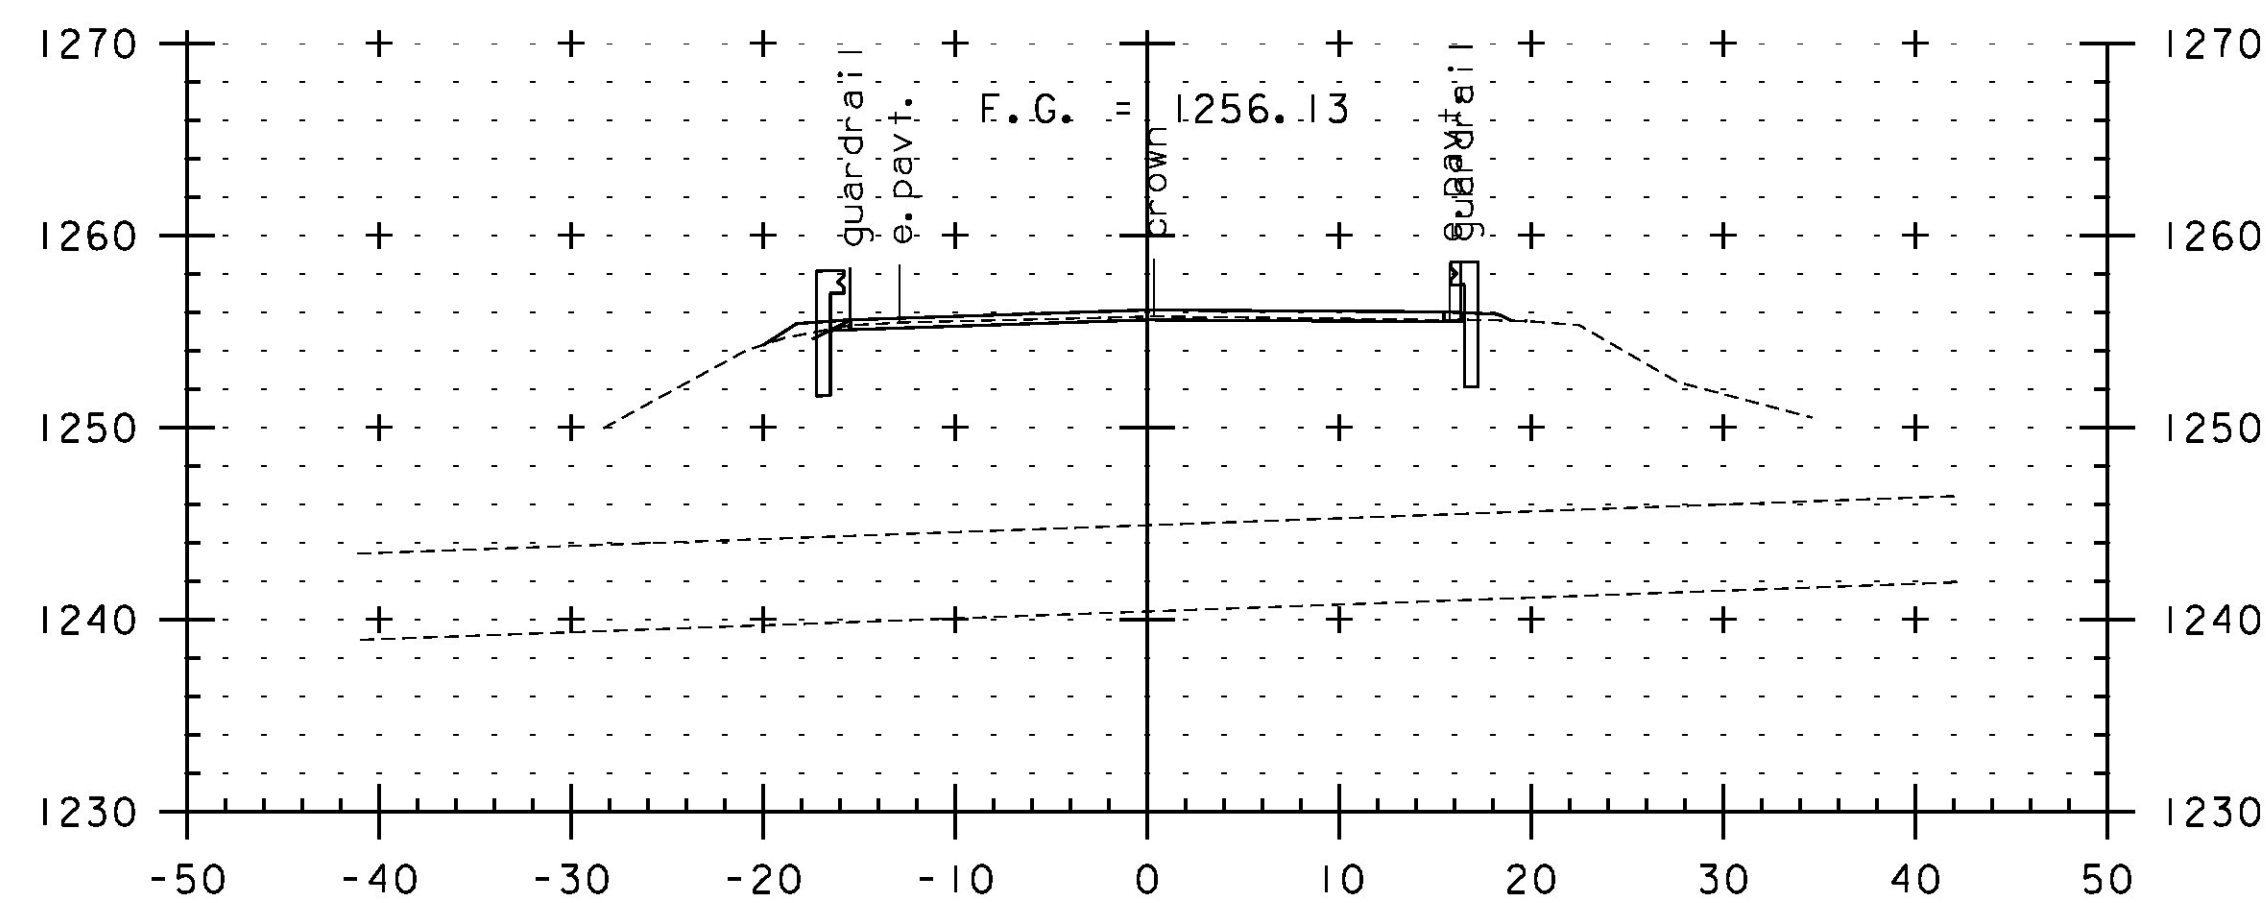

325+50
BRIDGE 50
APPROXIMATE LOCATION
NOT SURVEYED

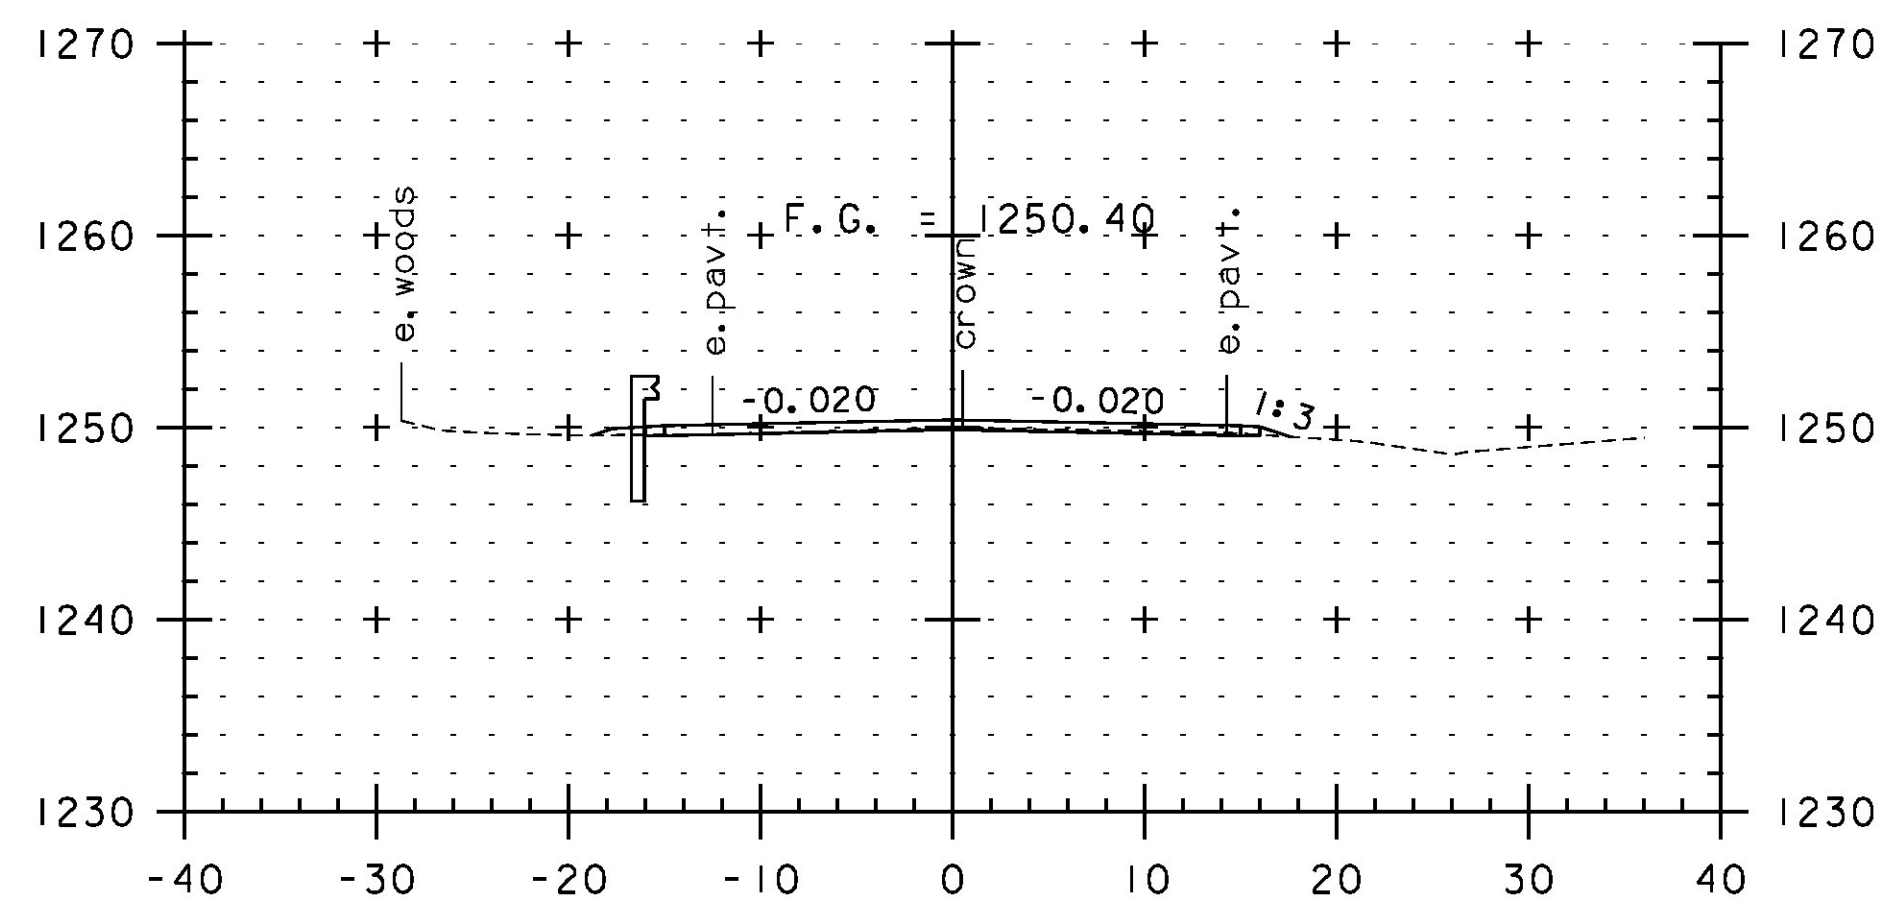

326+50

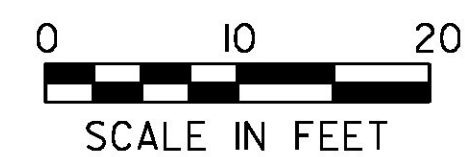

STA. 325+50 TO STA. 327+50

PROJECT NAME:	JAY-TROY	PLOT DATE:	5/16/2014
PROJECT NUMBER:	STP 2315(I)	DRAWN BY:	W. GORDON
FILE NAME:	z10b232xs.dgn	DESIGNED BY:	N. LEMAY
PROJECT LEADER:	P. SHEDD	CHECKED BY:	P. SHEDD
CROSS SECTION SHEET	74	SHEET	210 OF 244