




333+50

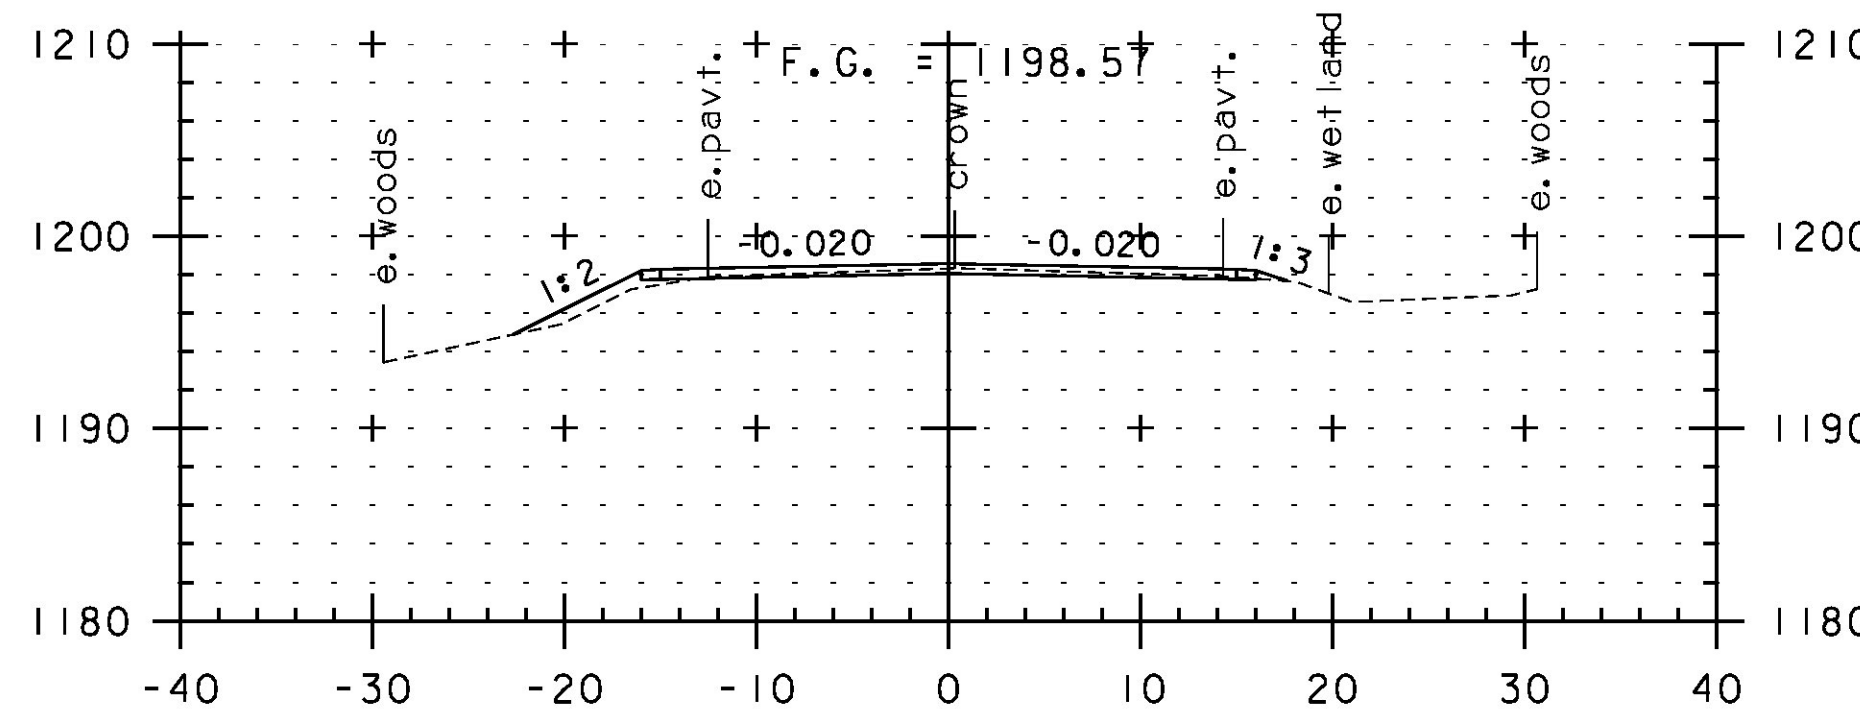


335+00

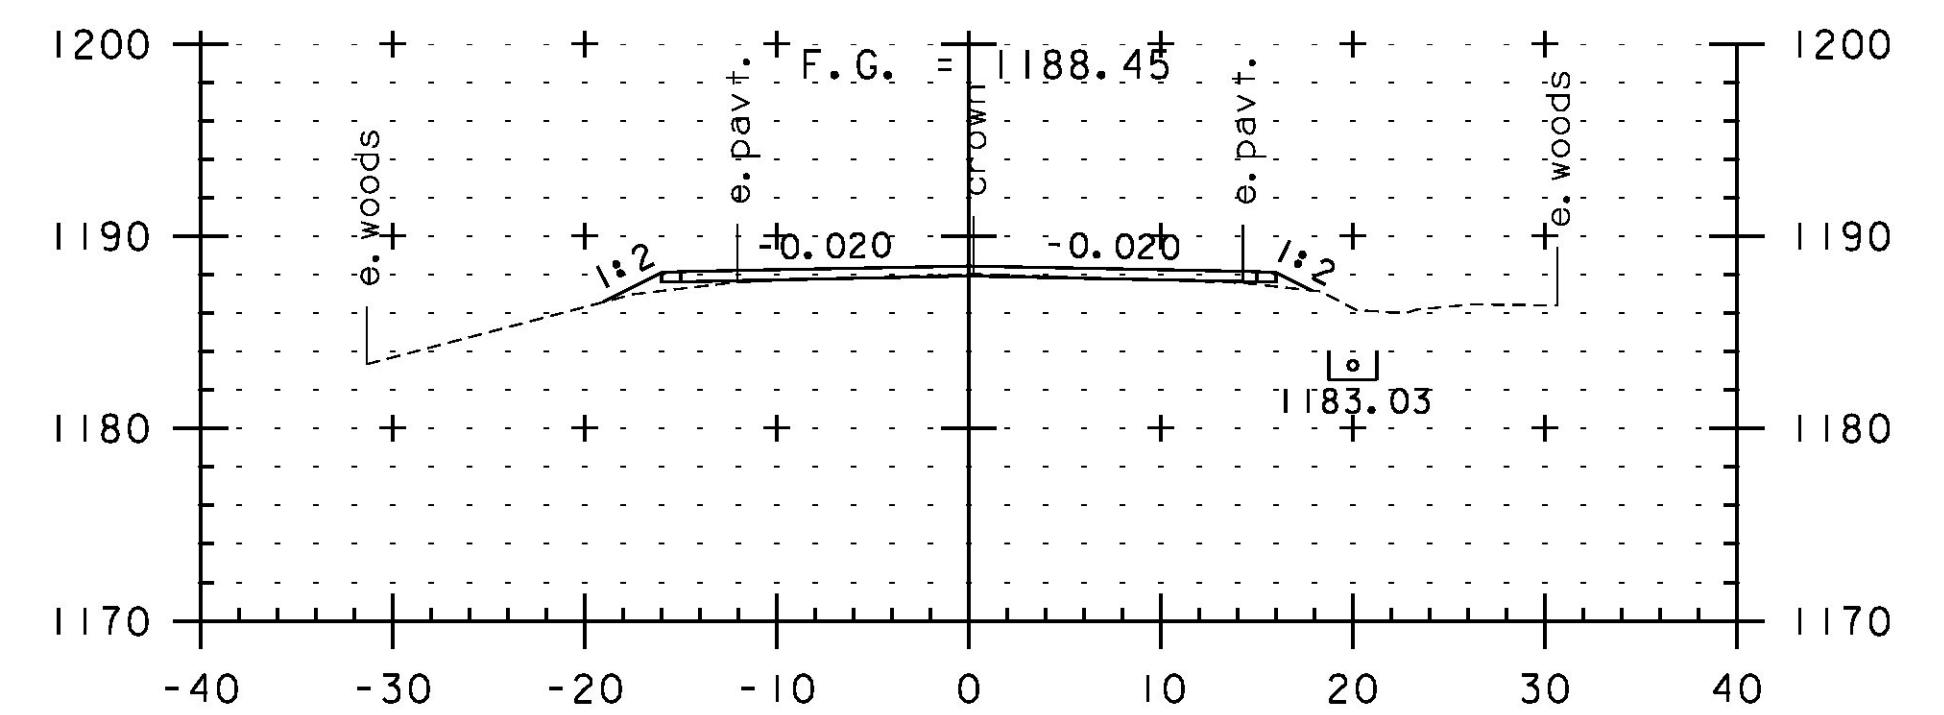


336+50

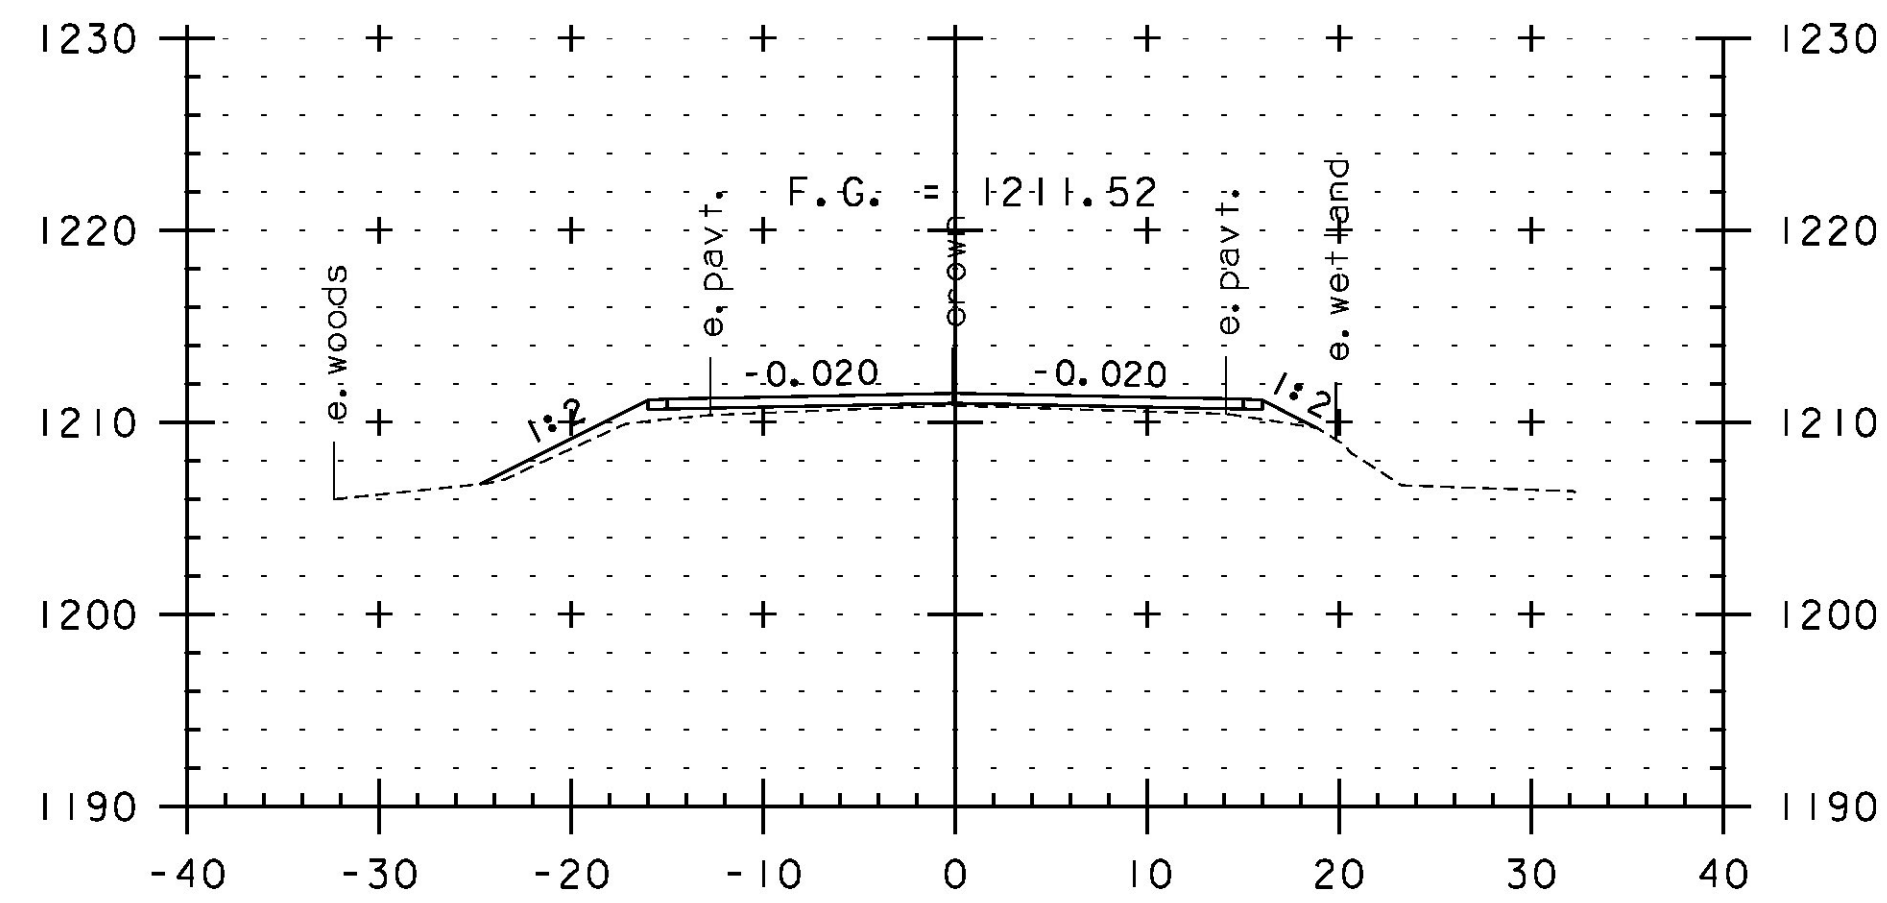


333+00

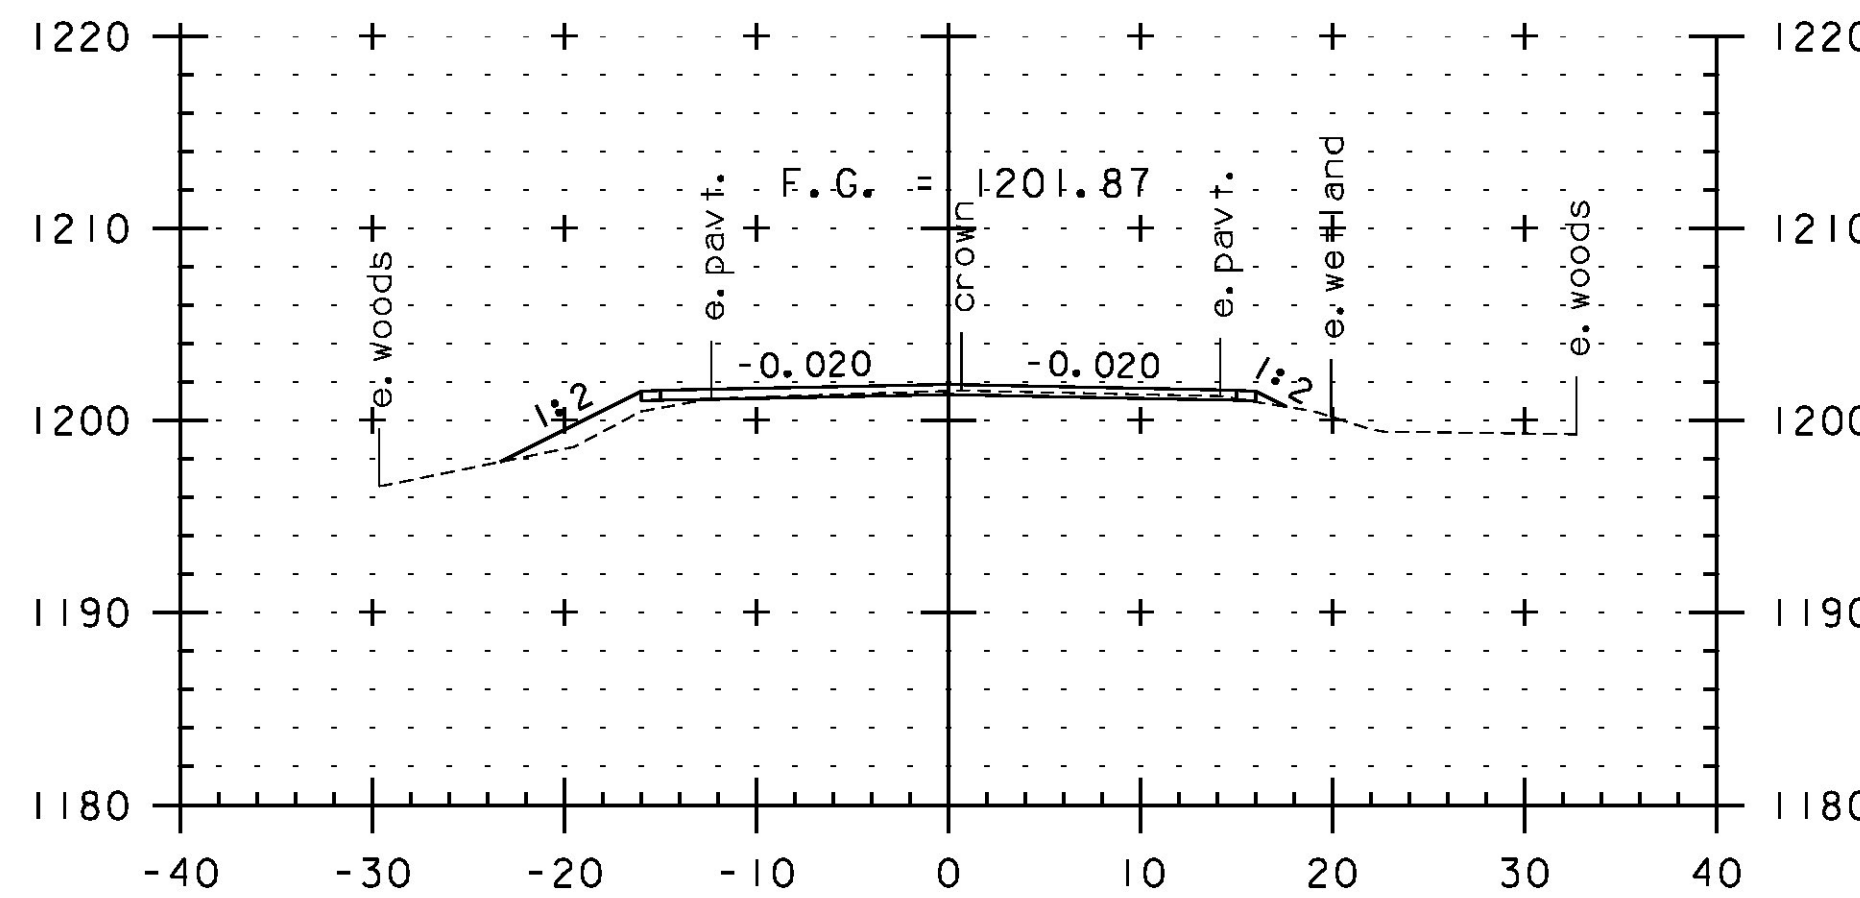


334+50

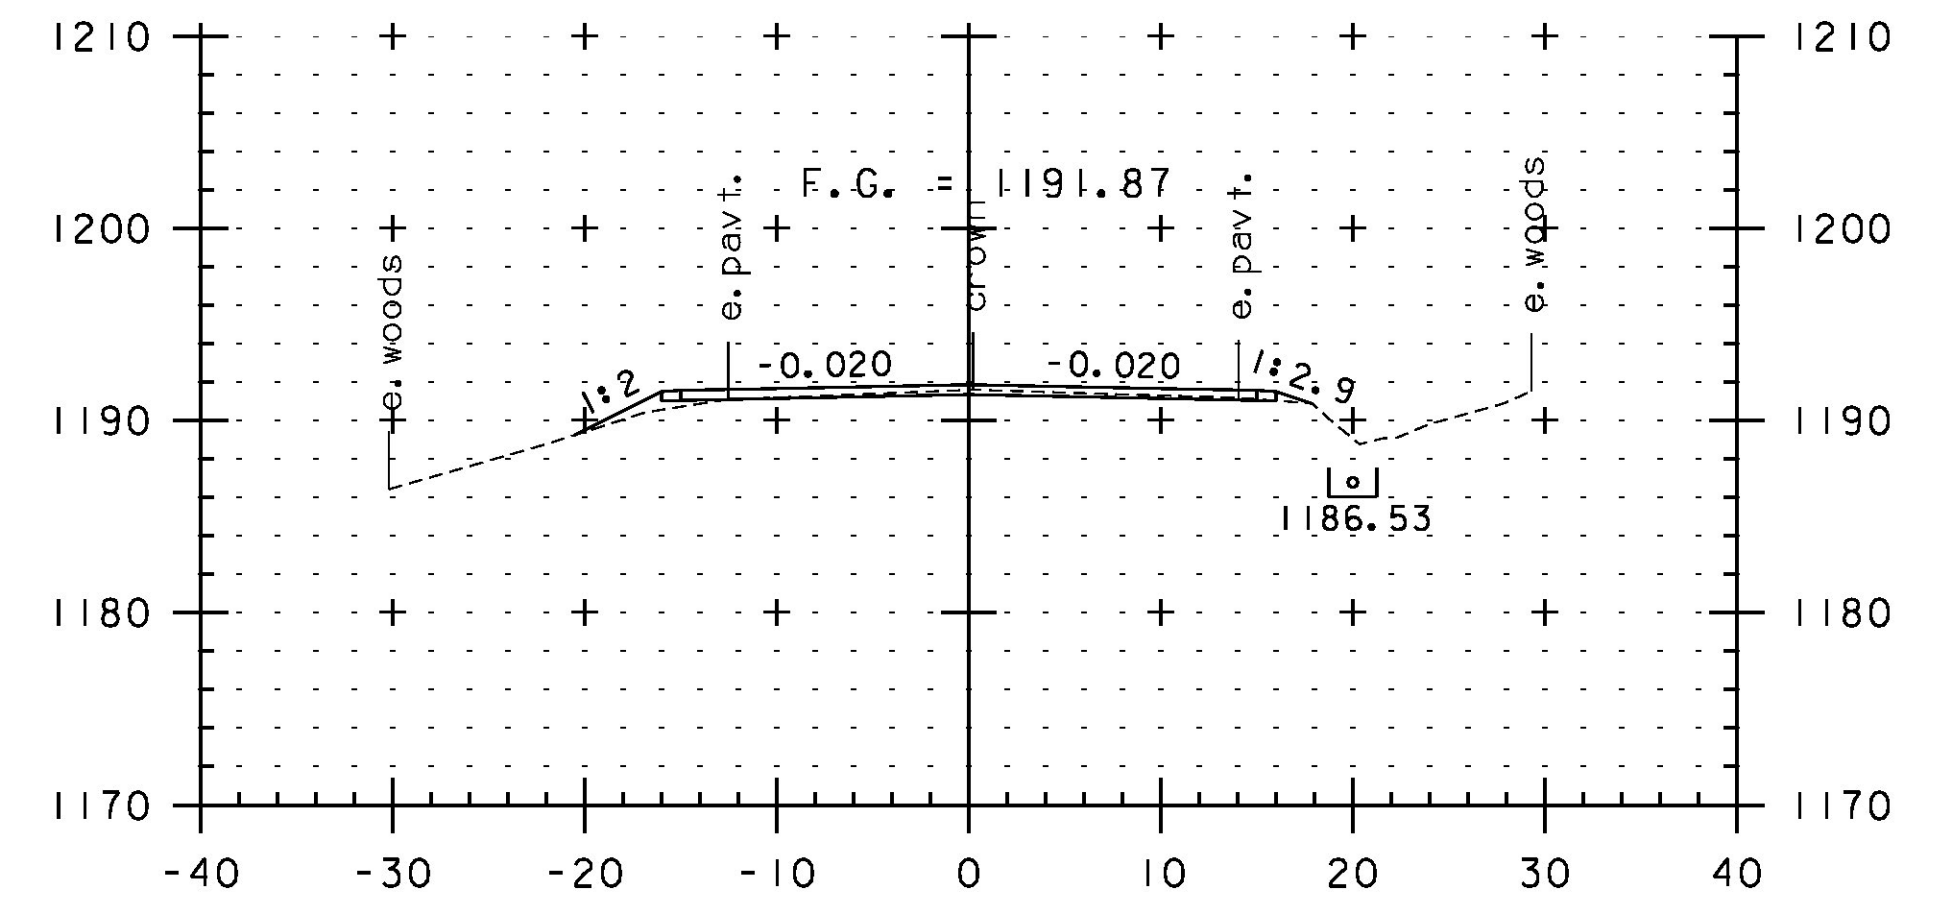


336+00

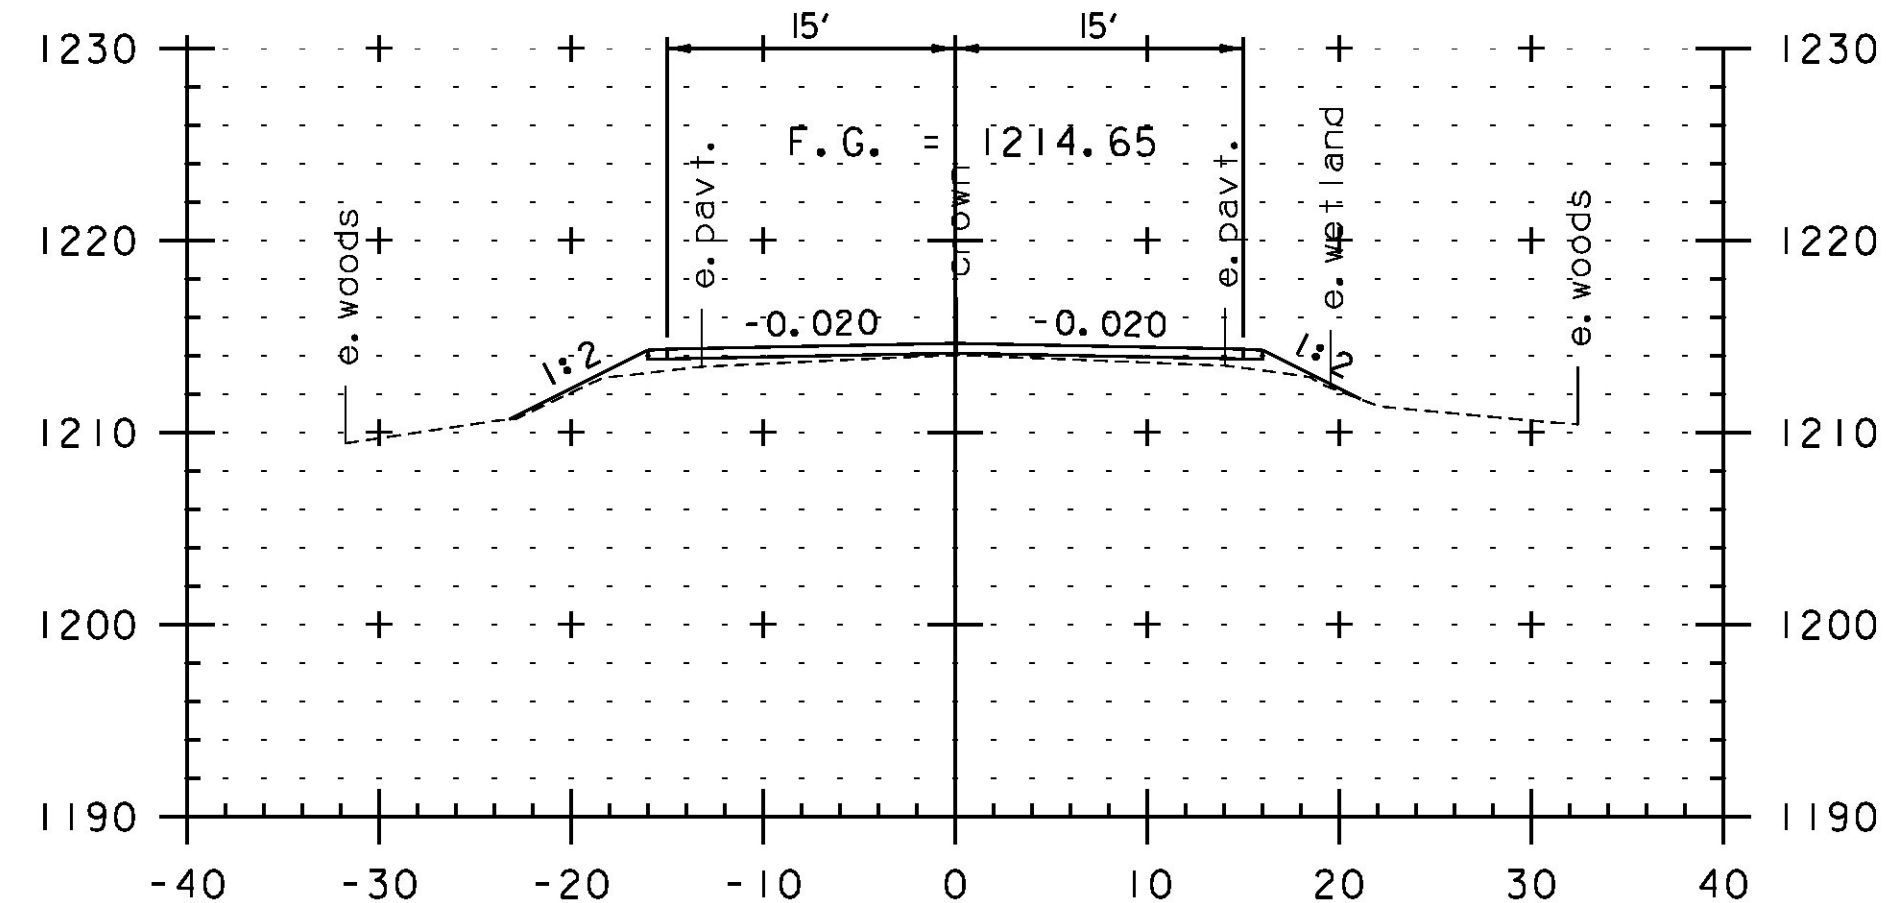

332+50

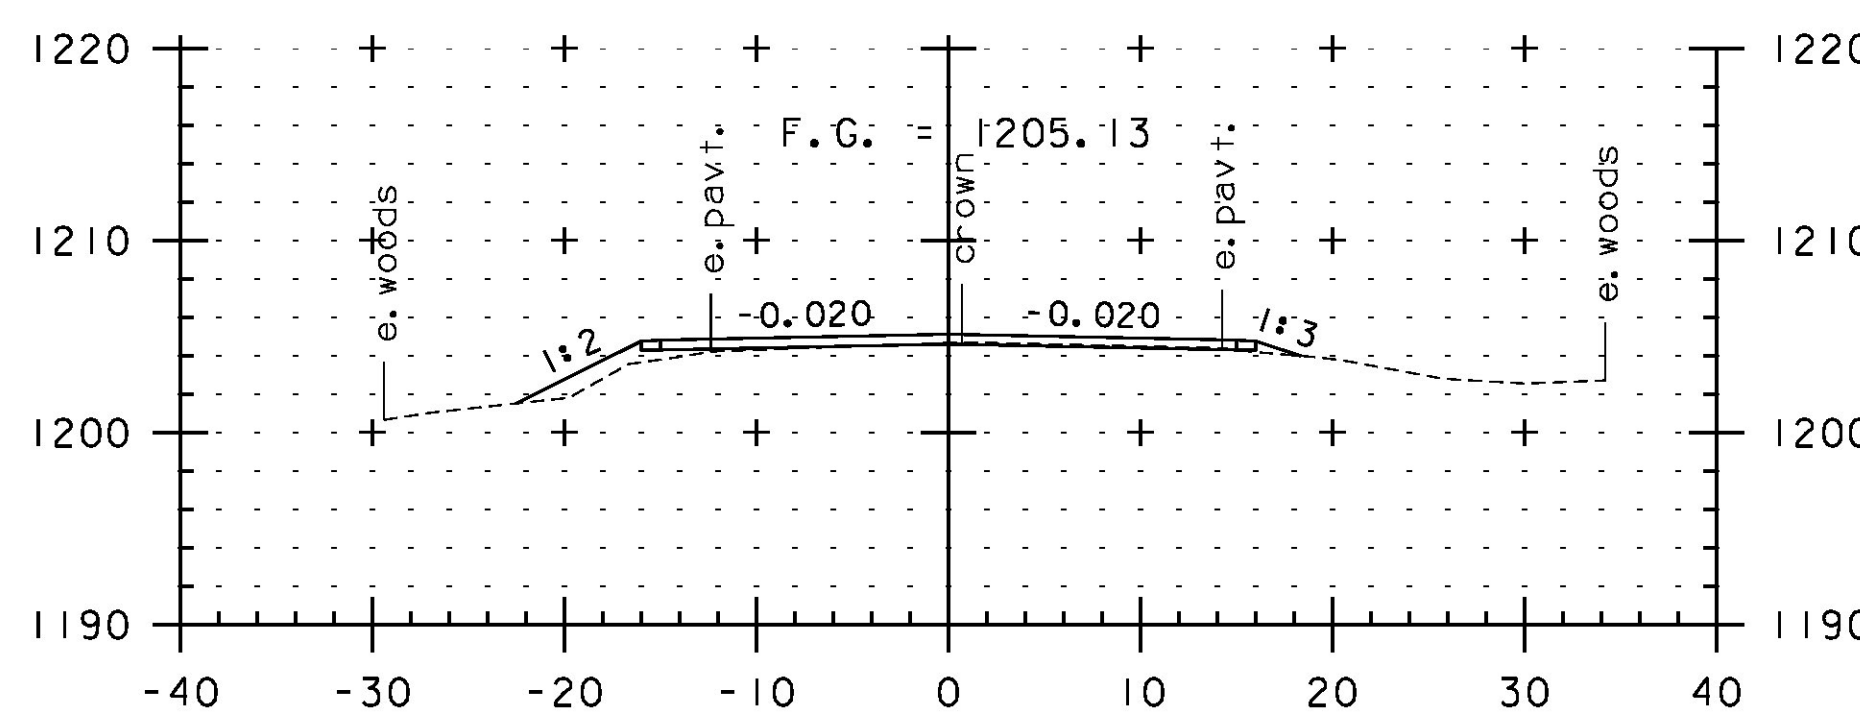

334+00

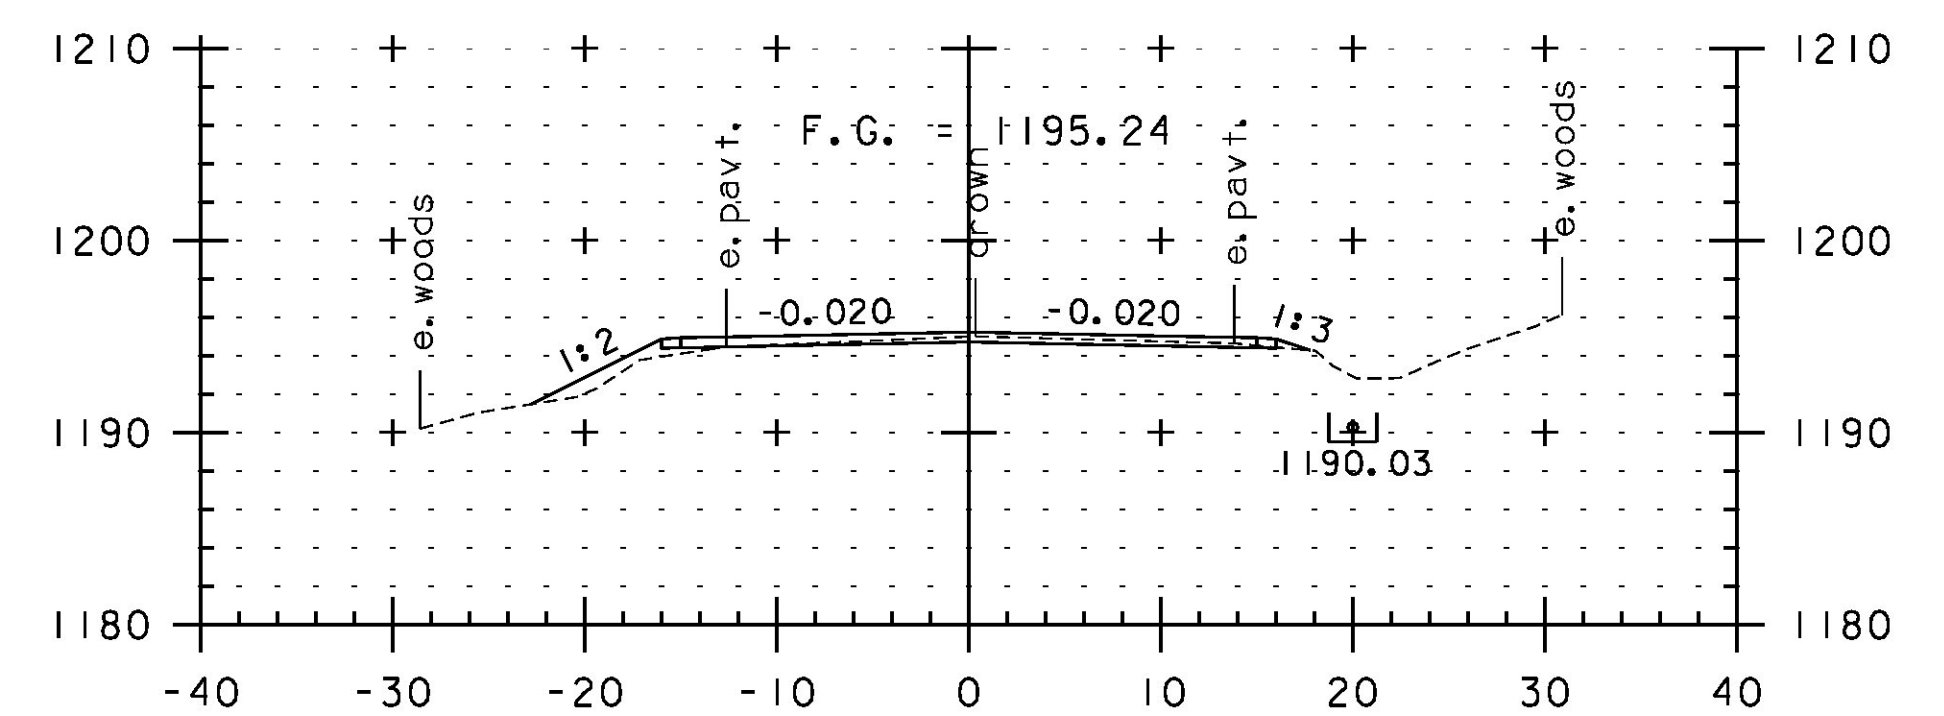

335+50



STA. 332+50 TO STA. 336+50

PROJECT NAME:	JAY-TROY	PLOT DATE:	5/16/2014
PROJECT NUMBER:	STP 2315(I)	DRAWN BY:	W. GORDON
FILE NAME:	z10b232xs.dgn	CHECKED BY:	P. SHEDD
PROJECT LEADER:	P. SHEDD	CROSS SECTION SHEET	76
DESIGNED BY:	N. LEMAY	SHEET	212 OF 244