




347+00

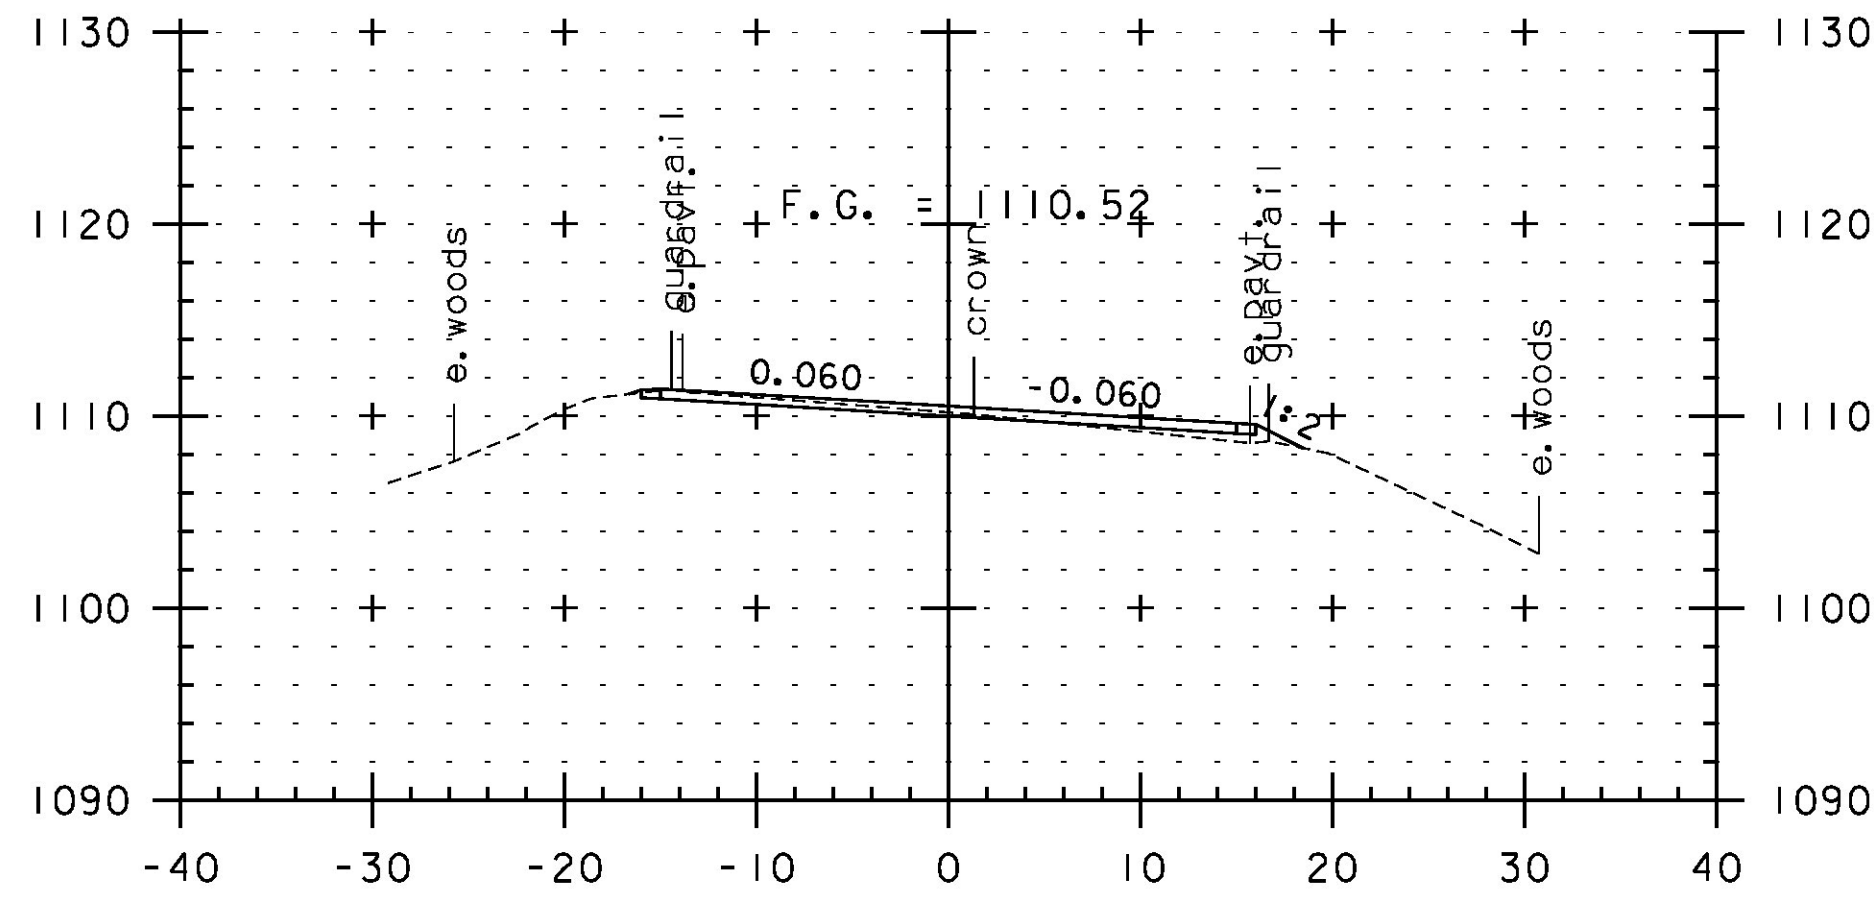


348+00

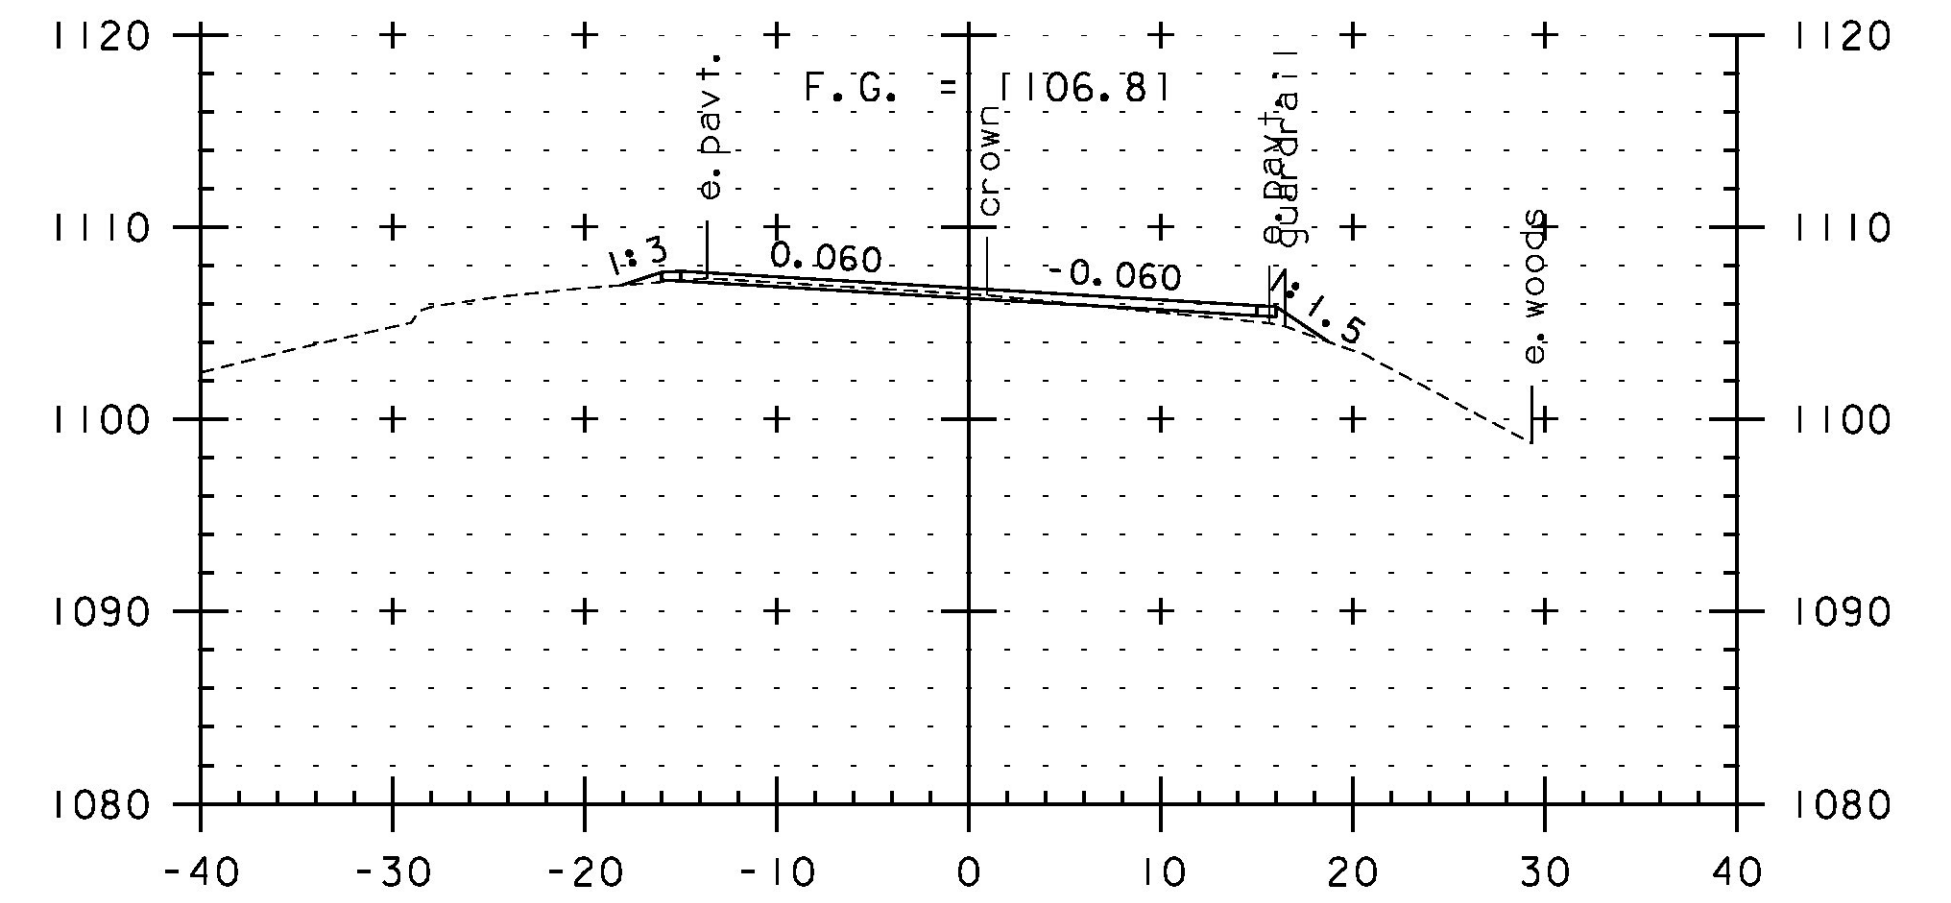


349+00

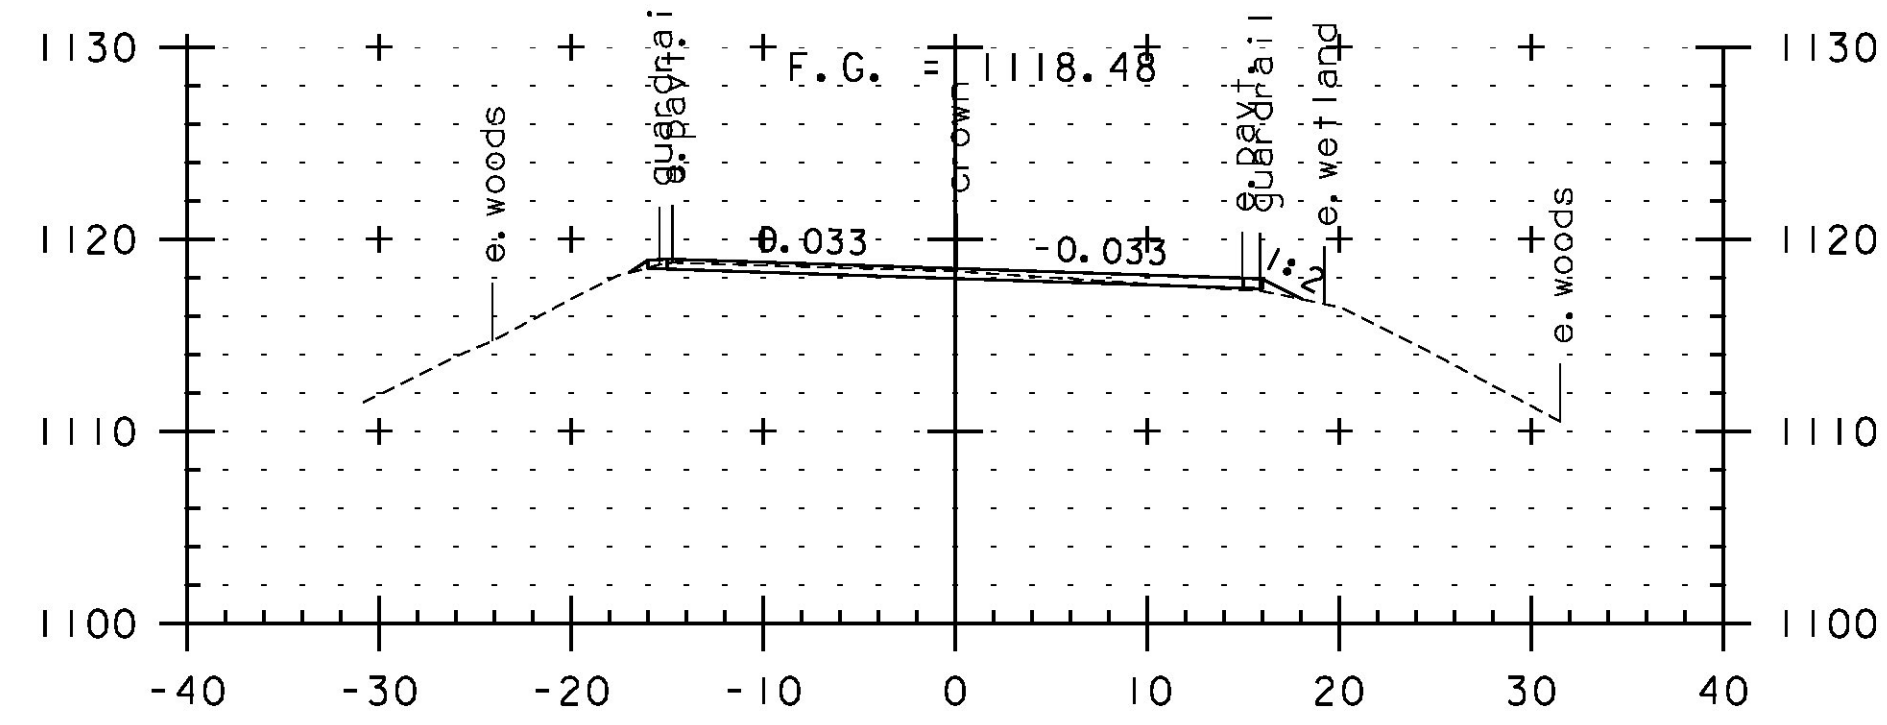


346+50

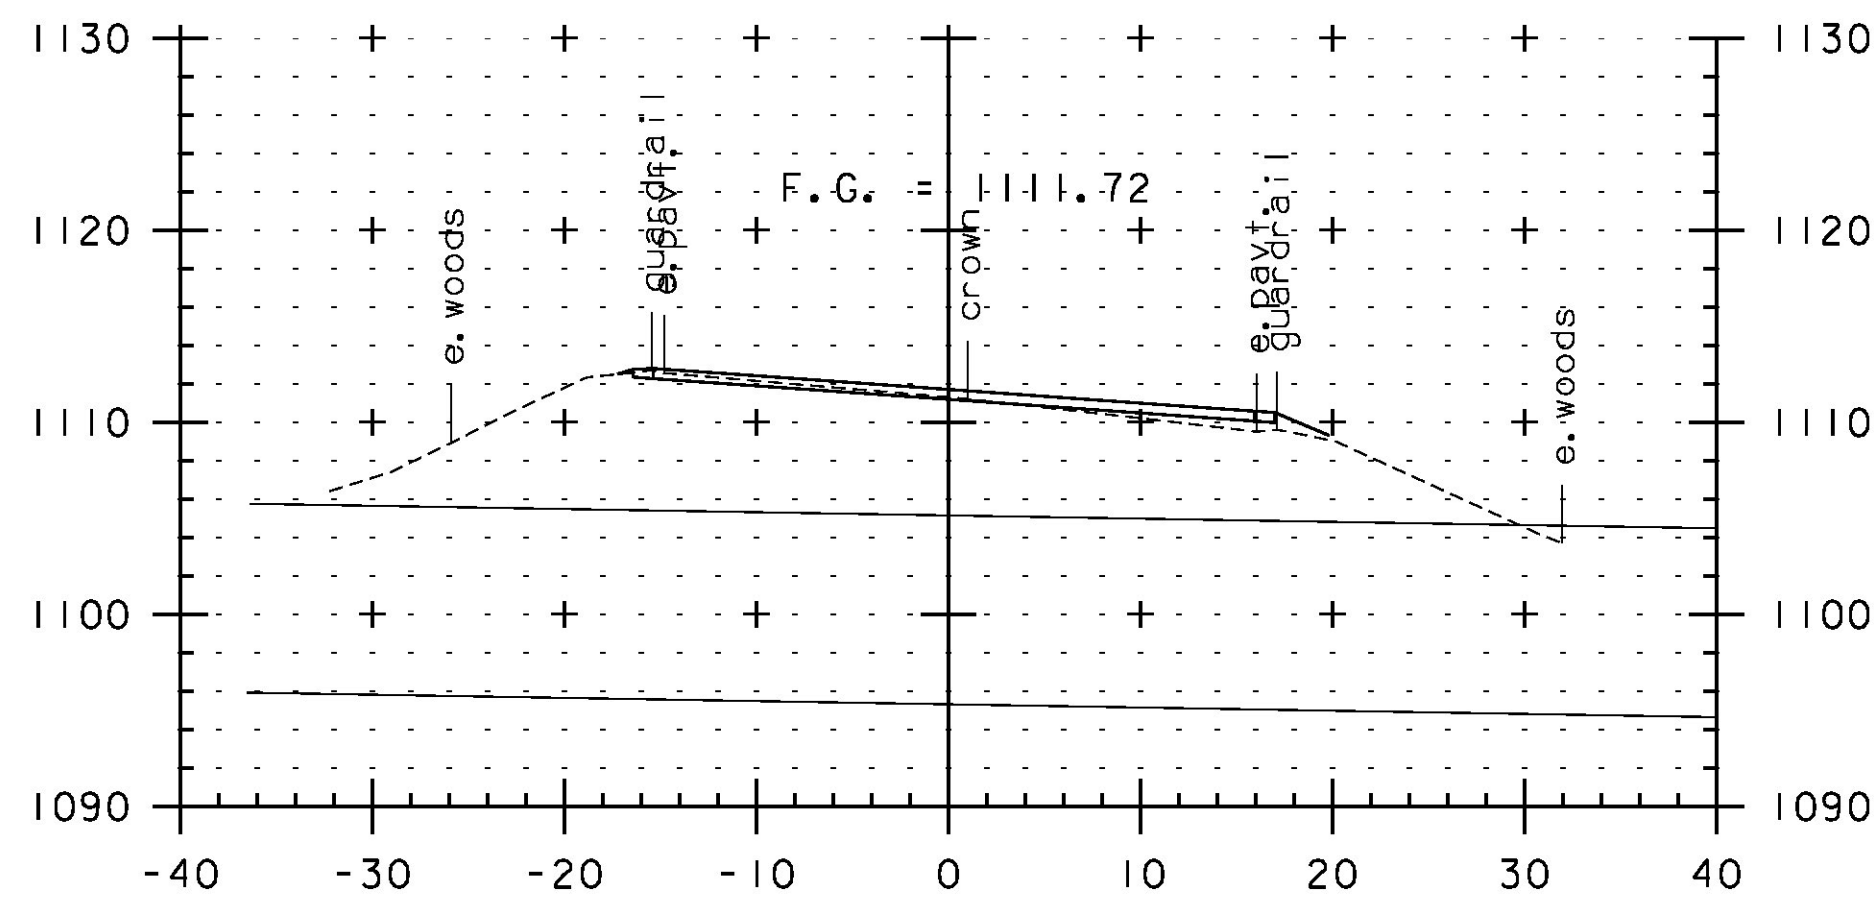


347+75
BRIDGE 51

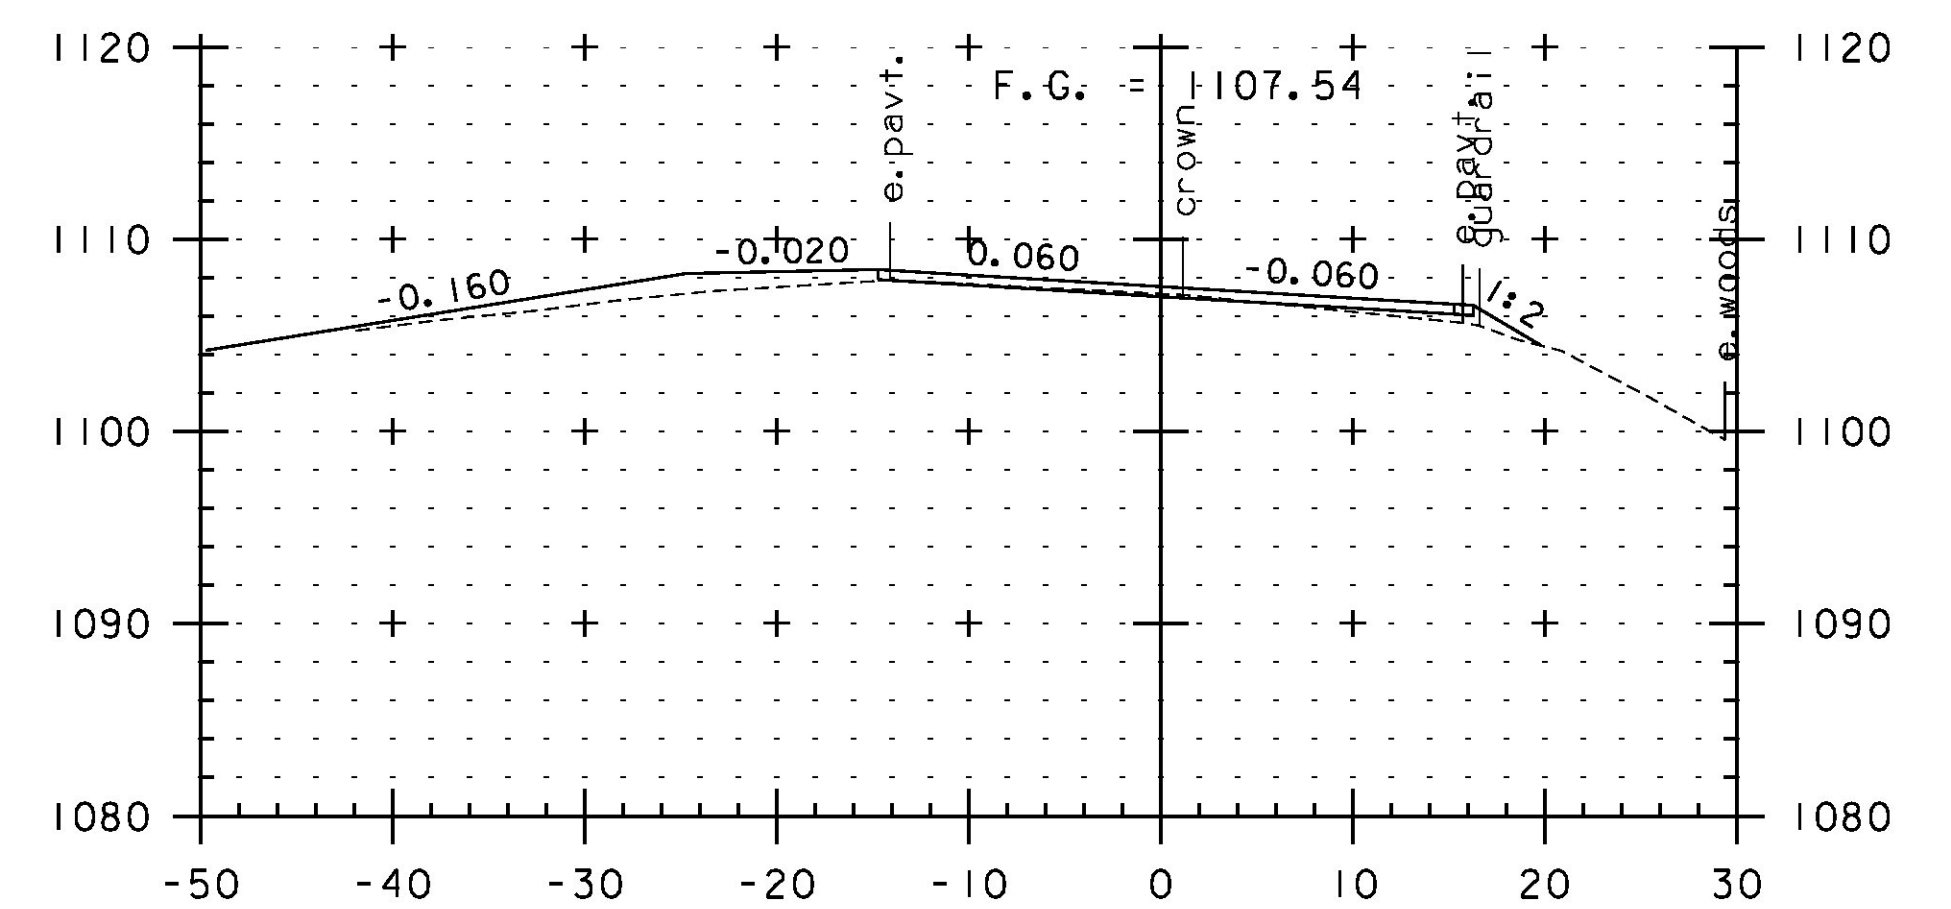


348+79
TH 44 LT

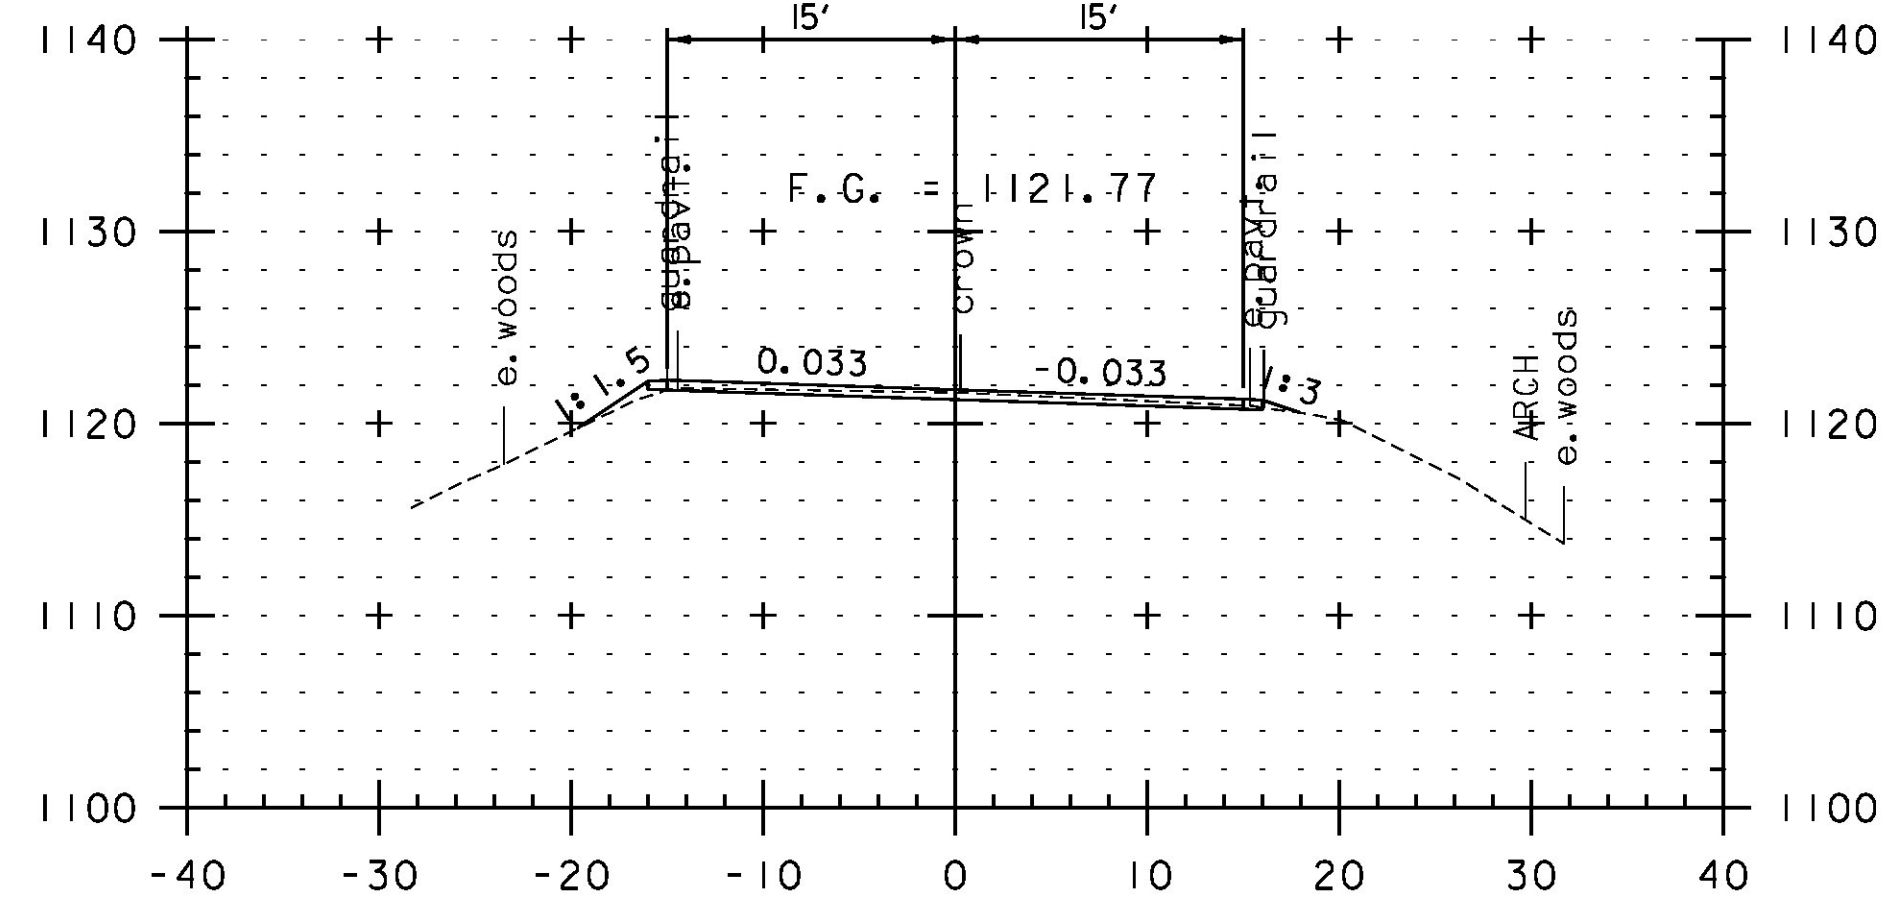

346+00

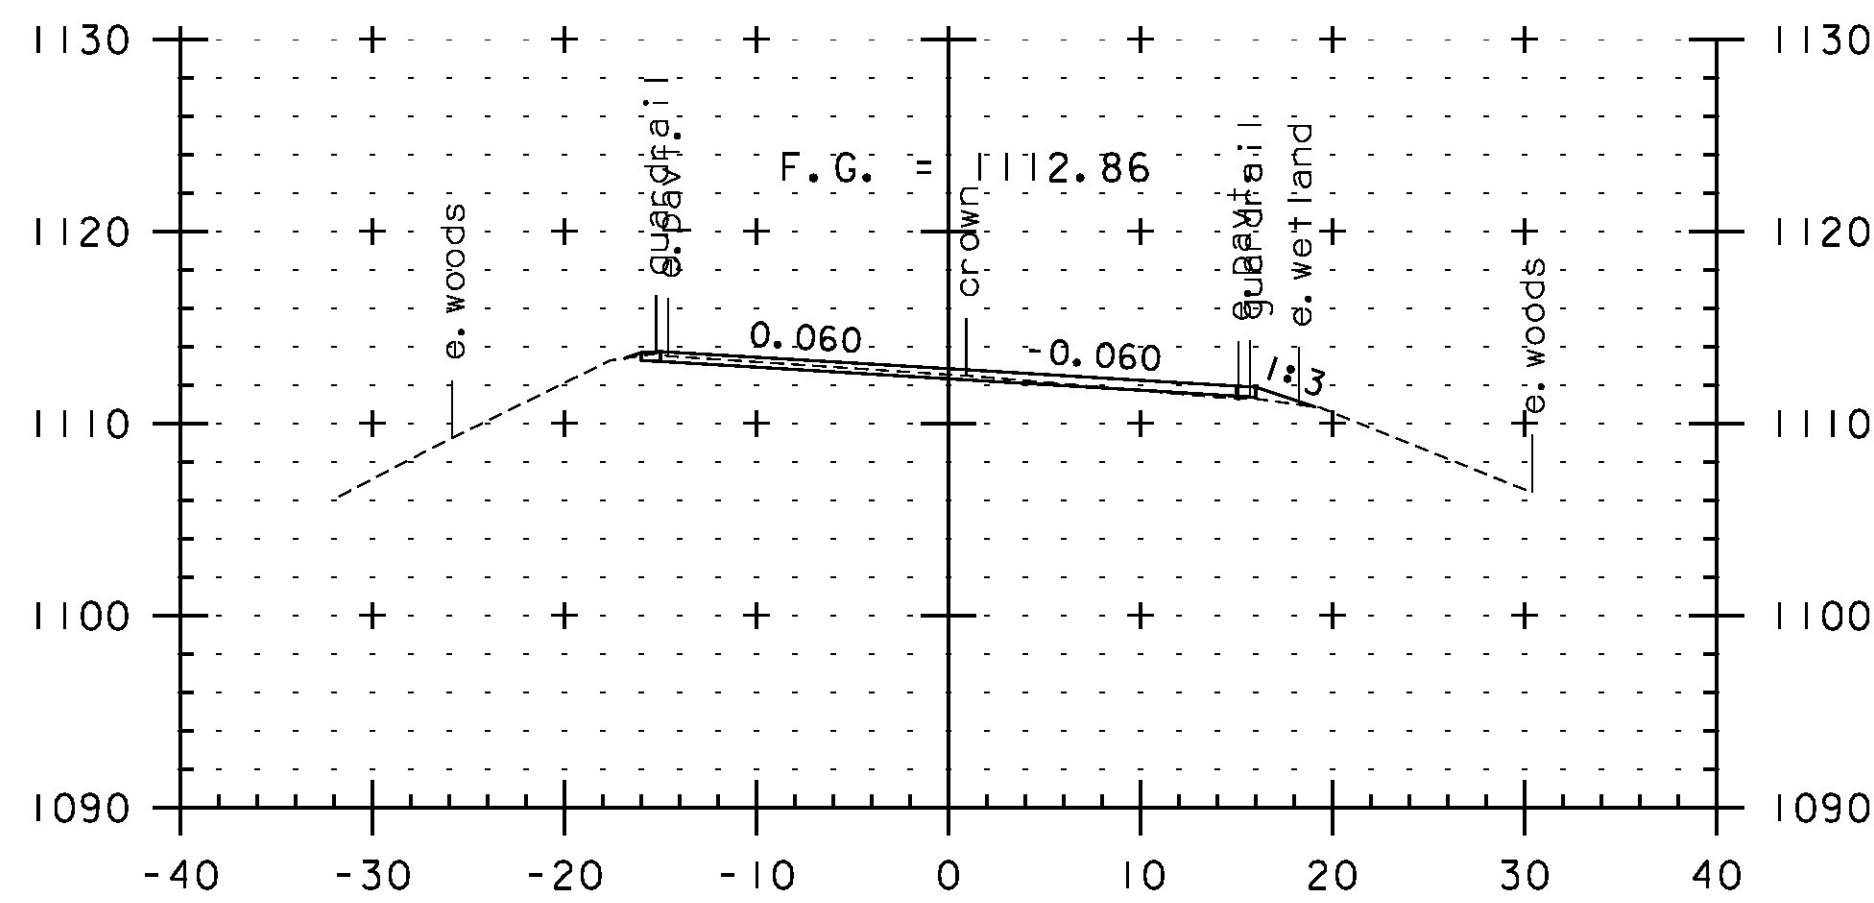

347+50

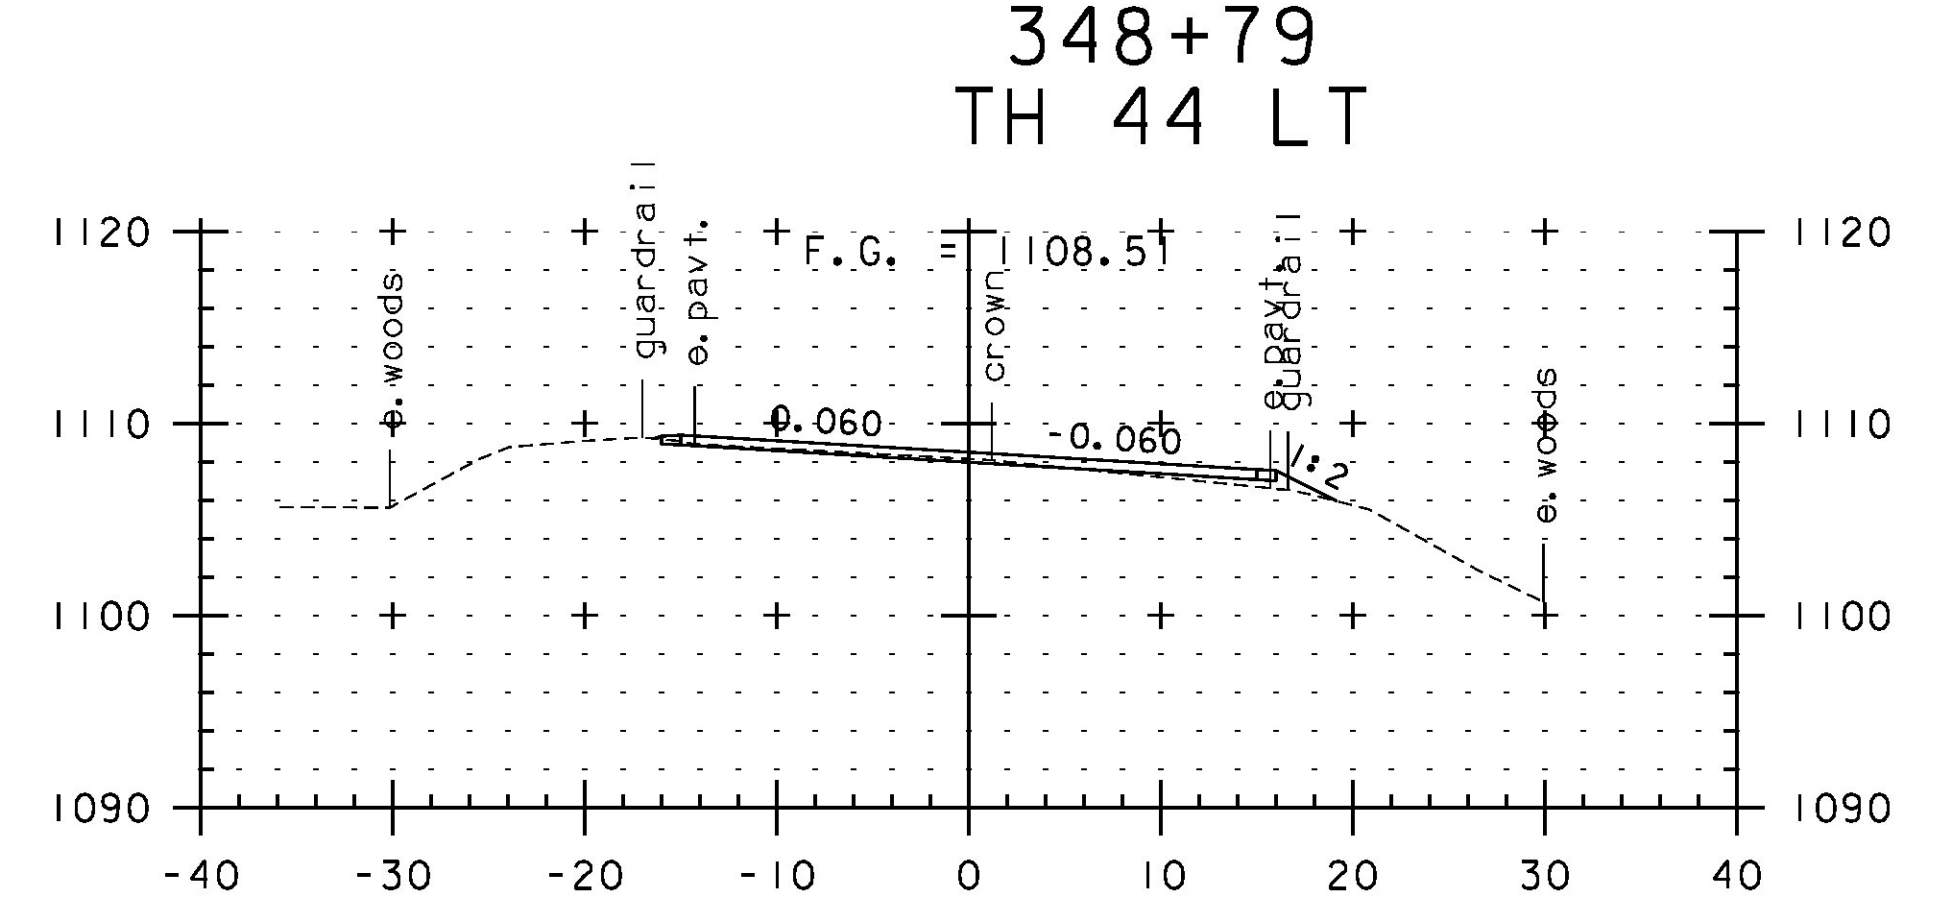

348+50



STA. 346+00 TO STA. 349+00

PROJECT NAME:	JAY-TROY	PLOT DATE:	5/16/2014
PROJECT NUMBER:	STP 2315(I)	DRAWN BY:	W. GORDON
FILE NAME:	z10b232xs.dgn	CHECKED BY:	P. SHEDD
PROJECT LEADER:	P. SHEDD	CROSS SECTION SHEET	79
DESIGNED BY:	N. LEMAY	SHEET	215 OF 244