




350+50

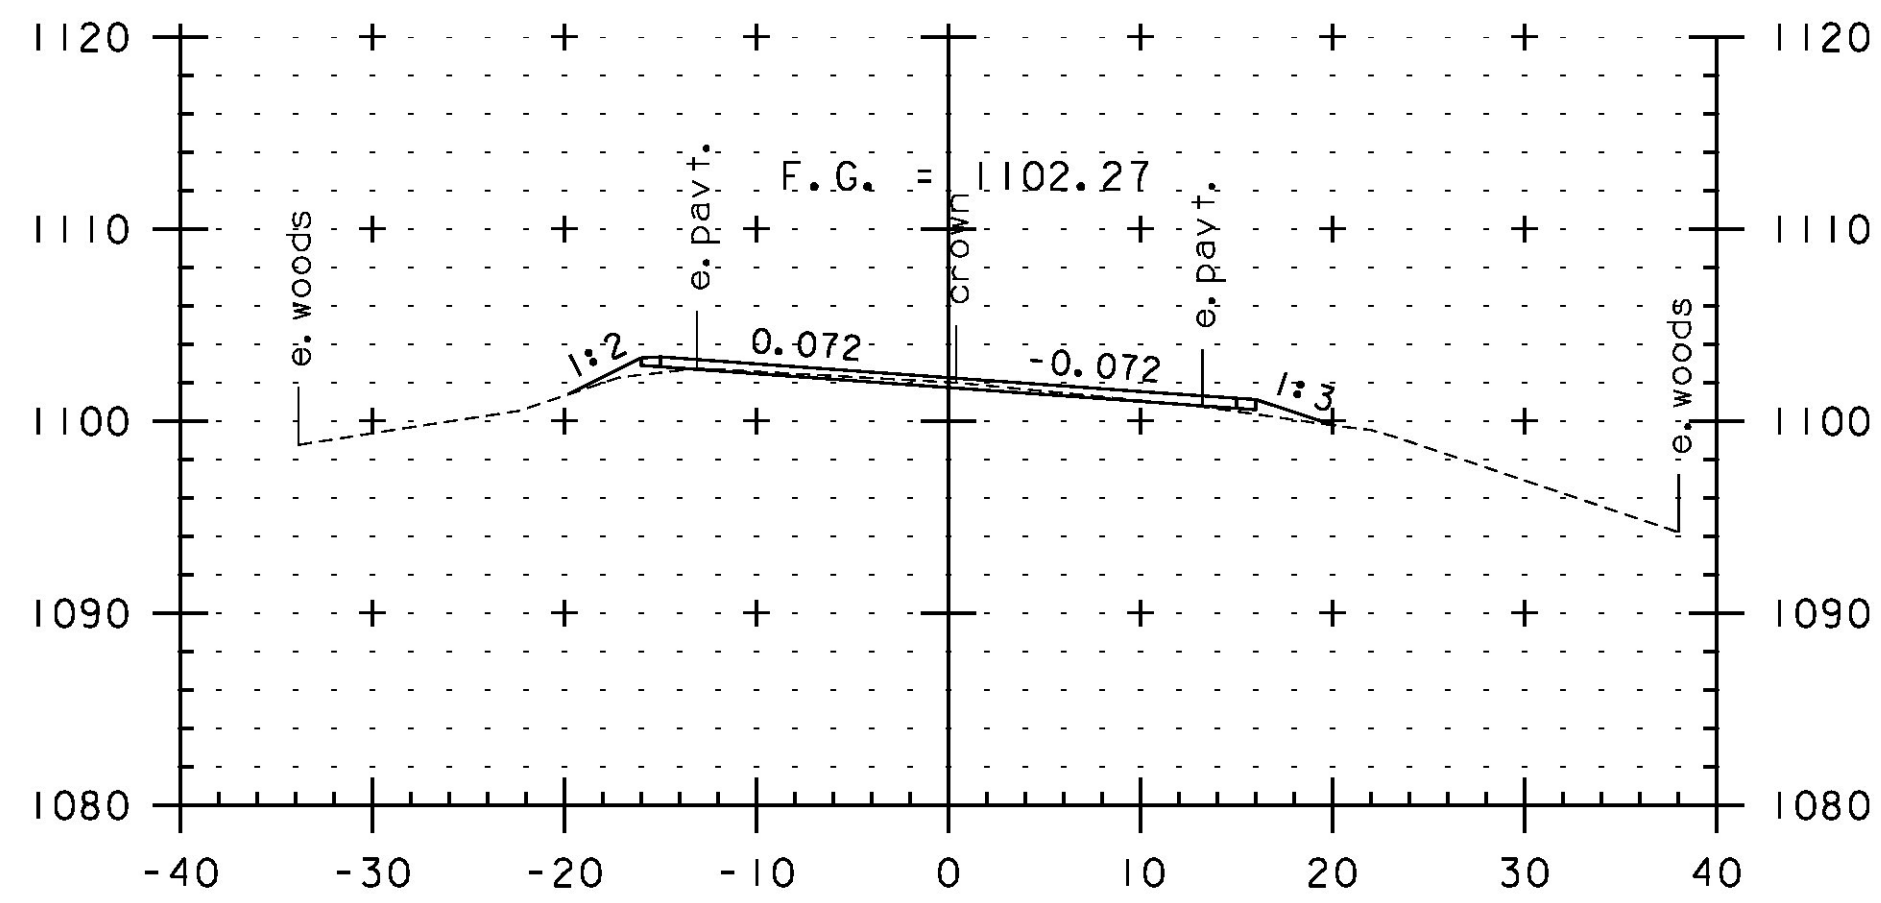


352+00

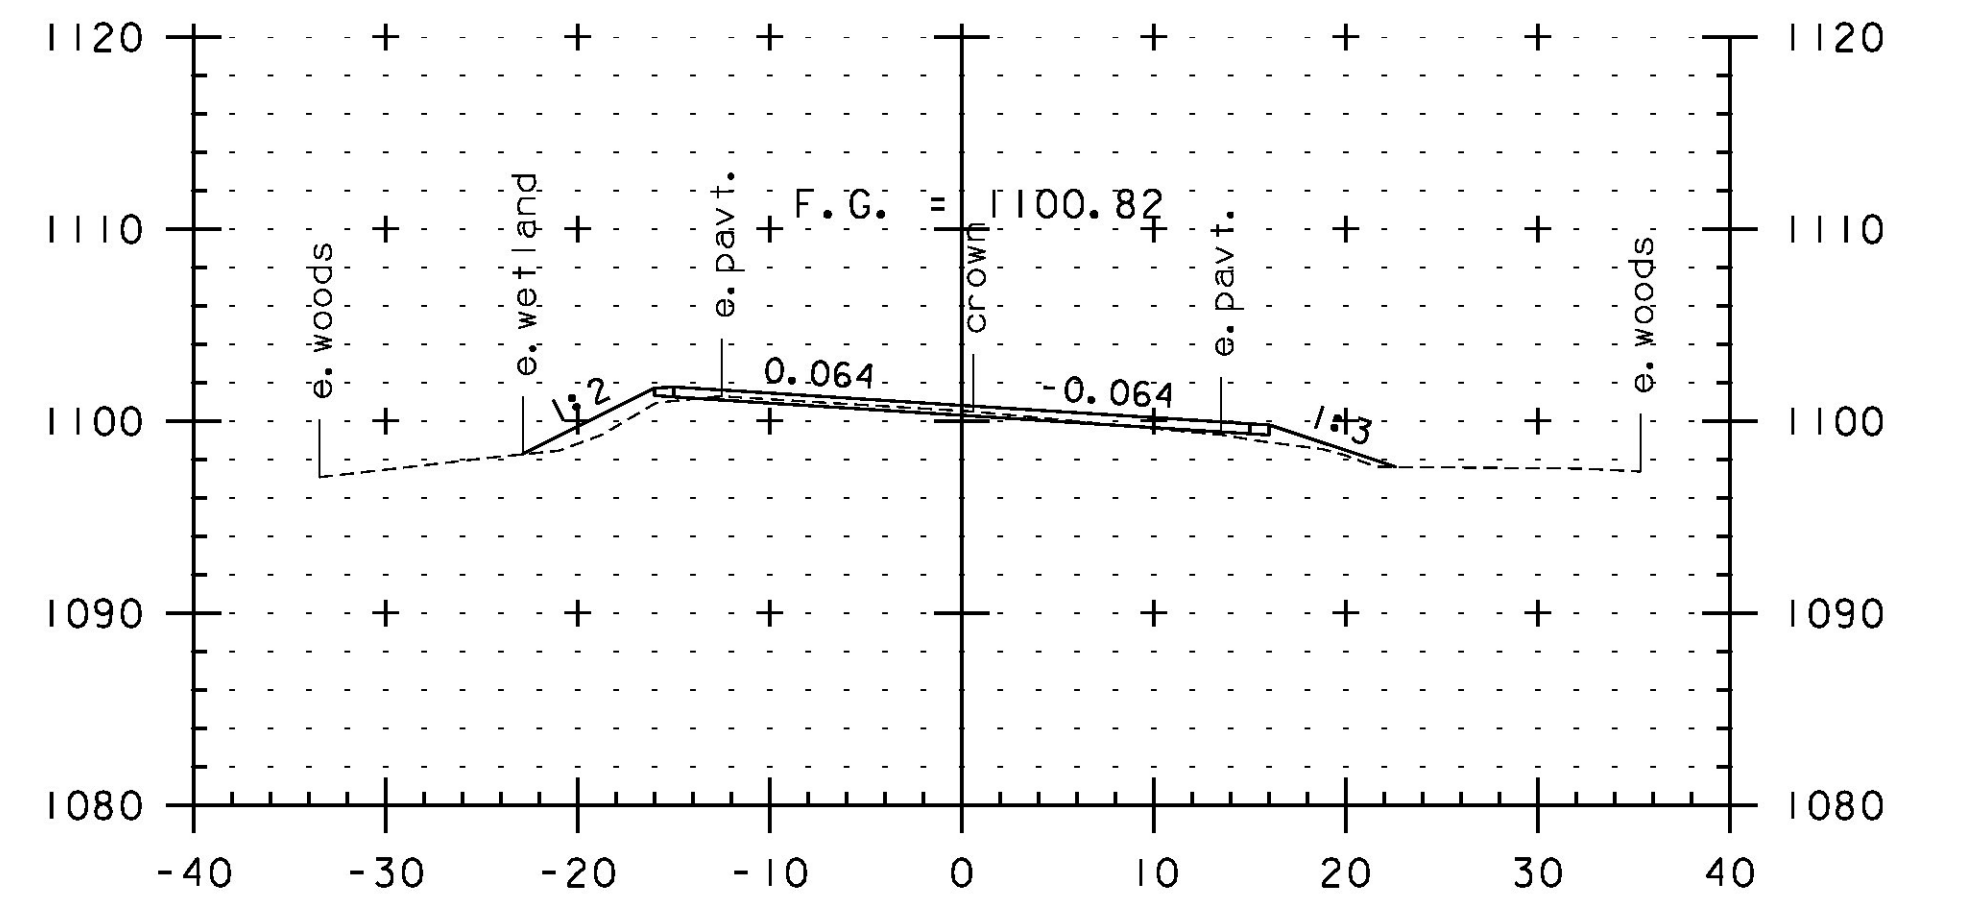


353+50

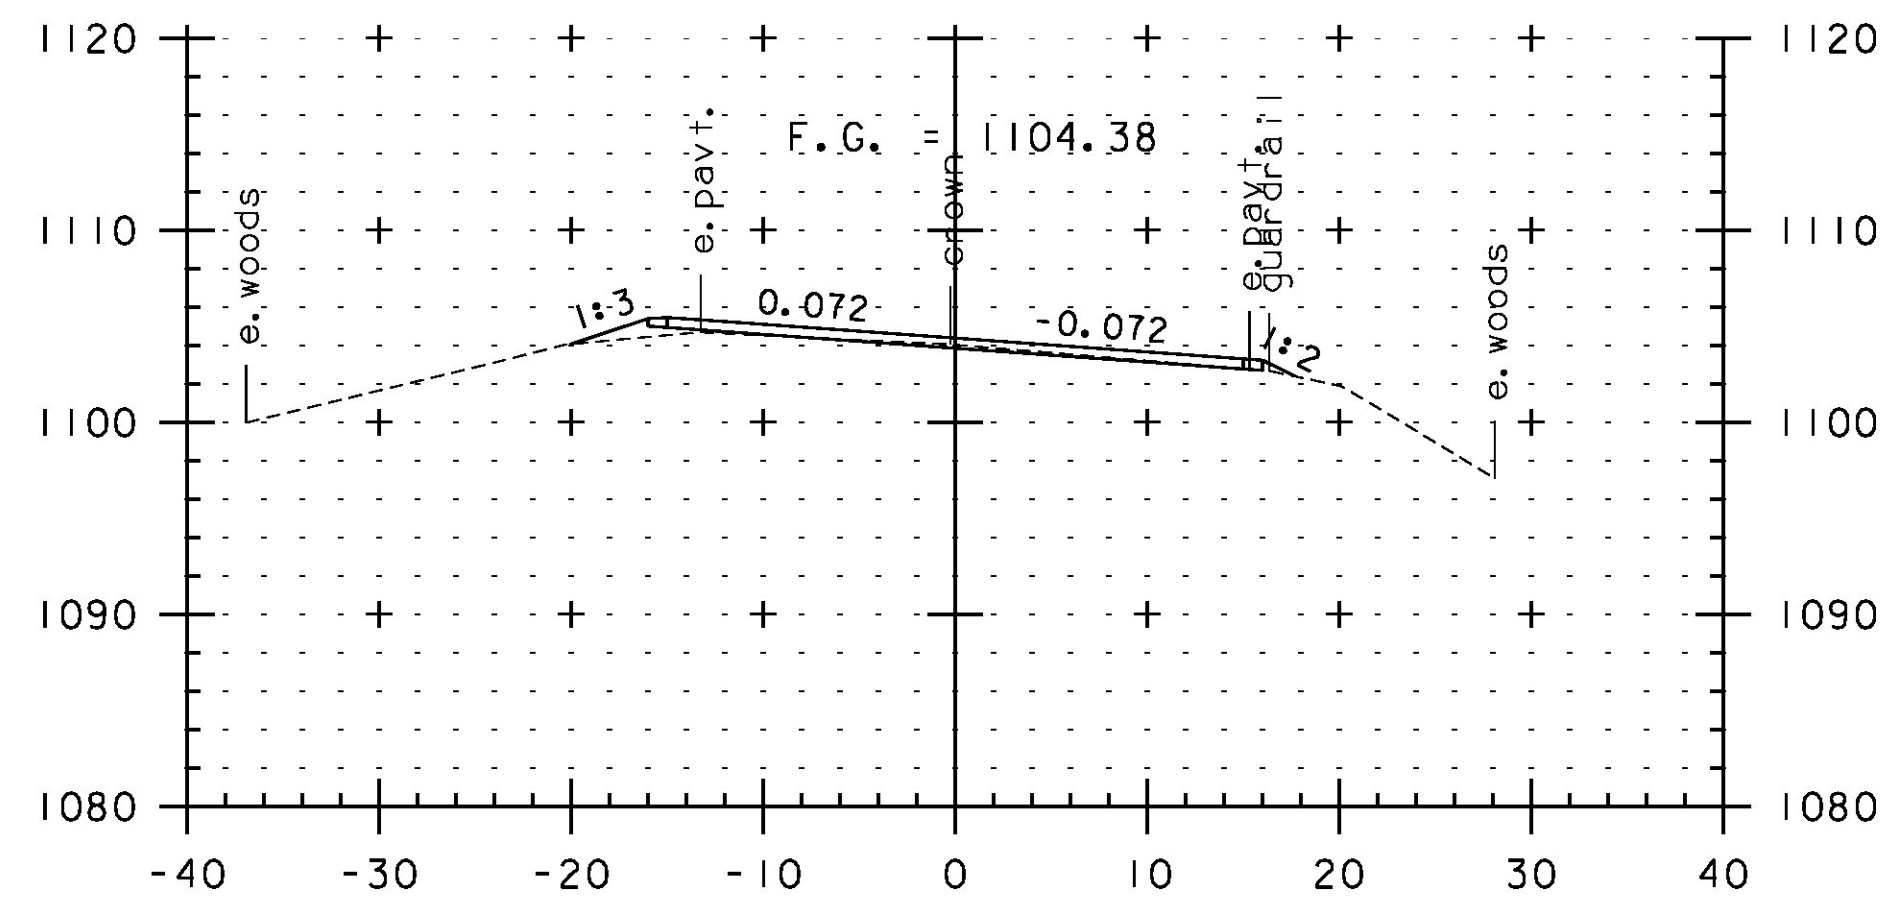


350+00

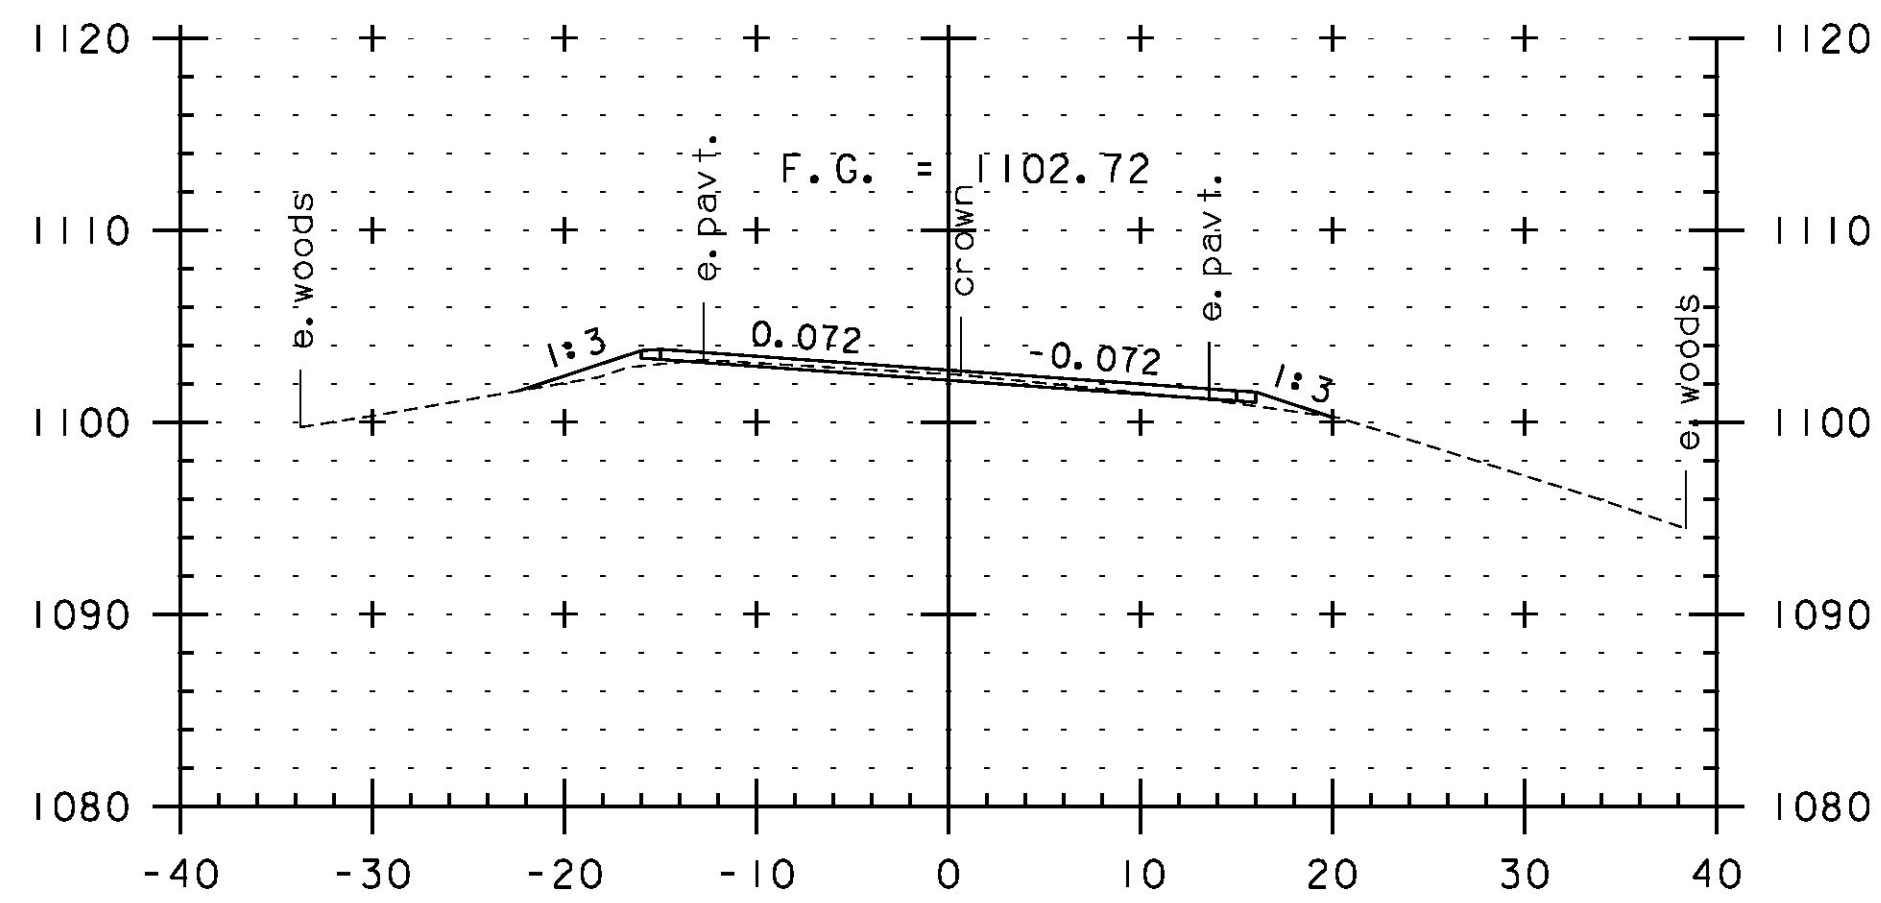


351+50

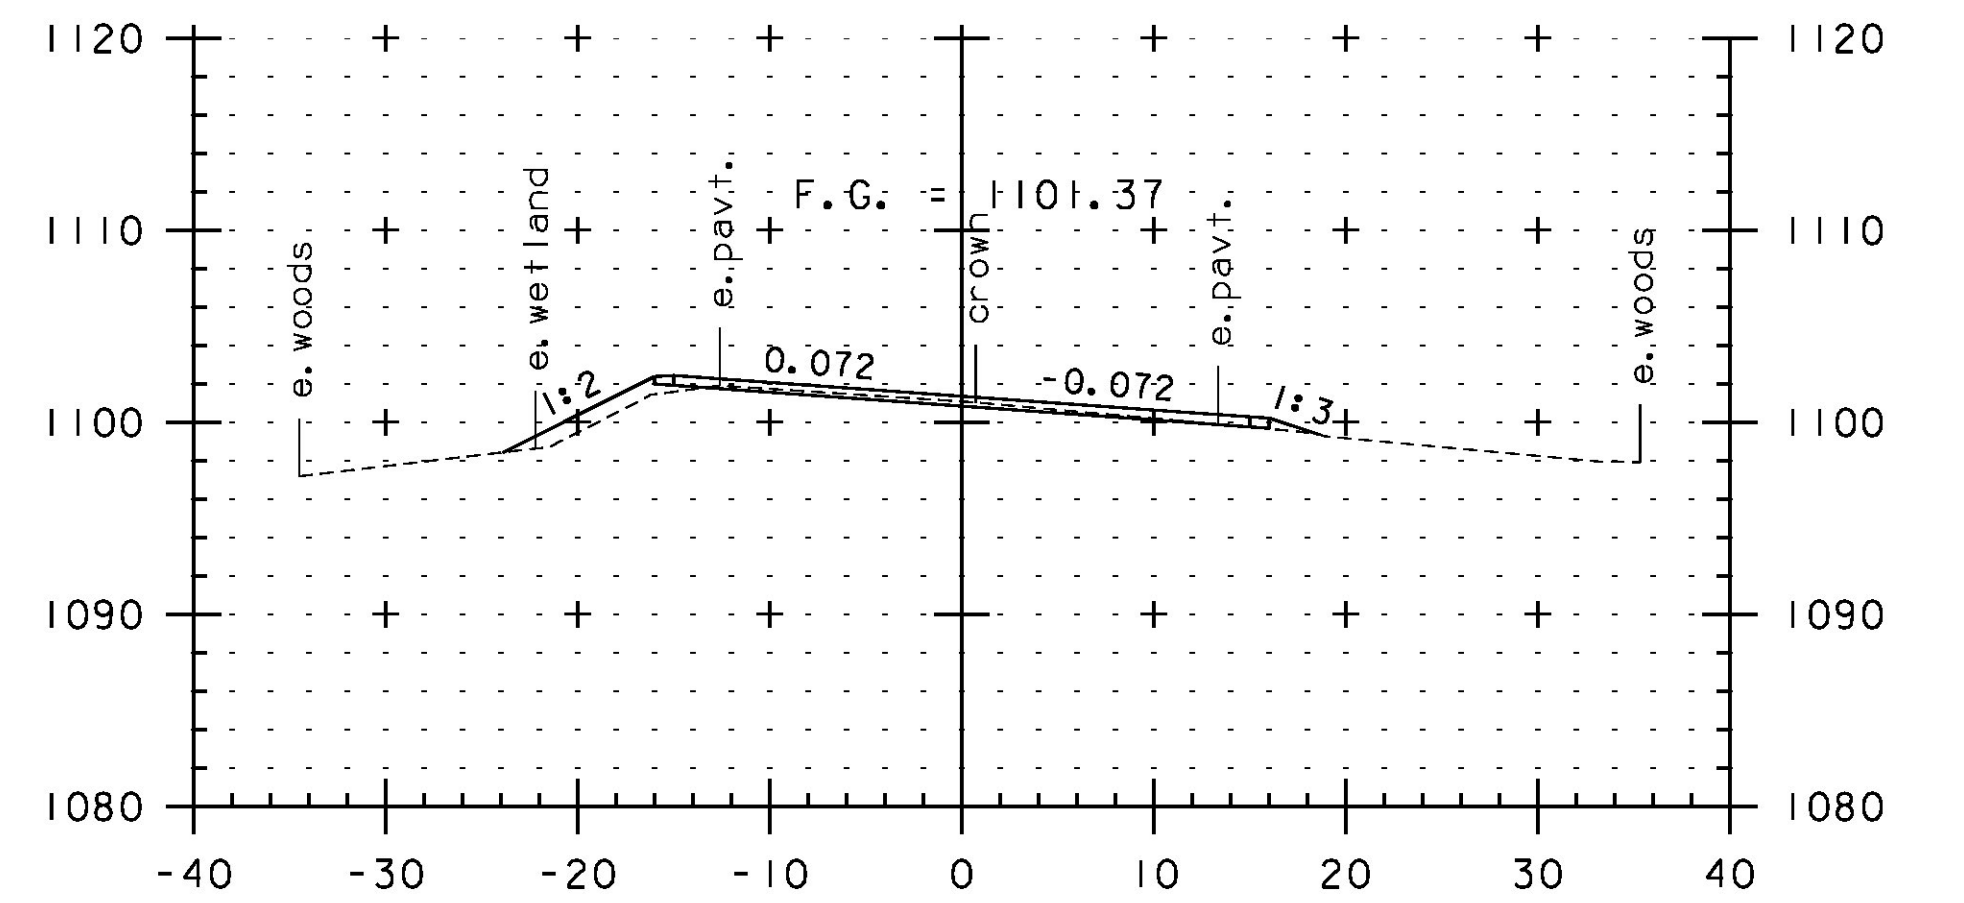


353+00

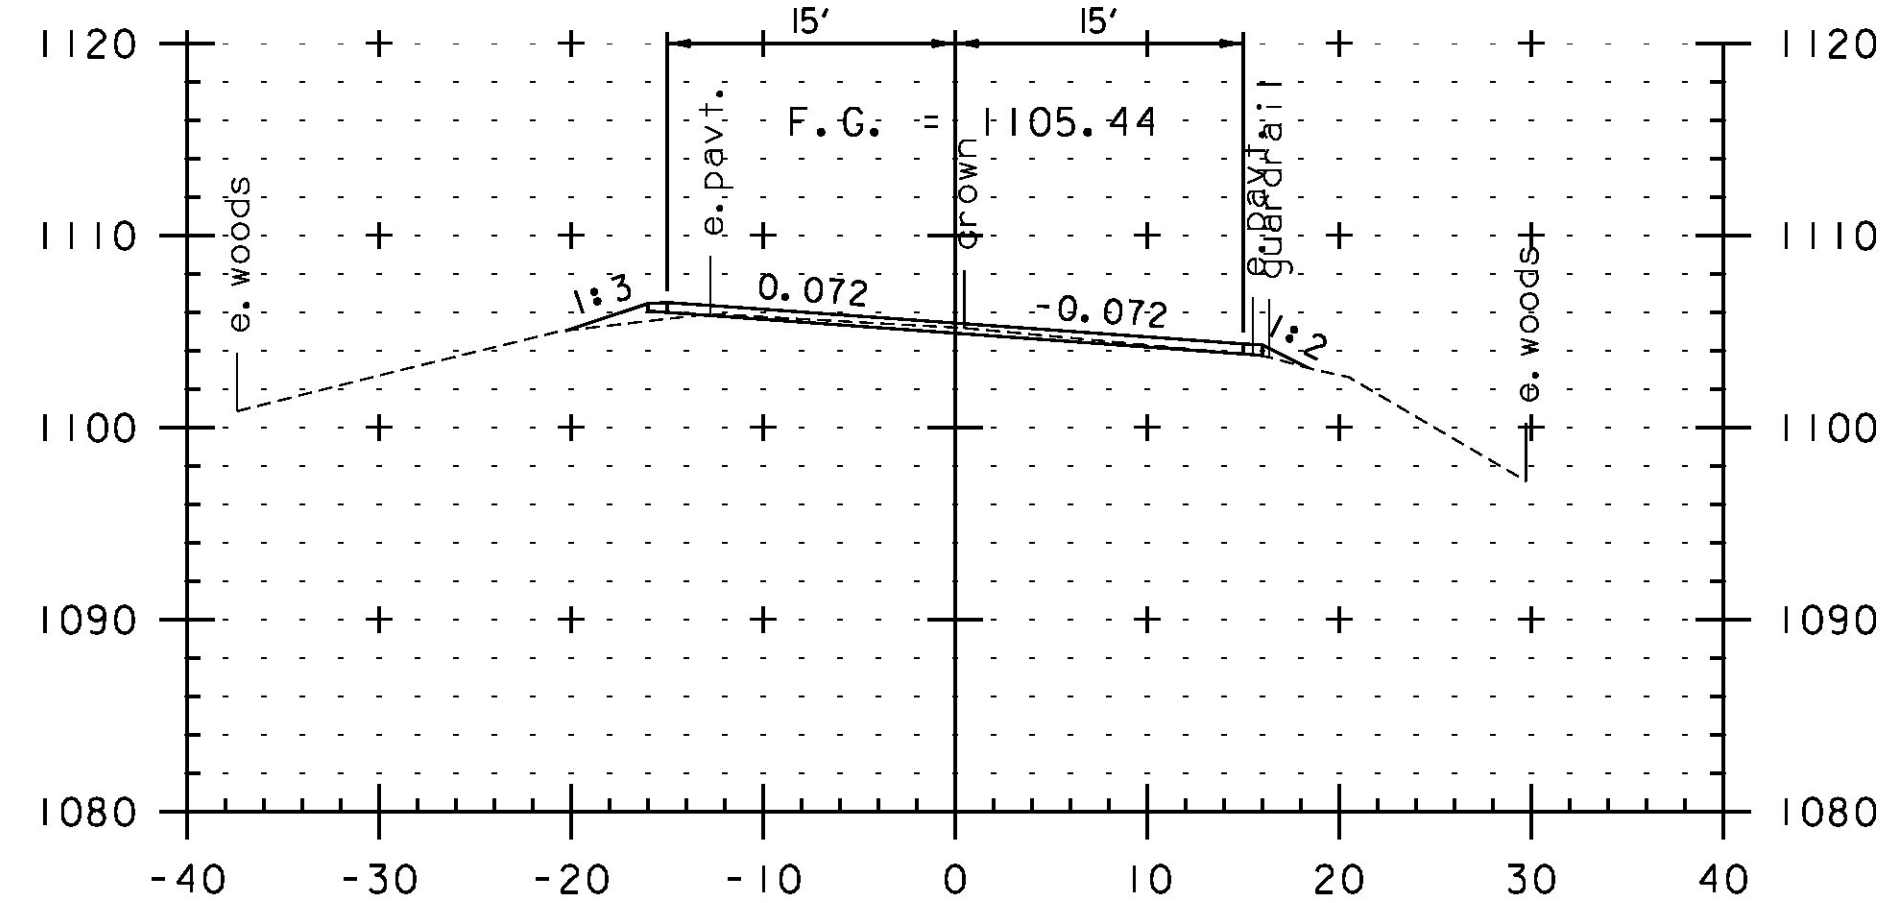

349+50

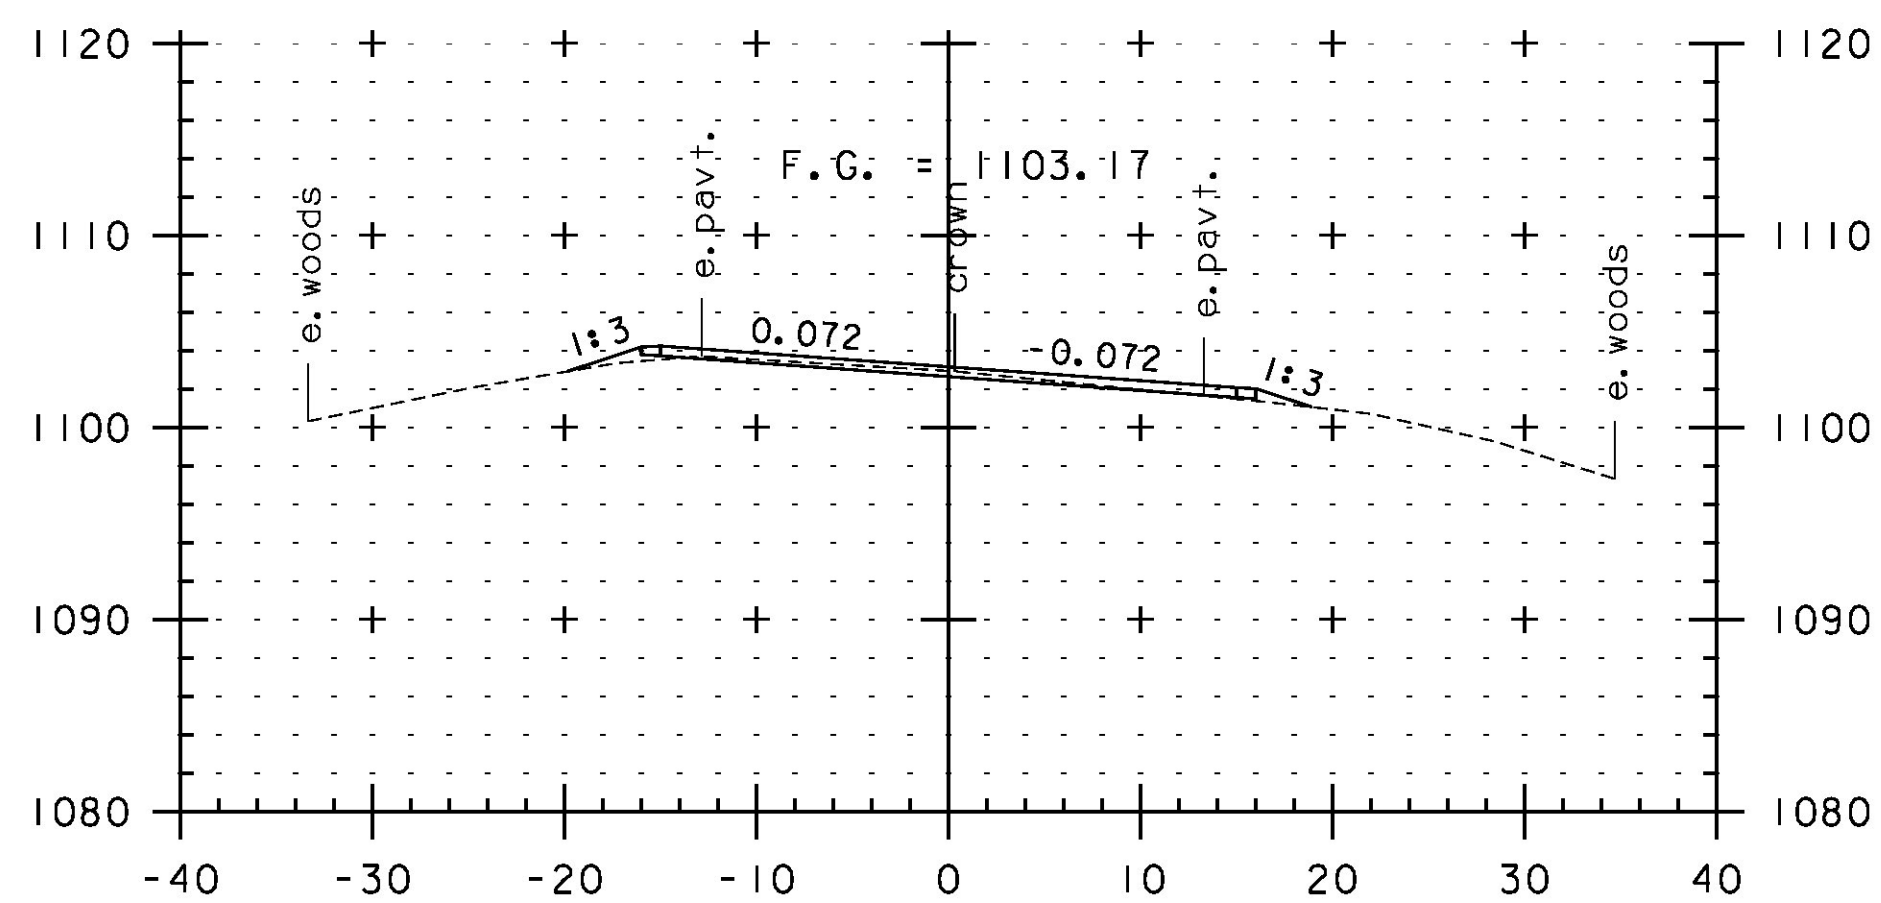

351+00

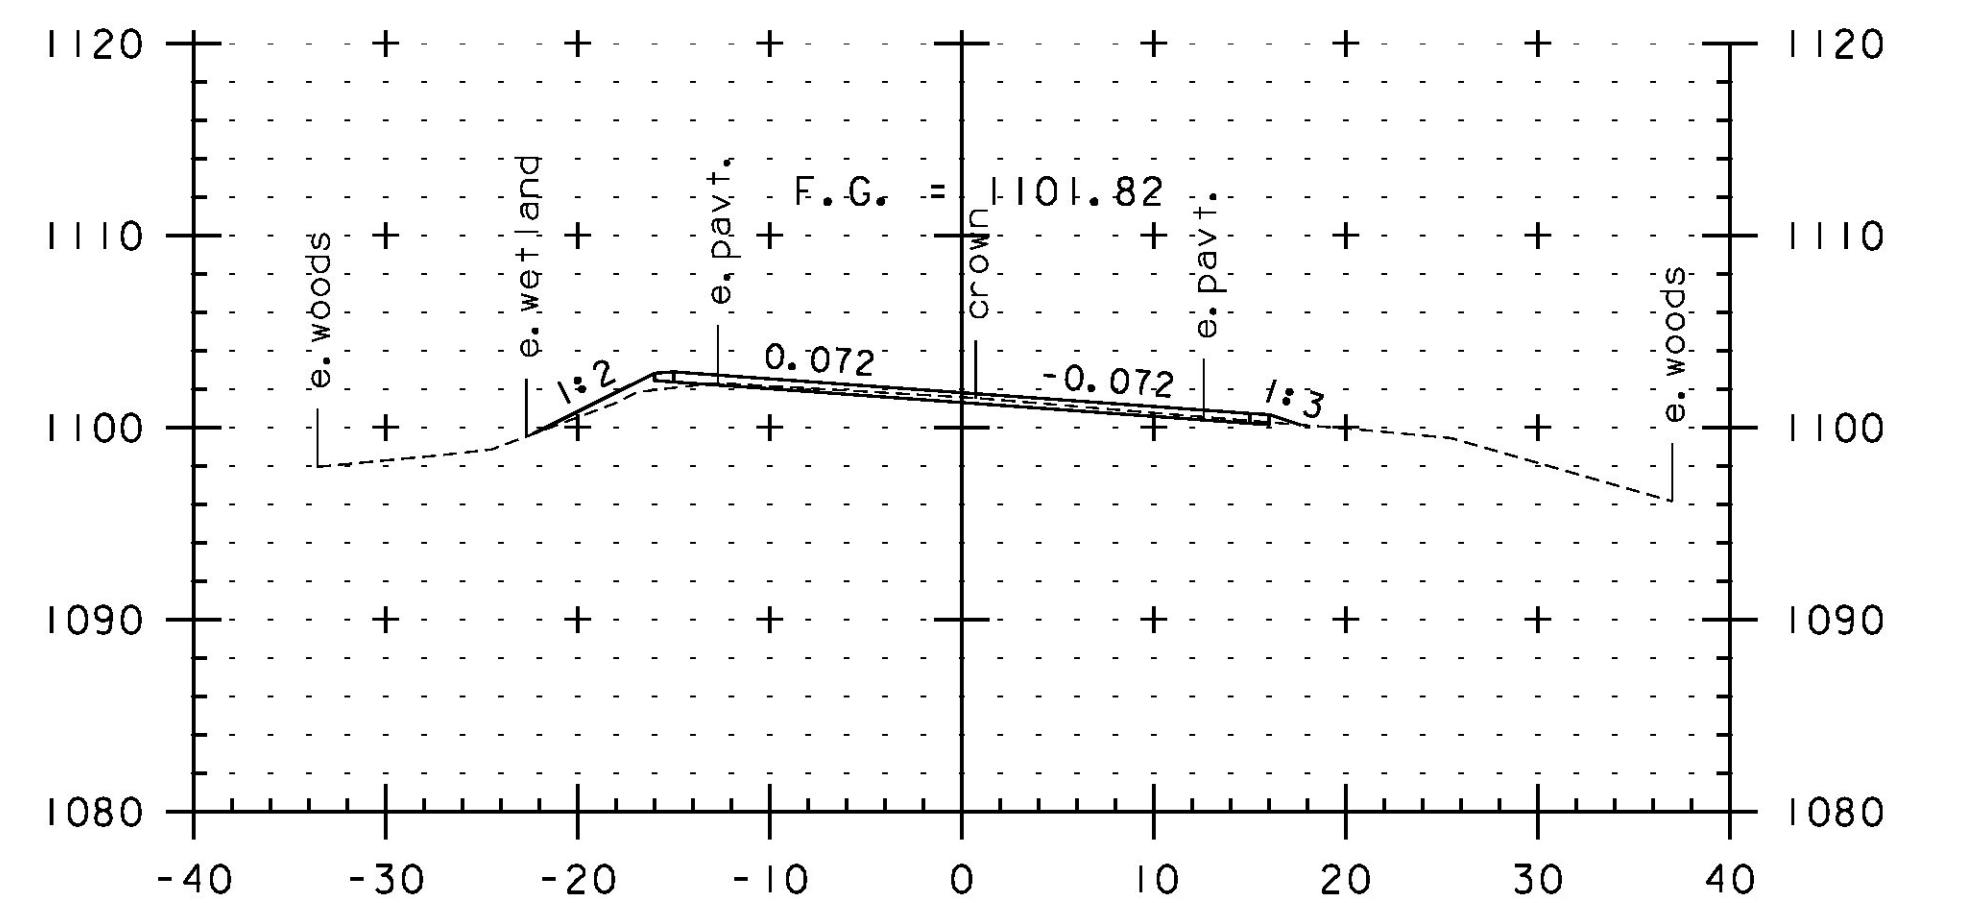

352+50



STA. 349+50 TO STA. 353+50

PROJECT NAME:	JAY-TROY	PLOT DATE:	5/16/2014
PROJECT NUMBER:	STP 2315(1)	DRAWN BY:	W. GORDON
FILE NAME:	z10b232xs.dgn	CHECKED BY:	P. SHEDD
PROJECT LEADER:	P. SHEDD	CROSS SECTION SHEET	80
DESIGNED BY:	N. LEMAY	SHEET	216 OF 244